


J. F. G. W.



Clearing of Right-of-Way shall include removal of all trees, fence, hedge and etc.- within the easement. All equipment, labor and tools necessary to complete the items shall be included in price bid of "Lump Sum Clear R/W."

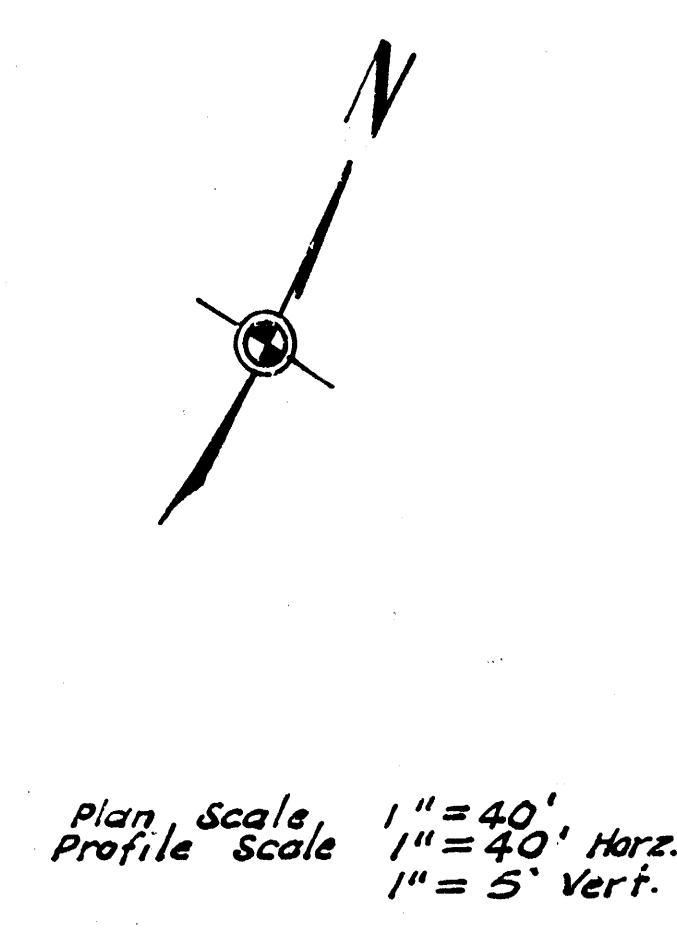

As Built Final Meas. K-102

LAT. 64, S. W. INTERCEPT SEWER
CITY OF WICHITA, KANSAS
R. W. LINN - CITY ENGINEER
DEC. 1973 PROJECT NO. DBKL 573075