

LAT 70 SOUTHWEST INTERCEPTOR CITY OF WICHITA, KANSAS

R. W. LINN _____ CITY ENGINEER

PROJECT NUMBER DBKL574067

GENERAL NOTES

1. LINE NO. 1 IS TO BE COMPLETED AT THE EARLIEST POSSIBLE DATE SUCH THAT SEWER SERVICE WILL BE AVAILABLE FOR THE NURSING HOME DEVELOPMENT. CONTRACTOR SHALL VERIFY ELEVATION OF BUILDING SEWER AT STATION 1+431.1 ON LINE NO. 1 PRIOR TO INSTALLING ANY PIPE ON THIS PROJECT.
2. EXCAVATED MATERIAL SHALL BE USED AS BACKFILL FROM STATION 0+00 TO 2+00 ON LINE NO. 1 AND FROM STATION 3+43.5 TO 4+90.0 ON LINE NO. 2. EXCAVATED MATERIAL SHALL BE COMPACTED TO A MINIMUM DENSITY OF 90% OF STANDARD DENSITY.
3. GRASSED AREAS DISTURBED BETWEEN THE LIMITS OF STATION 0+00 TO 2+00 ON LINE NO. 1 SHALL BE SEEDED AND MULCHED. SEED SHALL BE APPLIED AT A RATE OF 250 LBS. TO THE ACRE.

MILES LAKEWOOD VILLAGE SECOND ADDITION



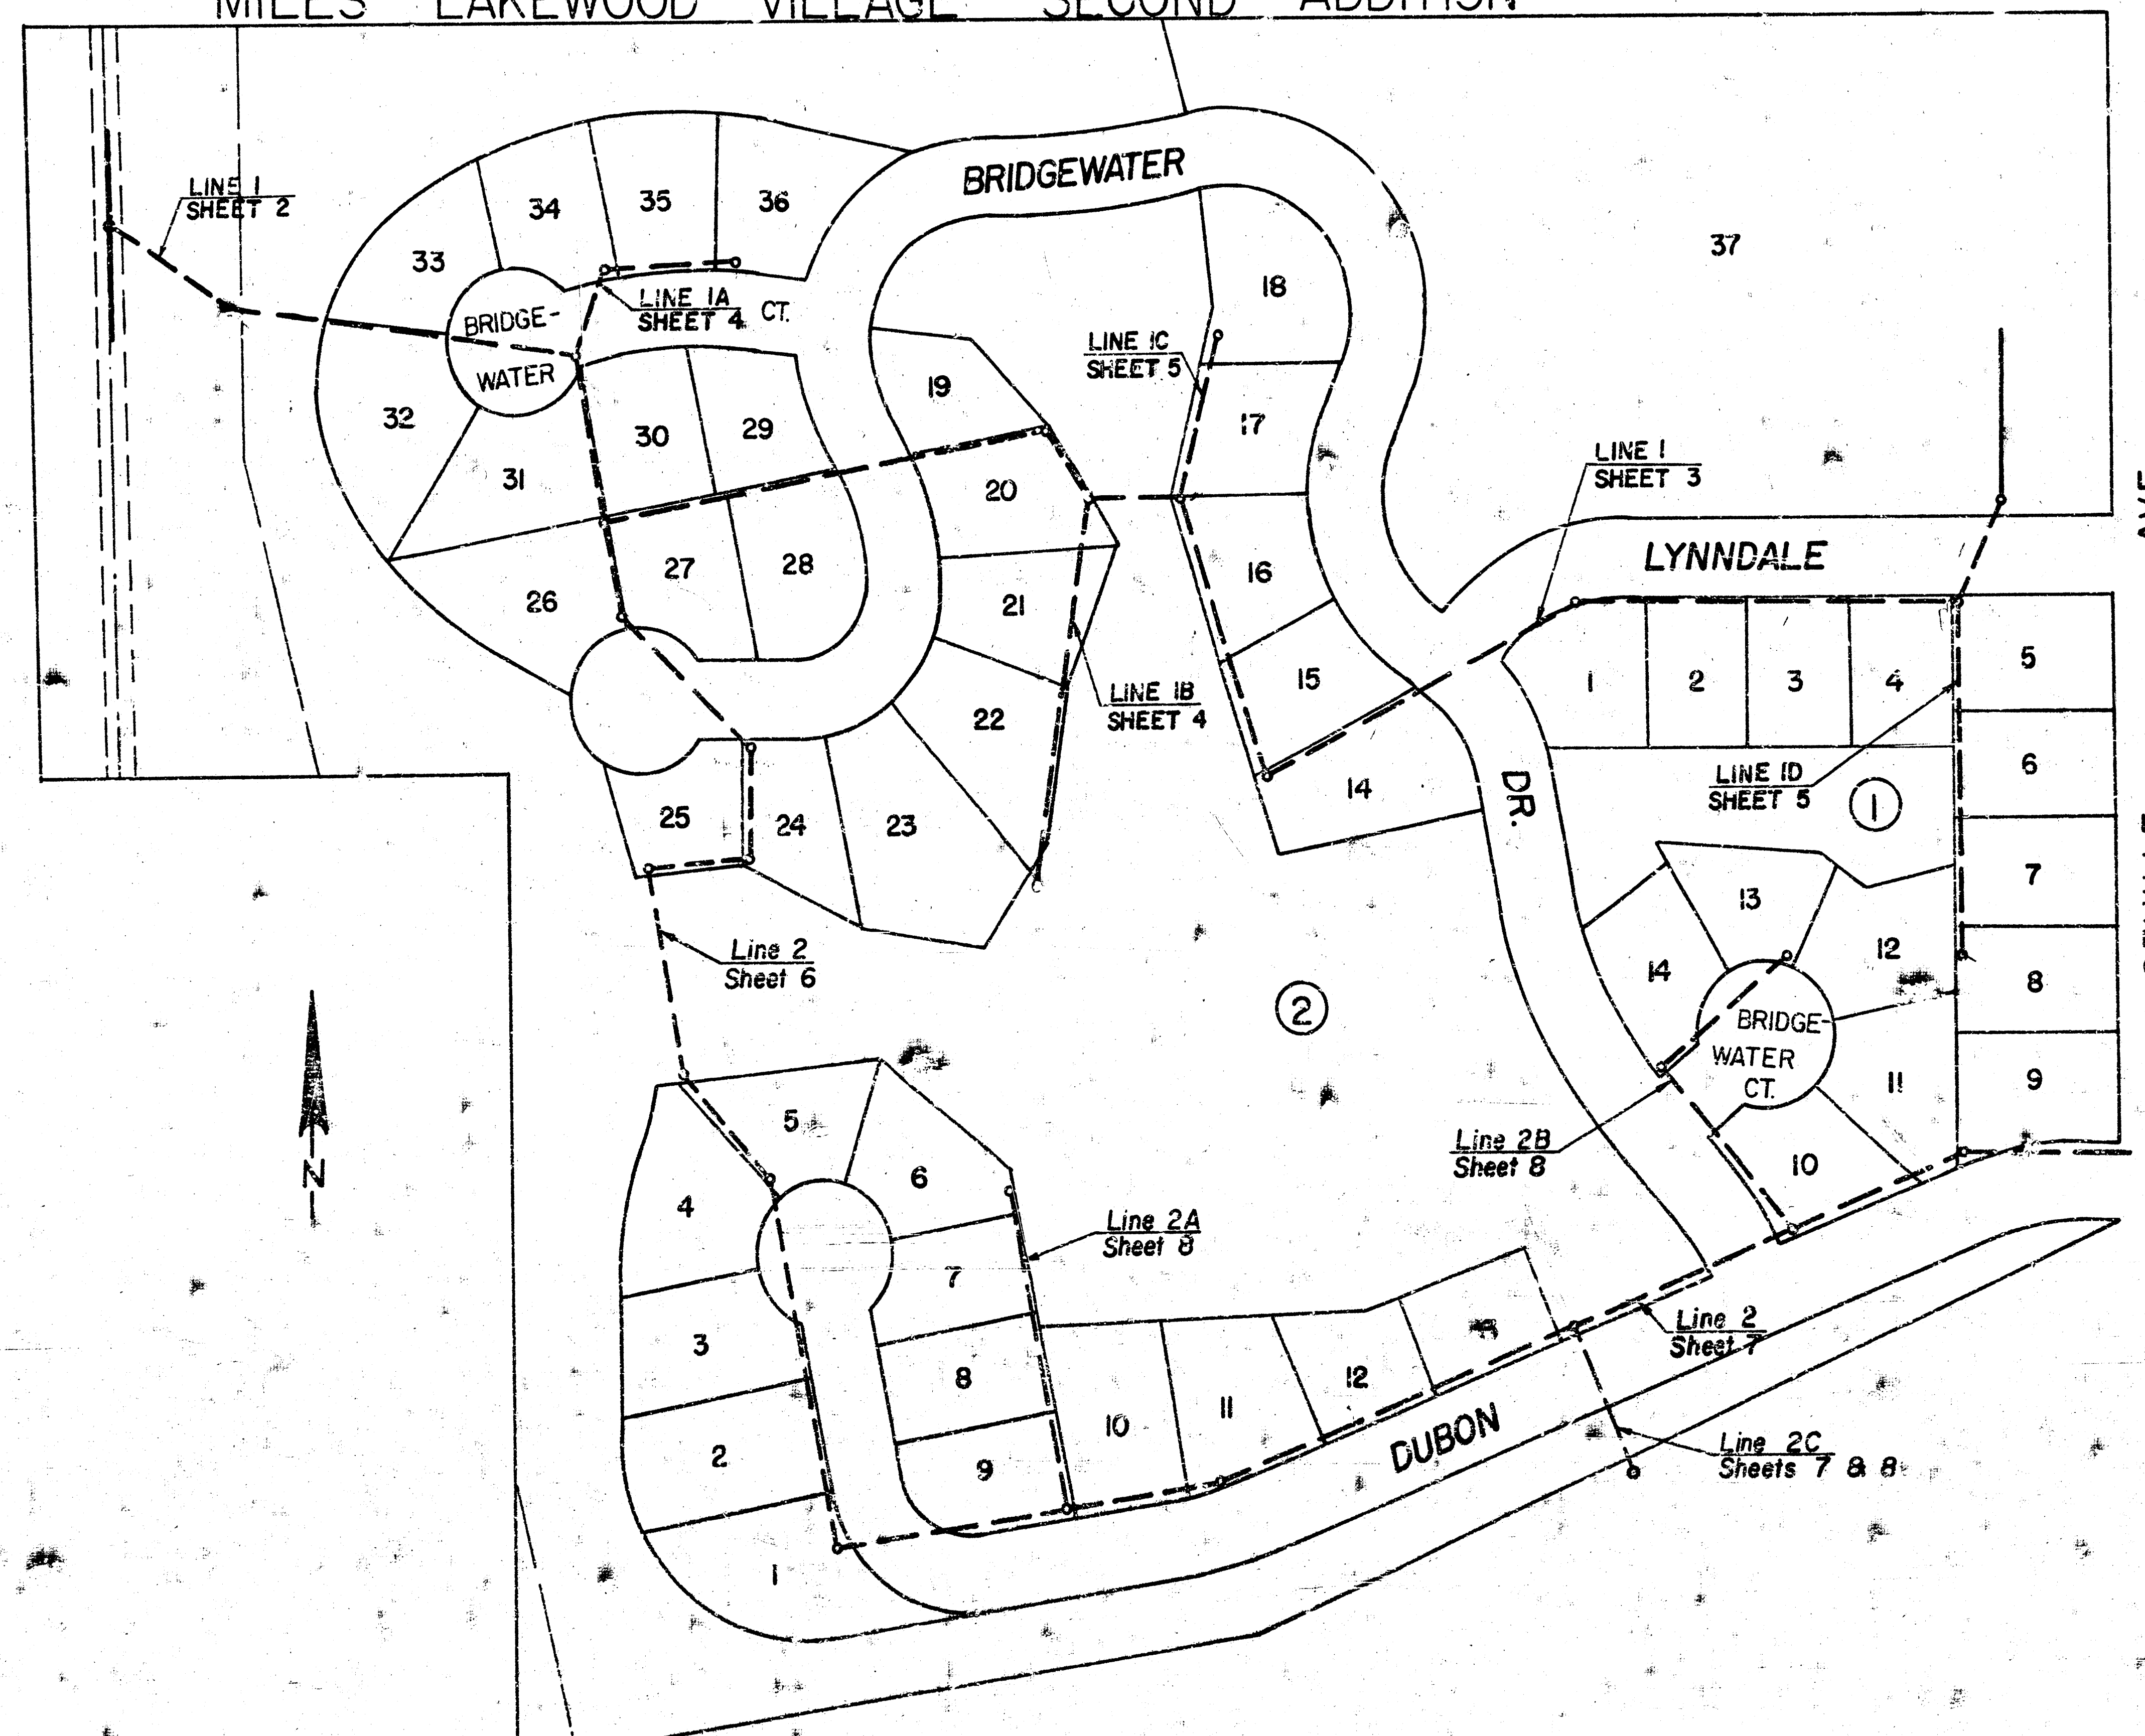


TABLE OF CONTENTS


Line 1	Sheets 2 & 3
Line 1A	Sheet 4
Line 1B	Sheet 4
Line 1C	Sheet 5
Line 1D	Sheet 5
Line 2	Sheet 6 & 7
Line 2A	Sheet 8
Line 2B	Sheet 8
Line 2C	Sheets 7 & 8
Detail Of Manhole Connection	Sheet 9



As built 3-14-78

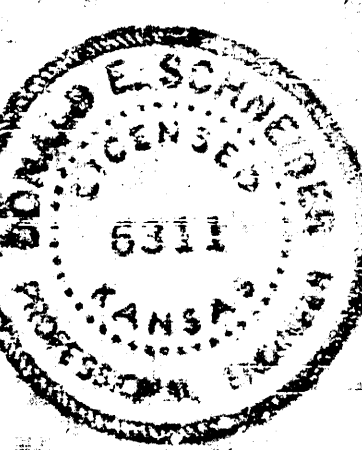

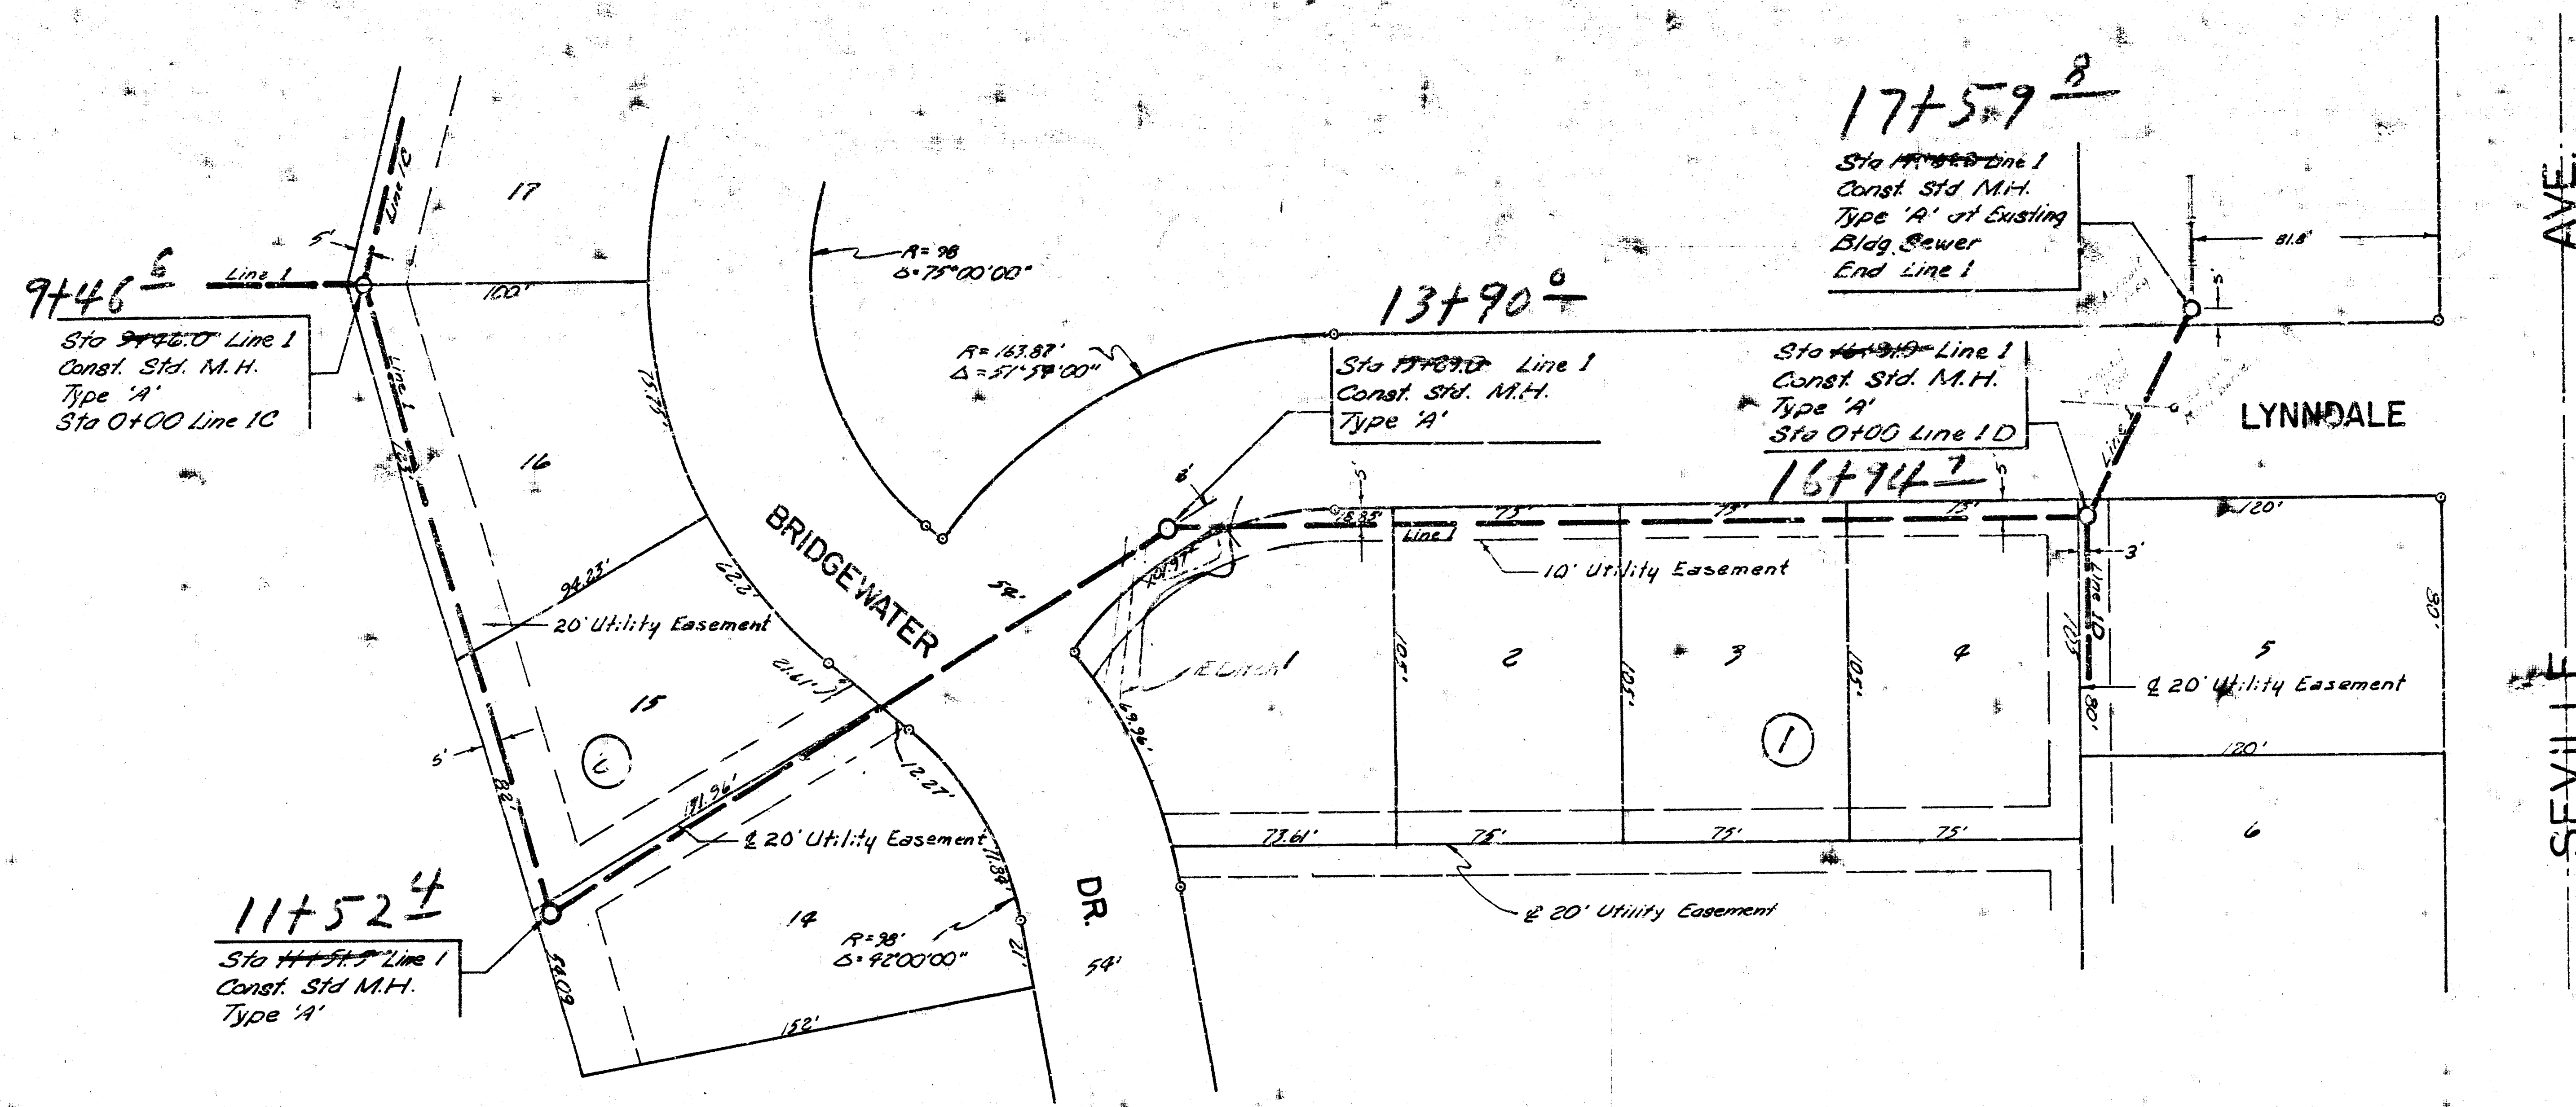


Plan Scale: 1" = 40'
 Profile Scale: 1" = 40' Horiz
 1" = 5' Vert.



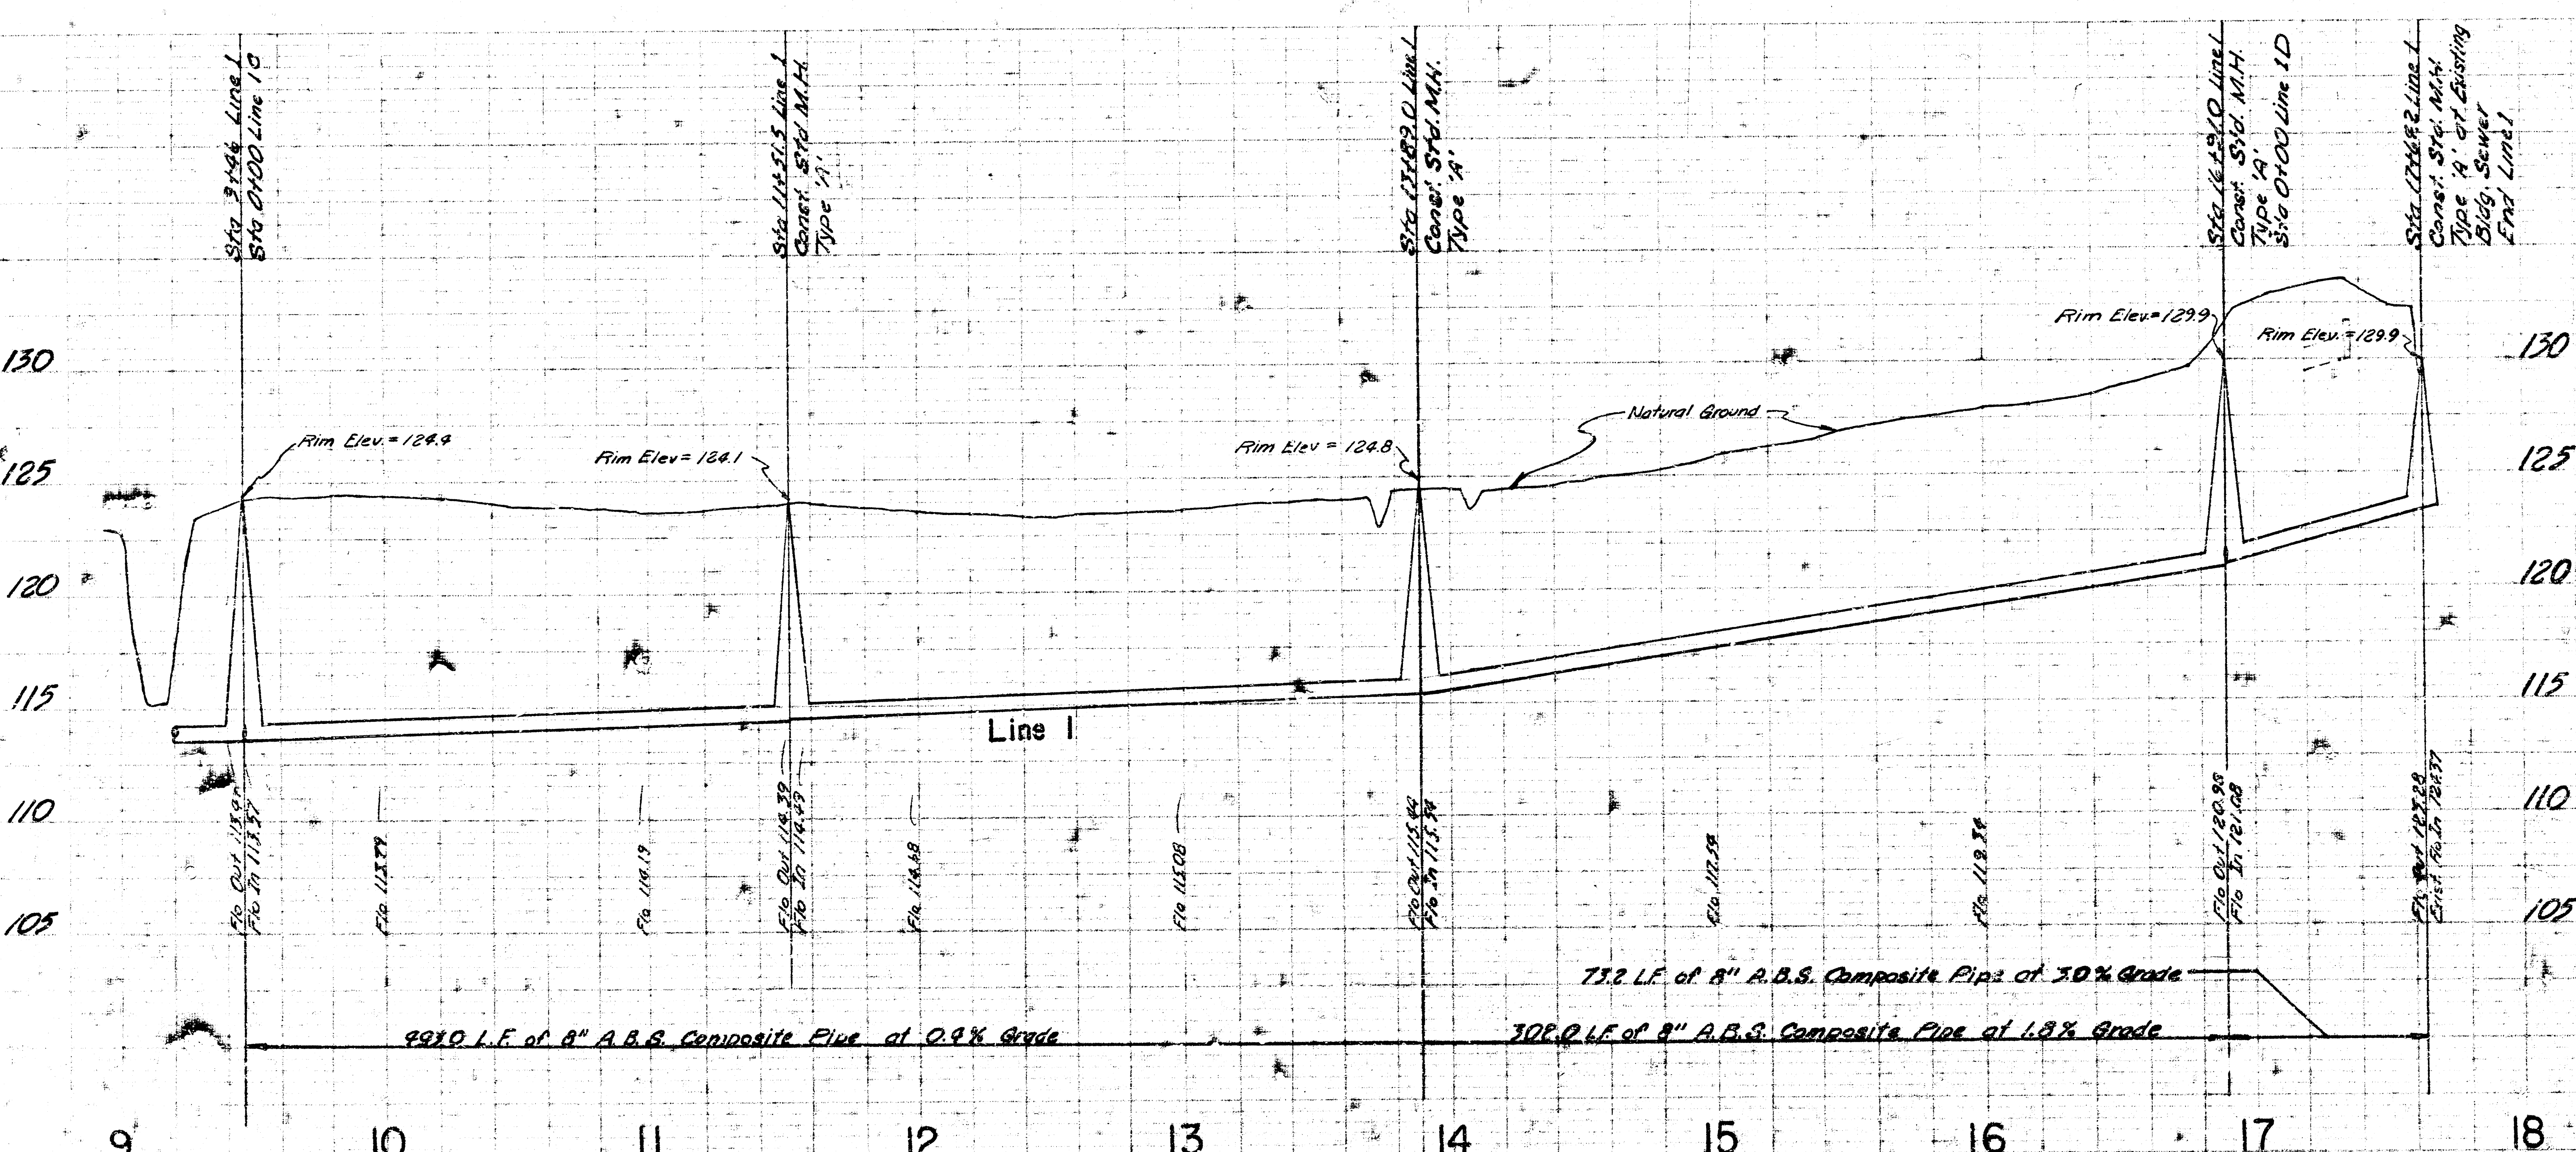


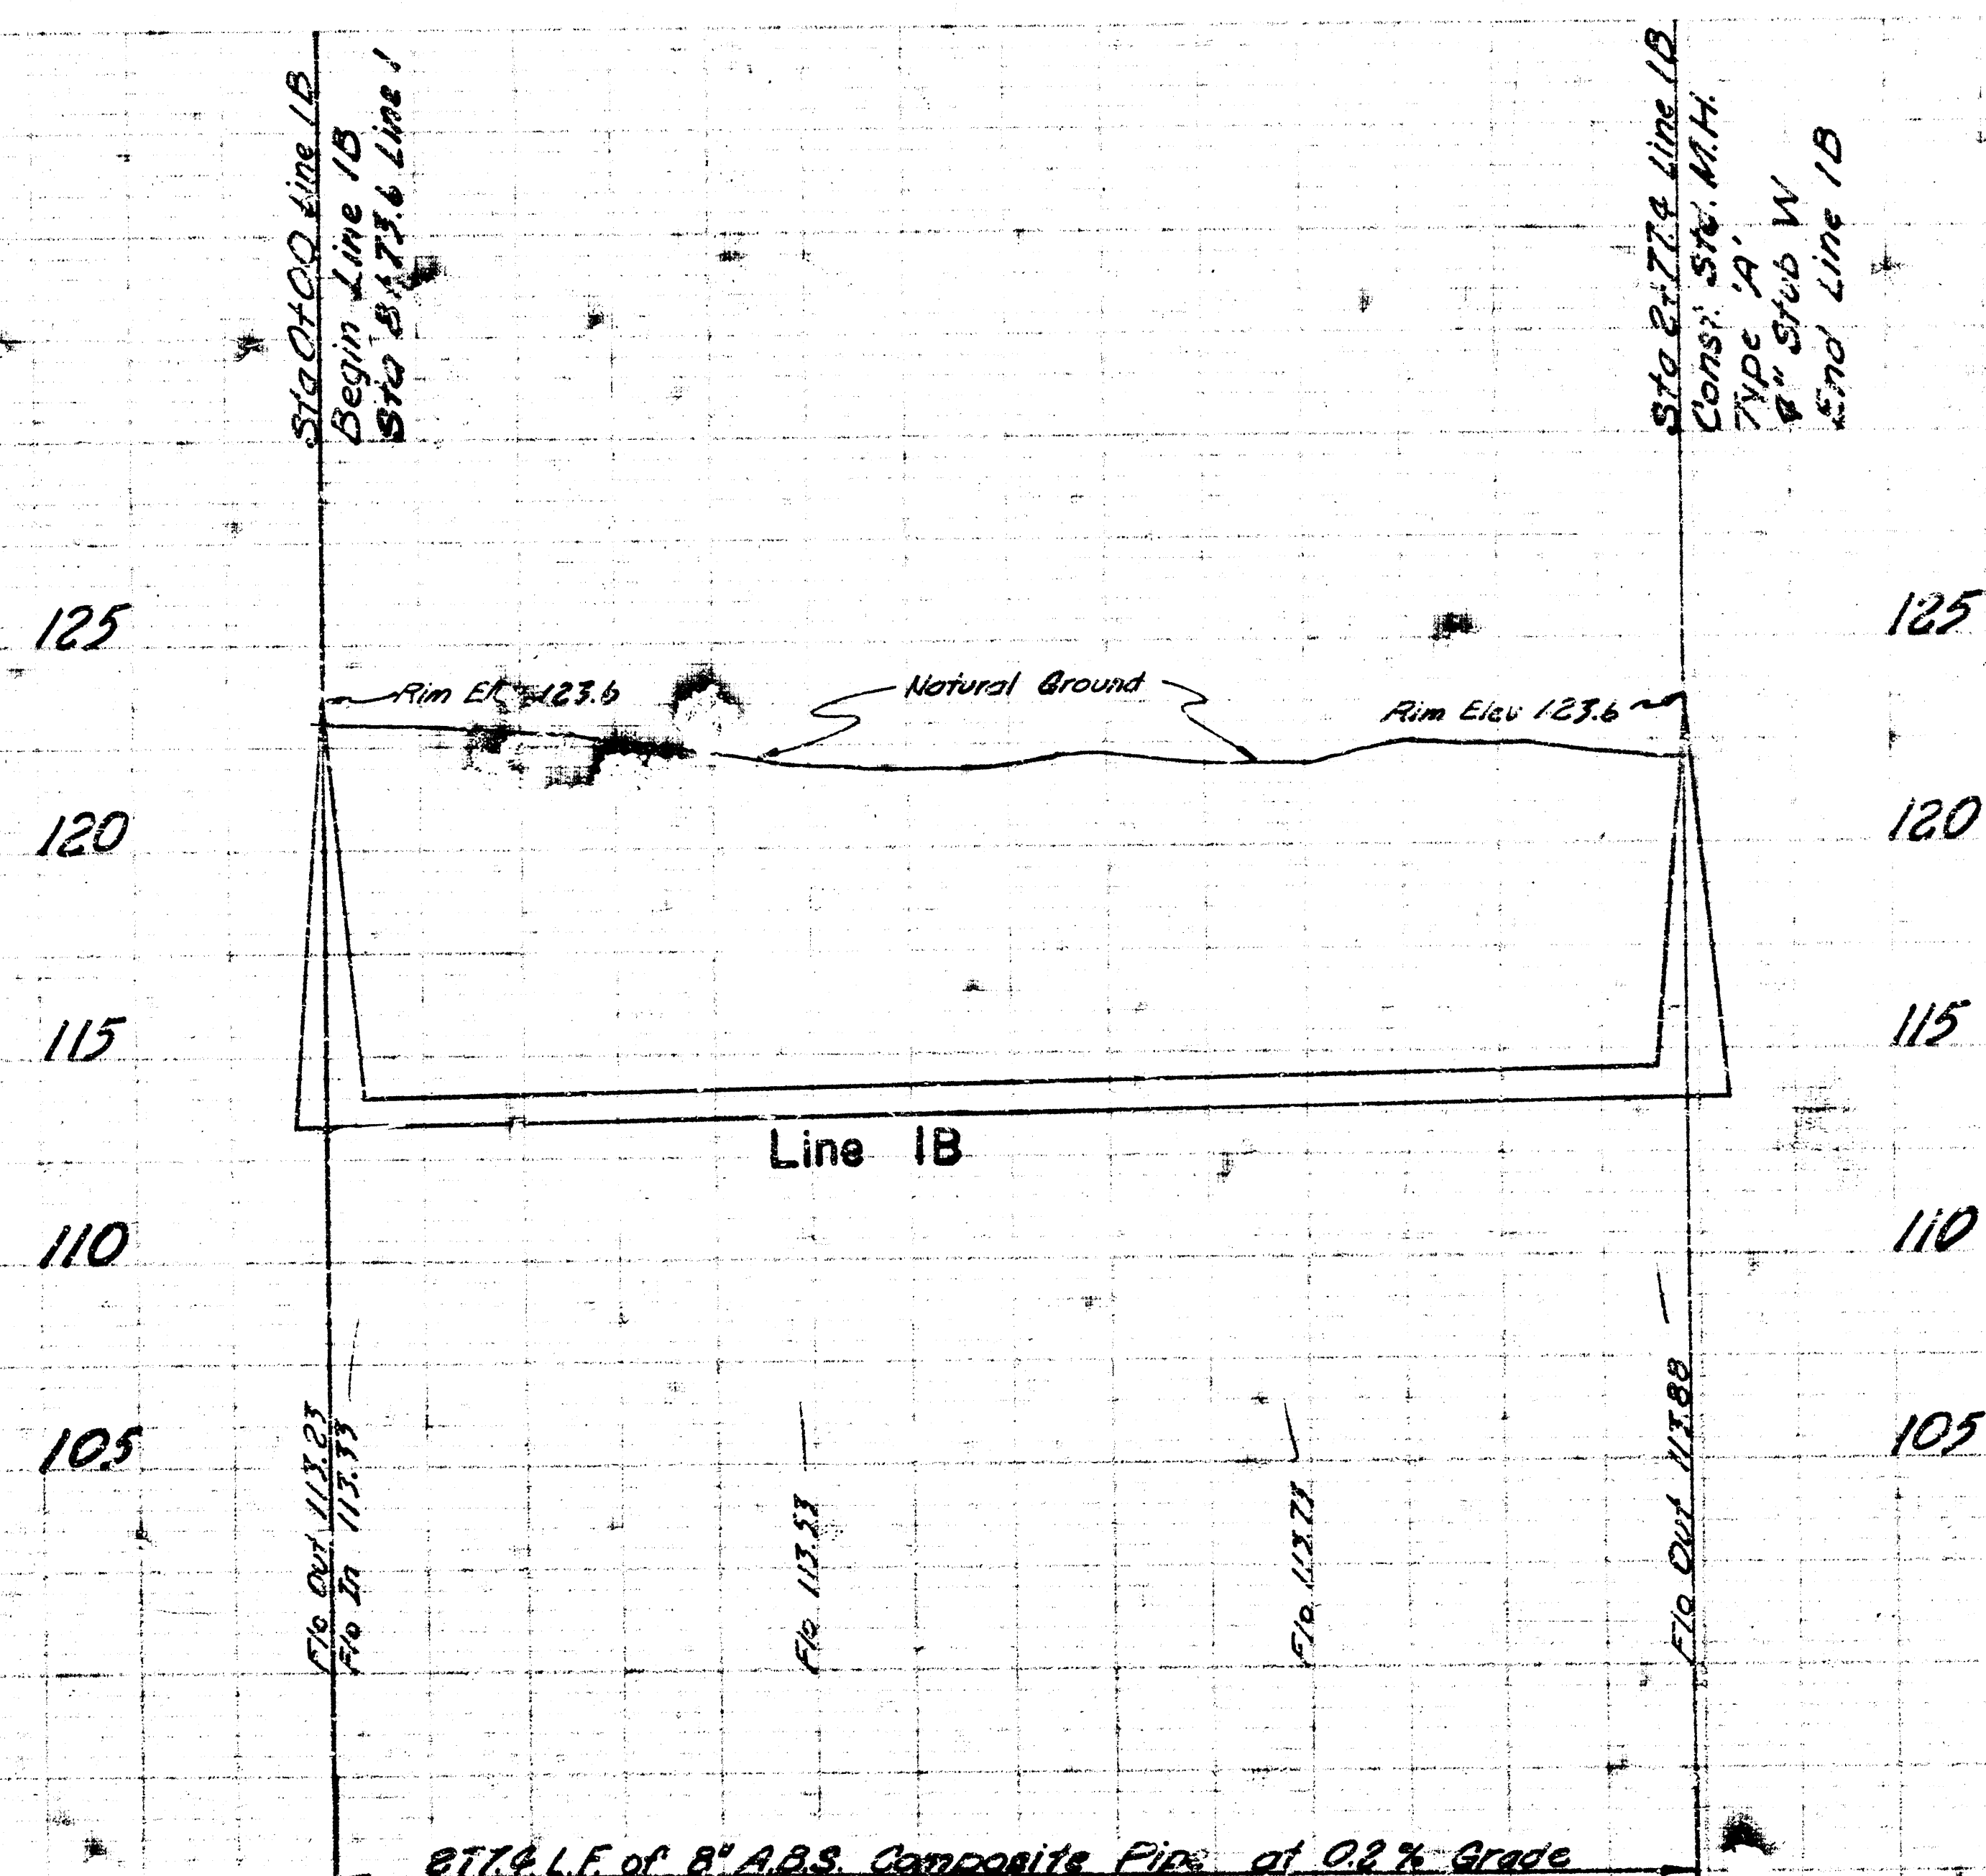
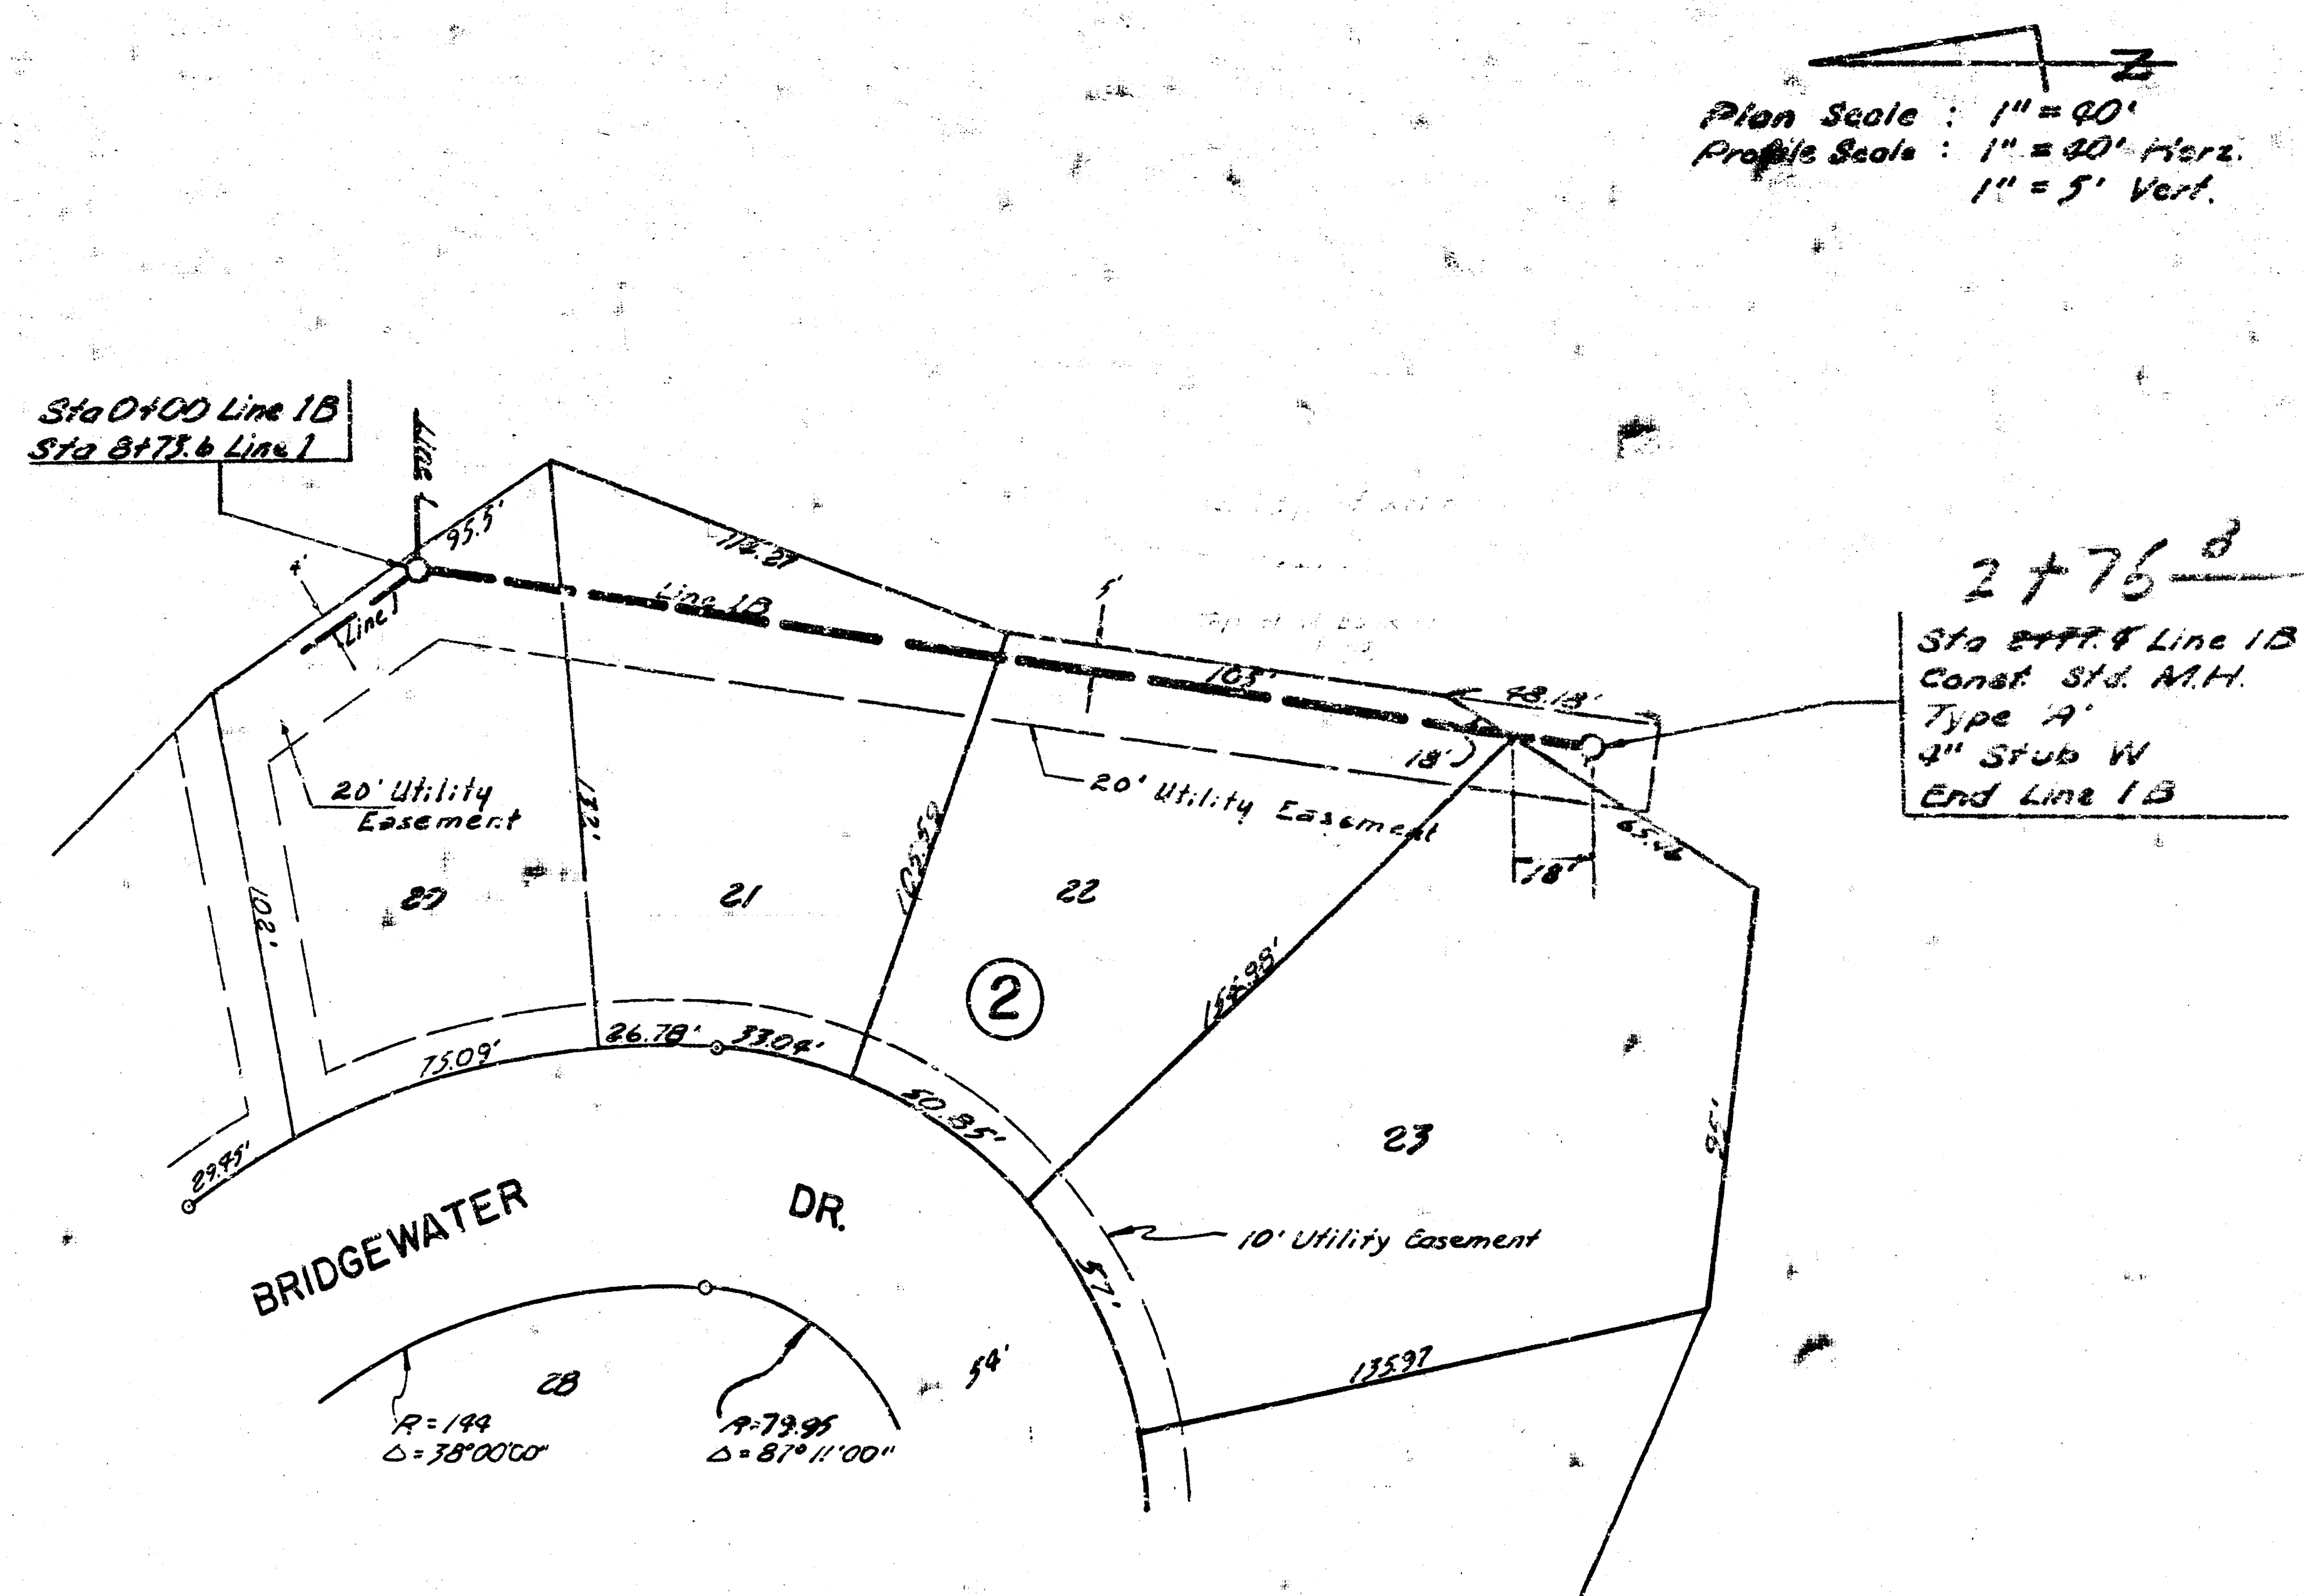



Plan Scale : 1" = 40'
 Profile Scale : 1" = 40' Horiz.
 1" = 5' Vert.

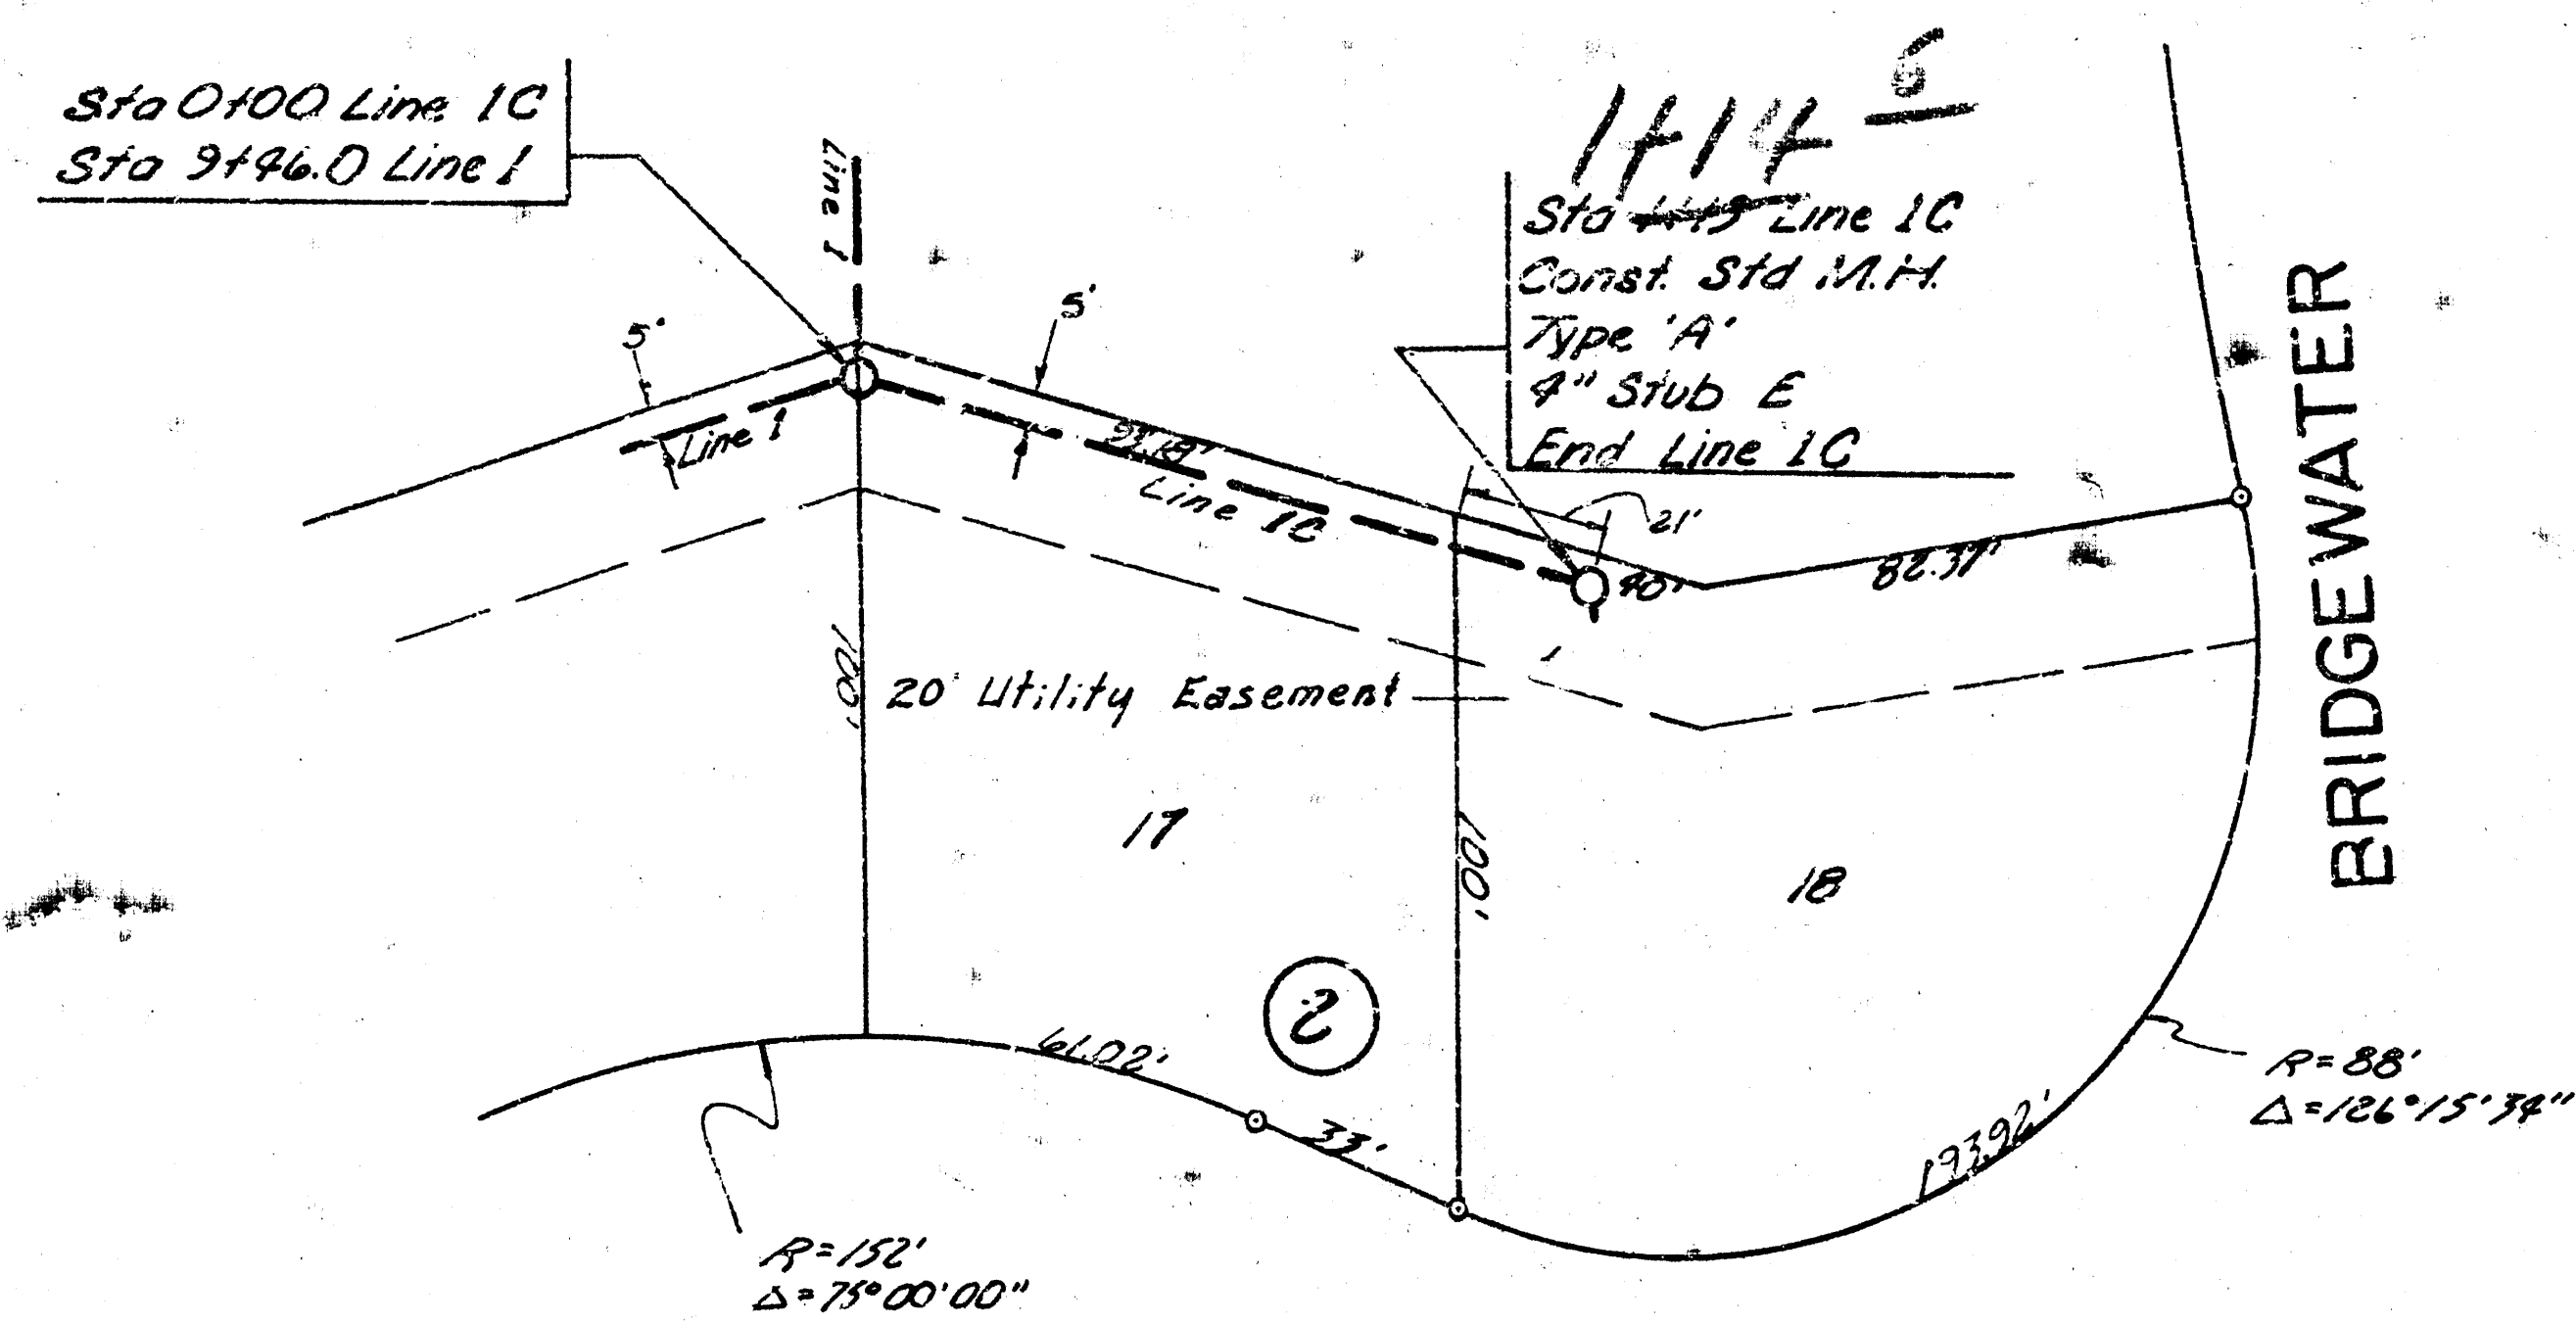





Plan Scale : 1" = 40'
 Profile Scale : 1" = 40' Horiz.
 1" = 5' Vert.

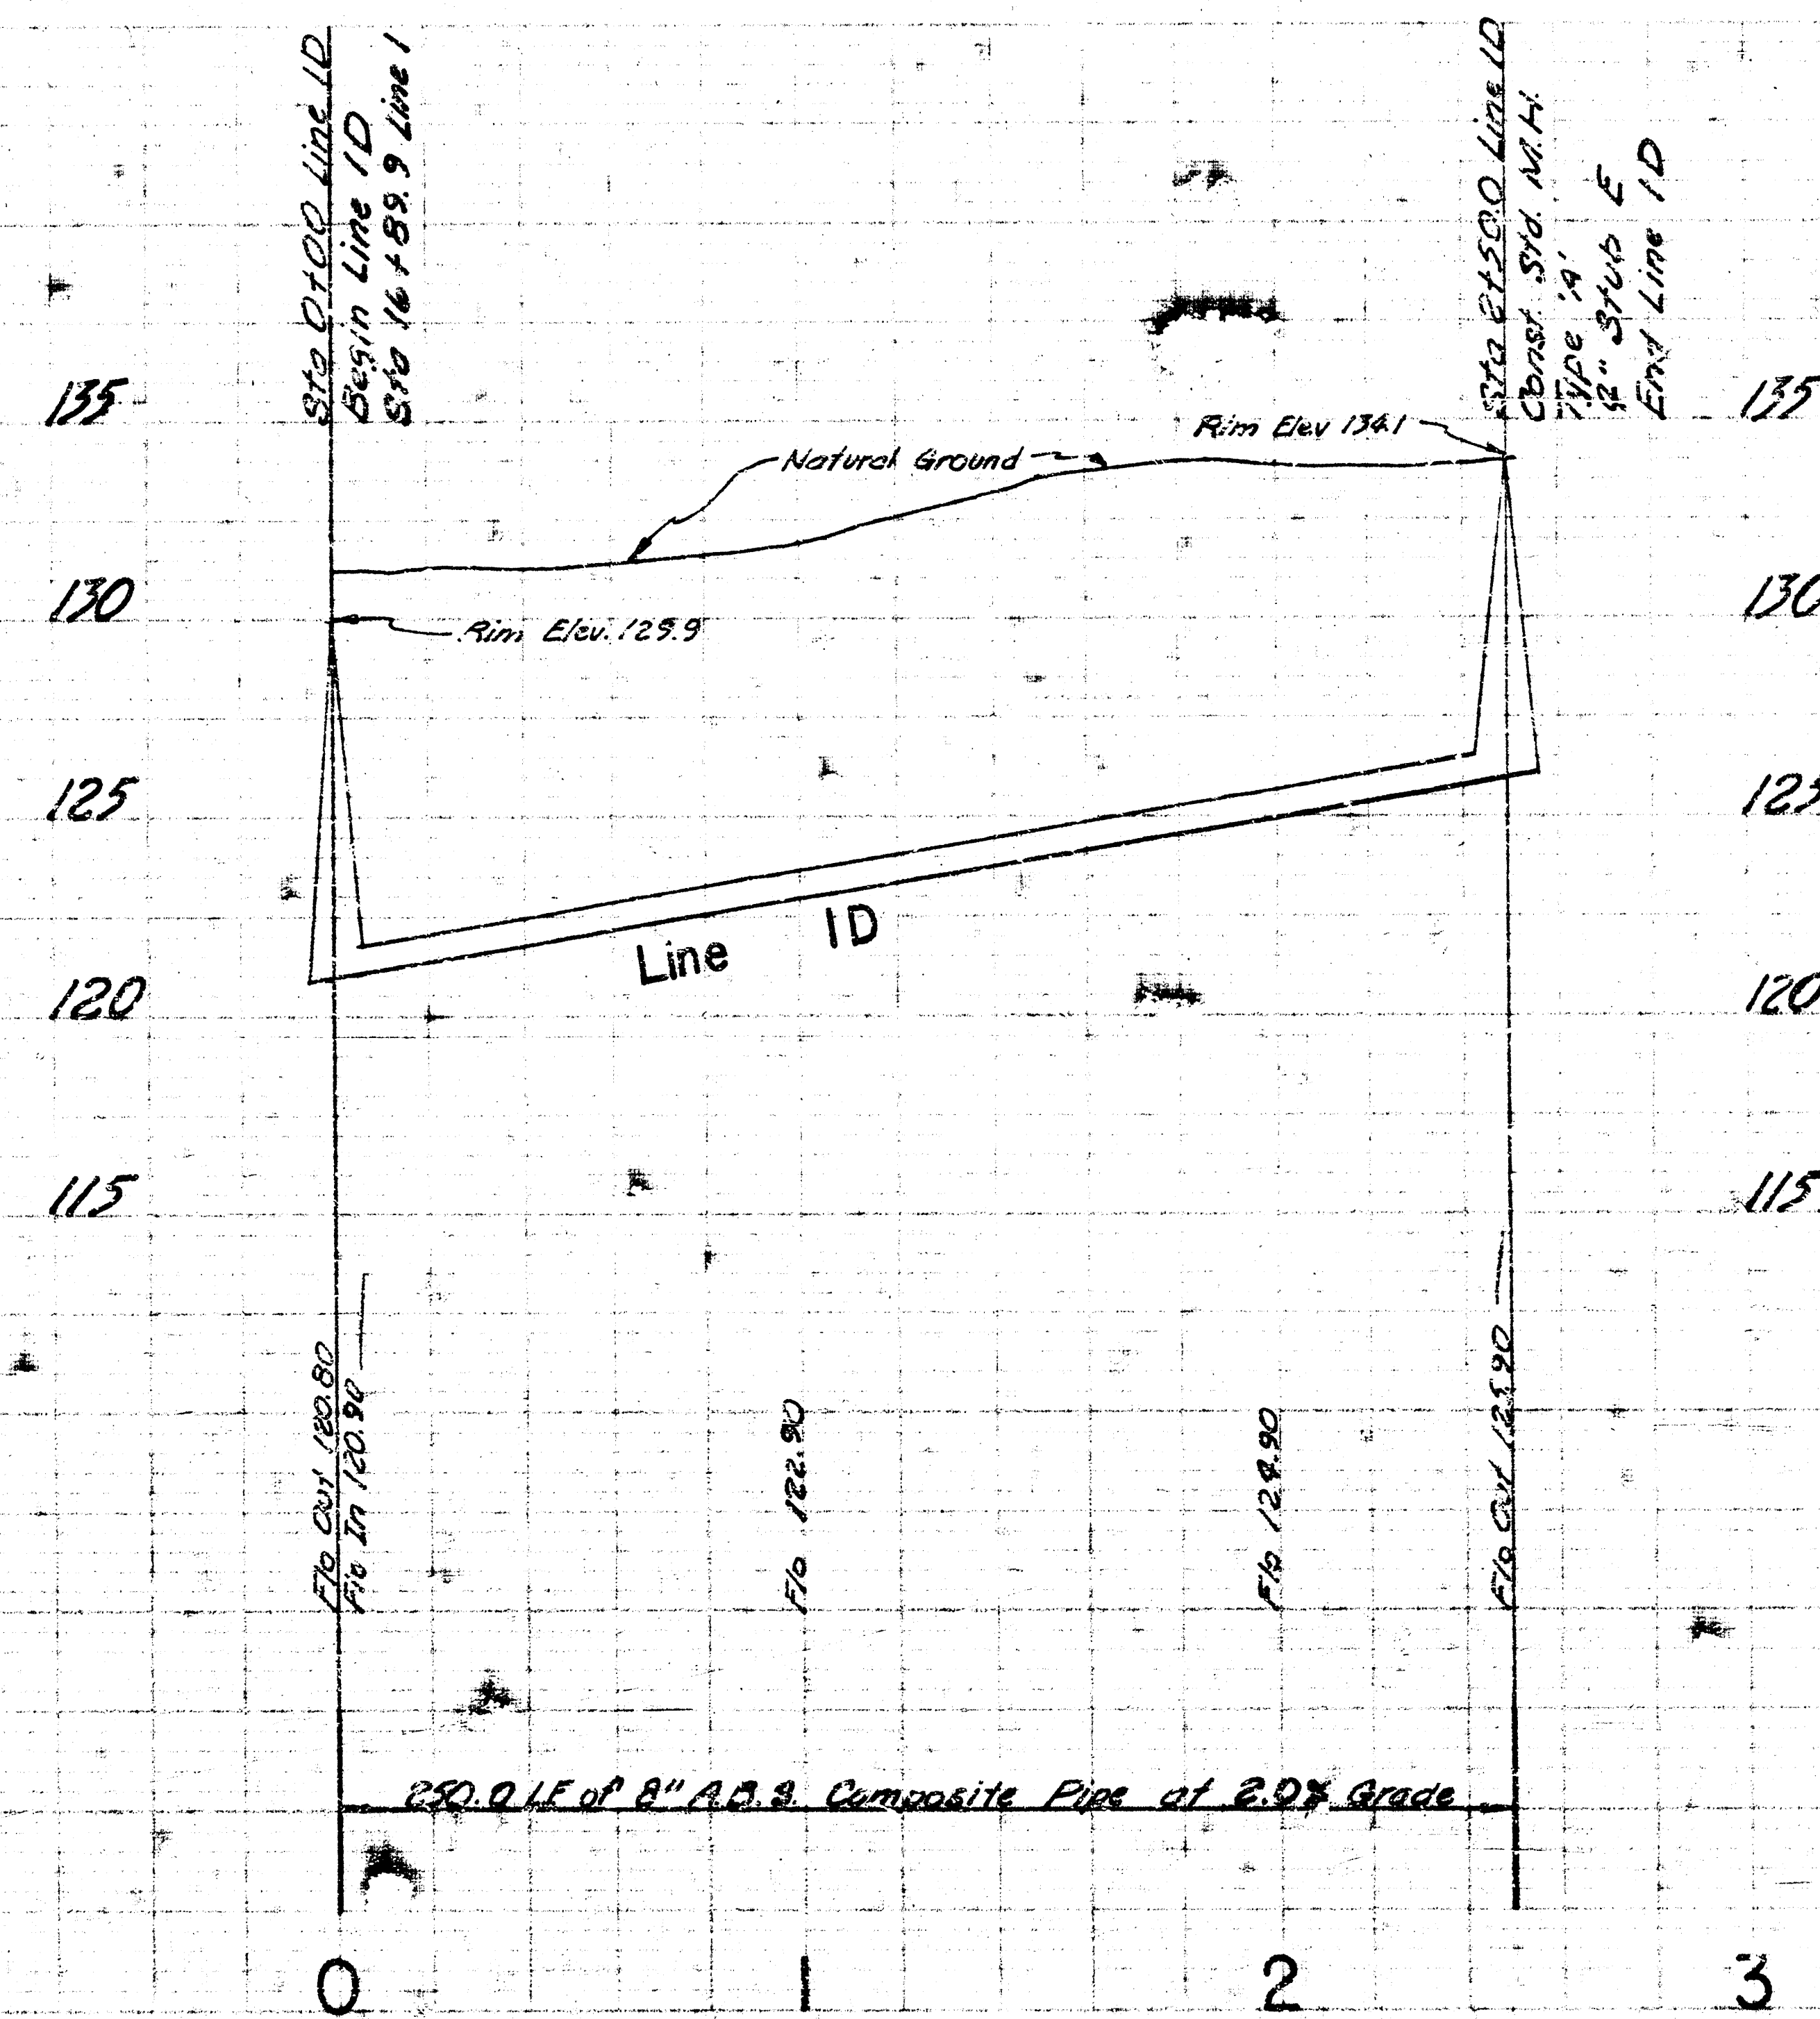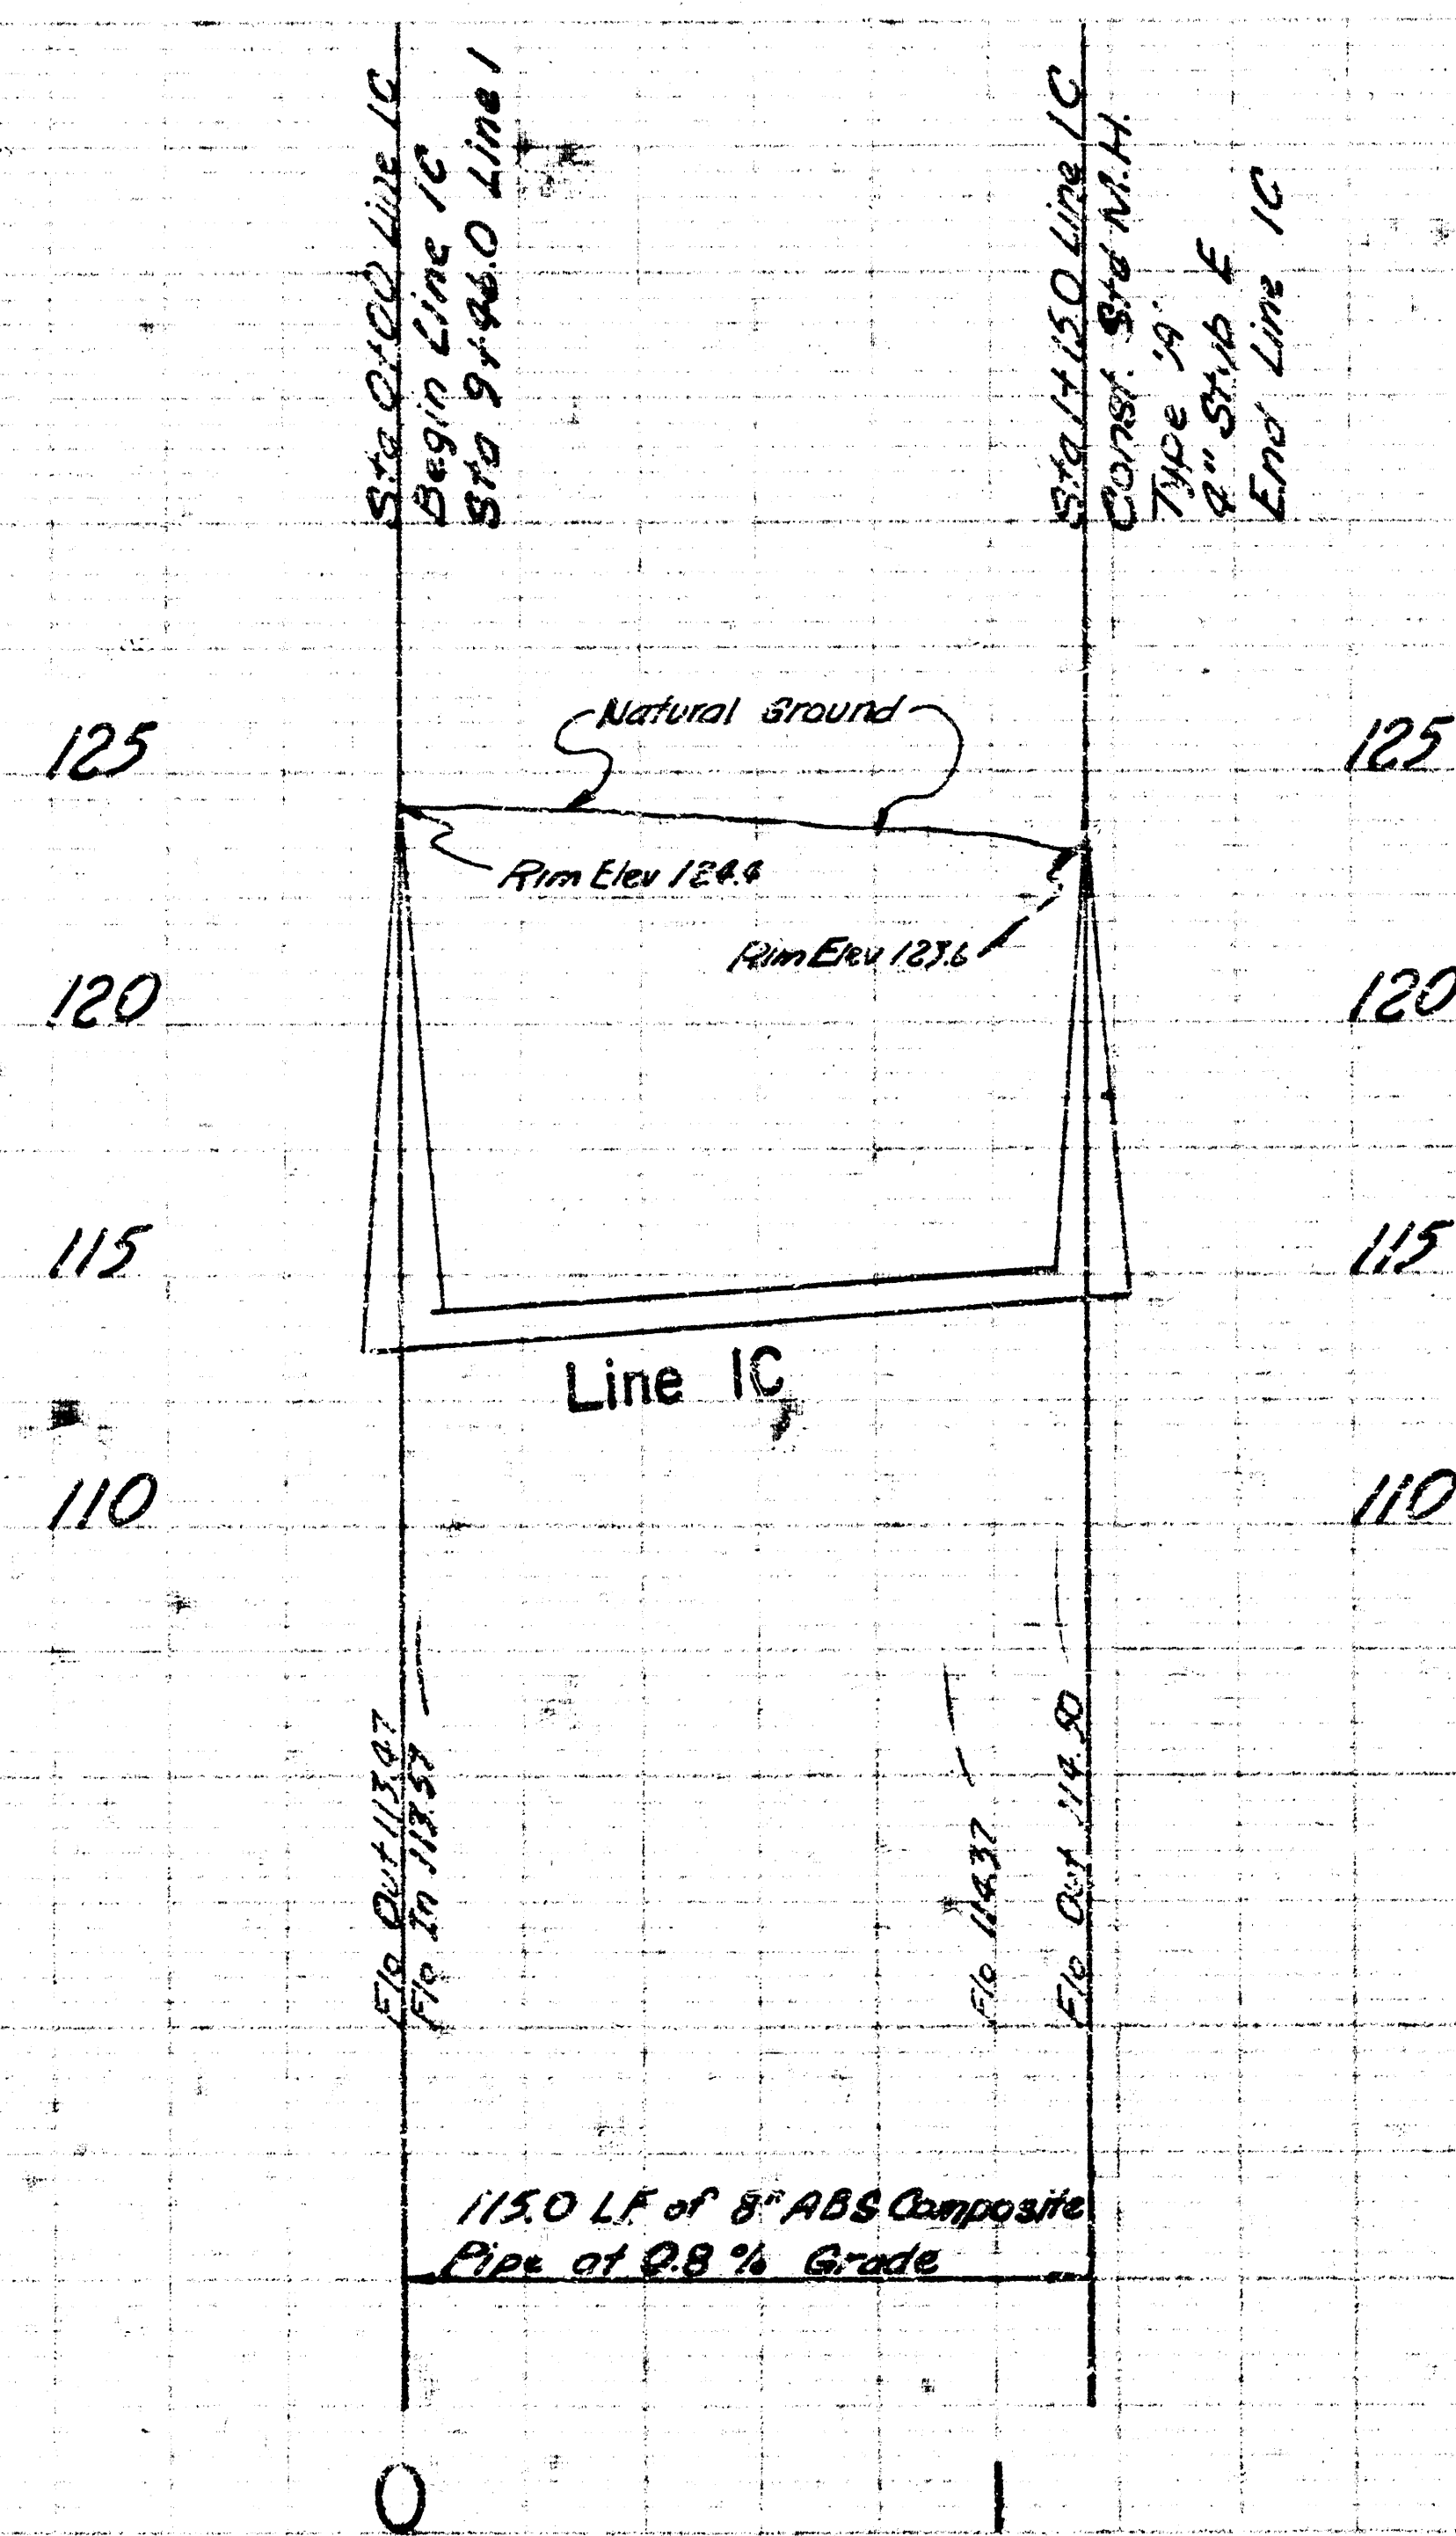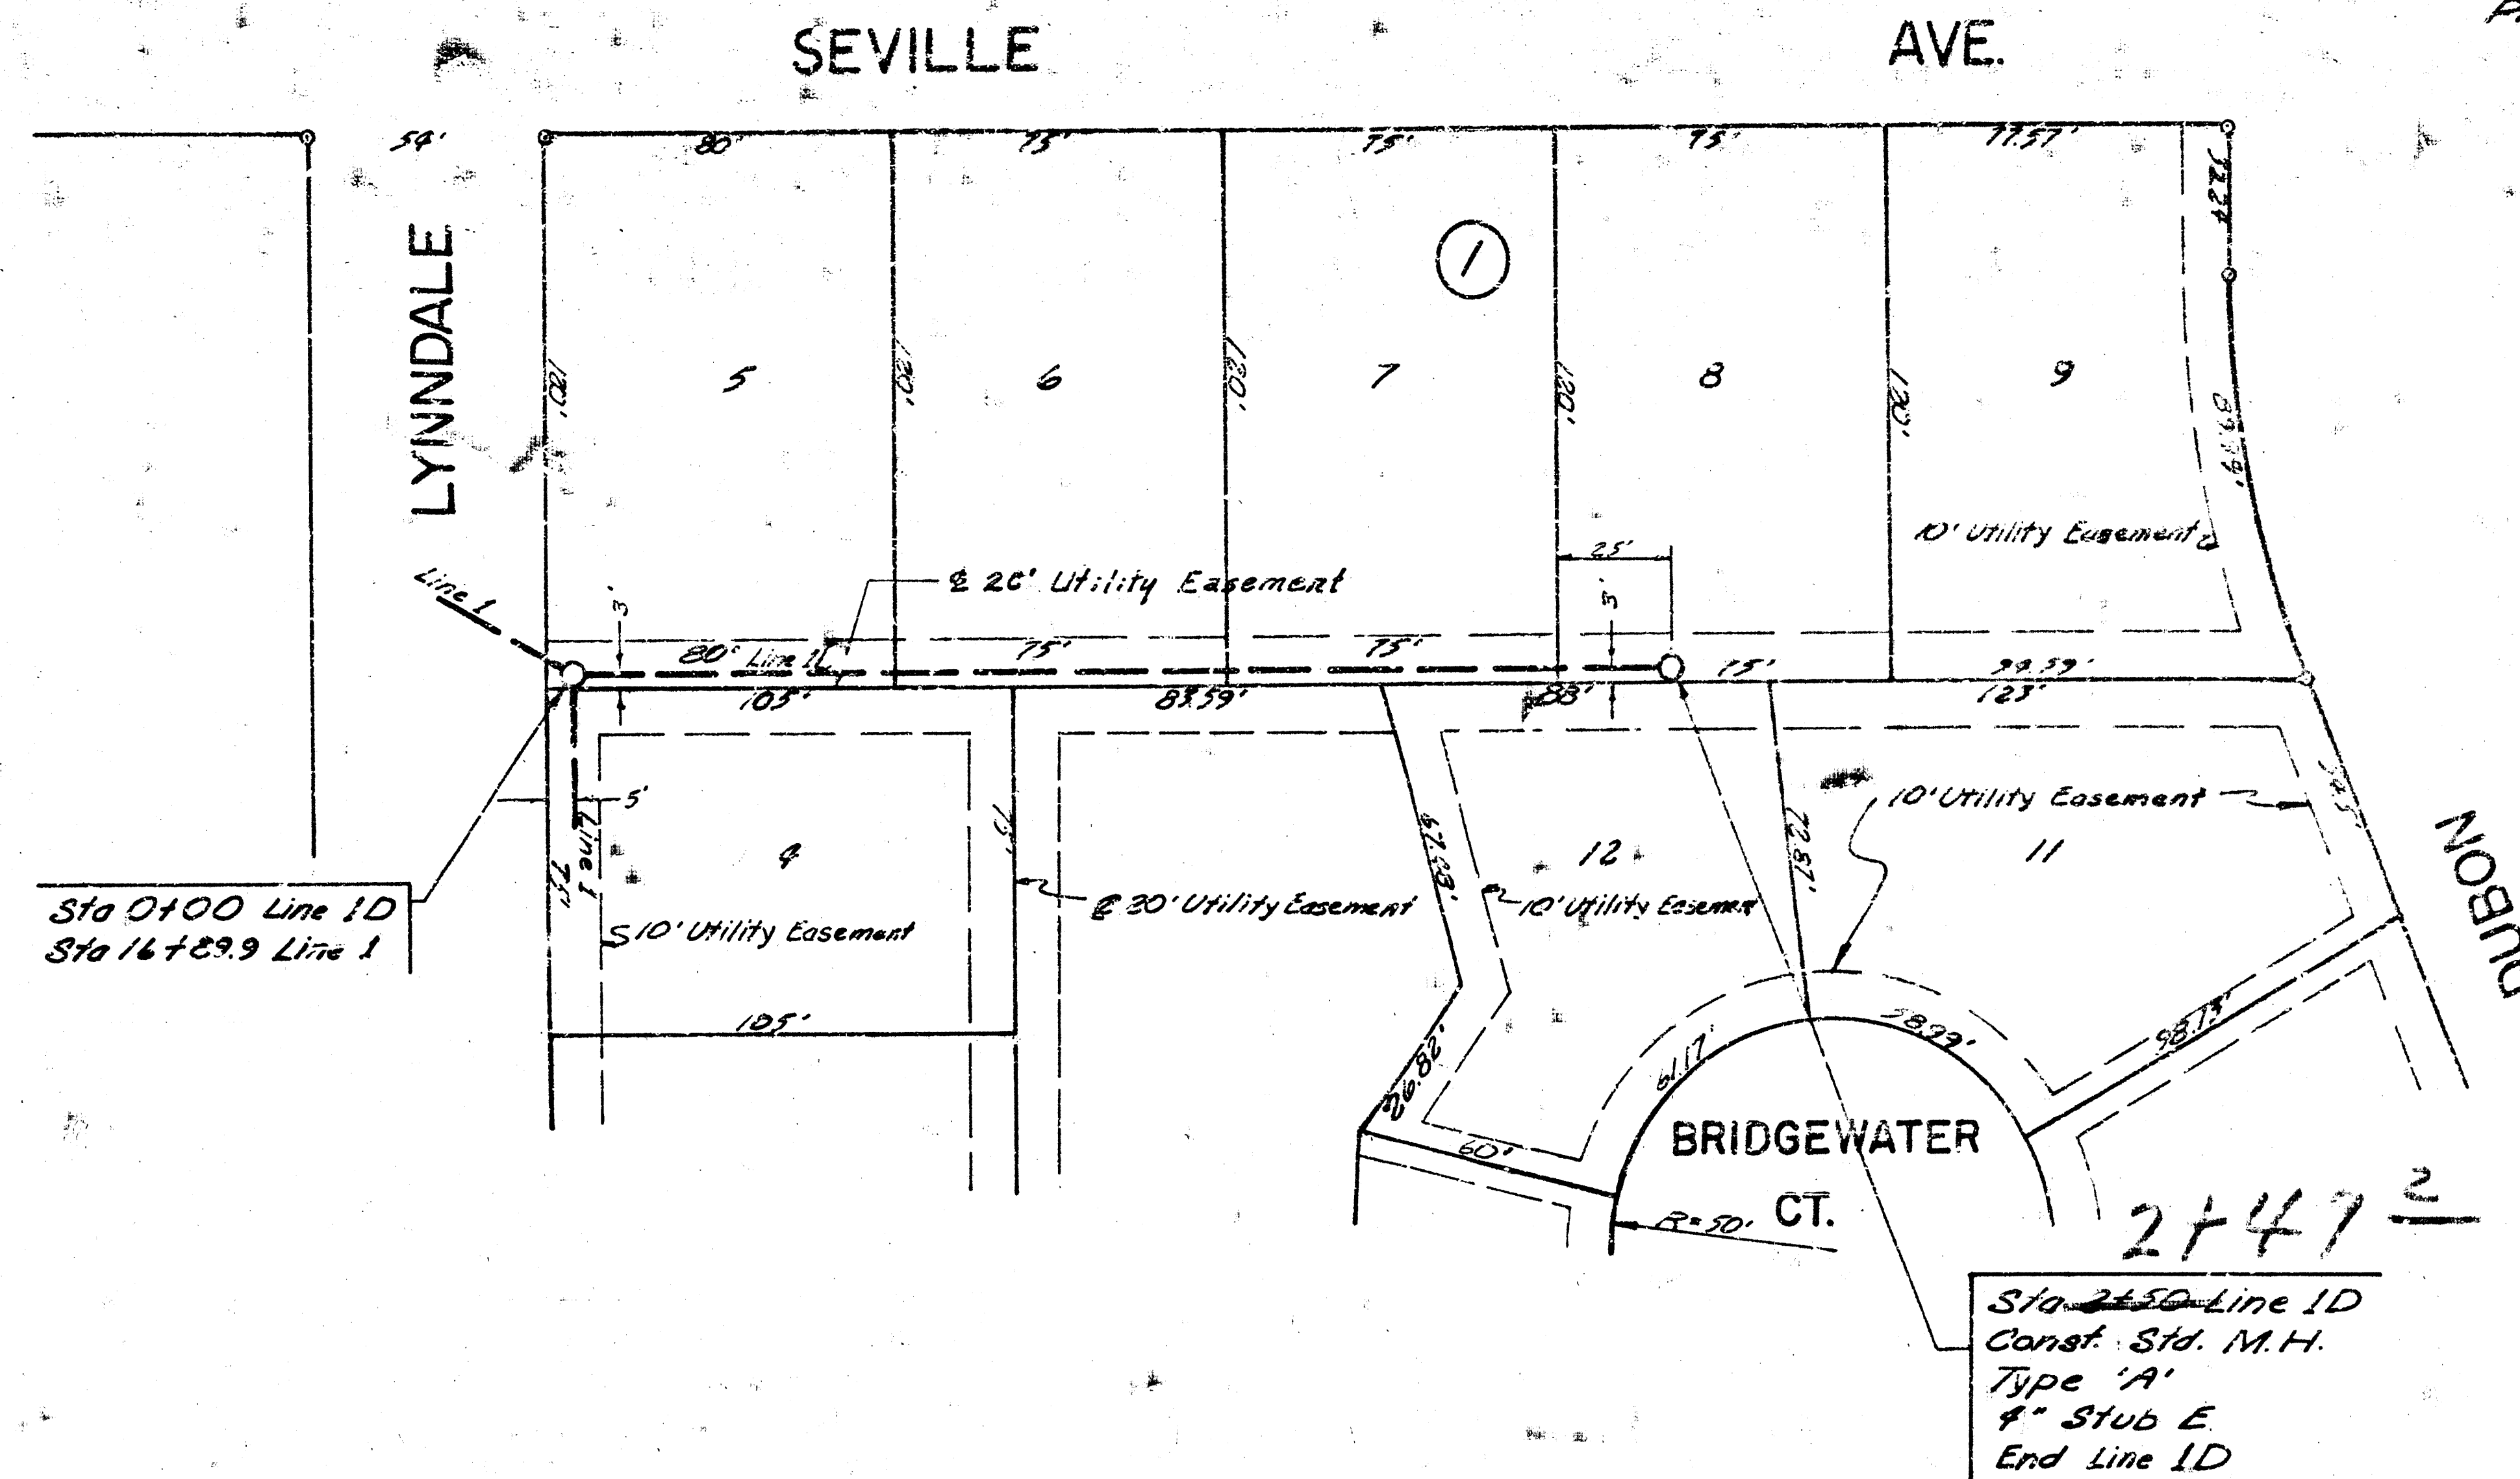

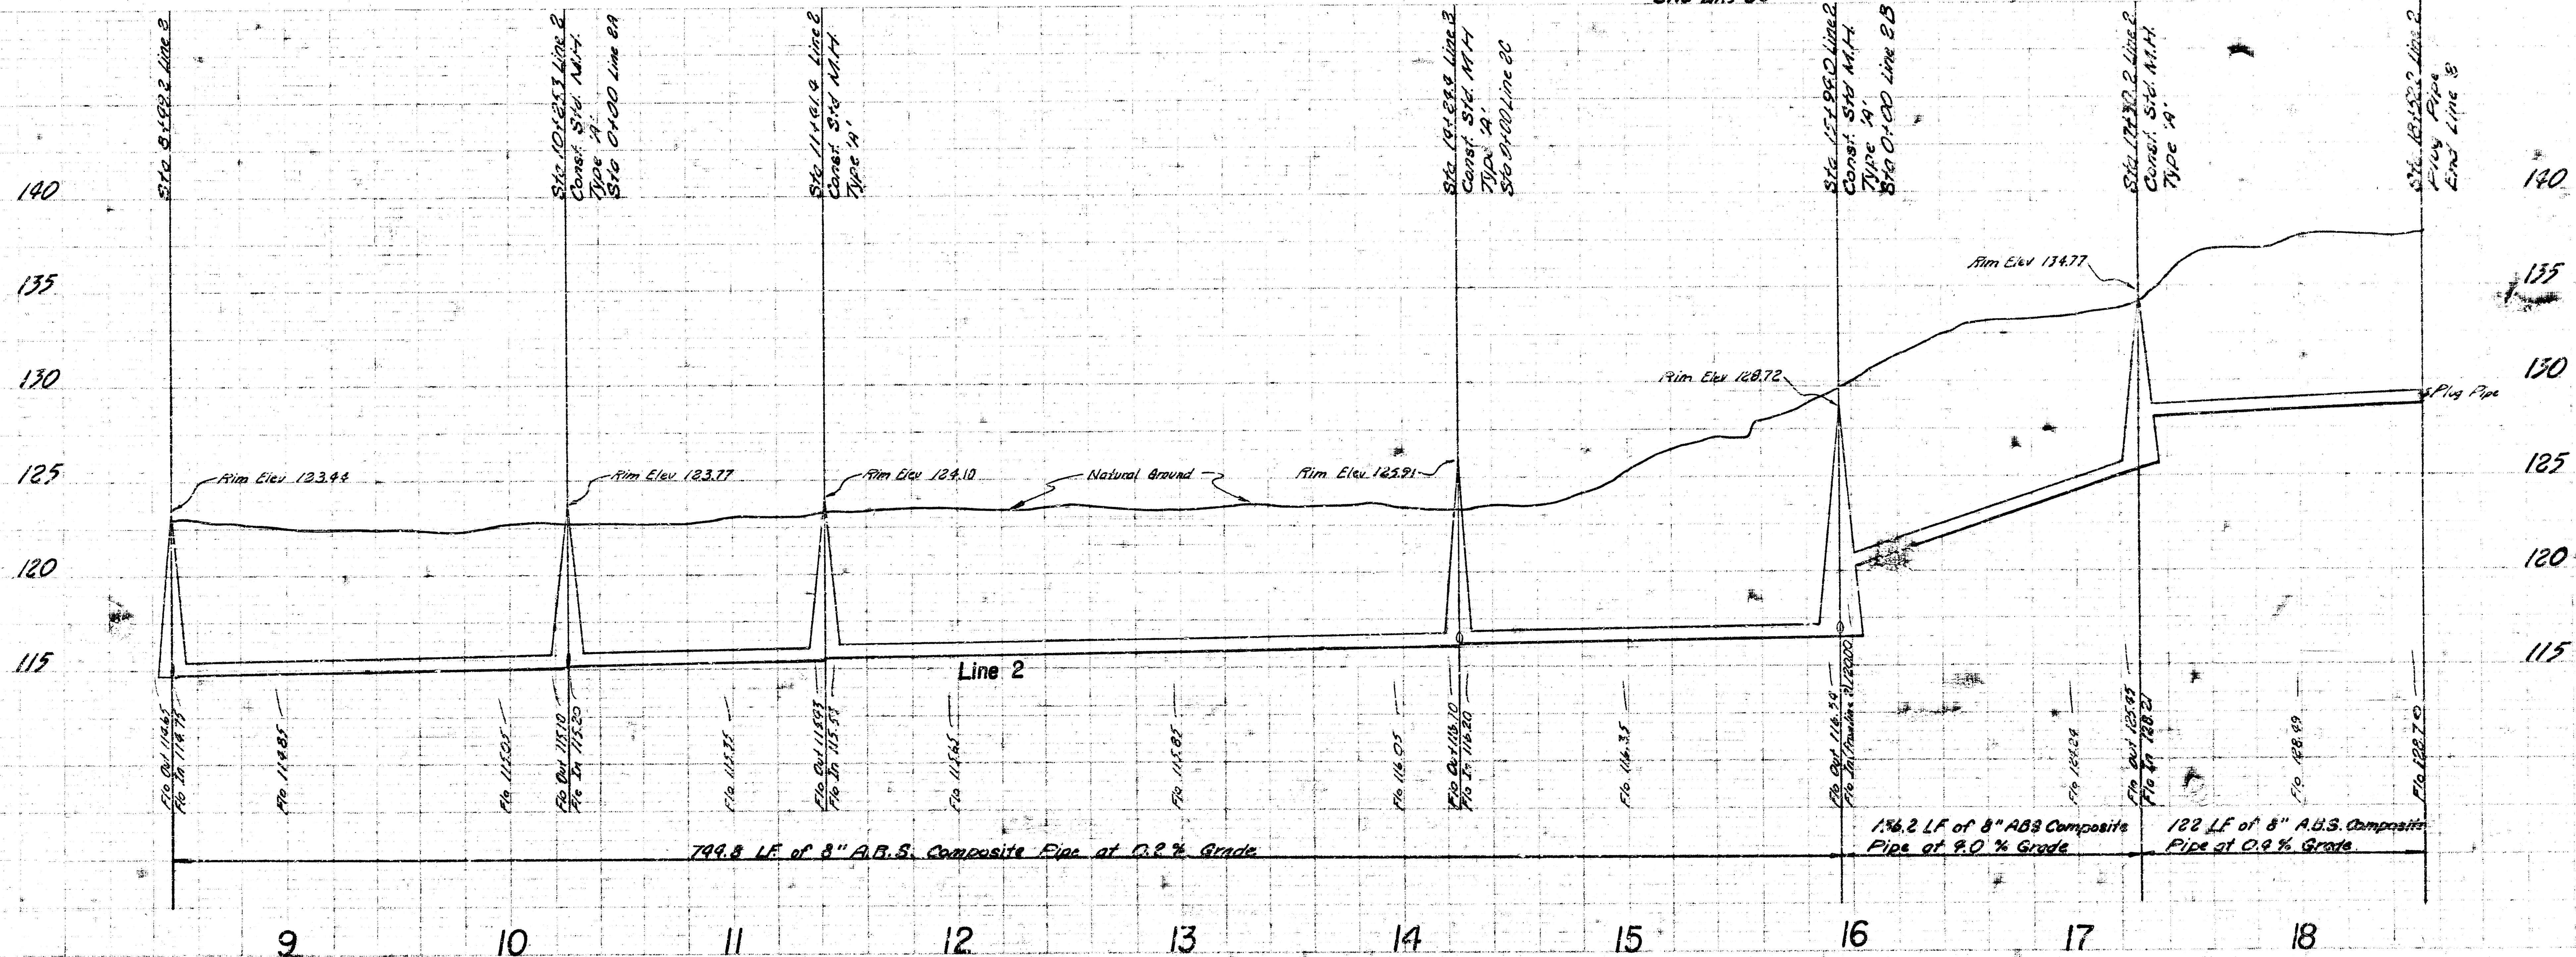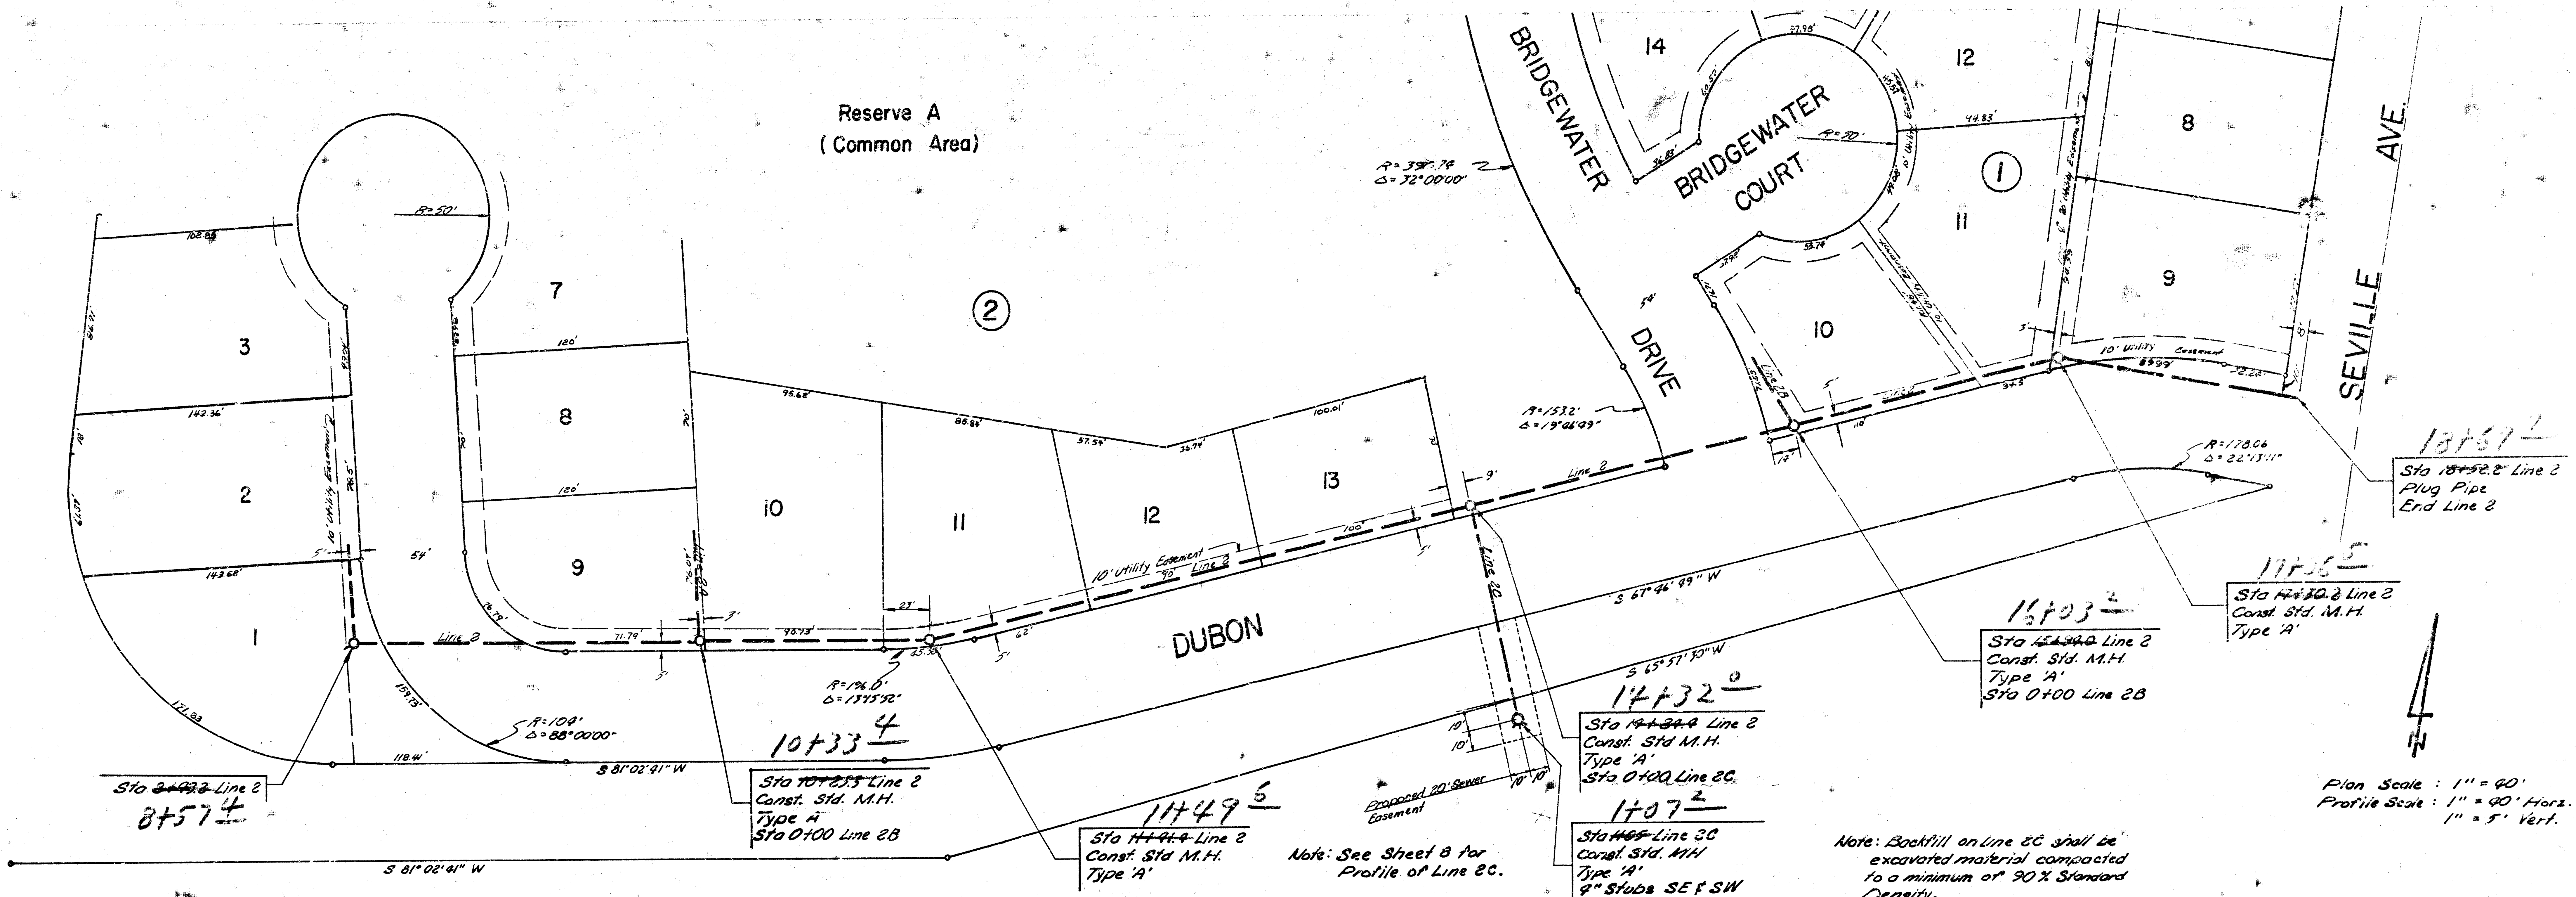


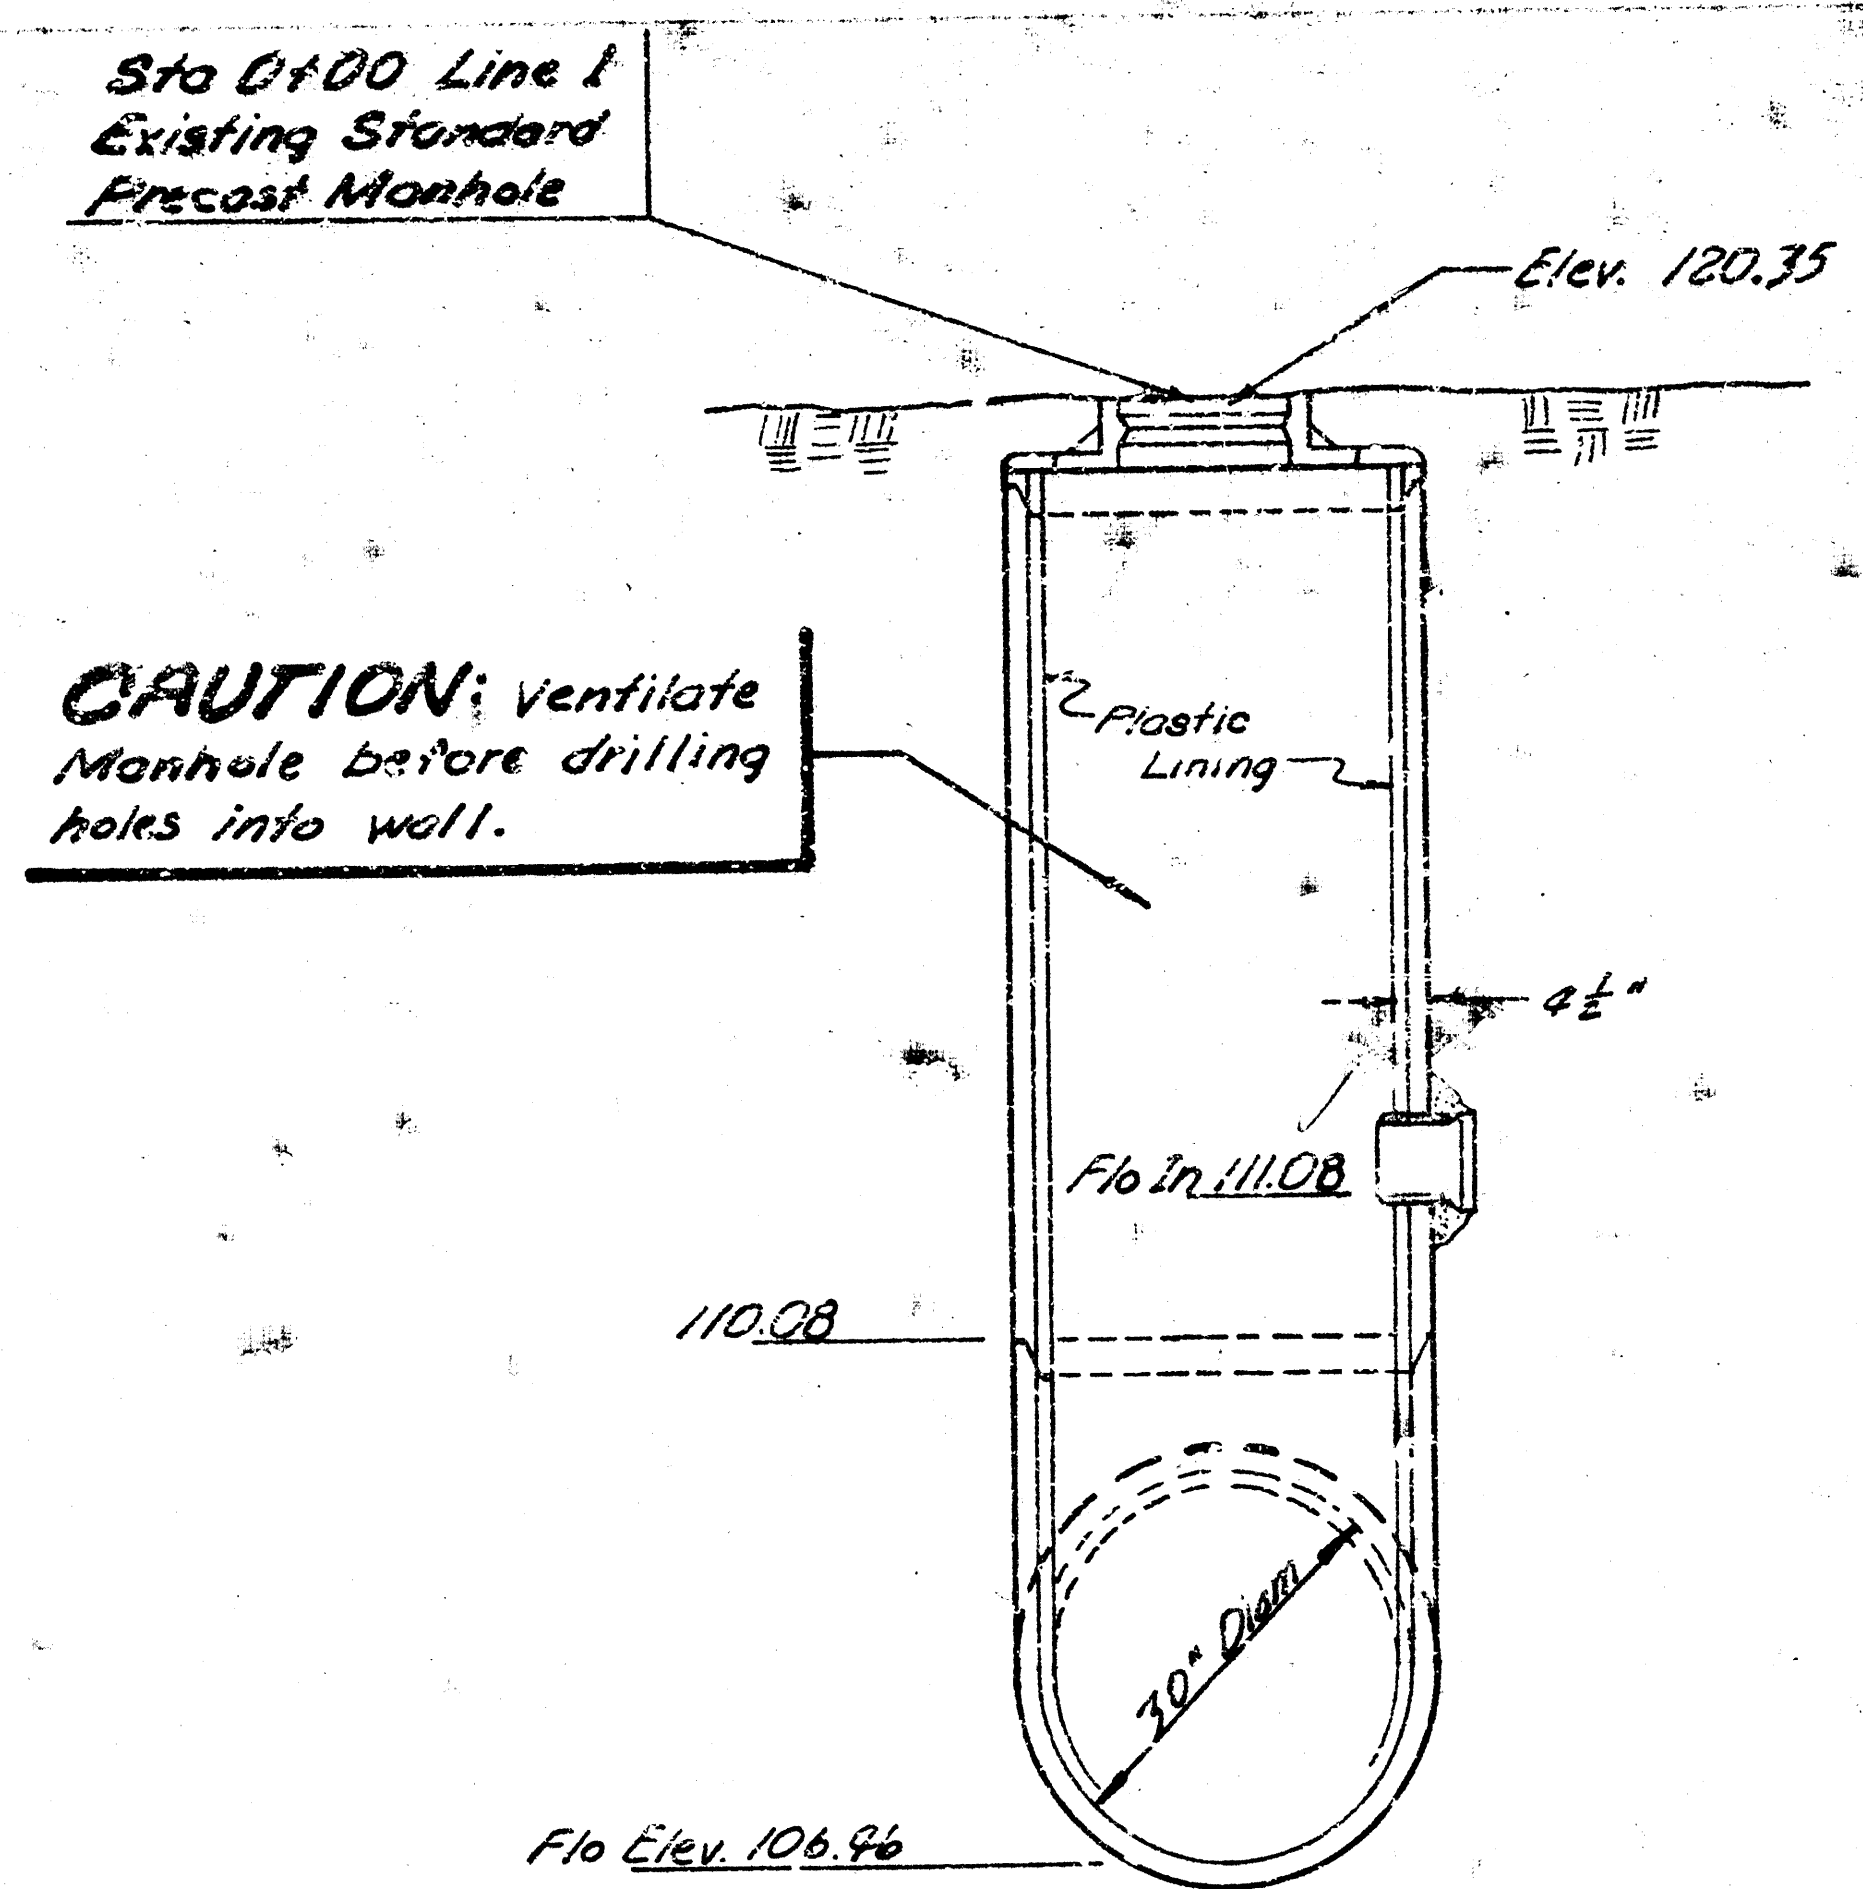

CONNECTION FOR
PRECAST MANHOLE
No Scale

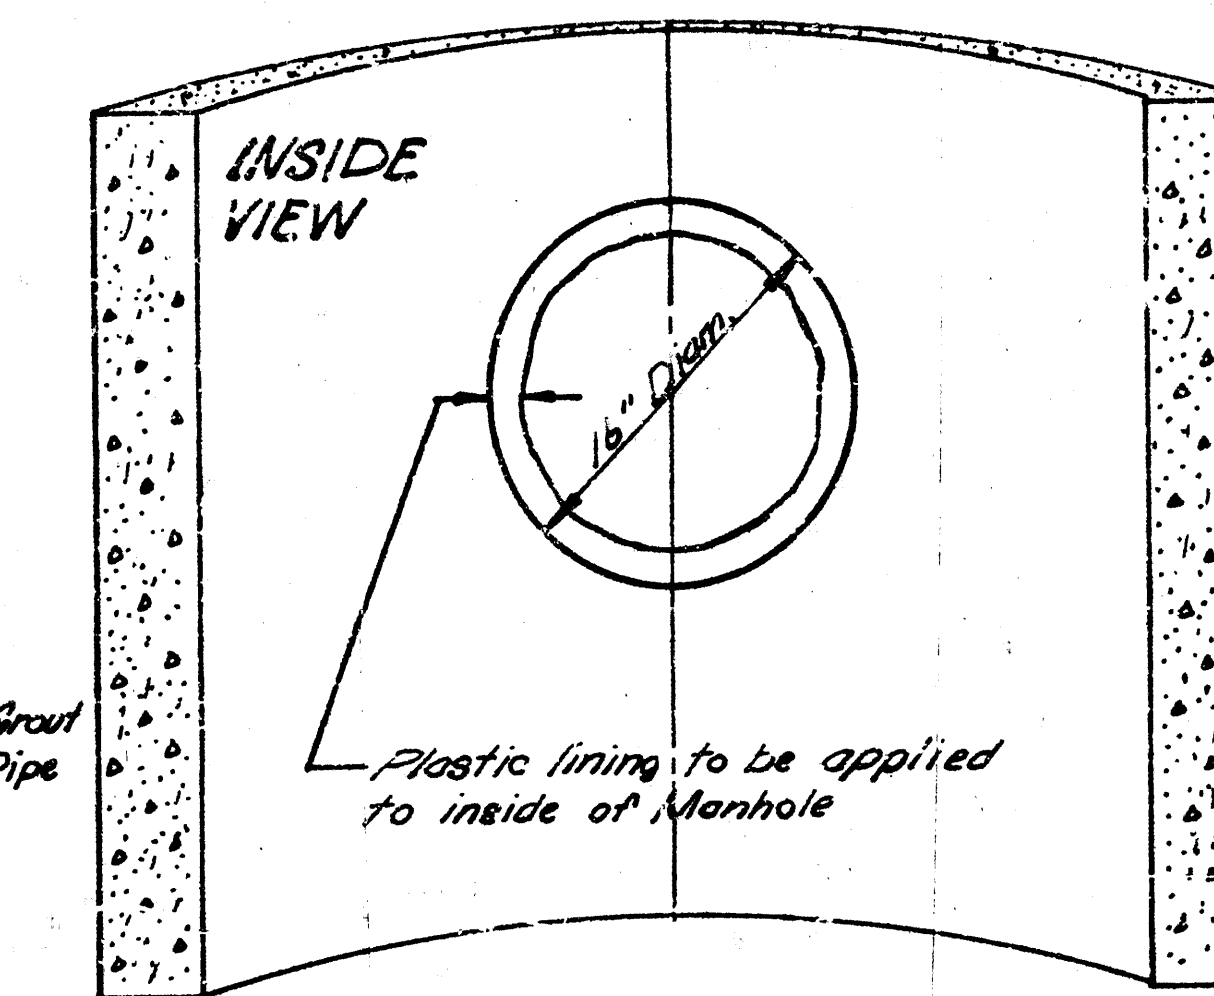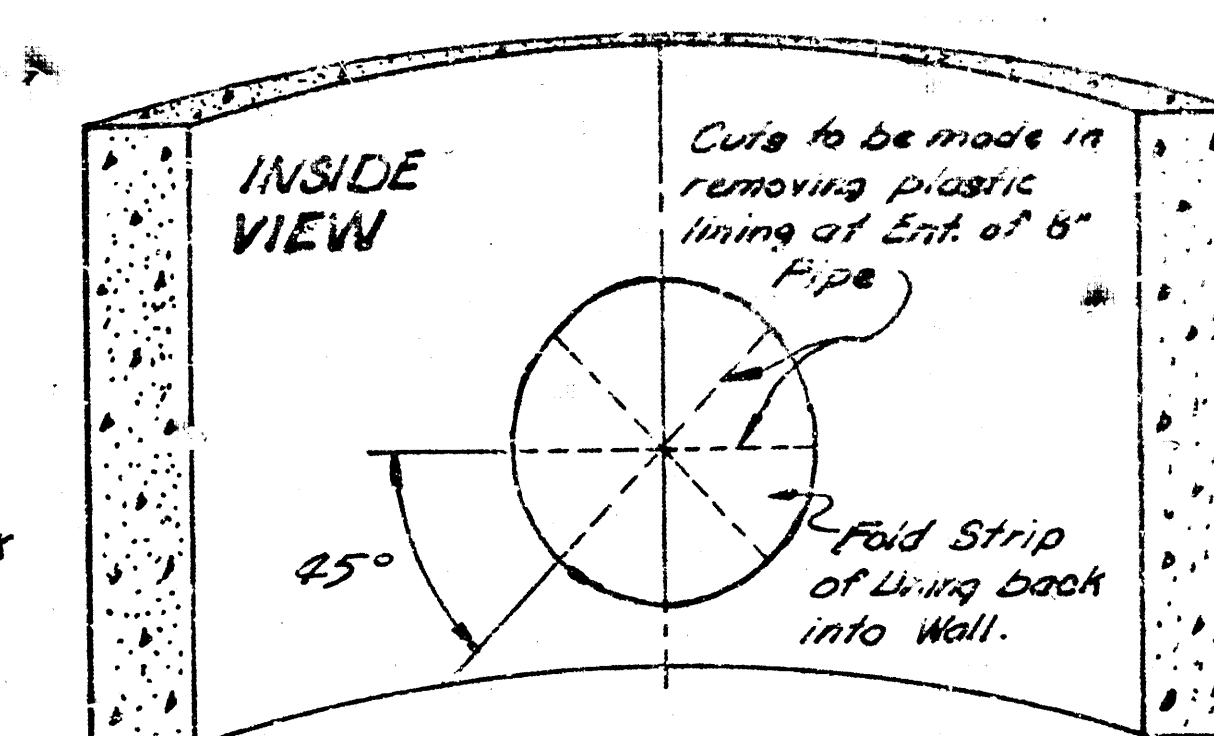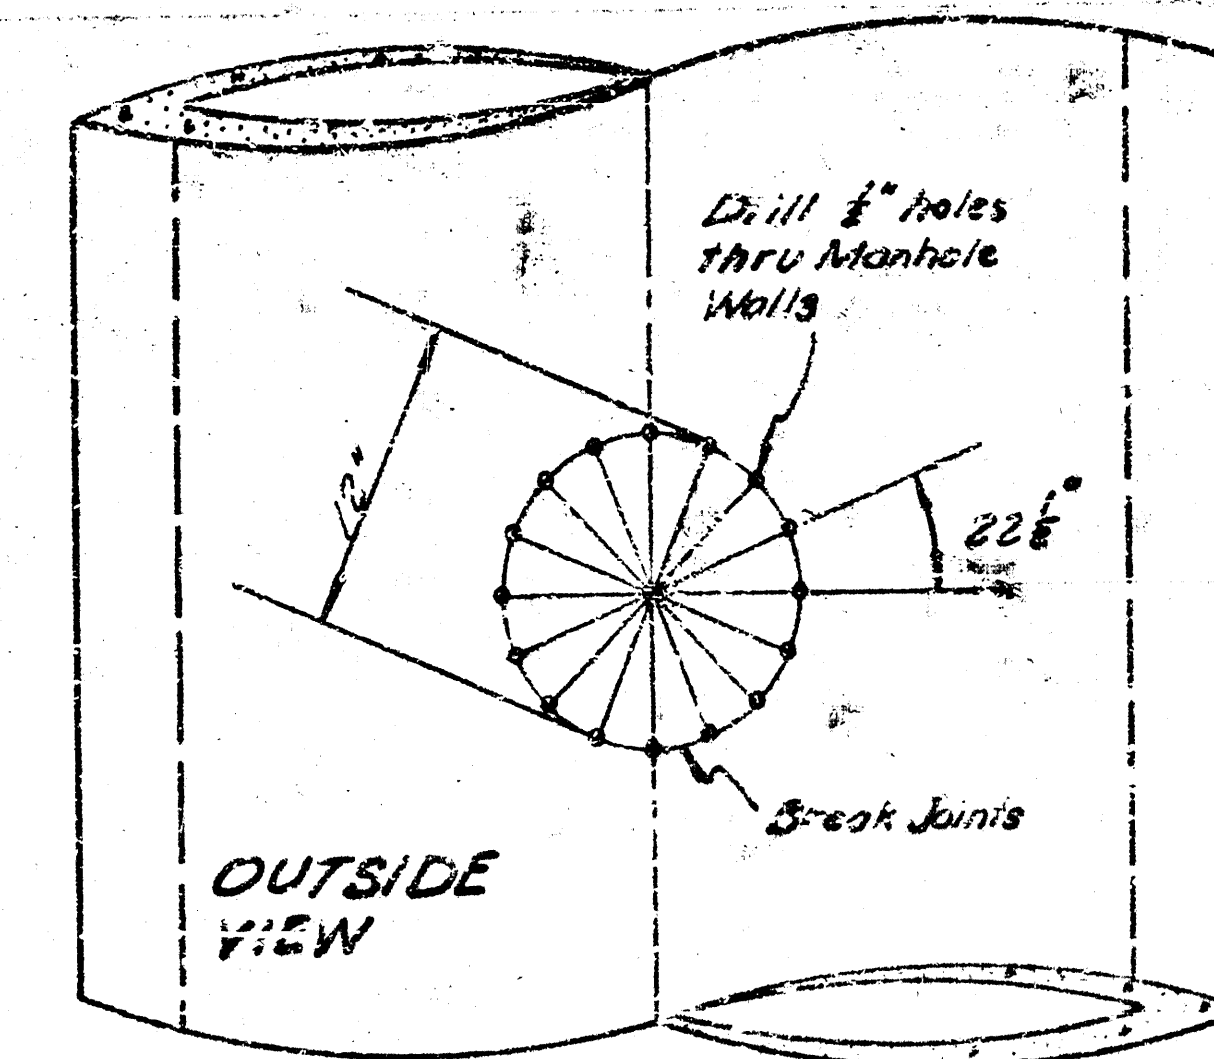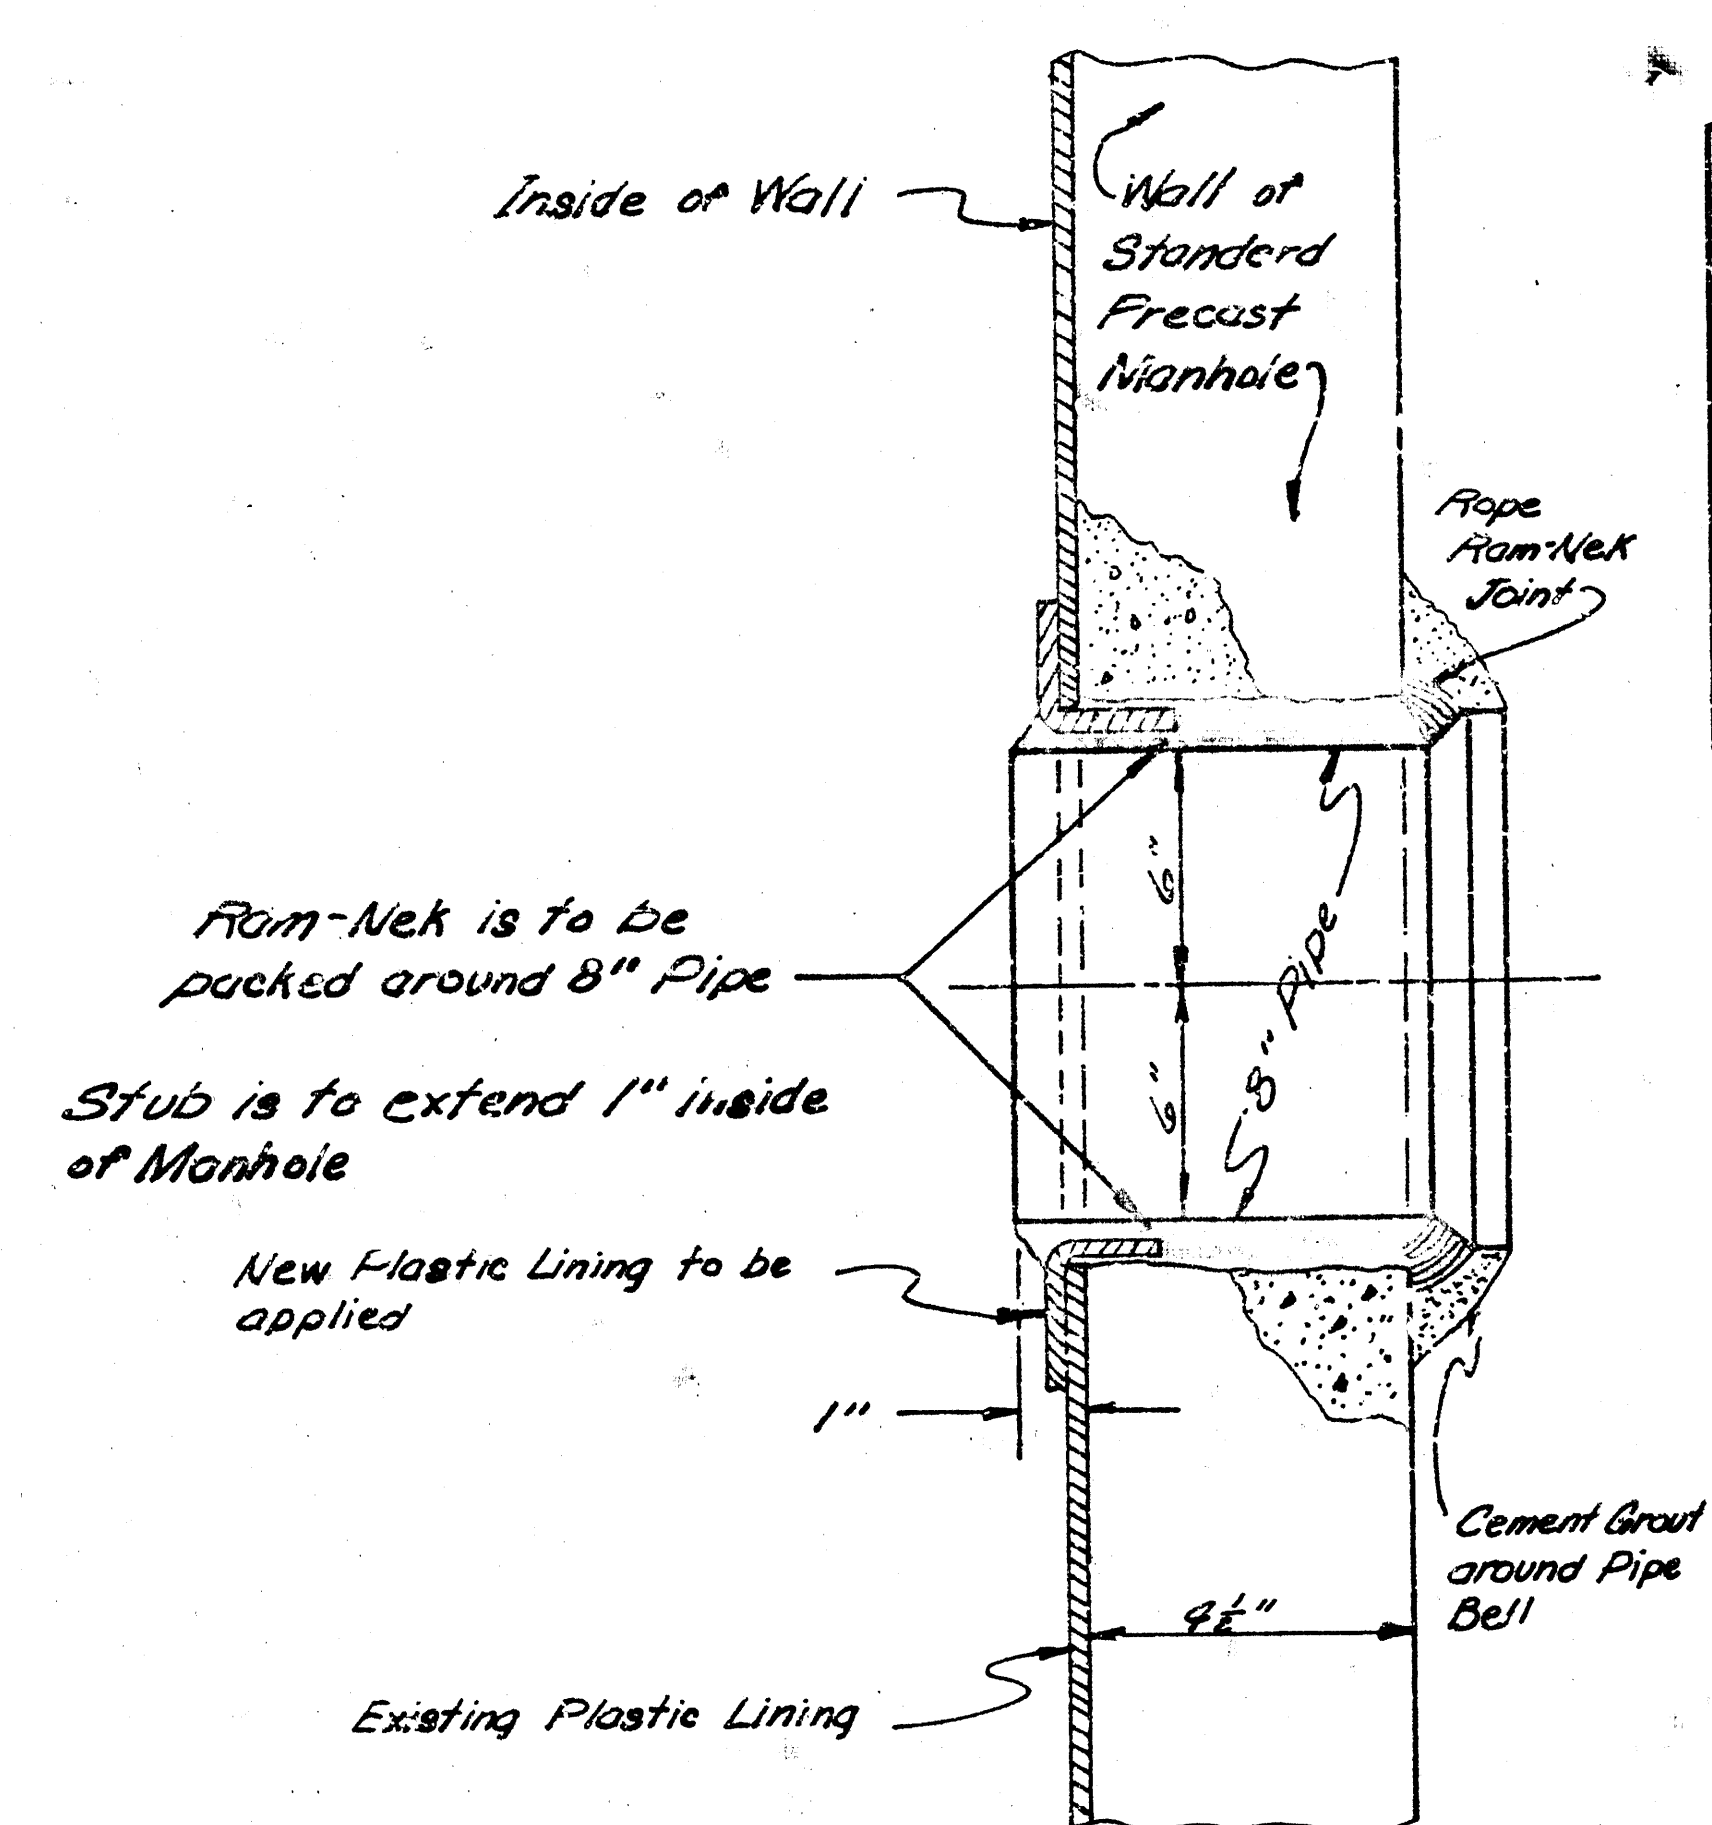

Plan Scale : 1" = 30'
 Profile Scale : 1" = 30' Horiz.
 1" = 5' Vert.

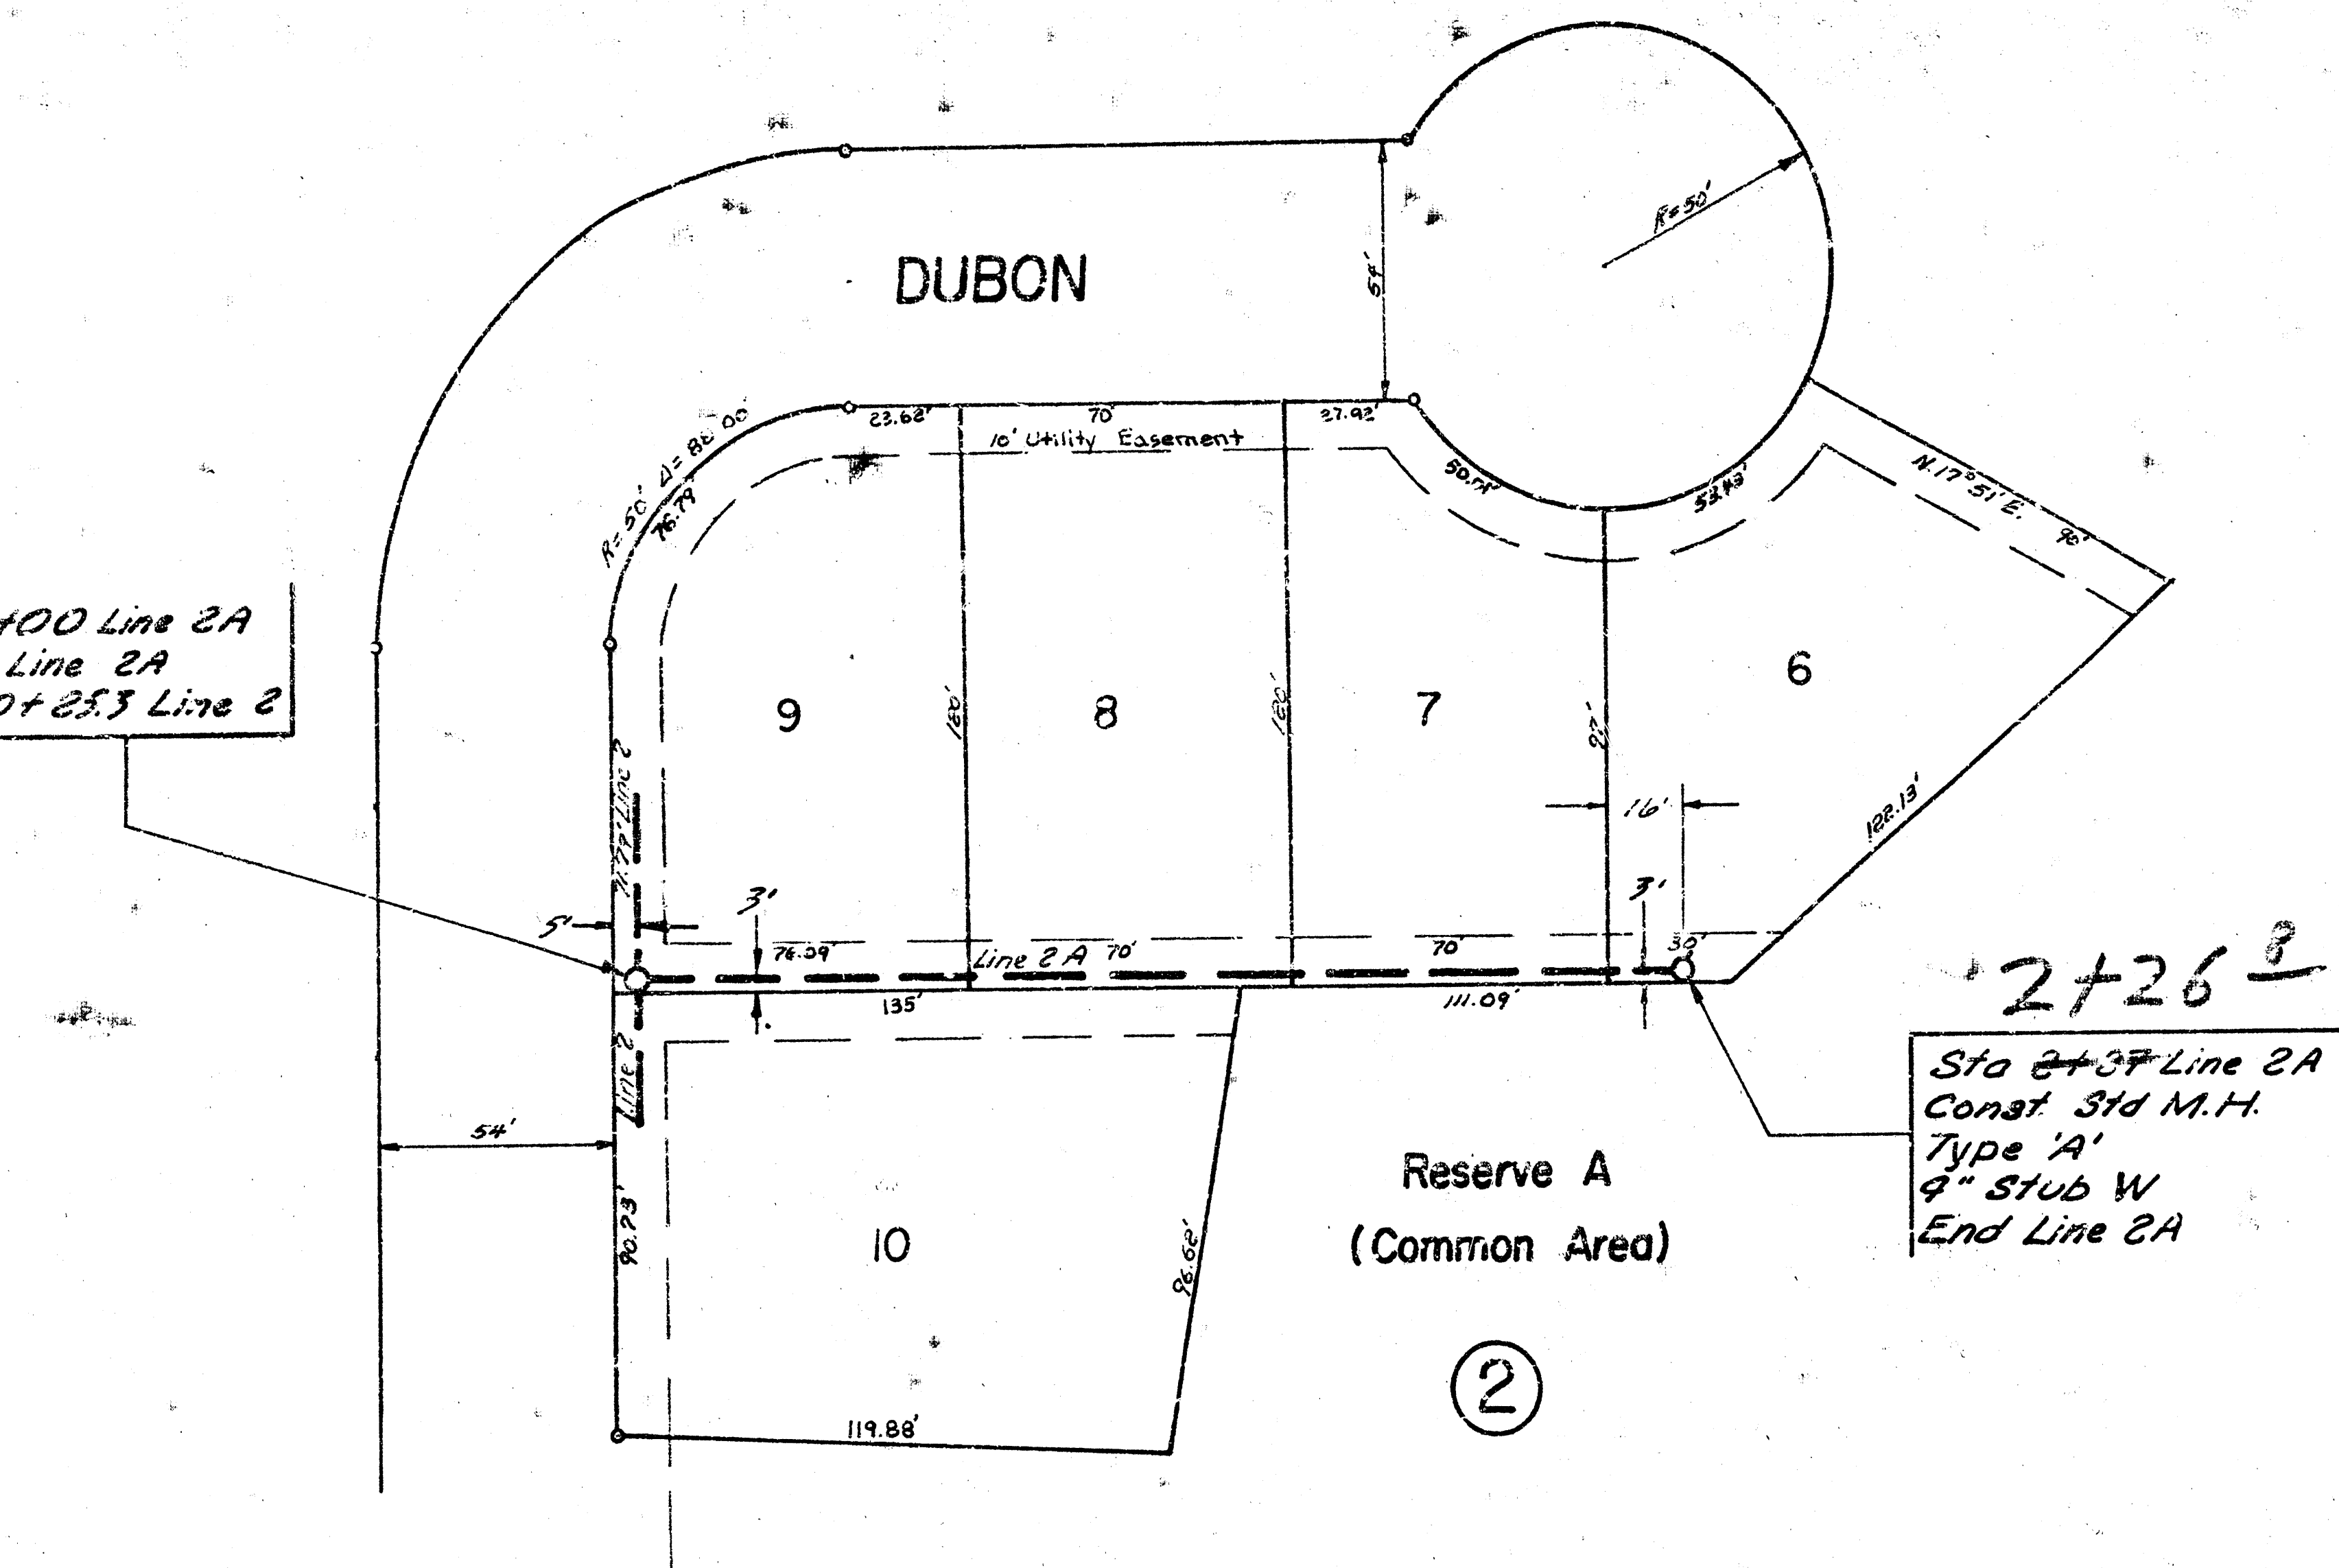

Plan Scale : 1" = 30'
 Profile Scale : 1" = 30' Horiz.
 1" = 5' Vert.

