



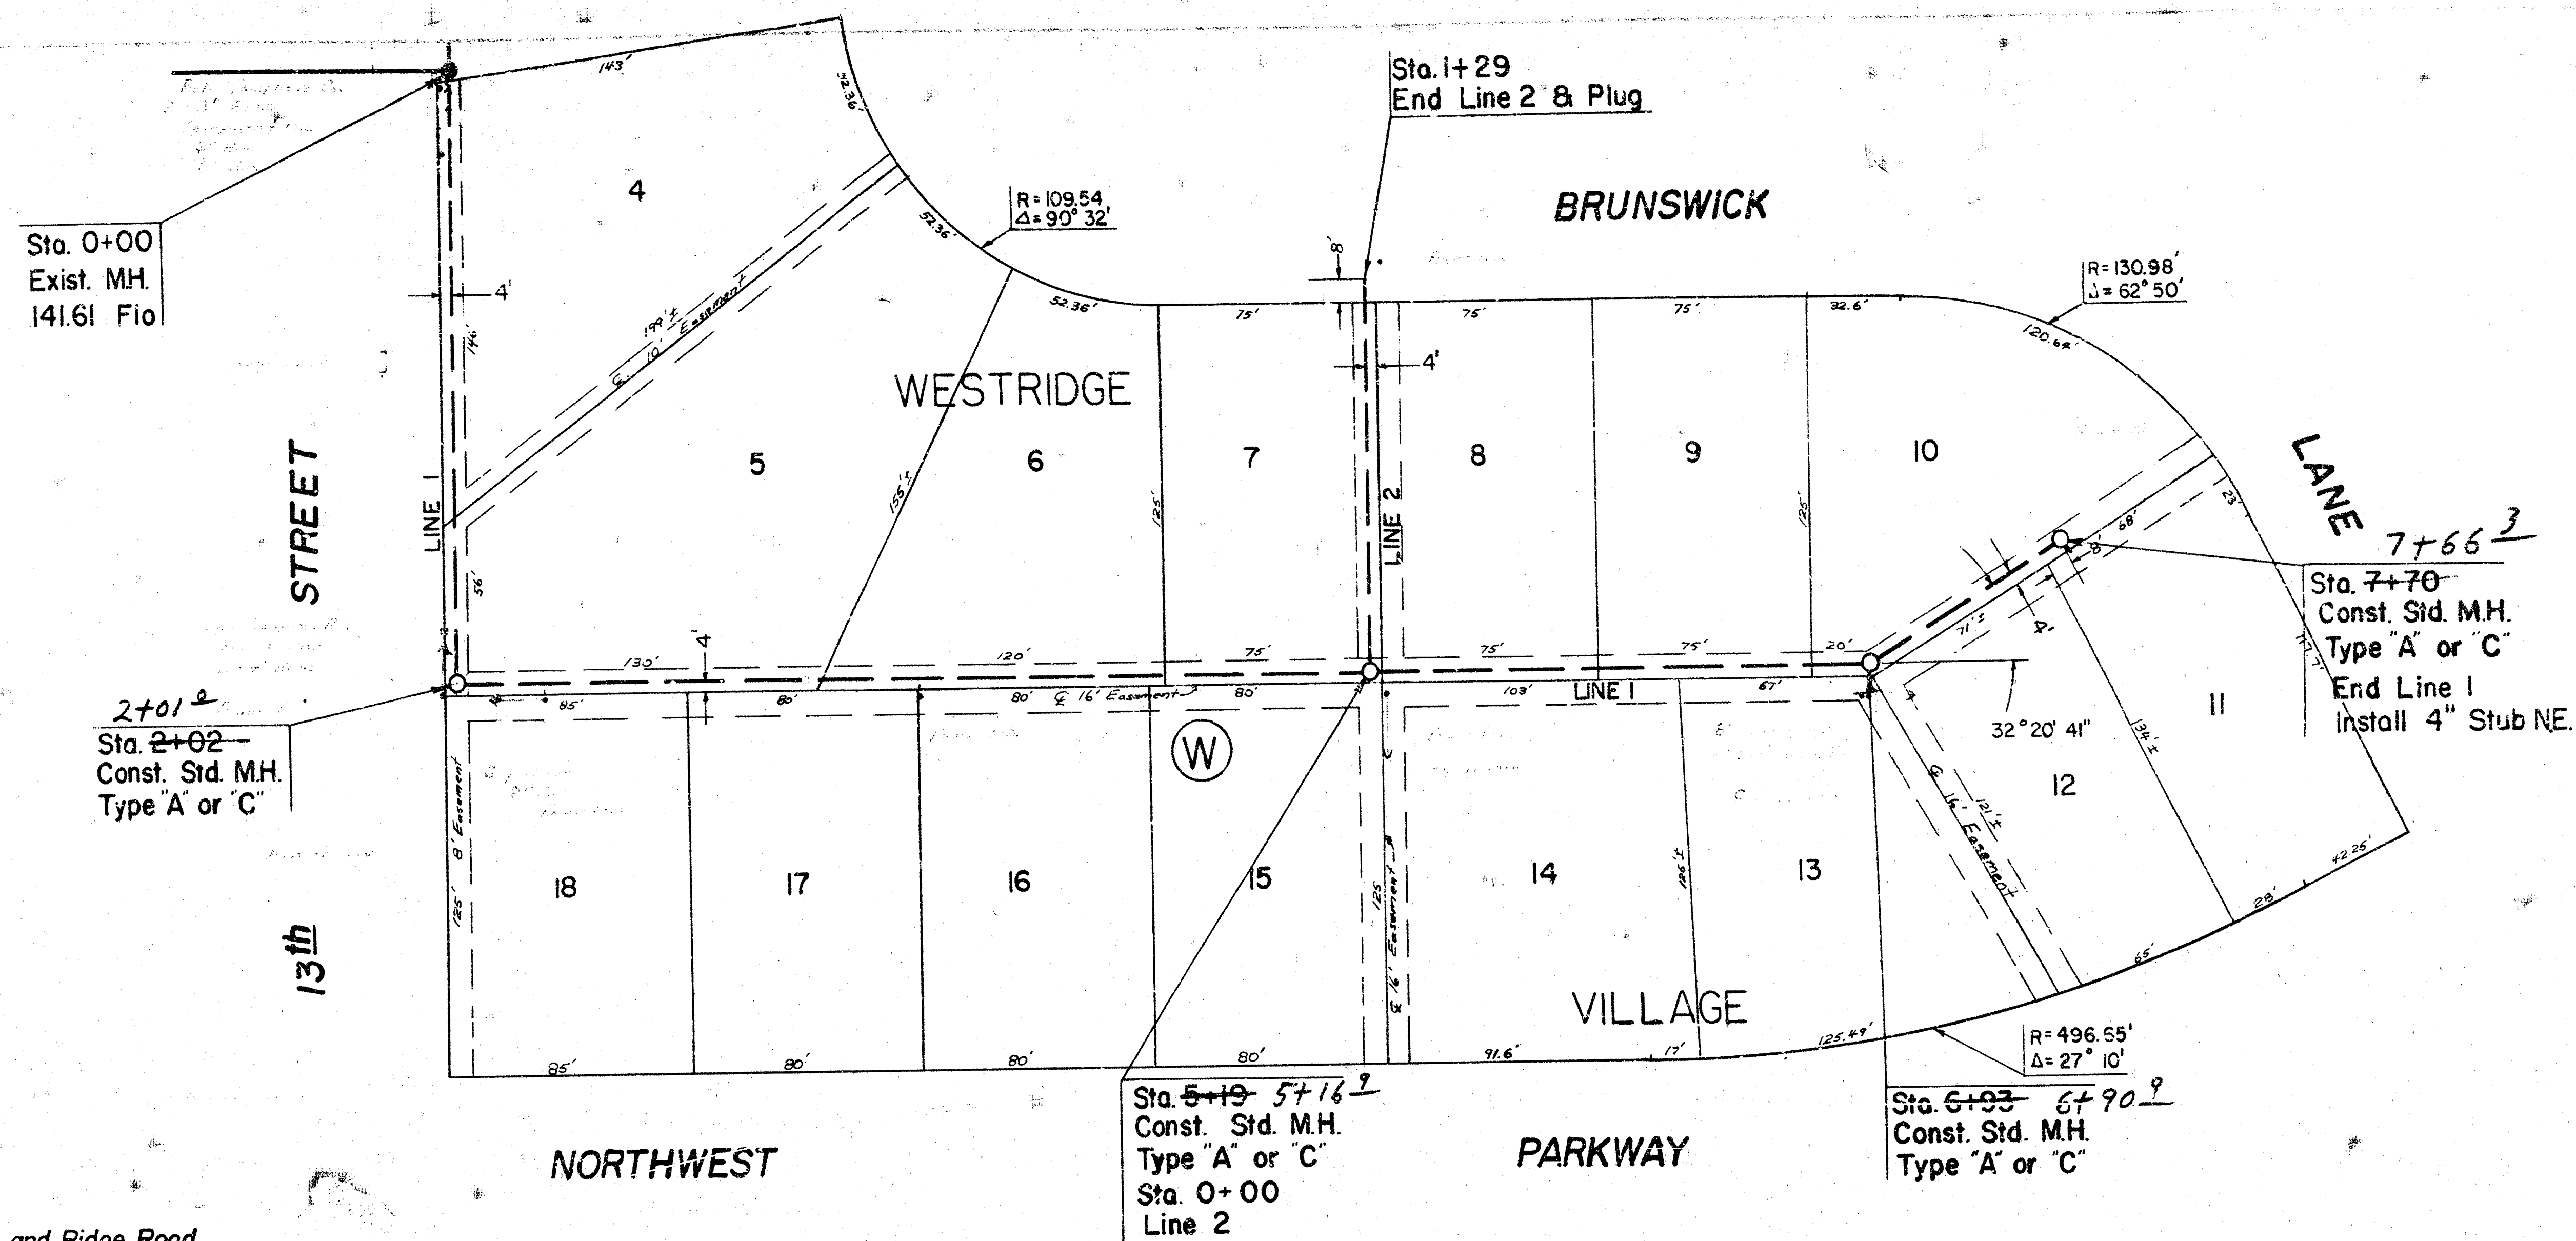

Plan Scale 1" = 40'
 Profile Scale 1" = 40' Horiz.
 1" = 5' Vert.

BM = 148.10 Wichita City Std. at 13th St. and Ridge Road
 BM = 150.27 " at West end return at NW corner Margantown and Nantucket

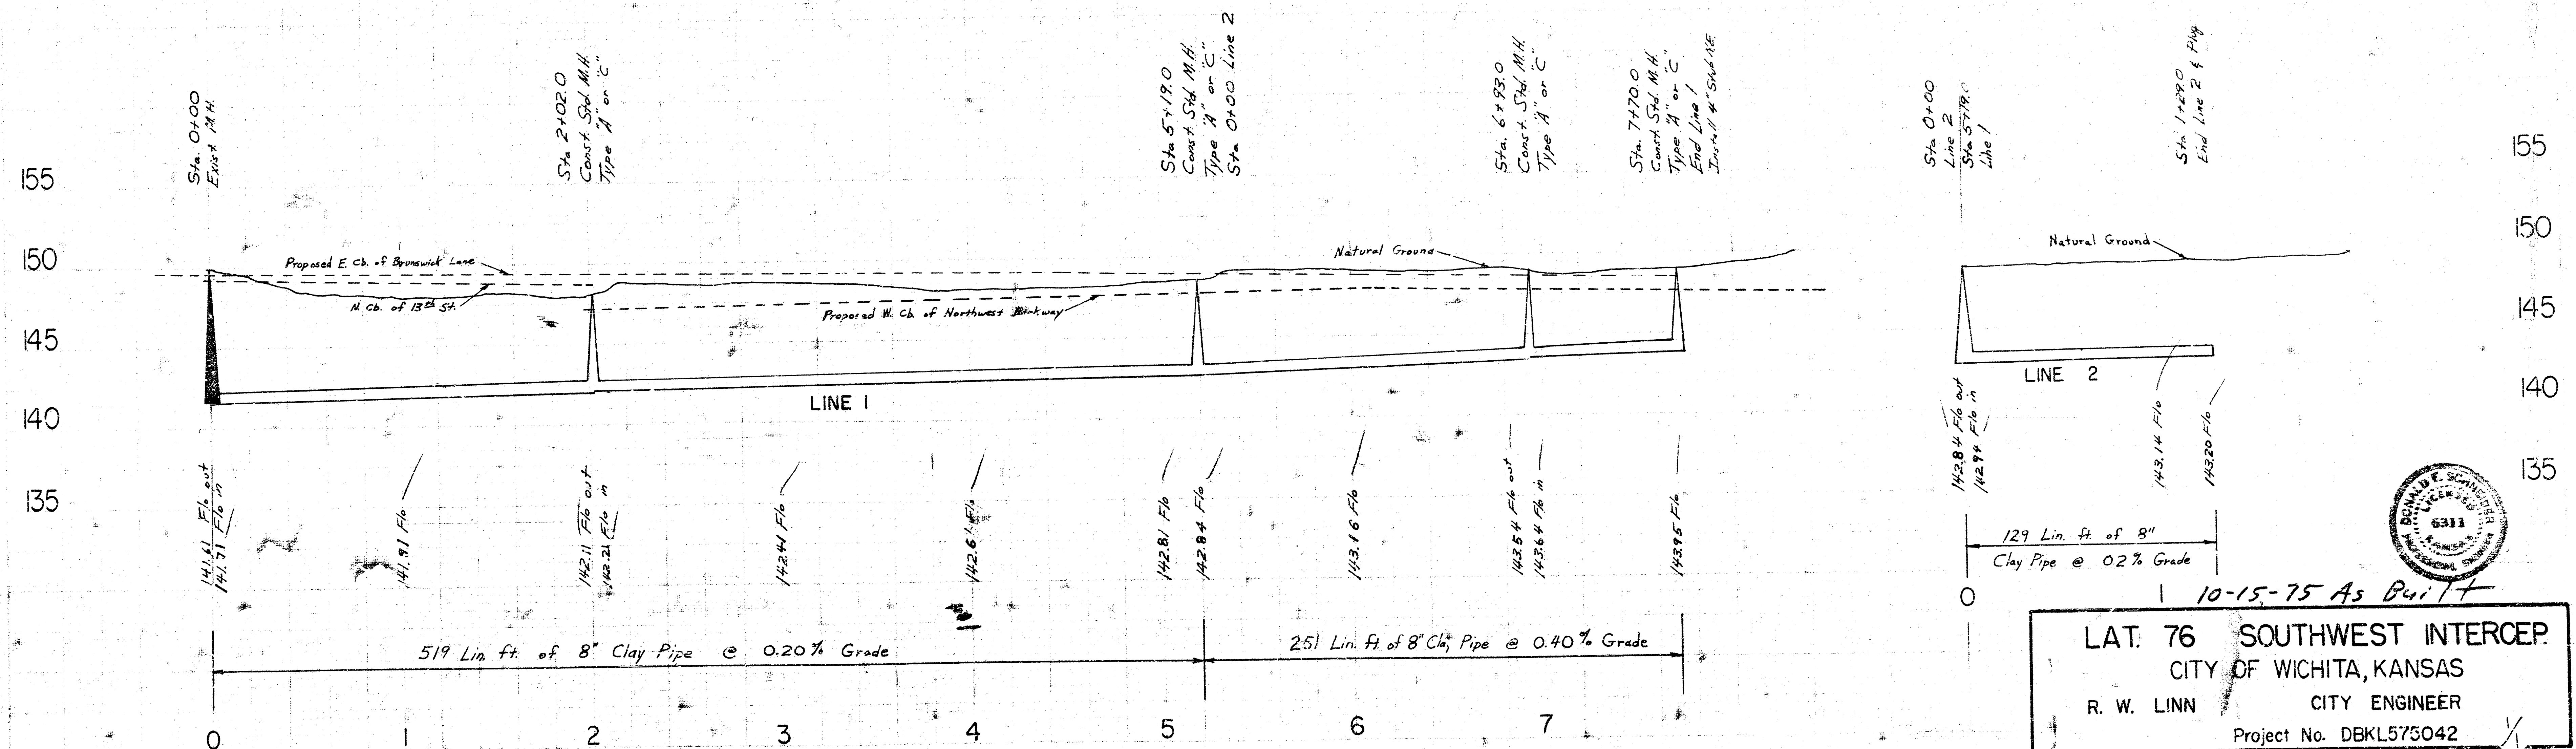

10-15-75 As Built
 LAT. 76 SOUTHWEST INTERCEP.
 CITY OF WICHITA, KANSAS
 R. W. LINN CITY ENGINEER
 Project No. DBKL573042