



B.M. 156.187 City BM Disc +2.3' E. + 44.0' N. of 1/4 Sec. Cor. @ 13th + Woodchuck
 B.M. 150.27 ' + @ W. end return @ N.W. corner Morgantown + Nantucket
 B.M. 137.95 RR. spike east side Power Pole 1010' N. of & 13th + 48' west of & Ridge Road
 B.M. 149.83 ' + on top curb west end Rad. N.W. corner Northwest Parkway + Morgantown

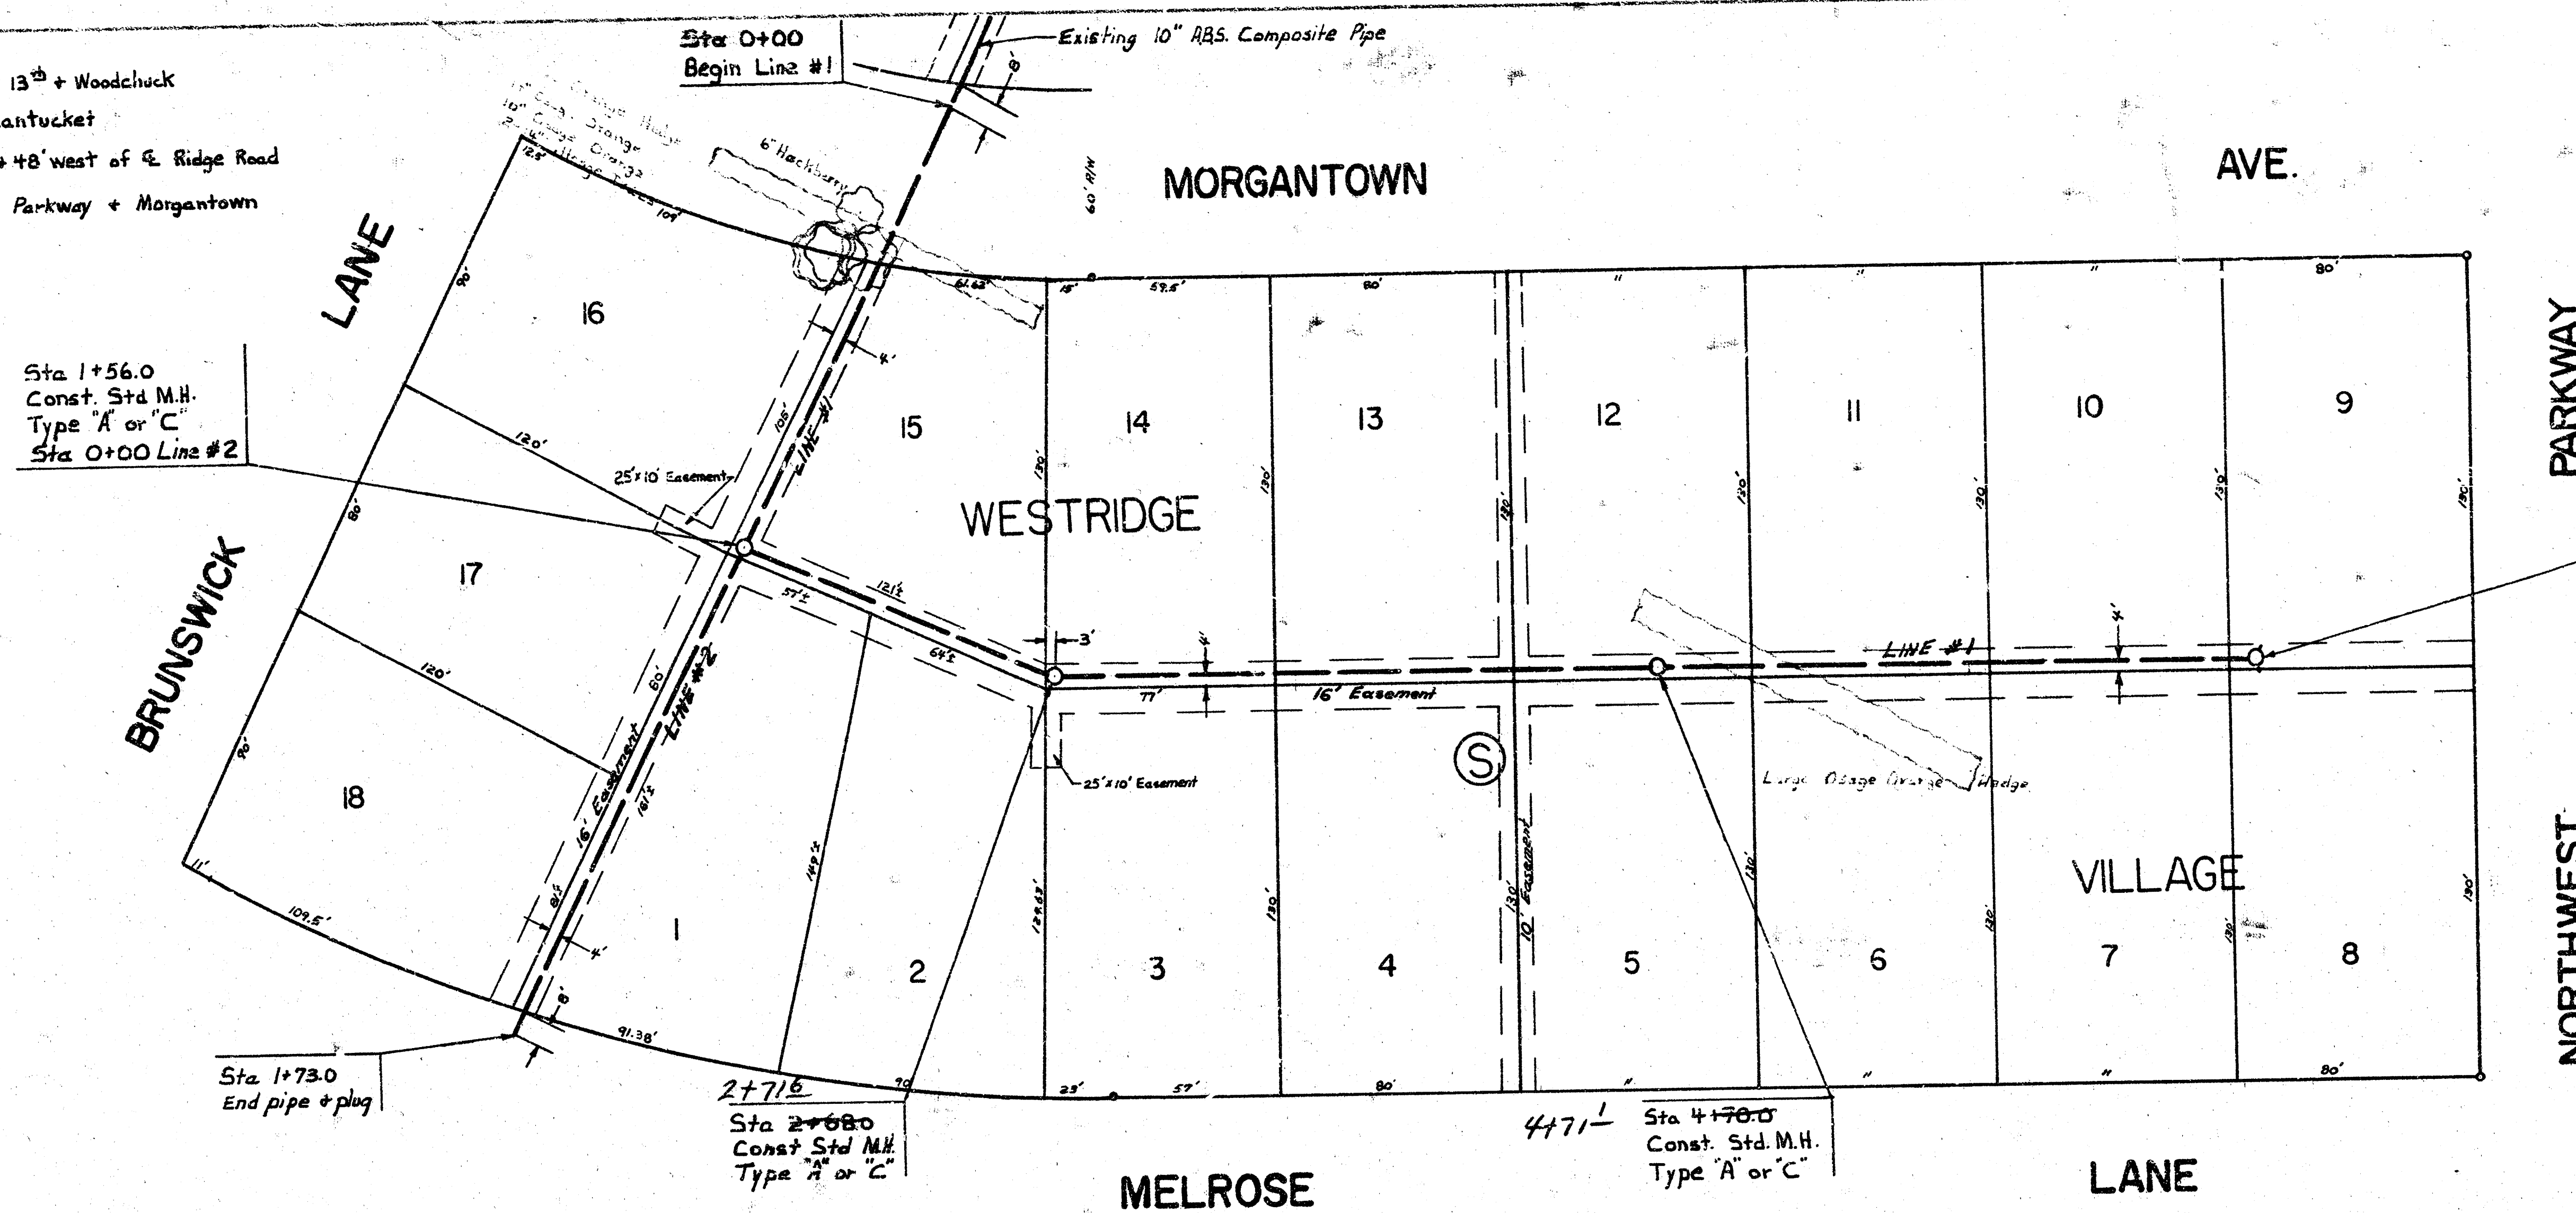

Plan Scale 1" = 40'
 Profile Scale 1" = 40' Horz.
 1" = 5' Vert.

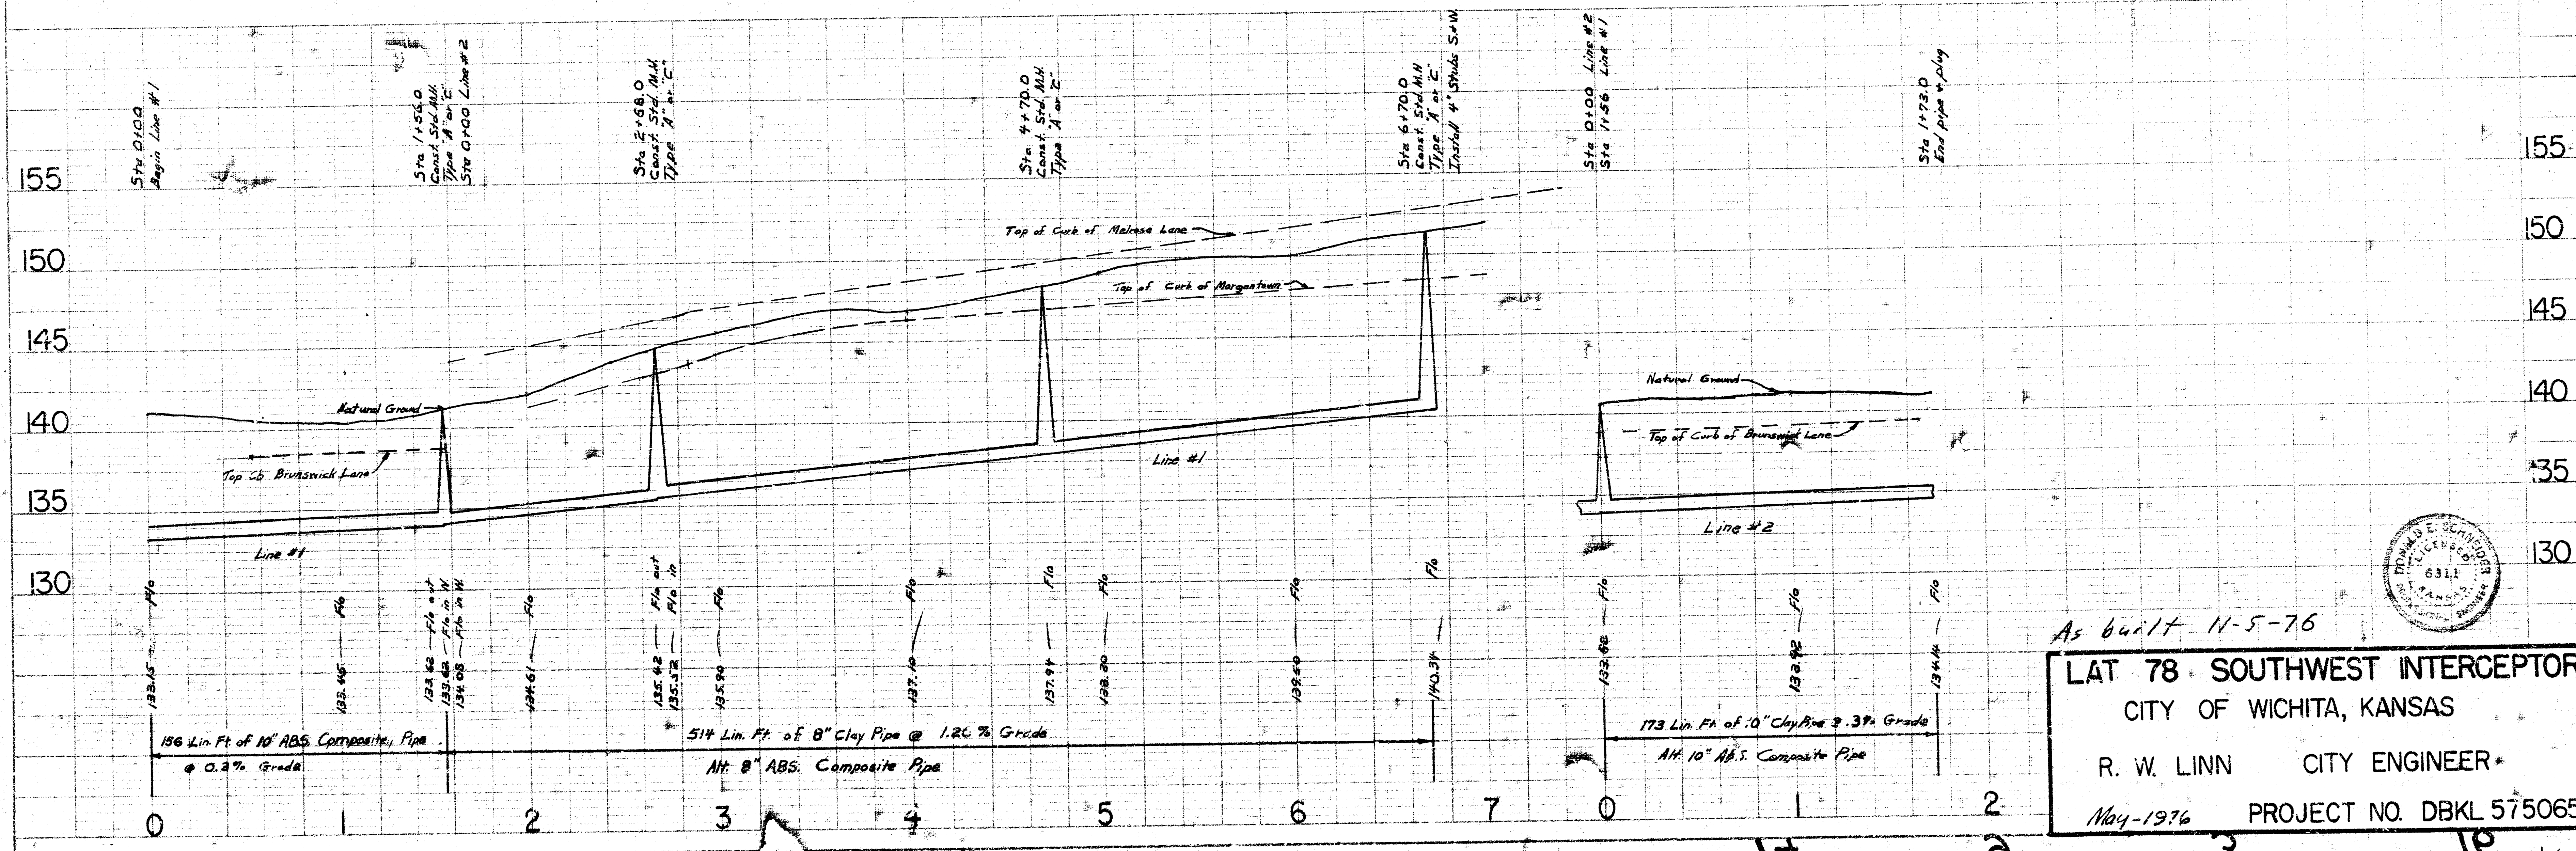

As built 11-5-76
LAT 78 SOUTHWEST INTERCEPTOR
 CITY OF WICHITA, KANSAS
 R. W. LINN CITY ENGINEER
 May-1976 PROJECT NO. DBKL 575065