

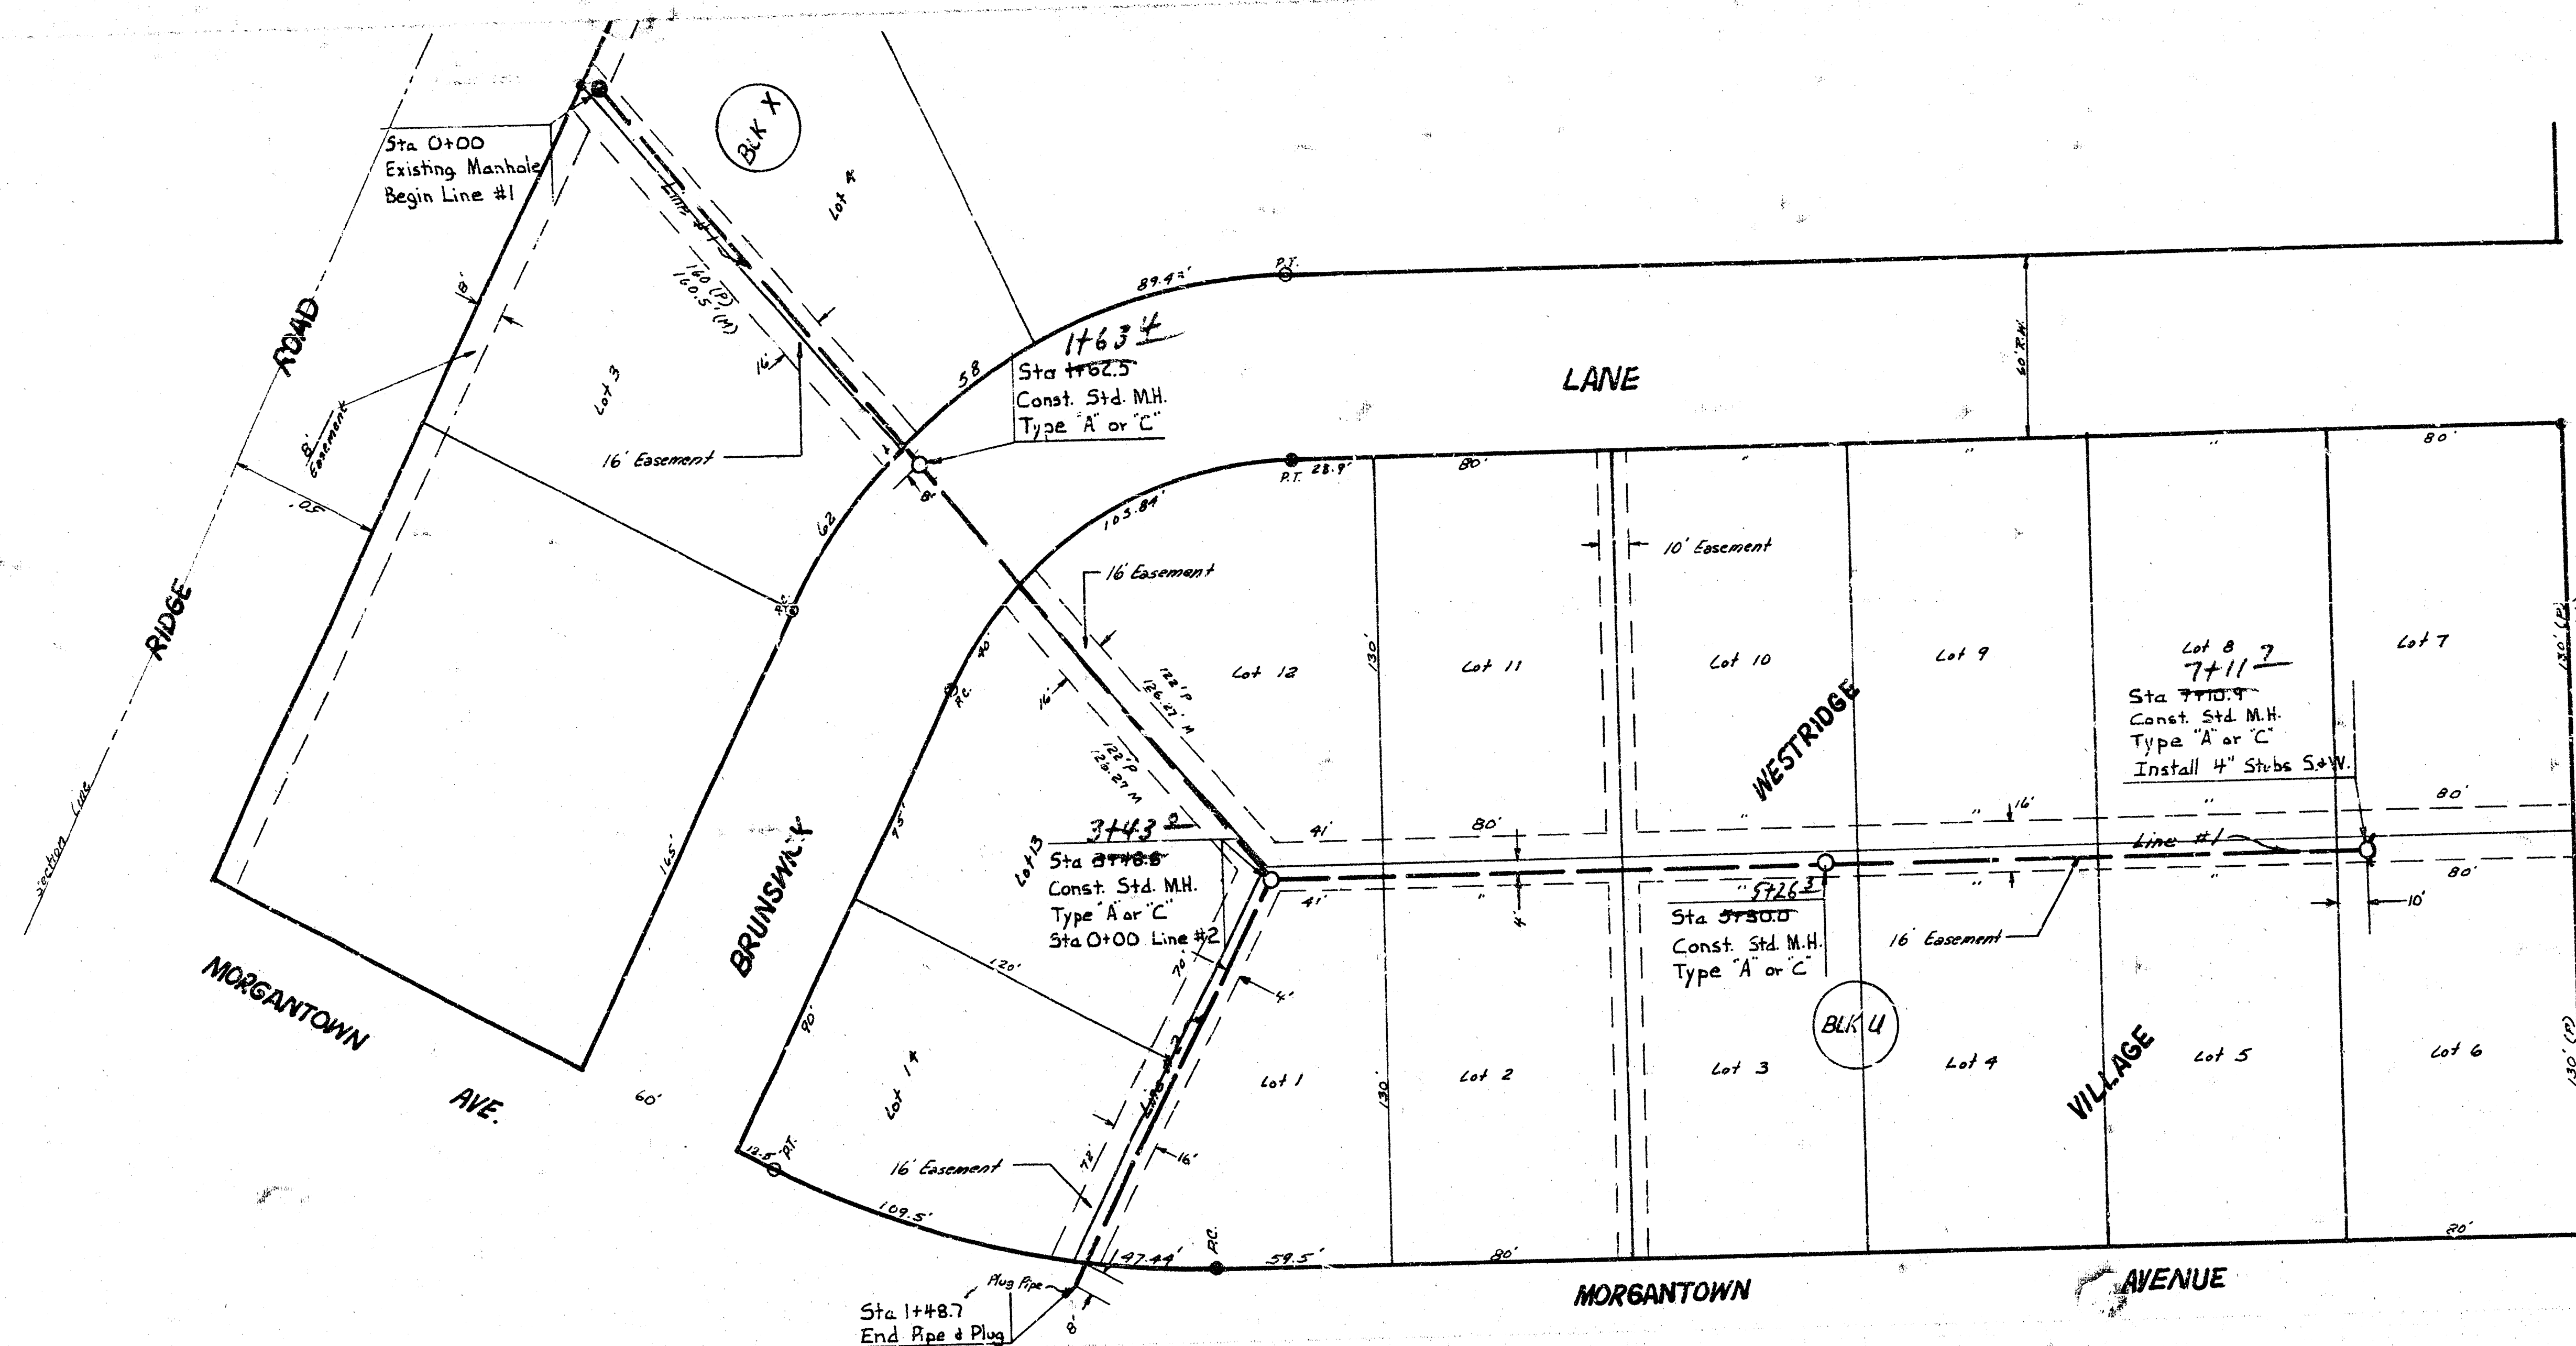


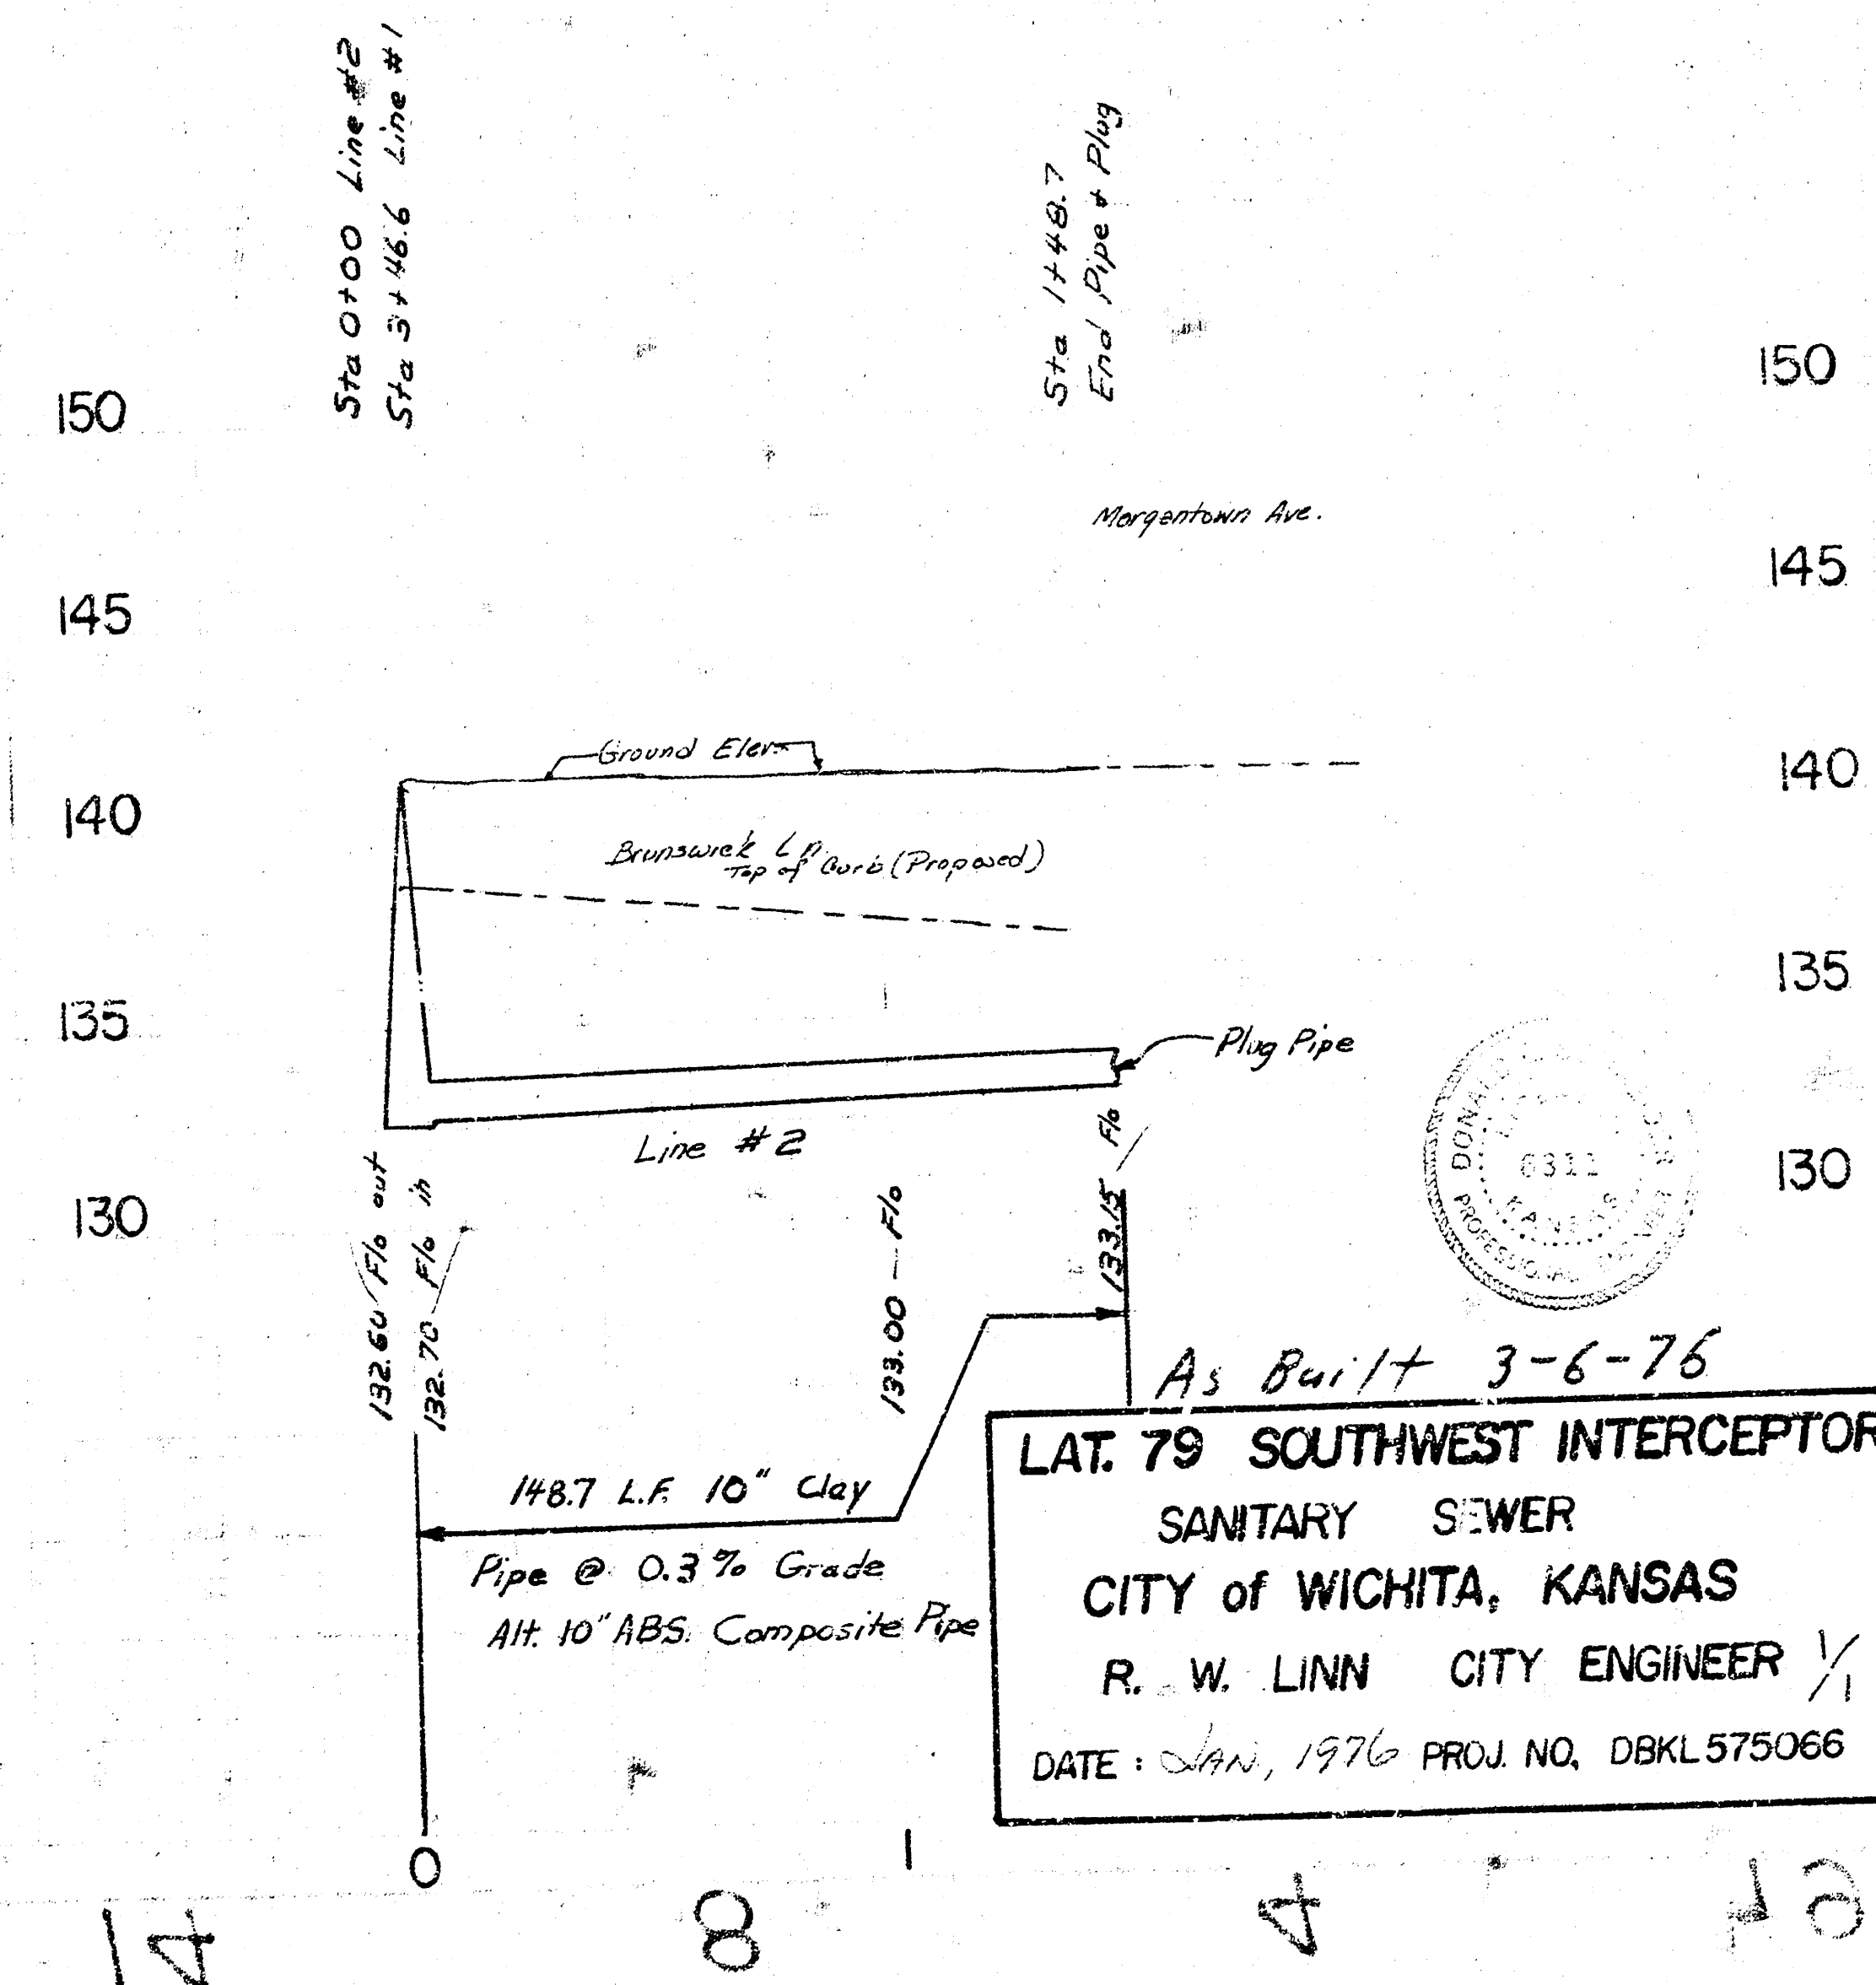

SCALE: PLAN: 1" = 40'
 PROFILE: HORIZONTAL: 1" = 40'
 VERTICAL: 1" = 5'

B.M. - 156.19 - CITY B.M. DISC. 423 E. + 44 N. of 1/4 SEC. CORNER of 13TH STREET & WOODCHUCK.
 B.M. - 150.27 - 1/4" at W. end of RETURN, N.W. CORNER of MORGANTOWN and NANTUCKET.
 B.M. - 137.55 - RR SPIKE in E.S. of P.P. 1016' N. of E. of 13TH ST and 48' W. of E. of RIDGE ROAD.
 B.M. - 144.83 - 1/4" on TOP of CURB - WEST END of RADIUS, N.W. CORNER of NORTHWEST PARKWAY and MORGANTOWN AVE.

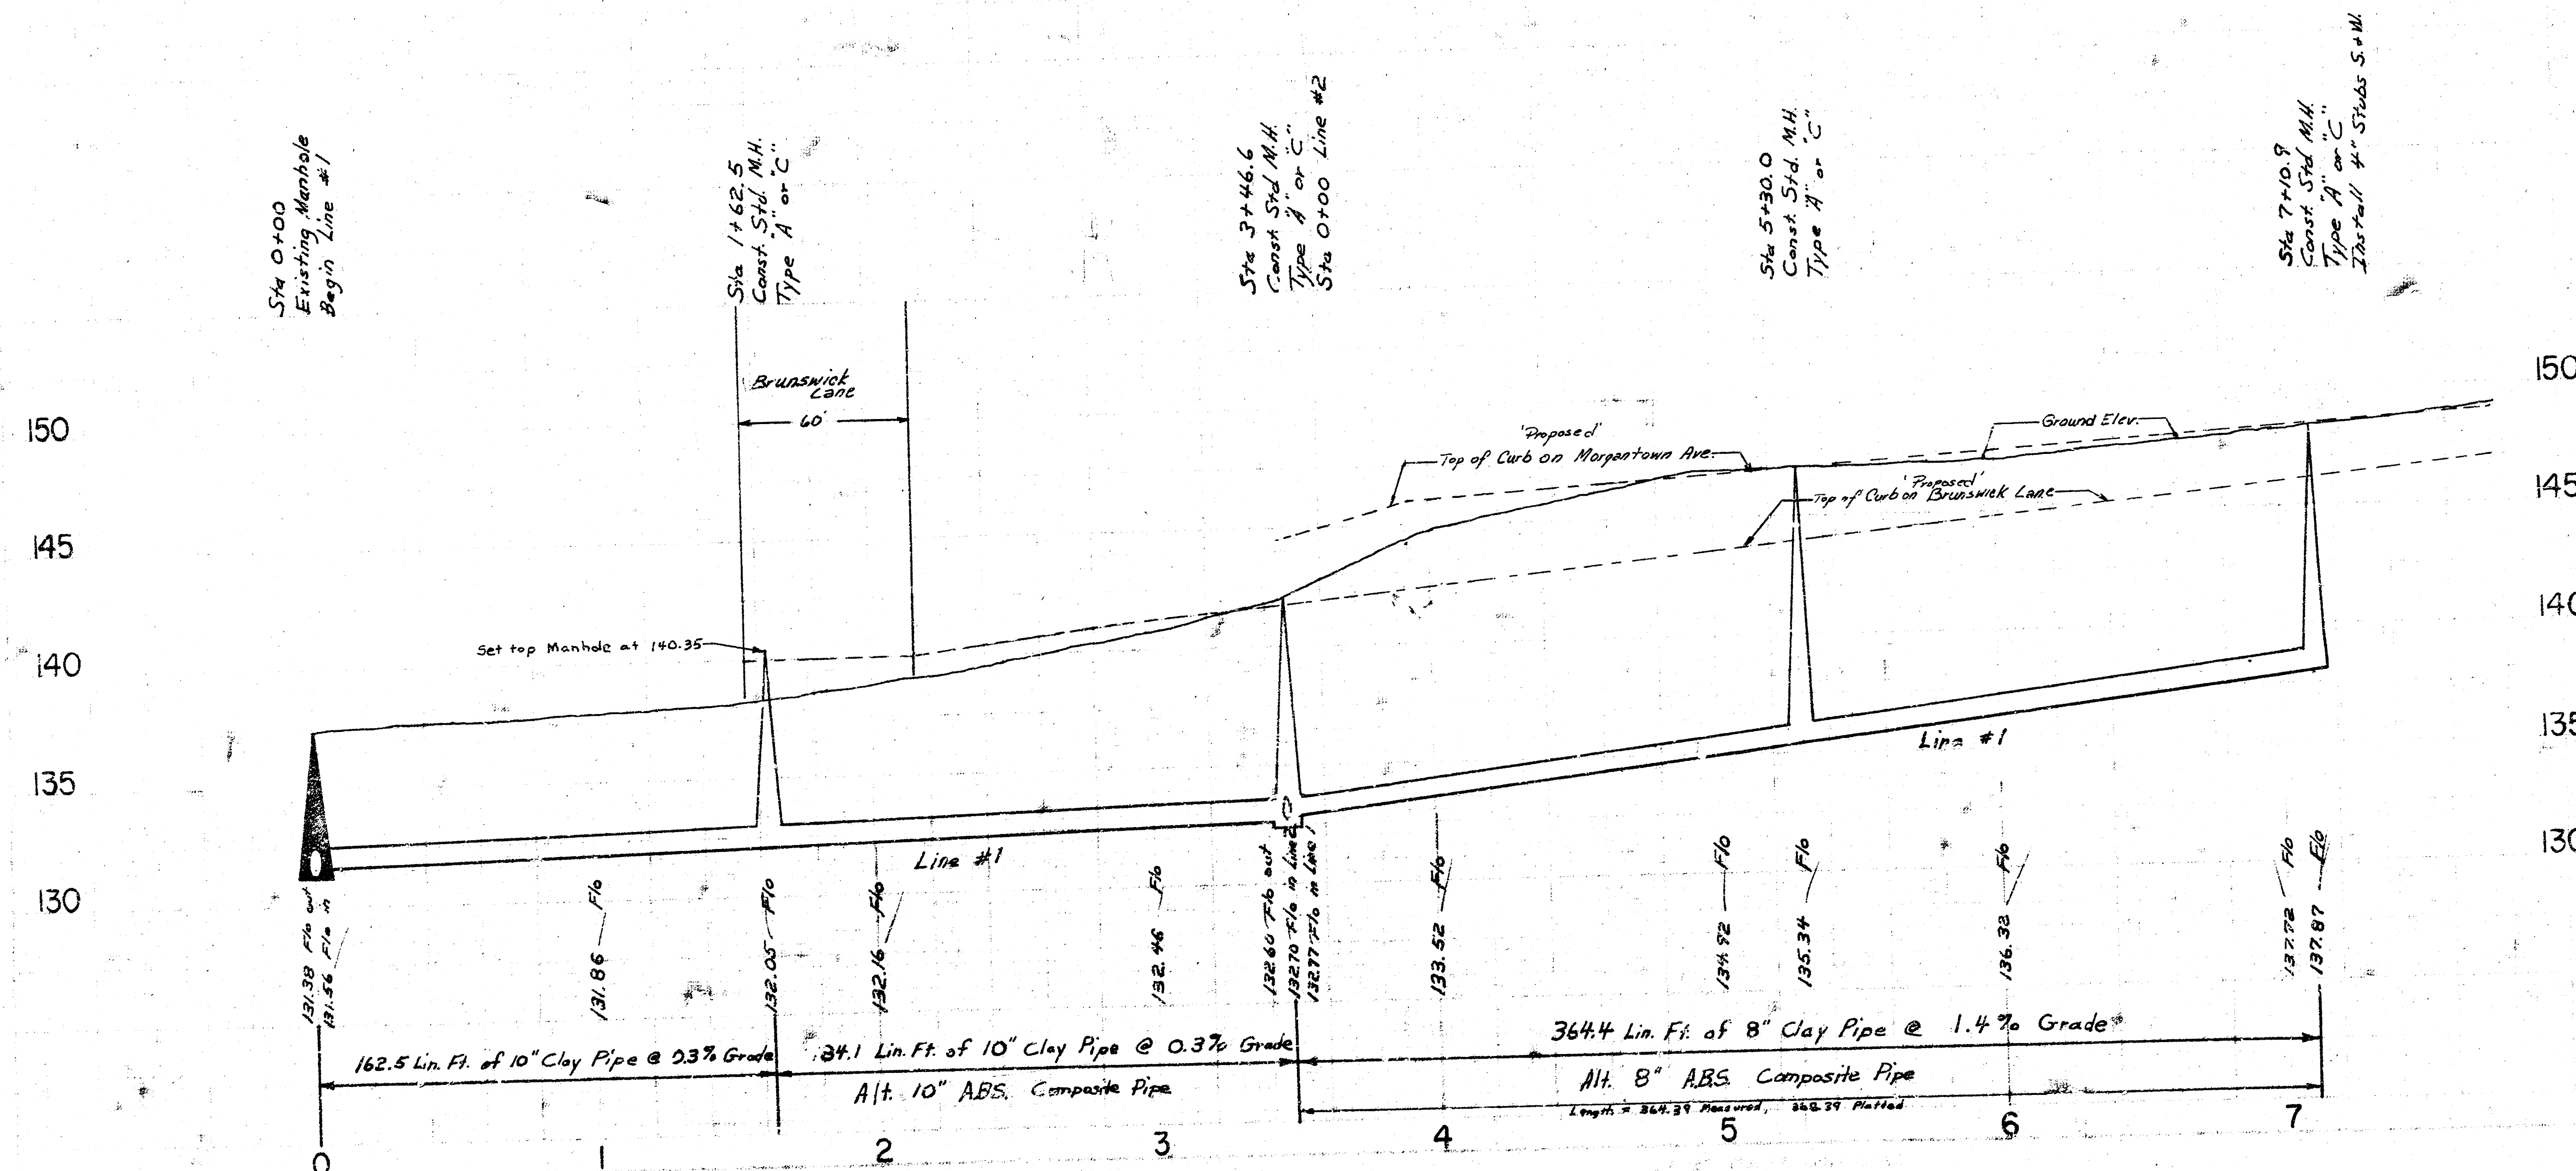

As Built 3-6-76
 LAT. 79 SOUTHWEST INTERCEPTOR
 SANITARY SEWER
 CITY OF WICHITA, KANSAS
 R. W. LINN CITY ENGINEER
 DATE: JAN, 1976 PROJ. NO. DBKL575066