

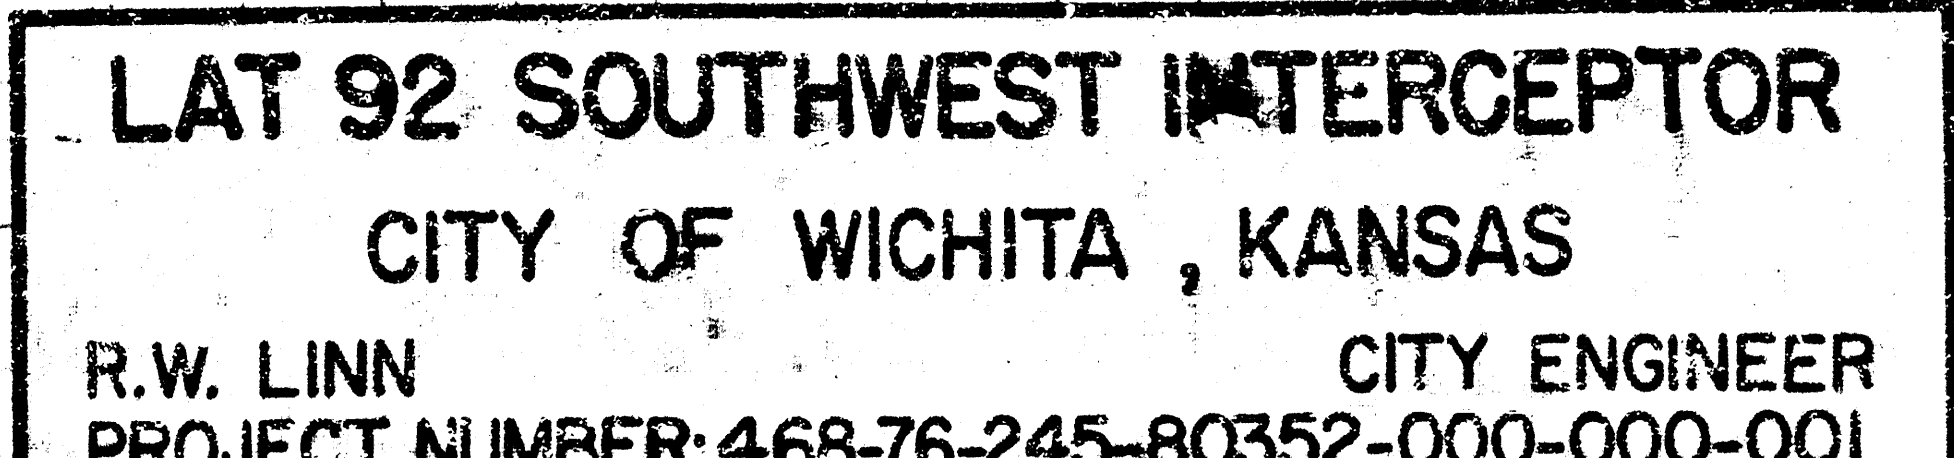
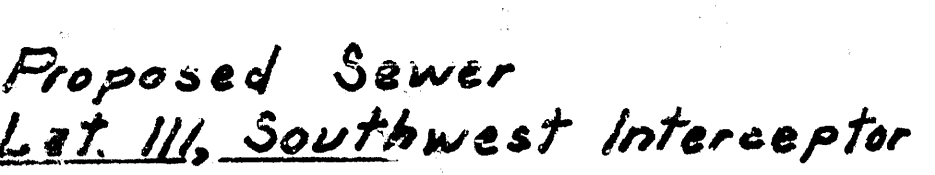


Plan Scale: 1"=40'  
Profile Scale: 1"=40' Horiz.  
1"=5' Vert.

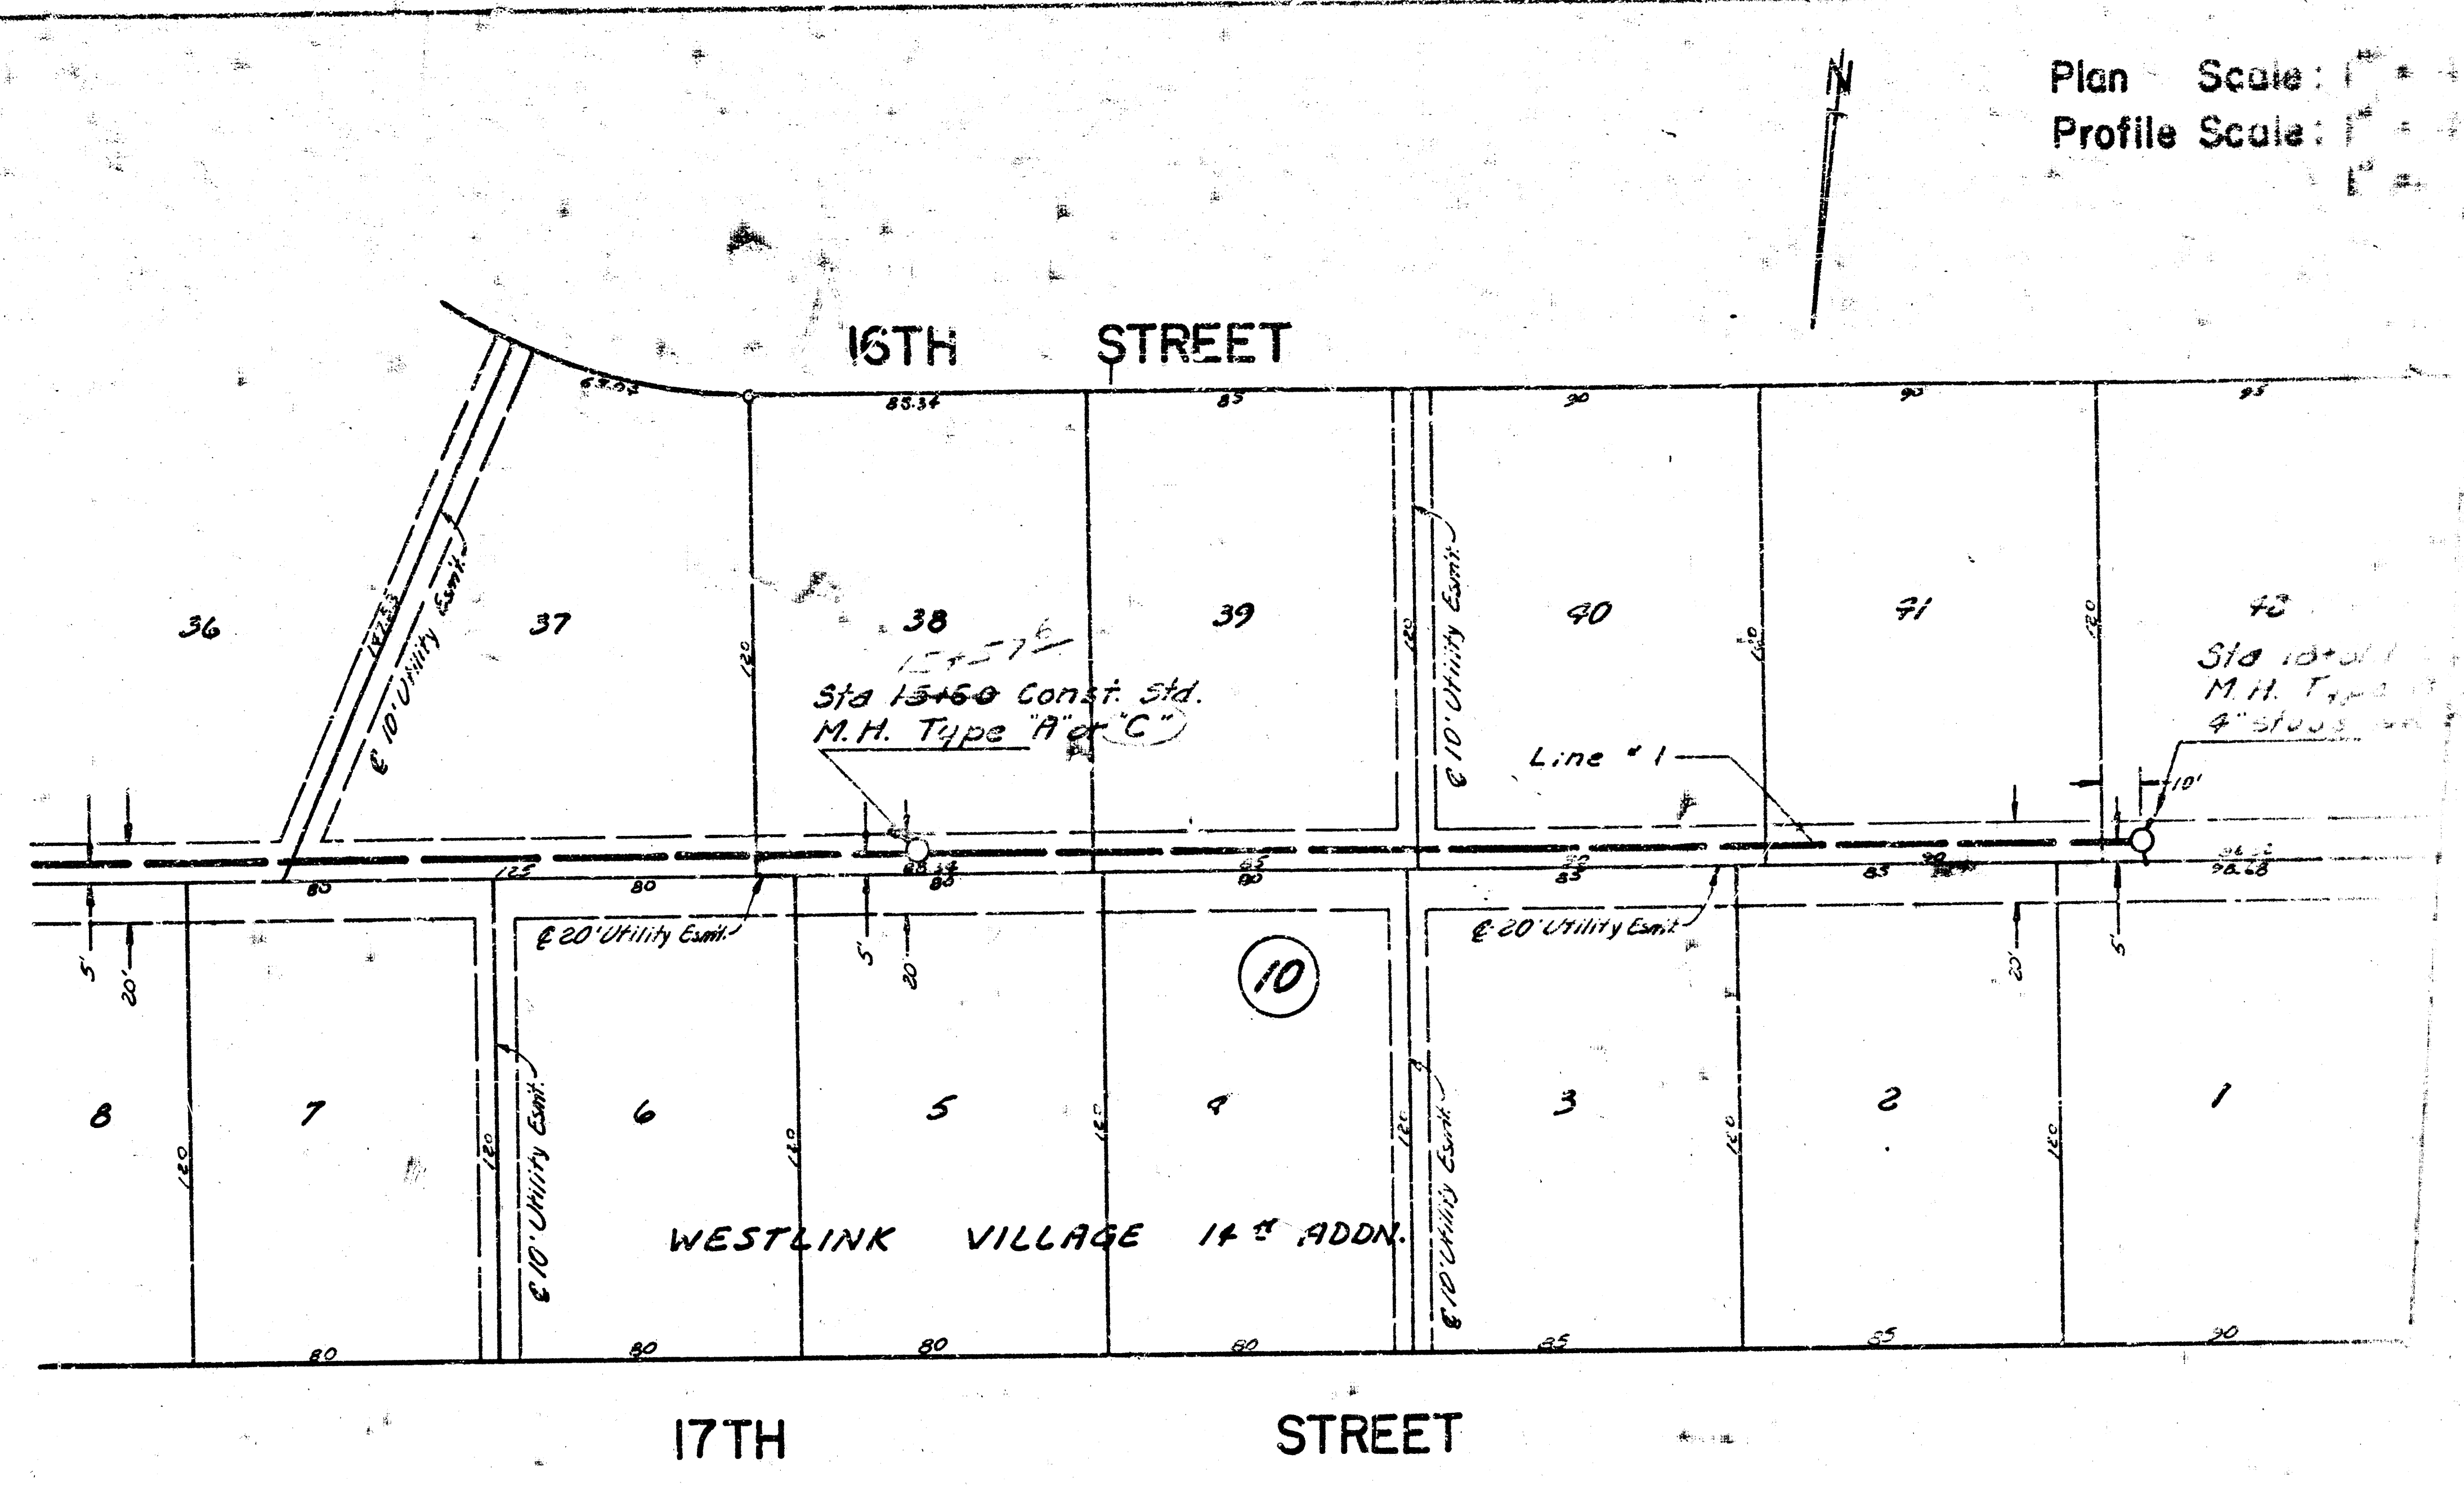

|           |      |    |         |
|-----------|------|----|---------|
| PLAN      | DATE | BY | CHECKED |
| NOTE BOOK |      |    |         |
|           |      |    |         |

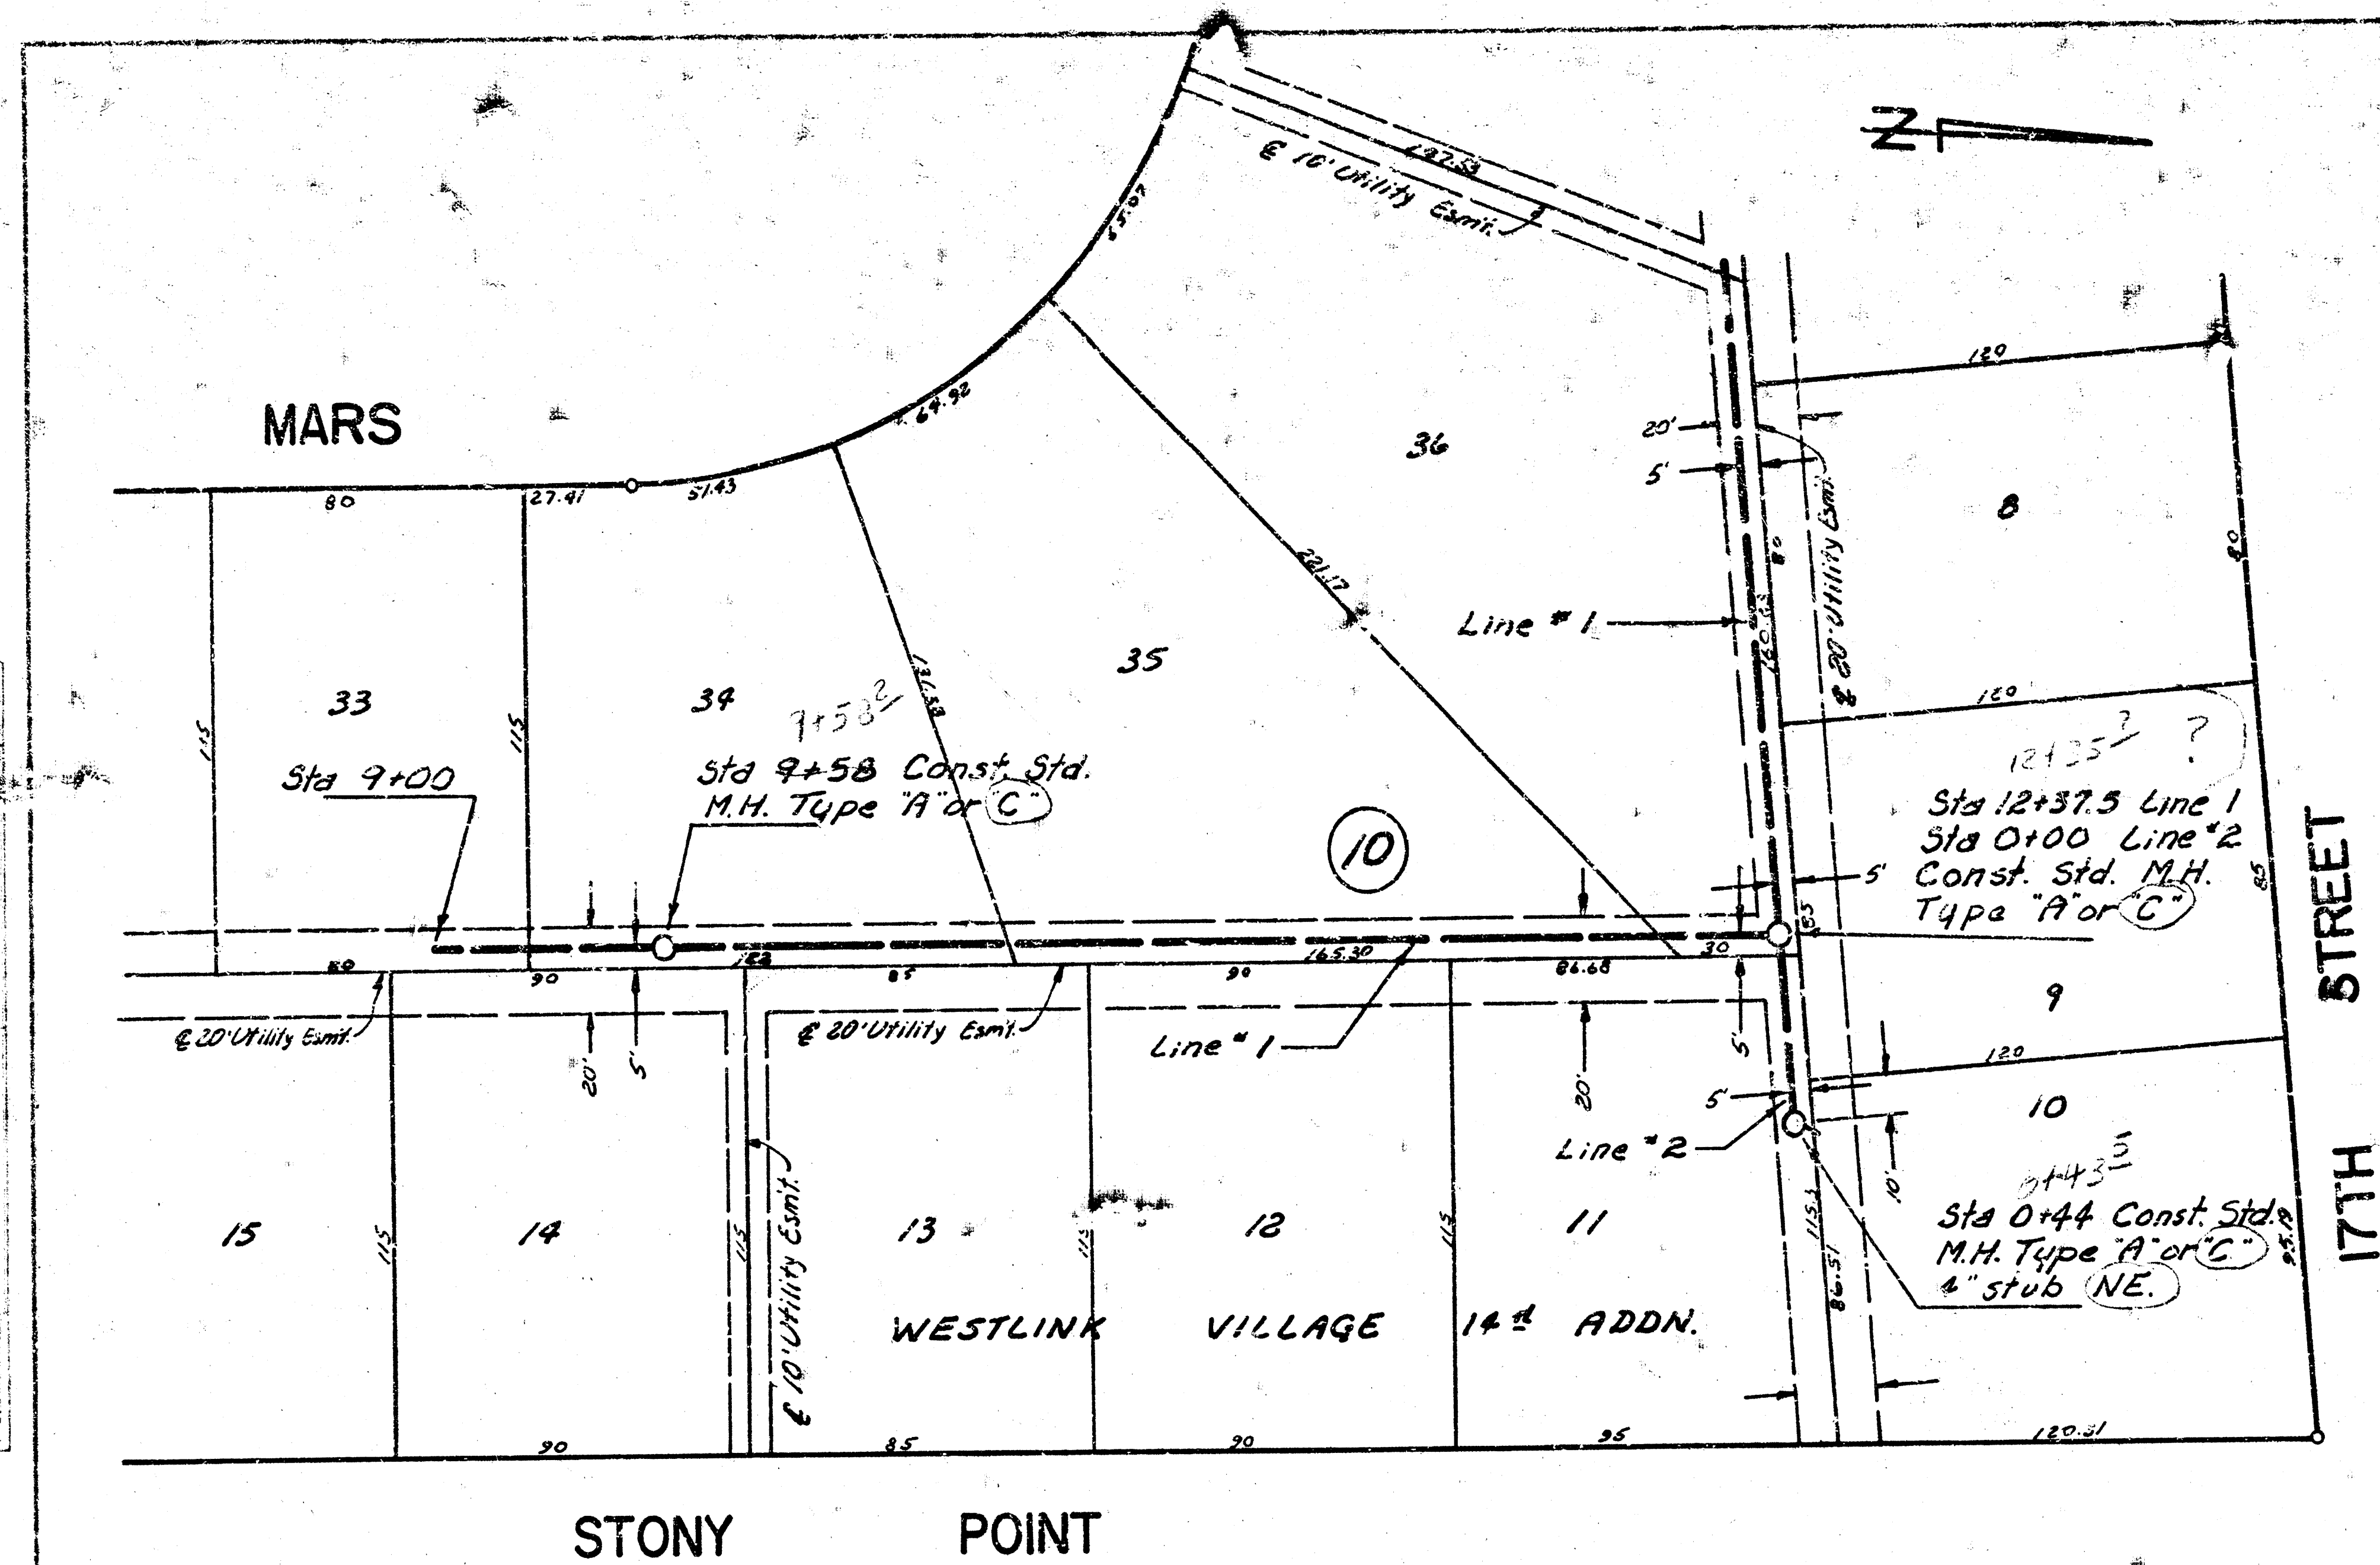

|           |      |    |         |
|-----------|------|----|---------|
| PROFILE   | DATE | BY | CHECKED |
| NOTE BOOK |      |    |         |
|           |      |    |         |

