


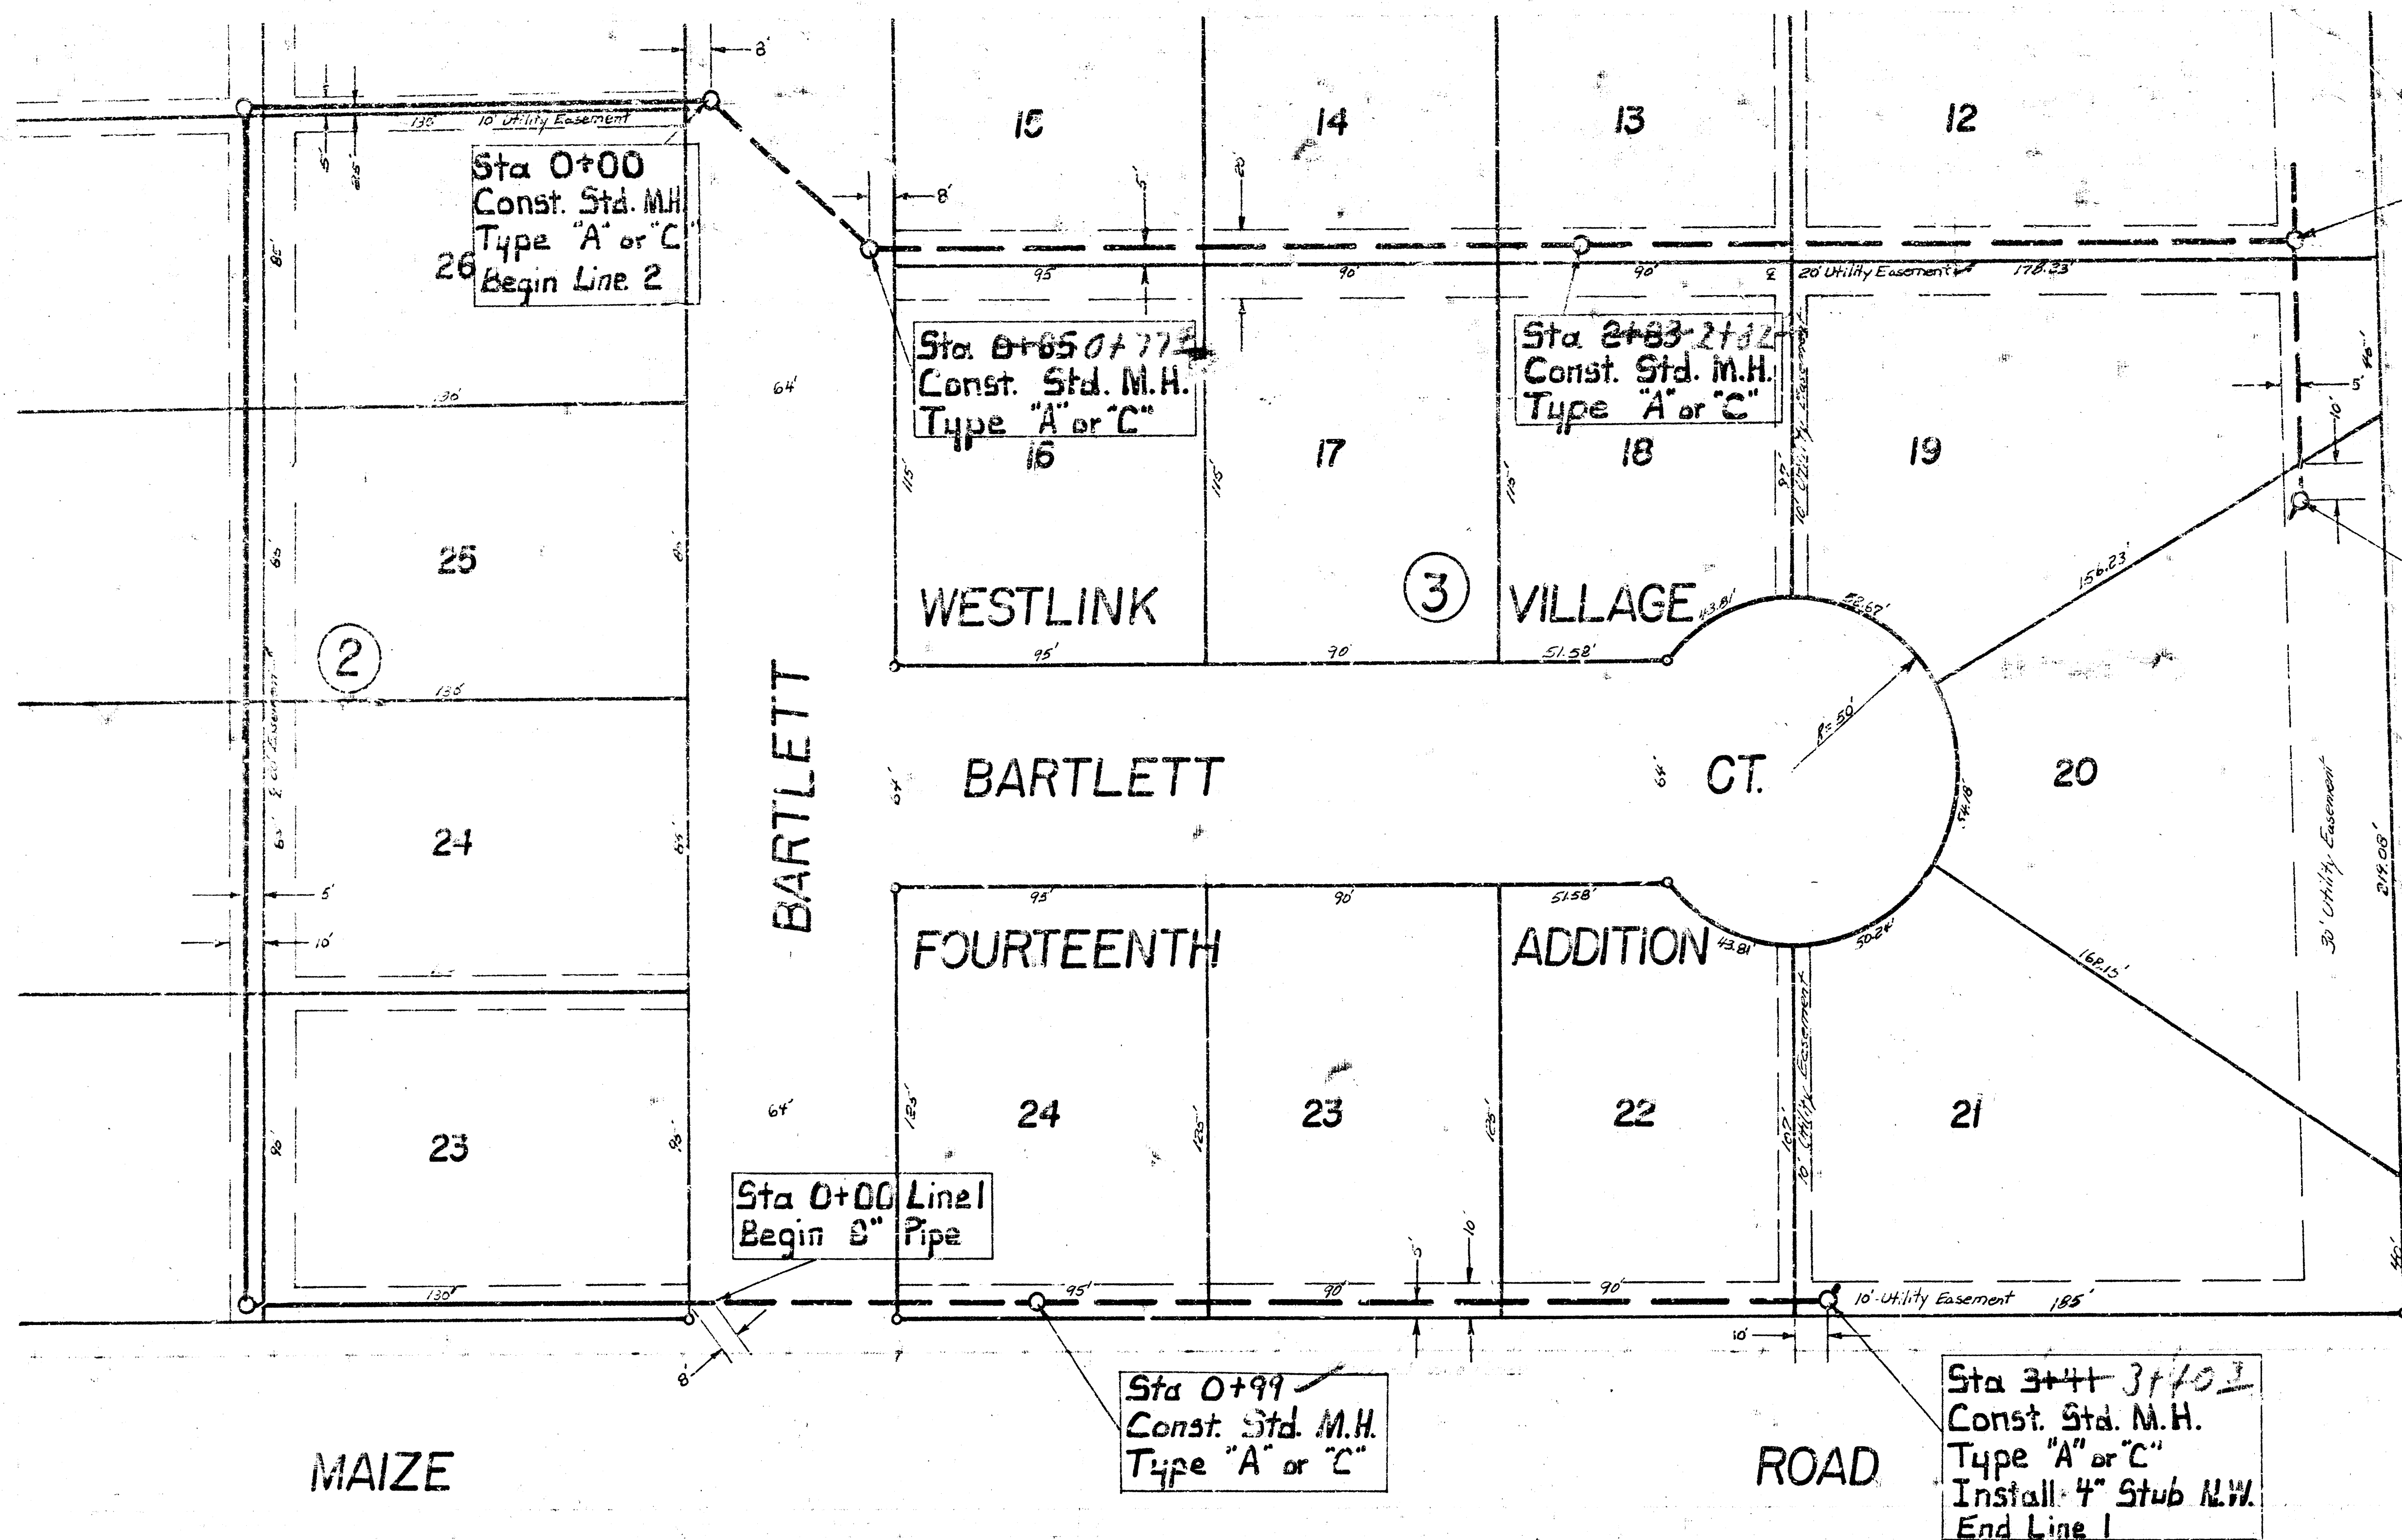

Sta 0+00 5+00
Const. Std. M.H.
Type 'A' or 'C'
Sta 0+00 Line 2A

Sta 5+76
Const. Std. M.H.
Type 'A' or 'C'
Install 4\"/>

Sta 3+41 3+42
Const. Std. M.H.
Type 'A' or 'C'
Install 4\"/>

Sta 0+99
Const. Std. M.H.
Type 'A' or 'C'

Sta 0+00 Line 1
Begin 8\"/>



NOTE: PIPE FROM STATION 1+00 TO 0+00 ON LINE NO. 1 AND FROM STATION 0+00 TO 0+10 ON LINE NO. 2 SHALL BE SAME TYPE OF PIPE AS PIPE SOUTH OF STATIONS 0+00 WHICH IS TO BE INSTALLED BY THE CONTRACTOR FOR LATERAL 100, SOUTHWEST INTERCEPTOR.

BM 162.11 R.R. Spike W. fc. P.P. N.W. cor. Maize Rd. & Bartlett
BM 164.49 R.R. Spike W. fc. P.P. S.W. cor. 17th & Maize Rd.

Plan Scale 1\"/>

MAIZE

ROAD

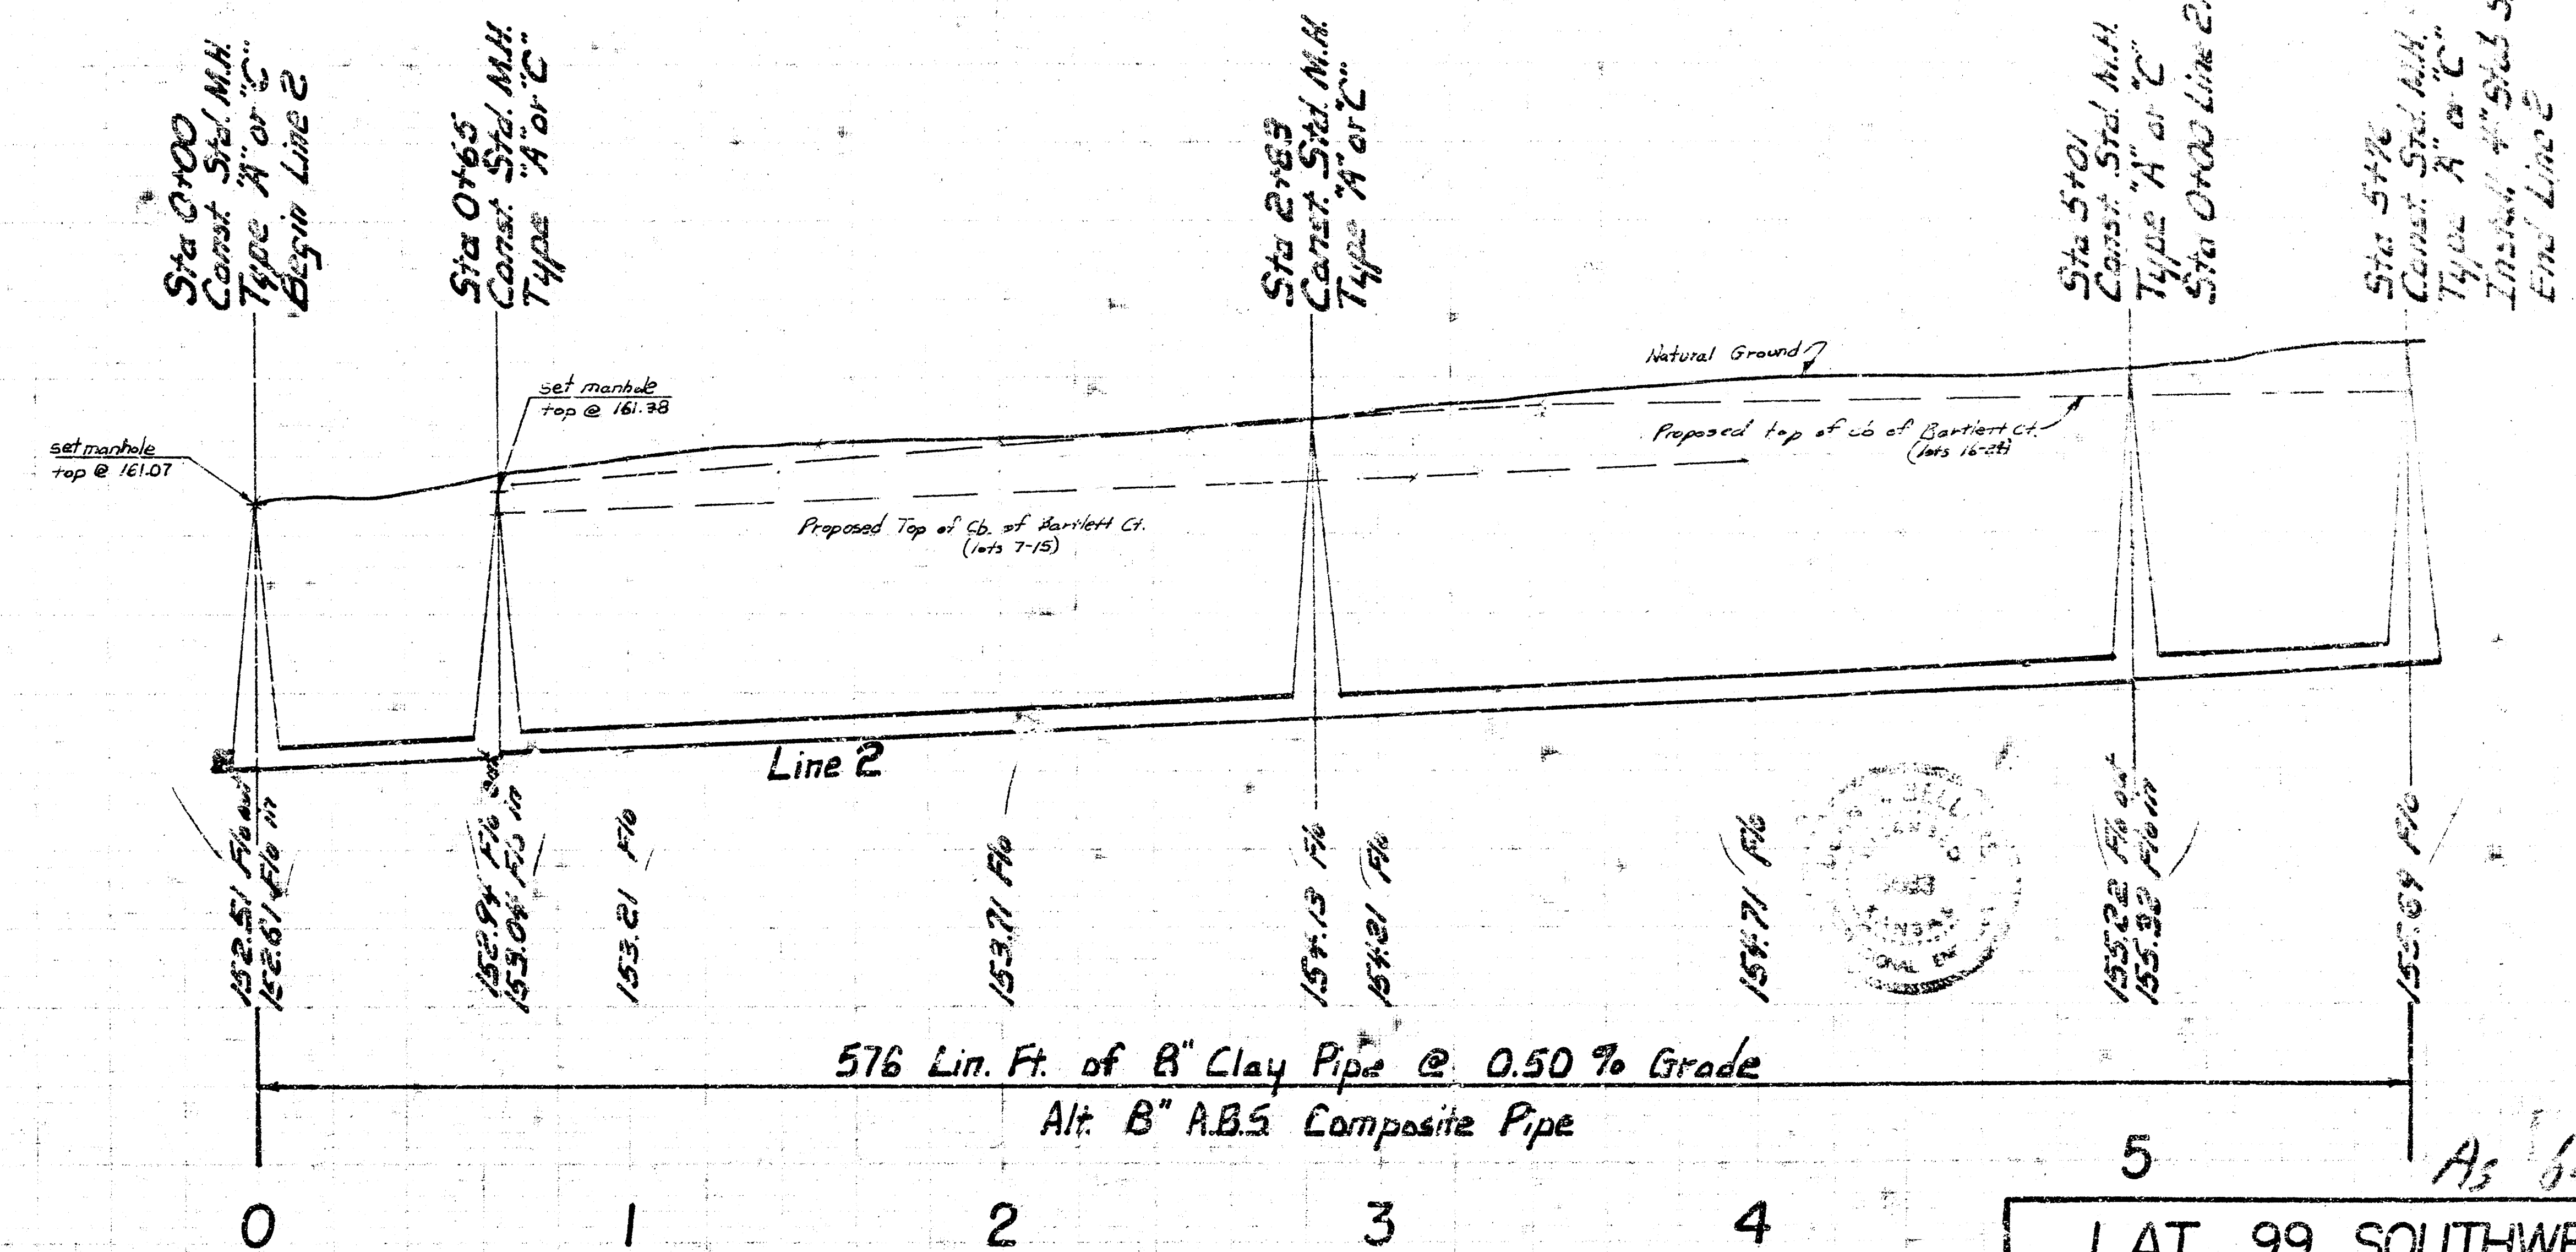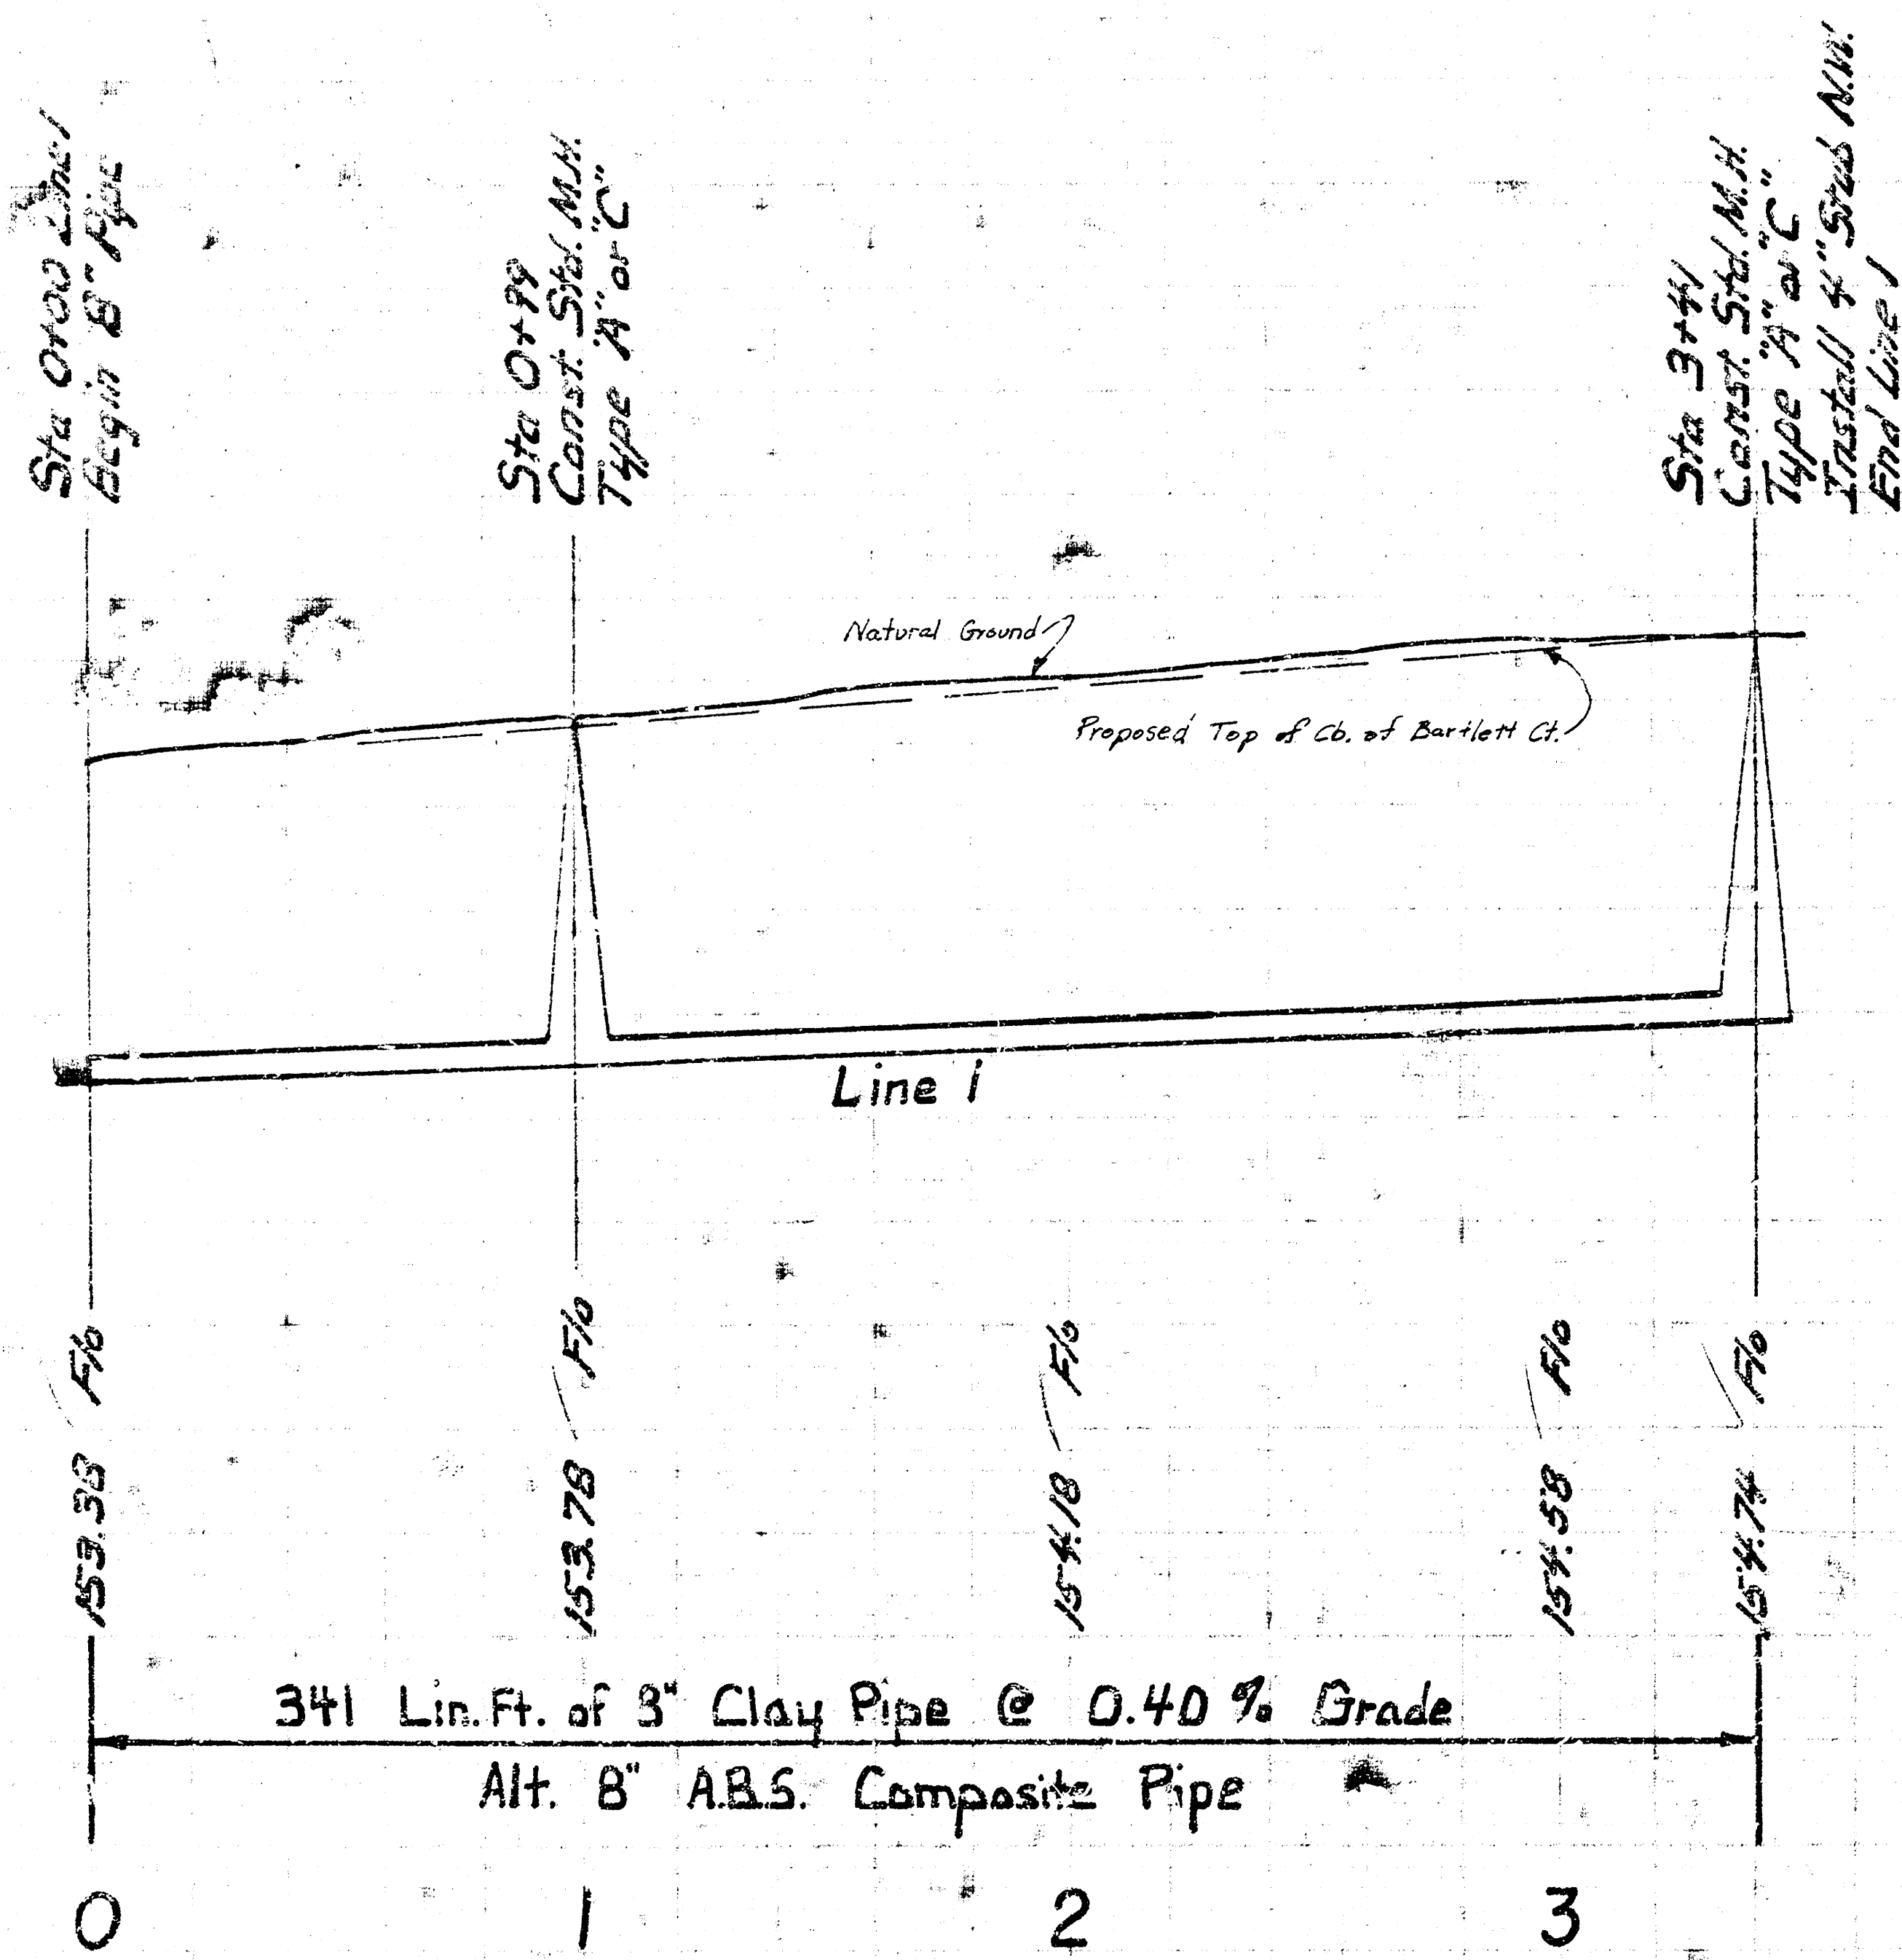

As Built 2-22
LAT 99 SOUTHWEST INTERCEPTOR
CITY OF WICHITA, KANSAS
R.W. LINN
DATE: PROJECT NUMBER: DRK1572

