



NOTE: RISERS OR STUBS IN MANHOLES SHALL BE CONSTRUCTED ON THIS PROJECT TO SERVE LOTS WHERE THE DEPTH OF THE 6" SEWER IS GREATER THAN 10'. STUBS SHALL BE INSTALLED IN MANHOLES AT ELEVATIONS 10' BELOW EXISTING GROUND. RISERS SHALL BE CONSTRUCTED TO AN ELEVATION 10' BELOW EXISTING GROUND ELEVATION. RISER CONSTRUCTION SHALL CONFORM TO THE REQUIREMENTS OF THE SLOPING TRENCH WALL AS SHOWN ON STANDARD RISER DETAIL SHEET. LOCATIONS OF THE ENDS OF THE RISERS SHALL BE MARKED BY FASTENING GREEN PLASTIC COLORED TAPE TO THE END OF THE RISER AND BROUGHT TO THE GROUND SURFACE AS THE EXCAVATION IS BACKFILLED SUCH THAT THE COLORED TAPE WILL BE VISIBLE WHEN THE PROJECT IS COMPLETED.

Plan Scale: 1" = 40'
Profile Scale: 1" = 40' Horiz.
1" = 5' Vert.

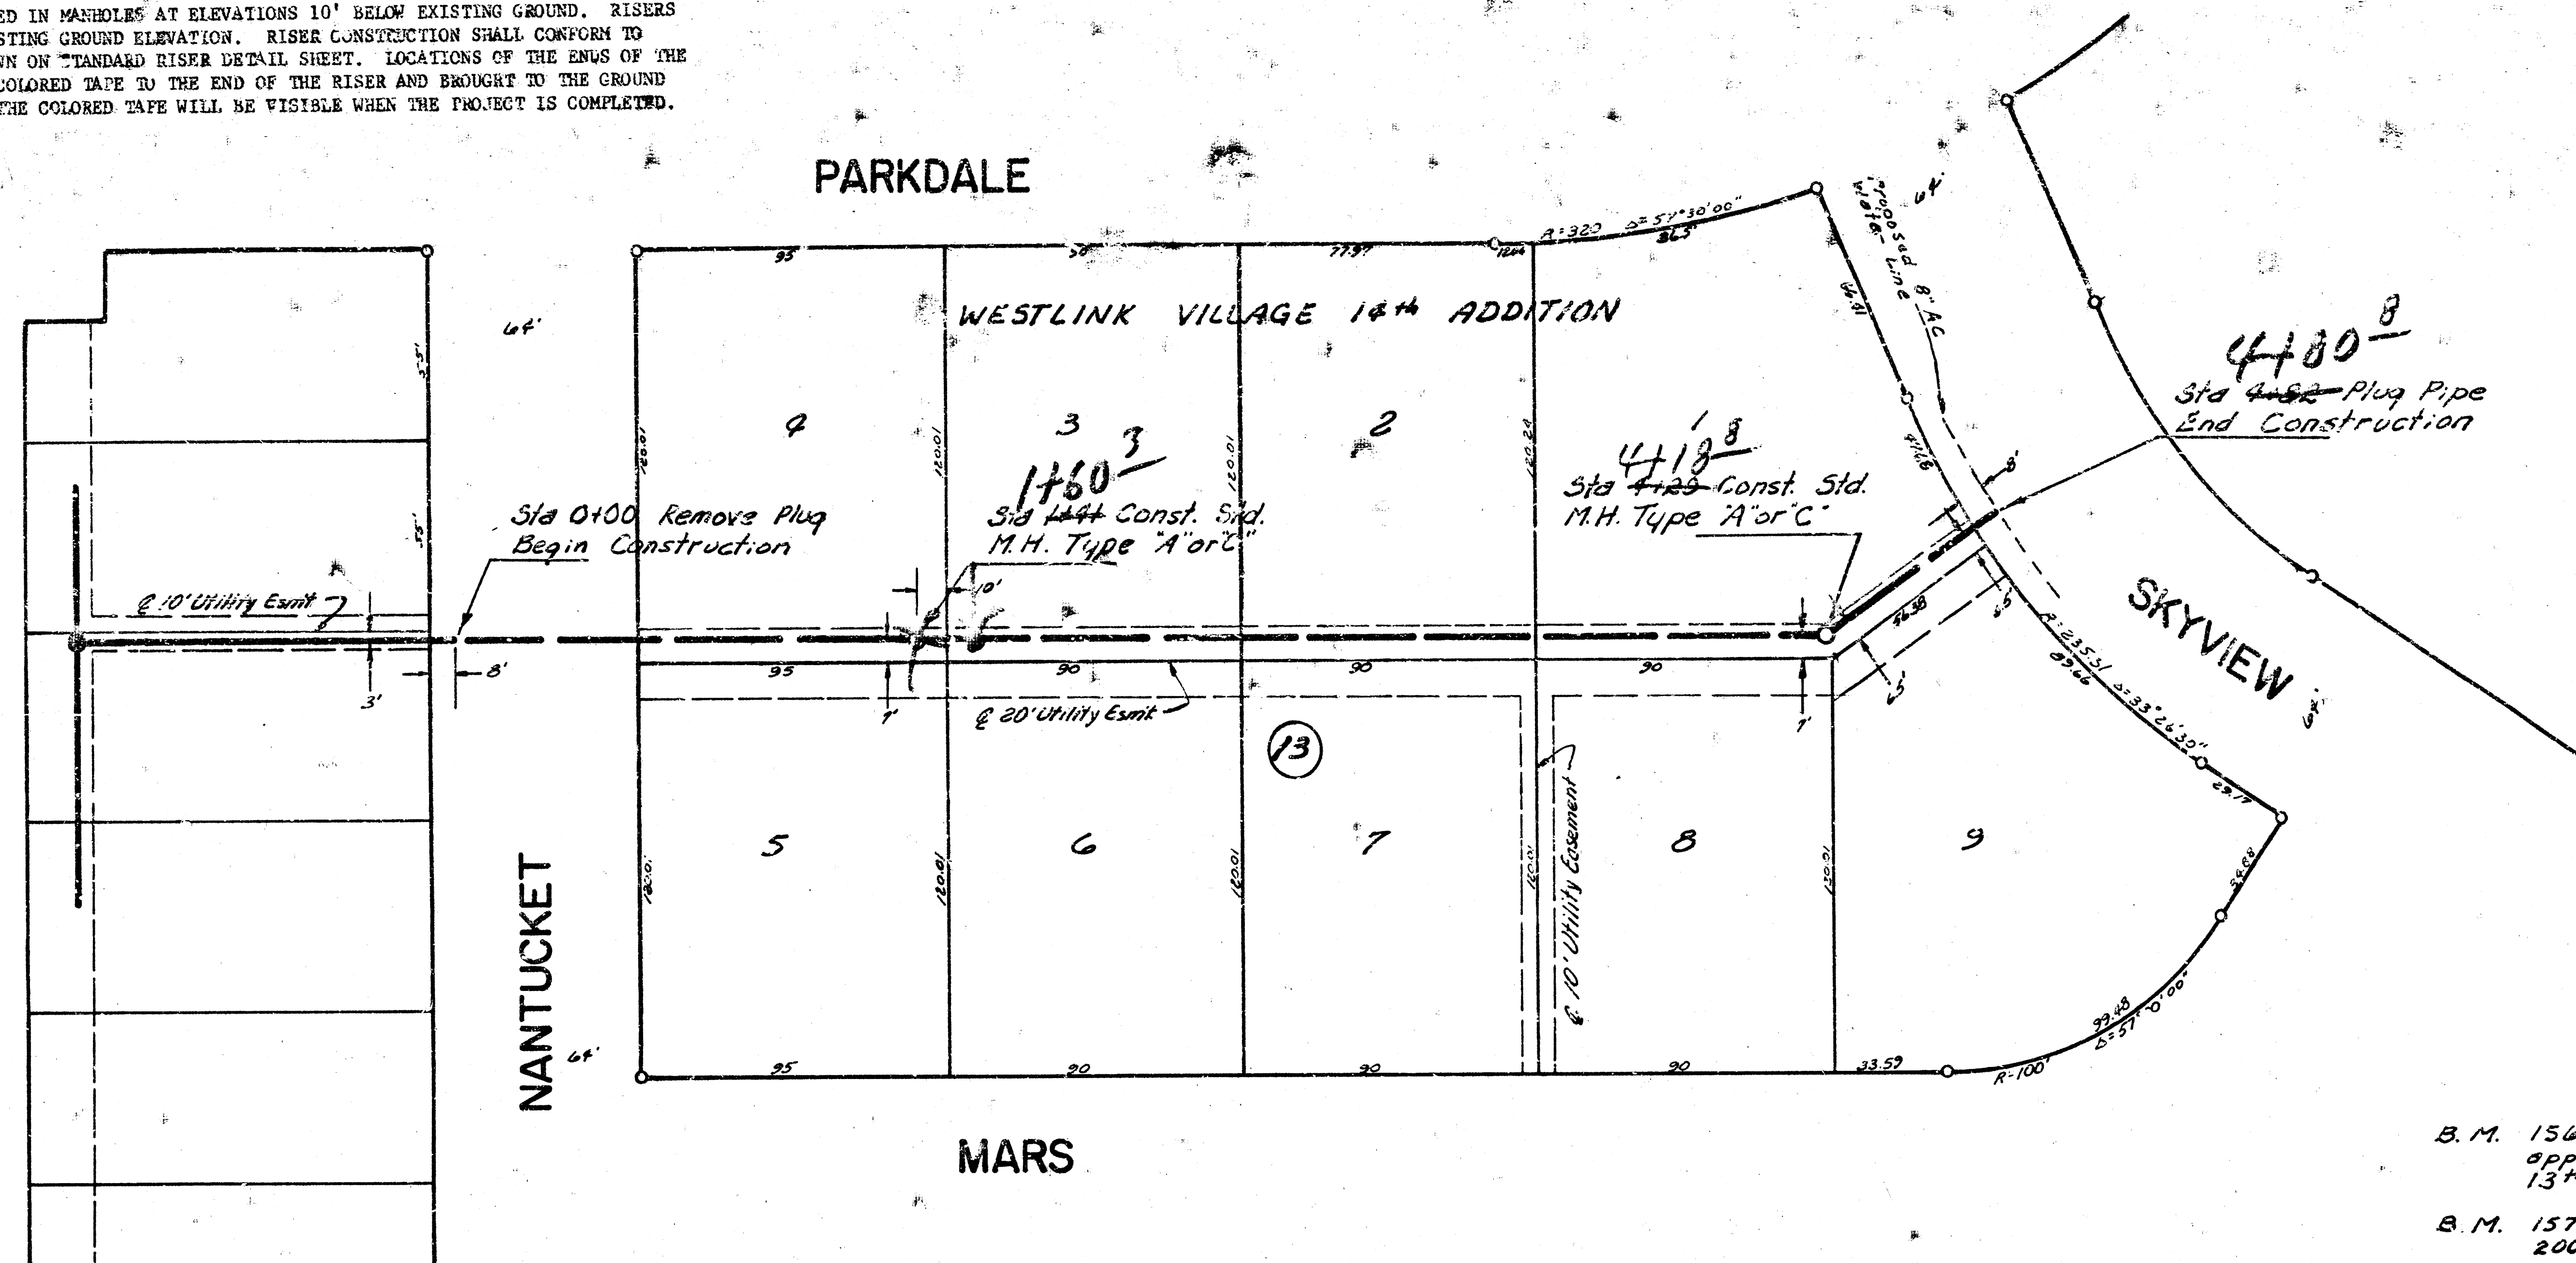

B.M. 156.626 Railroad Spike N. face Power Pole approx. 90' West and 20' south of NW. corner 13th and Parkdale.
B.M. 157.039 R.R. Spike North face Power Pole approx. 200' S. and 100' W. of N.W. corner Nantucket & Lark.

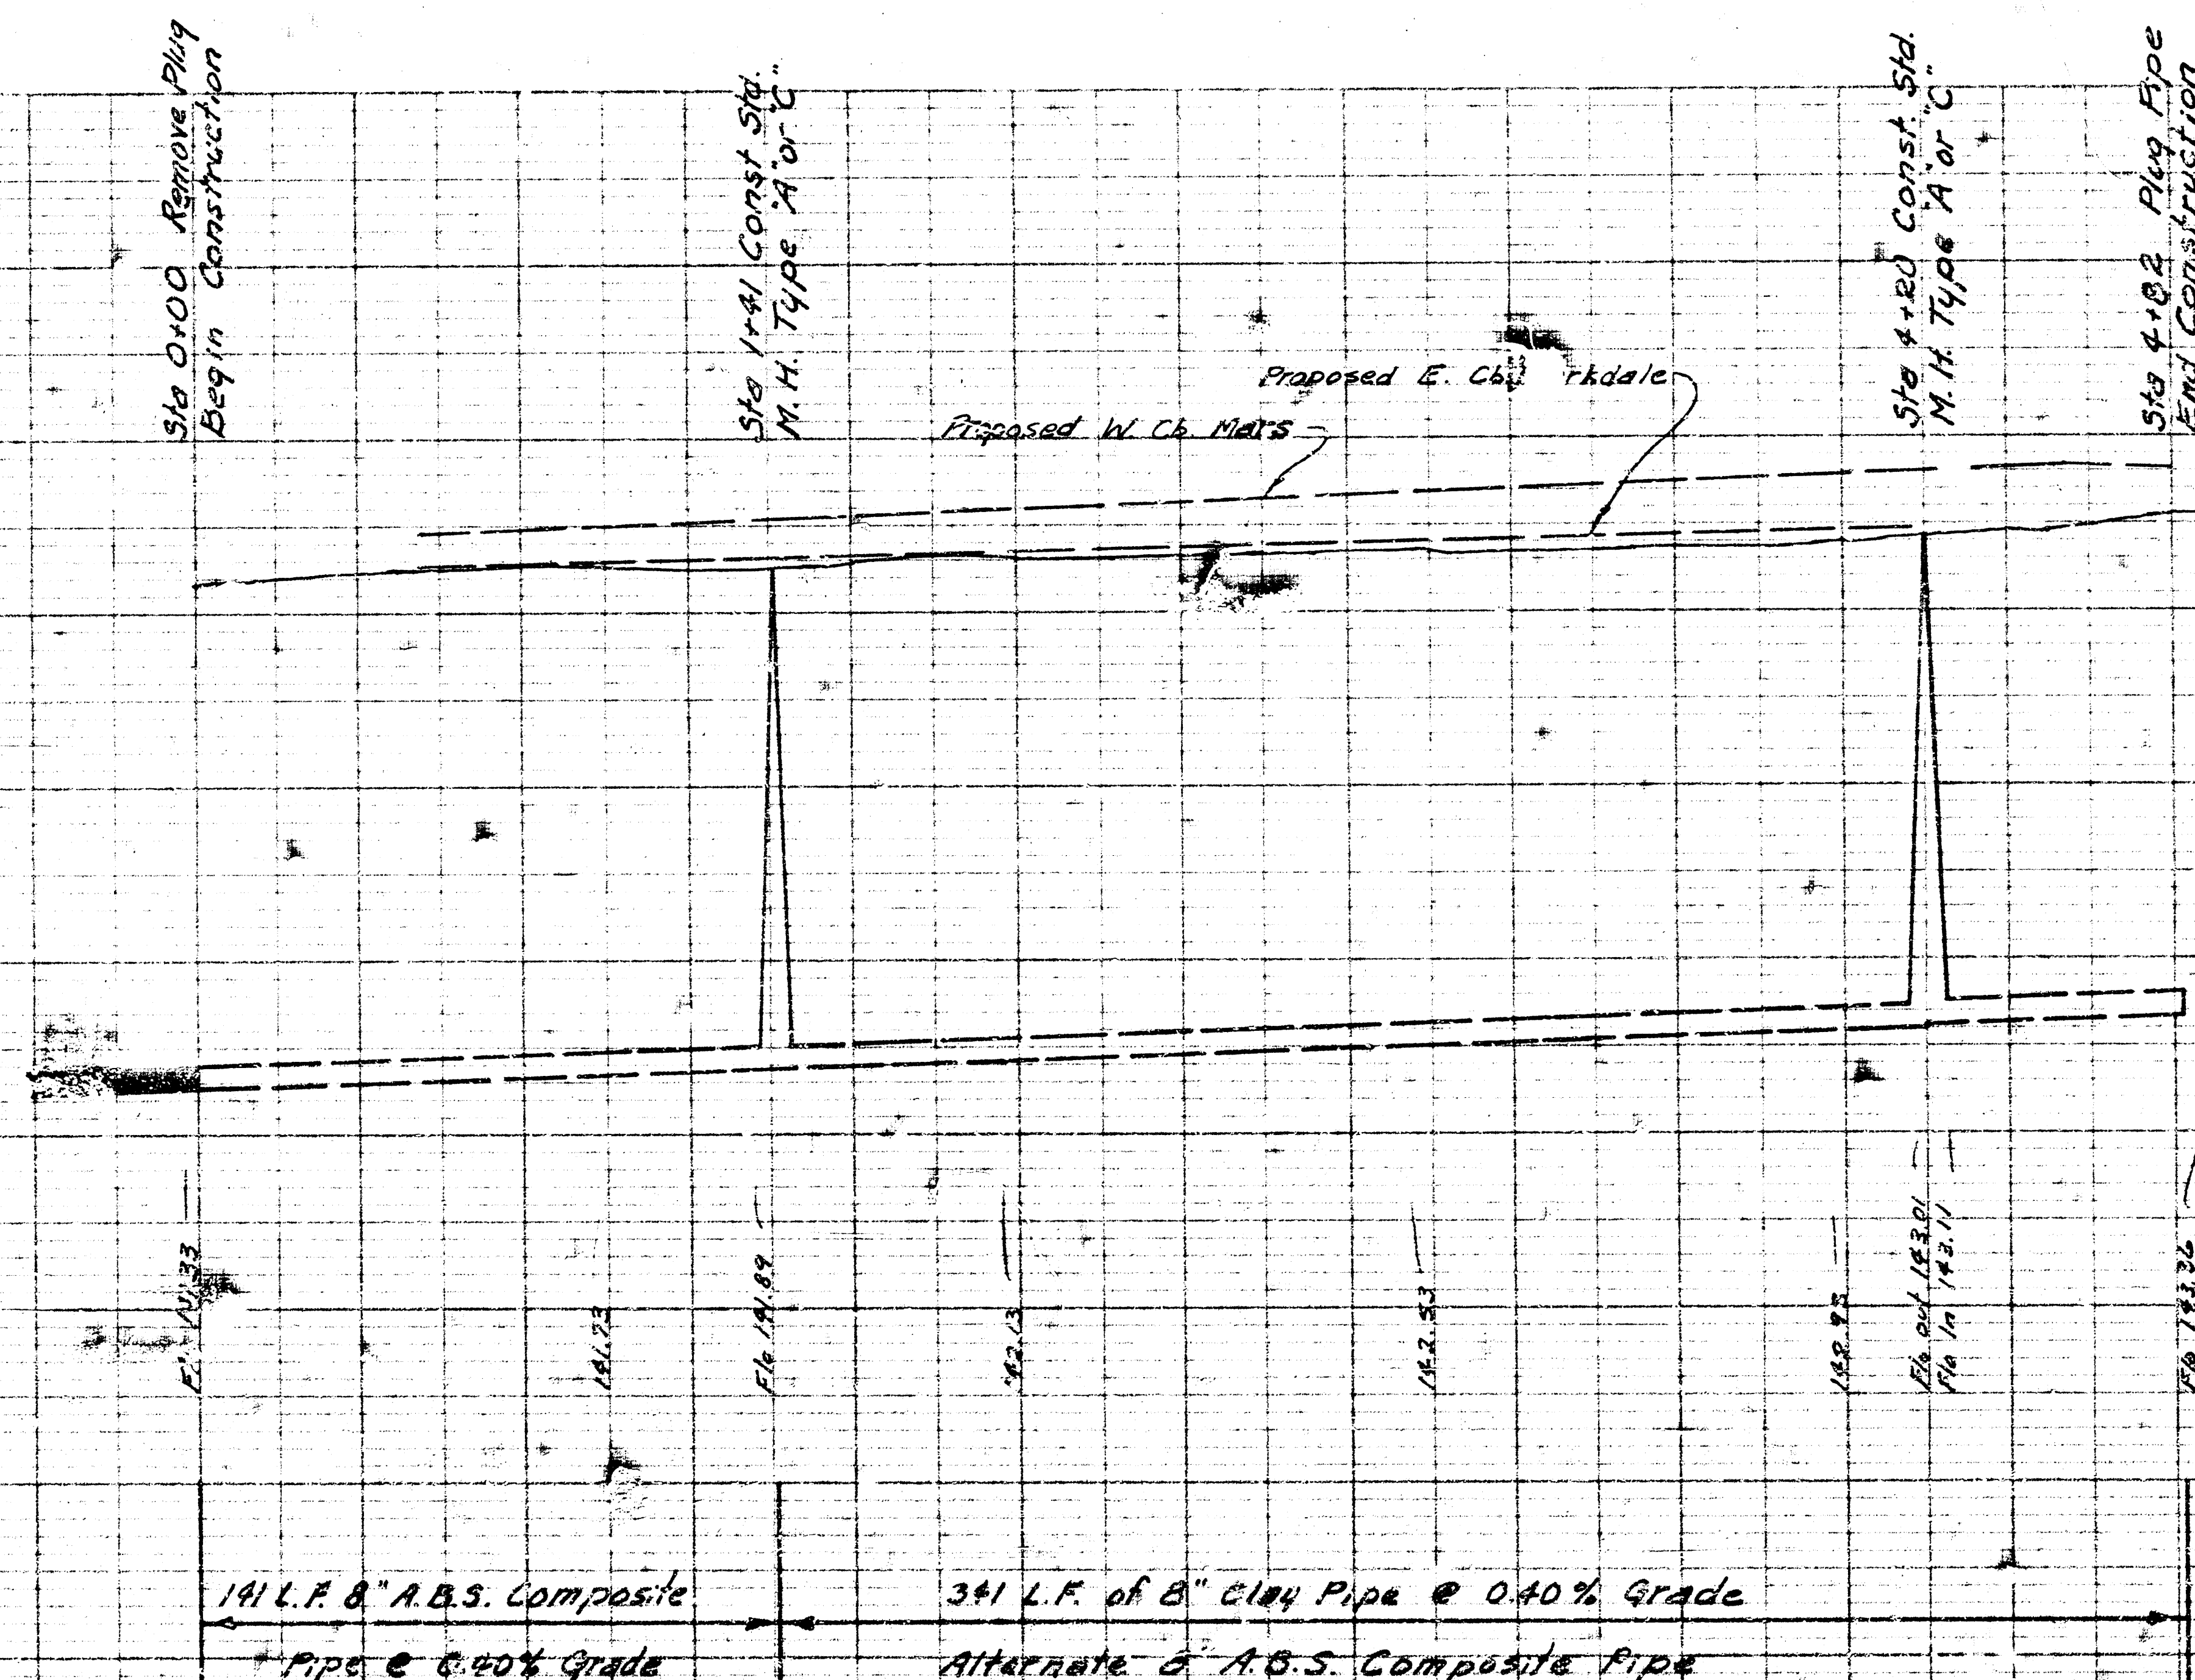

As built 9-7-78

LAT 101 SOUTHWEST INTERCEPTOR
CITY OF WICHITA, KANSAS

R.W. LINN CITY ENGINEER
PROJEC NUMBER: 468-76-245-90336-000-000-001

