



BM 157.04 R.R. spike N. of PP approx. 200' S. & 100' W. of NW cor. Nantucket & Lark (4th PP W. Maize Rd.)

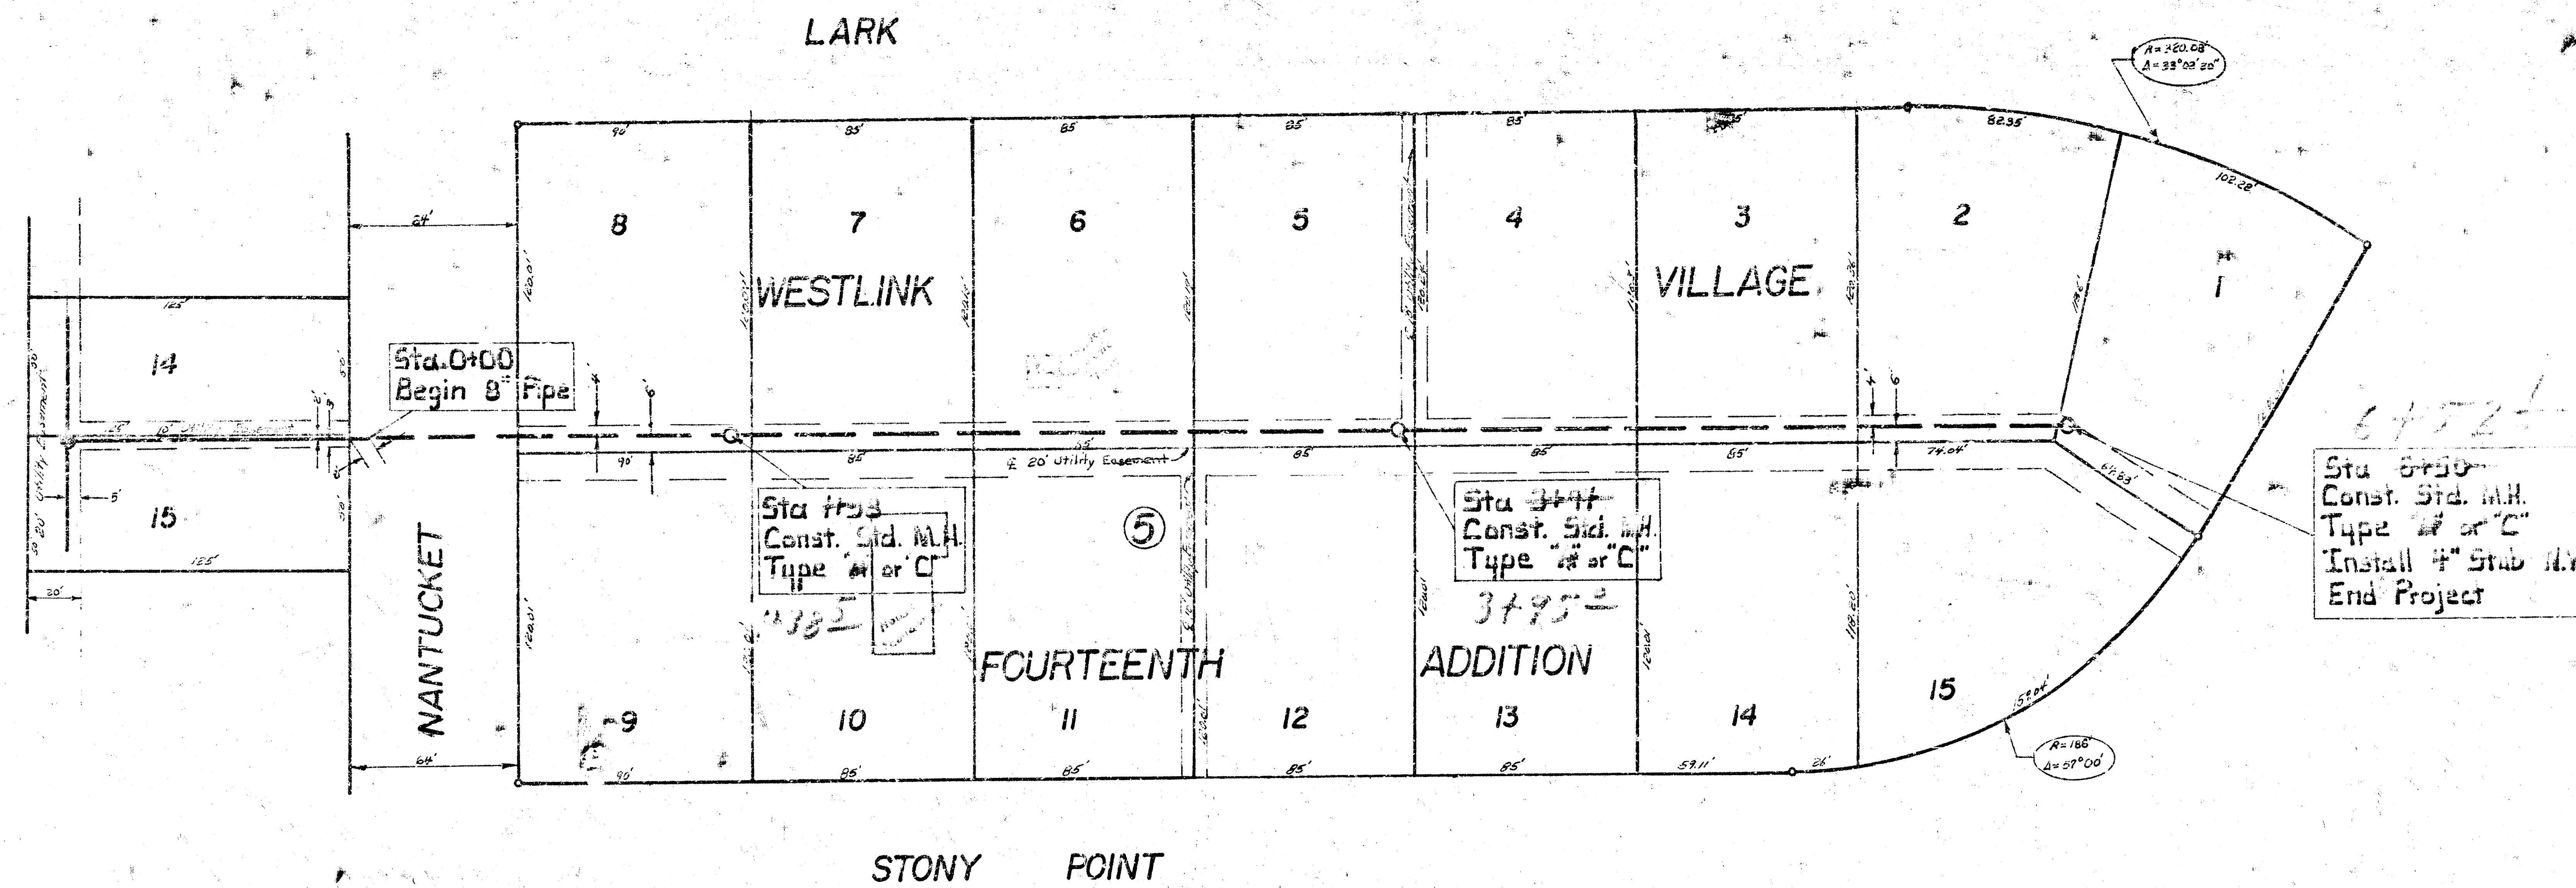

Plan Scale 1" = 40'
Profile Scale 1" = 40' Horiz.
1" = 5' Vert.

NOTE: PIPE BETWEEN STATION 0+00 AND 1+38 SHALL BE SAME TYPE OF PIPE AS PIPE SOUTH OF STATION 0+00 WHICH IS TO BE INSTALLED BY THE CONTRACTOR FOR LATERAL 103, SOUTHWEST INTERCEPTOR.

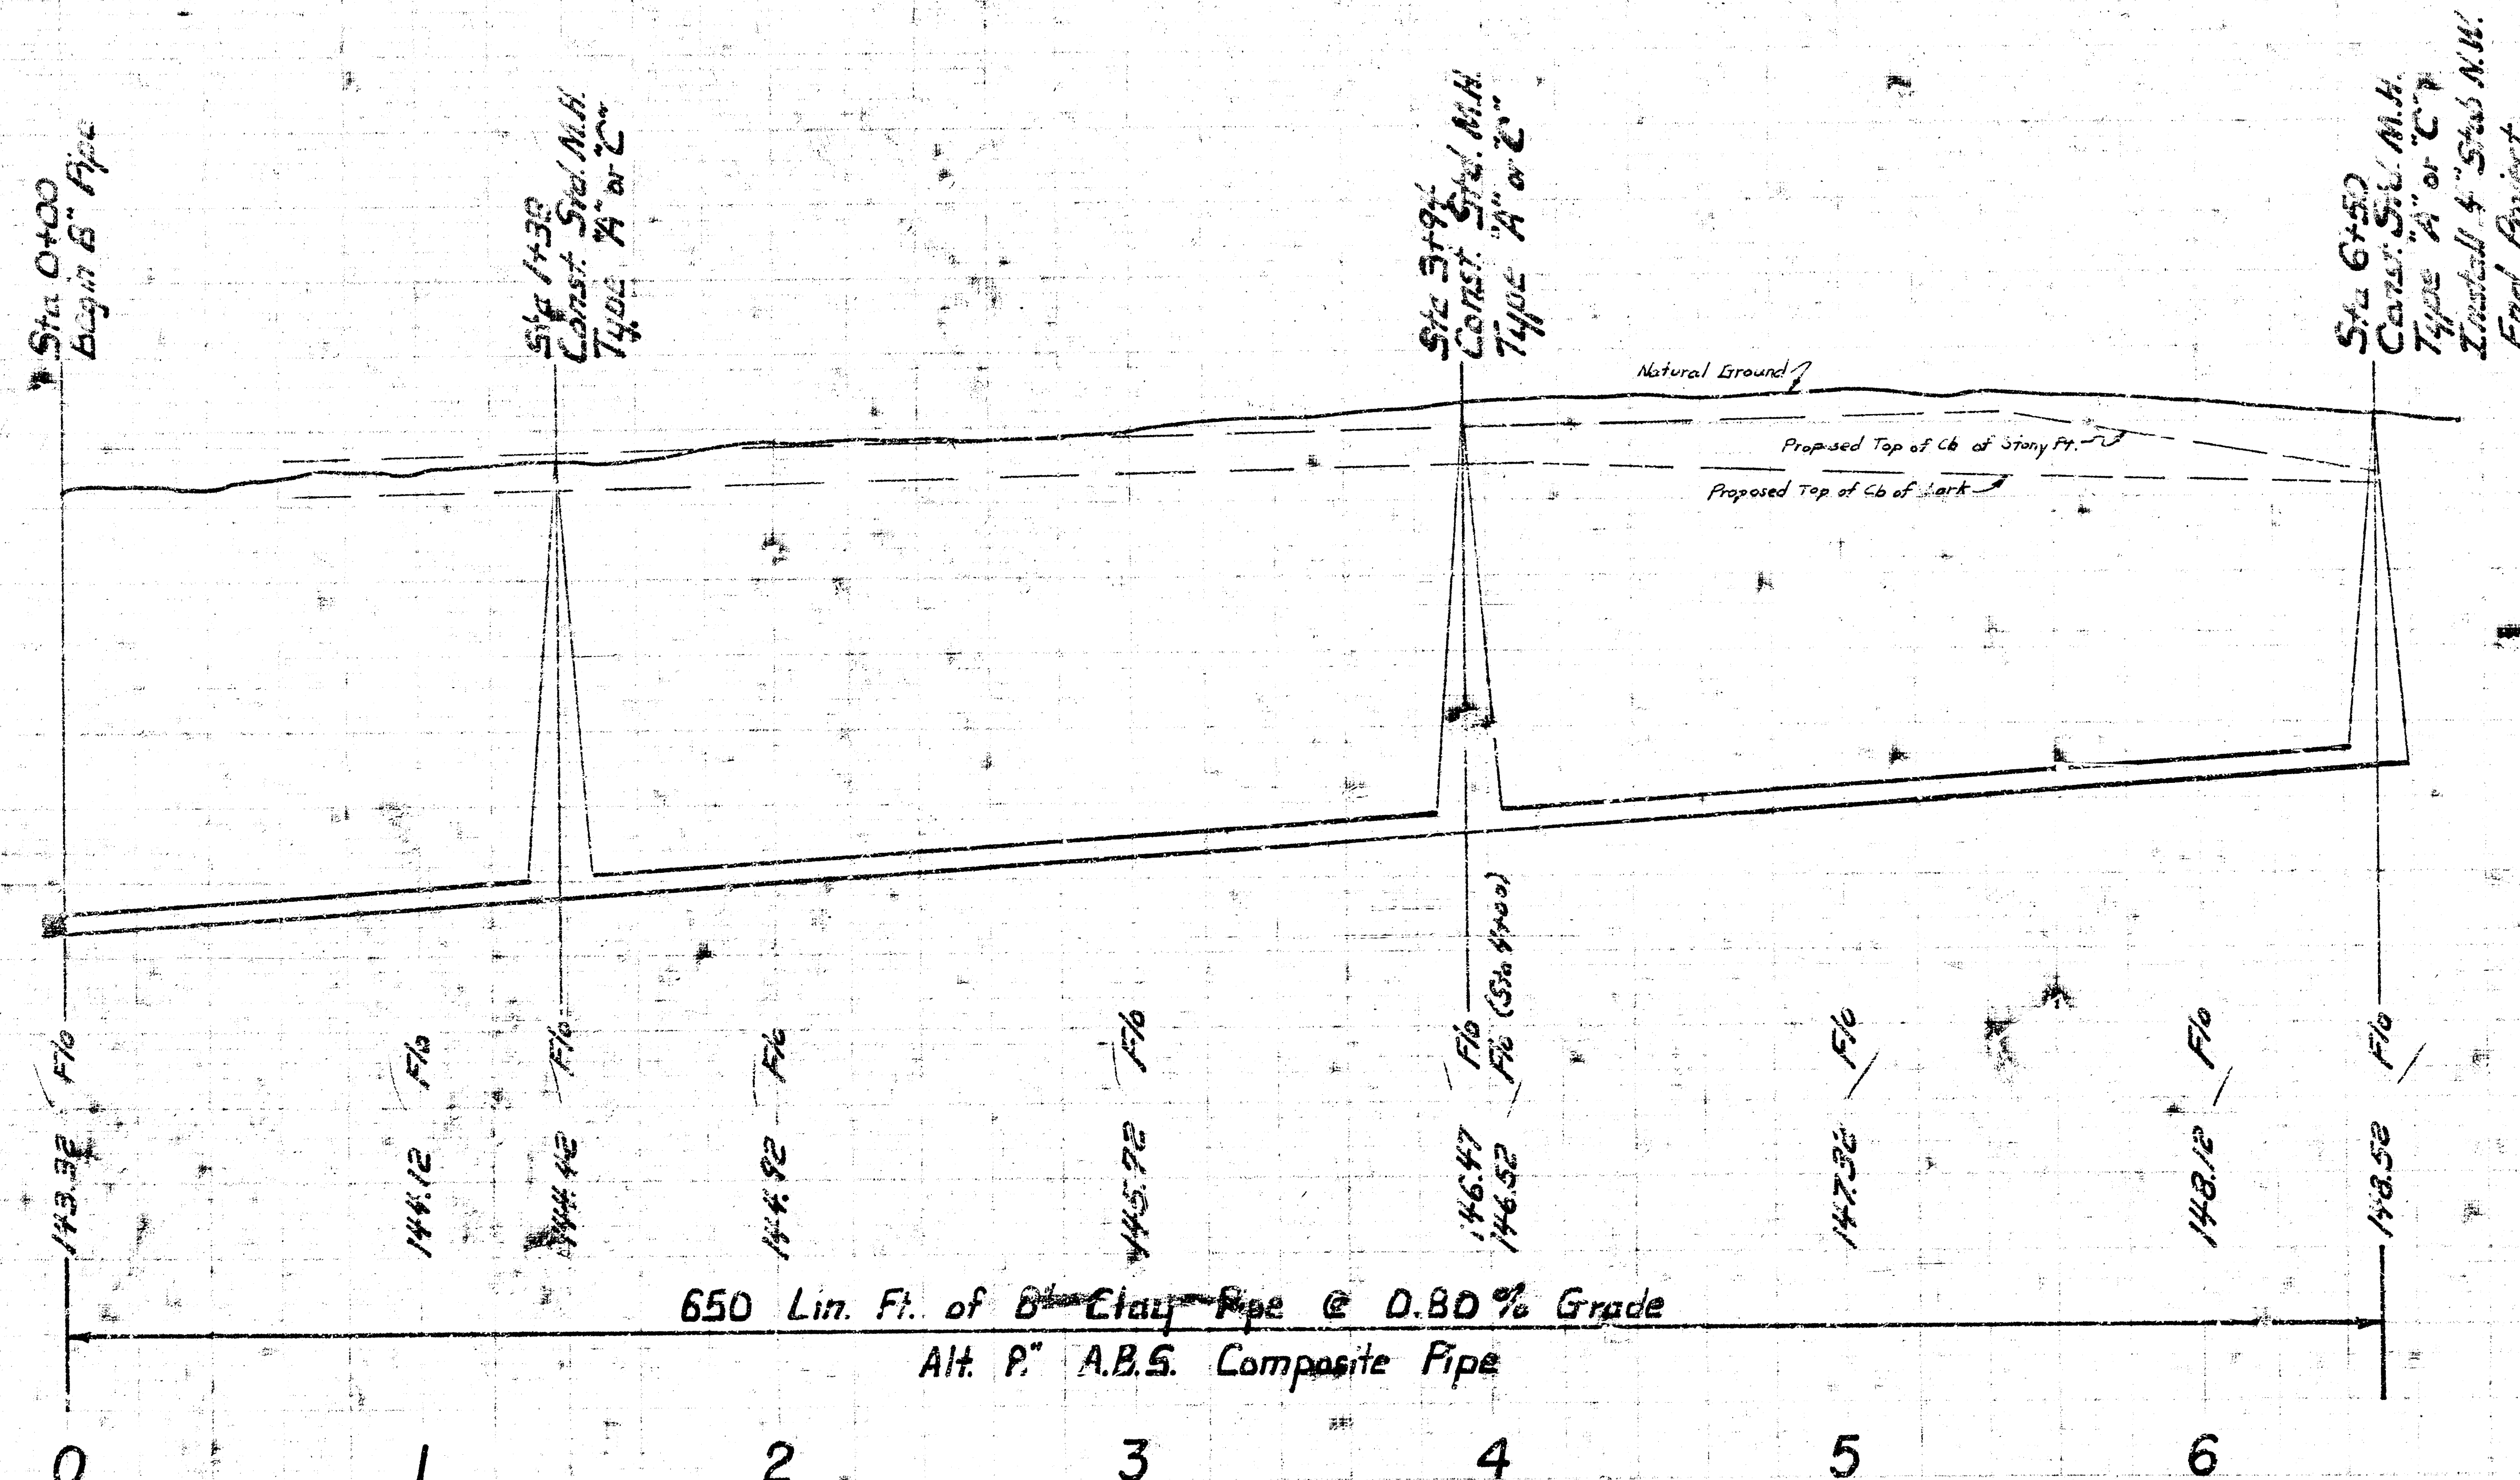

As built 4-24-78

LAT 103 SOUTHWEST INTERCEPTOR
CITY OF WICHITA, KANSAS

R.W. LINN CITY ENGINEER
DATE: PROJECT NUMBER DBKL 577040