

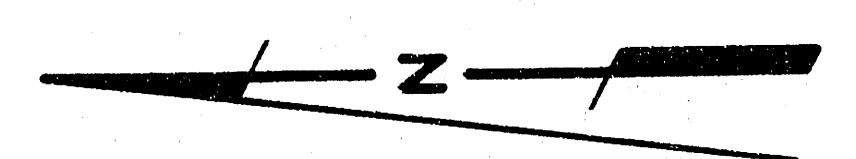


10-80
J. Lindsey
10-80
D. Dallas
J. Lindsey
10-80
D. Dallas
J. Lindsey


CAUTION
UNDERGROUND UTILITIES
Please check with K & L or
Southwestern Bell
Telephone Co. for Location.

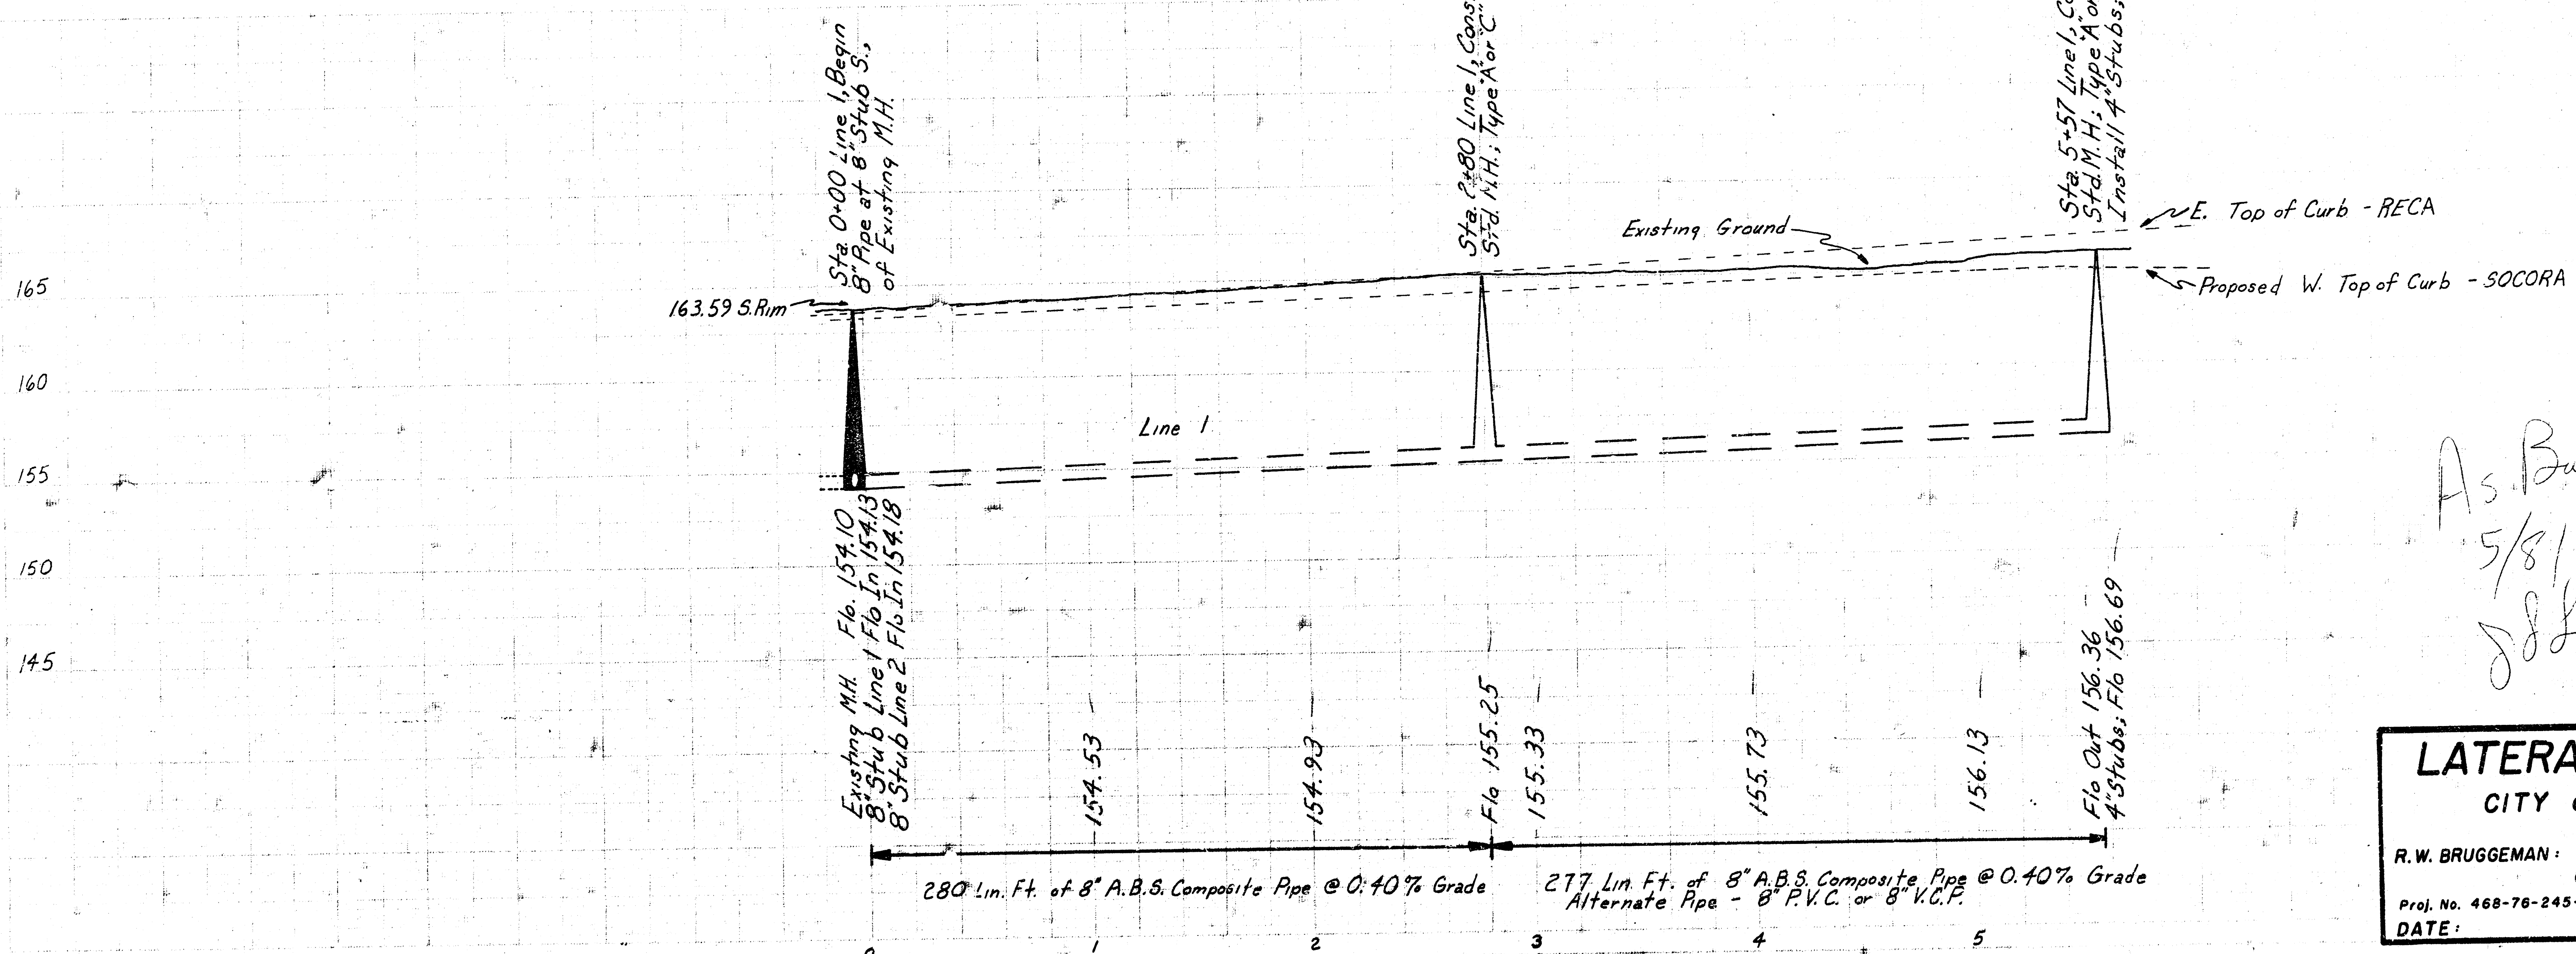

Scale: 1" = 40' Plan
Horz. 1" = 40' Profile
Vert. 1" = 5'
© - Irons -

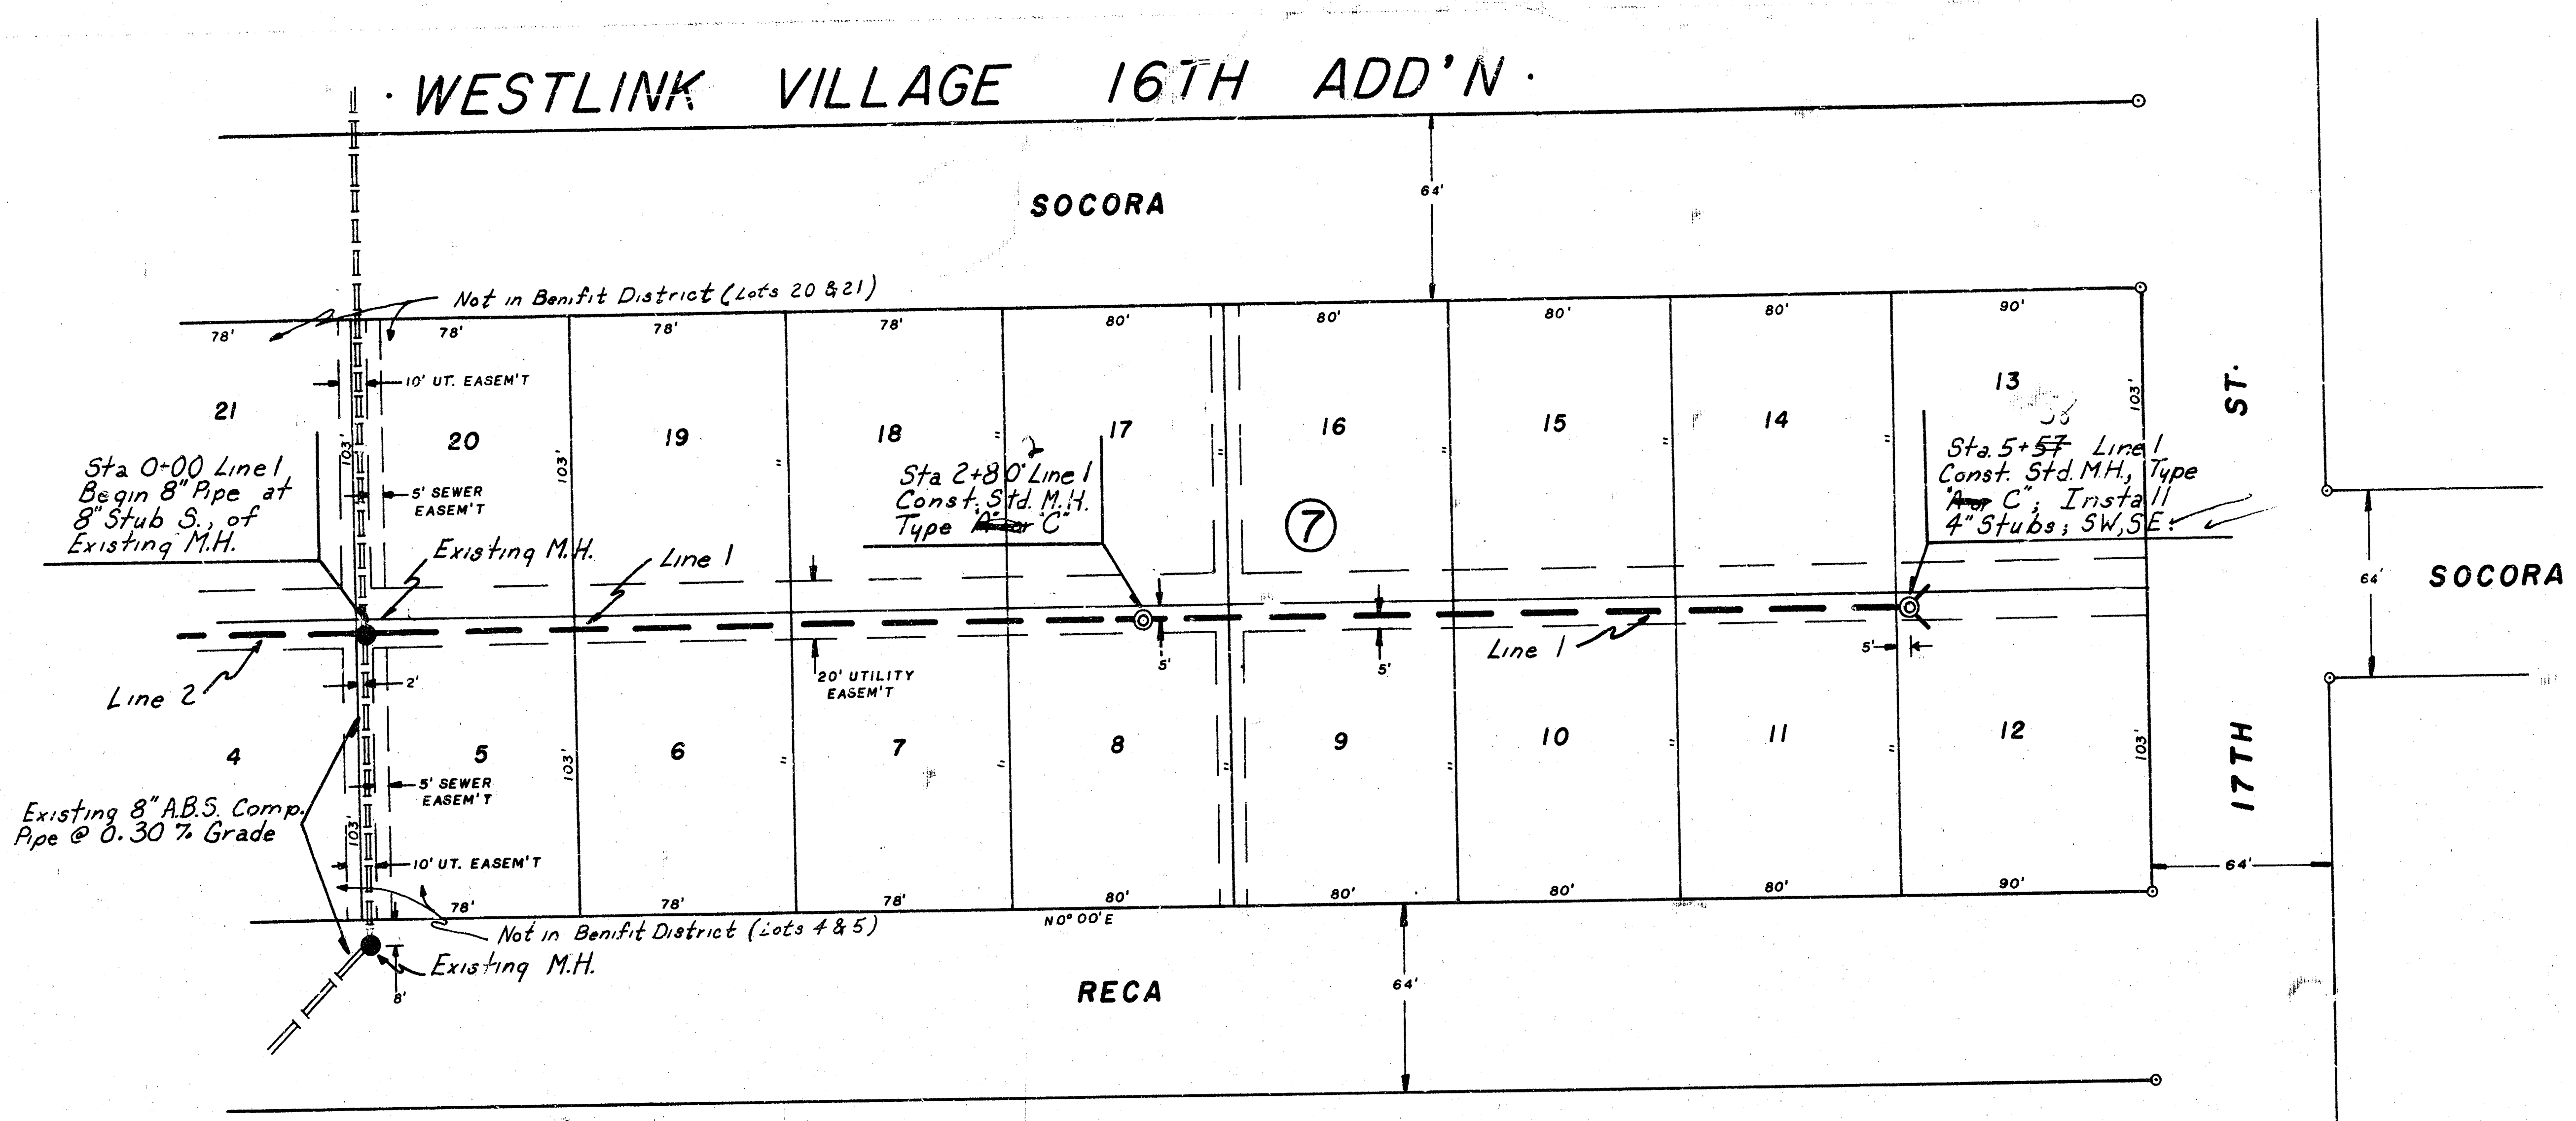

As Built
5/81
JLL

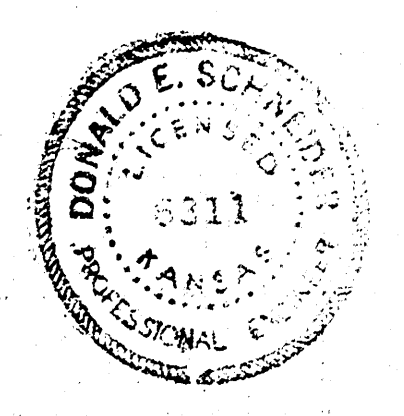

LATERAL 132, S.W.I.
CITY OF WICHITA, KANSAS
R.W. BRUGGEMAN: DIRECTOR OF ENGINEERING / CITY ENGINEER
Proj. No. 468-76-245-80602-000-000-001
DATE: _____ Line 1

9-80
J. Lindsey

9-80
J. Lindsey

D.C.D.M.

