


LAT 140 SOUTHWEST INTERCEPTOR

CITY OF WICHITA

DEAN SELLERS - CITY ENGINEER


PROJECT NO. 468-76-245-80681-000-000-001

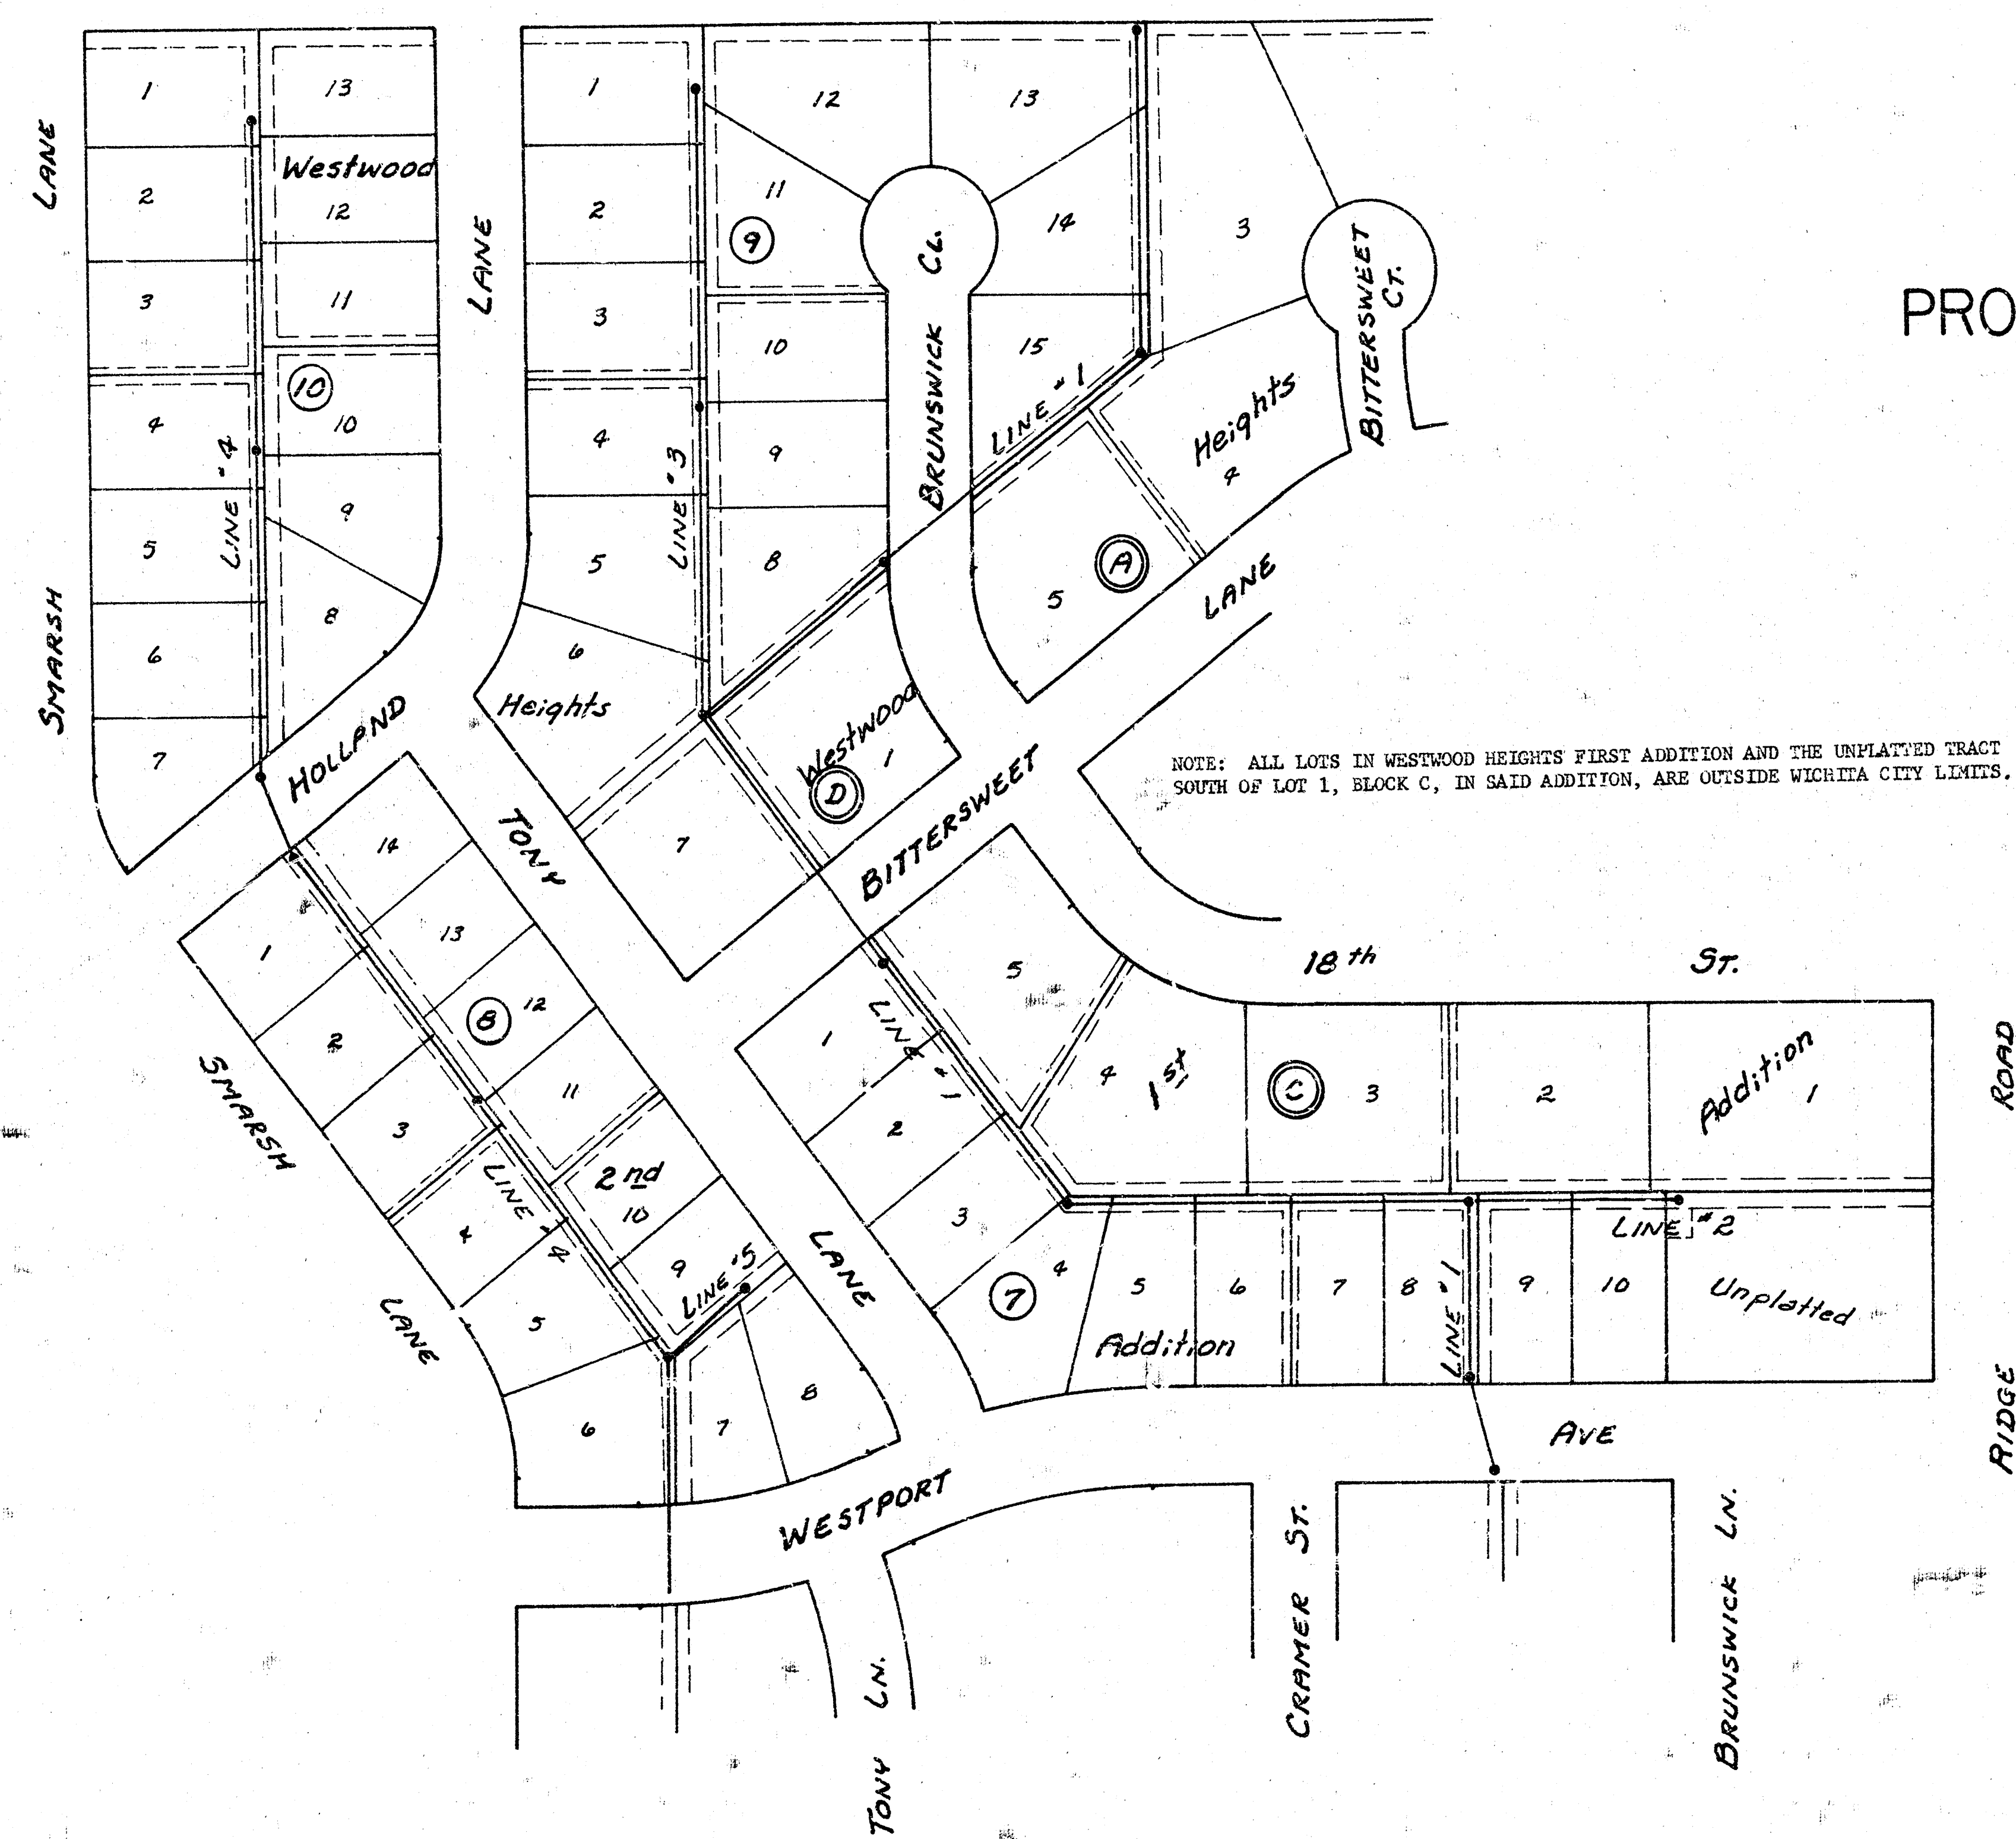

LINE #1	SHEETS 2-3
LINE #2	SHEET 3
LINE #3	SHEET 4
LINE #4	SHEETS 4-5
LINE #5	SHEET 4


NOTE: CONTRACTOR SHALL GIVE OWNERS OF DEVELOPED PROPERTY SERVED BY THIS PROJECT A MINIMUM ADVANCE NOTICE OF 48 HOURS PRIOR TO START OF CONSTRUCTION. THIS PROJECT SHALL BE COORDINATED WITH THE PROJECT LAT. 138, SOUTHWEST INTERCEPTOR. FIELD ENGINEER SHALL SET TOPS OF PARBOLLS TO MATCH PROPOSED FINISHED GRADE AS DETERMINED BY THE DEVELOPER.

As Built
7/81
J.S.

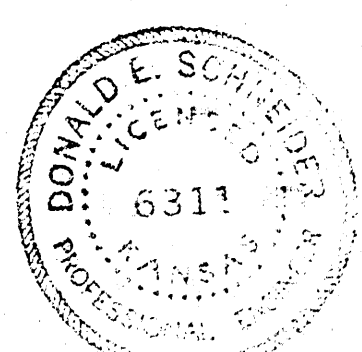



Revised 2-7-80

Sheet 1 of 5

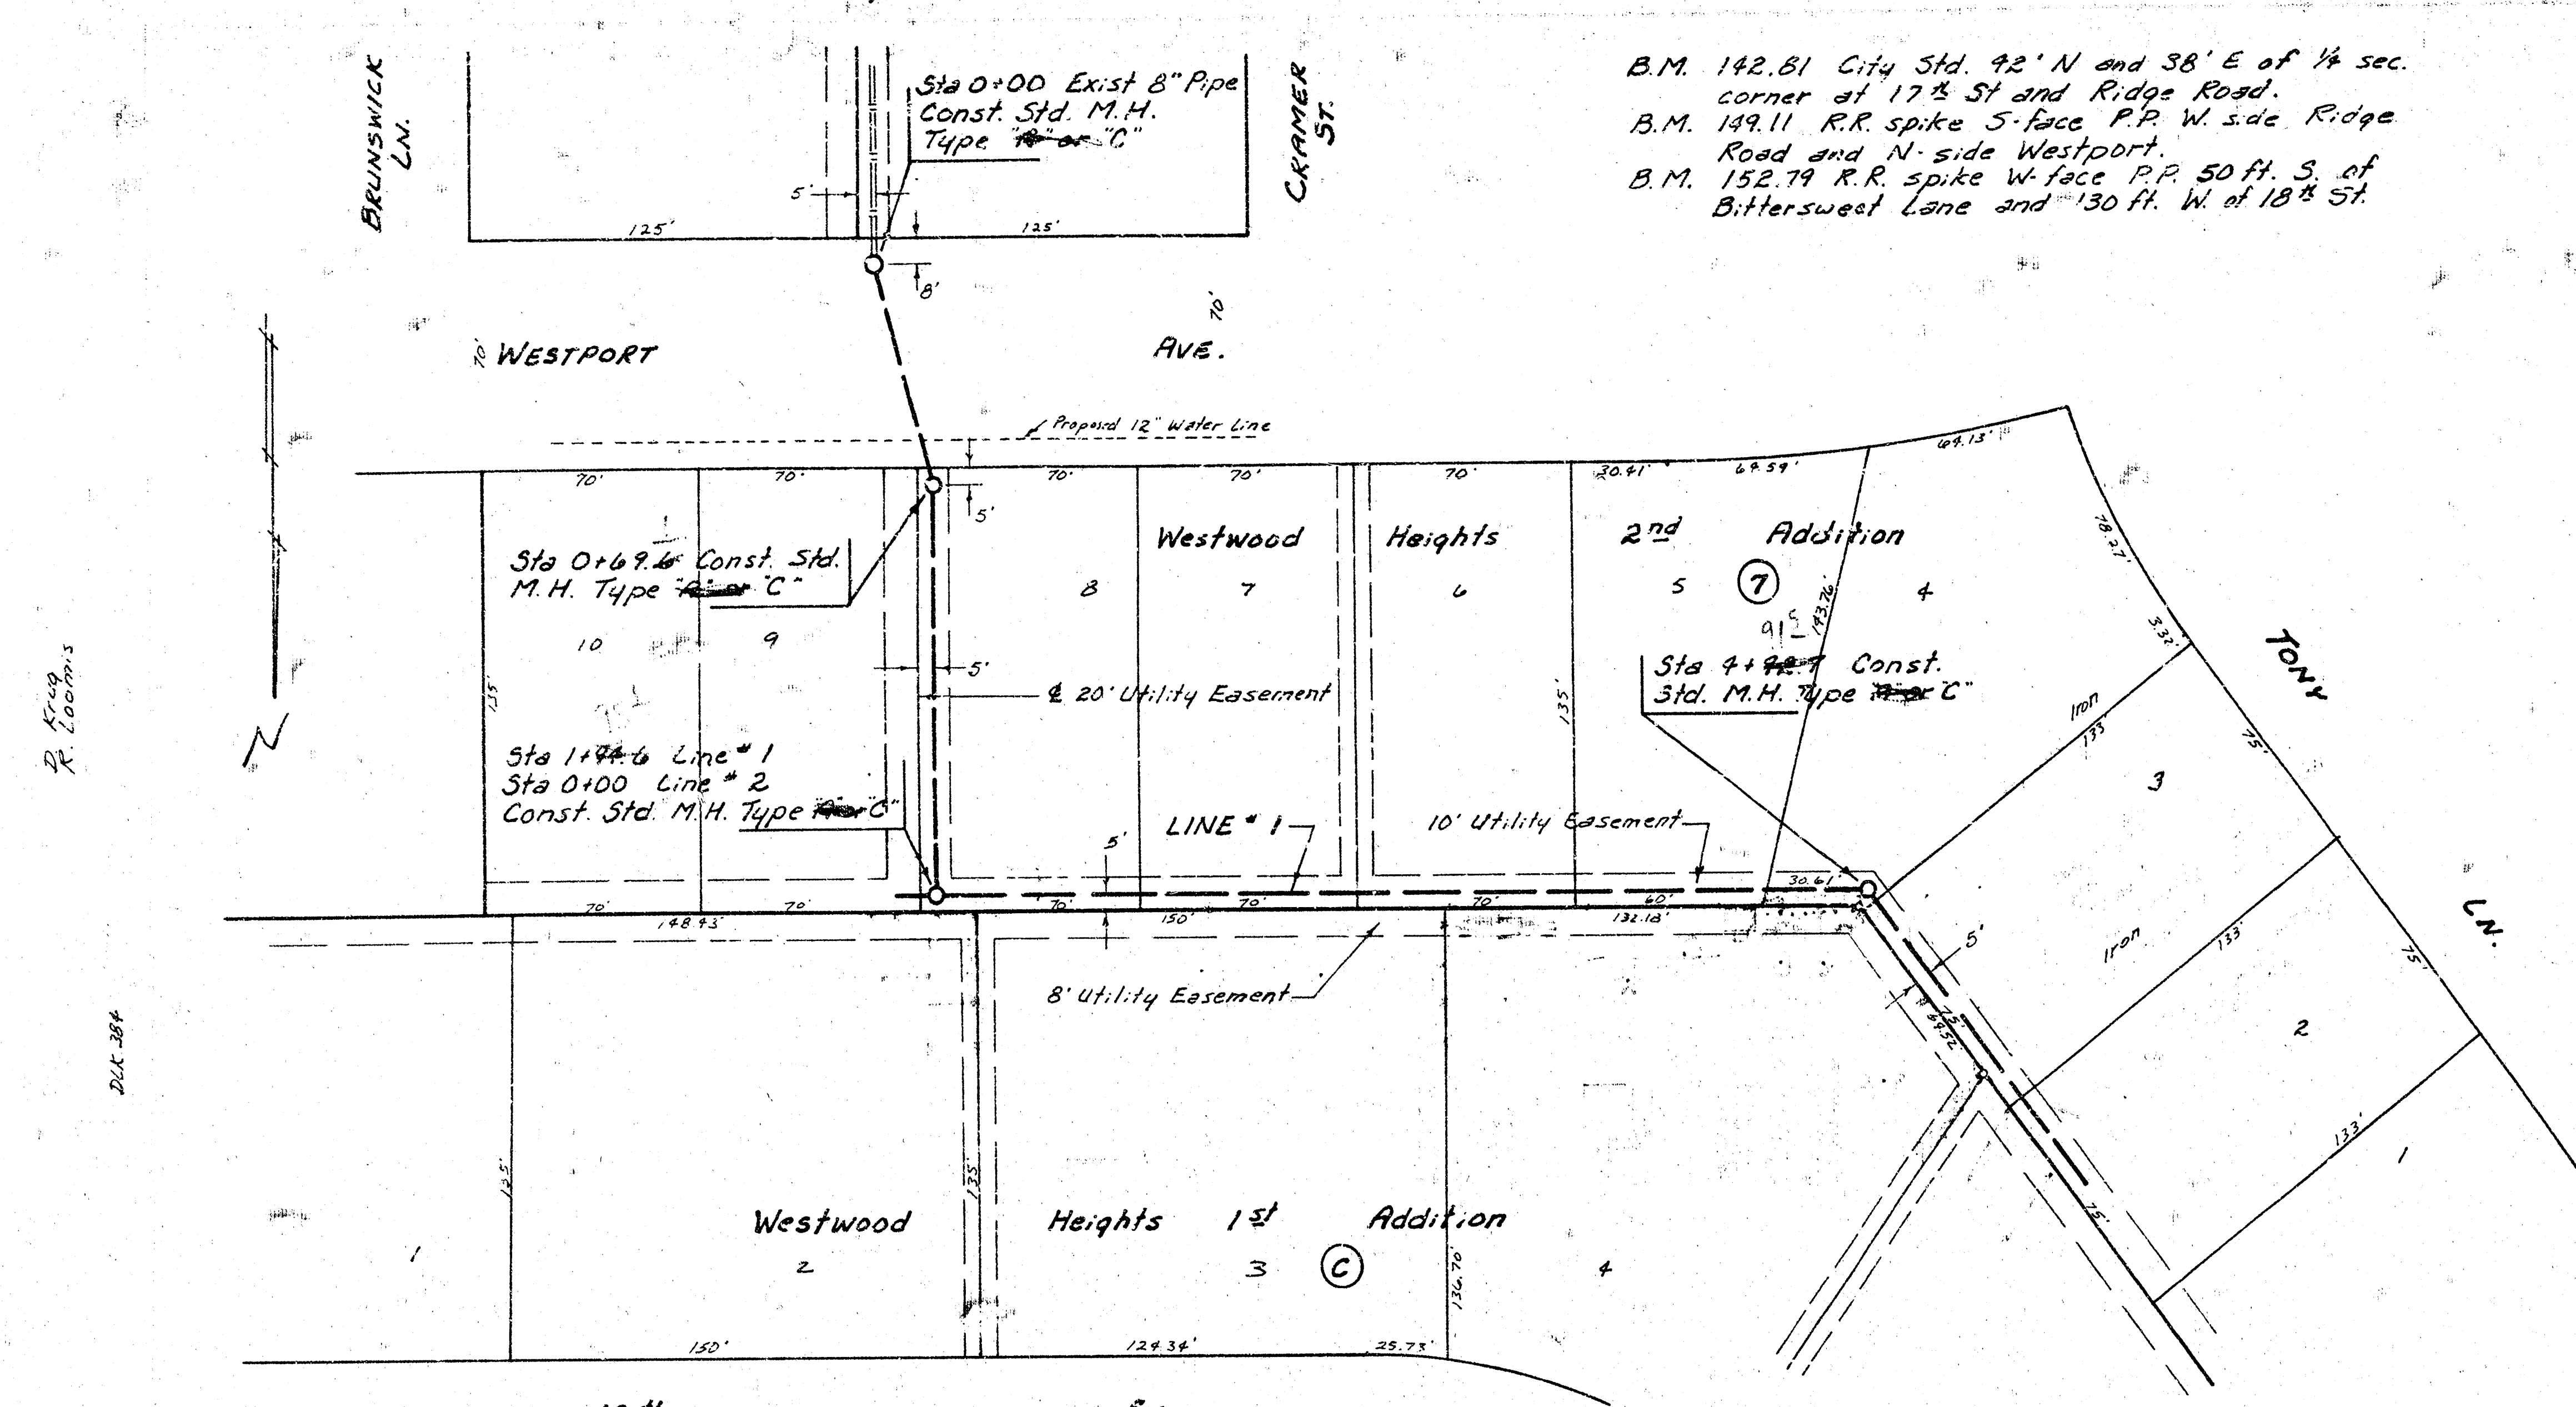

B.M. 142.81 City Std. 42' N and 38' E of 1/4 sec. corner at 17th St and Ridge Road.
 B.M. 149.11 R.R. spike 5' face P.P. W. side Ridge Road and N. side Westport.
 B.M. 152.79 R.R. spike W. face P.P. 50 ft. S. of Bittersweet Lane and 130 ft. W. of 18th St.



Scale Plan 1" = 40'
 Profile 1" = 40' Horiz.
 1" = 5' Vert.

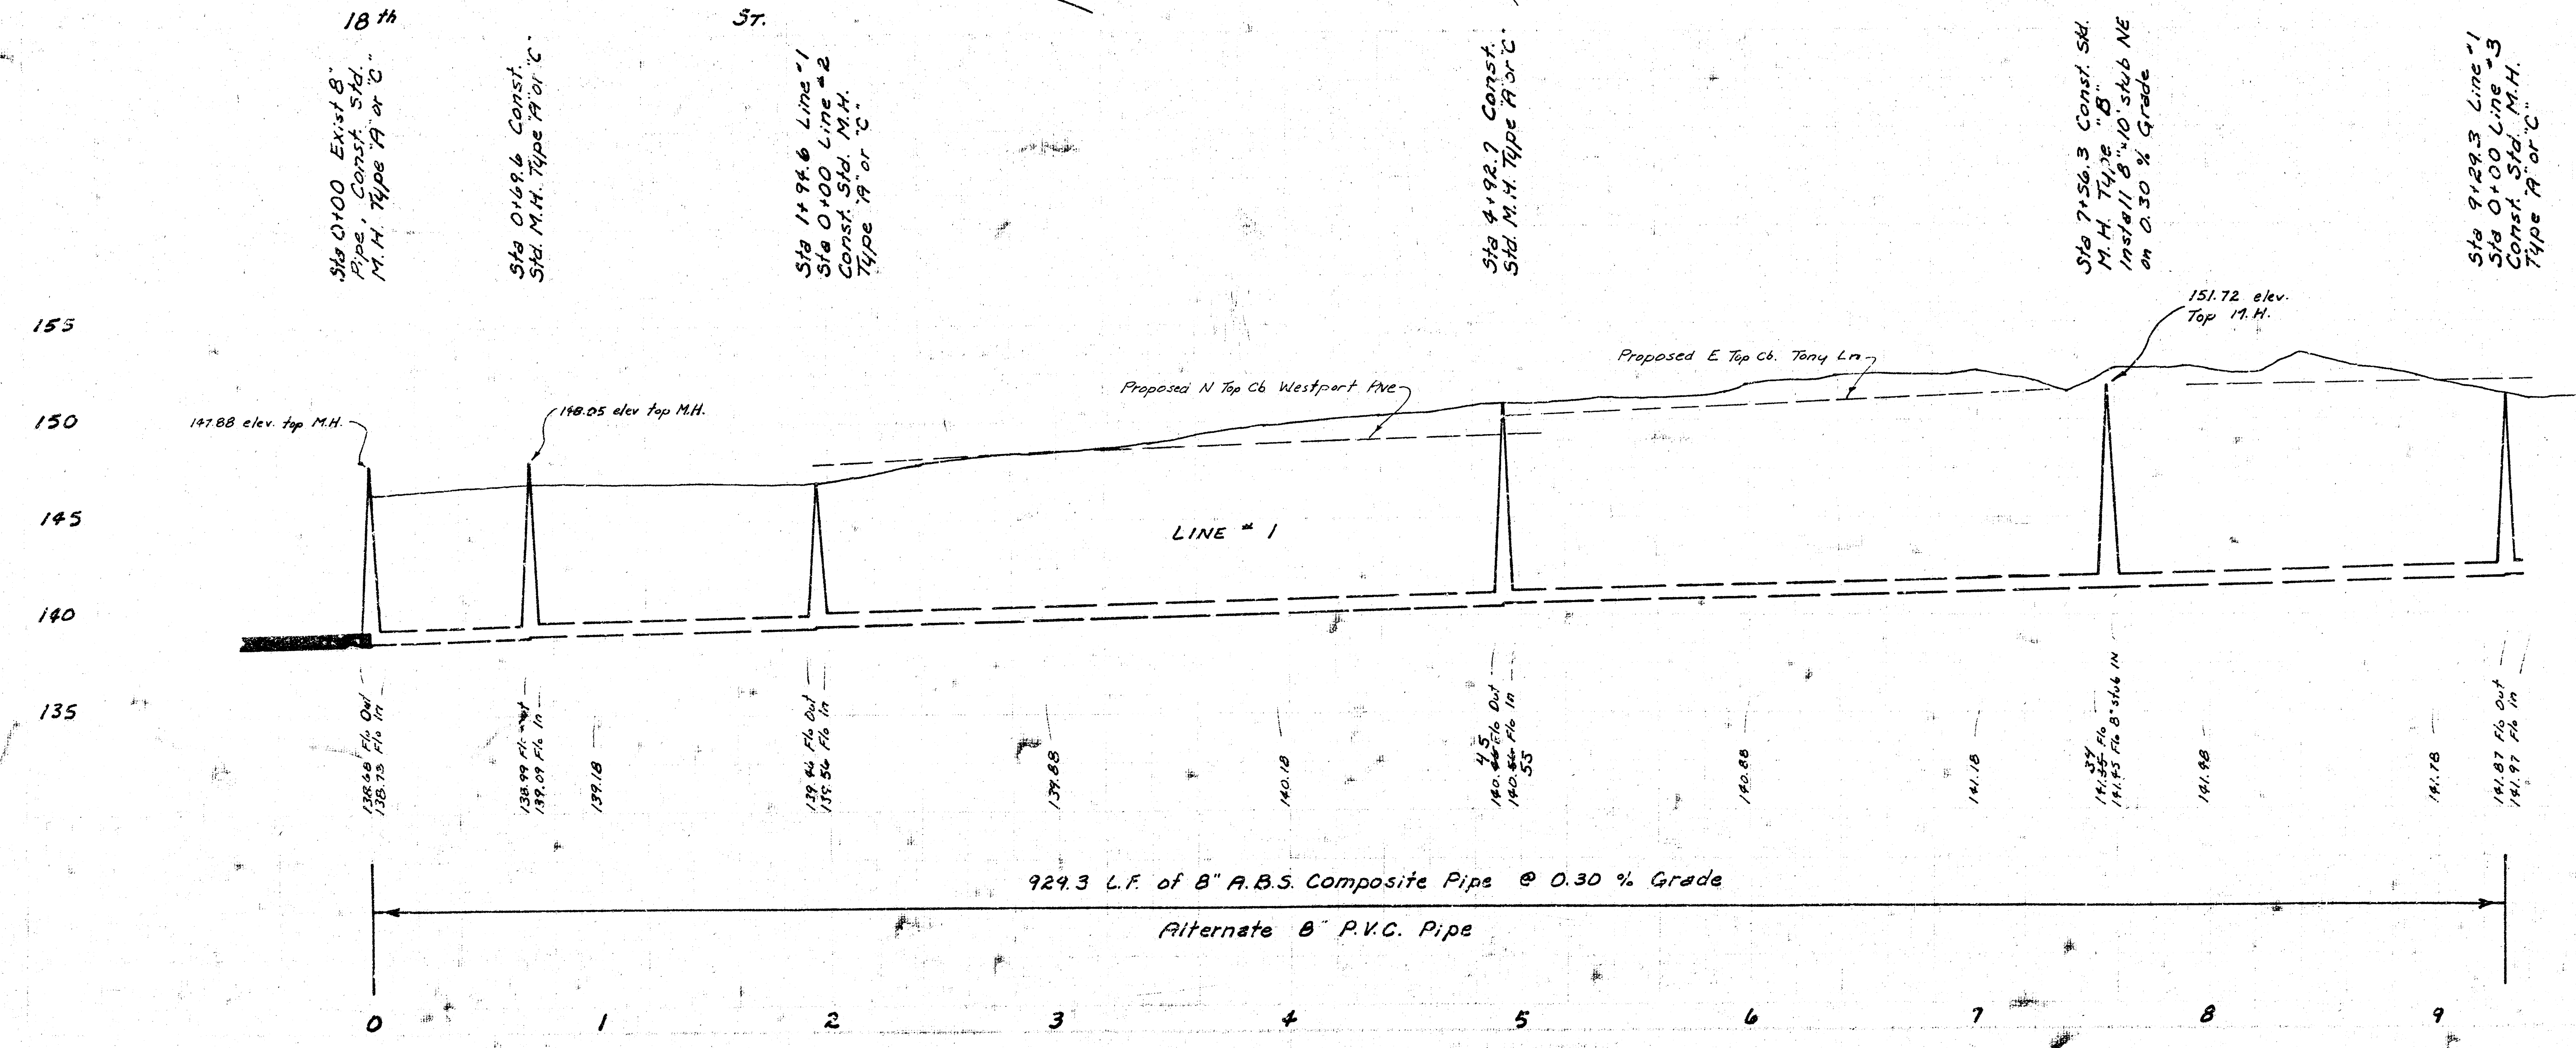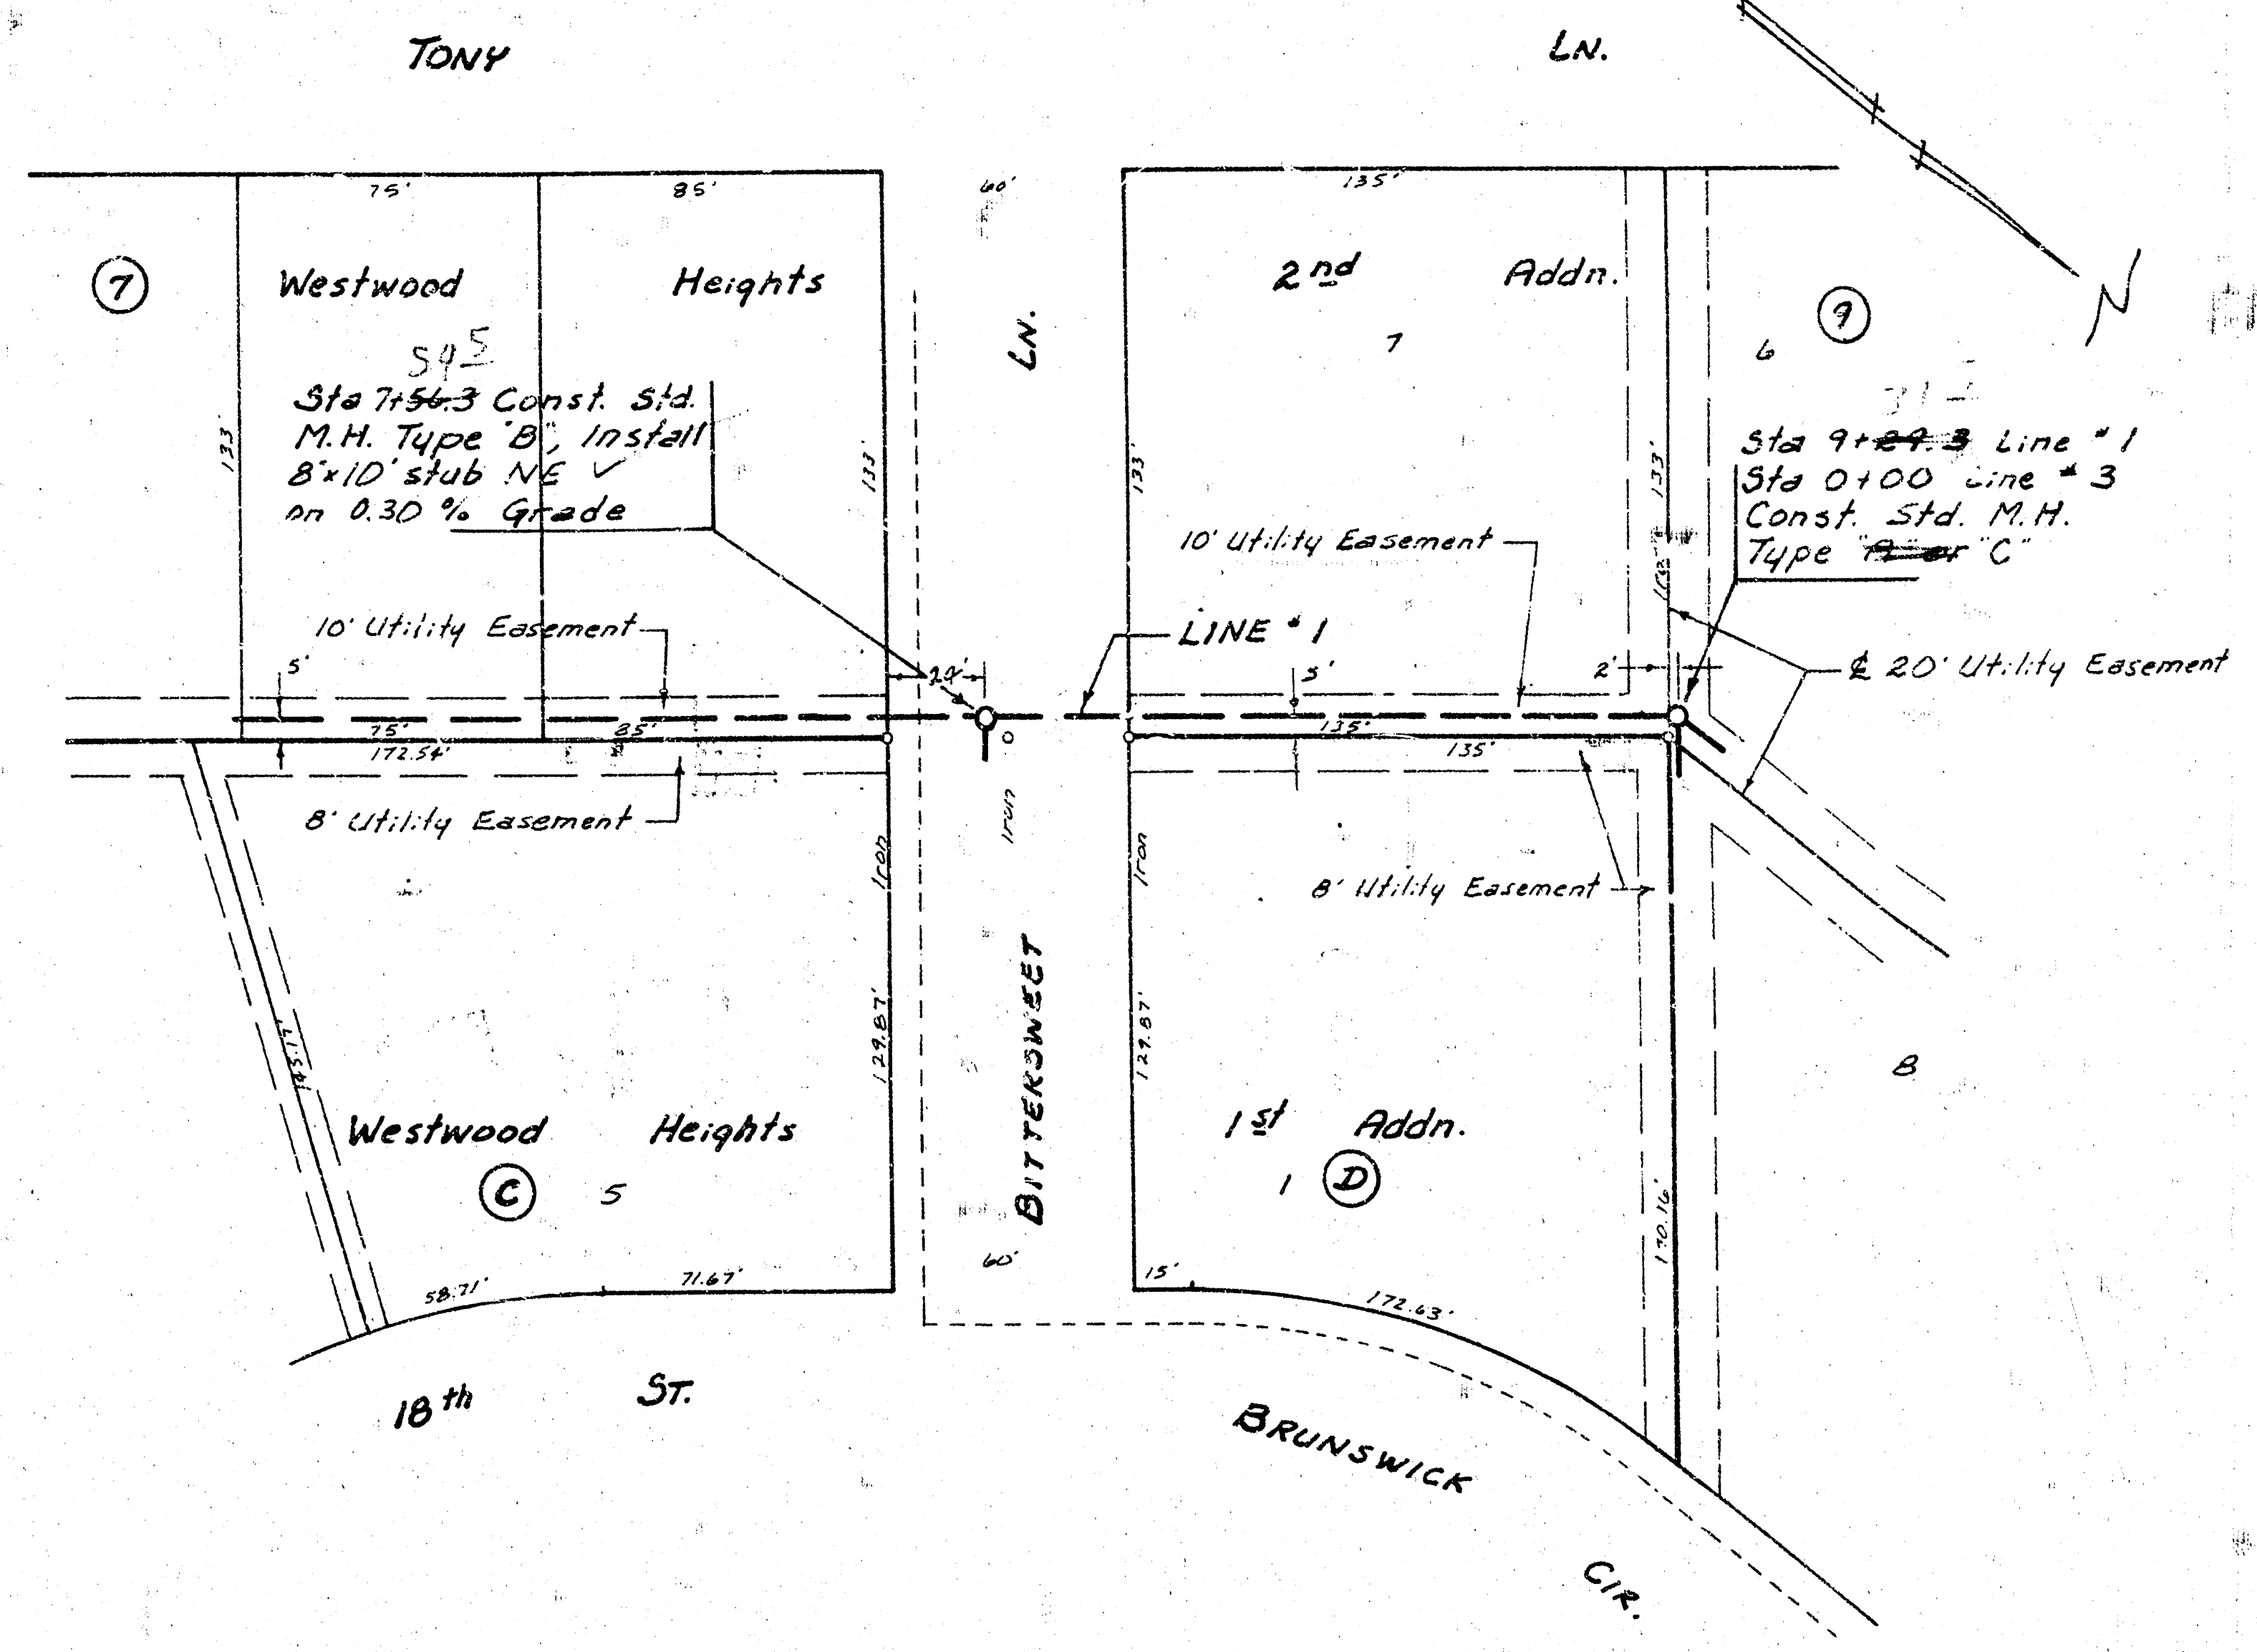

Sheet 2 of 5
 LAT 180 SOUTHWEST INTERCEPTOR
 Proj. No. 448-76-245-BD481-000-000-001

FILMED FROM THE BEST

Scale Plan 1" = 40'
Profile 1" = 40' Horiz.
1" = 5' Vert.

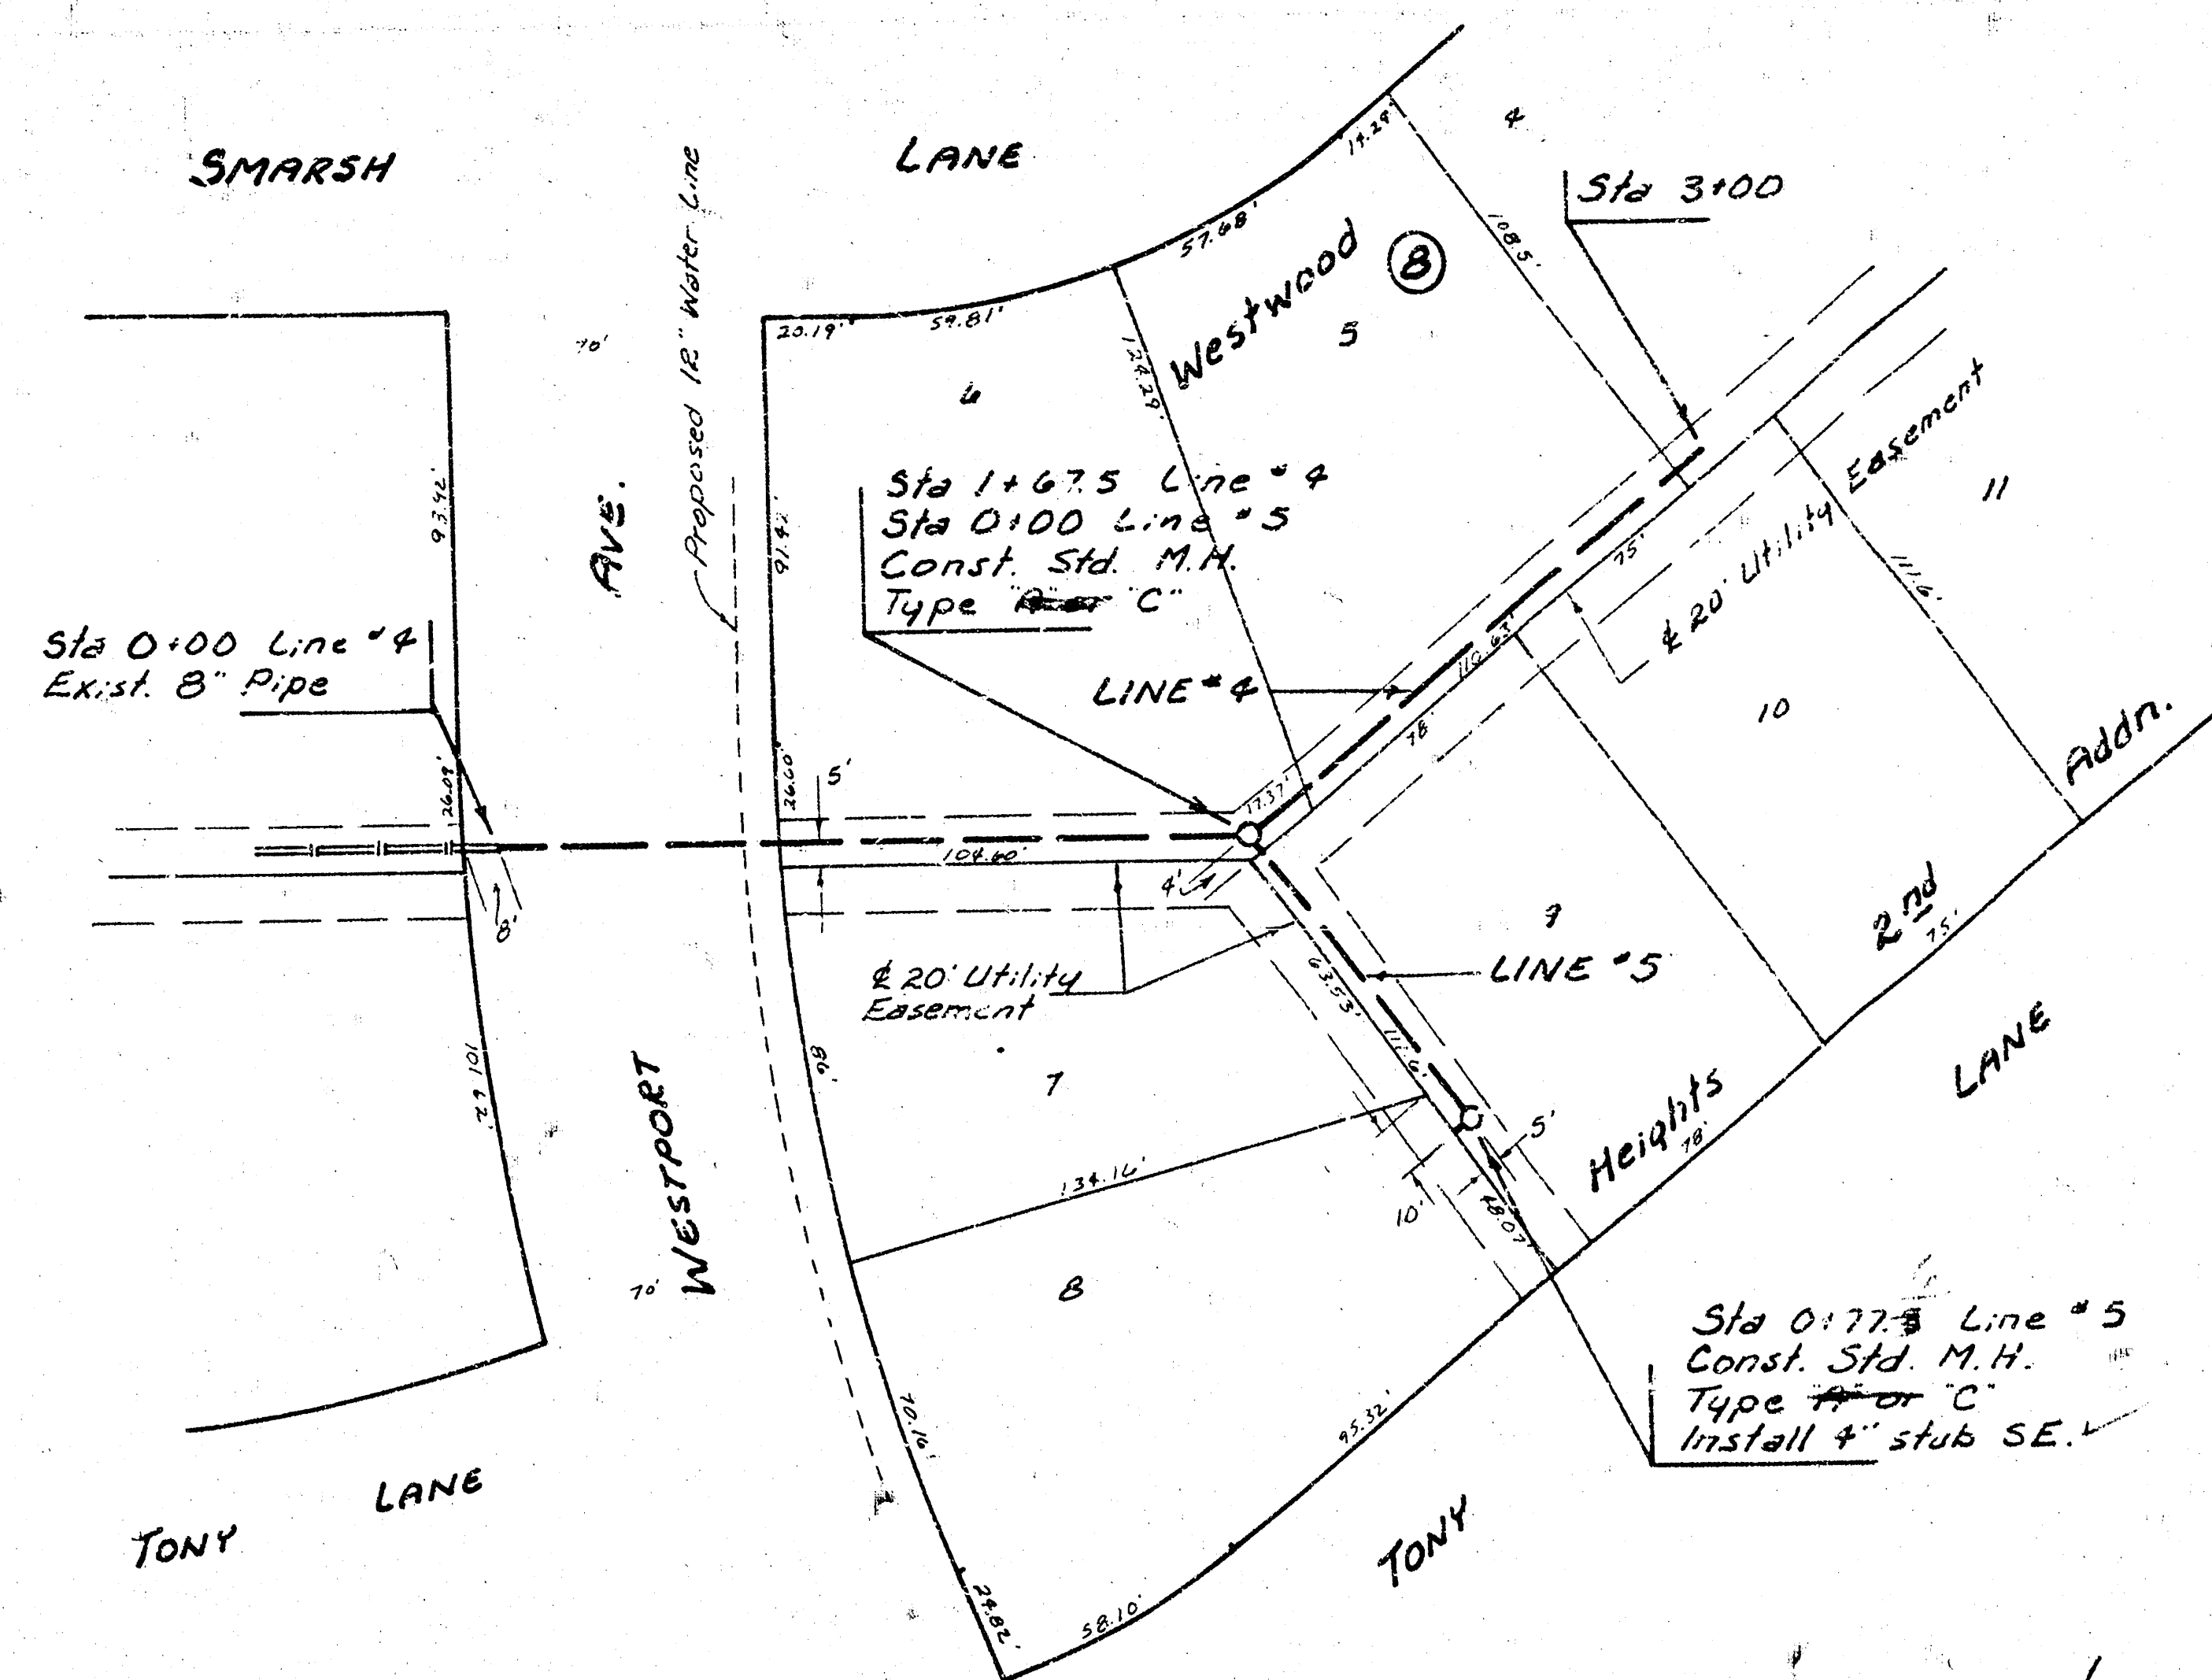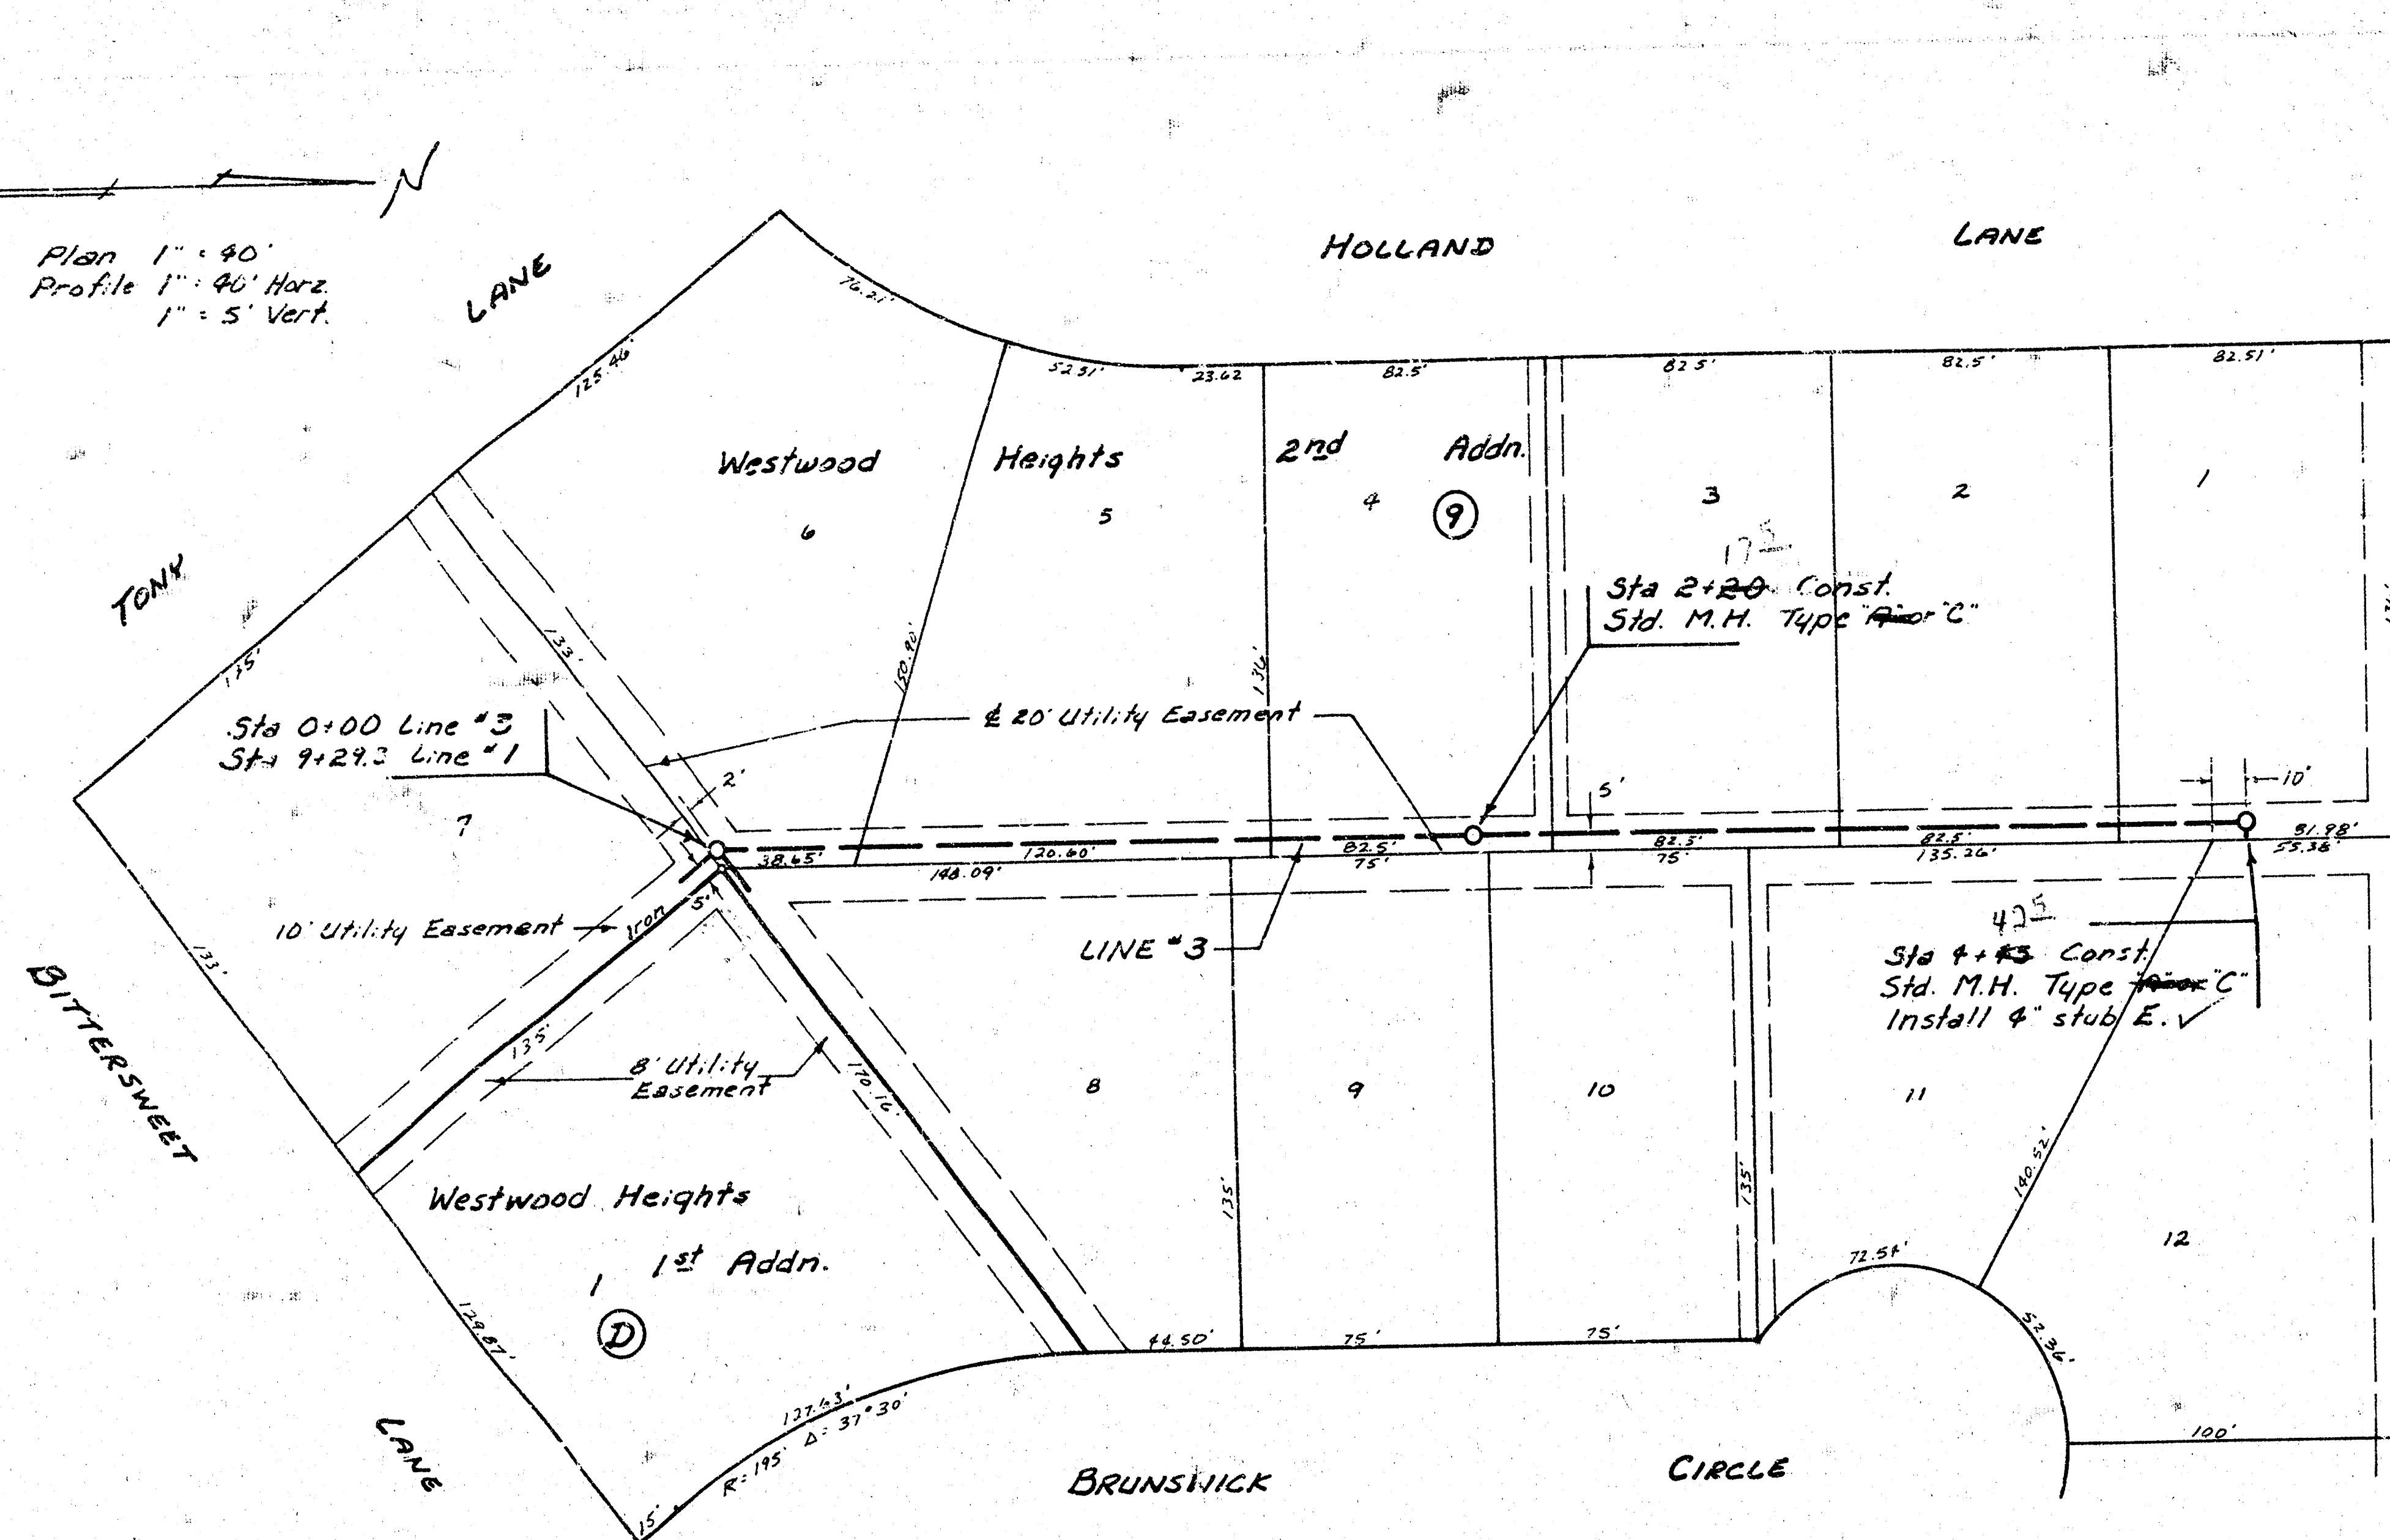

Sta 0+00 Line #3
Sta 9+29.3 Line #1

Sta 2+20 Const.
Std. M.H. Type "A" or "C"

Sta 4+45 Const.
Std. M.H. Type "A" or "C"
Install 4" stub E.

Sta 0+00 Line #4
Exist. 8" Pipe

Sta 1+67.5 Line #4
Sta 0+00 Line #5
Const. Std. M.H.
Type "A" or "C"

Sta 3+00

Sta 0+00 Line #5
Sta 1+67.5 Line #4

Sta 0+77.5 Line #5
Const. Std. M.H.
Type "A" or "C"
Install 4" stub SE.

