

B.M. 142.81 - C.P. Std. Disc. 42' N & 38.5' E. of 1/4 Sec. Cor. on Ridge Rd. 1/2 mi. N. of 13th St. N.
 148.04 - RR Spt. W Side PP. approx. 125' N & 12' E. of NW Cor. Ridge Rd. & 18th St. N.
 152.76 - RR Spt. W Side PP. 50' S. of Bittersweet Ln. & 130' W. of 18th St. N.

SCALE: 1" = 40' Plan
 Horiz. 1" = 40' Profile
 Vert. 1" = 5'

Sta. 0+00
 Existing M.H.
 Top M.H. Elev. = 152.84

Sta. 0+00 Reconst.
 10" 8" Stub to .8% Grade

Sta. 2+29.3 Const. Std.
 M.H. Type "B", Prop.
 Top of M.H. Elev. = 154.0

Sta. 3+70.2 Const. Std. M.H.
 Type "B", Prop. Top of M.H. Elev. = 150.0

Sta. 4+36.2 Const. Std. M.H.
 Type "B", Prop. Top of M.H. Elev. = 151.0


Sta. 8+29.3 Const. Std. M.H.
 Type "B", Prop. Top of M.H. Elev. = 149.8

THE CONTRACTOR SHALL BE RESPONSIBLE FOR PRESERVING PROPERTY IRONS. THE CONTRACTOR SHALL BE REQUIRED TO RE-ESTABLISH ANY PROPERTY IRONS WHICH ARE DAMAGED OR DESTROYED BY HIS CONSTRUCTION OPERATIONS. SUCH IRONS SHALL BE RE-ESTABLISHED BY A LICENSED LAND SURVEYOR OR A LICENSED PROFESSIONAL ENGINEER IN ACCORDANCE WITH STATE LAWS.

CAUTION
 UNDERGROUND UTILITIES
 Please check with K.G.S. or Southwestern Bell Telephone Co. for Location

As Built
 J.L.L.
 5/82

LAT. 170, SOUTHWEST INT. SEWER
 CITY OF WICHITA, KANSAS
 R.W. BRUGGEMAN
 DIRECTOR OF ENGINEERING/CITY ENGINEER
 PROJ. NO. 468-76-245-81089-000-000-001

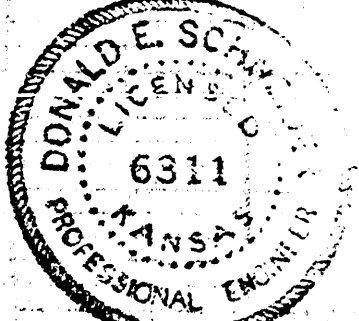

FILMED FROM THE BEST AVAILABLE COPY