

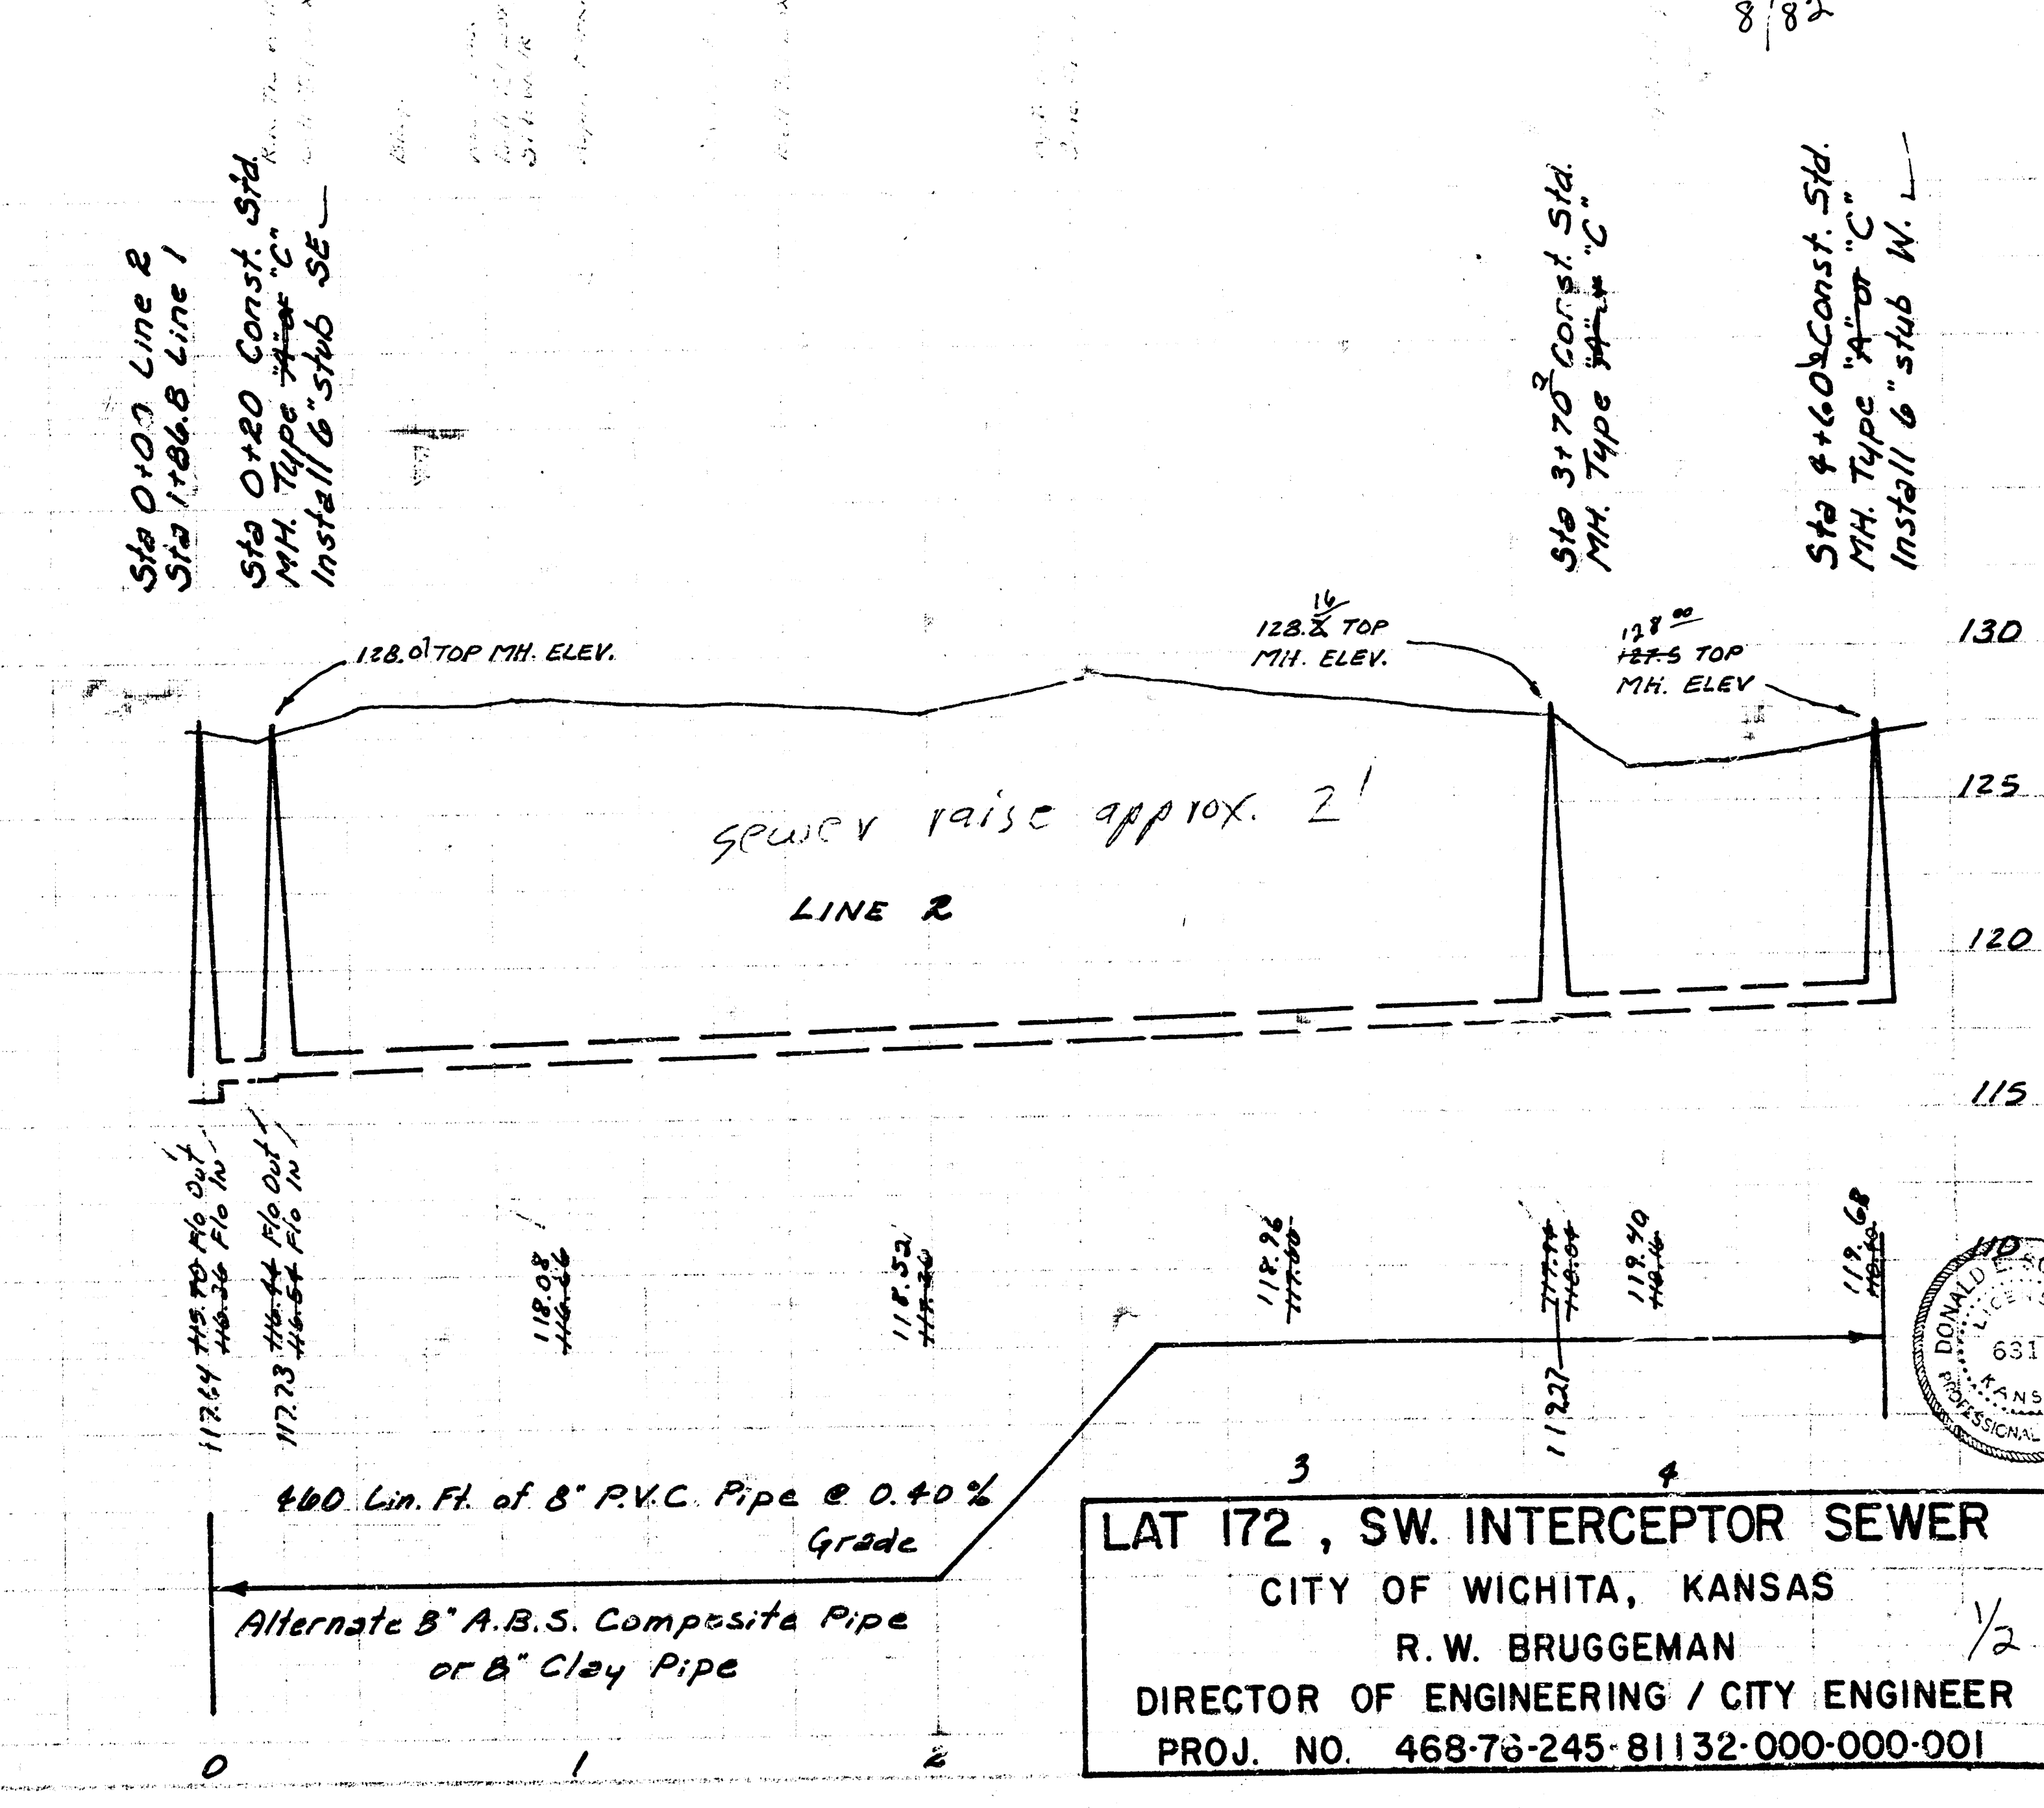



THE CONTRACTOR SHALL BE RESPONSIBLE FOR PRESERVING PROPERTY PLANTS. THE CONTRACTOR SHALL BE REQUIRED TO RE-ESTABLISH ANY PROPERTY PLANTS WHICH ARE DAMAGED OR DESTROYED BY HIS CONSTRUCTION OPERATIONS. SUCH PLANTS SHALL BE RE-ESTABLISHED BY A LICENSED LAND SURVEYOR OR A LICENSED PROFESSIONAL ENGINEER IN ACCORDANCE WITH STATE LAWS.

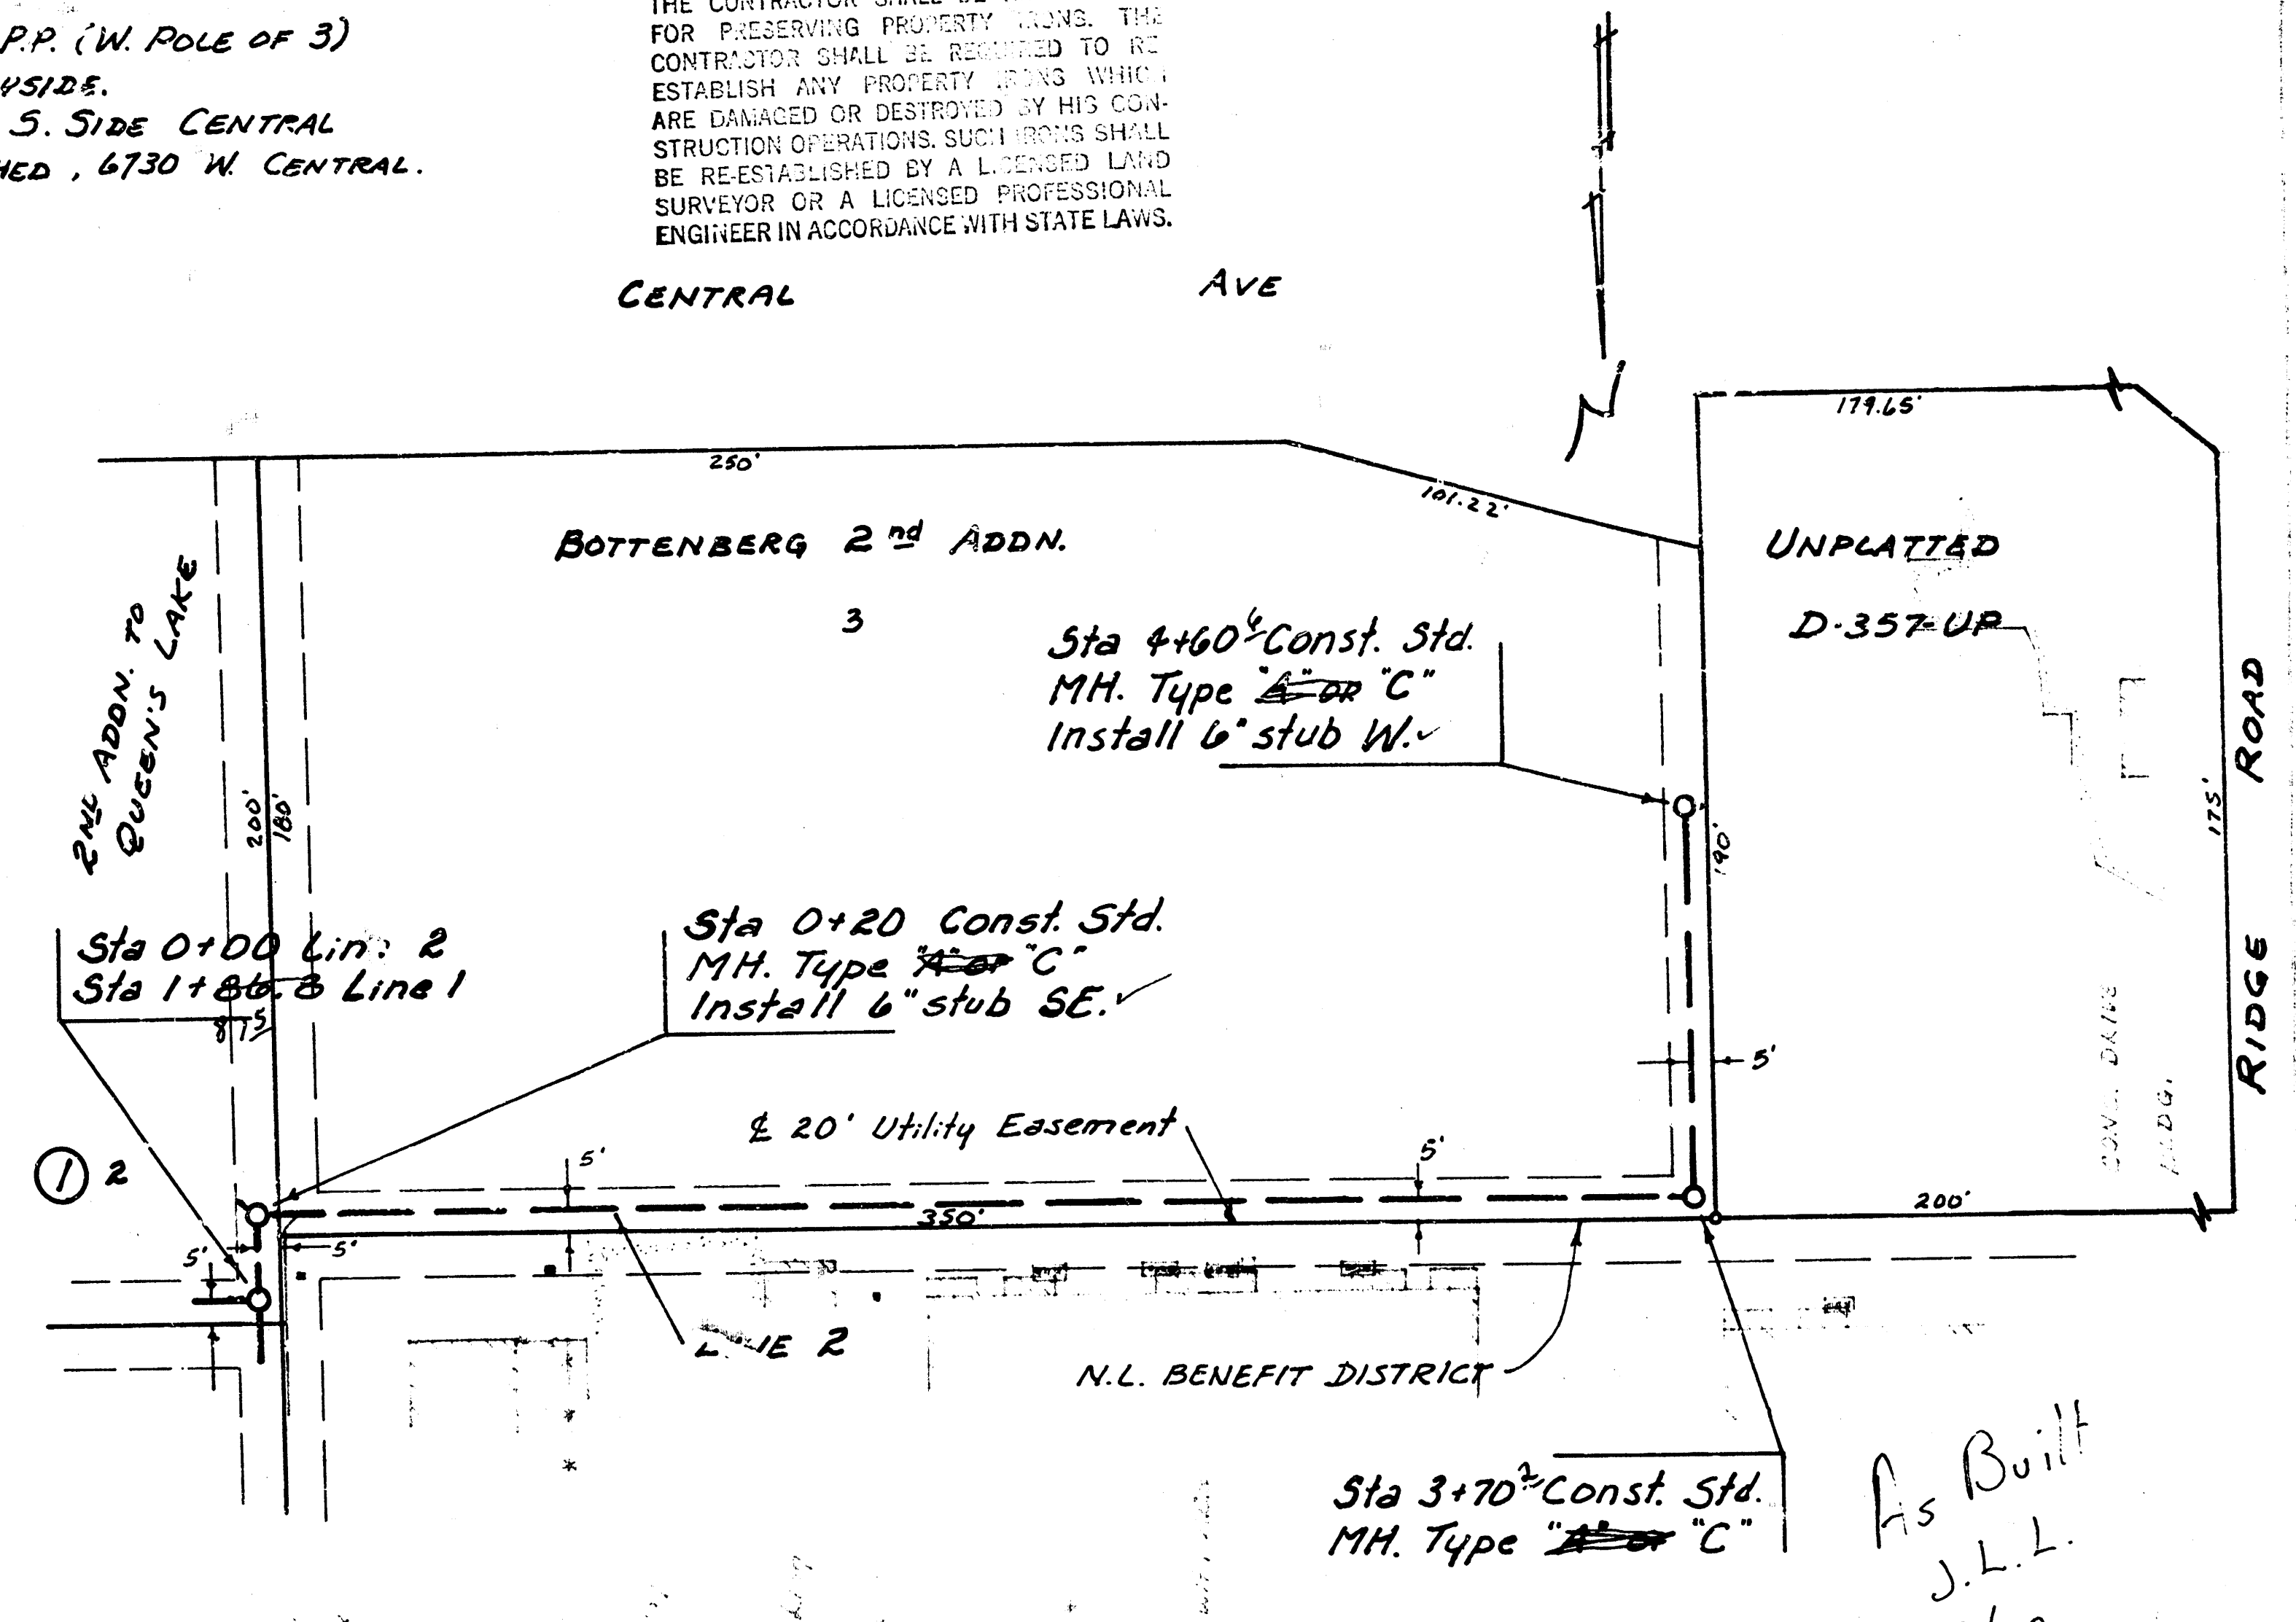

SCALE PLAN 1"=40'
 PROFILE 1"=40' HORIZ.
 1"=5' VERT.

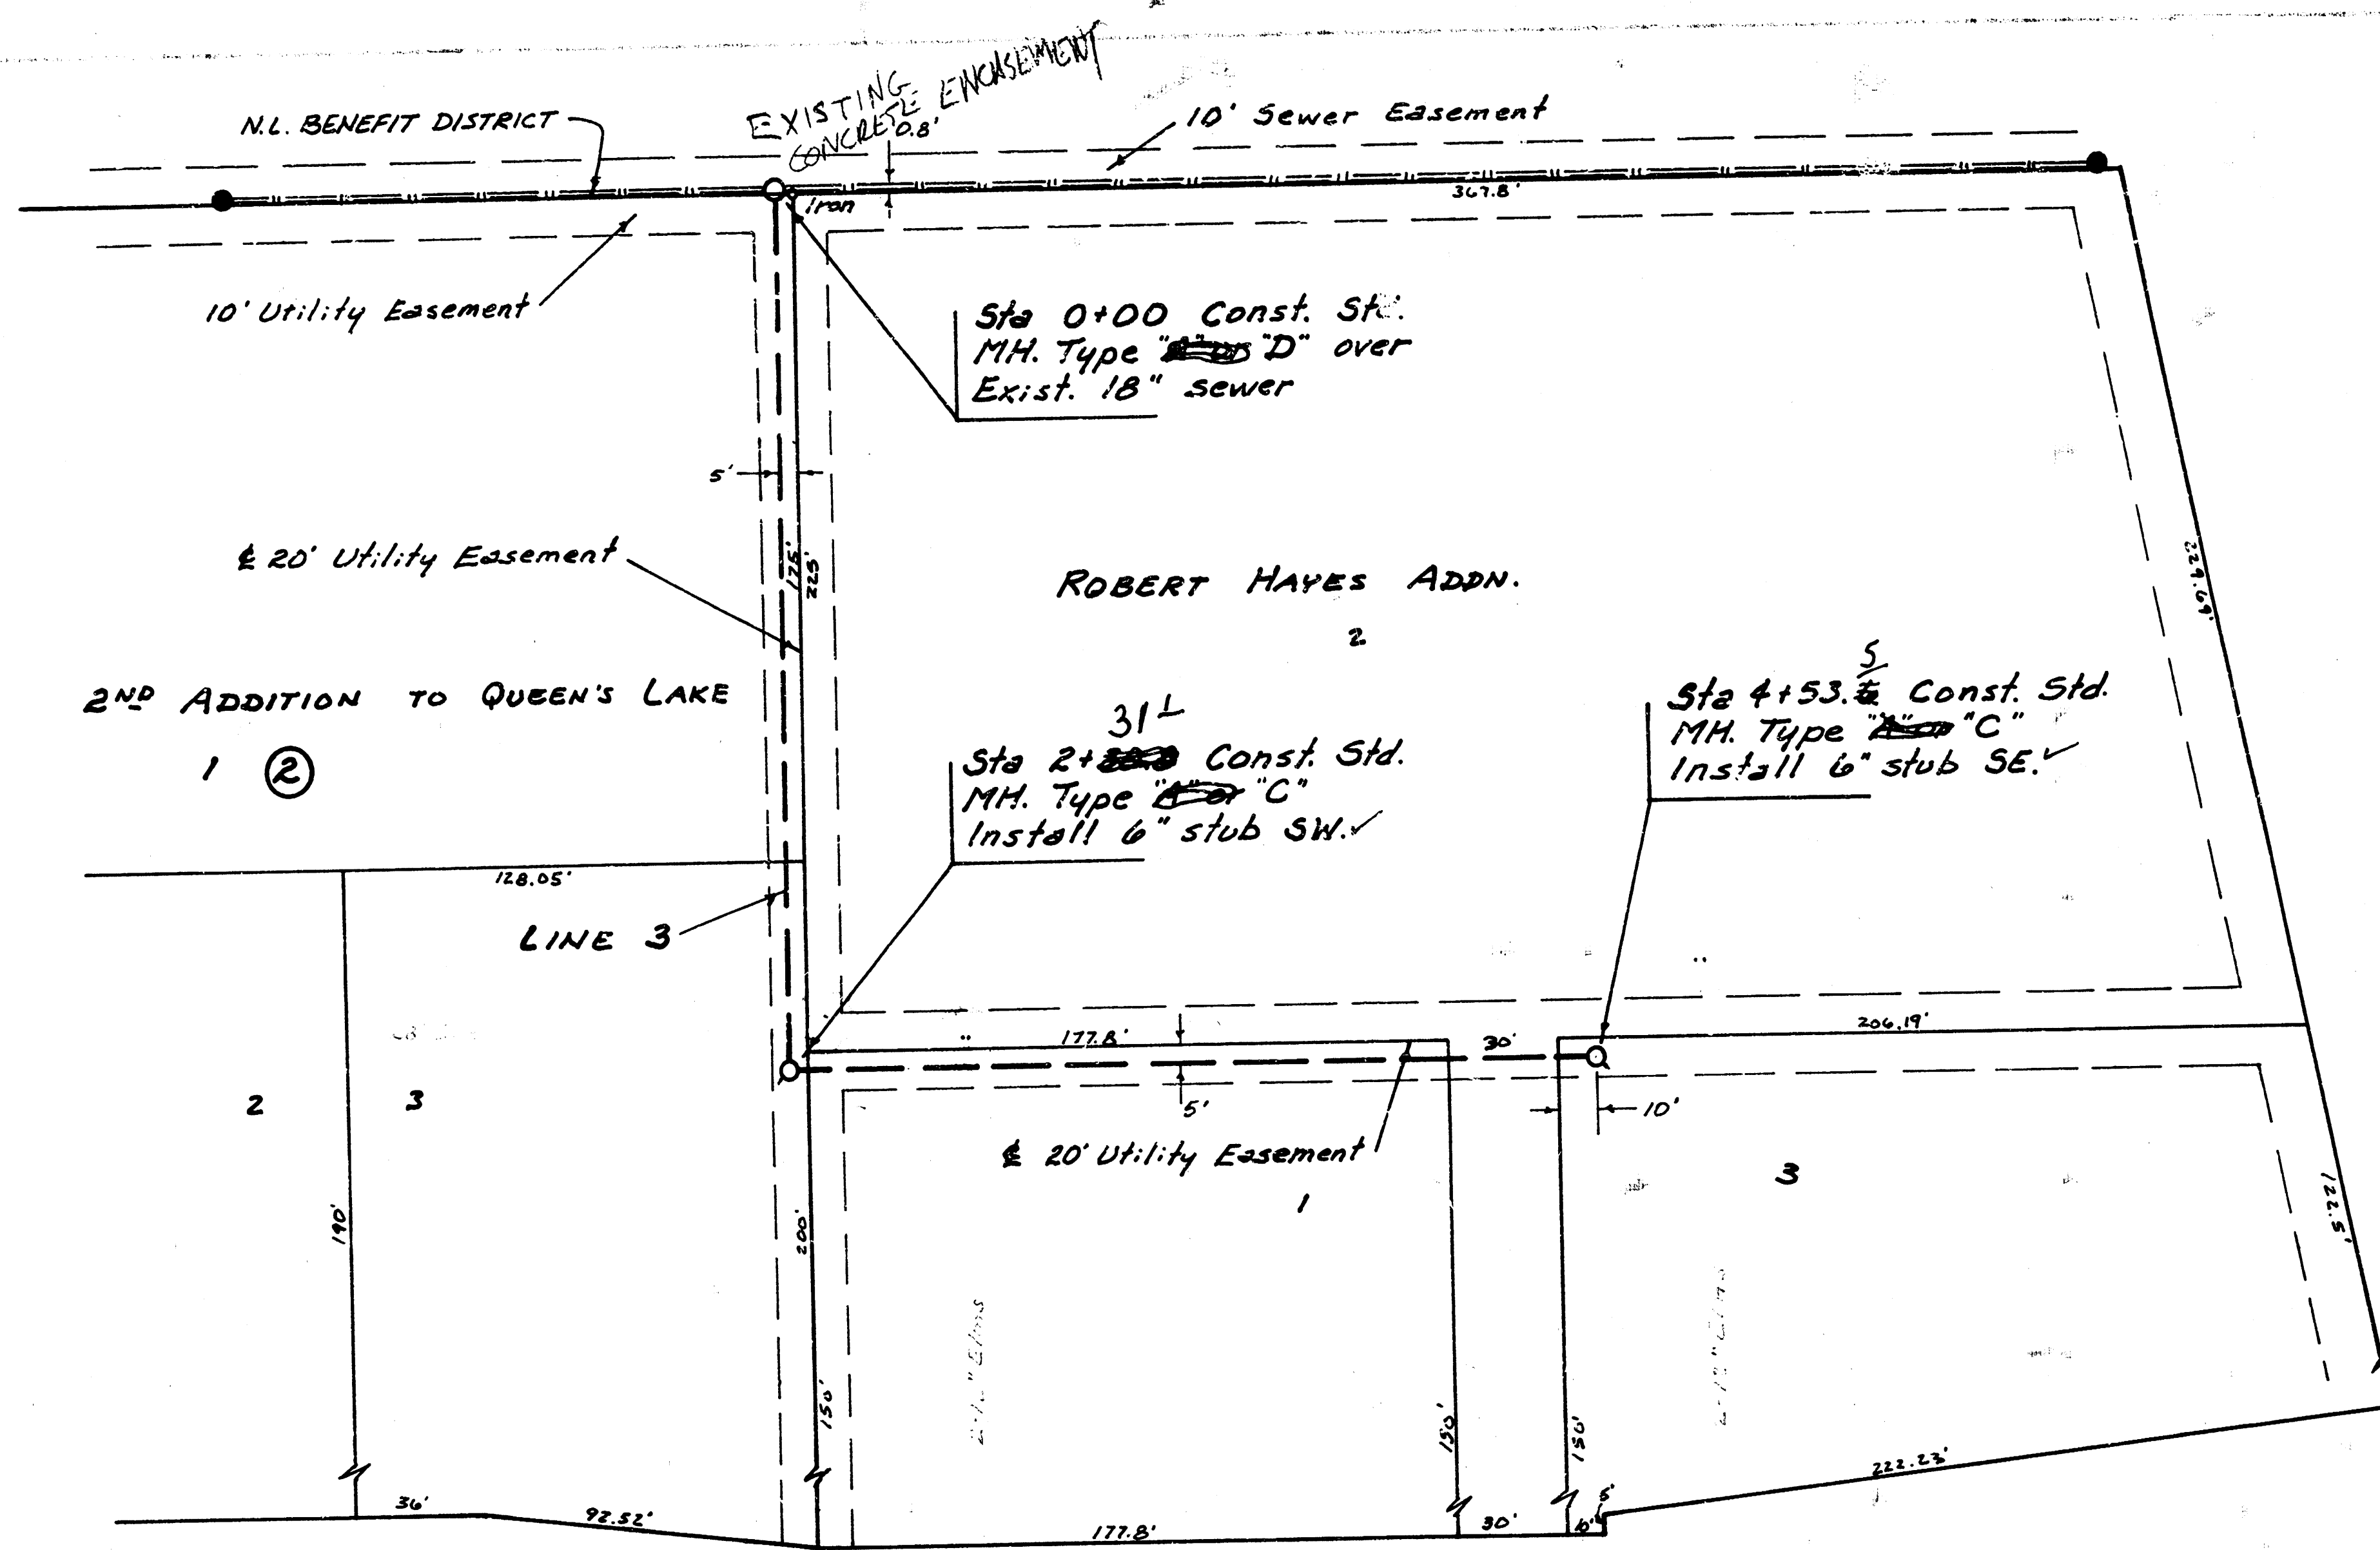

As Built
 J.L.L.
 8-82

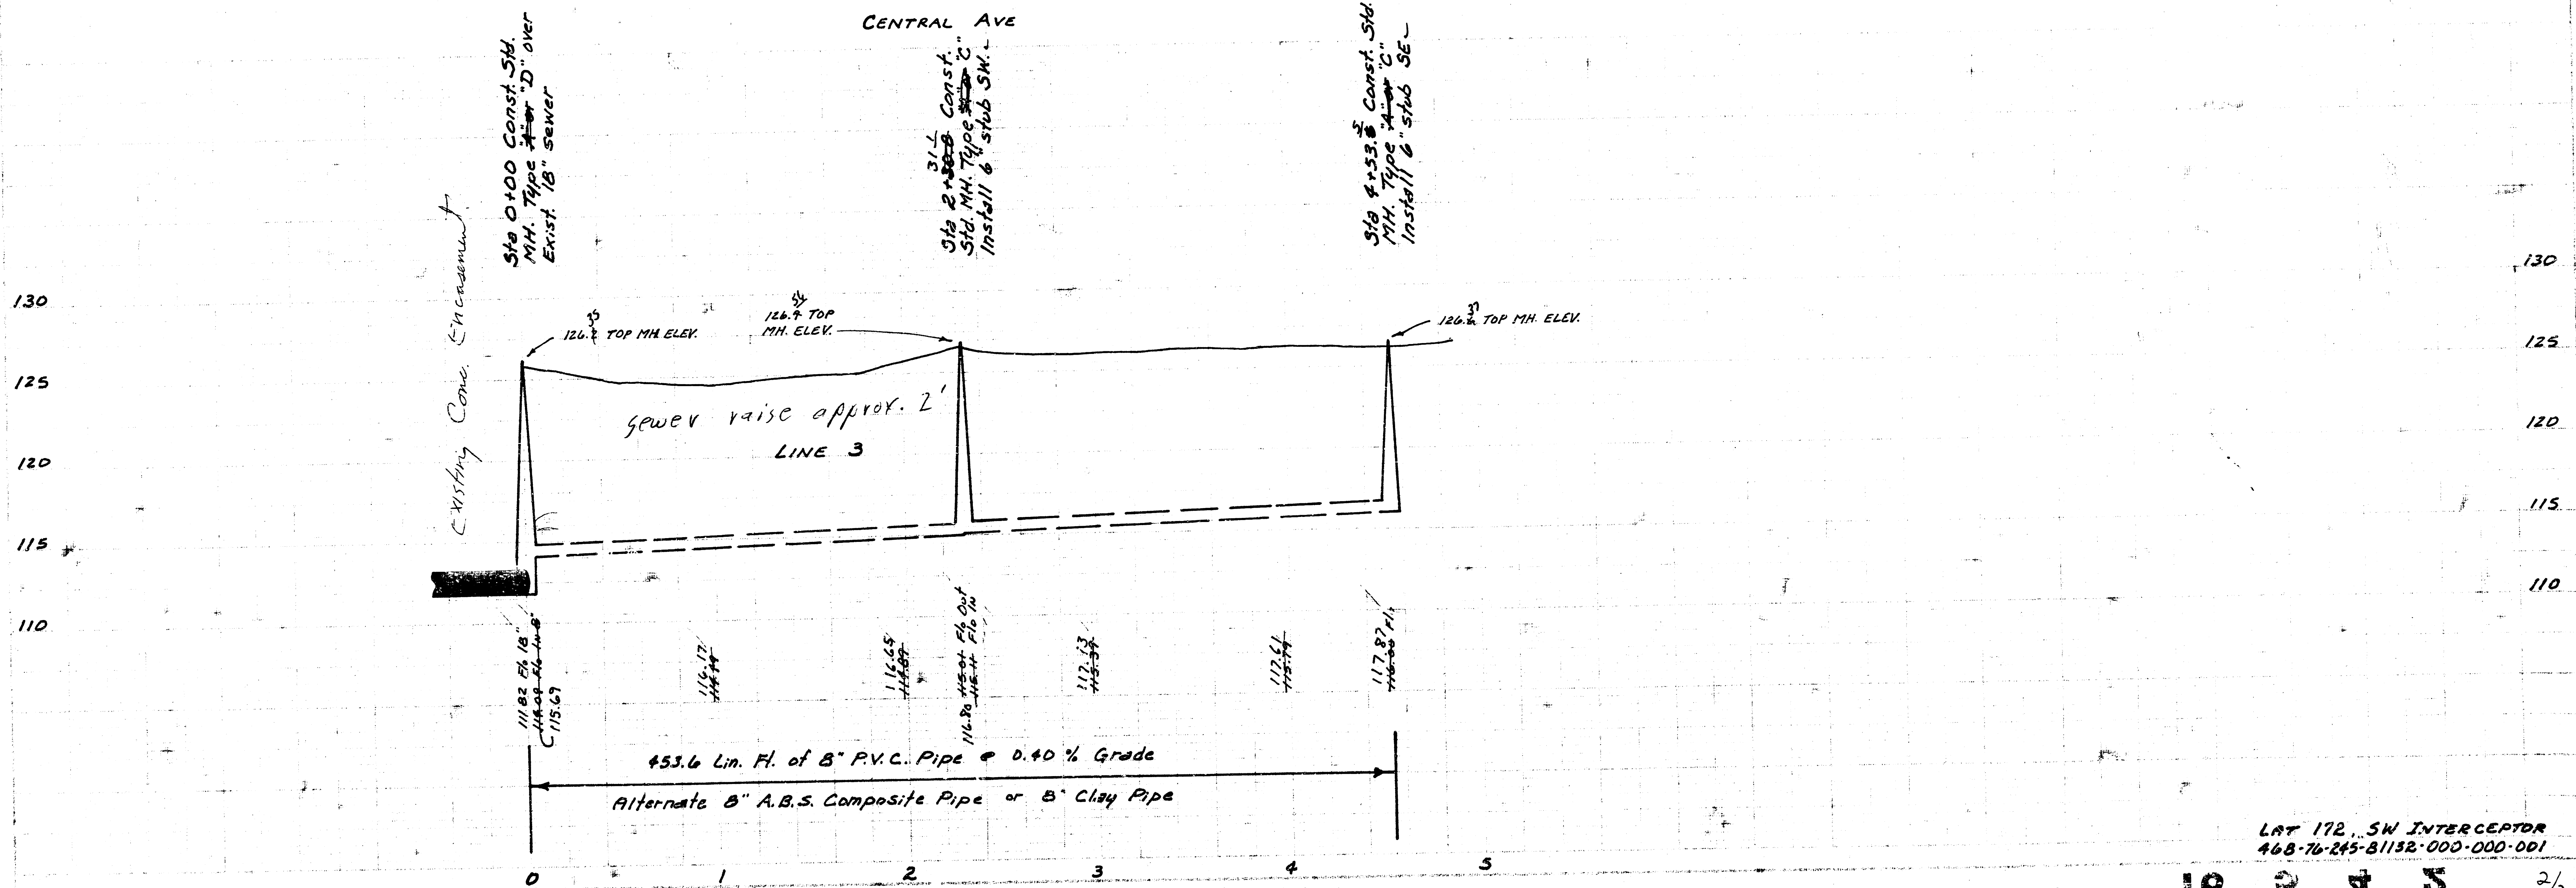

LAT 172 SW INTERCEPTOR
 468-76-245-81132-000-001