


CONSTRUCTION PLANS FOR
LATERAL 184
OF THE
SOUTHWEST INTERCEPTOR SEWER

THE CITY OF WICHITA,
SEDGWICK COUNTY, KANSAS
MICHAEL E. LINDEBAK, P.E., CITY ENGINEER

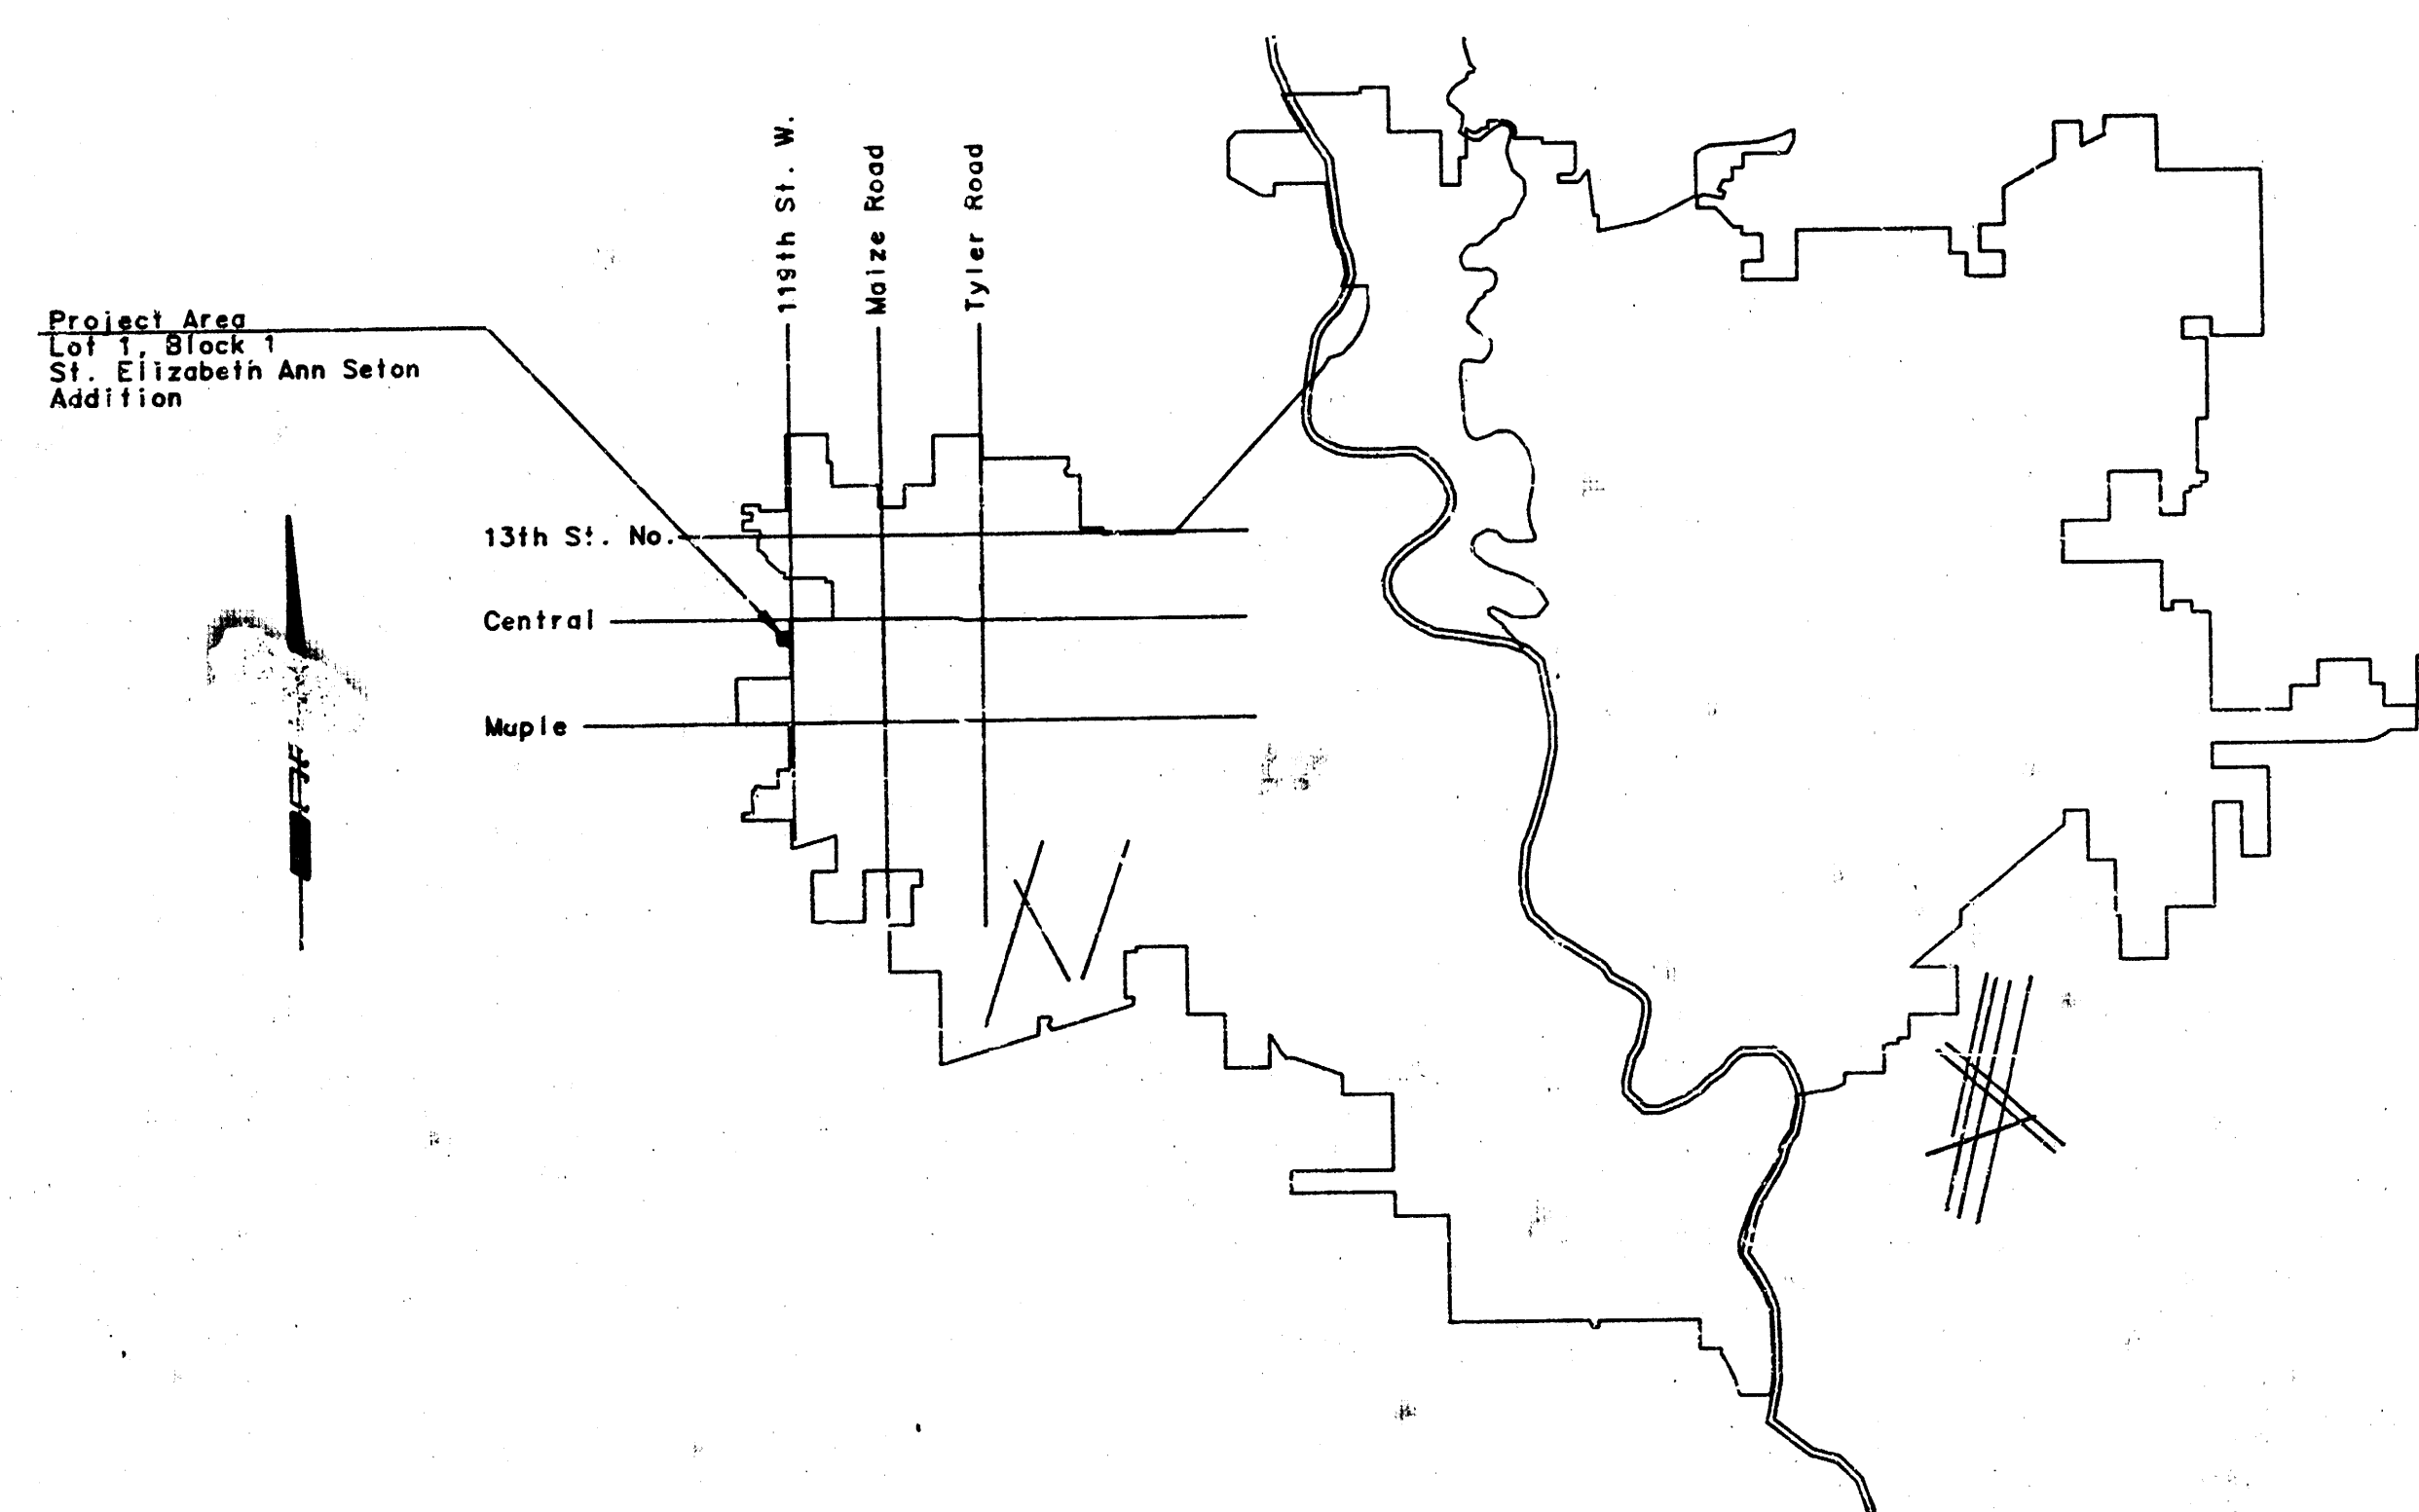


LOCATION MAP

CITY OF WICHITA PROJECT NO. 468-76-245-81364-000-000-001

SEPTEMBER, 1984

PLANS PREPARED BY


PROFESSIONAL ENGINEERING CONSULTANTS, P.A.
ENGINEERS
WICHITA, KANSAS

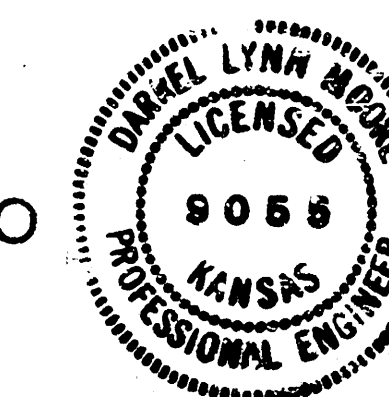

As Built
3/85
CH

1/2

DATE	BY	SURVEYED PLOTTER'S GRADES CHECKED B. M.'S RATED
------	----	--

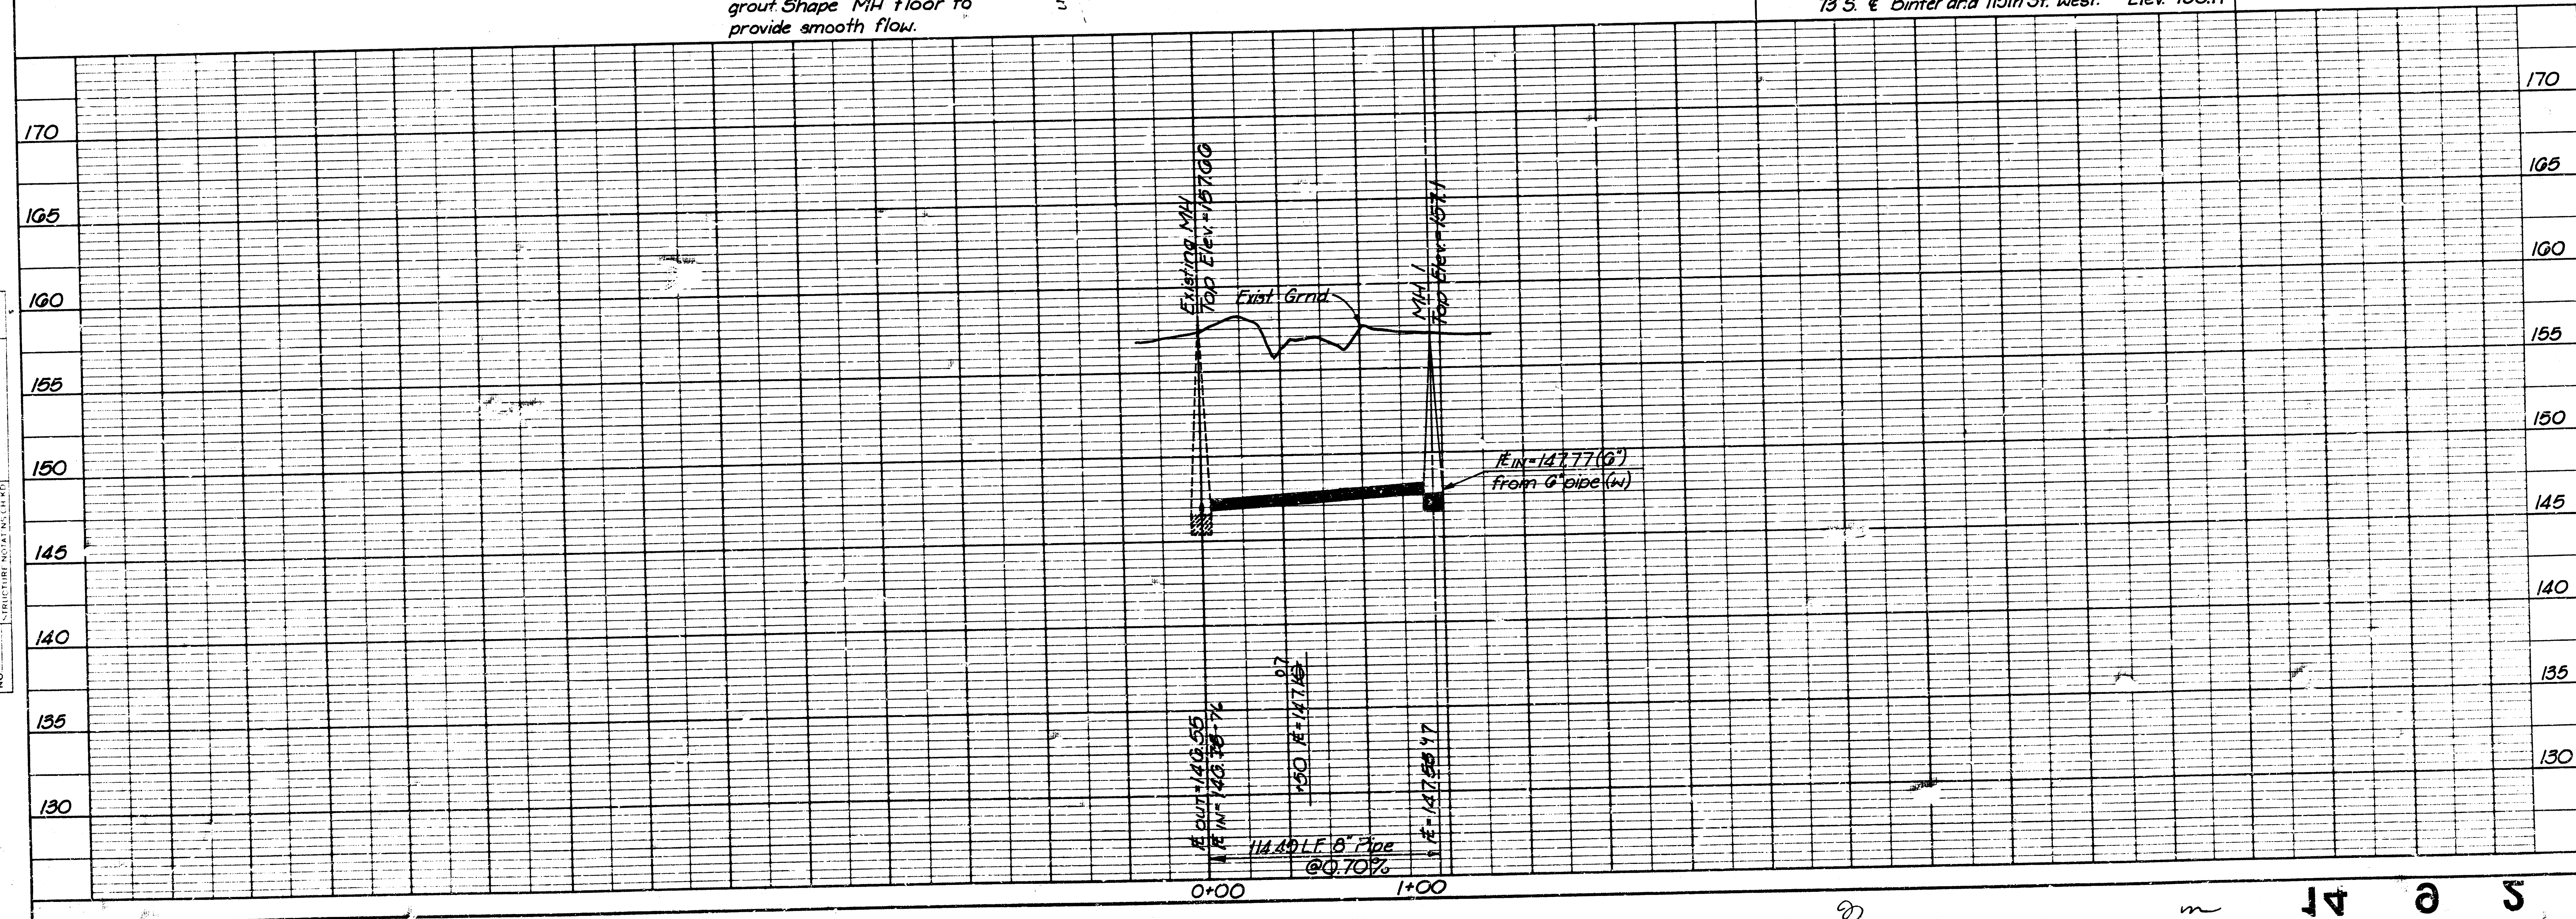

-

B.M. - Railroad Spike in west
face power pole, 27'E $\frac{1}{2}$
73'S & Binter and 119th St. West. Elev. = 158.1

CITY OF WICHITA, KANSAS
LATERAL 184
OF THE
SOUTHWEST INTERCEPTOR SEWER
MICHAEL E. LINDBERGH, PE, - CITY ENGINEER
CITY OF WICHITA PROJECT NO. 468-76-246-81364-000-000-001

	PROFESSIONAL ENGINEERING CONSULTANTS, P.A.
	ENGINEERS WICHITA, KANSAS
Job No. 34-84512-042 Date September 1984	Designed by DLM

Designed by	DLM
Job No.	34-84512-042
Date	September 1984

Designed by *DLM*

**FILMED FROM THE BEST
AVAILABLE COPY.....**