
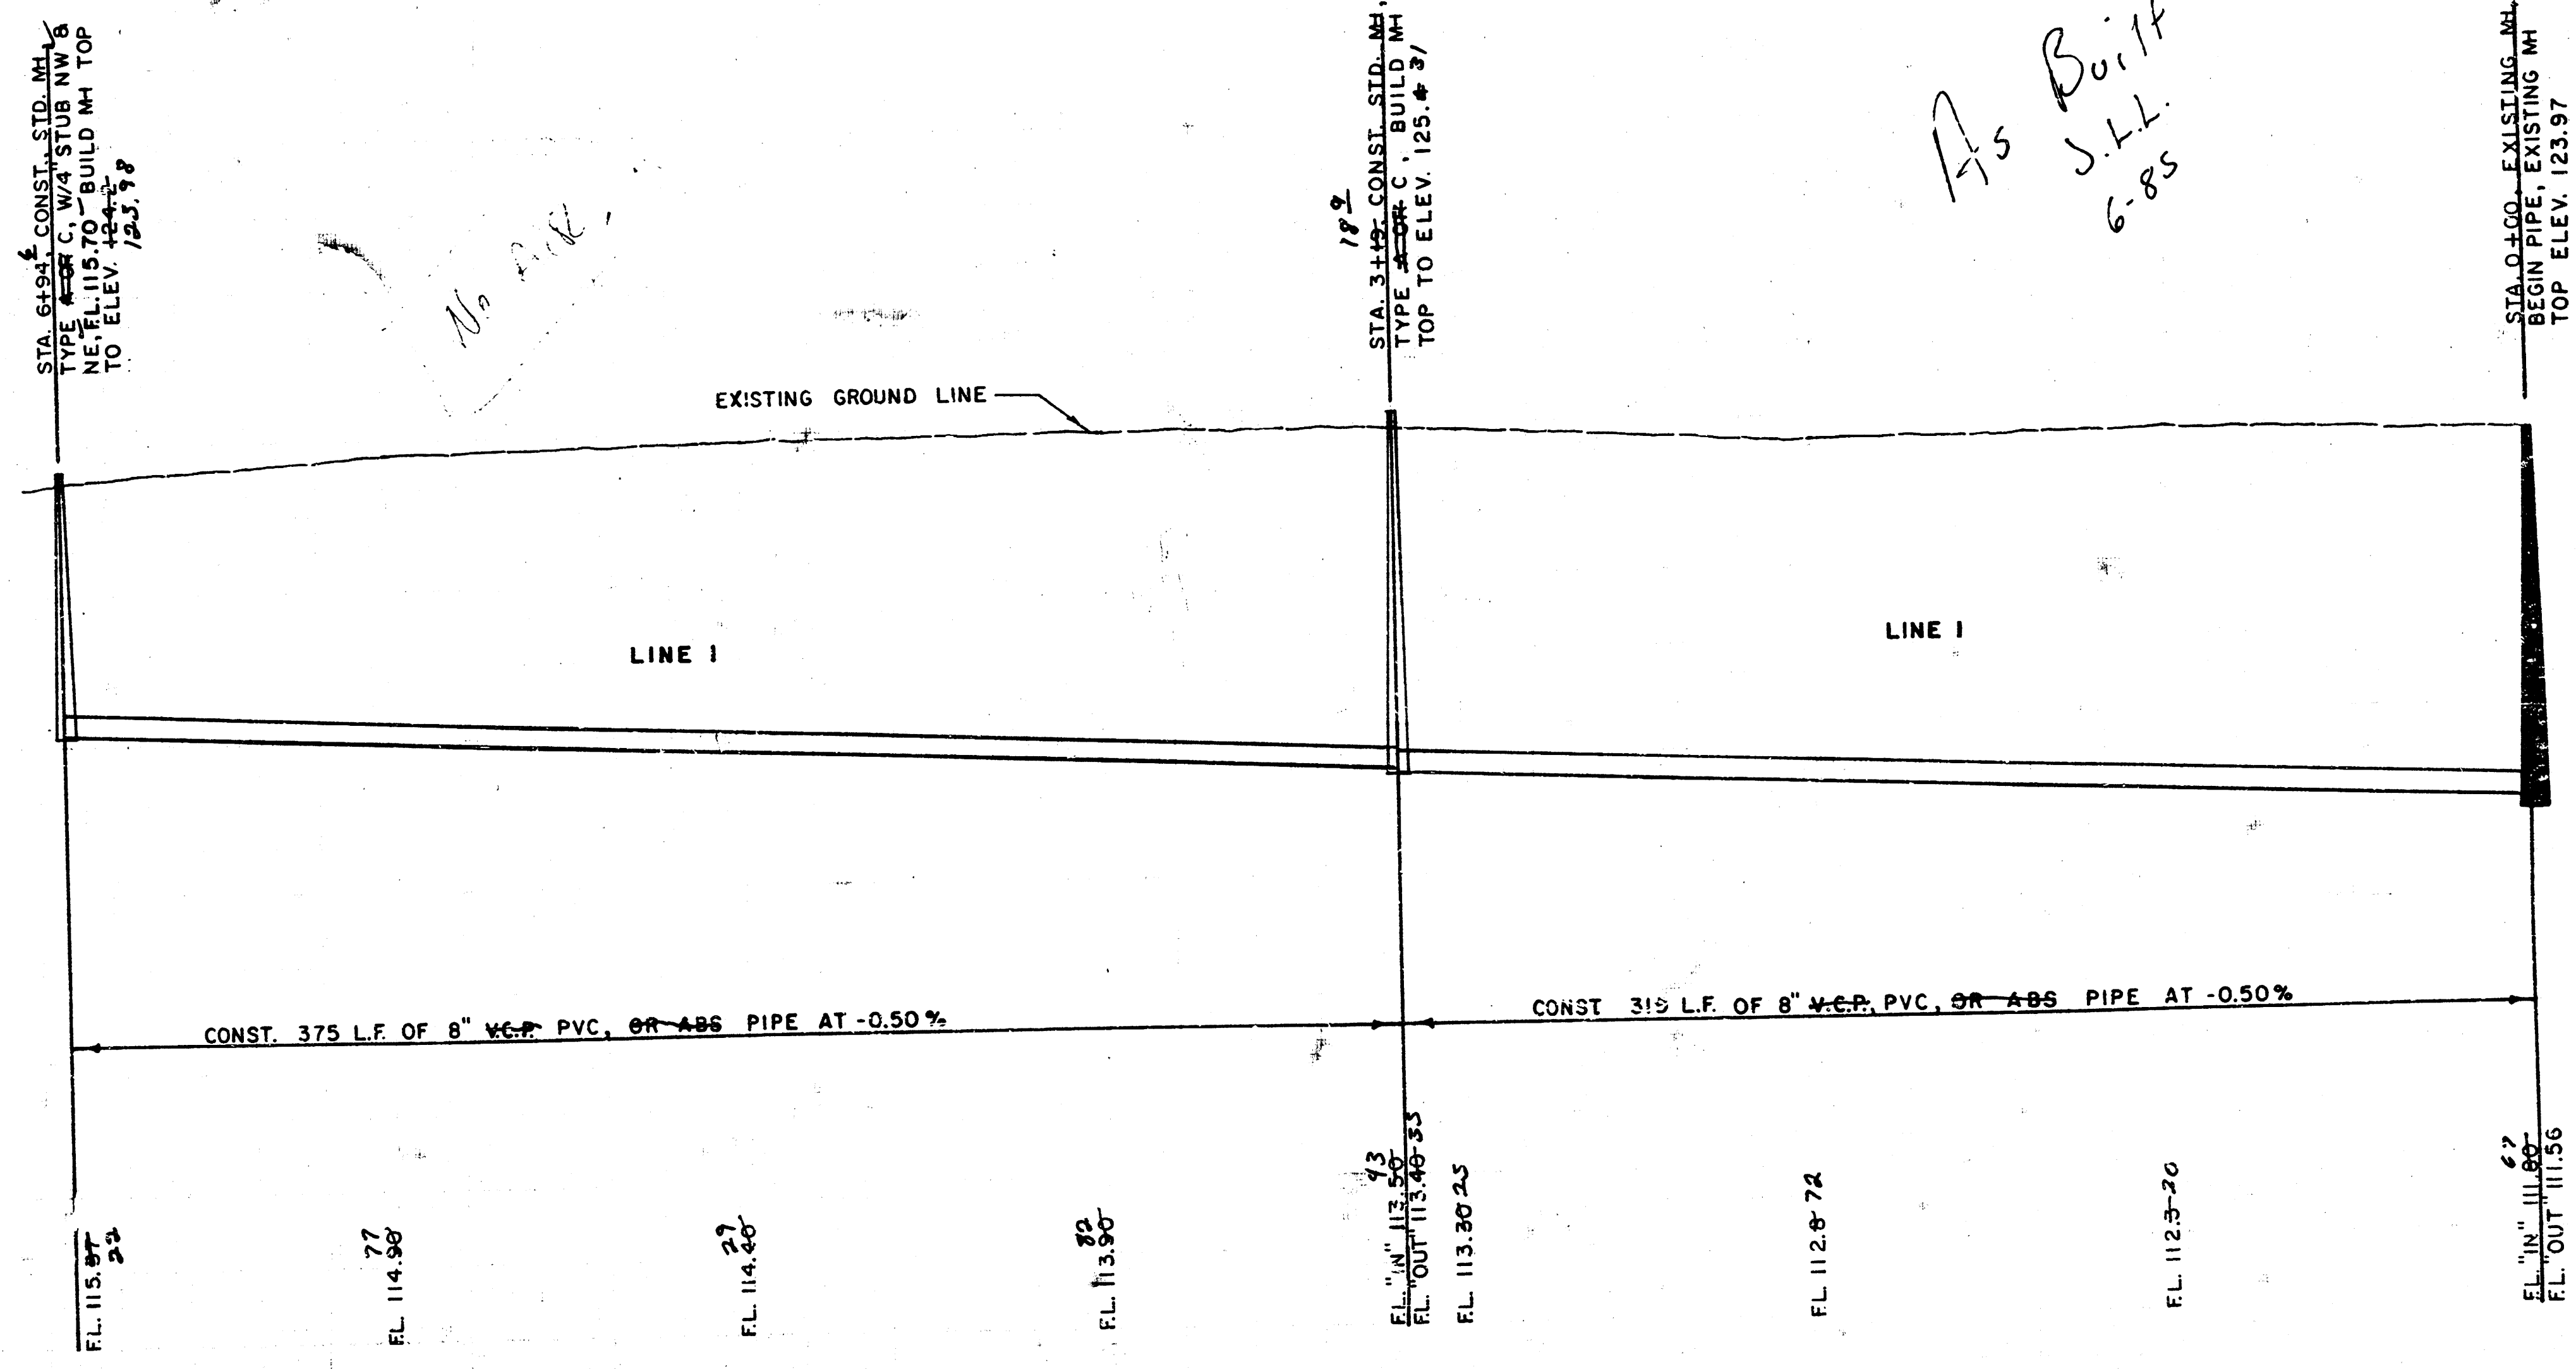


B.M. - WEST RIM OF M, STA. 0+00, LINE 1,
ELEV. 123.97

130
125
120
115
110

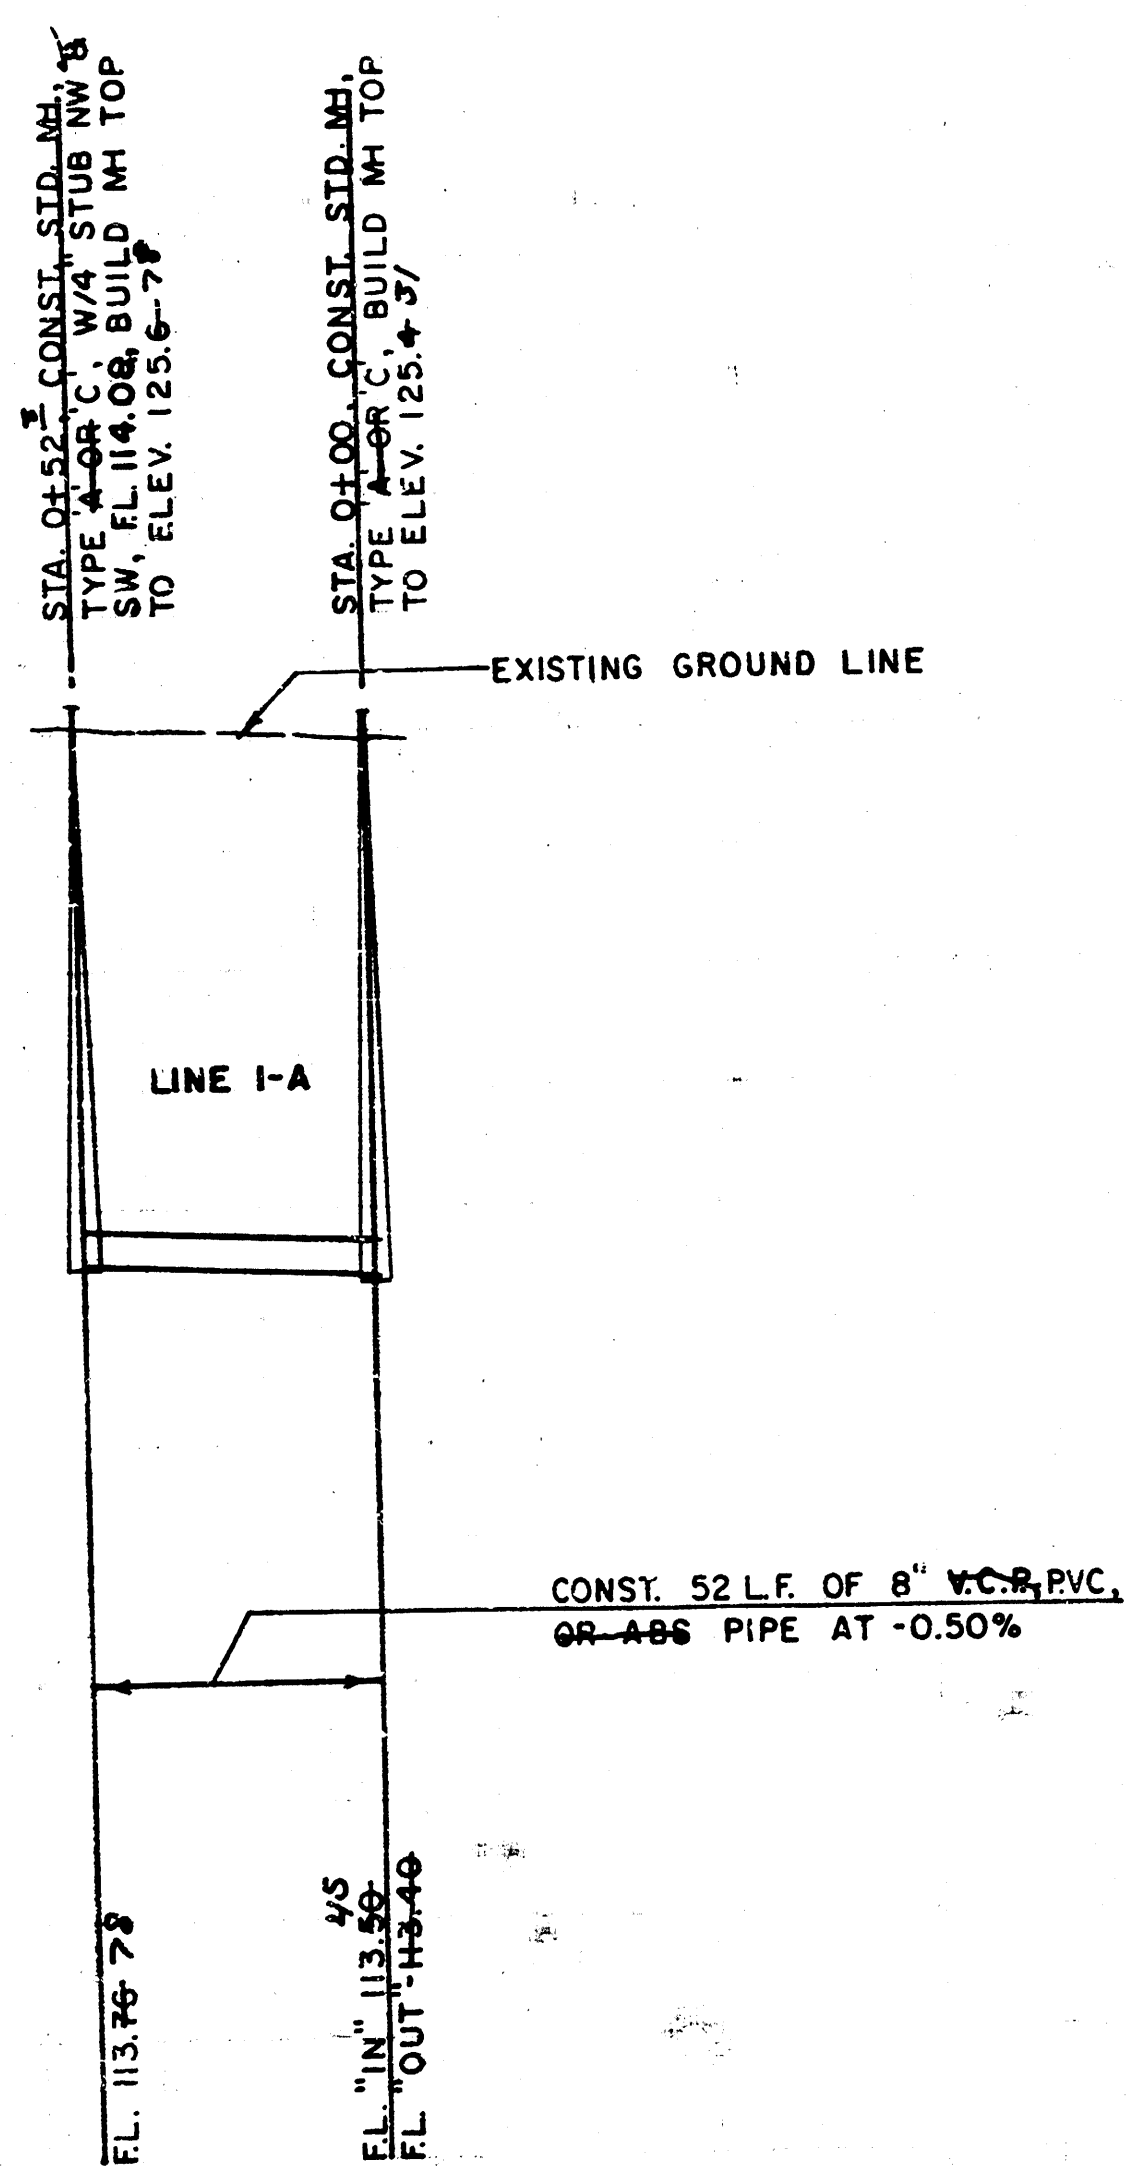


130
125
120
115
110

2/3 (2/3)

Lat 190, SW I



FILMED FROM THE BEST
AVAILABLE COPY

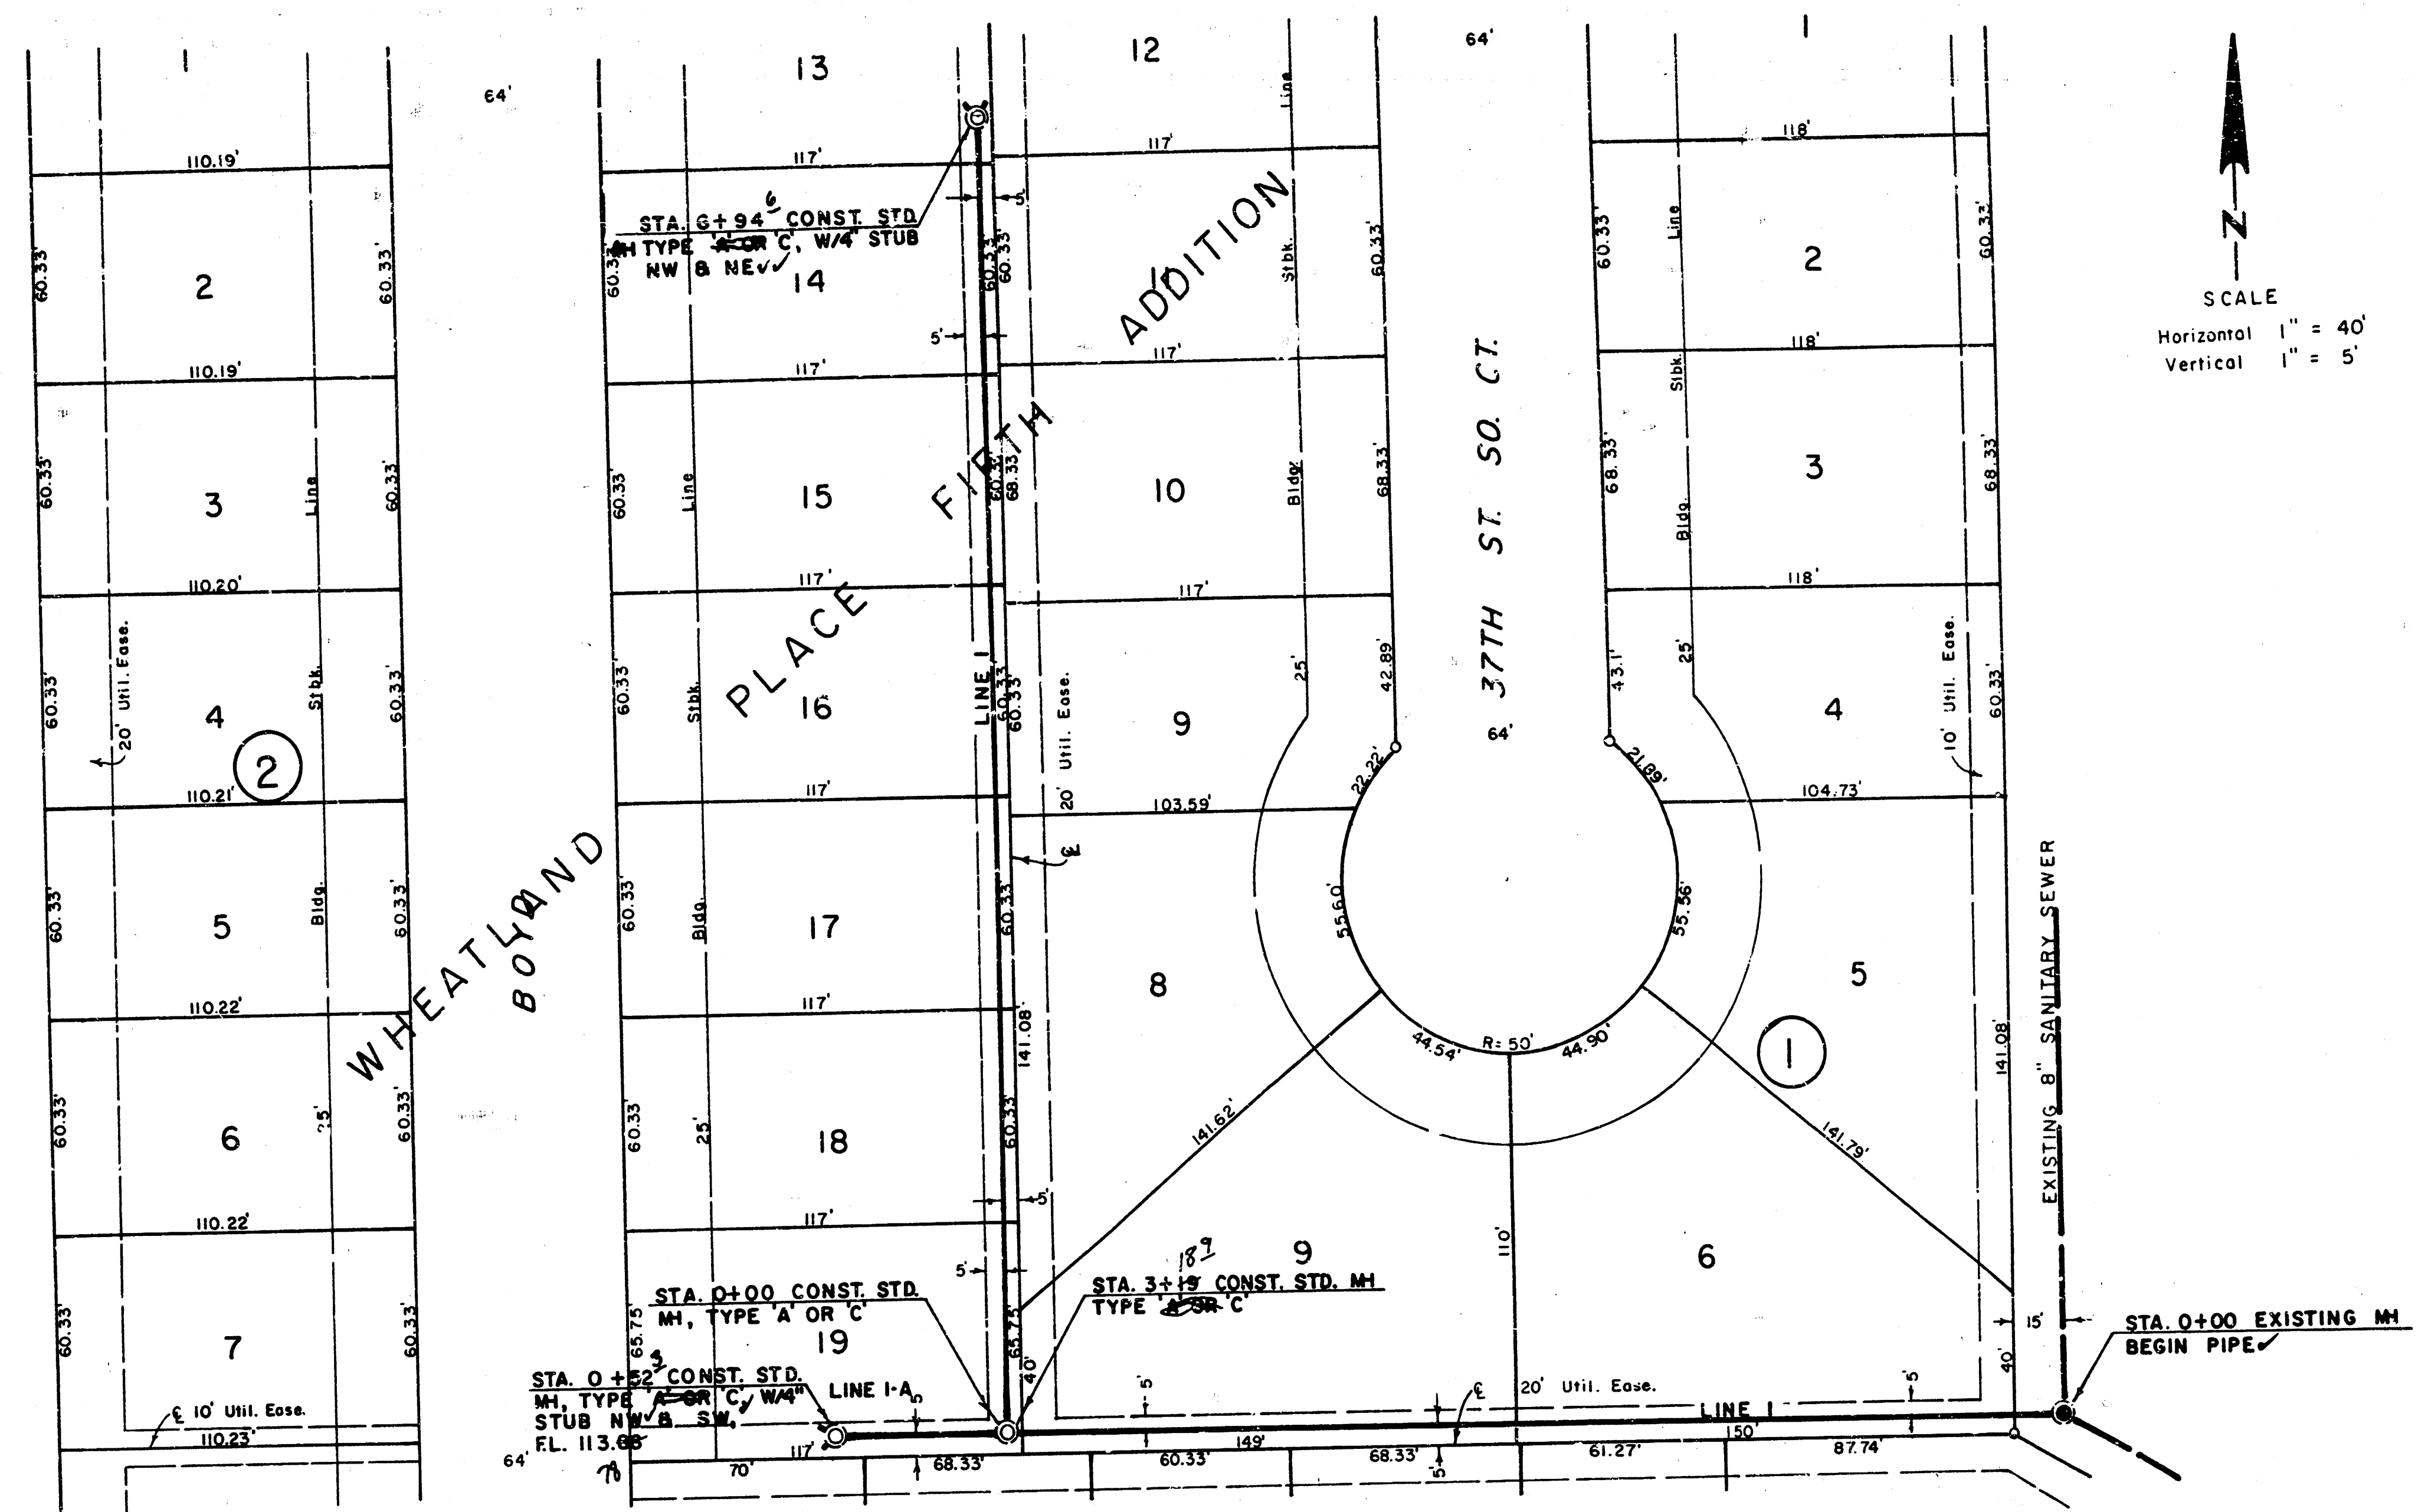

SCALE
Horizontal 1" = 40'
Vertical 1" = 5'



SCALE
Horizontal 1" = 40'
Vertical 1" = 5'

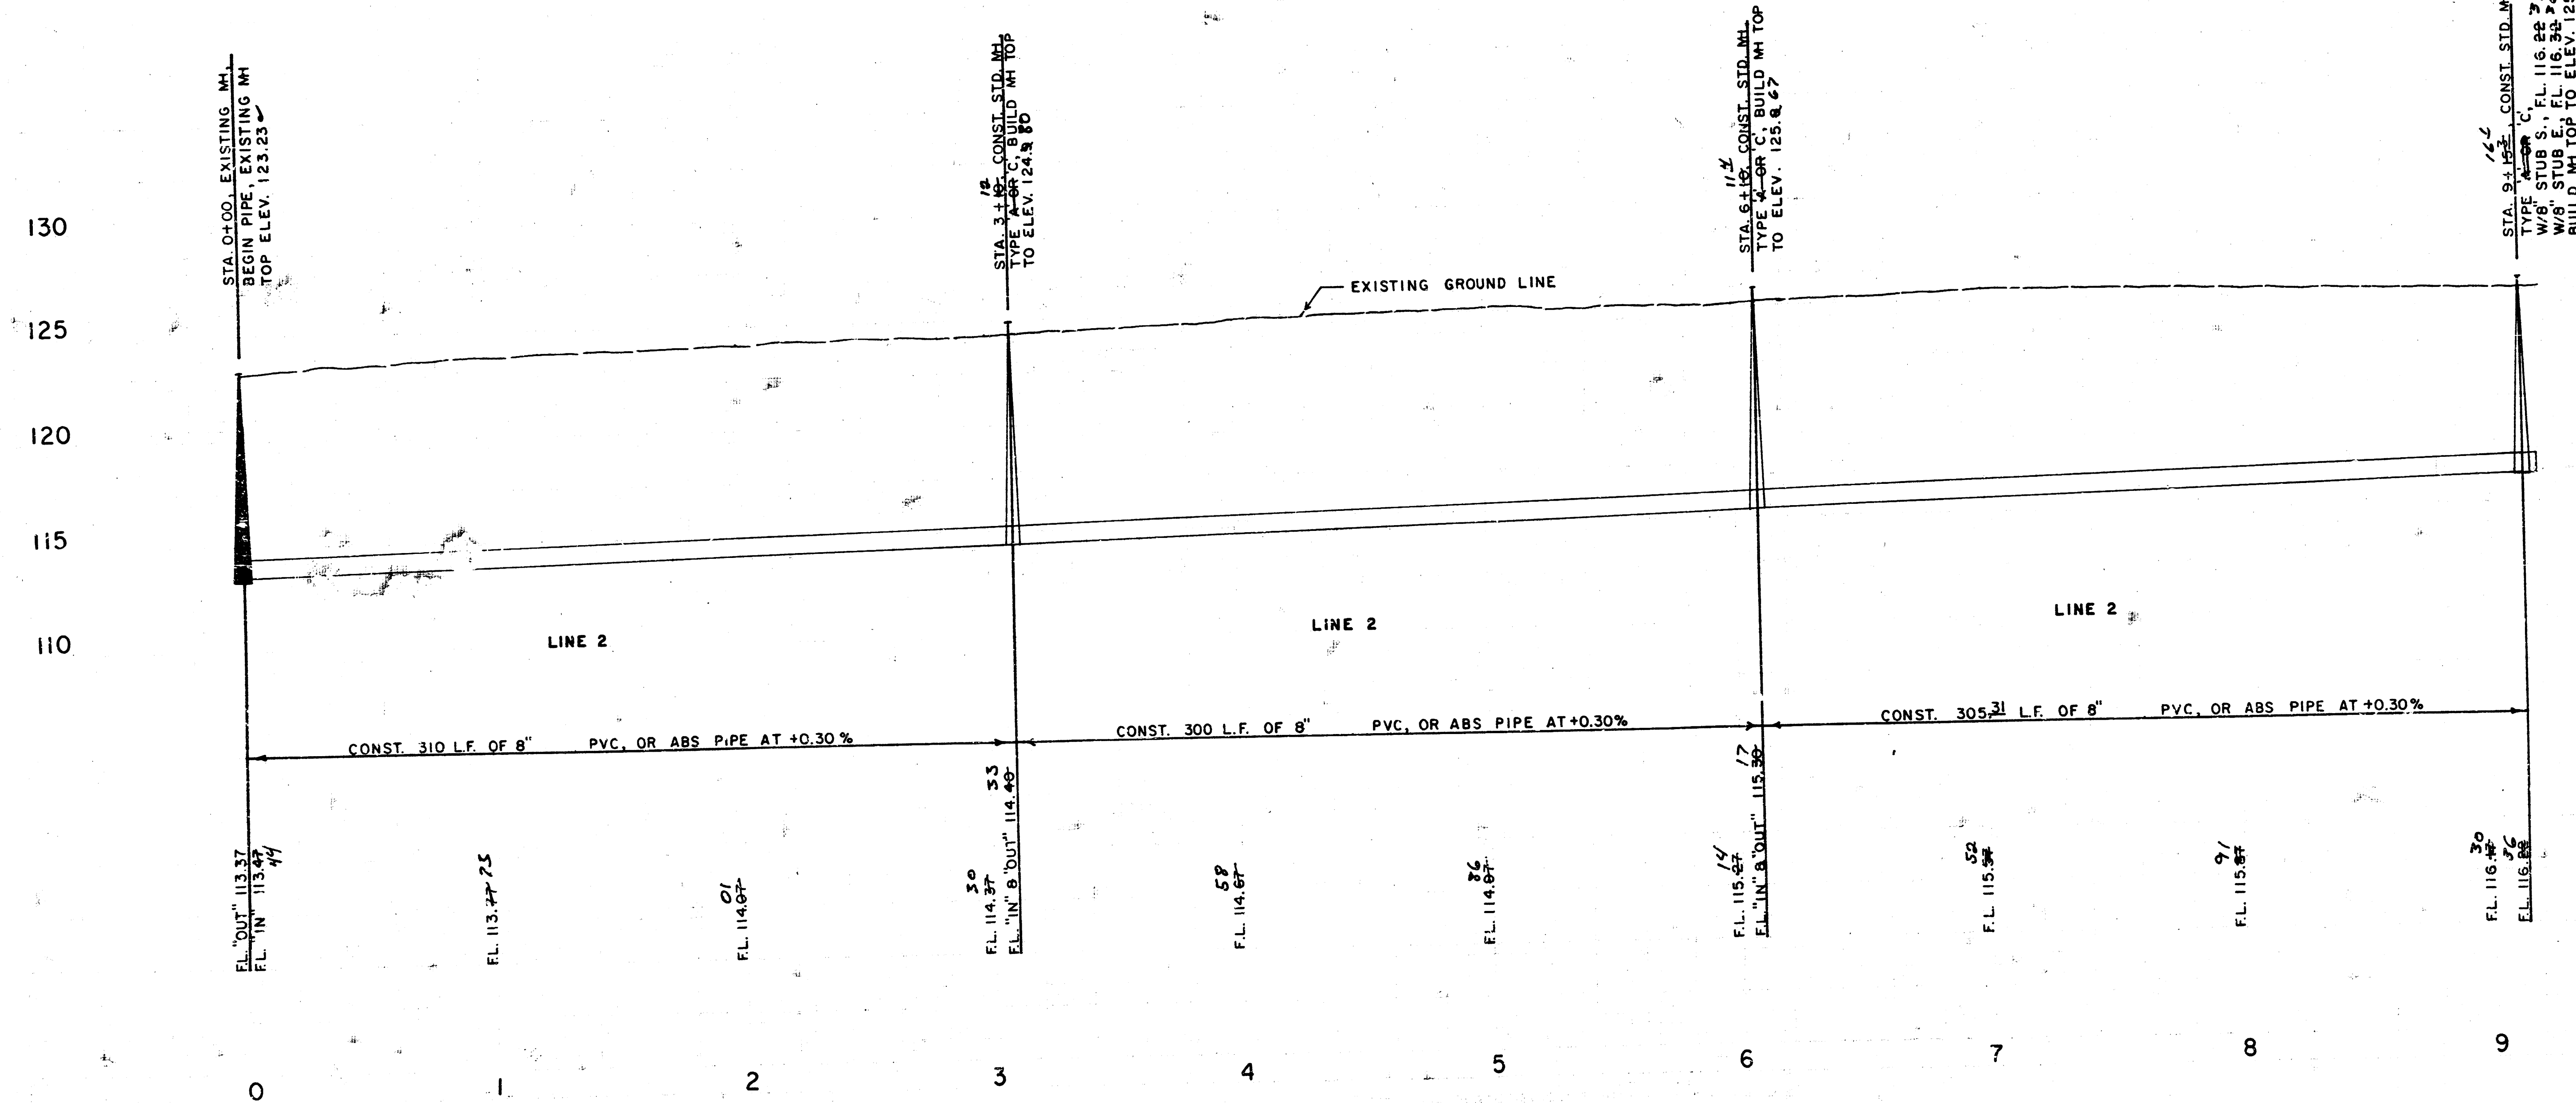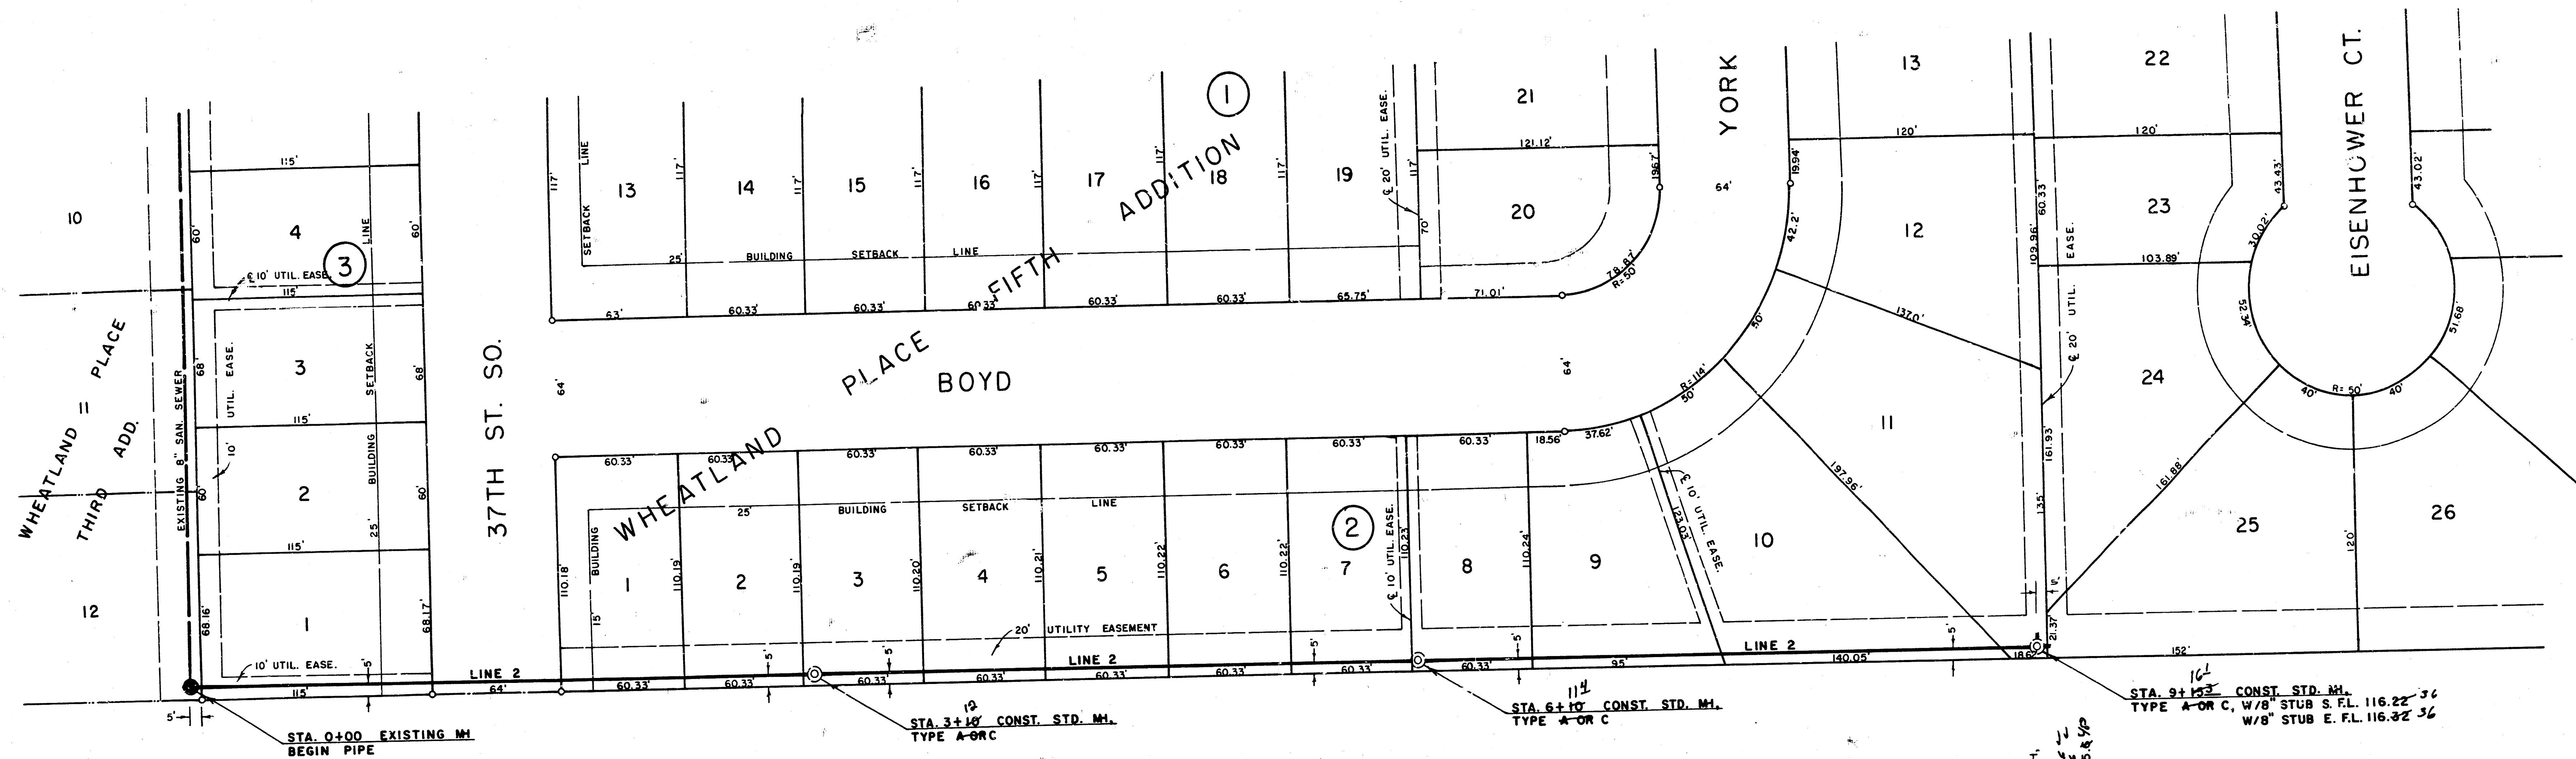

B.M. - SOUTH RIM OF M. STA. 0+00 LINE 2.
ELEV. 123.23

*As Built
J.L.L.
6-85*

3/3

Lat 190. SW I

FILMED FROM THE BEST
AVAILABLE COPY.....