


ERAL 200, S. W. INTERCEPTOR
PROJECT NO.
468-76-245-81438-000-000-001

CITY OF WICHITA, KANSAS
MICHAEL E. LINDEBAK, CITY ENGINEER

GENERAL NOTES

1. The contractor shall be responsible for preserving property irons. The contractor shall be required to re-establish any property irons which are damaged or destroyed by his construction operations. Such irons shall be re-established by a licensed land surveyor or a licensed professional engineer in accordance with state laws.
2. Contractor shall contact Kan U Dig It, phone no. 267-2809 and/or the operating authority responsible for each utility, prior to construction. The contractor shall be responsible for location of all utilities, and shall protect all utilities from damage due to construction operations. All costs of repair and restoration of existing utilities damaged by the contractor shall be the responsibility of the contractor.
3. All work required to complete the project in accordance with the plans and standard specifications not specifically listed in the bid form shall be considered incidental to the project.


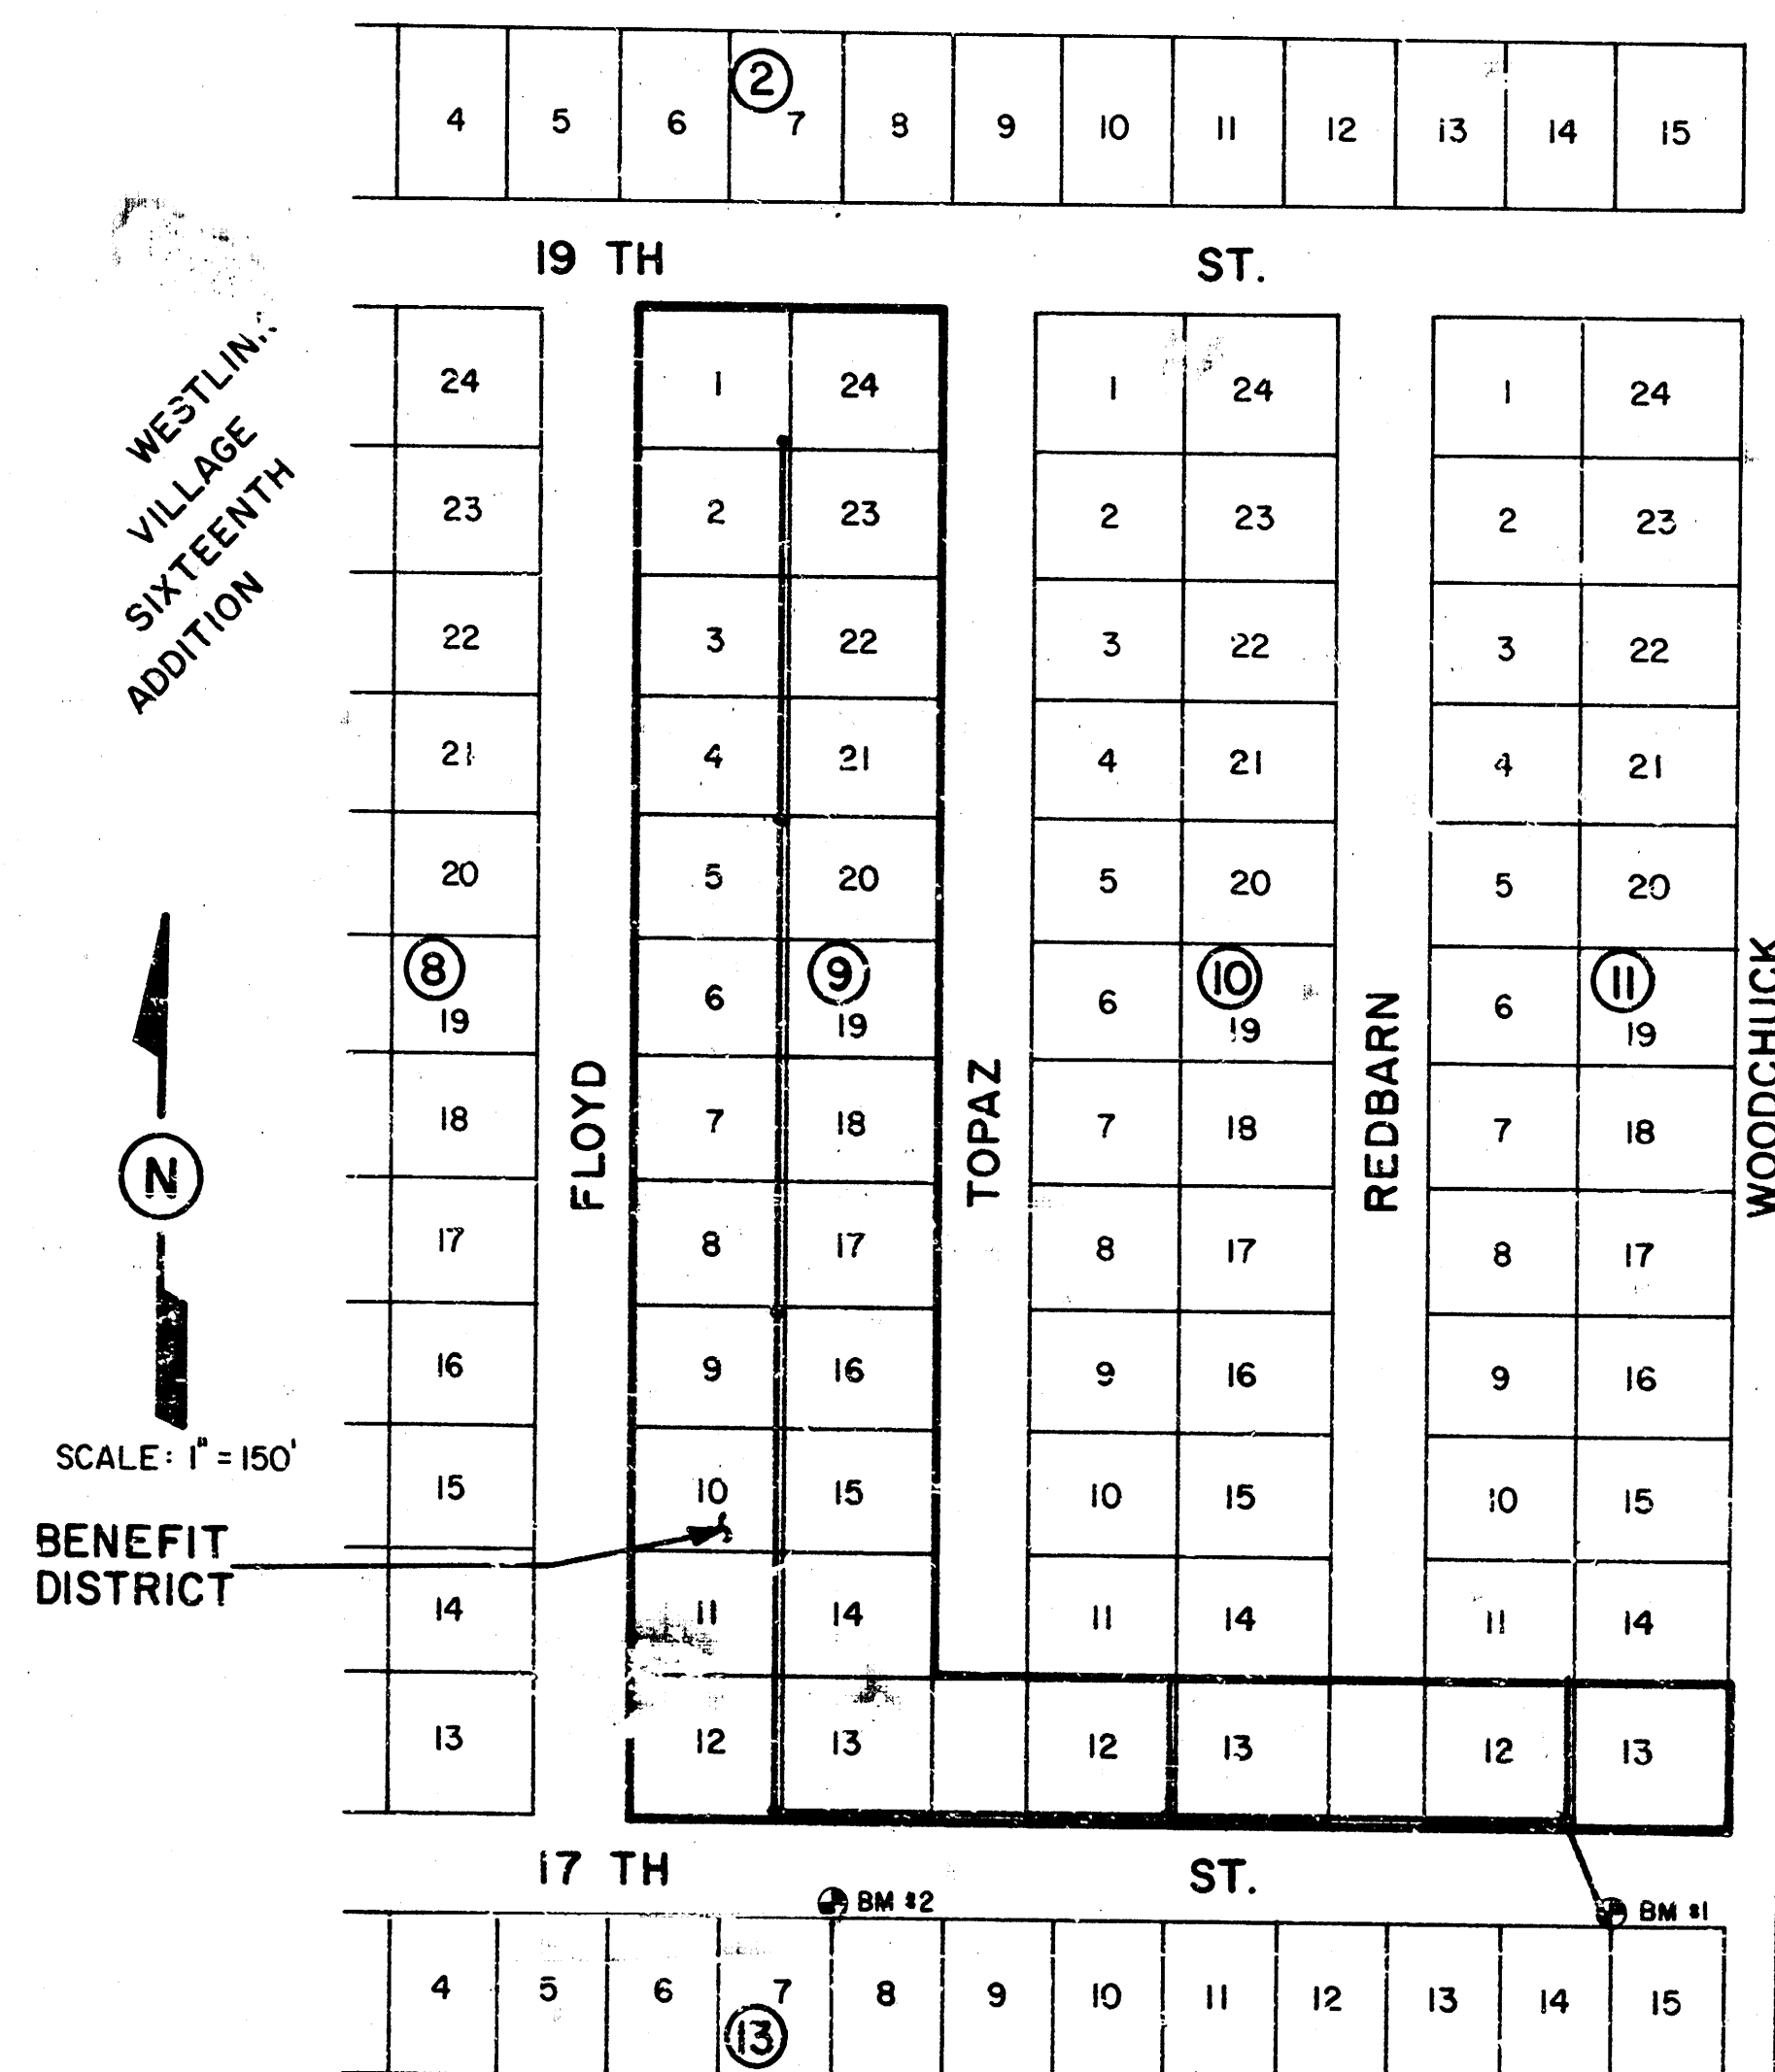


As Built
J.L.L.
8-85

INDEX


- | | |
|-----|-----------------------|
| 1 | Title Sheet |
| 2-3 | Plan Profile |
| 4 | Type A Manhole Detail |
| 5 | Type C Manhole Detail |
| 6 | Final Plat |



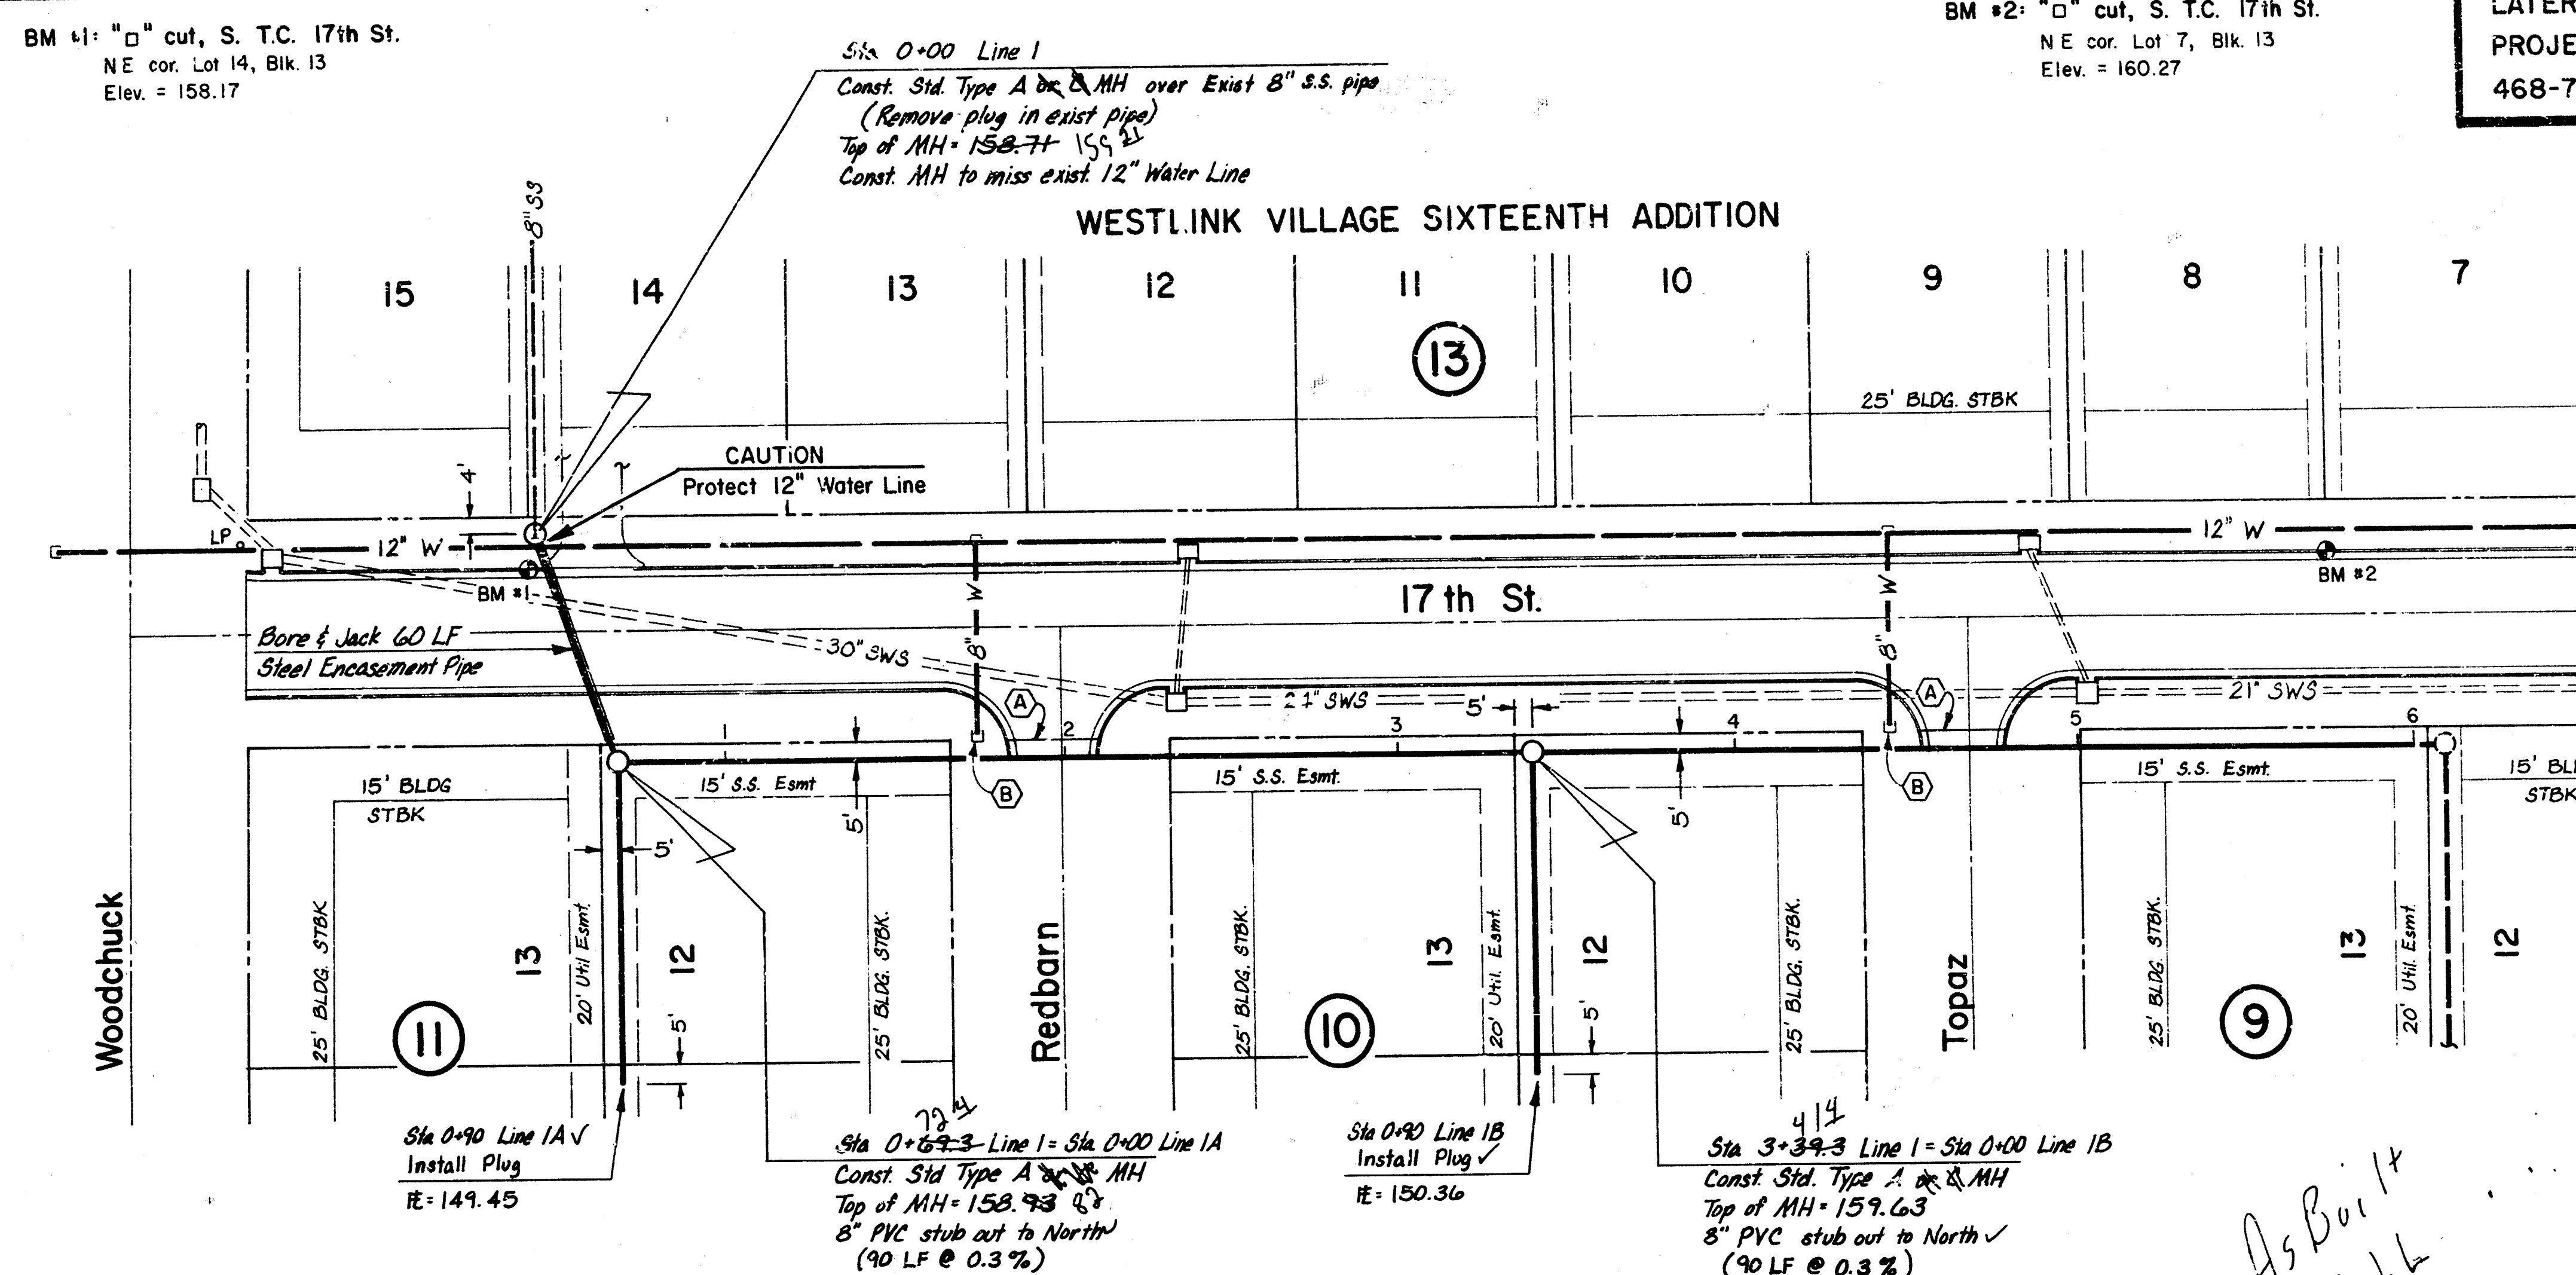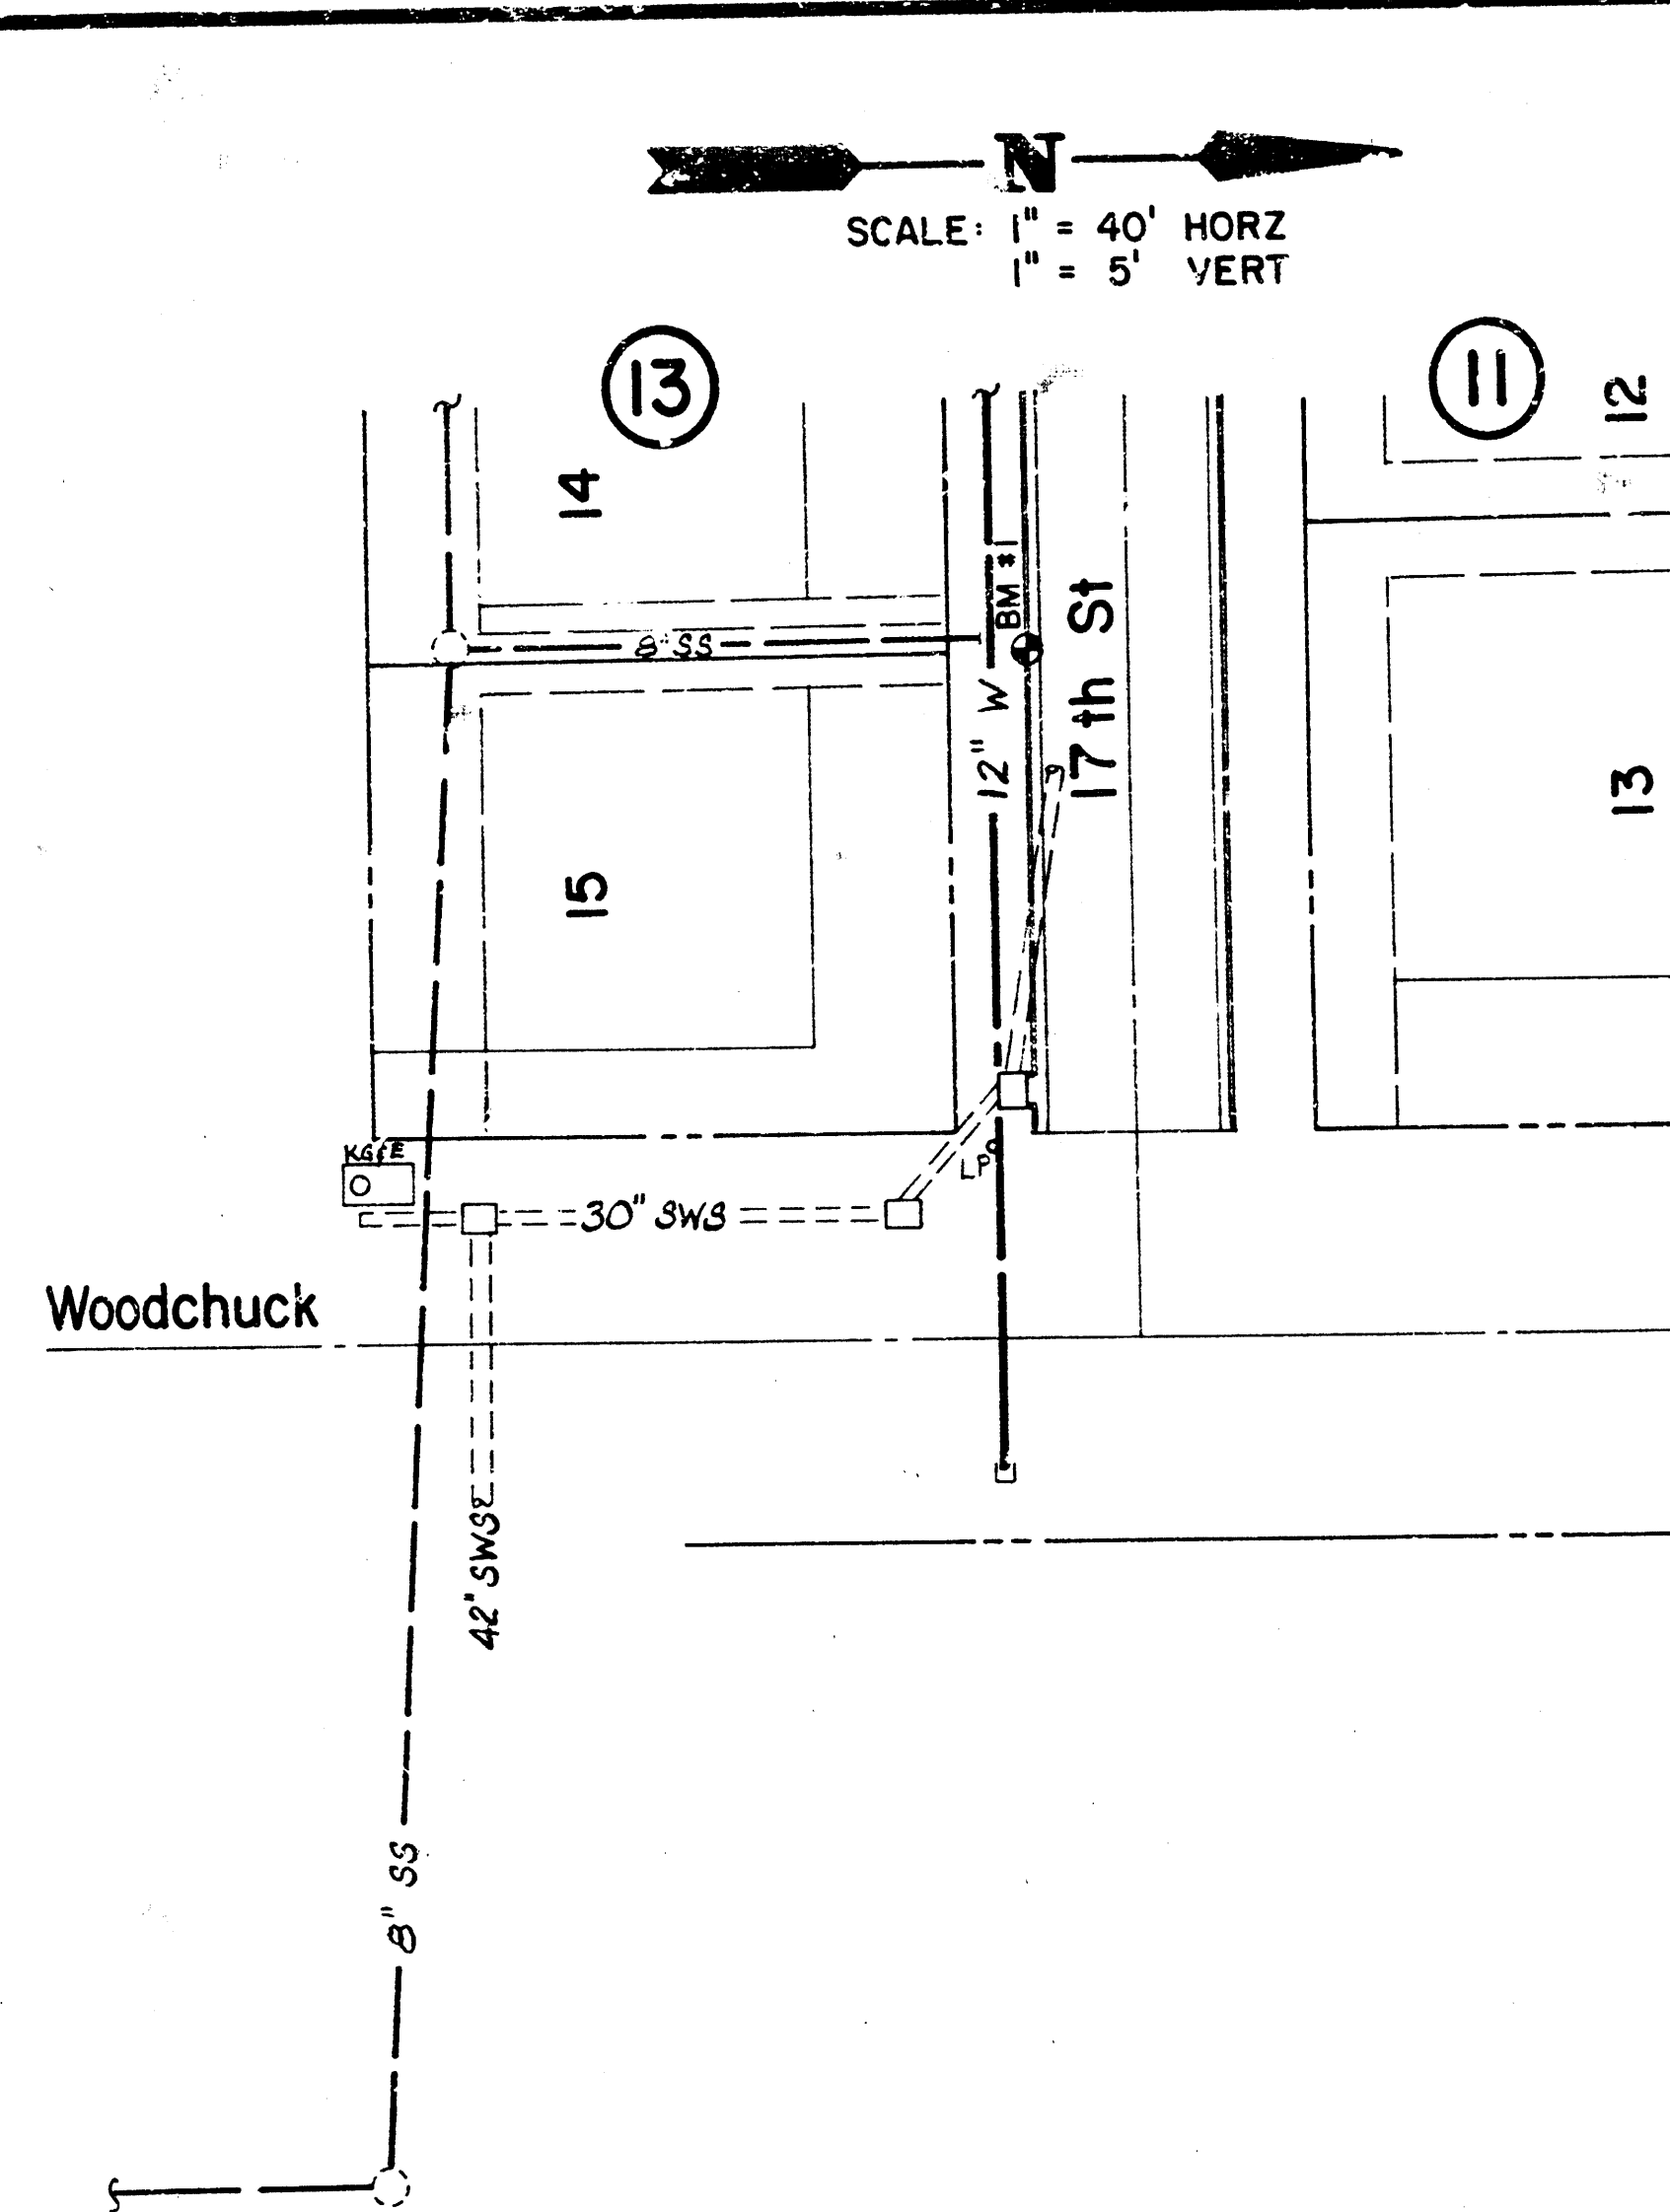

LATERAL 200, S.W. INTERCEPTOR
PROJECT NO.
468-76-245-81438-000-001


- NOTES
- (A) Saw Cut, remove conc curb & gutter & asphalt as reqd. Cost incidental (2 places)
 - (B) Caution: Protect Water Line stubs (2 places)

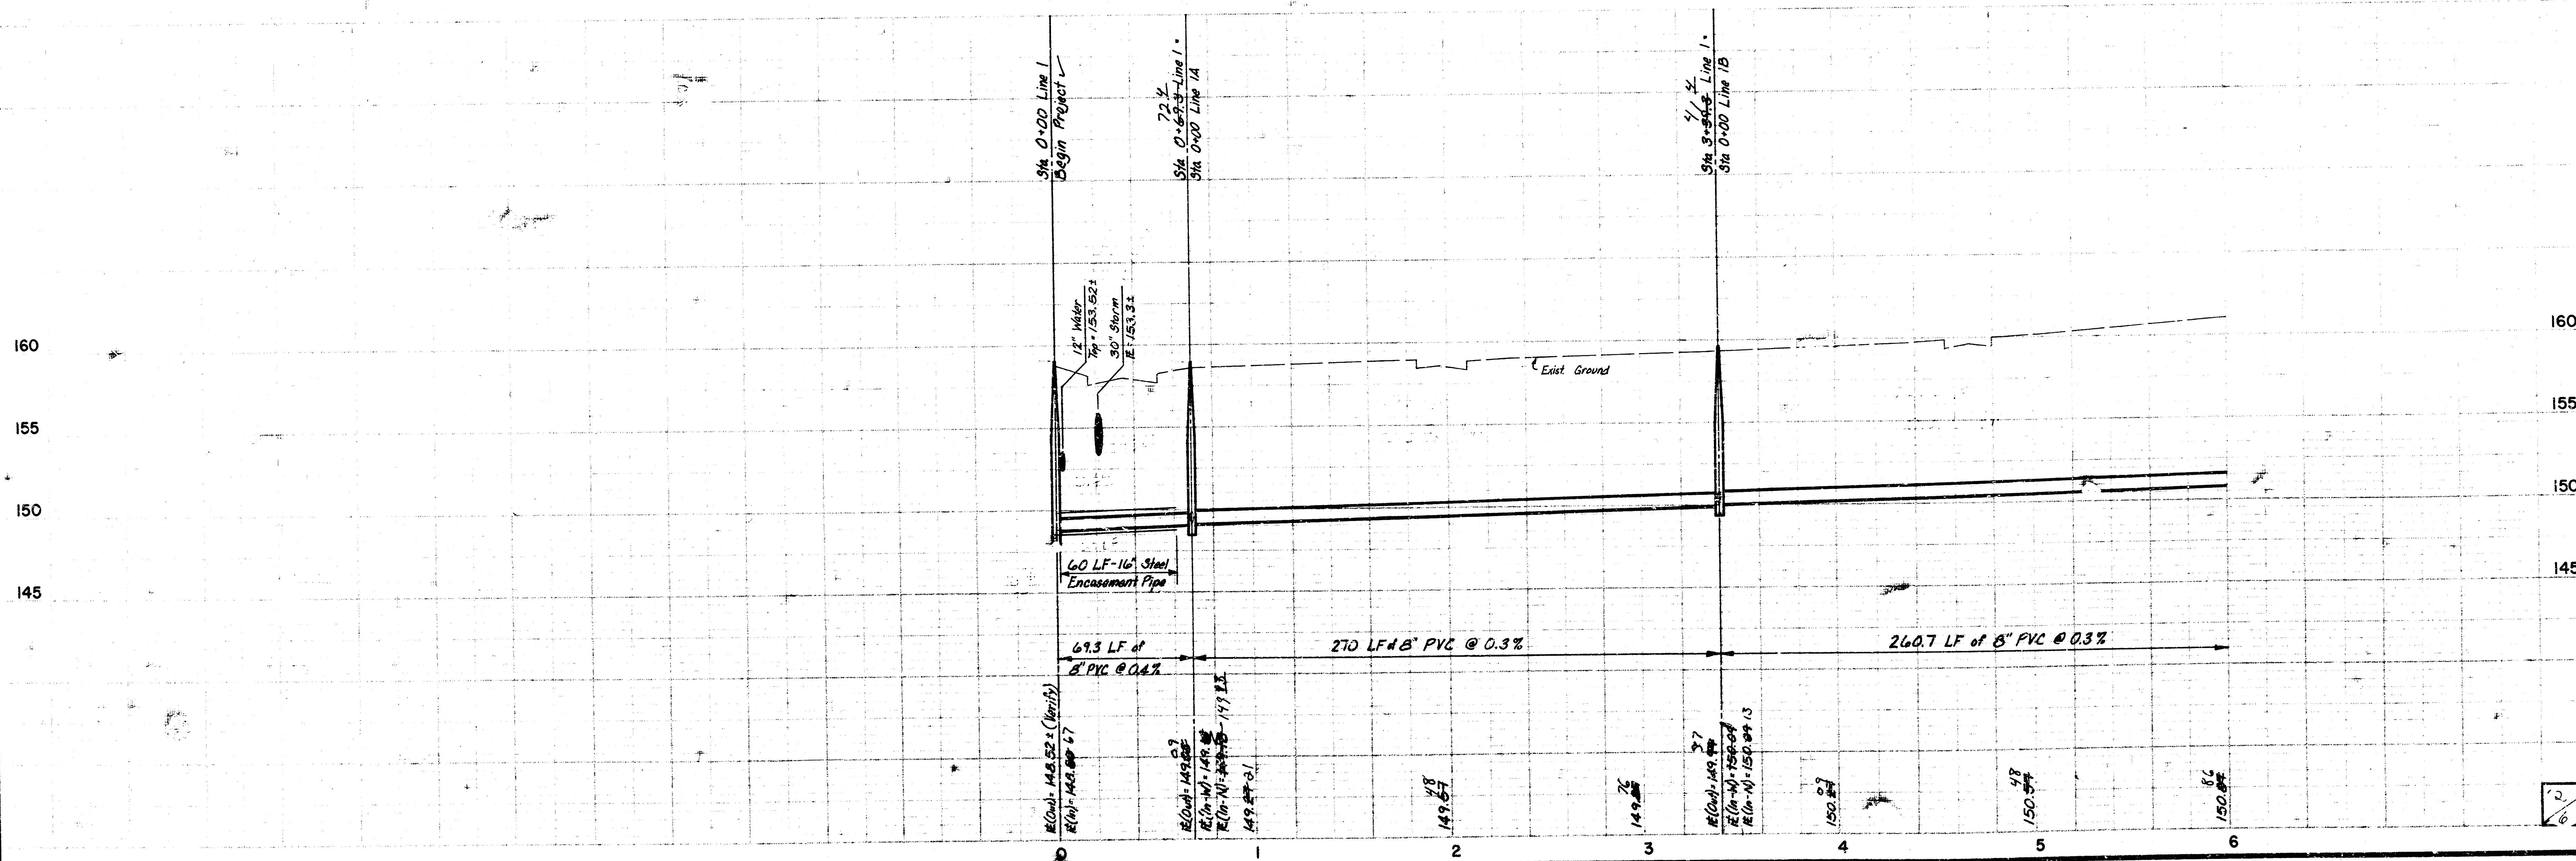


BM #2: "d" cut, S.T.C. 17th St.
N.E. cor. Lot 7, Blk. 13
Elev. = 160.27

LATERAL 200, S.W. INTERCEPTOR
PROJECT NO.
468-76-245-81438-000-001

SCALE: 1" = 40' HORZ
1" = 5' VERT

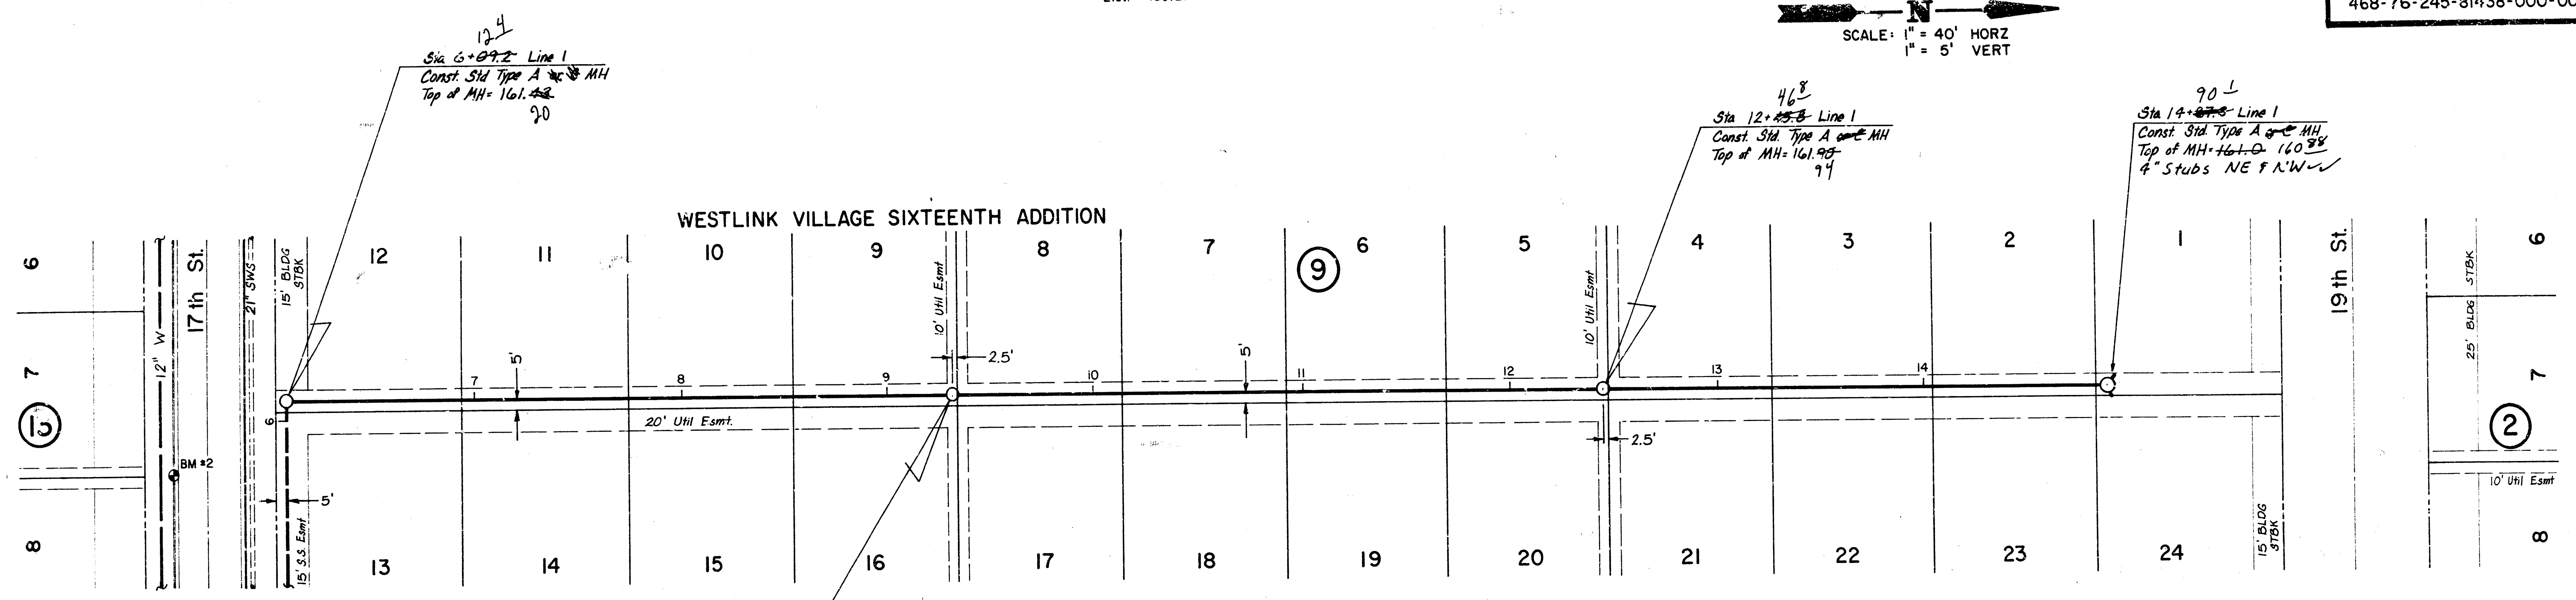

As Built
J.L.L.
8-85

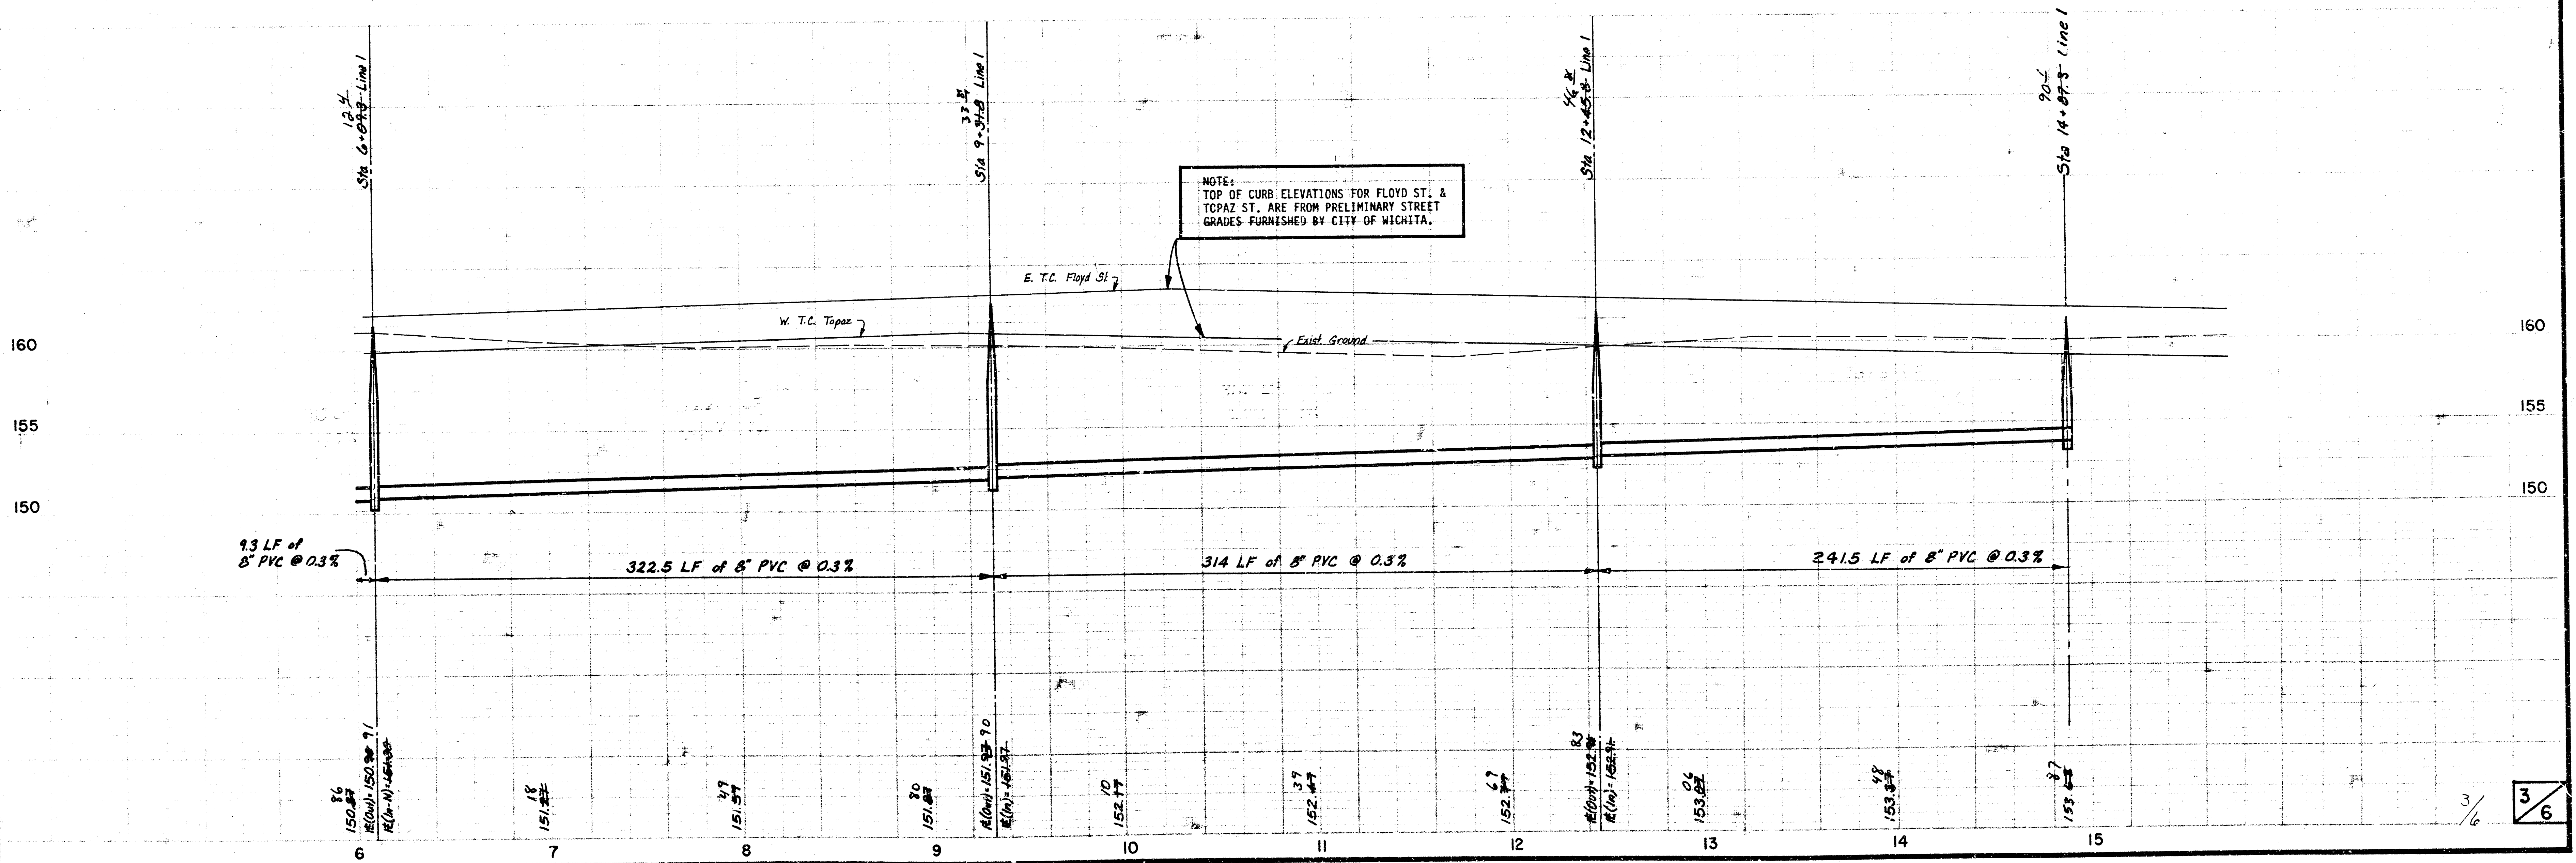


SEWER APPURTENANCES DETAILS

ADOPTED AS STANDARD DESIGN
BY


CITY of WICHITA, KANSAS

REVISED SEPTEMBER 1980


TYPE "A" MANHOLE

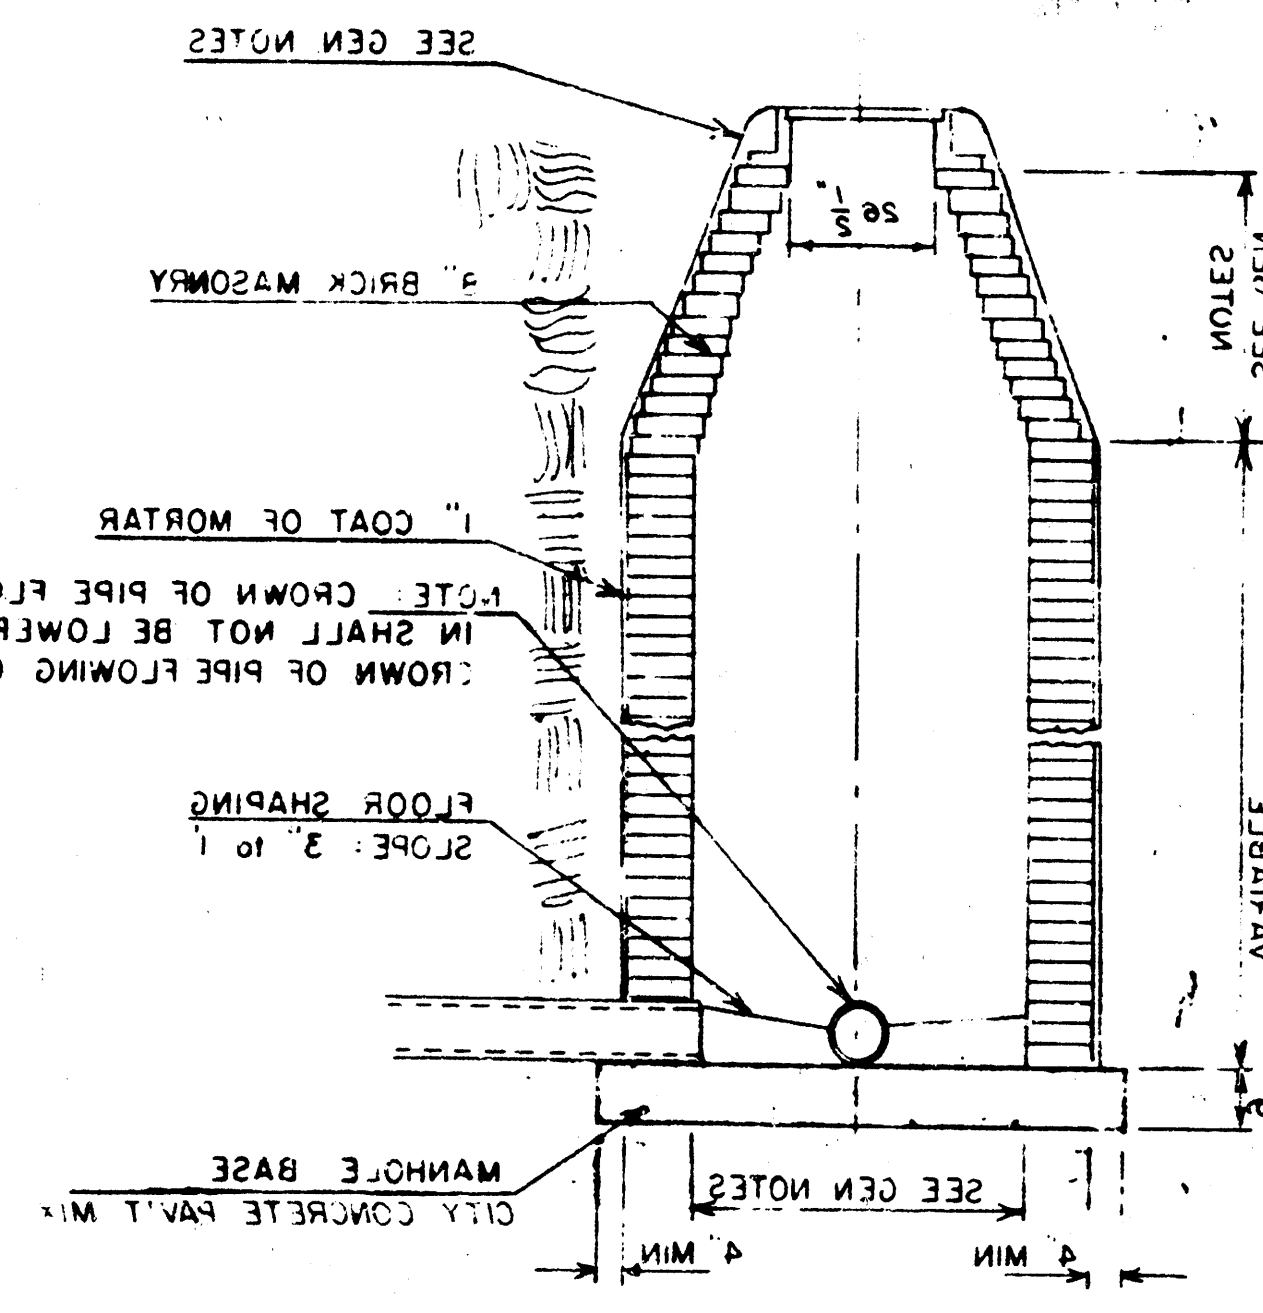

TYPE "A" INSIDE DROP MANHOLE

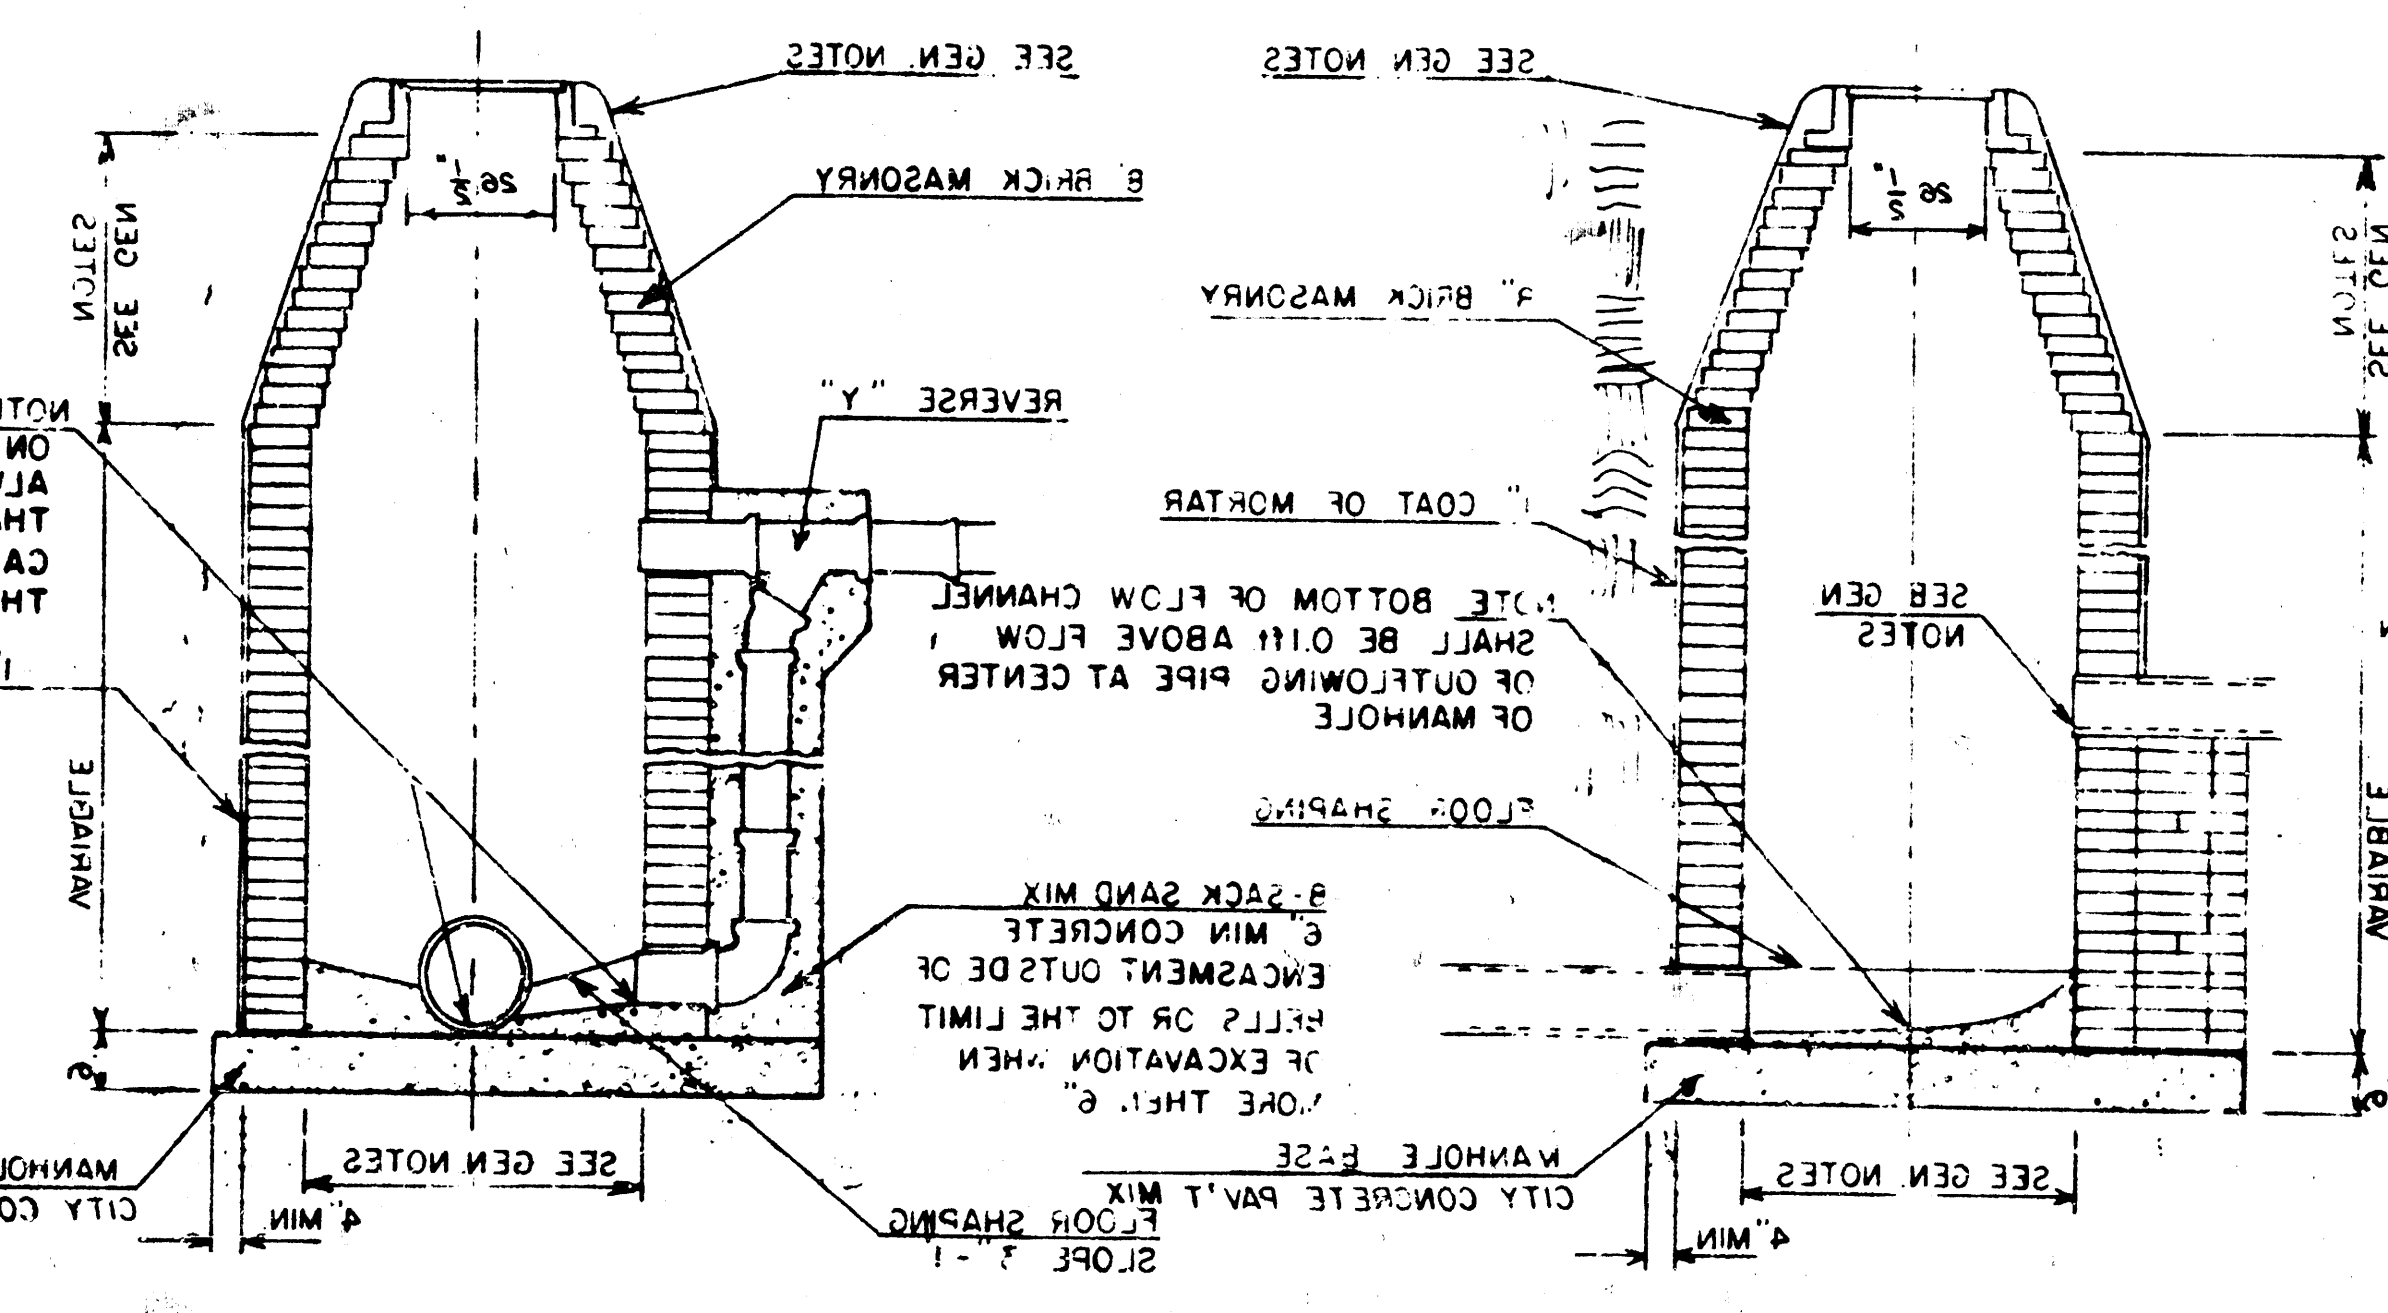

TYPE "A" OUTSIDE DROP MANHOLE

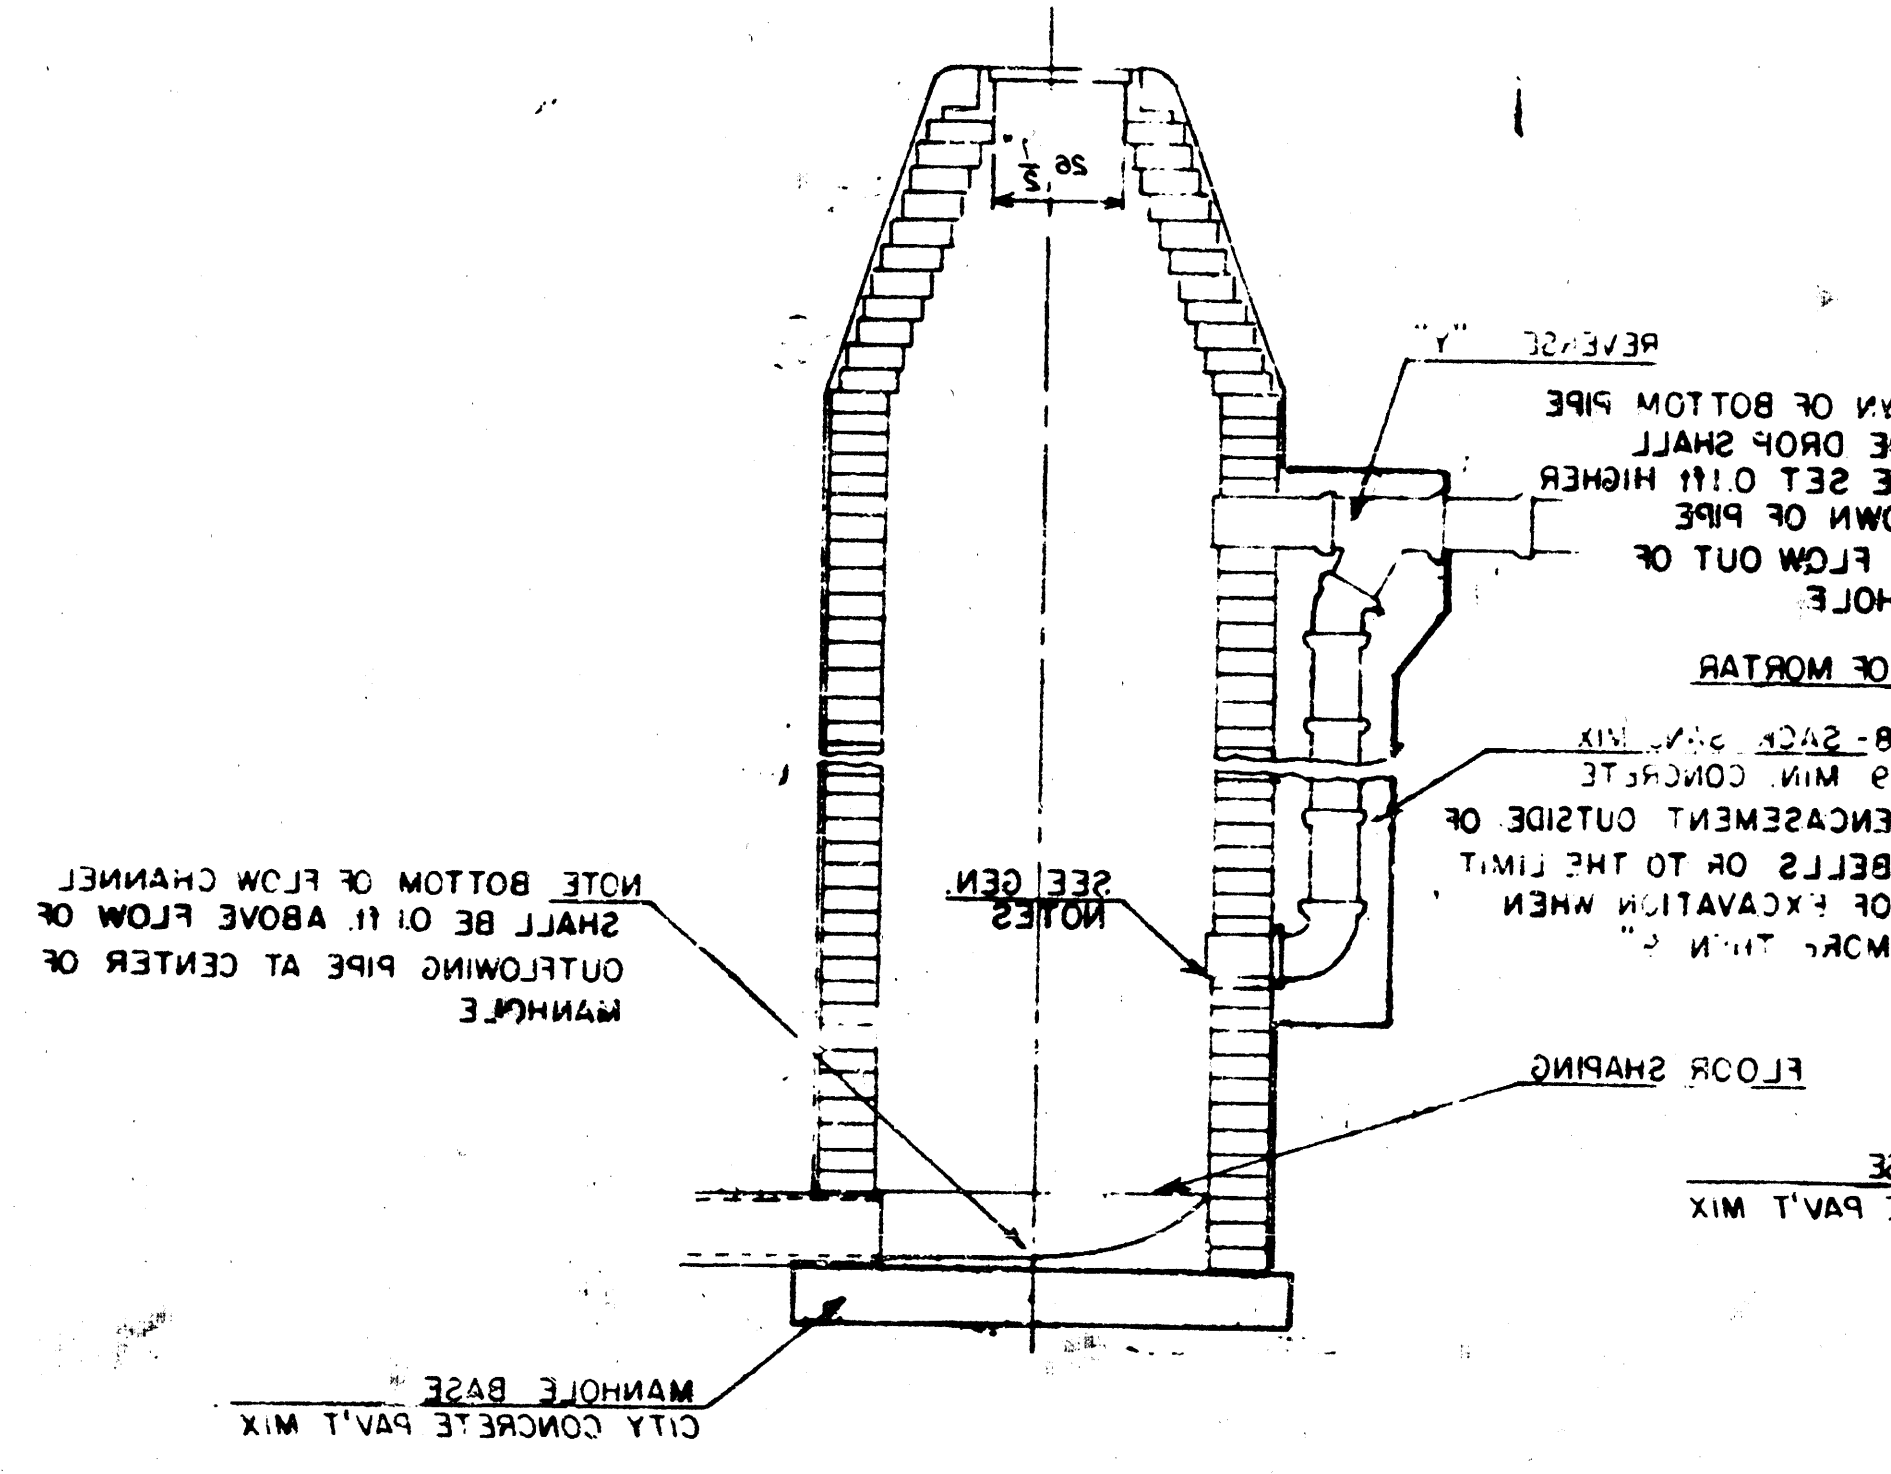

CONSTRUCTED ON EXISTING MANHOLE
DETAIL OF OUTSIDE DROP


SEWER APPURTENANCES DETAILS

ADOPTED AS STANDARD DESIGN


BY

City of Wichita, Kansas


STANDARD MANHOLE TYPE "C"

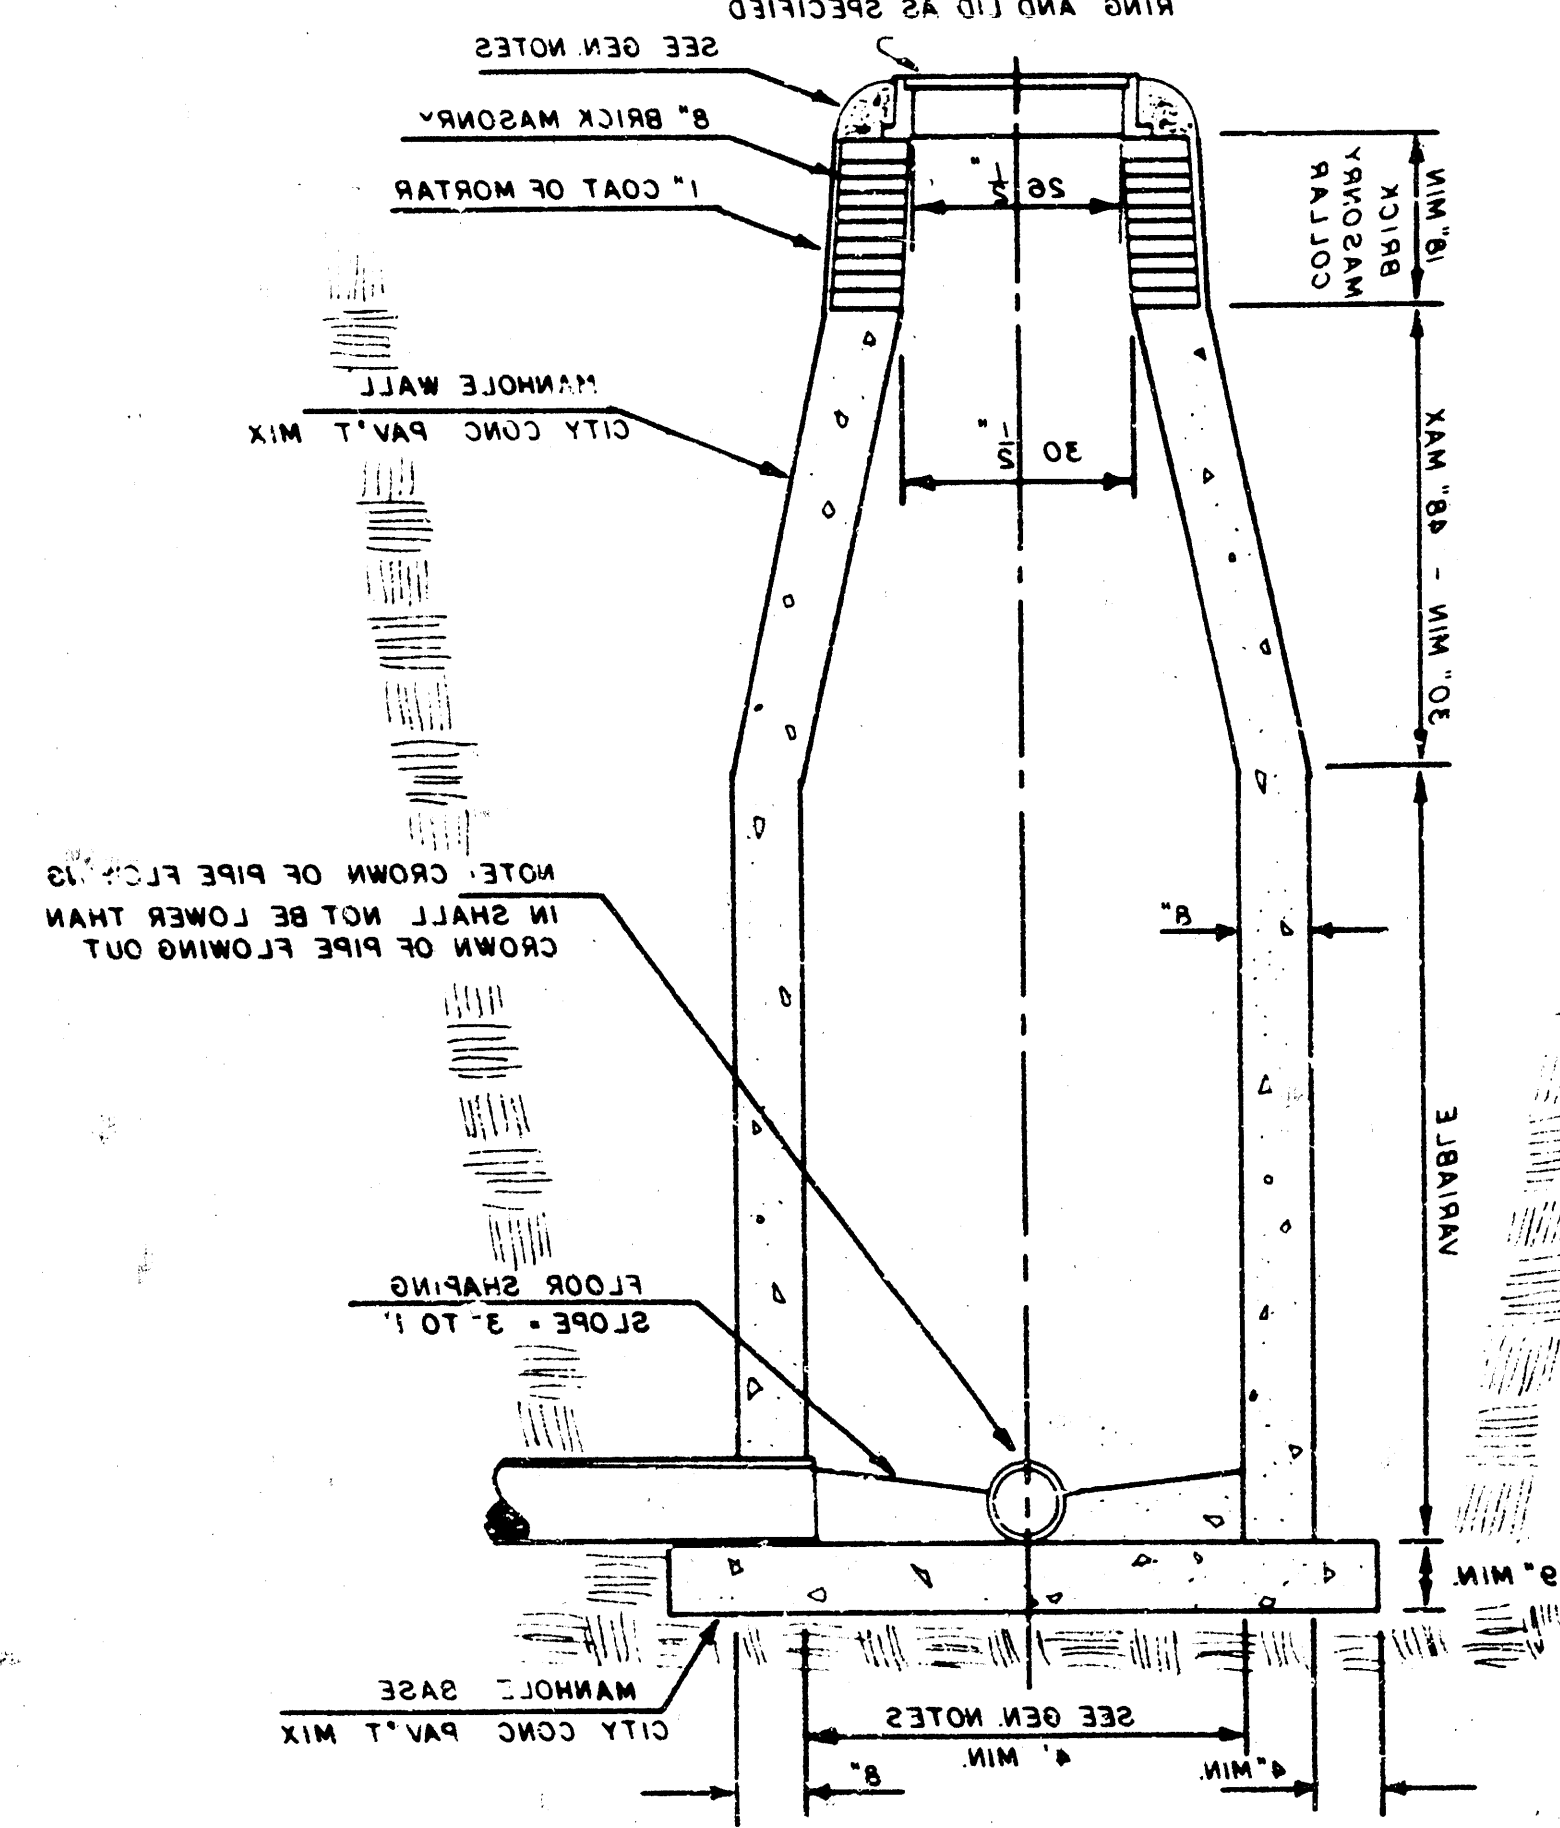

INSIDE DROP MANHOLE TYPE "C"

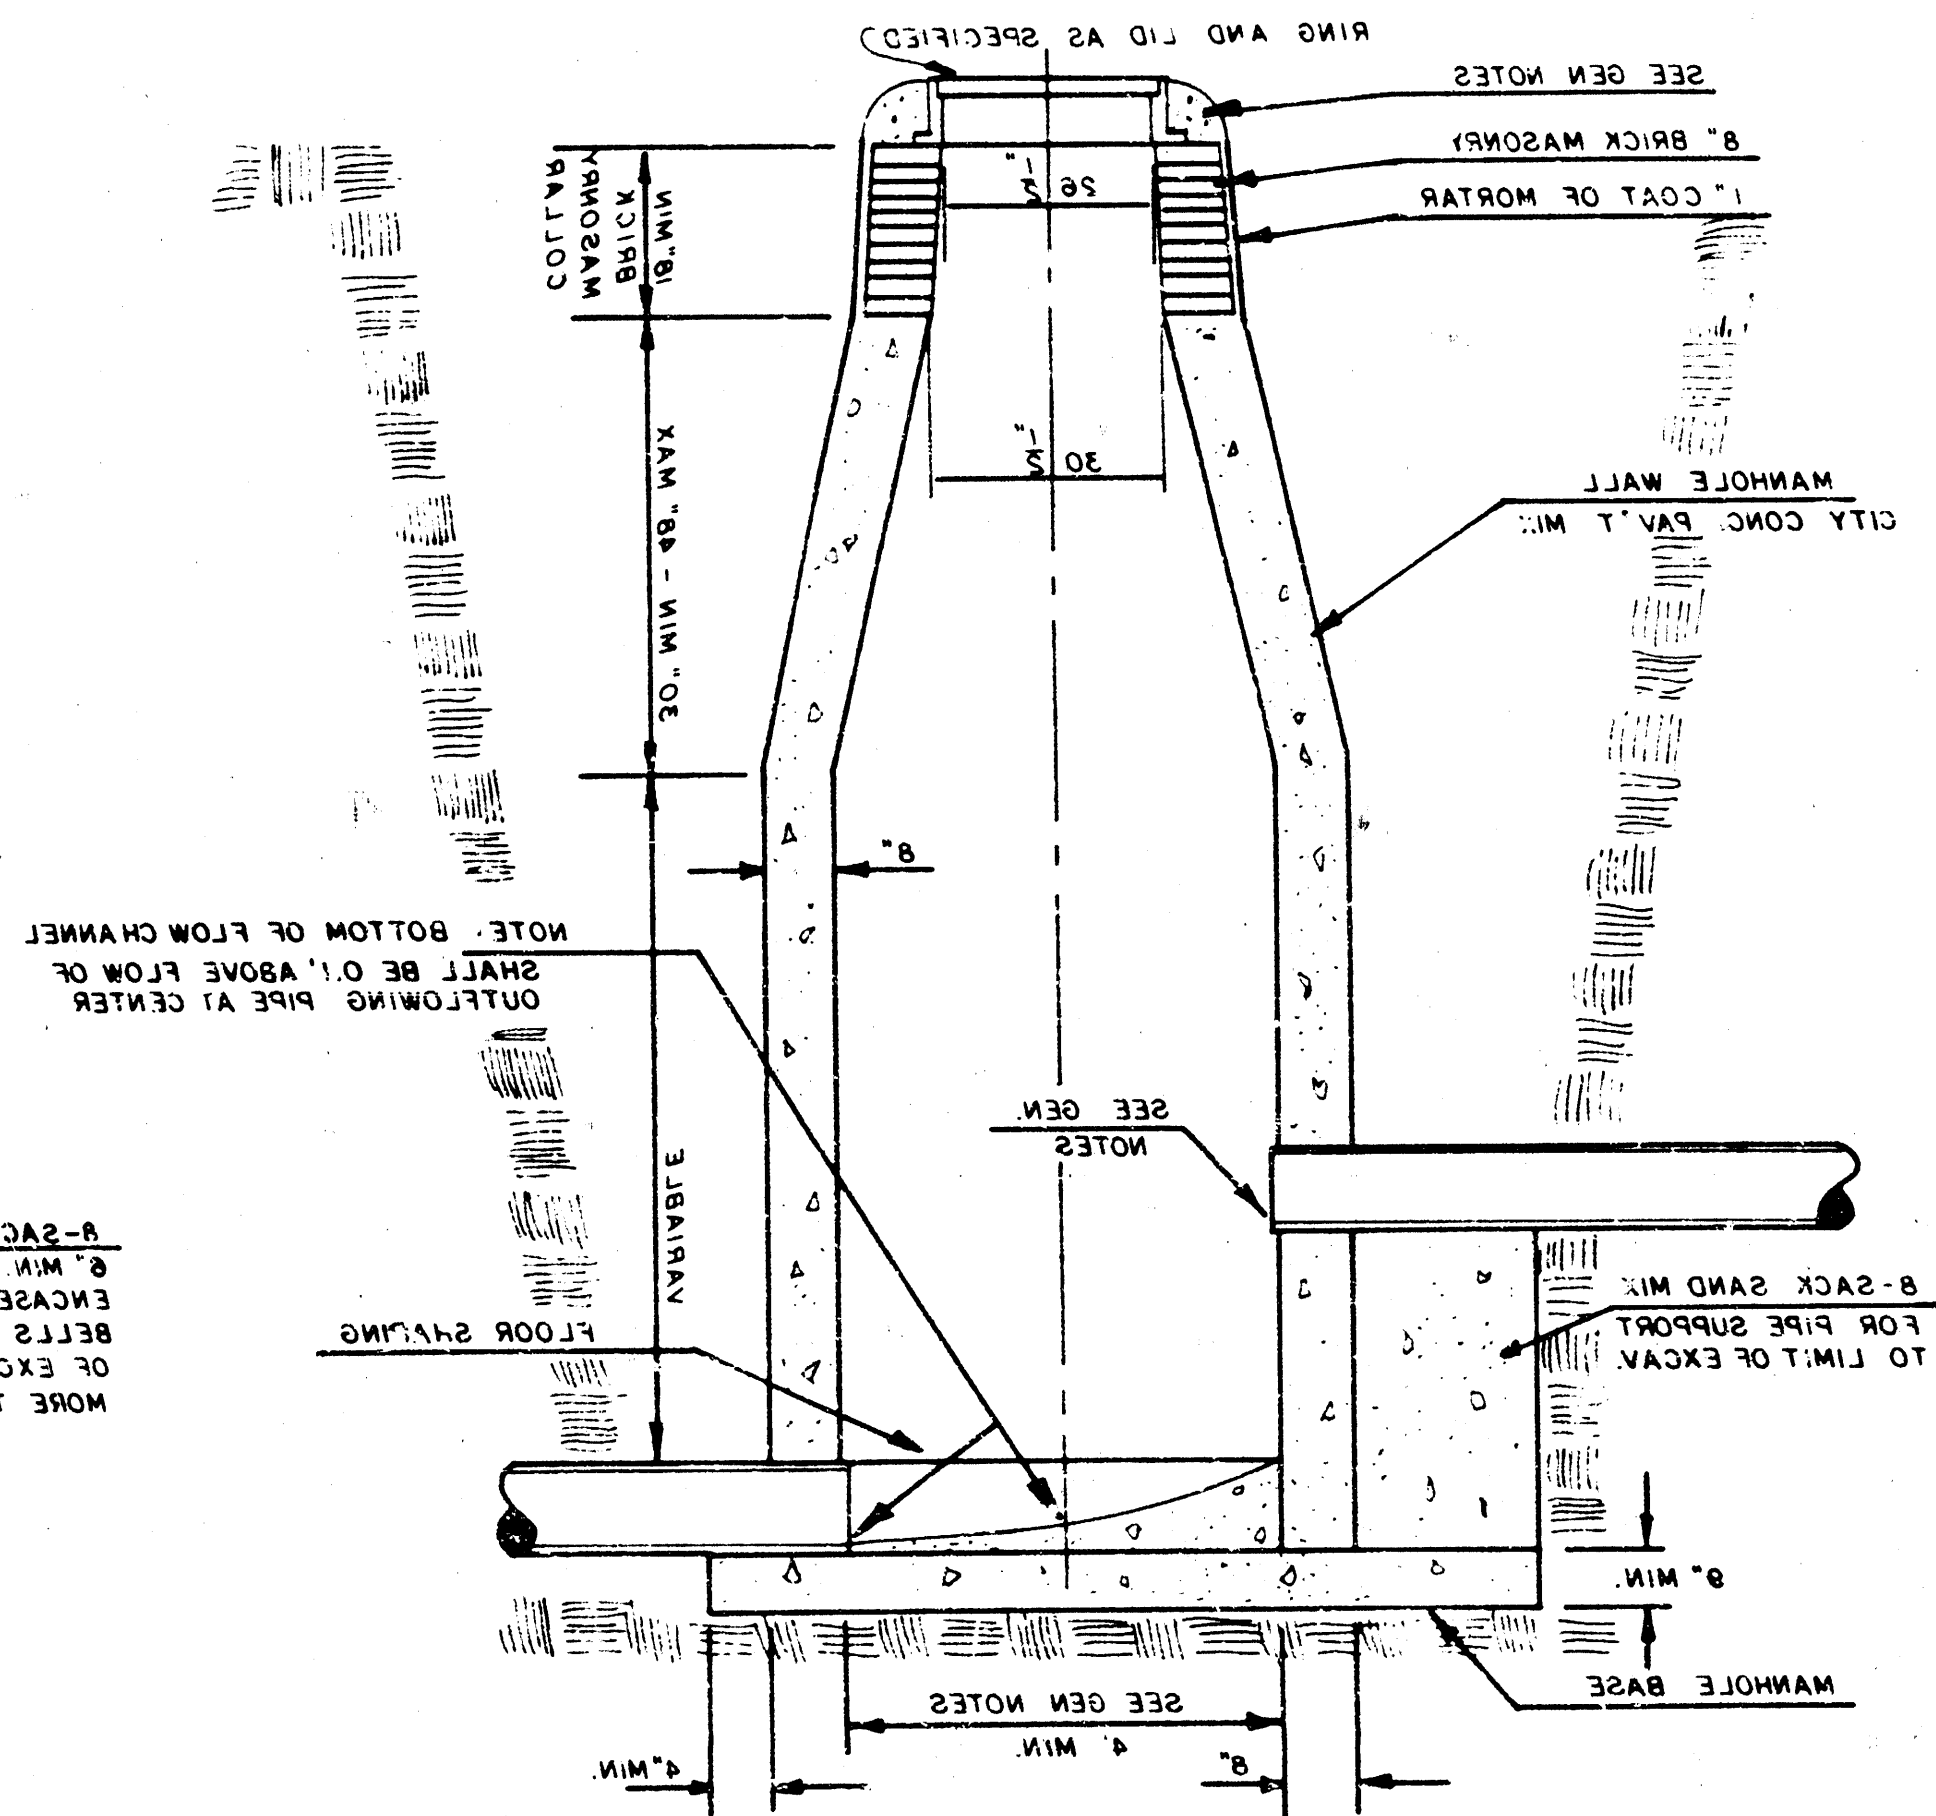

OUTSIDE DROP MANHOLE TYPE "C"

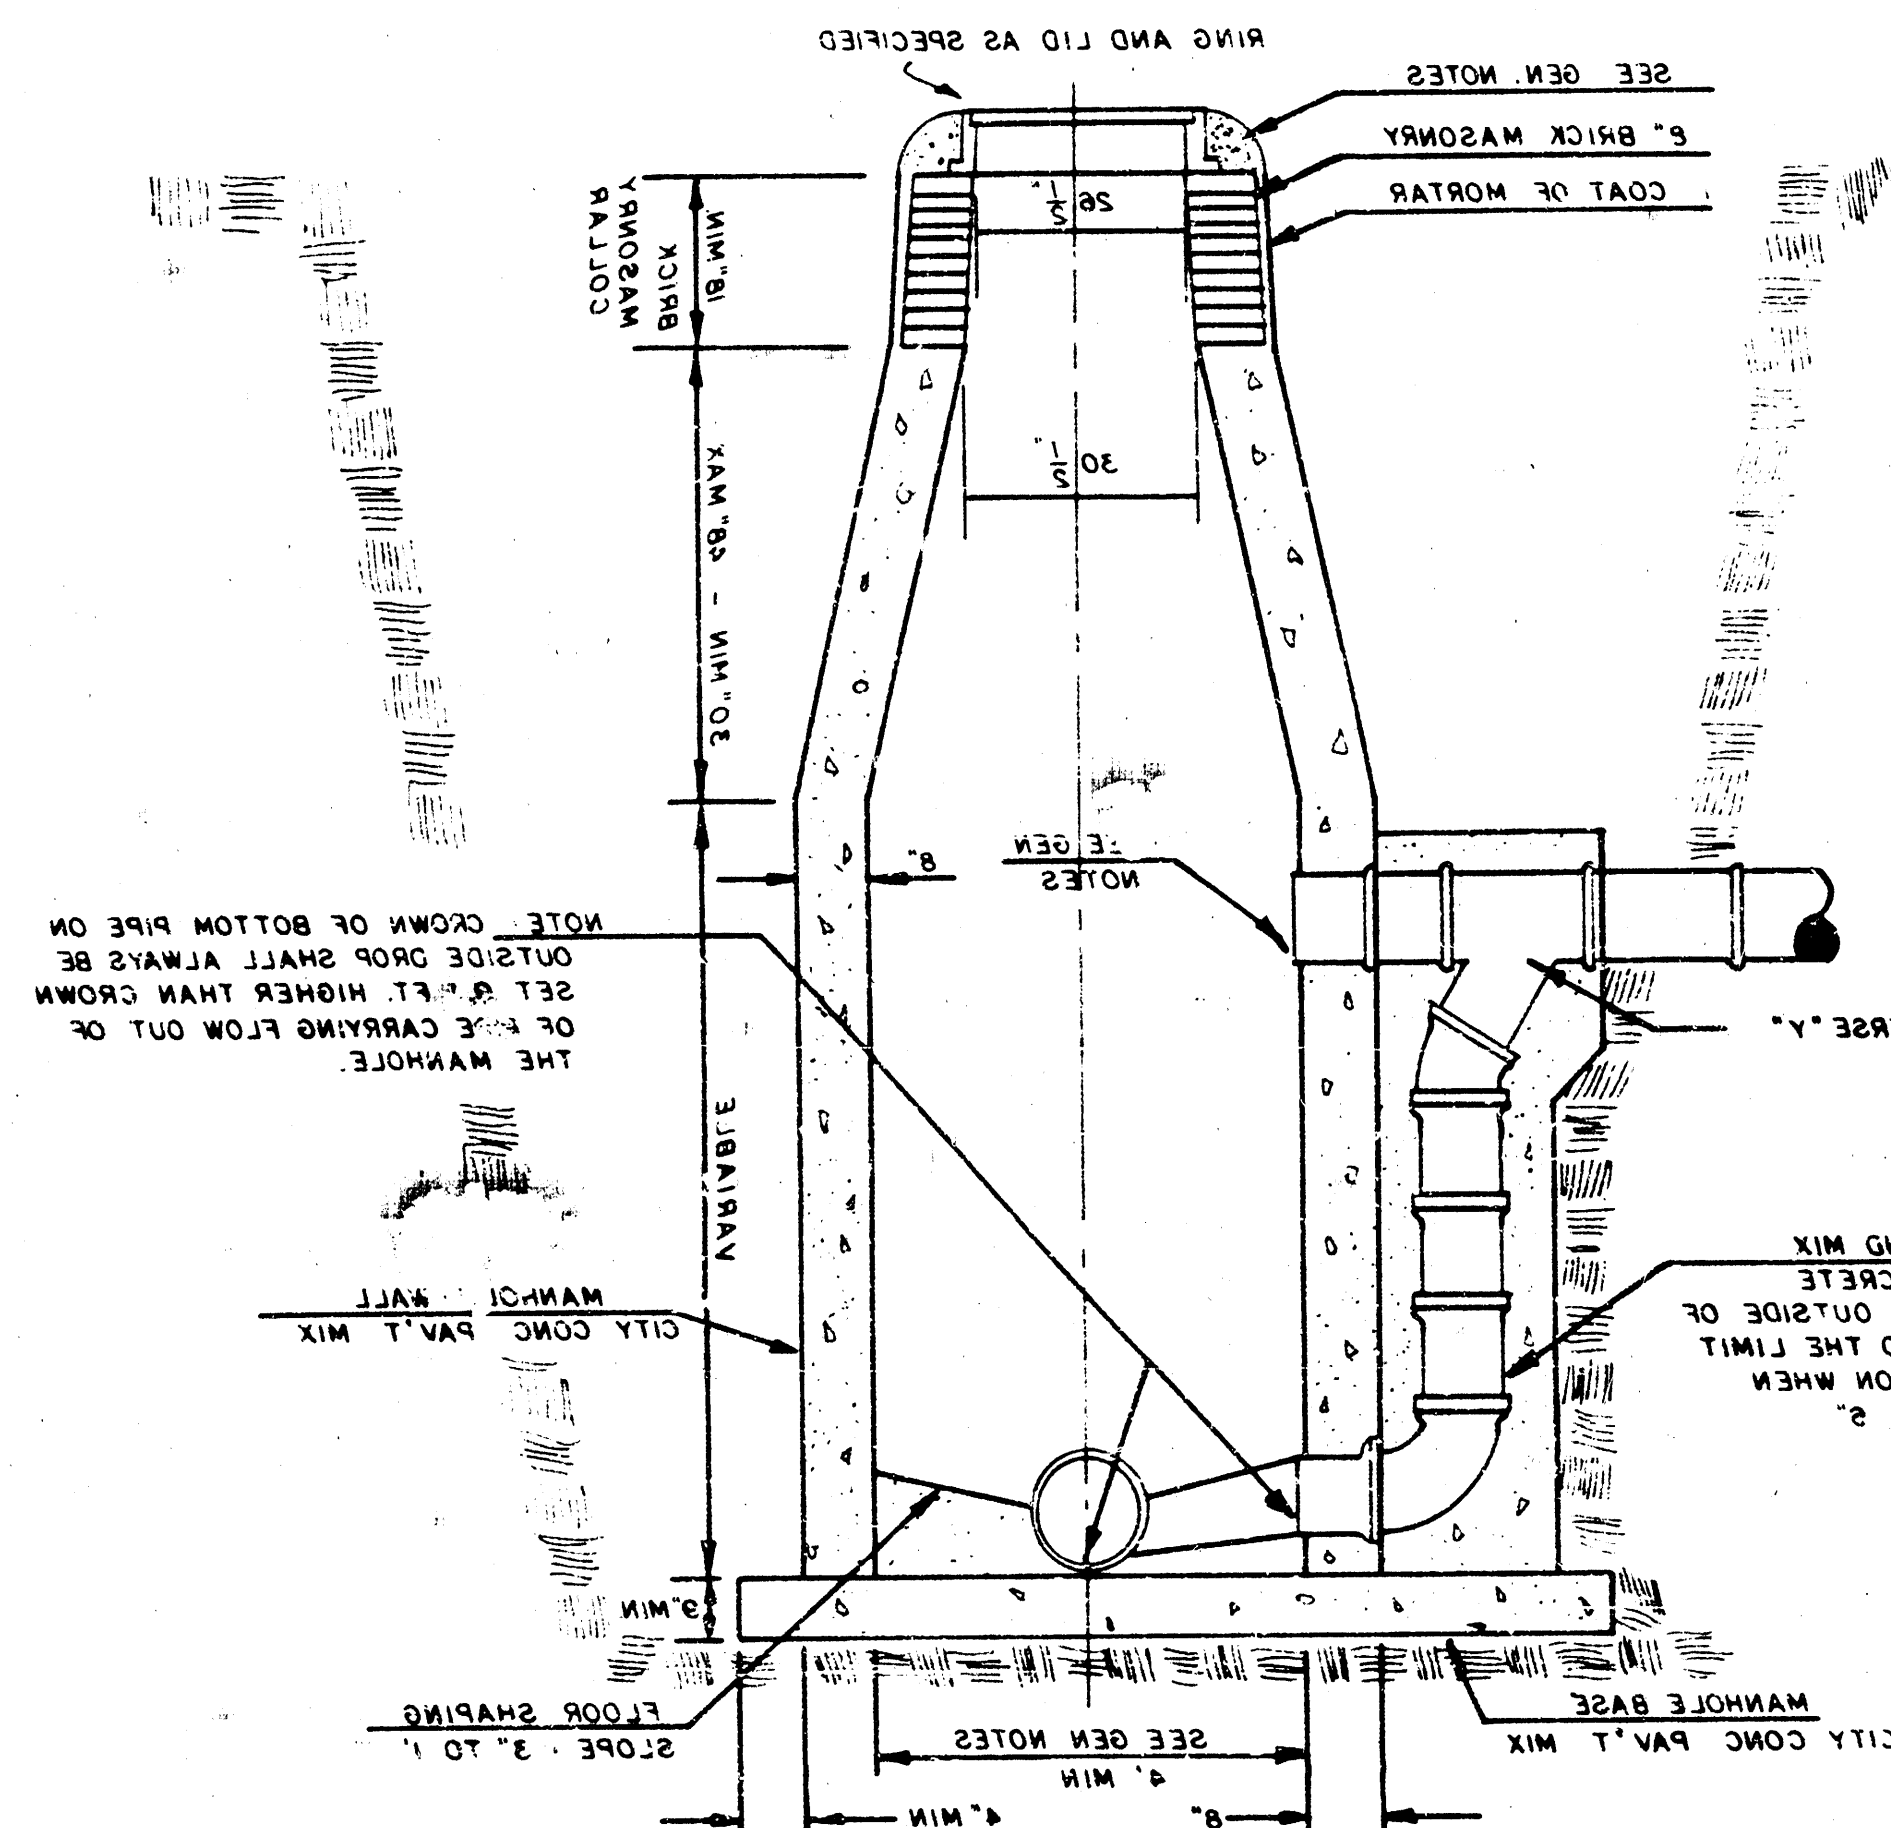

Notes and specifications for the manhole details, including material requirements and construction standards.

1. All masonry shall be constructed in accordance with the provisions of the Kansas Building Code, Chapter 19-1, and the American Institute of Steel Construction, Inc. (AISC) Manual of Steel Construction, 9th Edition.

2. The concrete base shall be constructed in accordance with the provisions of the Kansas Building Code, Chapter 19-1, and the American Institute of Steel Construction, Inc. (AISC) Manual of Steel Construction, 9th Edition.

3. The brick masonry wall shall be constructed in accordance with the provisions of the Kansas Building Code, Chapter 19-1, and the American Institute of Steel Construction, Inc. (AISC) Manual of Steel Construction, 9th Edition.

4. The ring and lid shall be constructed in accordance with the provisions of the Kansas Building Code, Chapter 19-1, and the American Institute of Steel Construction, Inc. (AISC) Manual of Steel Construction, 9th Edition.

5. The floor shall be constructed in accordance with the provisions of the Kansas Building Code, Chapter 19-1, and the American Institute of Steel Construction, Inc. (AISC) Manual of Steel Construction, 9th Edition.

6. The manhole shall be constructed in accordance with the provisions of the Kansas Building Code, Chapter 19-1, and the American Institute of Steel Construction, Inc. (AISC) Manual of Steel Construction, 9th Edition.

7. The manhole shall be constructed in accordance with the provisions of the Kansas Building Code, Chapter 19-1, and the American Institute of Steel Construction, Inc. (AISC) Manual of Steel Construction, 9th Edition.

8. The manhole shall be constructed in accordance with the provisions of the Kansas Building Code, Chapter 19-1, and the American Institute of Steel Construction, Inc. (AISC) Manual of Steel Construction, 9th Edition.

9. The manhole shall be constructed in accordance with the provisions of the Kansas Building Code, Chapter 19-1, and the American Institute of Steel Construction, Inc. (AISC) Manual of Steel Construction, 9th Edition.

10. The manhole shall be constructed in accordance with the provisions of the Kansas Building Code, Chapter 19-1, and the American Institute of Steel Construction, Inc. (AISC) Manual of Steel Construction, 9th Edition.

[illegible]