



| PLAN     | DATE |
|----------|------|
| DESIGNED |      |
| CHECKED  |      |
| NOTED    |      |
| BY       |      |

| PROFILE  | DATE |
|----------|------|
| DESIGNED |      |
| CHECKED  |      |
| NOTED    |      |
| BY       |      |

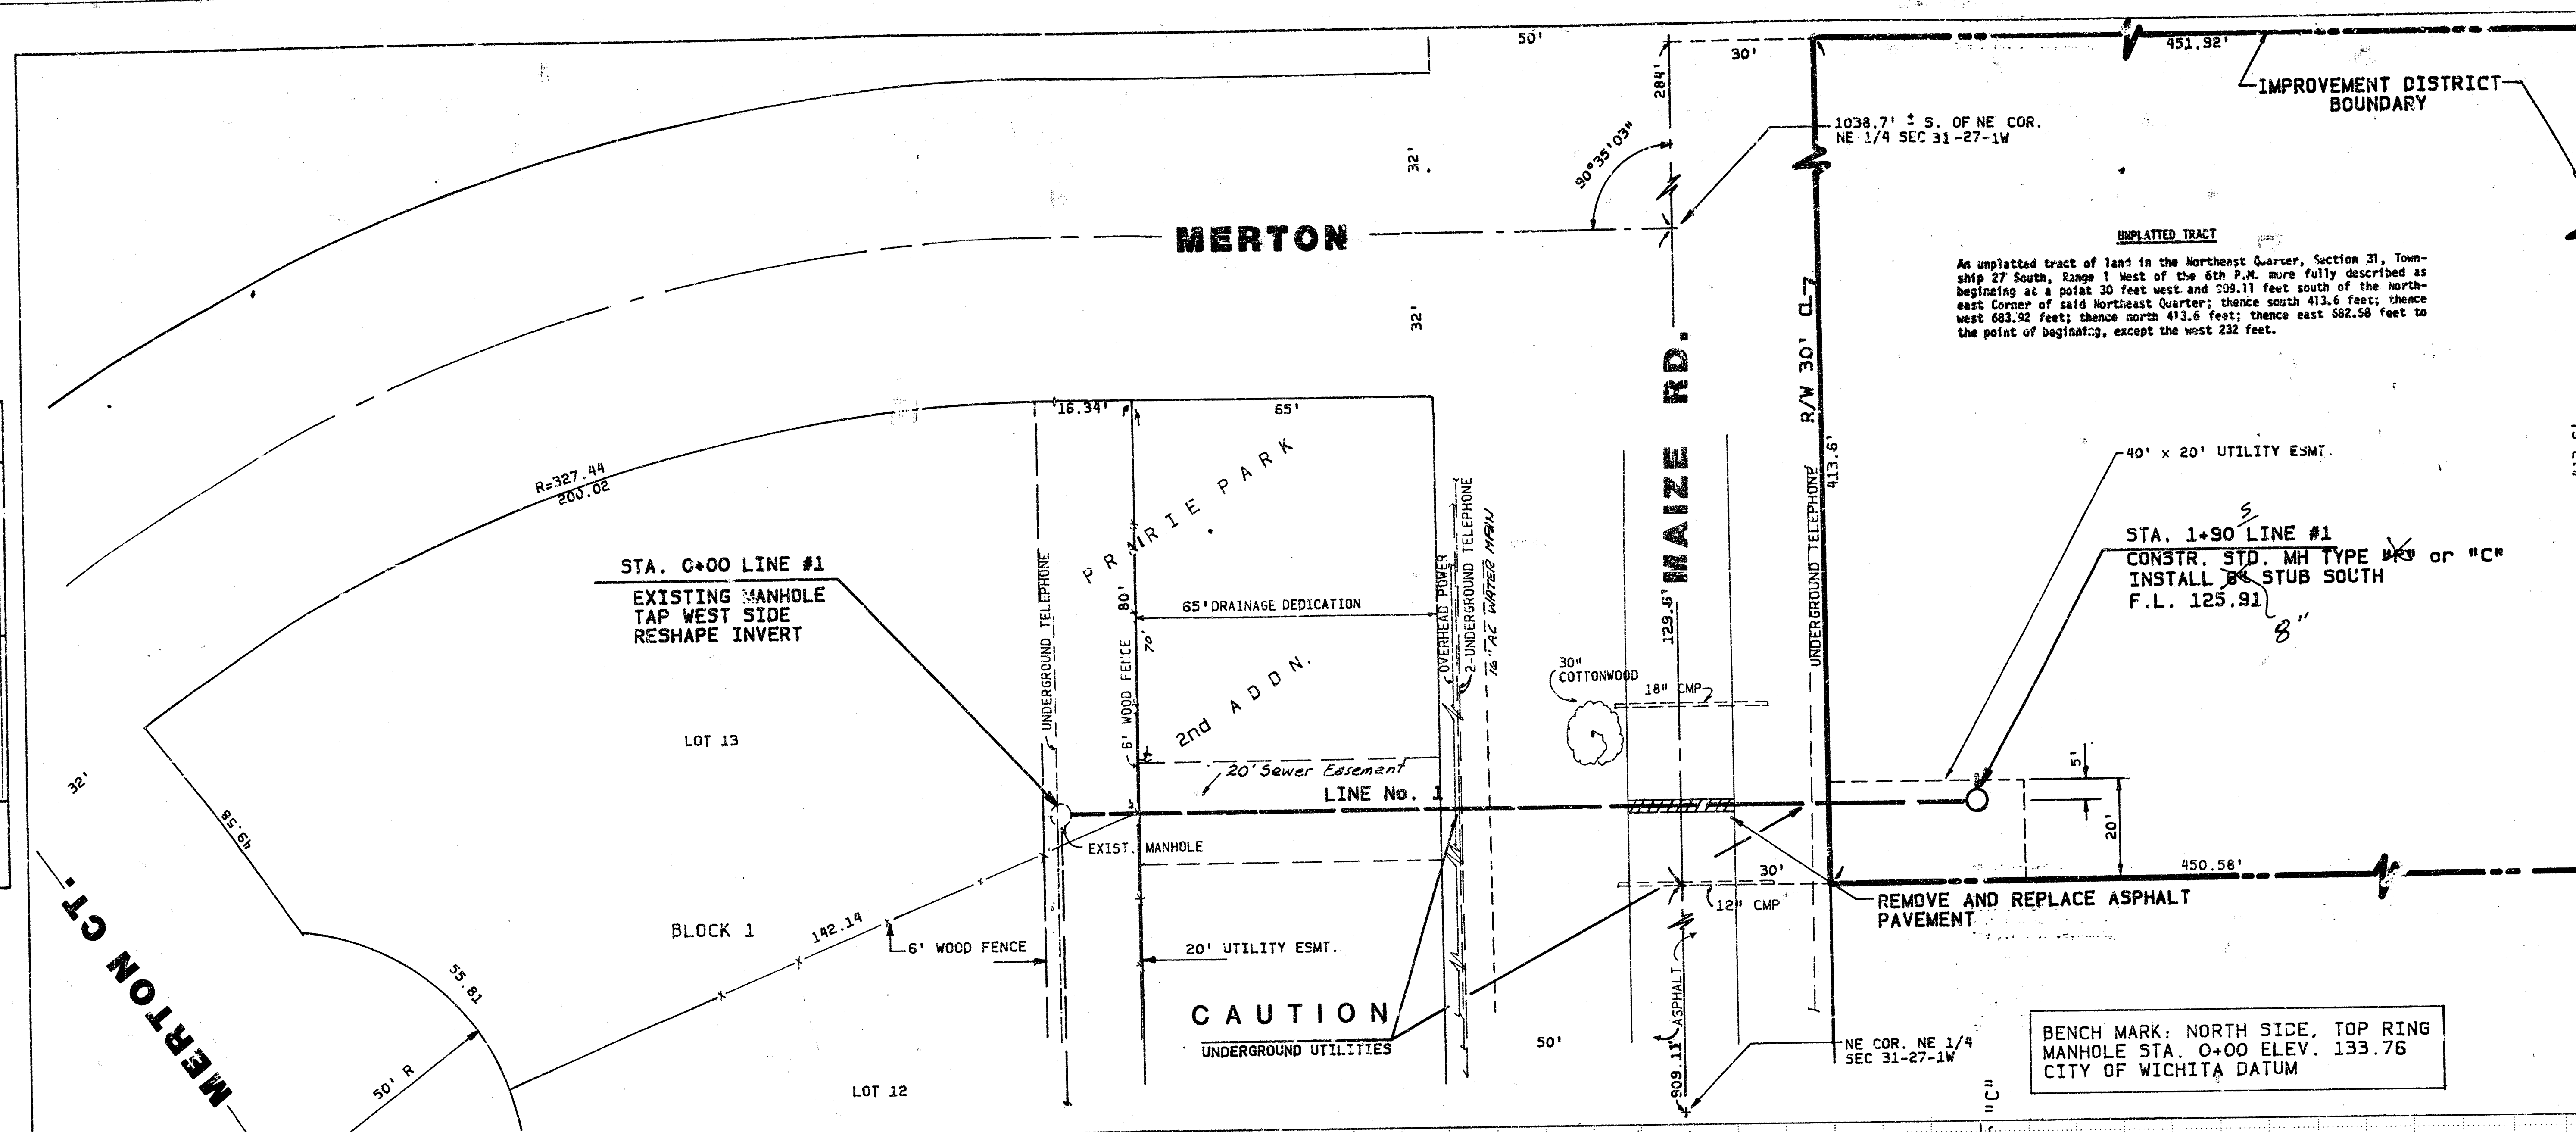

SCALE  
1" = 20' HORIZ.  
1" = 5' VERT.

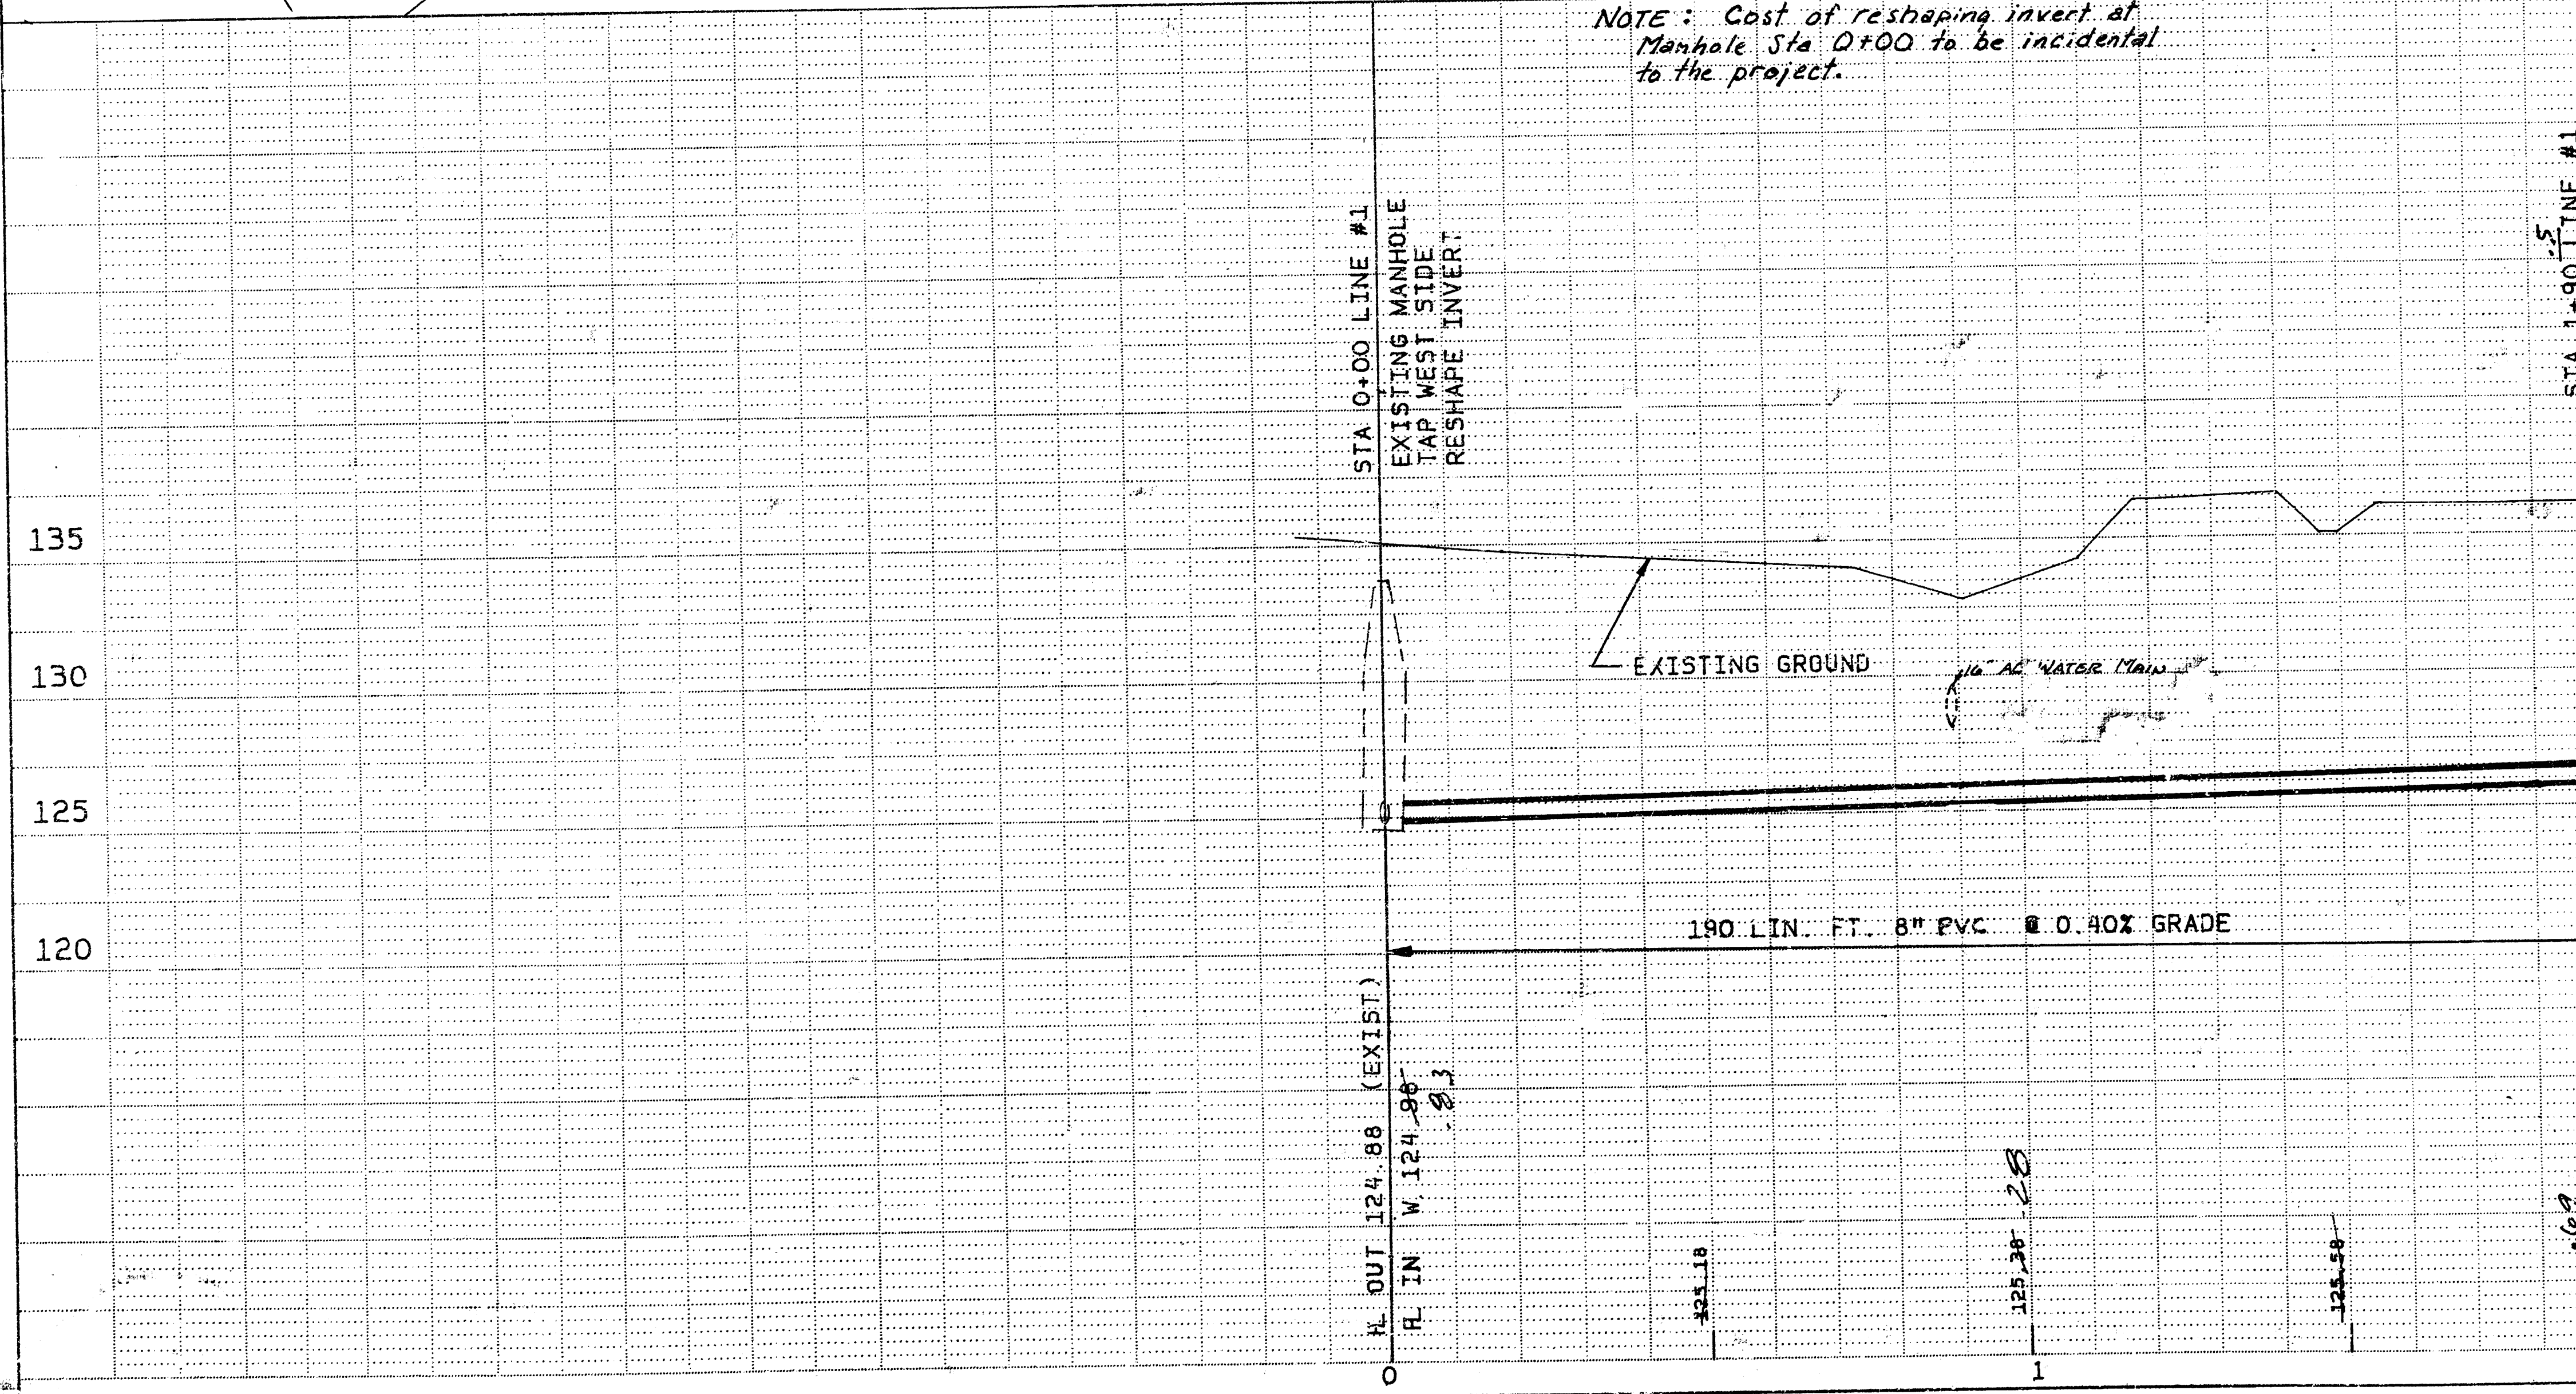


Notify the following companies prior to any excavation:

|                       |                |
|-----------------------|----------------|
| Arkia Gas Company     | 942-8350       |
| Bell Telephone        | 268-2256       |
| Cablevision           | 269-3340       |
| Gas Service Company   | 263-7511       |
| Kansas Gas & Electric | 261-6375       |
| Kansas One-Call       | 1-800-344-7233 |

AS BUILT  
RD  
11-86

Revised 8-29-86  
Revised 8-26-86

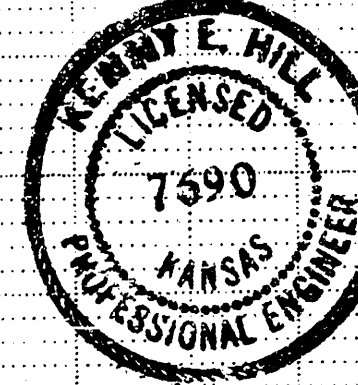

|                              |                              |
|------------------------------|------------------------------|
|                              | CITY OF WICHITA              |
|                              | LATERAL 217                  |
|                              | SOUTHWEST INTERCEPTOR SEWER  |
|                              | PROJECT NO.                  |
| 468 76 245 61543 000 000 001 | ENGINEER K. HILLENGTECH J.P. |
| POE & ASSOCIATES             | DRAWN BY J.P.                |
| CONSULTING ENGINEERS         | SCALE 1" = 20'               |
| DATE FEB. 1986               | SHEET 1 OF 1                 |

FILMED FROM THE BEST AVAILABLE COPY