

LATERAL 337, SOUTHWEST INTERCEPTOR

PROJ. NO. 468-82398

INDEX NO. 742007

CITY OF WICHITA, KANSAS

M. E. LINDEBAK - CITY ENGINEER


GENERAL NOTES:

1. ALL CONSTRUCTION AND MATERIAL TO COMPLY WITH CITY OF WICHITA SPECIFICATIONS AND STANDARDS.
2. THE CONTRACTOR SHALL NOTIFY THE UTILITY SERVICE COMPANIES TO FLAG THEIR UNDERGROUND LINES AND REQUEST ANY OVERHEAD POLE/LINE ADJUSTMENTS 48 HOURS PRIOR TO CONSTRUCTION.
3. THE UNDERGROUND UTILITY SERVICE LINES AND OVERHEAD UTILITY POLE LINES ARE TO BE ADJUSTED AS NECESSARY BY OTHERS PRIOR TO CONSTRUCTION UNLESS THE PLANS SPECIFICALLY CALL FOR THEIR ADJUSTMENT BY THE CONTRACTOR. EXISTING UTILITIES AND THEIR LOCATION, AS SHOWN ON THE PLANS, REPRESENT THE BEST INFORMATION OBTAINABLE FOR DESIGN. LOCATION INFORMATION HAS BEEN OBTAINED FROM THE VARIOUS UTILITY COMPANIES AND IS EITHER FROM COMPANY RECORD DRAWINGS OR COMPANY PROVIDED FIELD LOCATIONS. THE CONTRACTOR WILL BE REQUIRED TO WORK AROUND EXISTING UTILITIES WITHIN THE RIGHT-OF-WAY WHICH DO NOT CONFLICT WITH PROPOSED CONSTRUCTION.
4. THE CONTRACTOR SHALL GIVE ALL PROPERTY OWNERS AND/OR TENANTS DIRECTLY AFFECTED BY THE CONSTRUCTION OF THIS PROJECT A MINIMUM OF FIVE (5) DAYS ADVANCE WRITTEN NOTICE PRIOR TO START OF CONSTRUCTION.
5. ANY TREE OR SHRUB REMOVAL MUST BE APPROVED BY THE FIELD ENGINEER.
6. THE CONTRACTOR SHOULD EXAMINE THE CONSTRUCTION SITE PRIOR TO BIDDING AND BE SATISFIED AS TO THE WORK SHOWN FOR COMPLETION.

KANSAS ONE-CALL 1-800-344-7233

INDEX OF SHEETS


SHEET	1	-	TITLE SHEET
SHEET	2	-	PLAN/PROFILE
SHEET	3	-	SANITARY M.H. DETAIL

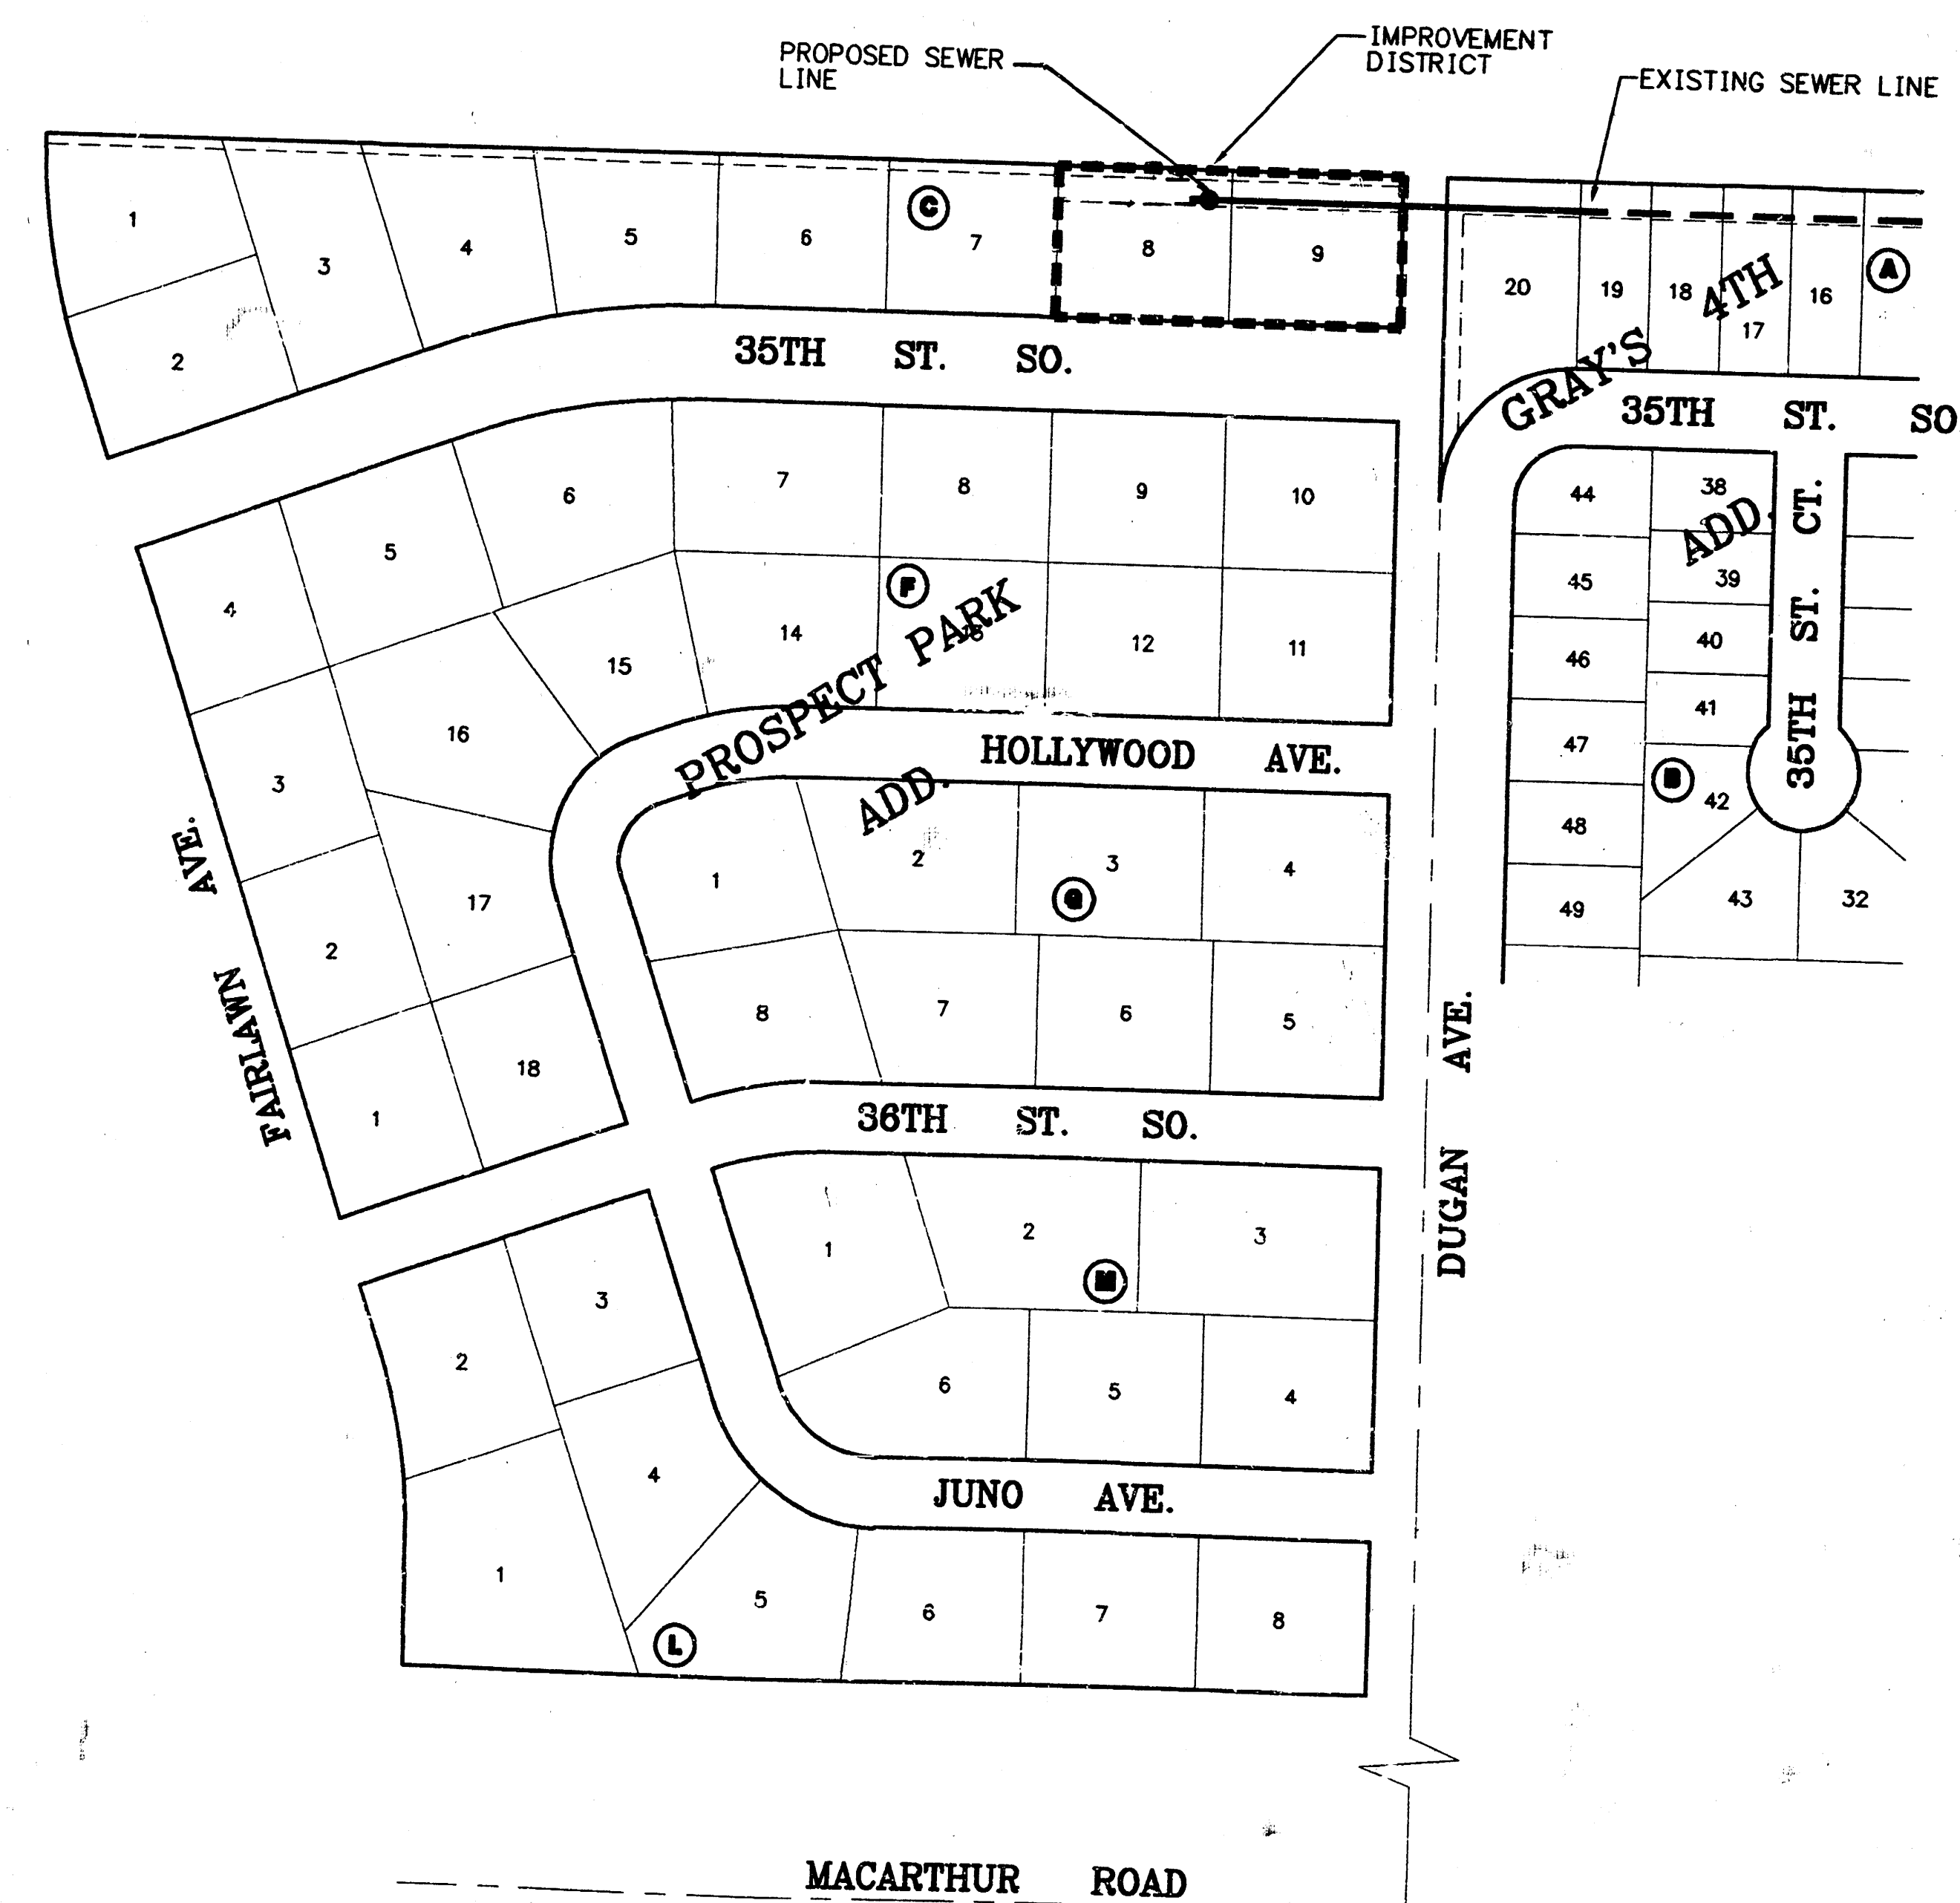


SCALE: 1" = 150'

BM. CITY OF WICHITA STANDARD DISC
DUGAN & 35TH ST. SO., WEST PARKING
DUGAN, 10' EAST OF N/S HEDGE ROW,
23' WEST AND 81.5' SOUTH OF C OF BOTH,
4' WEST OF BACK OF CURB, 10' EAST OF
1/2 SECTION LINE.
ELEV. = 119.56

BM. STA. 0+00 EXISTING MH. WEST RIM,
ELEV. = 119.97

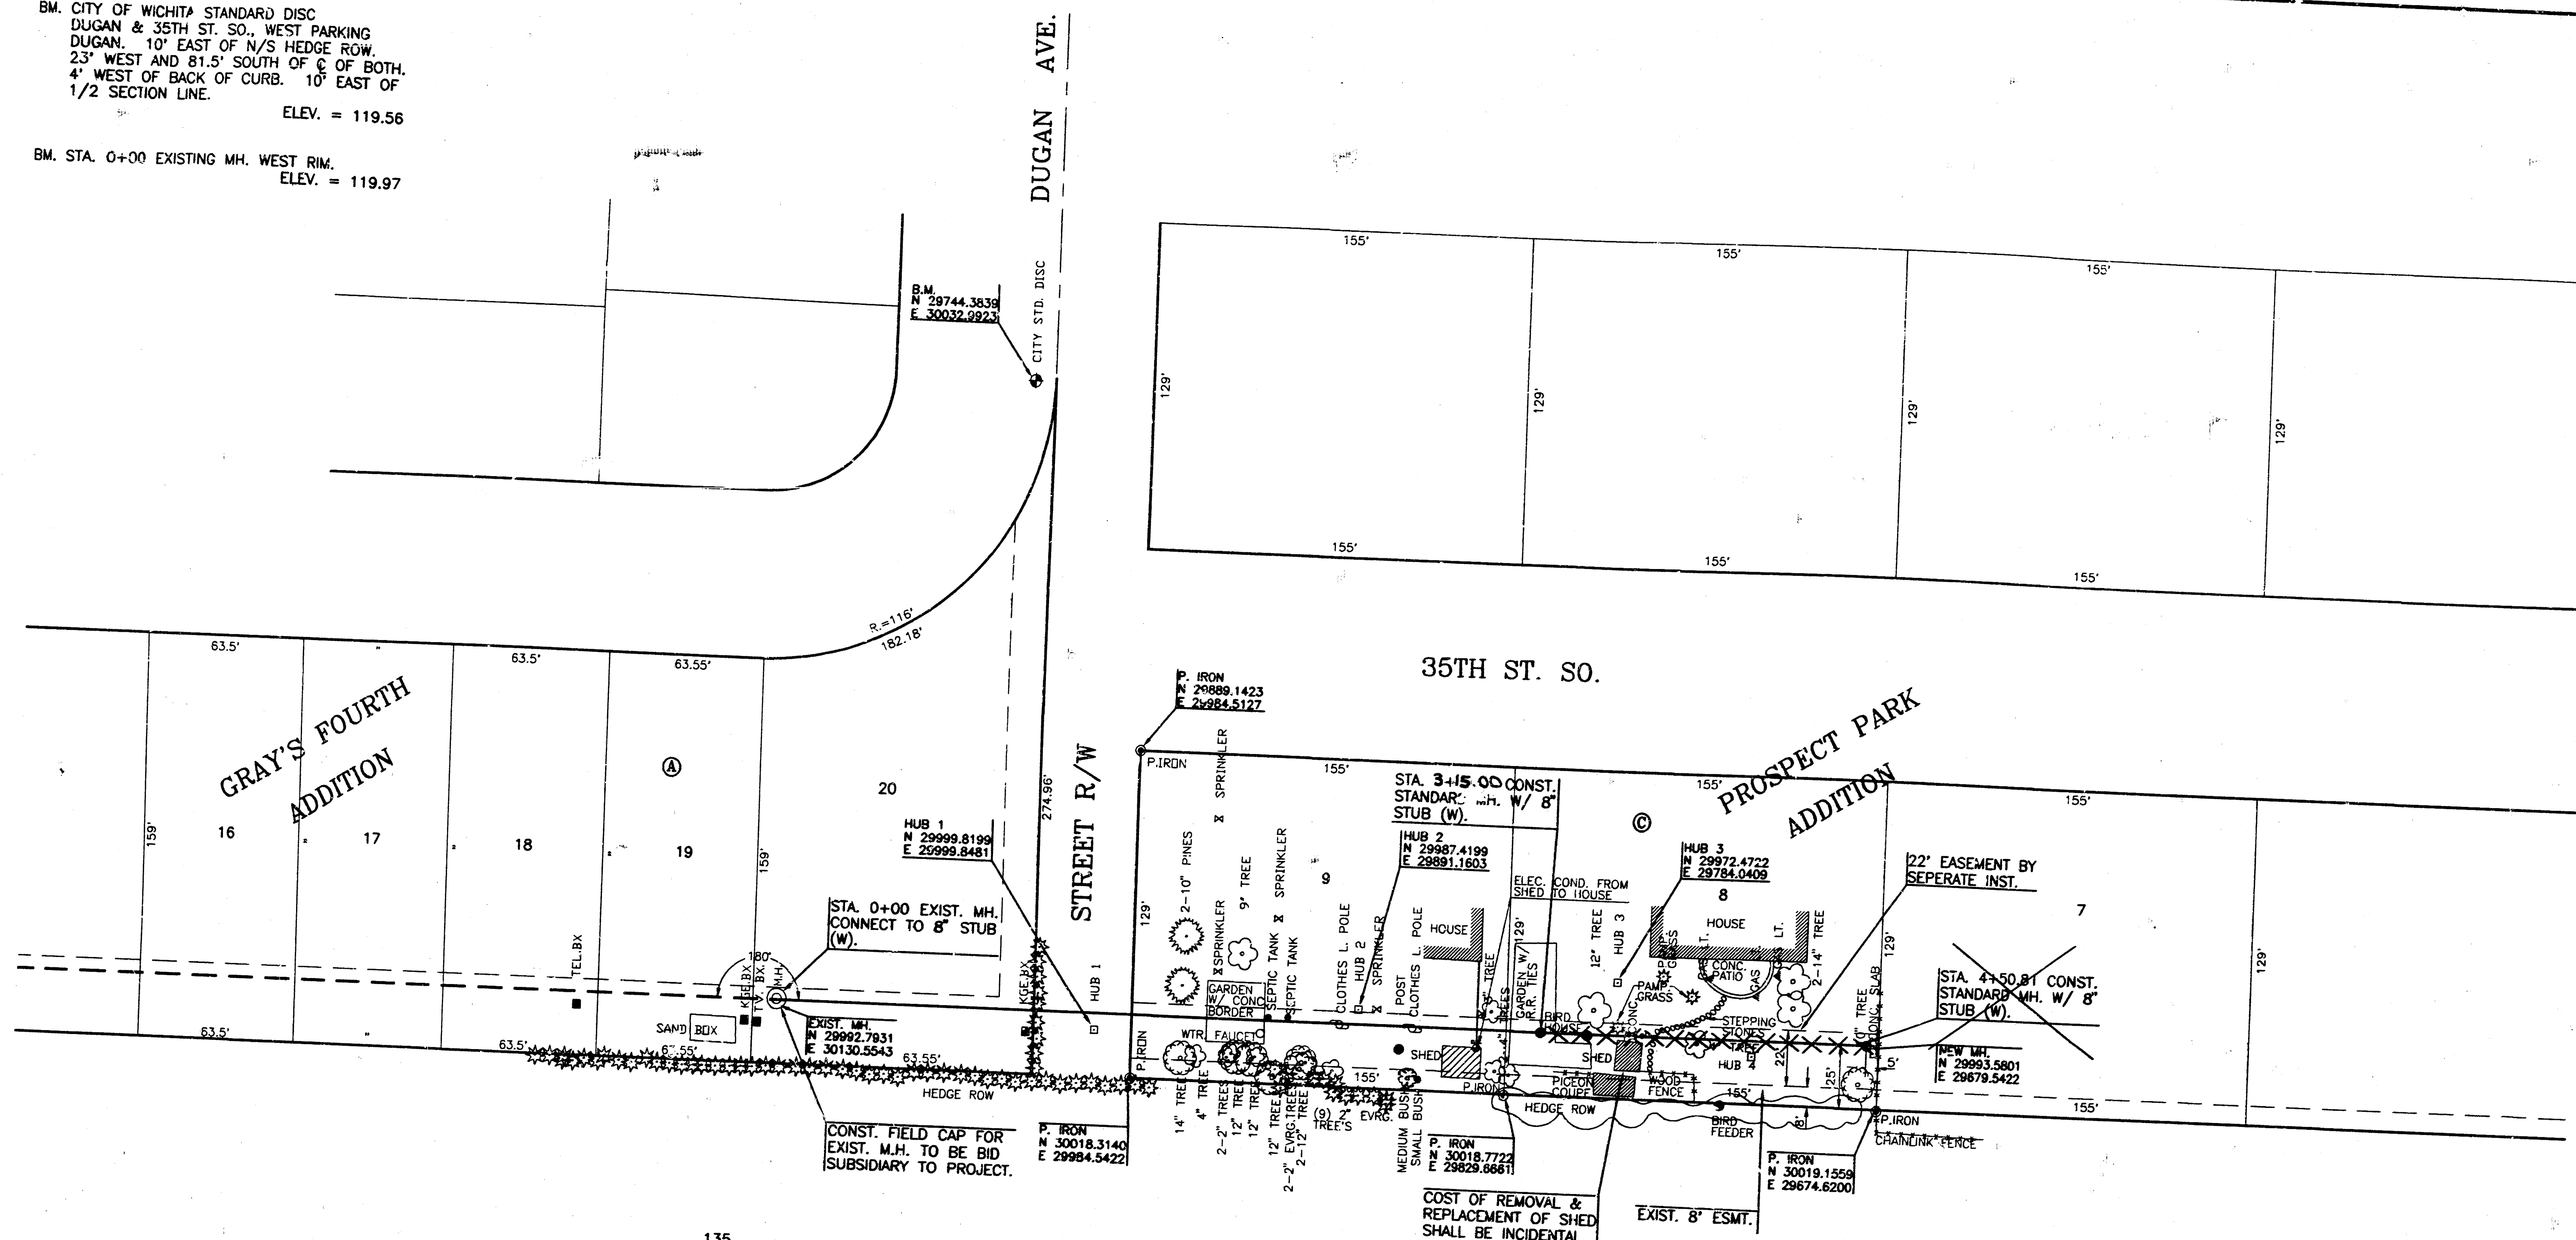

SCALE: 1"=40' HORIZ.
1"=5' VERT.

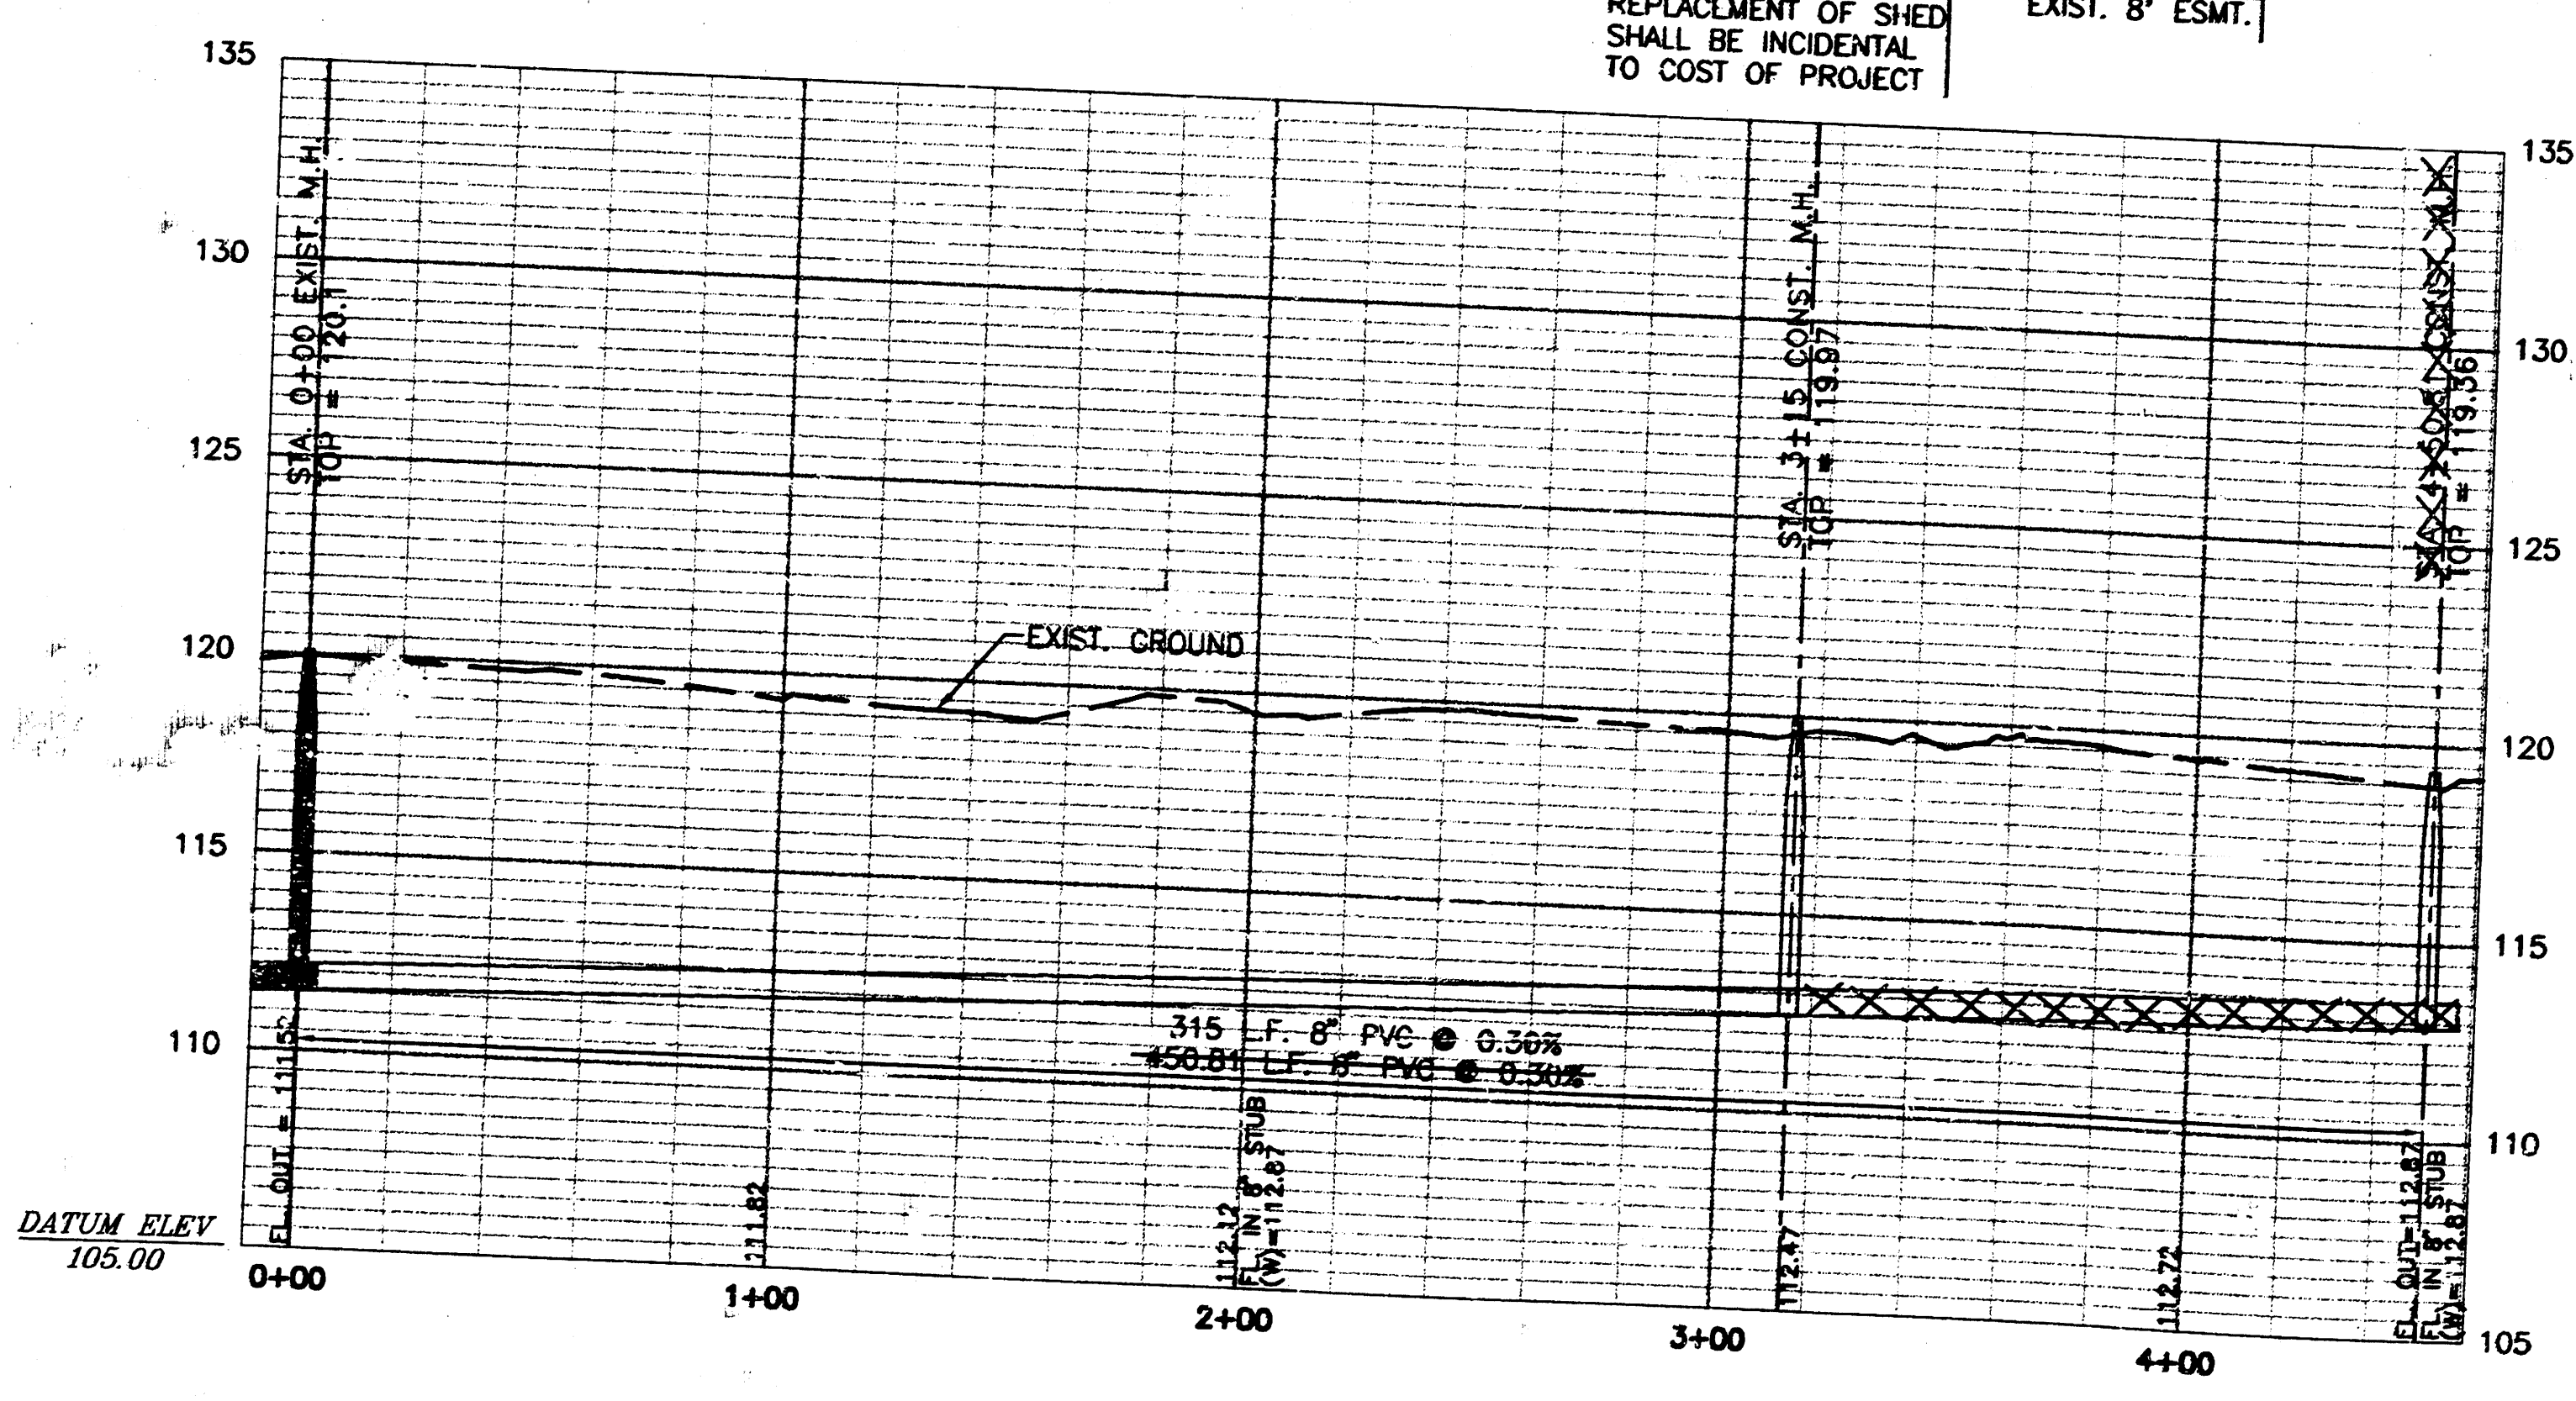

AS-BUILTS JKB 4-10-96

PROJ. NO. 468-82398
INDEX NO. 742007
DRAWN BY L. POWERS

SHEET 2 OF 3

