



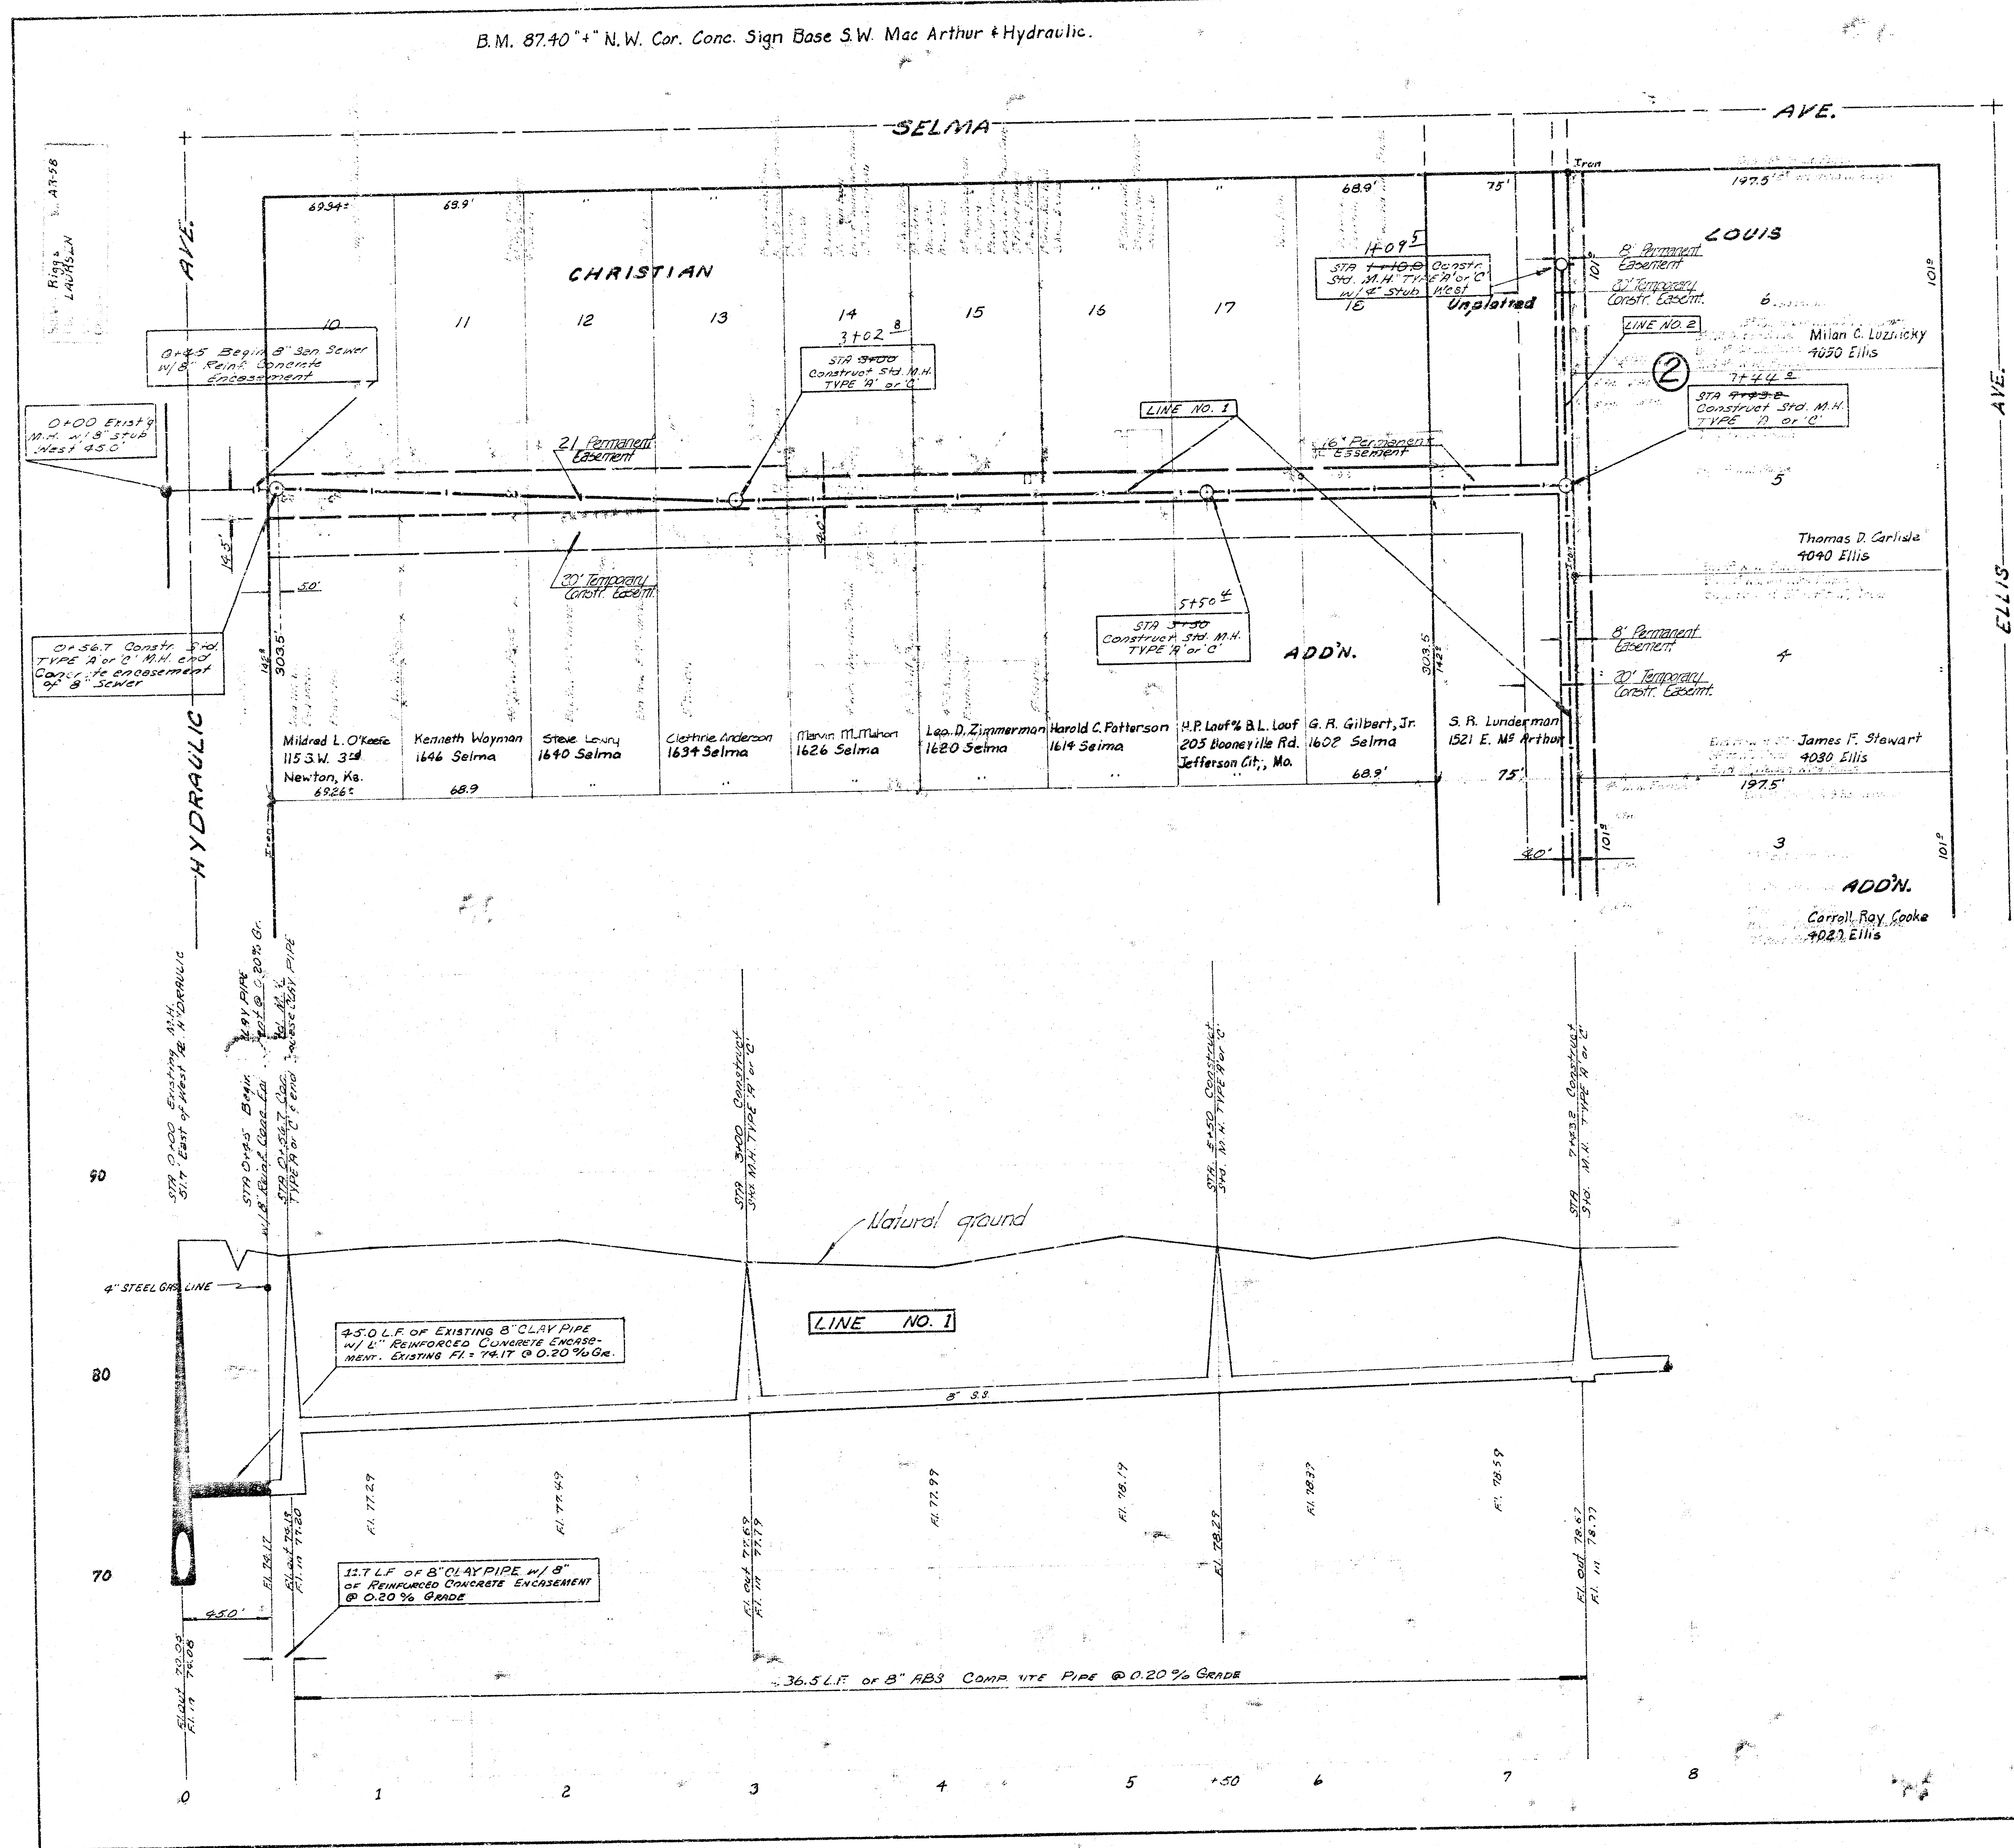

NOT: SANITARY SEWER CONSTRUCTION ON IMPAVED TRACT WILL BE IN CONFORMANCE WITH THE CITY OF WICHITA SANITARY SEWER ORDINANCE. THE CONTRACTOR SHALL BE RESPONSIBLE TO OBTAIN A PERMIT TO INSTALL A SANITARY SEWER LINE FROM THE HOUSE AT 1521 EAST MACARTHUR. A WATER METER SHALL BE INSTALLED ON MACARTHUR ROAD BY THE CITY OF WICHITA. THE CONTRACTOR SHALL BE RESPONSIBLE TO OBTAIN A PERMIT TO INSTALL A WATER METER. THE CONTRACTOR SHALL BE RESPONSIBLE TO OBTAIN A PERMIT TO INSTALL A WATER METER. THE CONTRACTOR SHALL BE RESPONSIBLE TO OBTAIN A PERMIT TO INSTALL A WATER METER.

PLAN SCALE 1"=40'
 PROFILE SCALE 1"=40' HORIZ.
 1"=4' VERT.

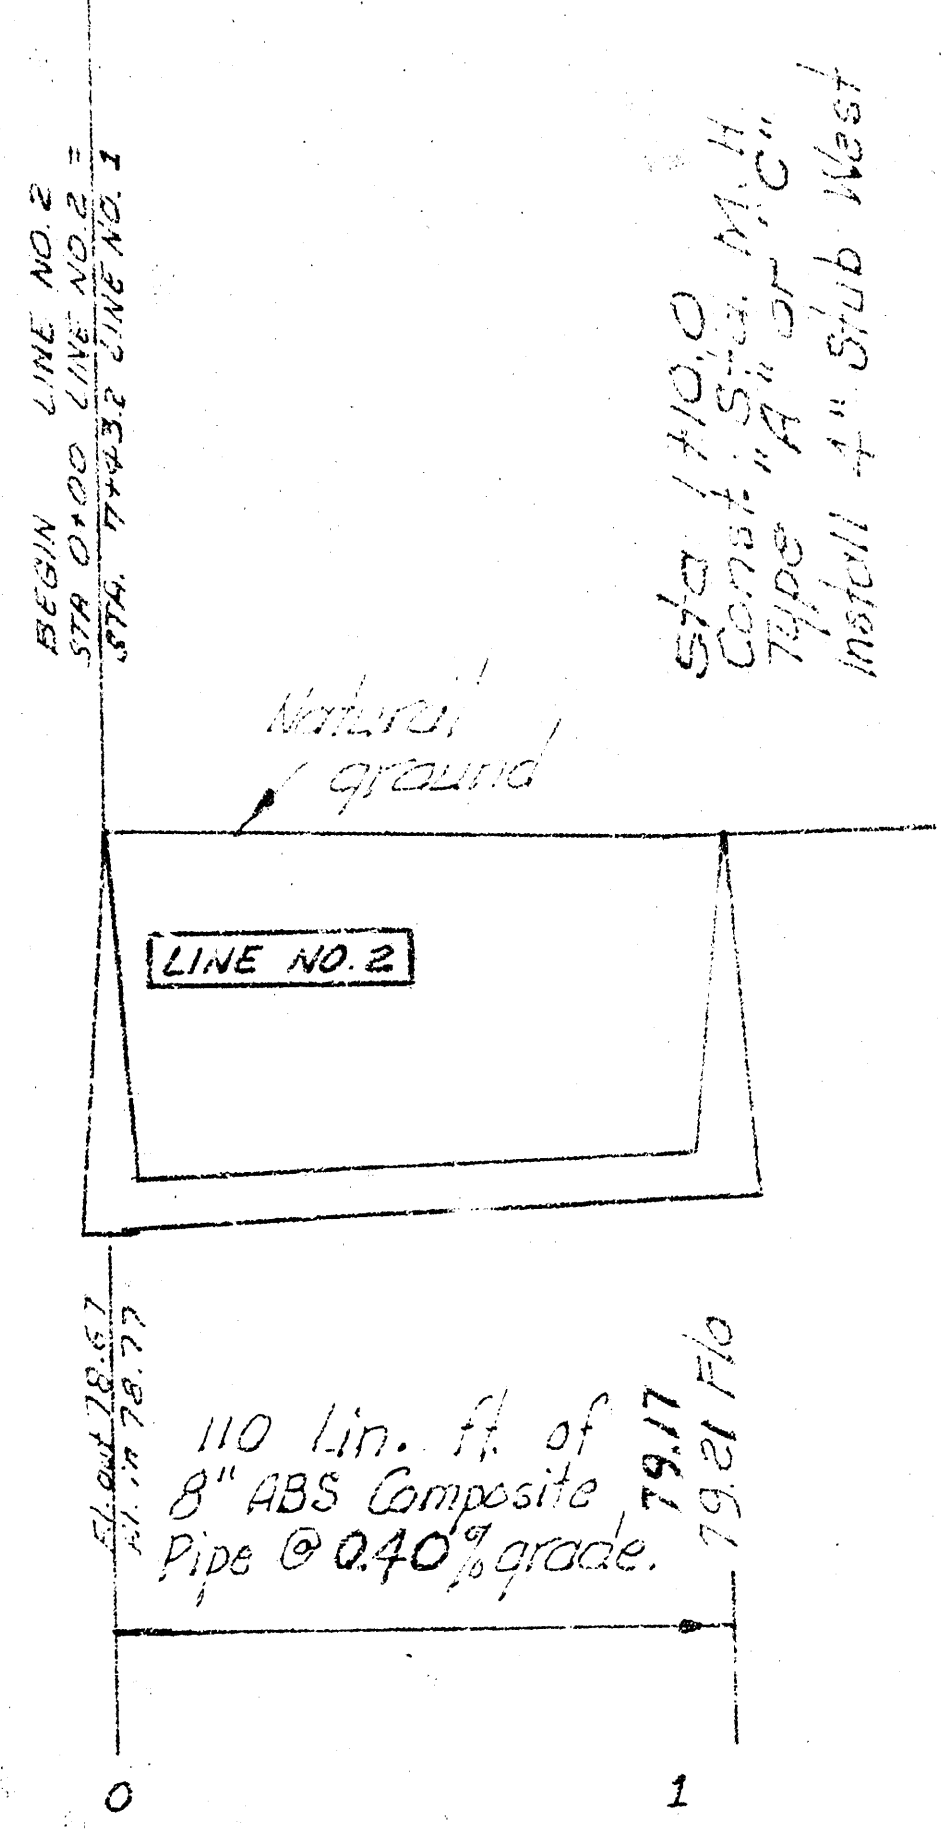

As Built 11-30-76
 LAT. 18, SUB. 1, S. W. INTER.
 CITY OF WICHITA, KANSAS
 R. W. LINN, CITY ENGINEER
 DATE: 11-30-76
 PROJ. NO. DBKL570041

