


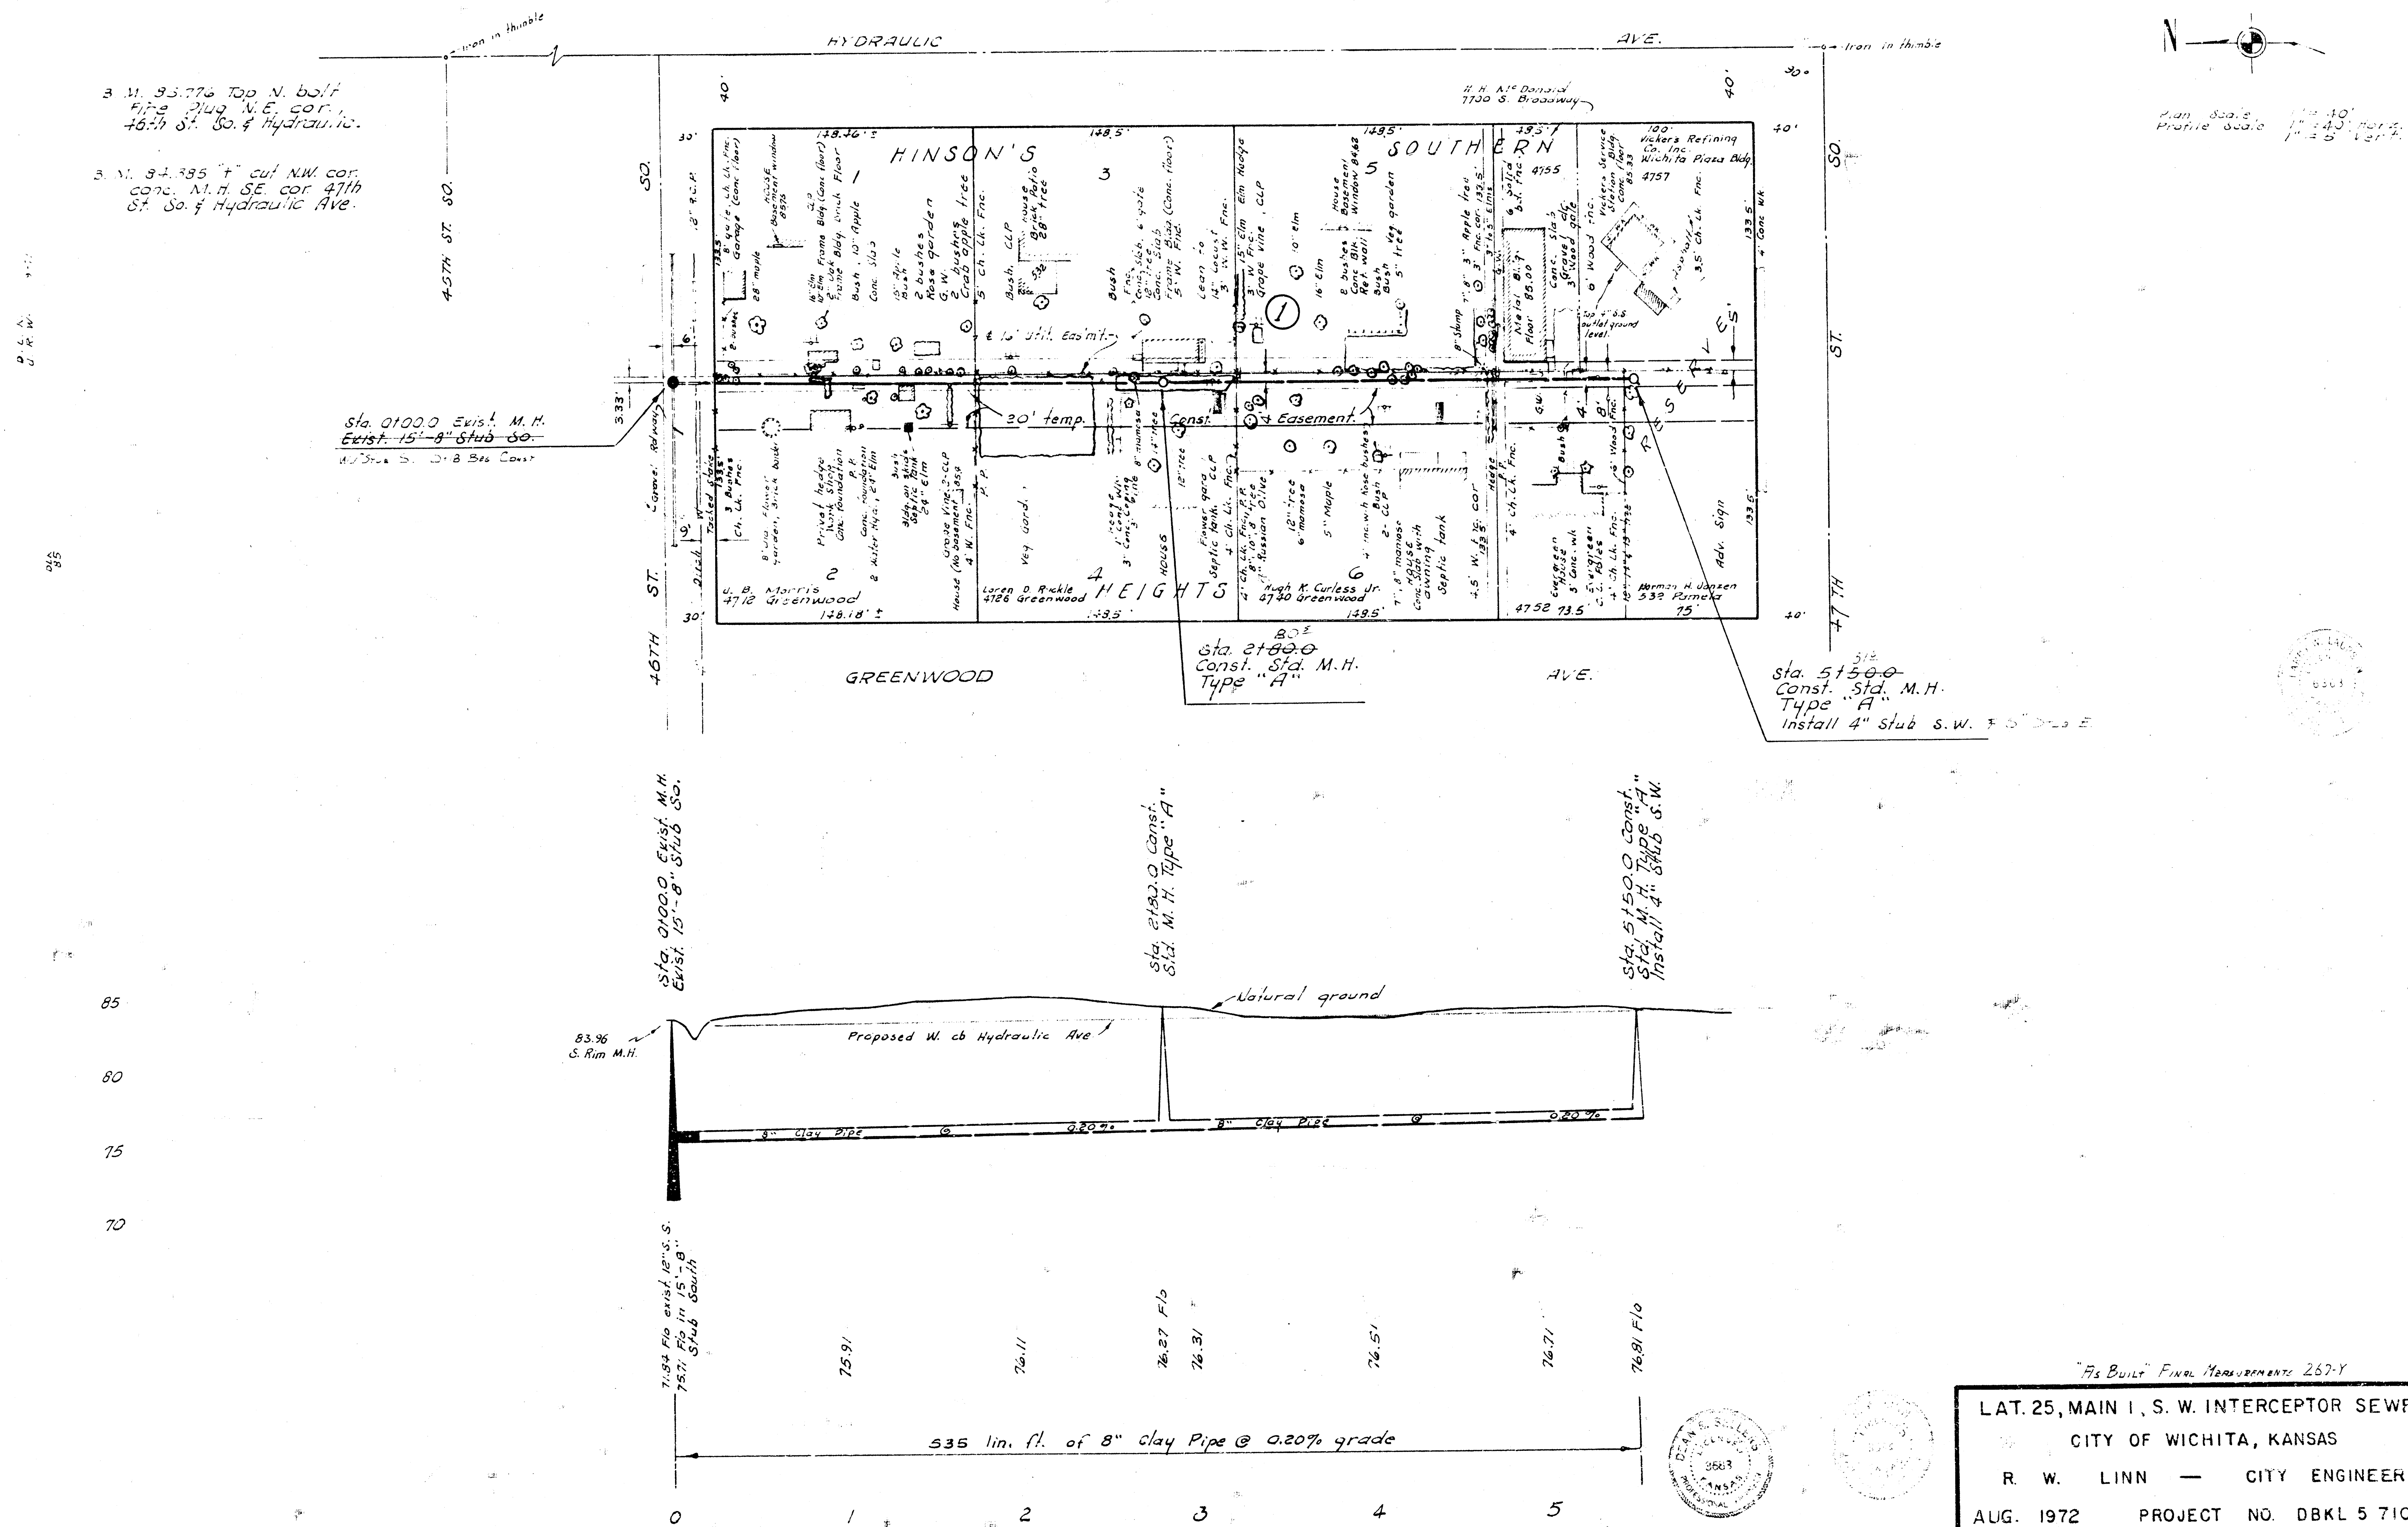

"As Built" Final Measurements 267-Y

LAT. 25, MAIN I, S. W. INTERCEPTOR SEWER
CITY OF WICHITA, KANSAS

R. W. LINN — CITY ENGINEER

AUG. 1972 PROJECT NO. DBKL 5 71008