



NOTE:
 Bid price for relocating small buildings shall include the cost of moving and resetting the building on a foundation equal to its previous foundation.
 Field Engineer may raise Flo line of sewer 1 ft. to facilitate the construction of the project.



PLAN SCALE 1" = 40'
 PROFILE SCALE 1" = 40' H
 1" = 40' V

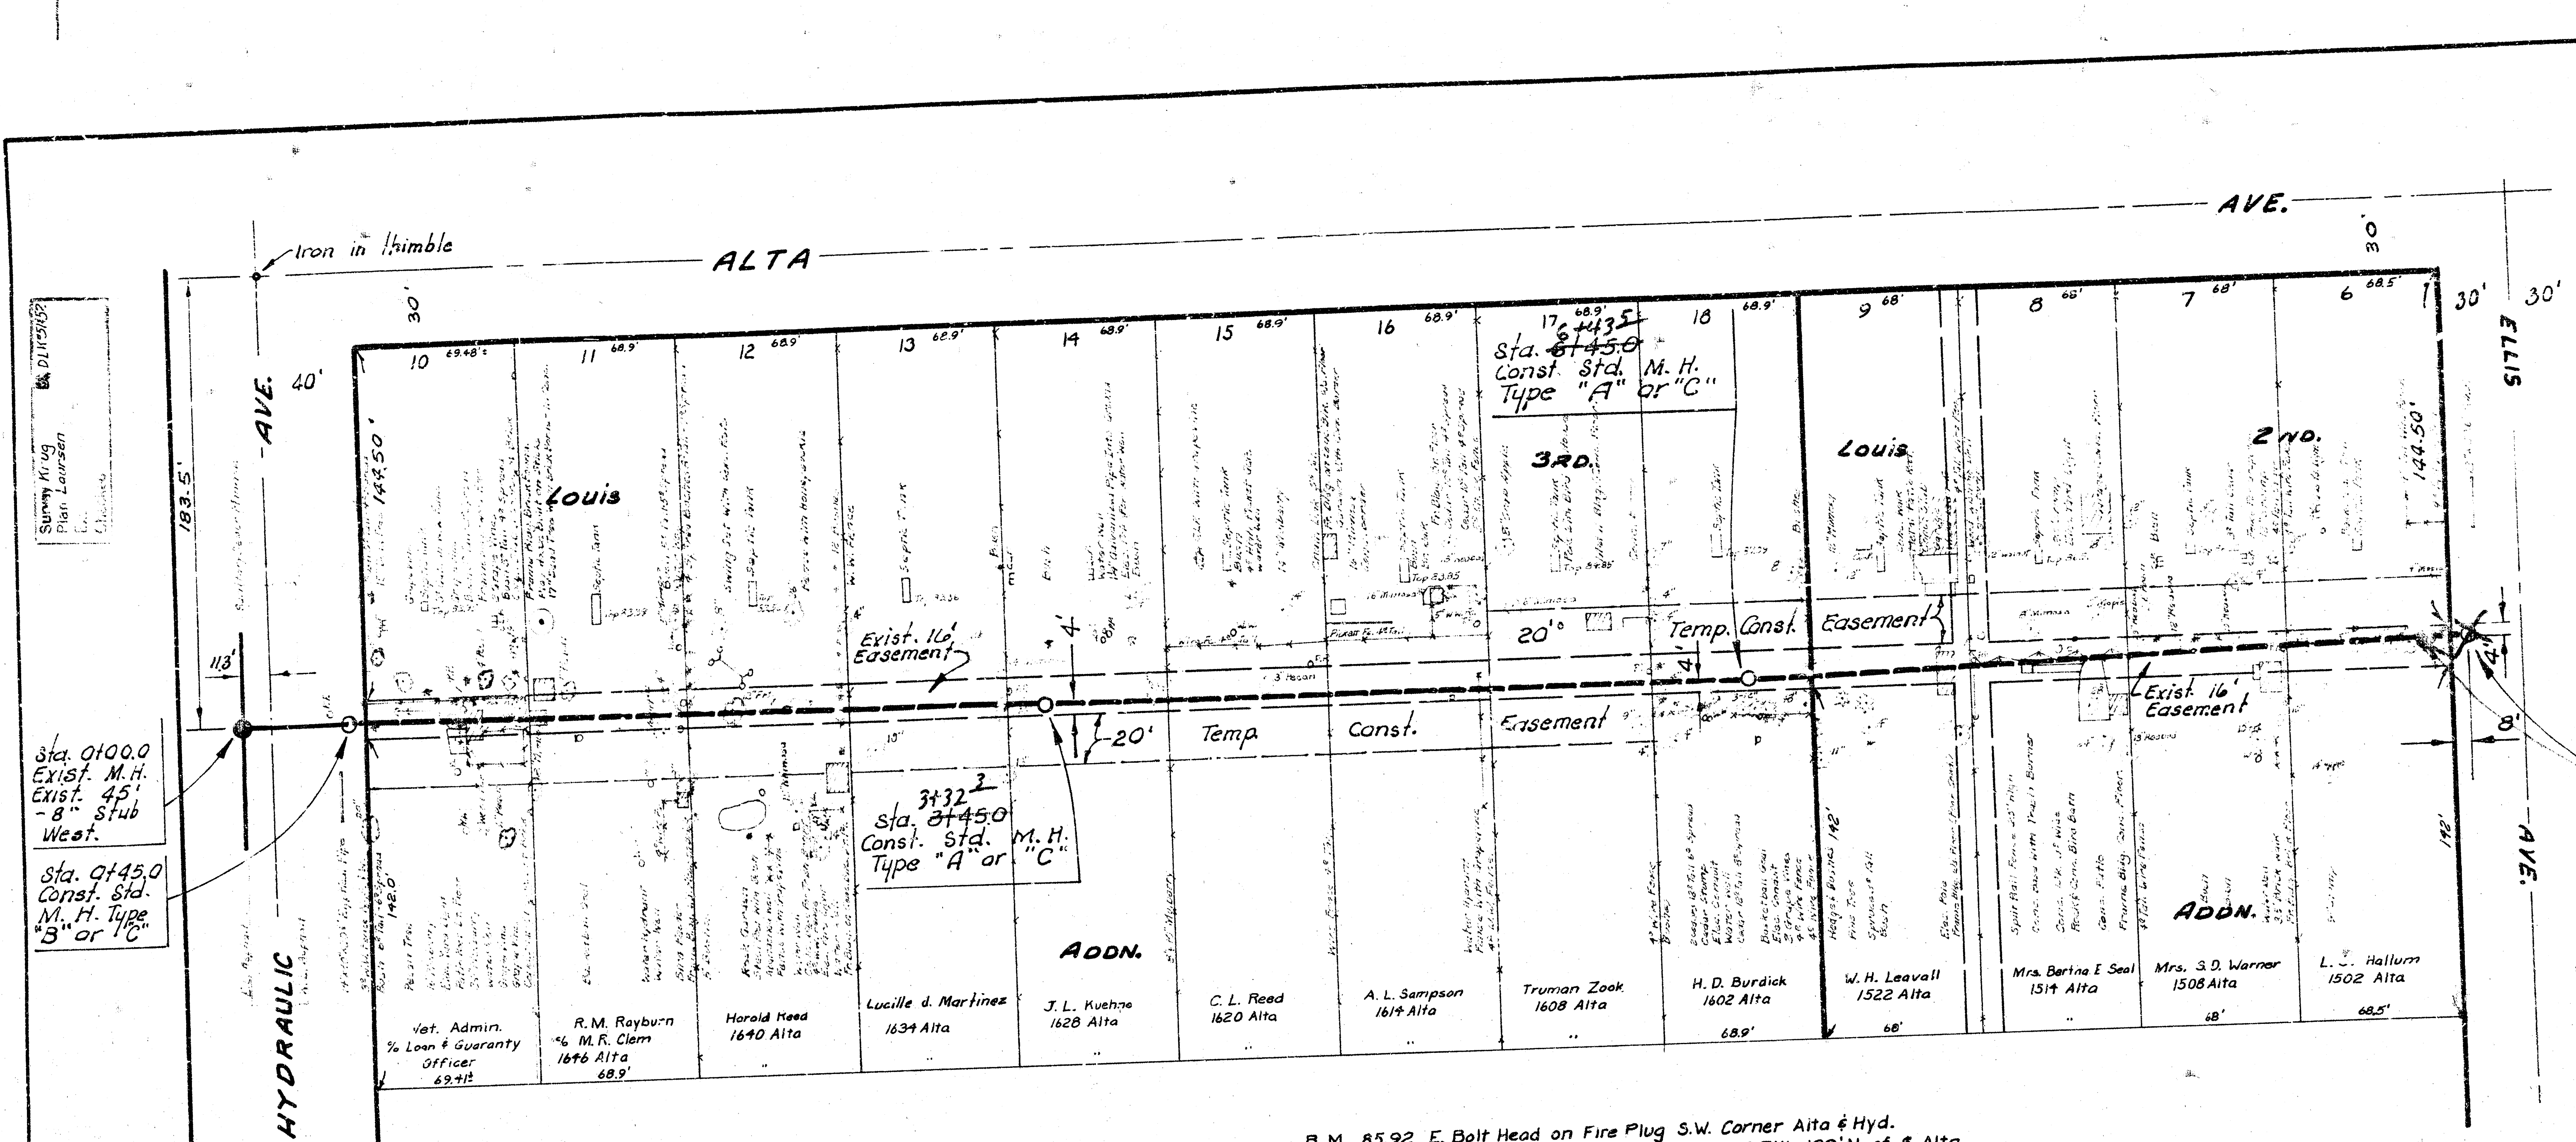

B.M. 85.92 E. Bolt Head on Fire Plug S.W. Corner Alta & Hyd.
 B.M. 86.20 60 Penny Nail N. Face P.P. W.L. of Ellis 180' N. of E Alta.

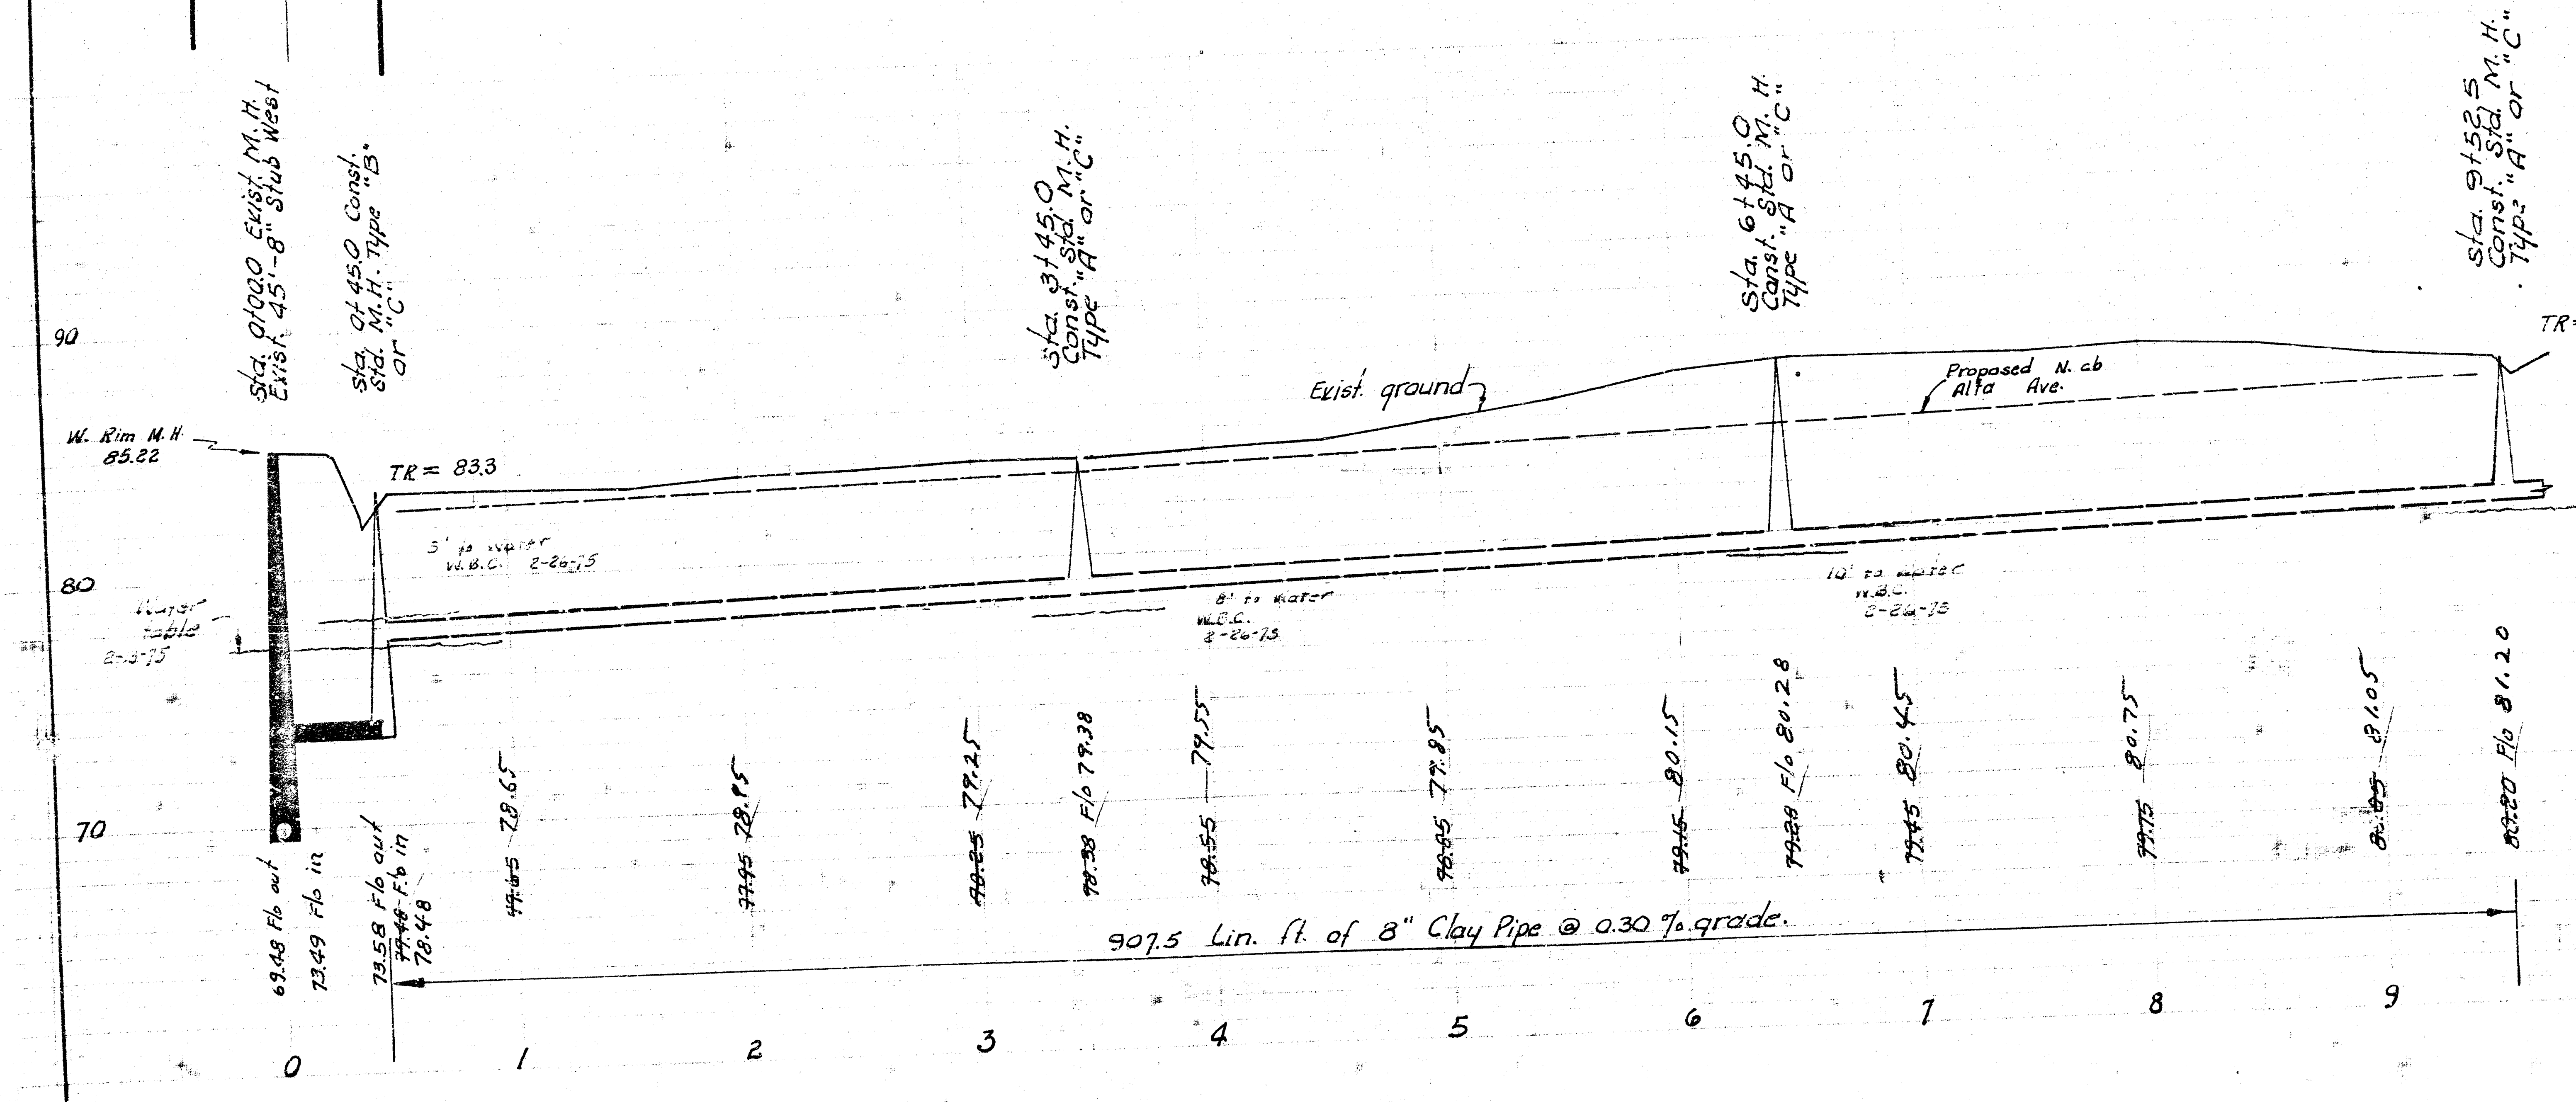

As Built 9-29-75
 LAT. 38, MAIN 1, S.W. I., SEWER
CITY OF WICHITA, KANSAS
 R.W. LINN - CITY ENGINEER
 PROJ. NO. DBKL575001 1975

