


R.C.D. 36  
R. Loomis


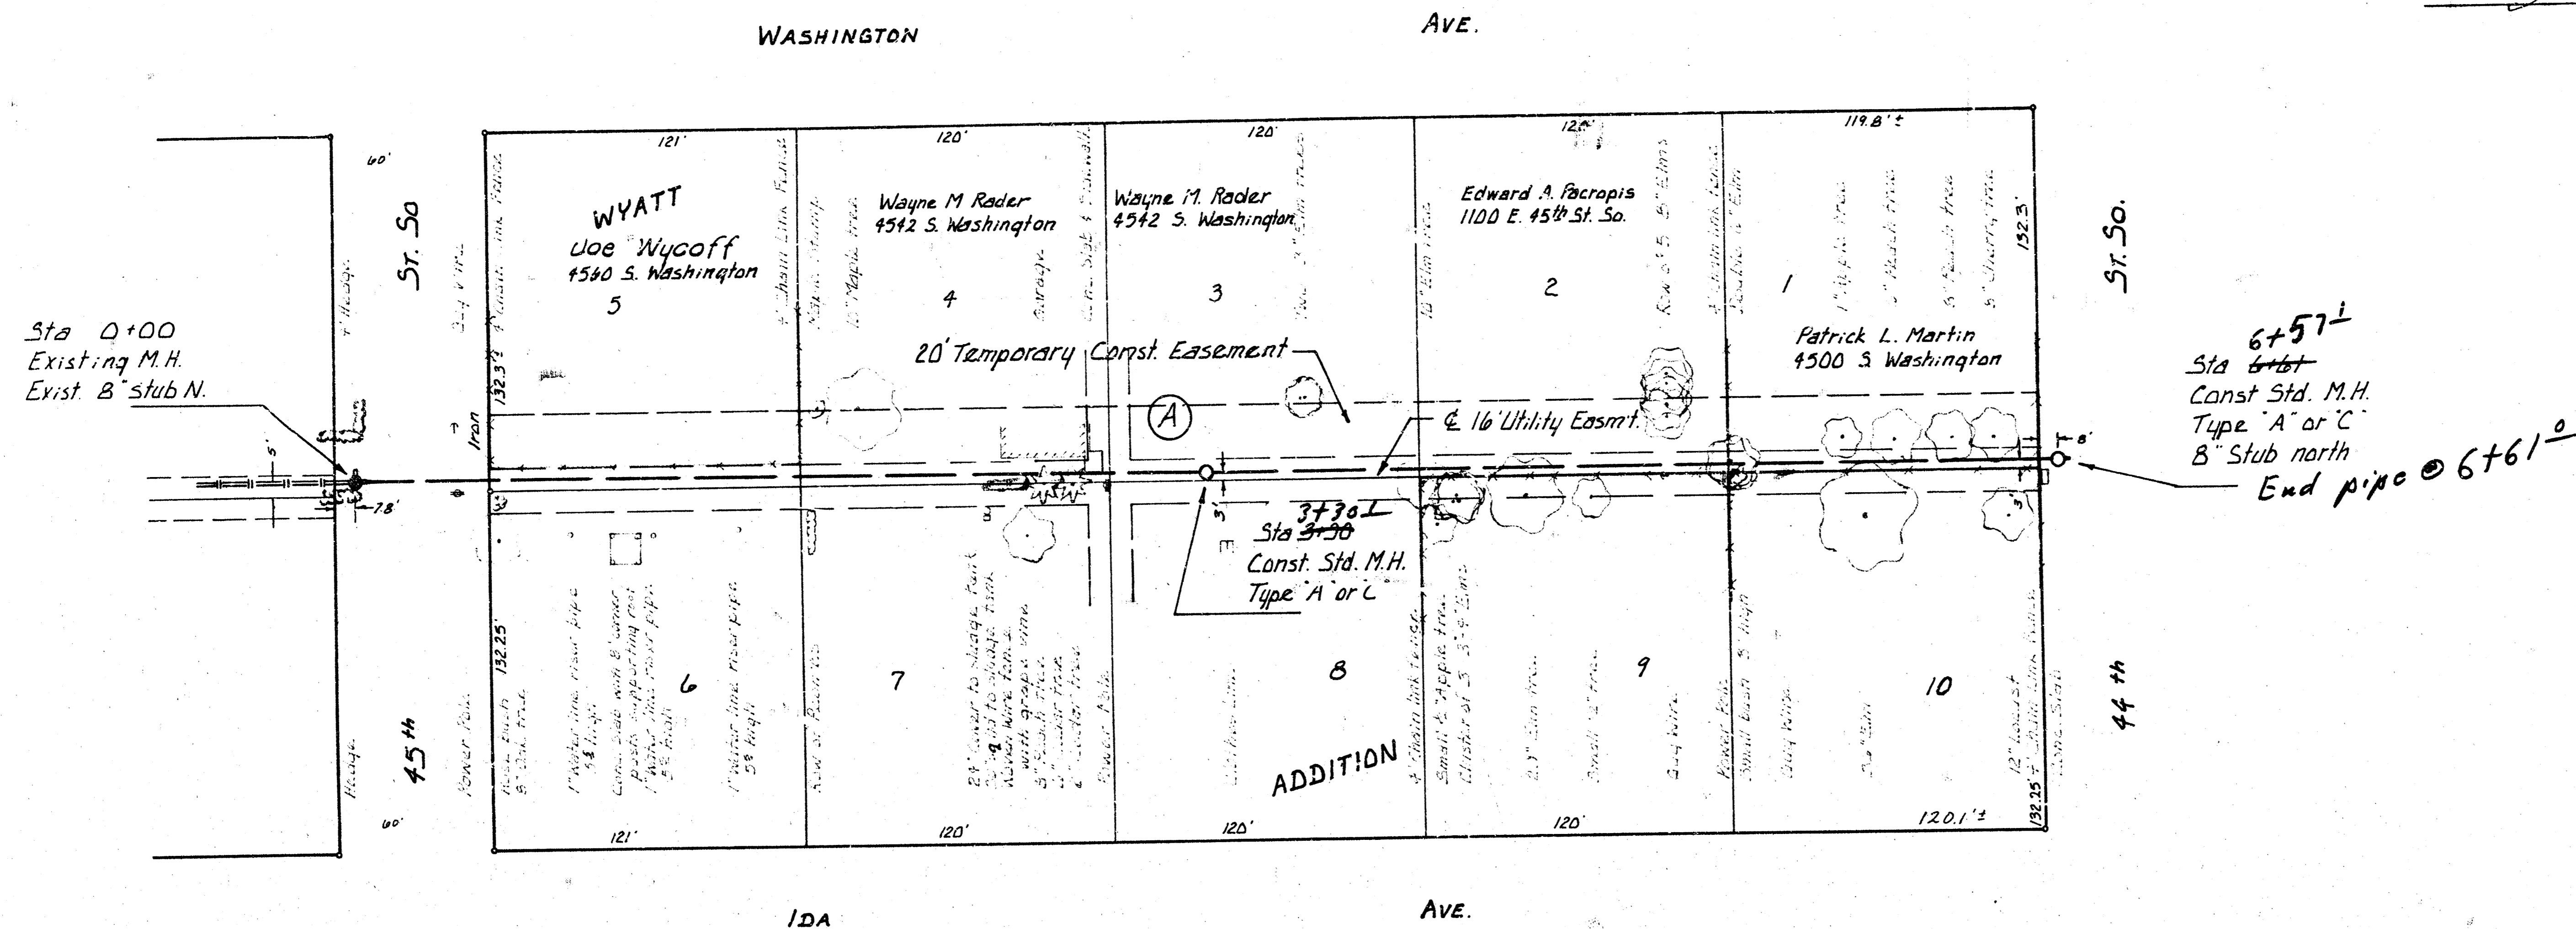


B.M. 82.53 City Std disc 2' South + 6' East of the N.E. corner of Ida + 47th St. So.

B.M. B6.93 S.E. corner lower conc. step on South Side of house at 4555 Ida

6+57.1  
Sta 6+61  
Const Std. M.H.  
Type A or C  
B' Stub north  
End pipe @ 6+61.0

Plan Scale 1" = 40'  
Profile Scale 1" = 40' Horiz.  
1" = 5' Vert.

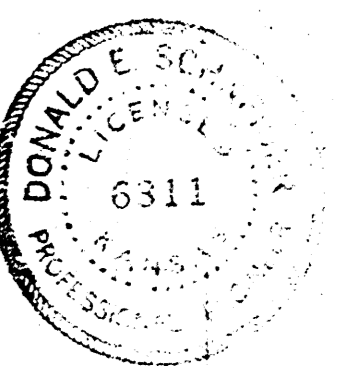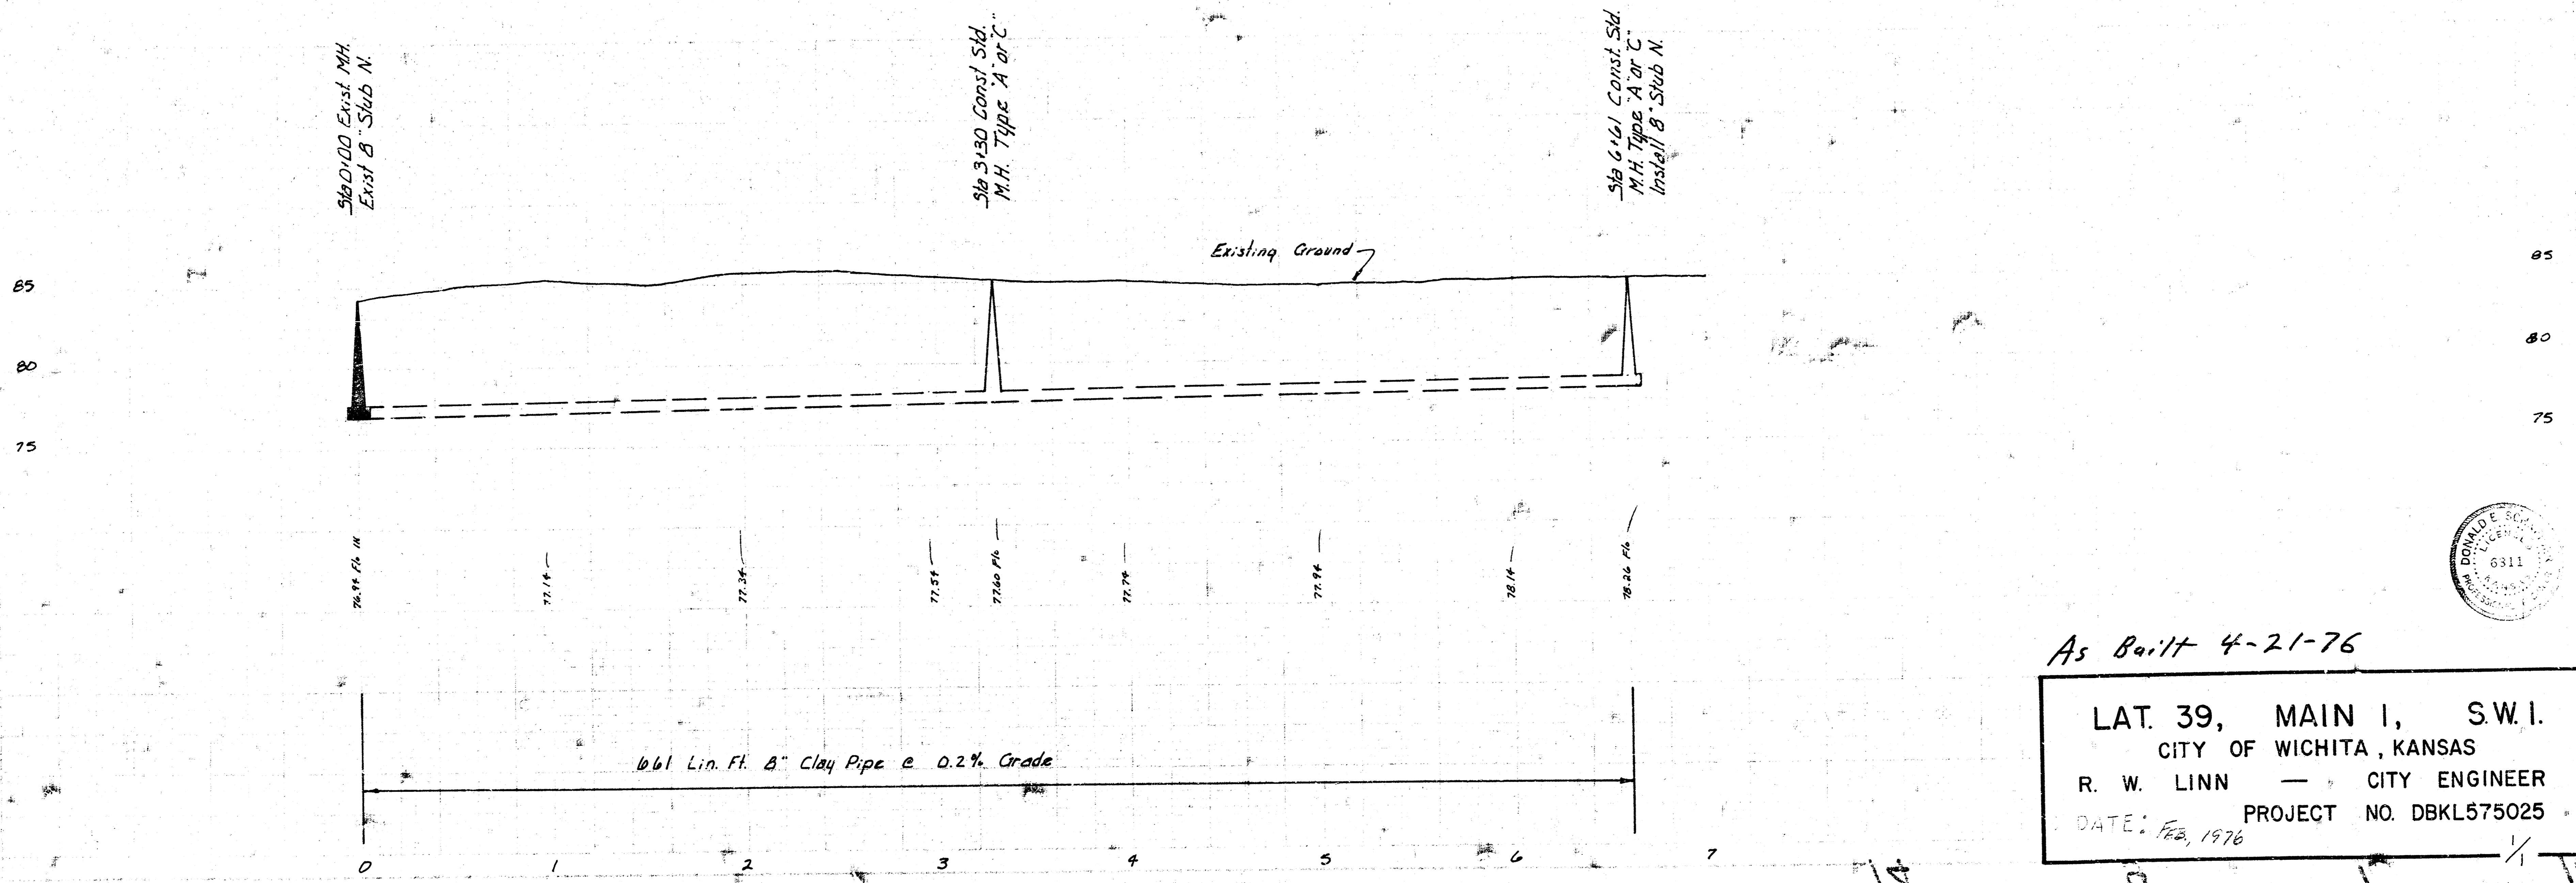

As Built 4-21-76

LAT. 39, MAIN 1, S.W.I.  
CITY OF WICHITA, KANSAS  
R. W. LINN — CITY ENGINEER  
PROJECT NO. DBKL575025  
DATE: Feb, 1976