



- B. M. 85.78 Top N. bolt Fire Hyd., N.E. cor 46th & Hydraulic.
- B. M. 86.86 S.E. bolt Top Flange, Fire Hyd. N.E. cor. Lulu & 46th.
- B. M. 84.51 R. R. Sdk. S. Side R.P. betw. Pattie & Lulu N. Side 46th.

Sta. 0+00.0
Exist. M.H.
Exist. 8"-25" stub No.
Stub not encased.

NOTE:
Const. temp. fence along west side of the 20' temp. Const. easement. This will keep the dogs in on lot No. 8.
This work will not be paid for directly and the cost shall be considered as subsidiary to other items of work.

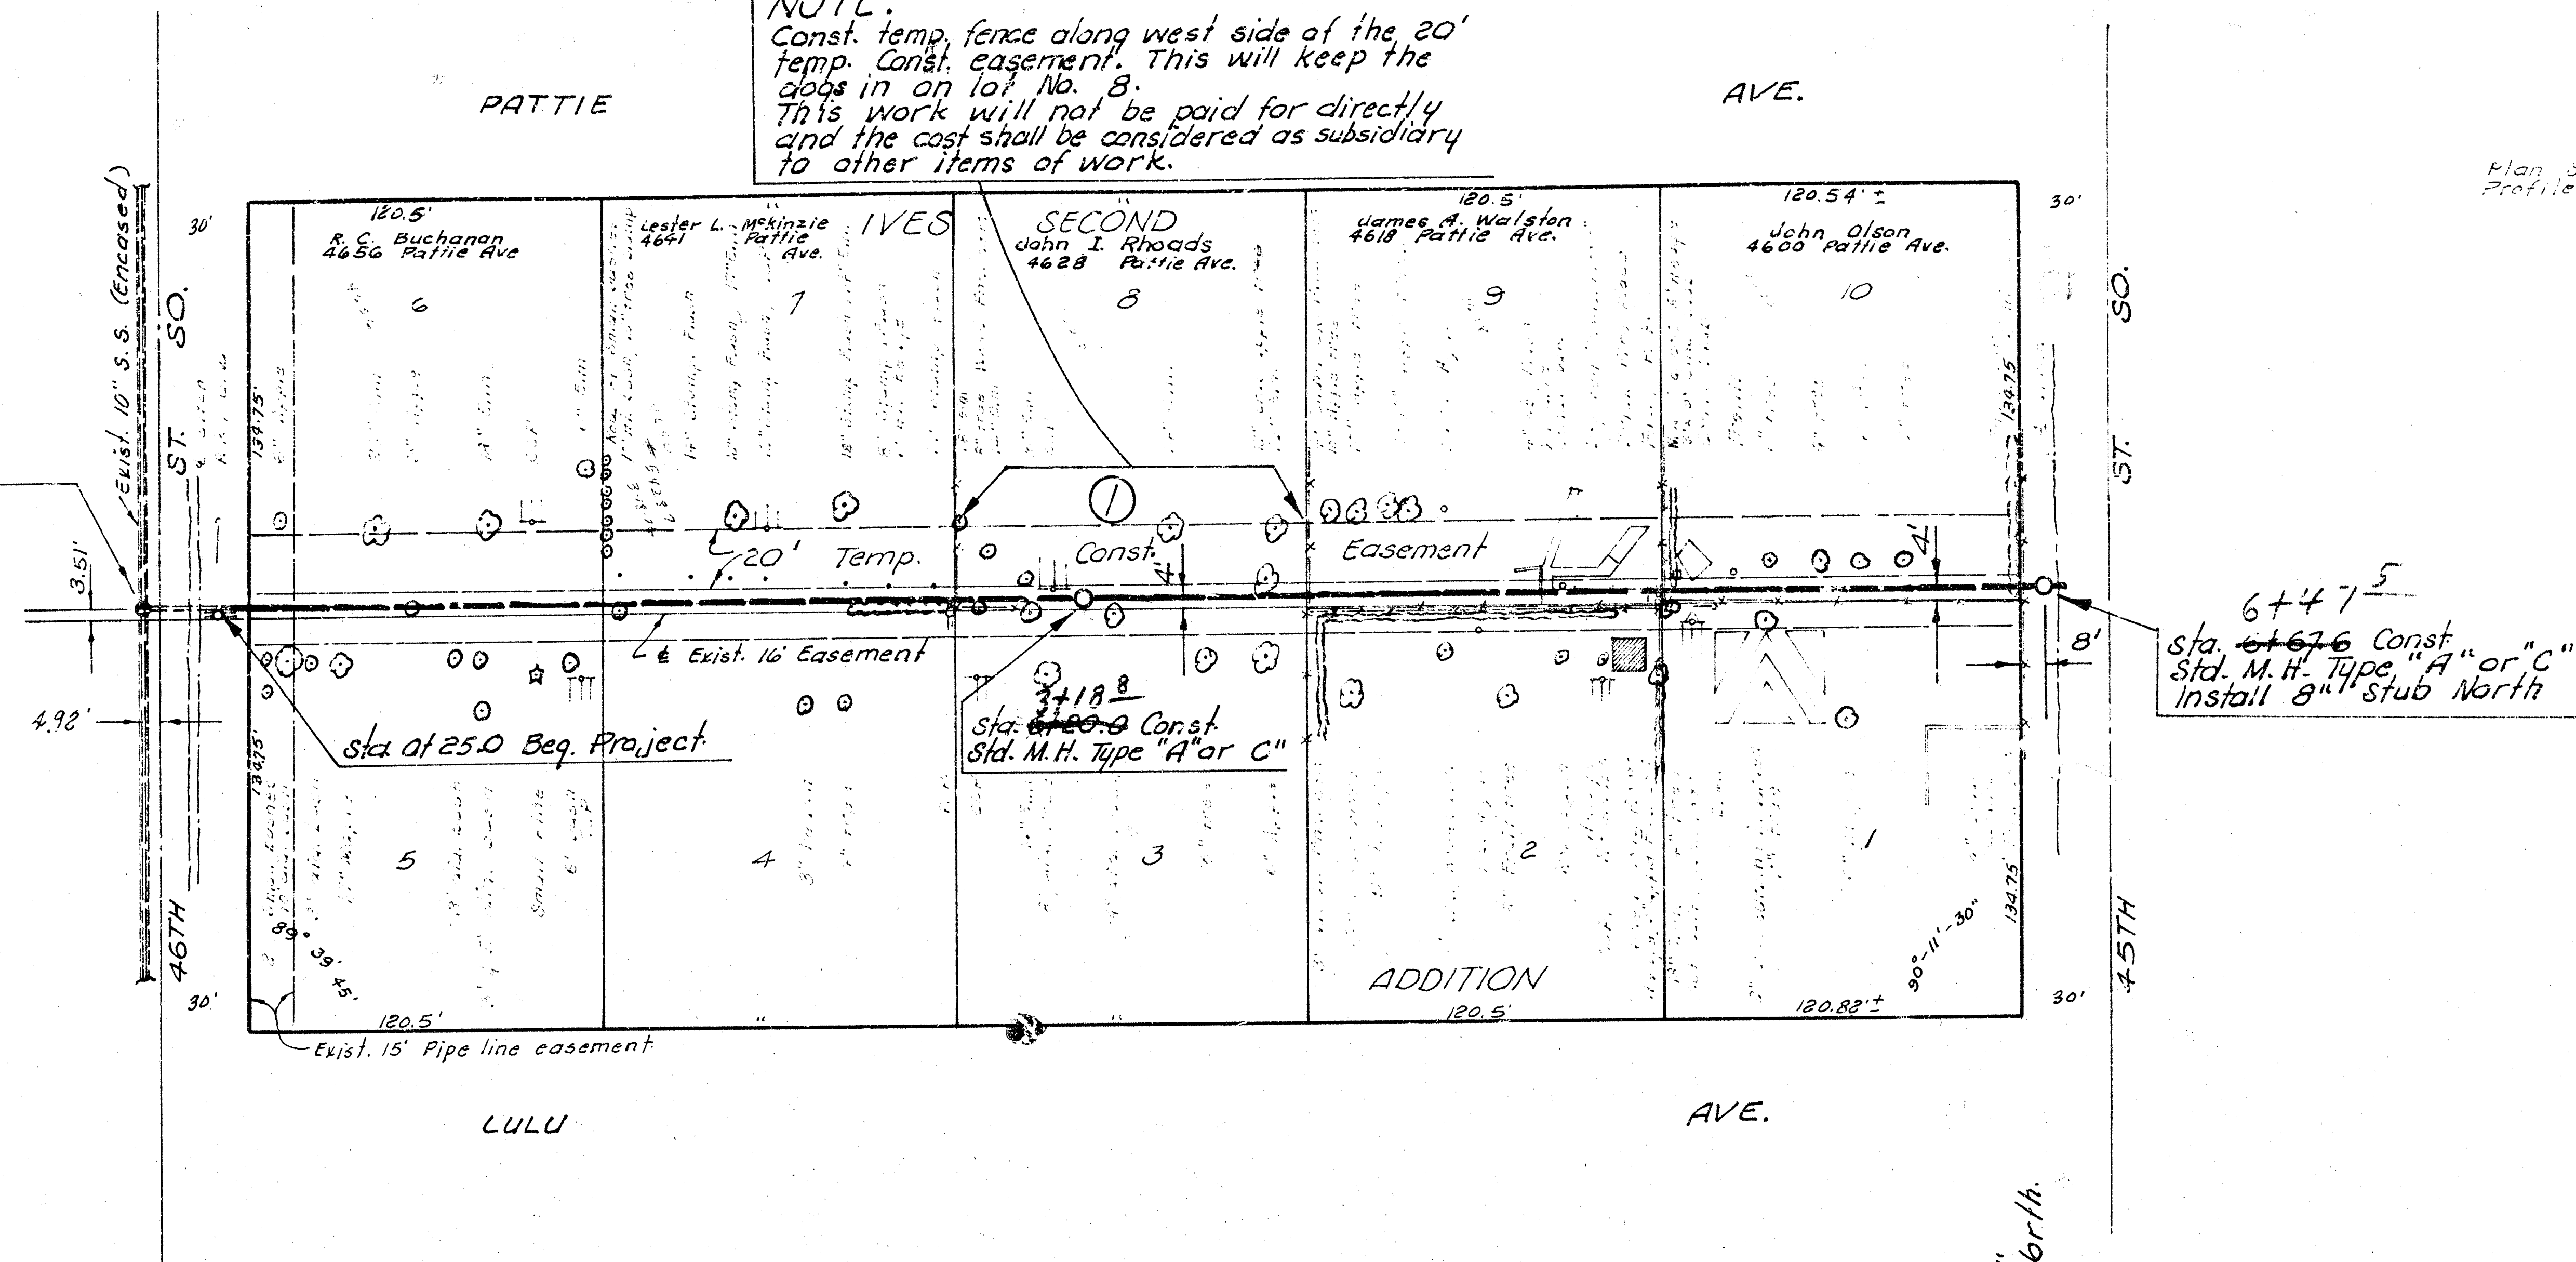

Plan Scale 1" = 40' Horiz.
Profile Scale 1" = 40' Vert.

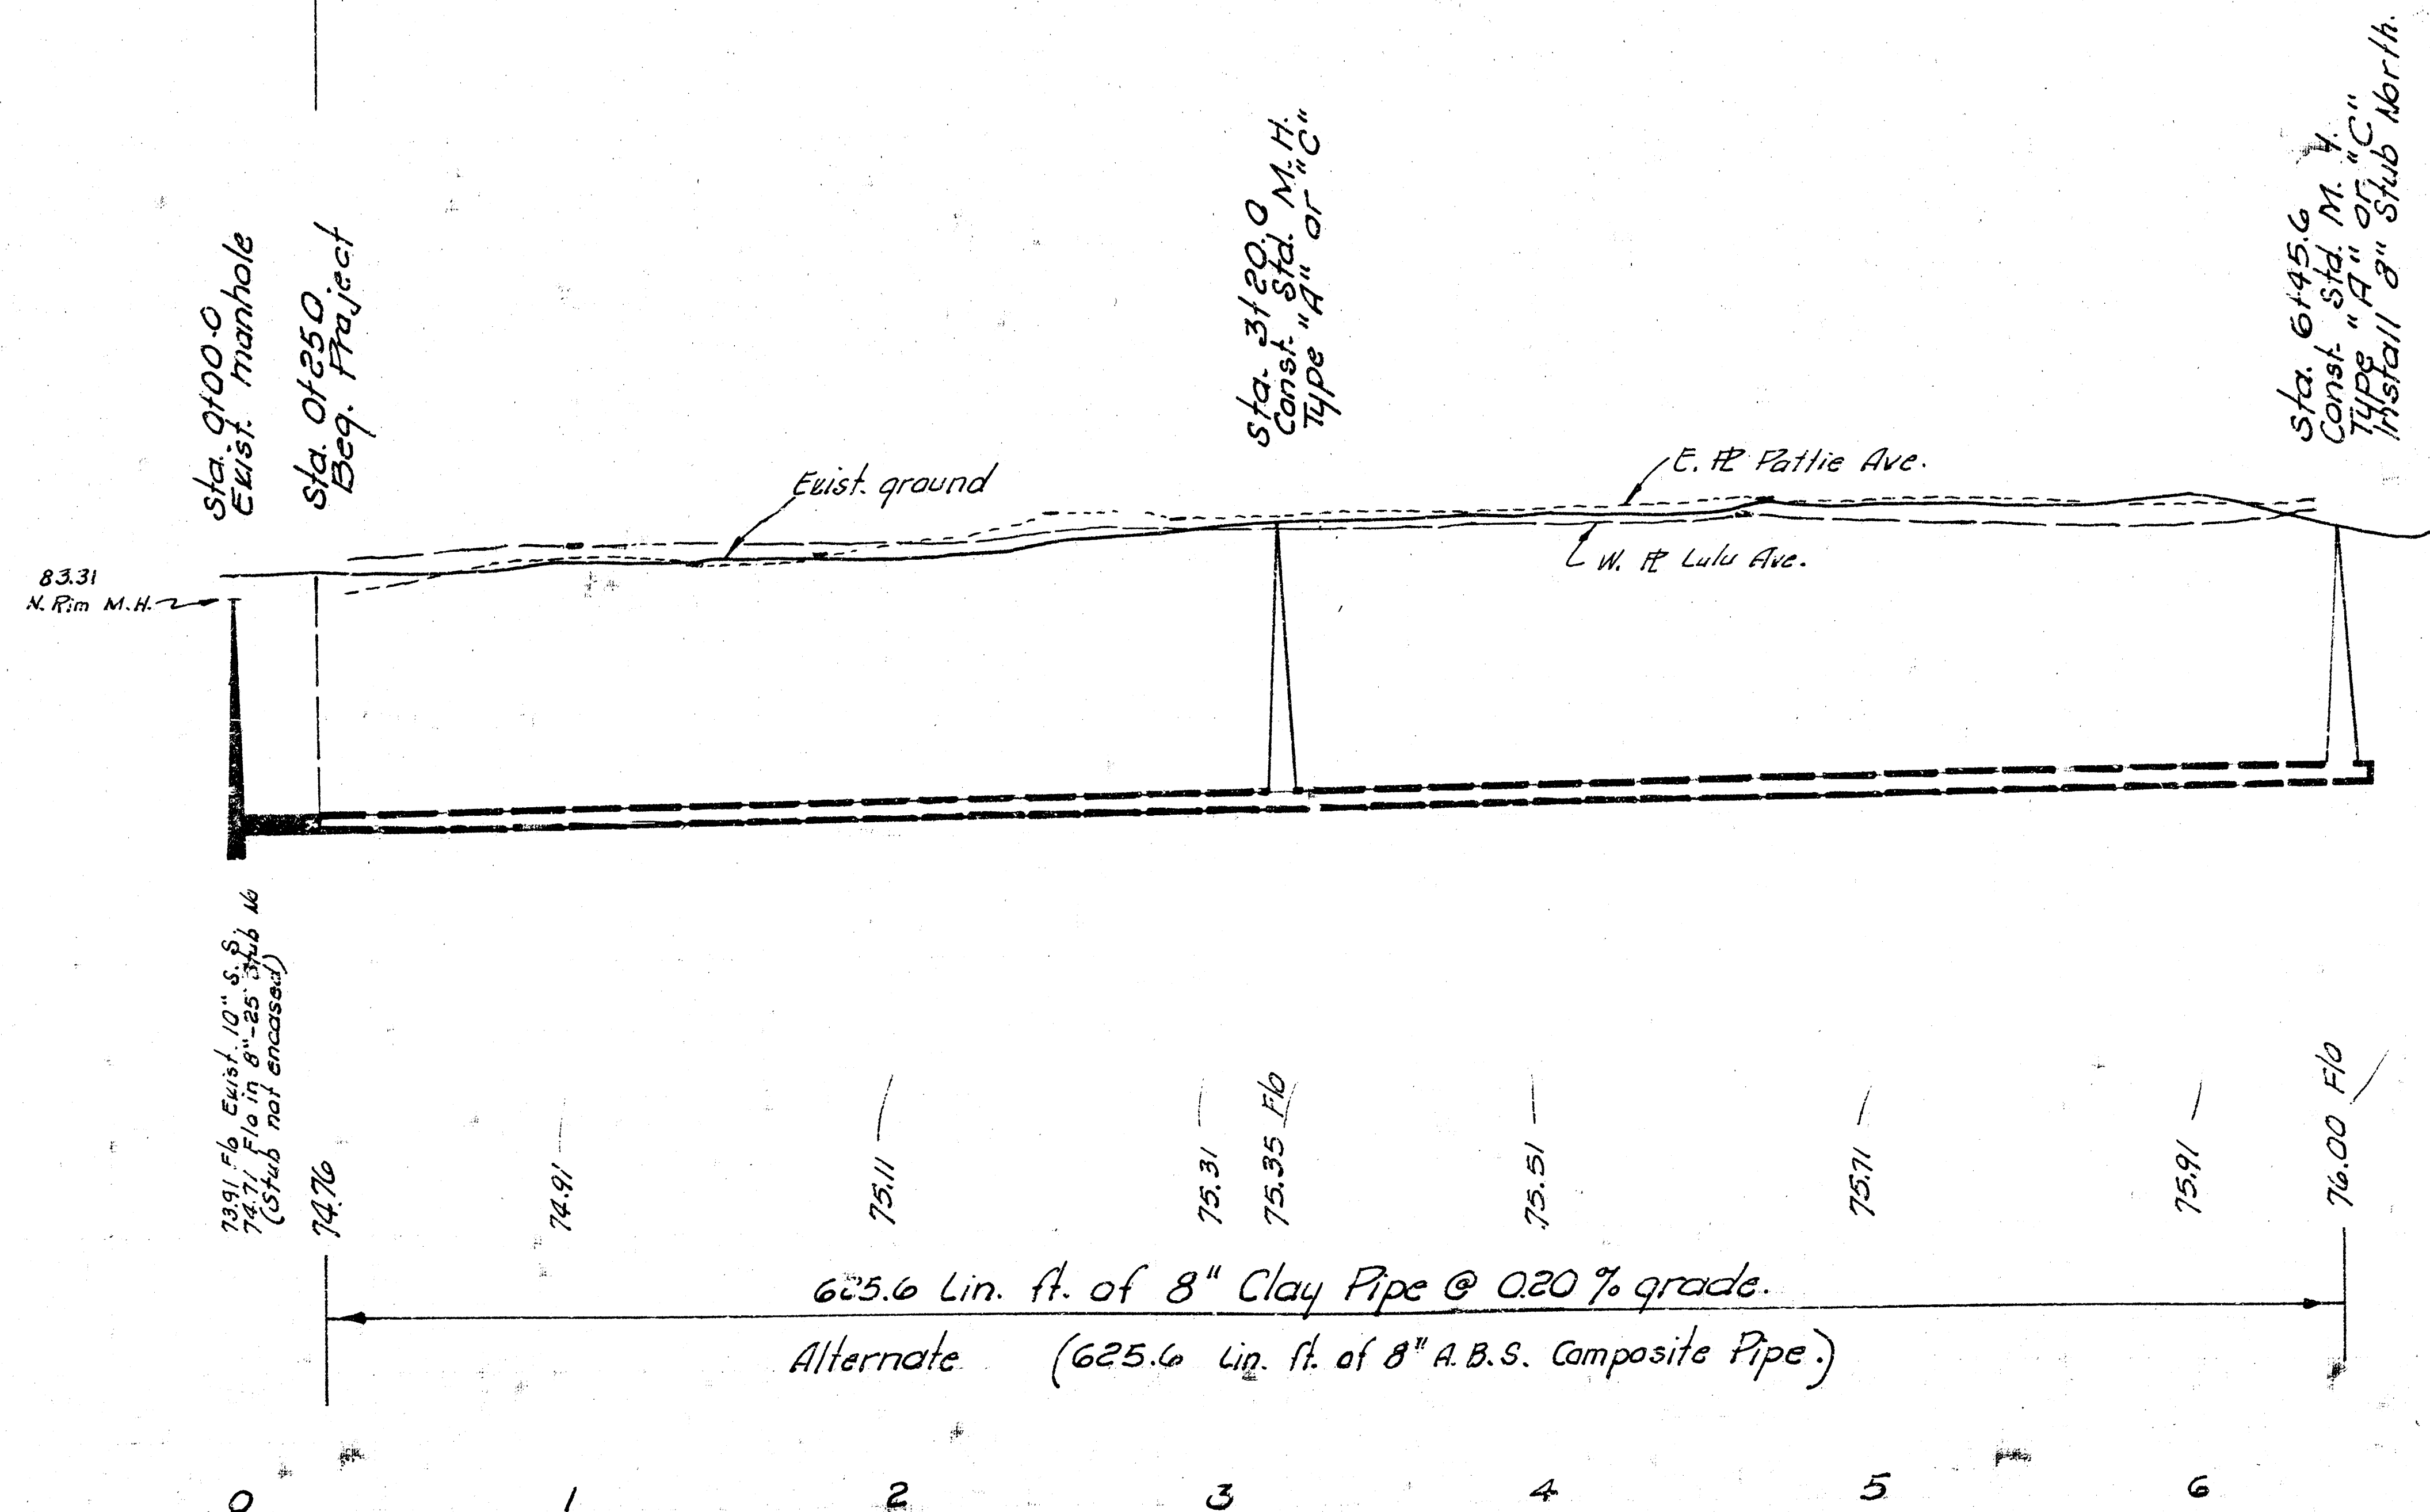

625.6 Lin. ft. of 8" Clay Pipe @ 0.20% grade.
Alternate (625.6 Lin. ft. of 8" A.B.S. Composite Pipe.)

As Built 3-22-76

LAT. 43, MAIN I, S. W. INTERCEPTOR SEWER
CITY OF WICHITA, KANSAS
R. W. LINN — CITY ENGINEER
DATE: 7/3 PROJECT NO. DBKL 575073