



LATERAL 55 , MAIN 1 SOUTHWEST INTERCEPTOR SEWER

Project no. 468-76-245-80795-000-000-001

CITY OF WICHITA, KANSAS
MIKE LINDEBAK CITY ENGINEER

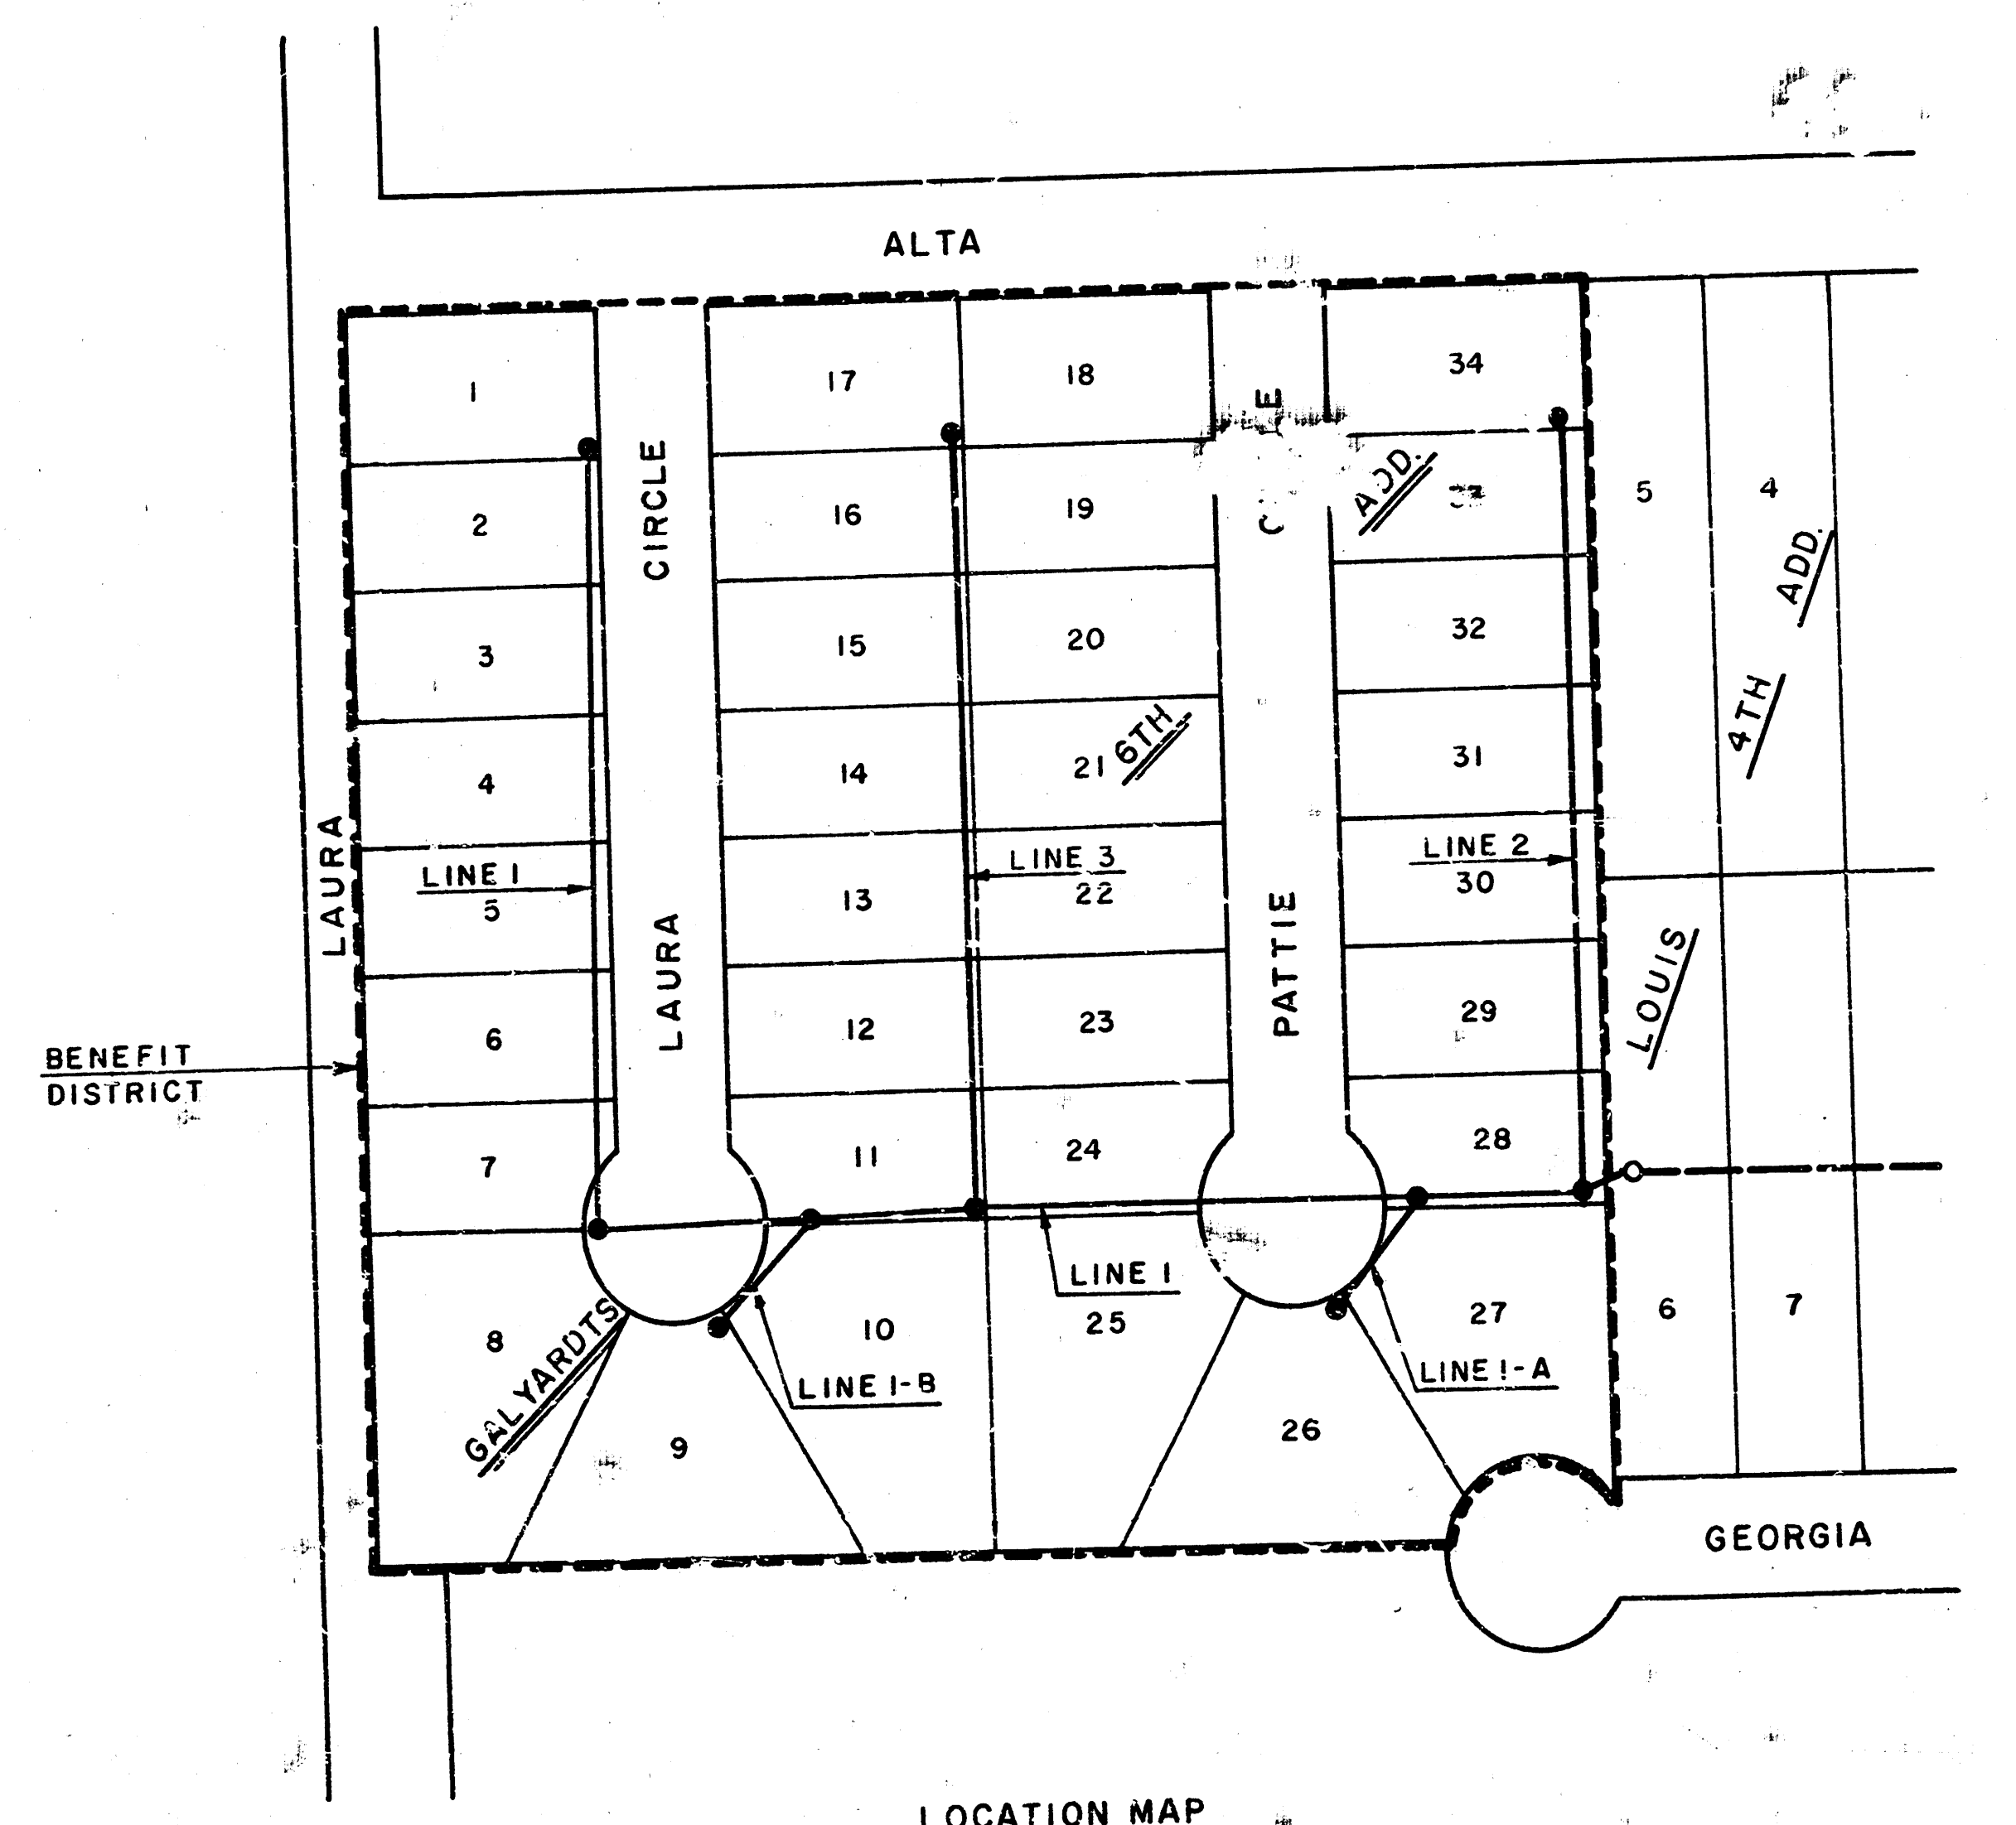


LOCATION MAP

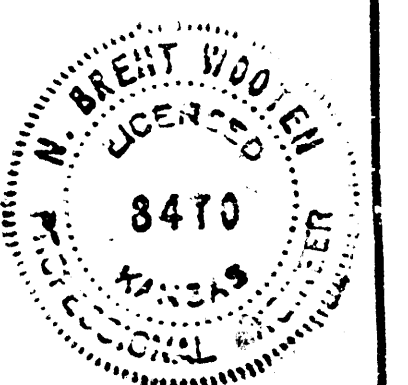




BAUGHMAN COMPANY, P.A.
SURVEYING & ENGINEERING
316/262-7271 • 200 LAURA • WICHITA, KANSAS 67211

APRIL 2, 2011

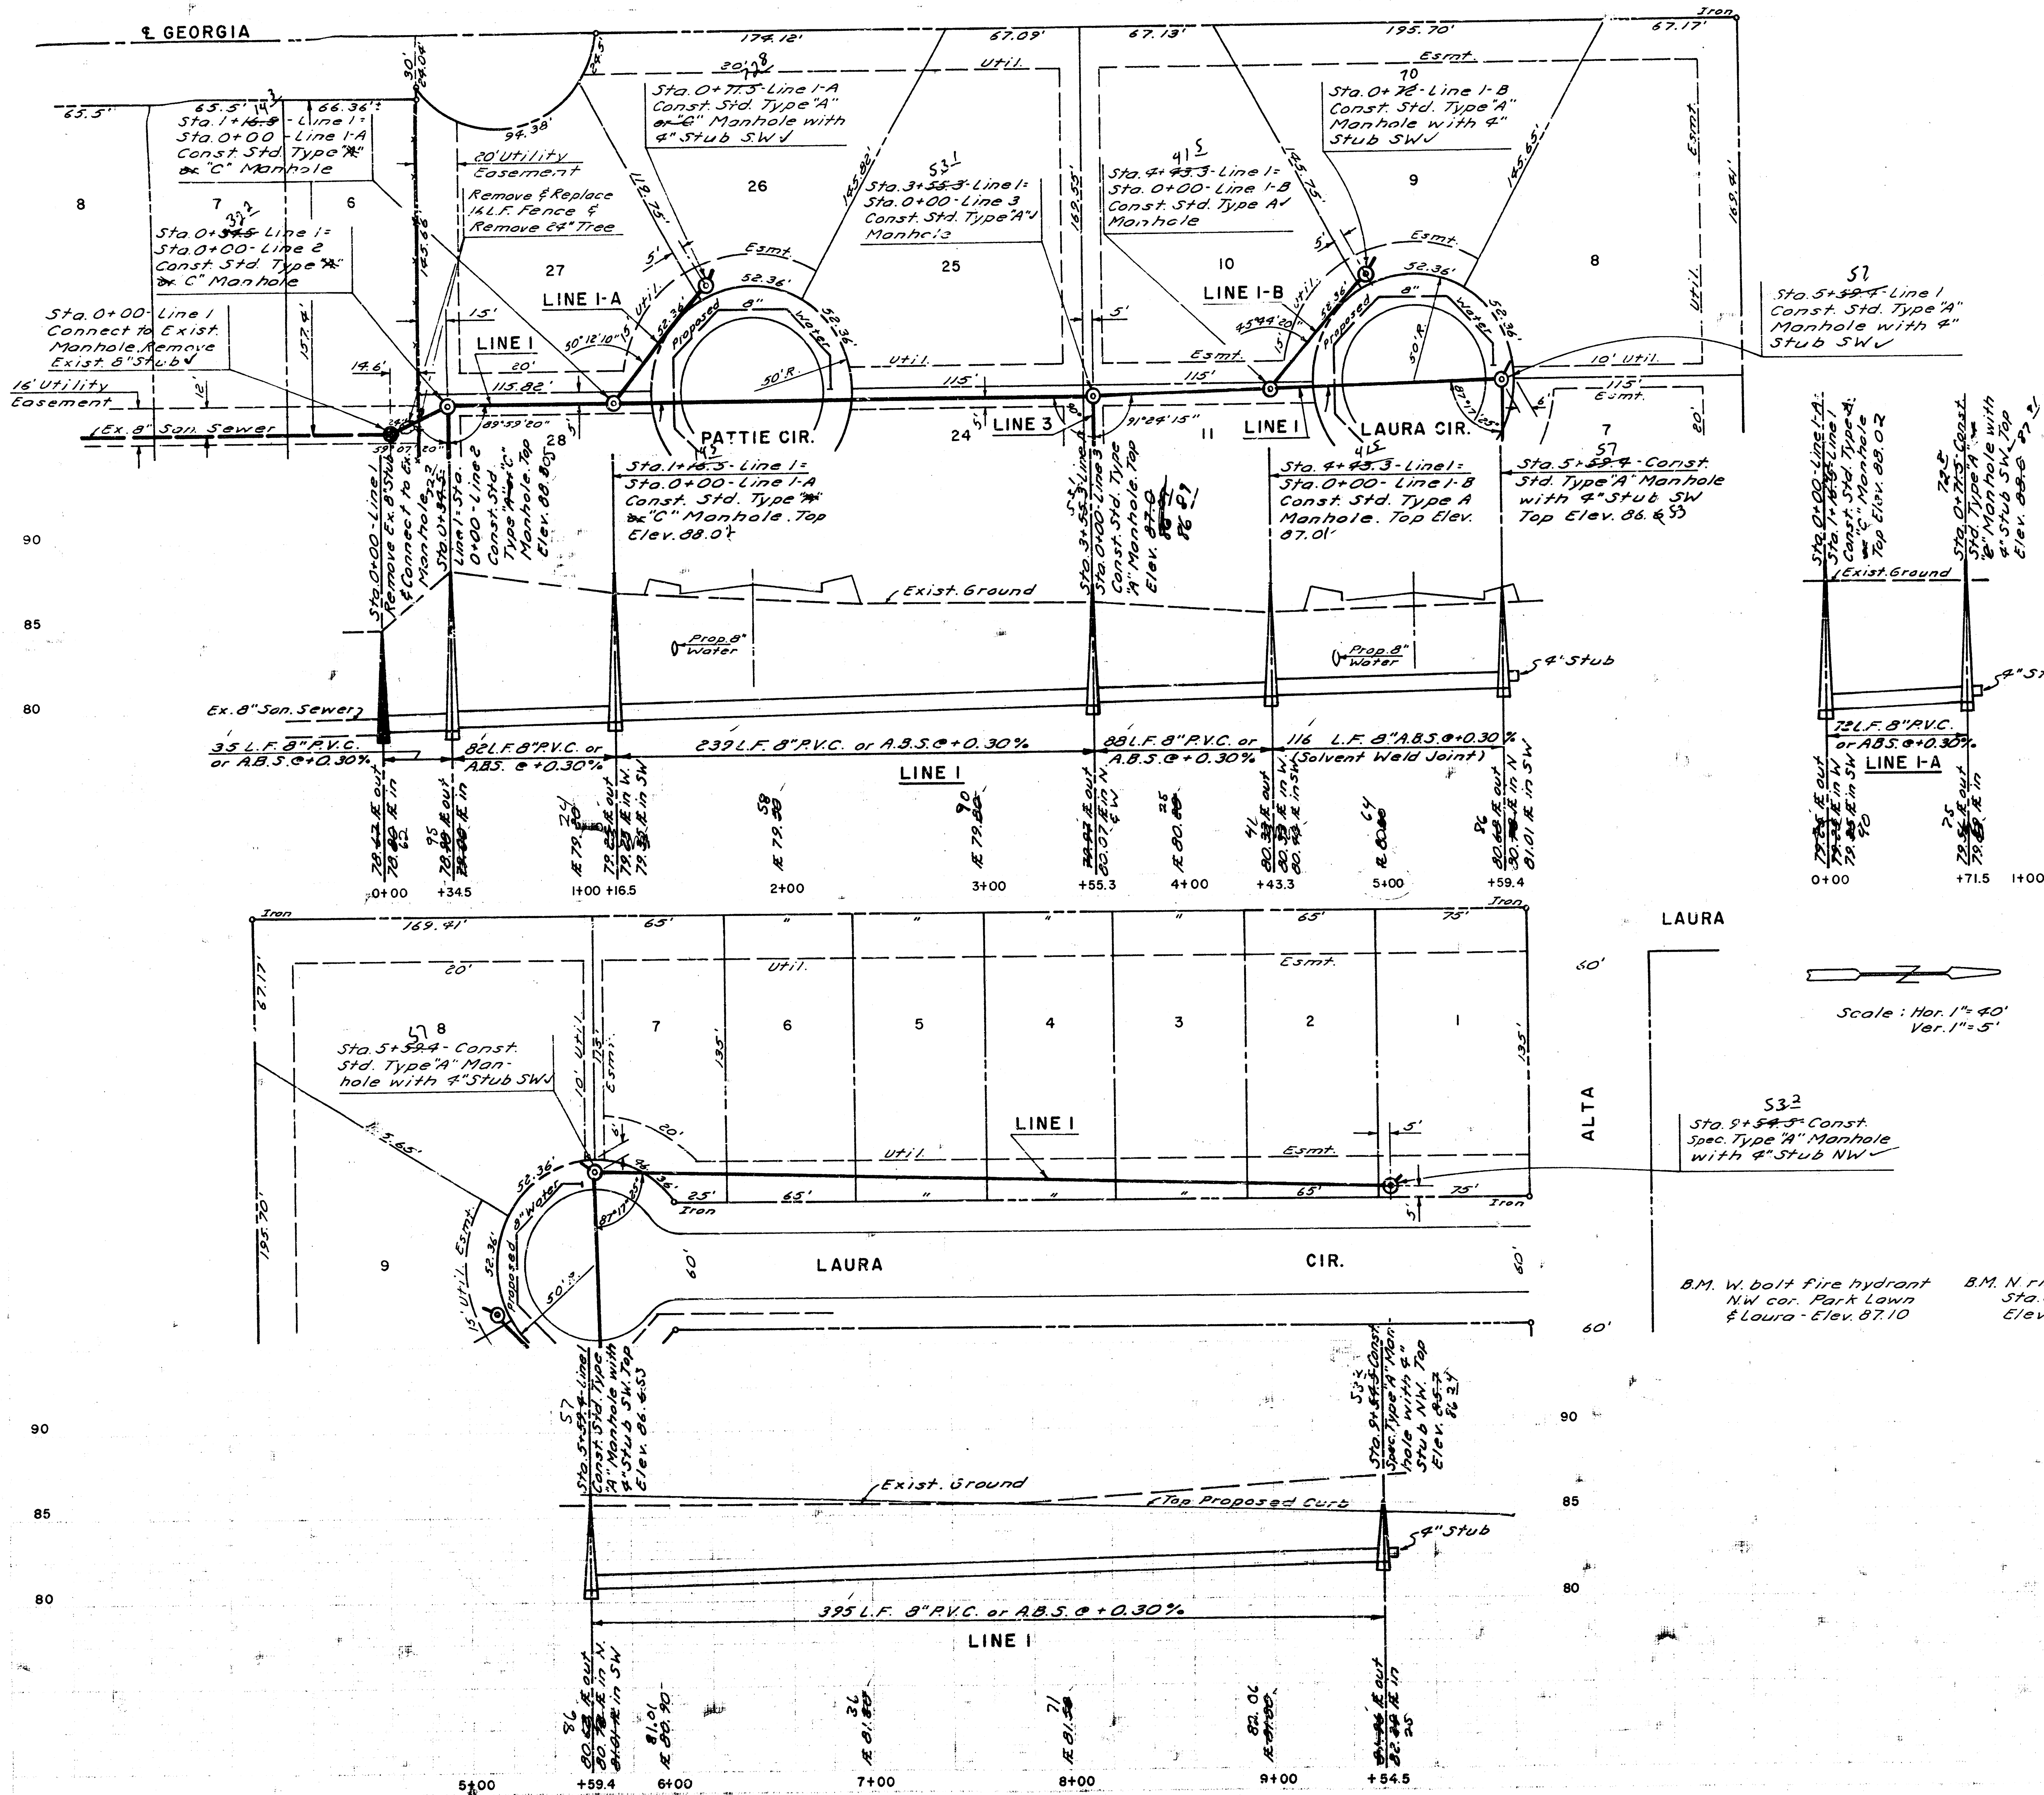

Scale: Hor. 1"=40'
Ver. 1"=5'

As Built
S.L.L.
6-84

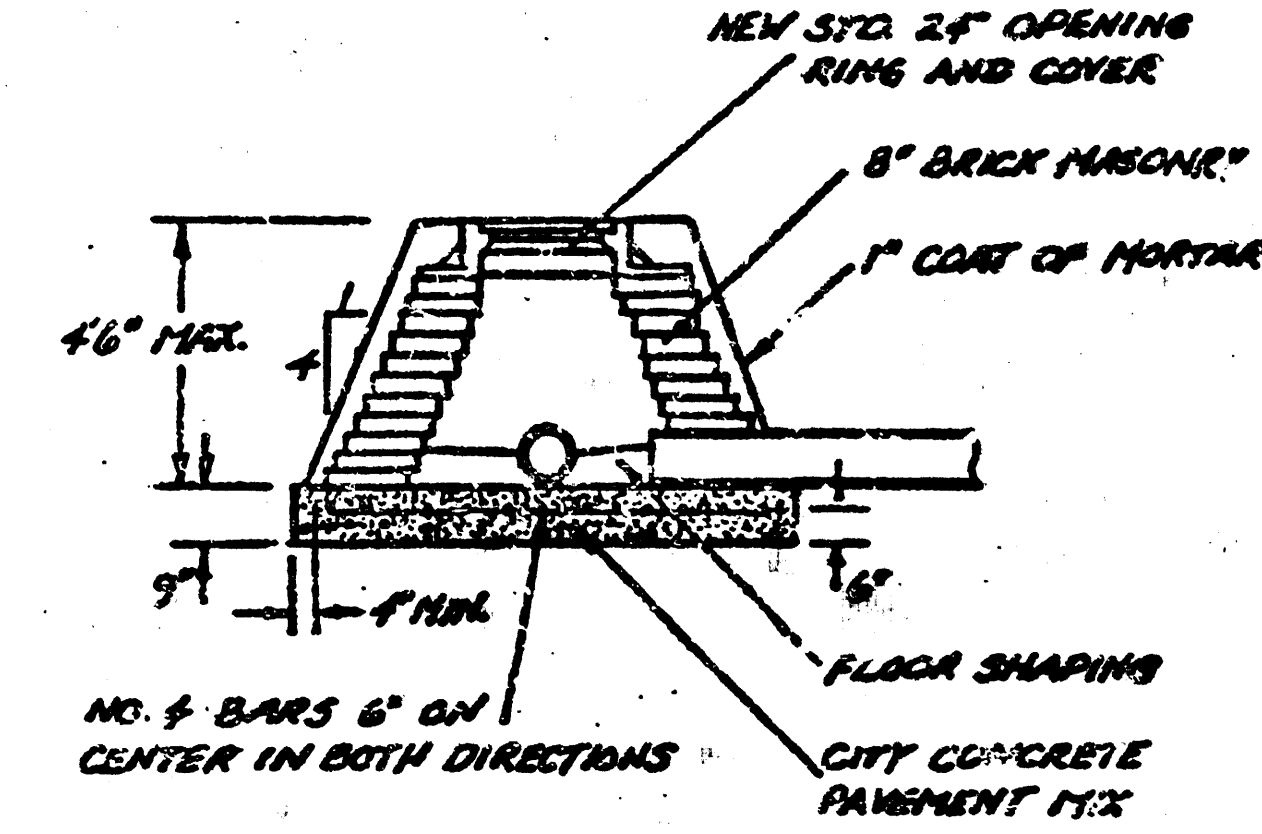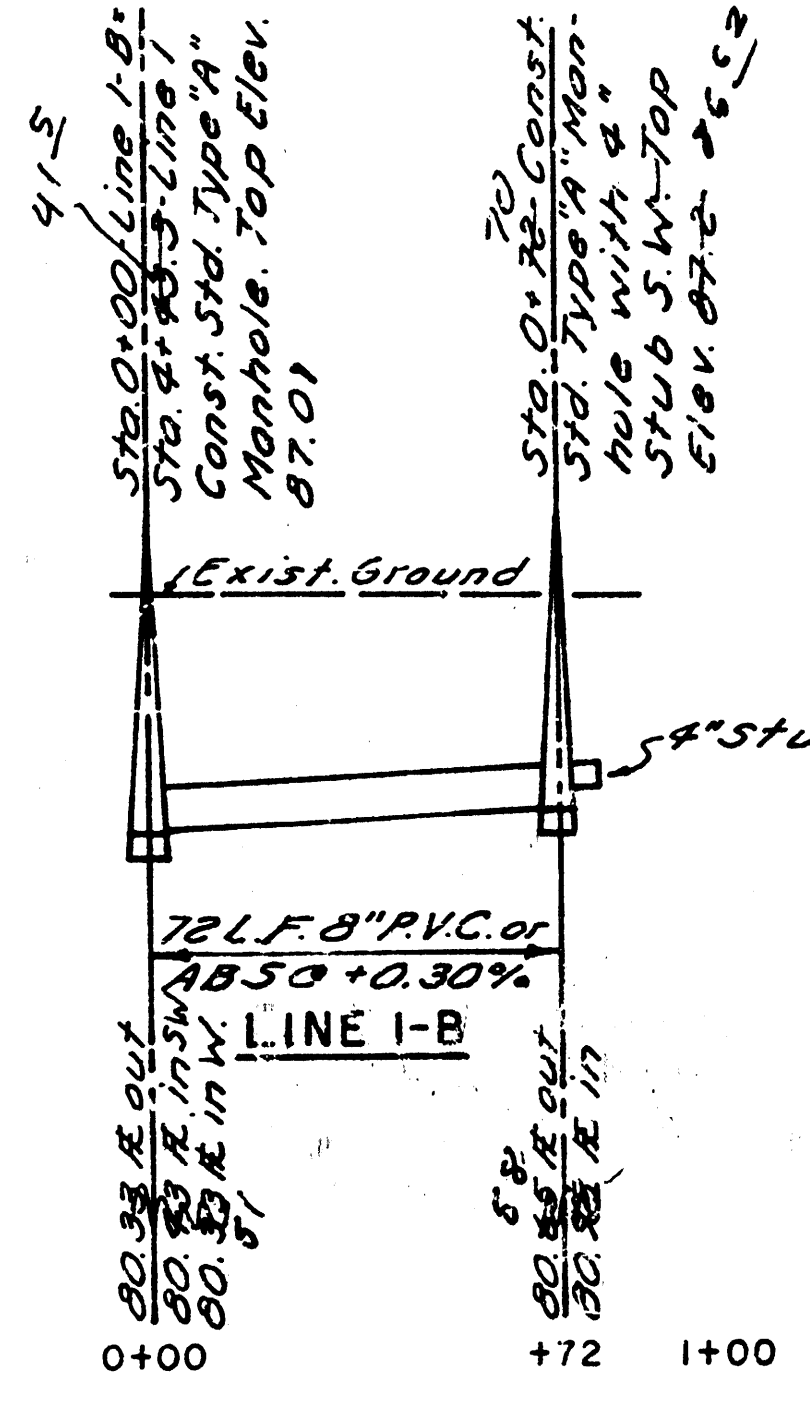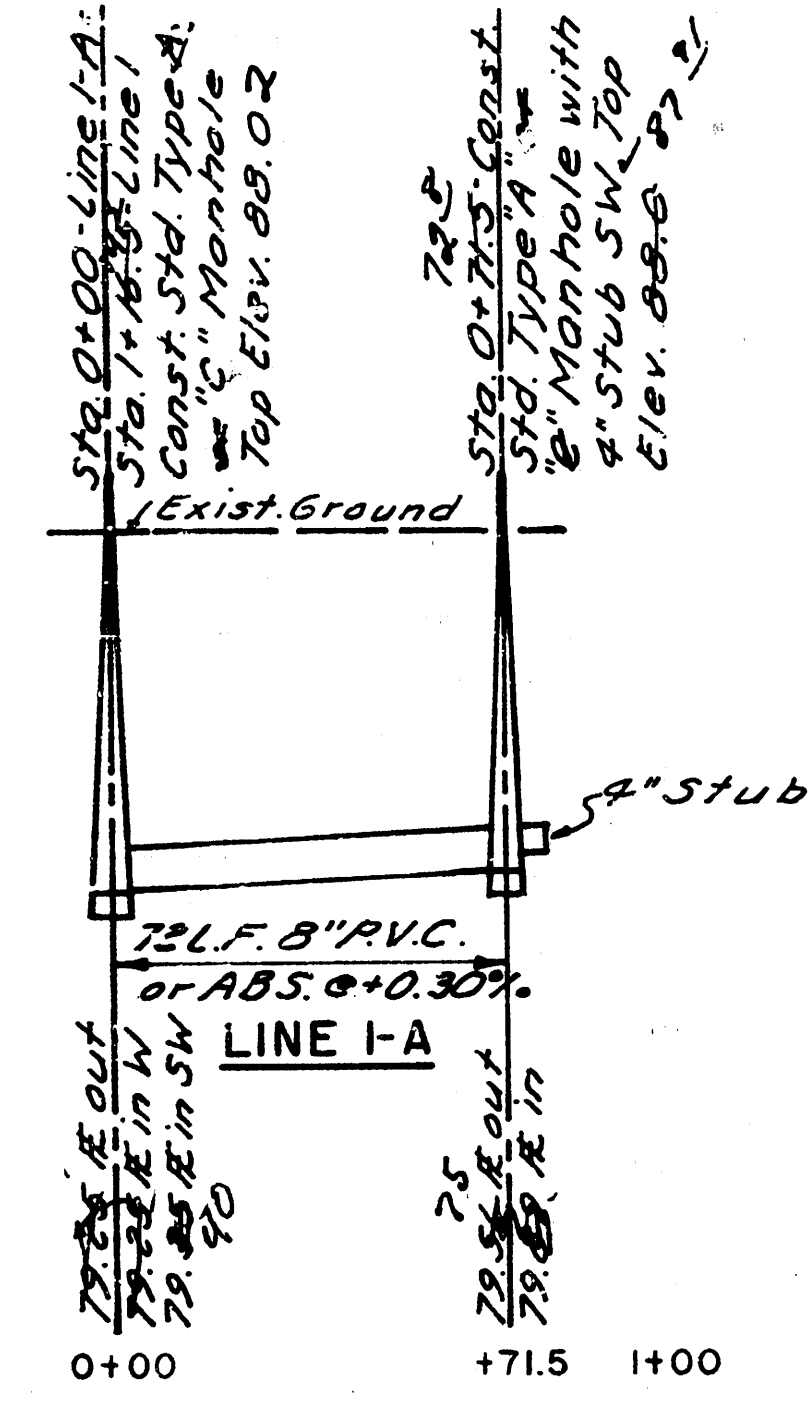

SPECIAL MANHOLE "TYPE A"

B.M. W. bolt fire hydrant
NW cor. Park Lawn
Laura - Elev. 87.10


B.M. N. rim of manhole
Sta. 0+00 - Line I
Elev. 87.81


LATERAL 5A, MAIN I
SOUTHWEST INTERCEPTOR SEWER

SANITARY SEWER TO SERVE
GALYARDT'S 6TH ADDITION


PROJ. NO. 468-76-245-80795-000-000-001

CITY OF WICHITA, KANSAS
MIKE LINDEBAK CITY ENGINEER

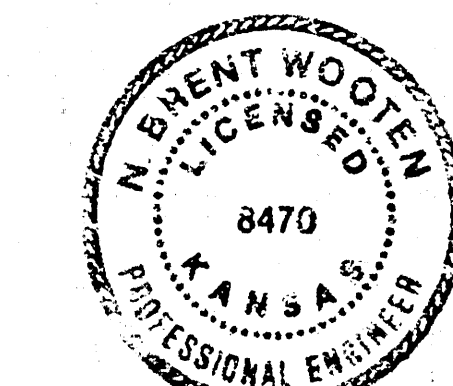

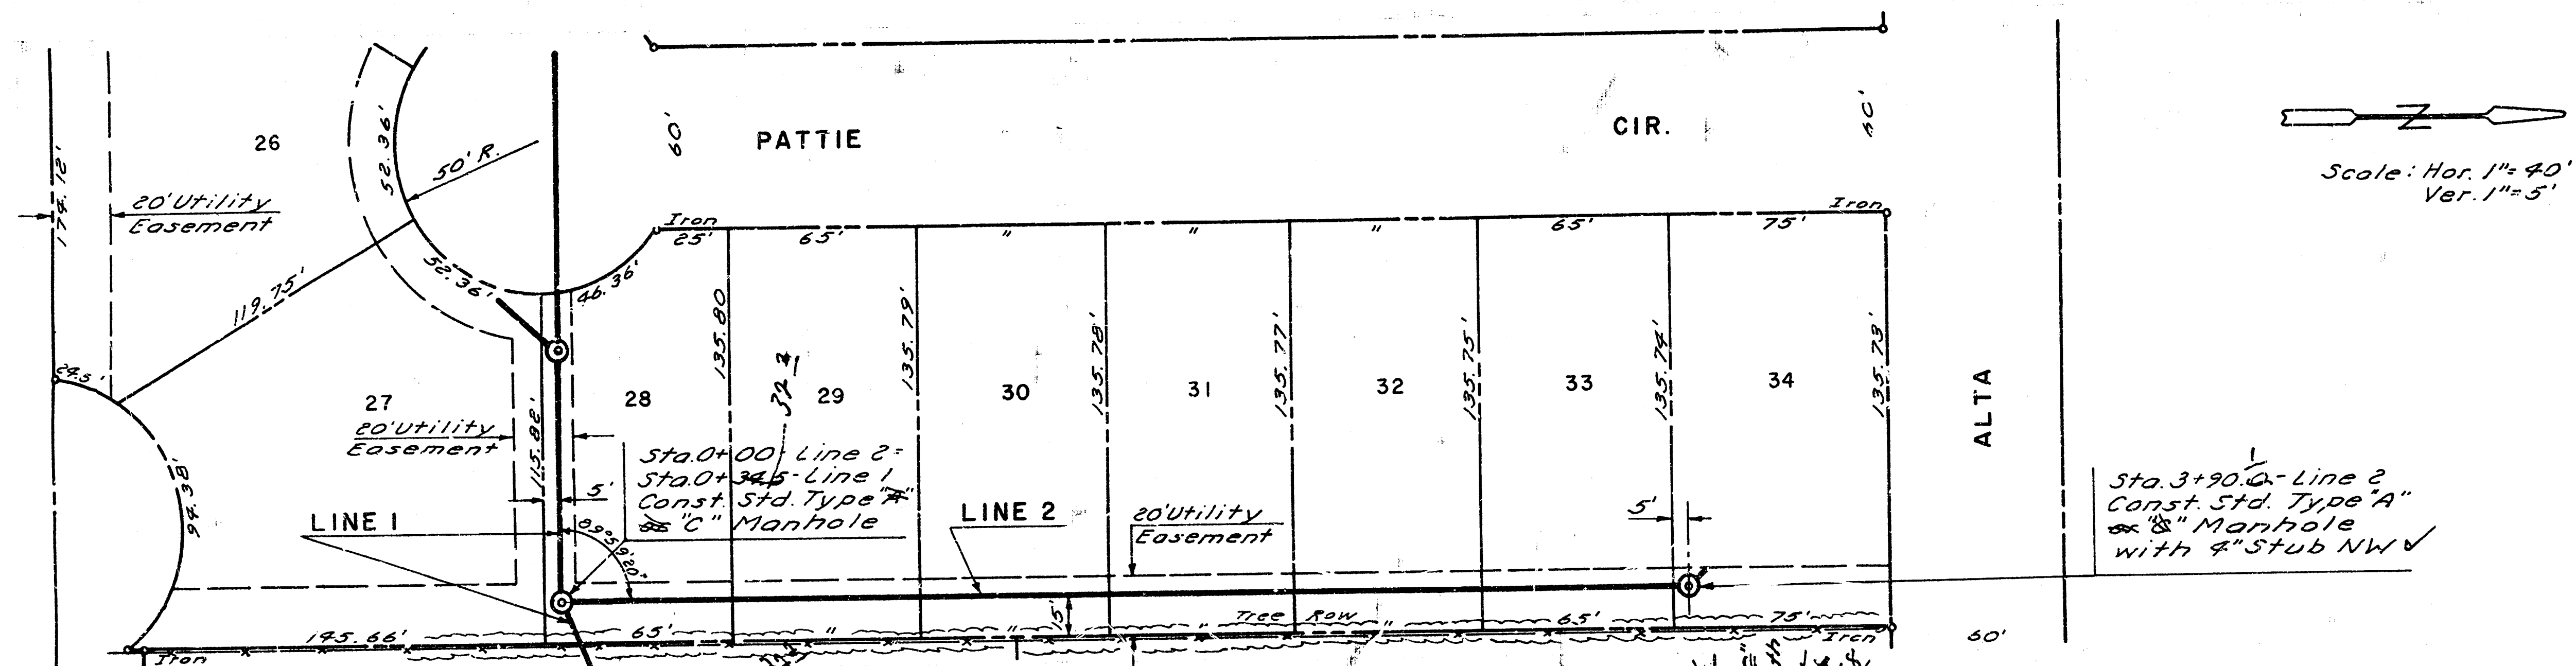

As Built
J.L.
6-84

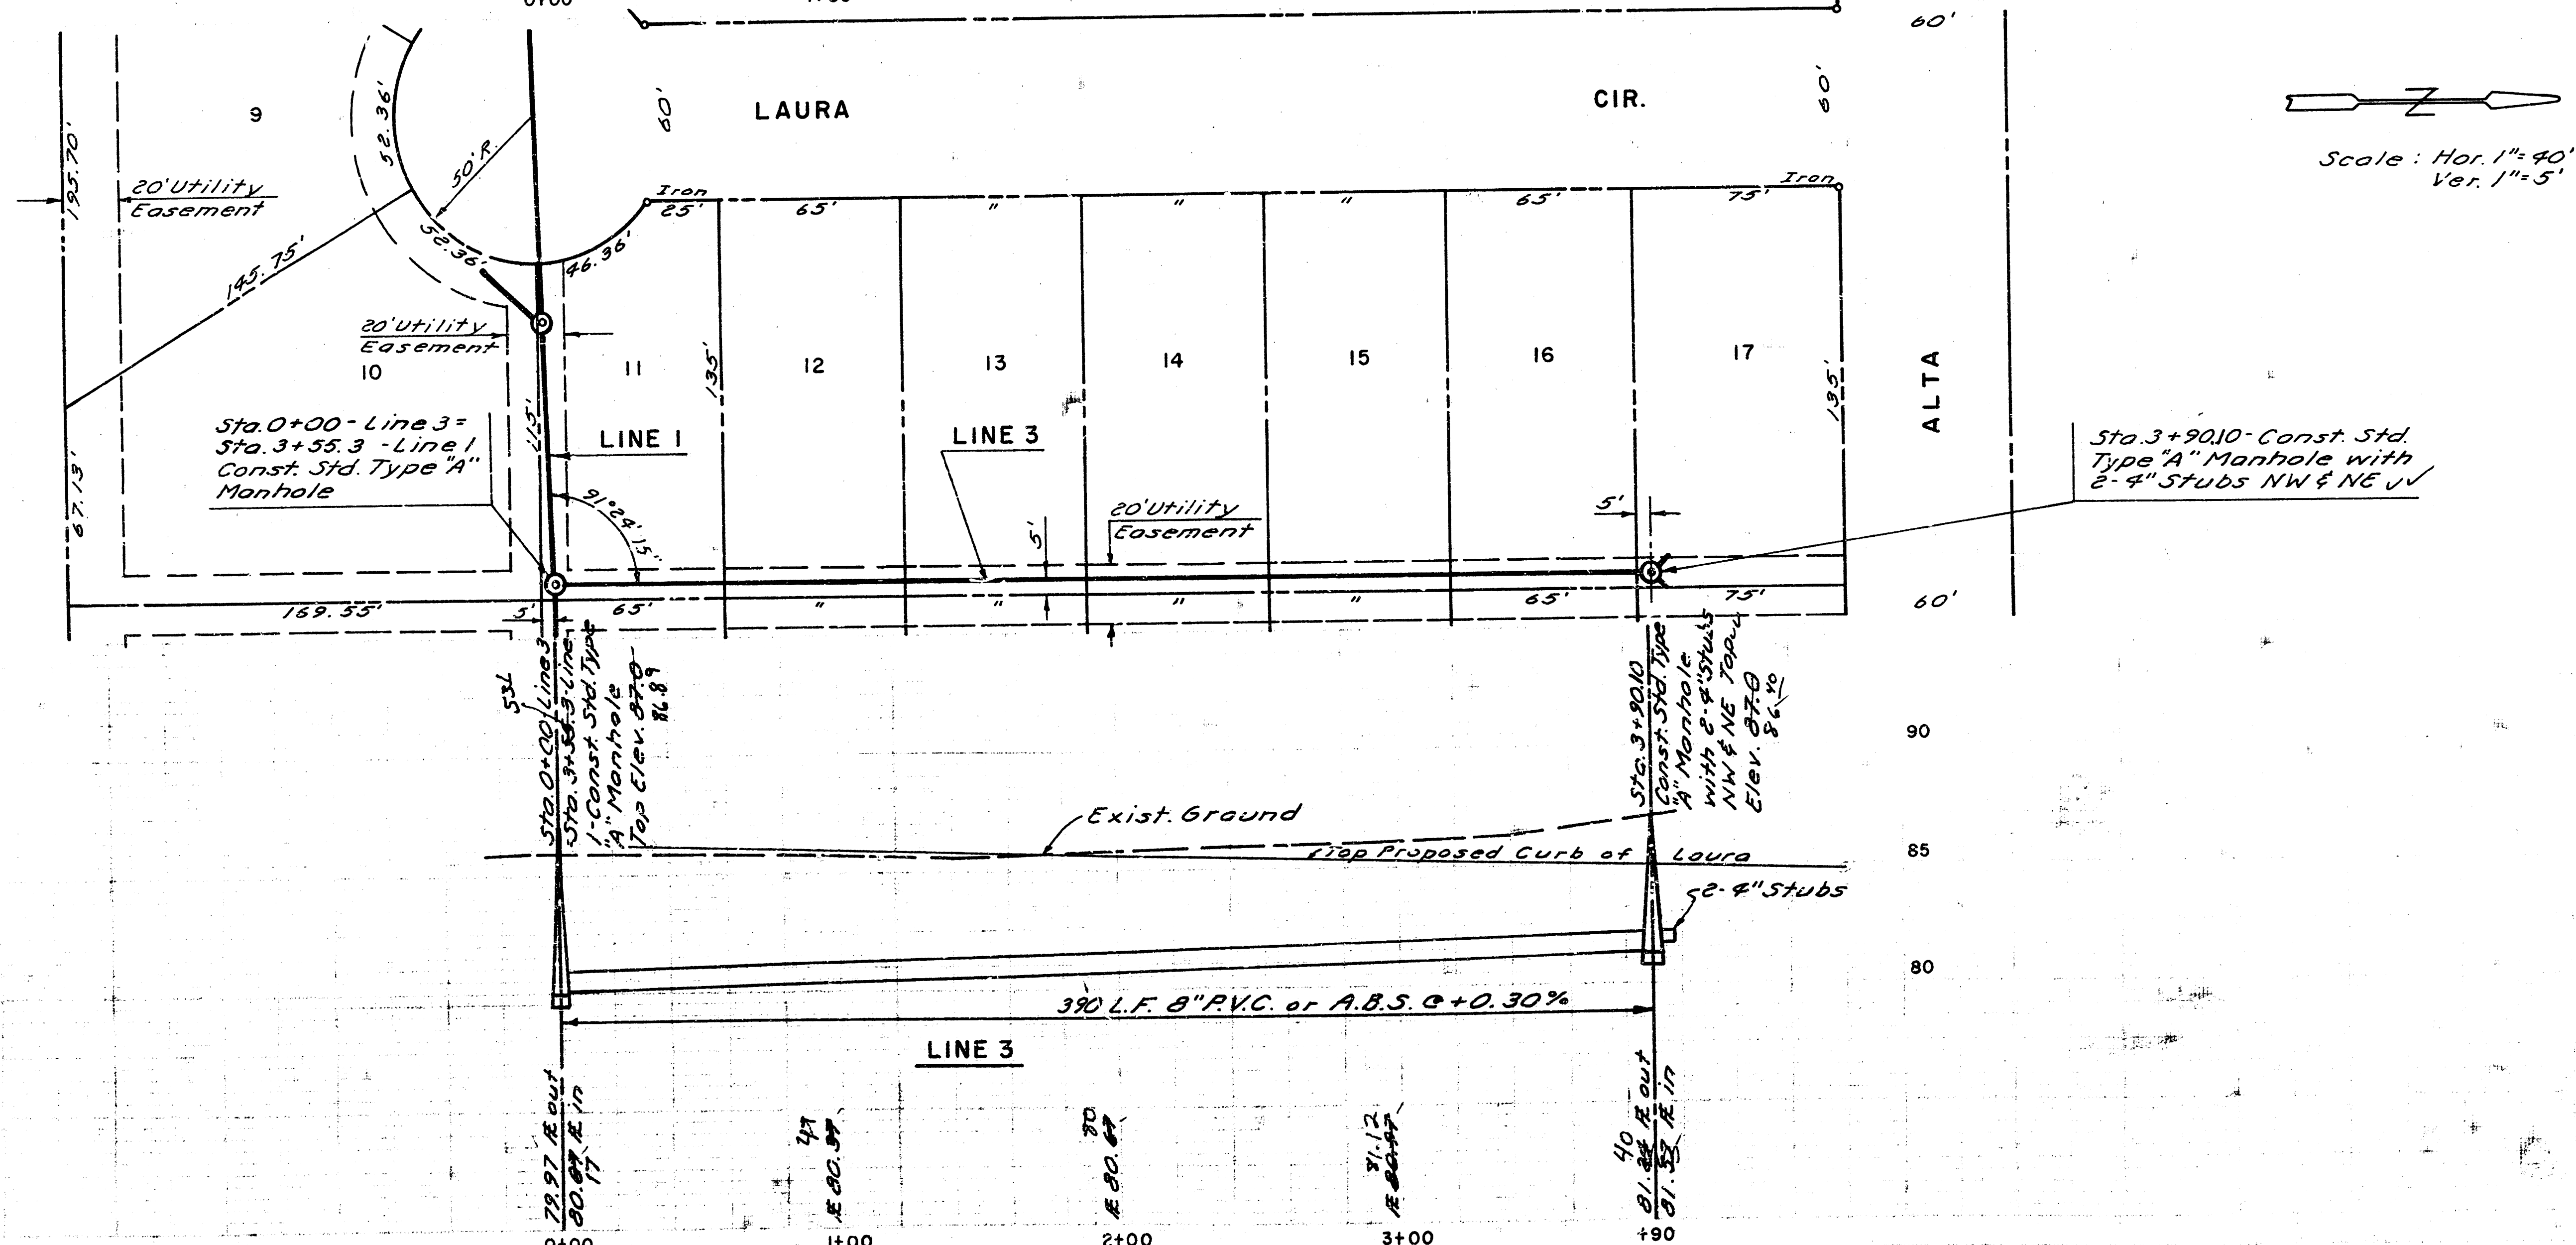

LATERAL 55, MAIN 1
SOUTHWEST INTERCEPTOR SEWER

SANITARY SEWER TO SERVE
GALYARDT'S 6TH ADDITION

PROJ. NO. 468-76-245- 80795-000-000-001

CITY OF WICHITA, KANSAS
MIKE LINDEBAK CITY ENGINEER