



BM 8420 City Sta. 44'E and 52' N of # HYDRULIC and 47th St Sa
 BM 8254 RR Spk. E-face PP NW Cor. HYDRULIC and FERNWOOD (West)

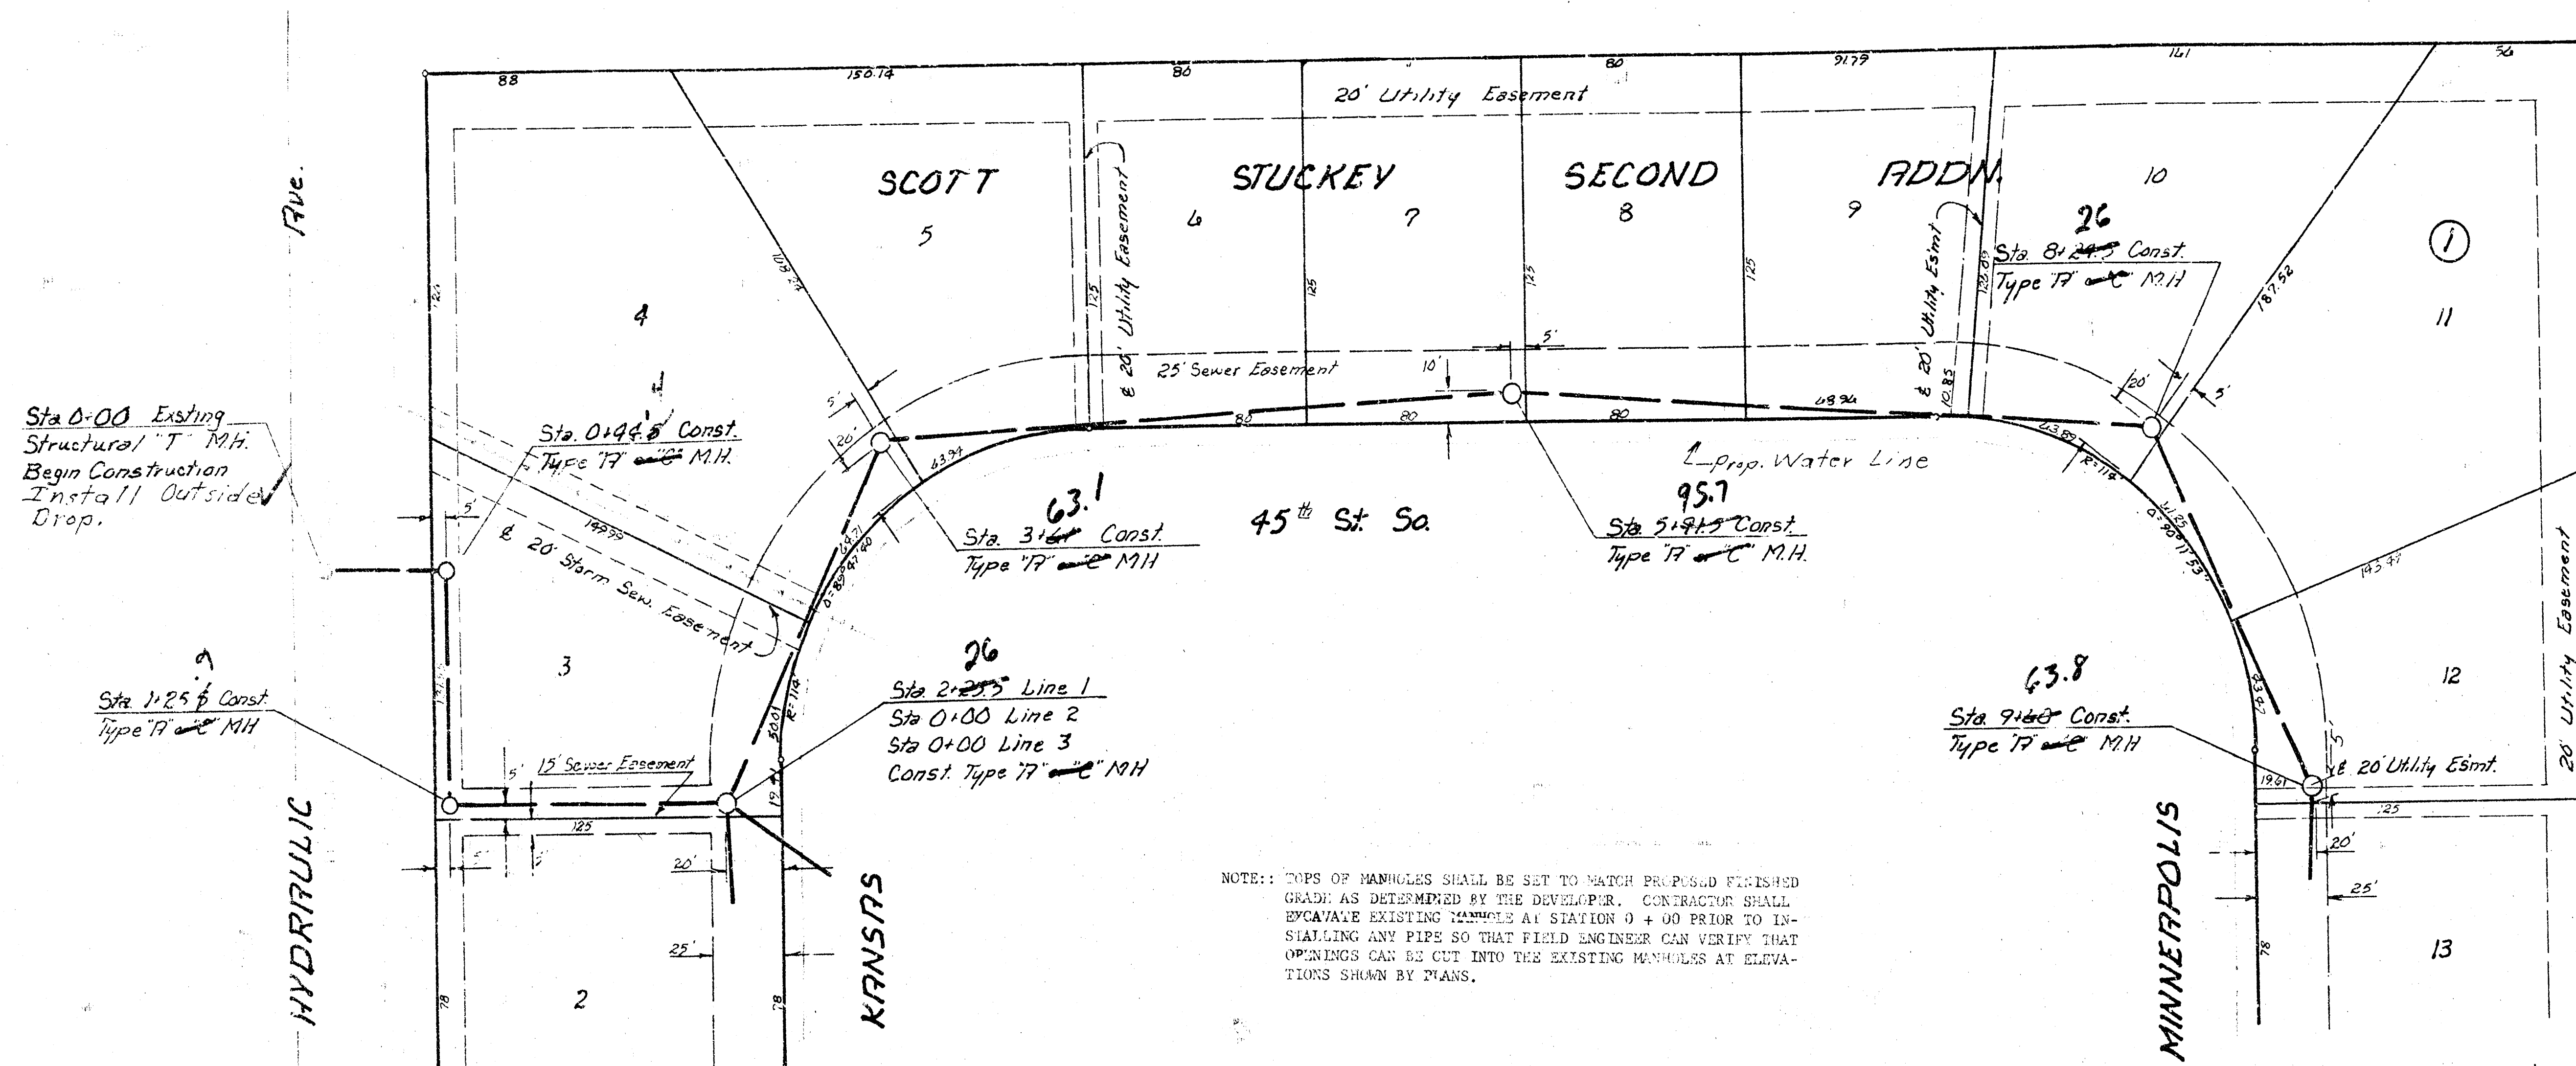

NOTE: TOPS OF MANHOLES SHALL BE SET TO MATCH PROPOSED FINISHED GRADE AS DETERMINED BY THE DEVELOPER. CONTRACTOR SHALL REEVALUATE EXISTING MANHOLES AT STATIONS 0 + 90 PRIOR TO INSTALLING ANY PIPE SO THAT FIELD ENGINEER CAN VERIFY THAT OPENINGS CAN BE CUT INTO THE EXISTING MANHOLES AT ELEVATIONS SHOWN BY PLANS.


SCALE
 PLAN 1" = 90'
 PROFILE 1" = 40'
 Horiz. 1" = 40'
 Vert. 1" = 5'

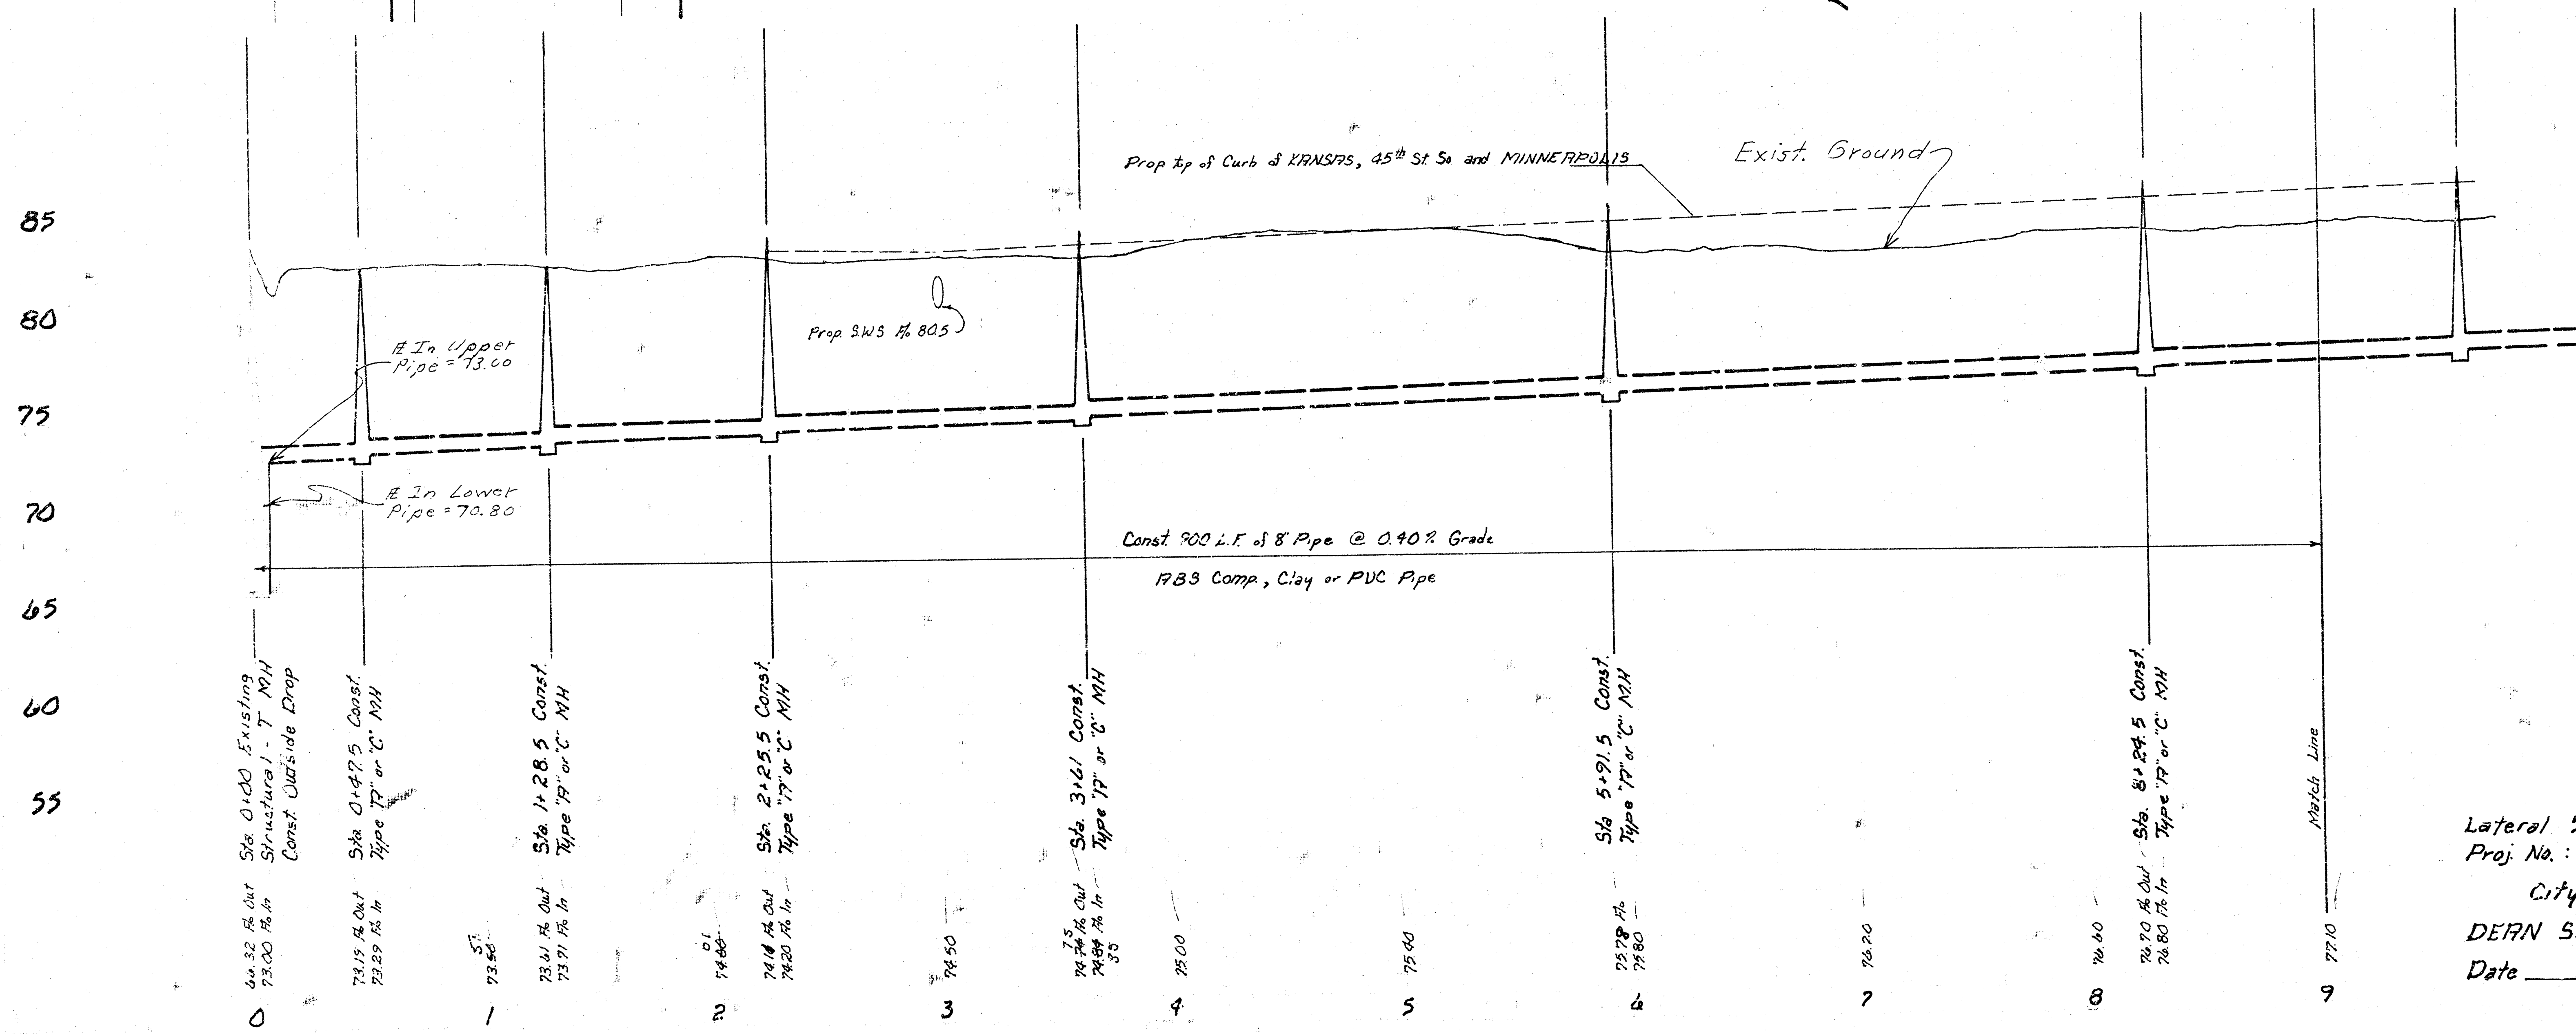

As Built
 11/8/1
 188



Lateral 57, Main 1, Southwest Interceptor Sewer
 Proj. No.: 448-76-245-80901-000-000-001
 City of WICHITA, KANSAS
 DERN SELLERS - Acting CITY ENGINEER
 Date _____


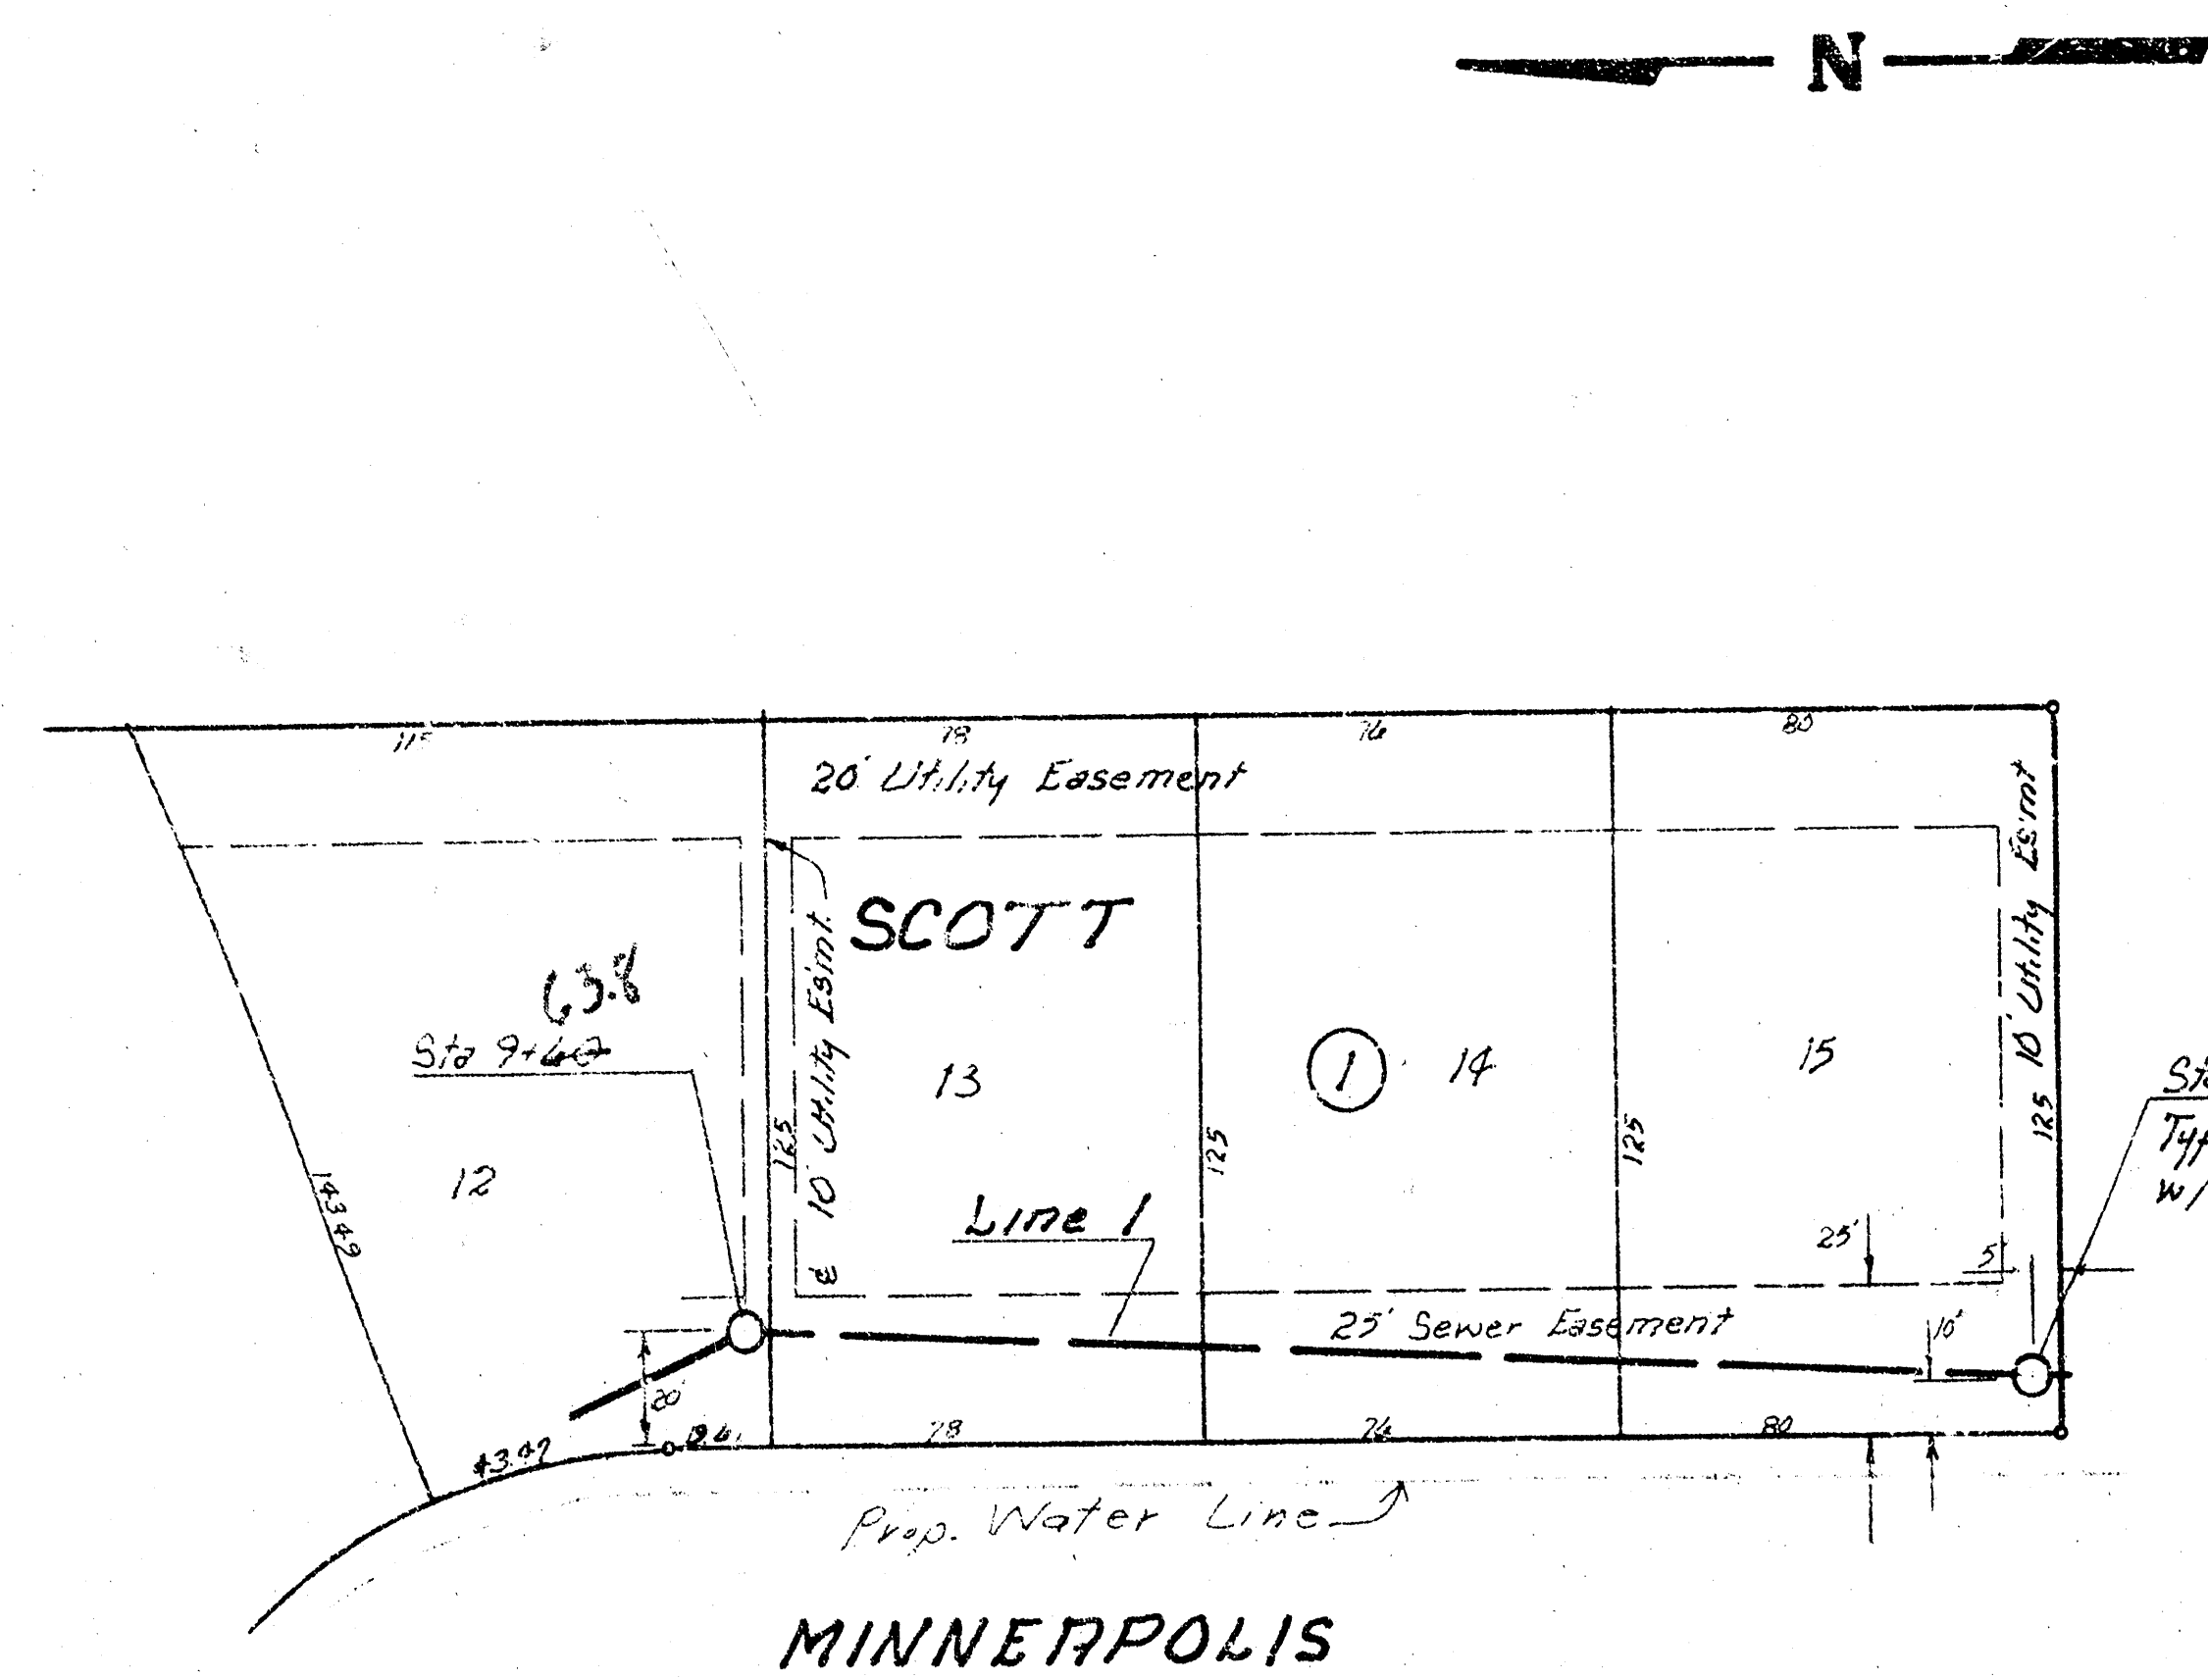


96.3

Sta 11+94.2 Const.

Type 17" or 18" M.H.

W/8" Stubs S

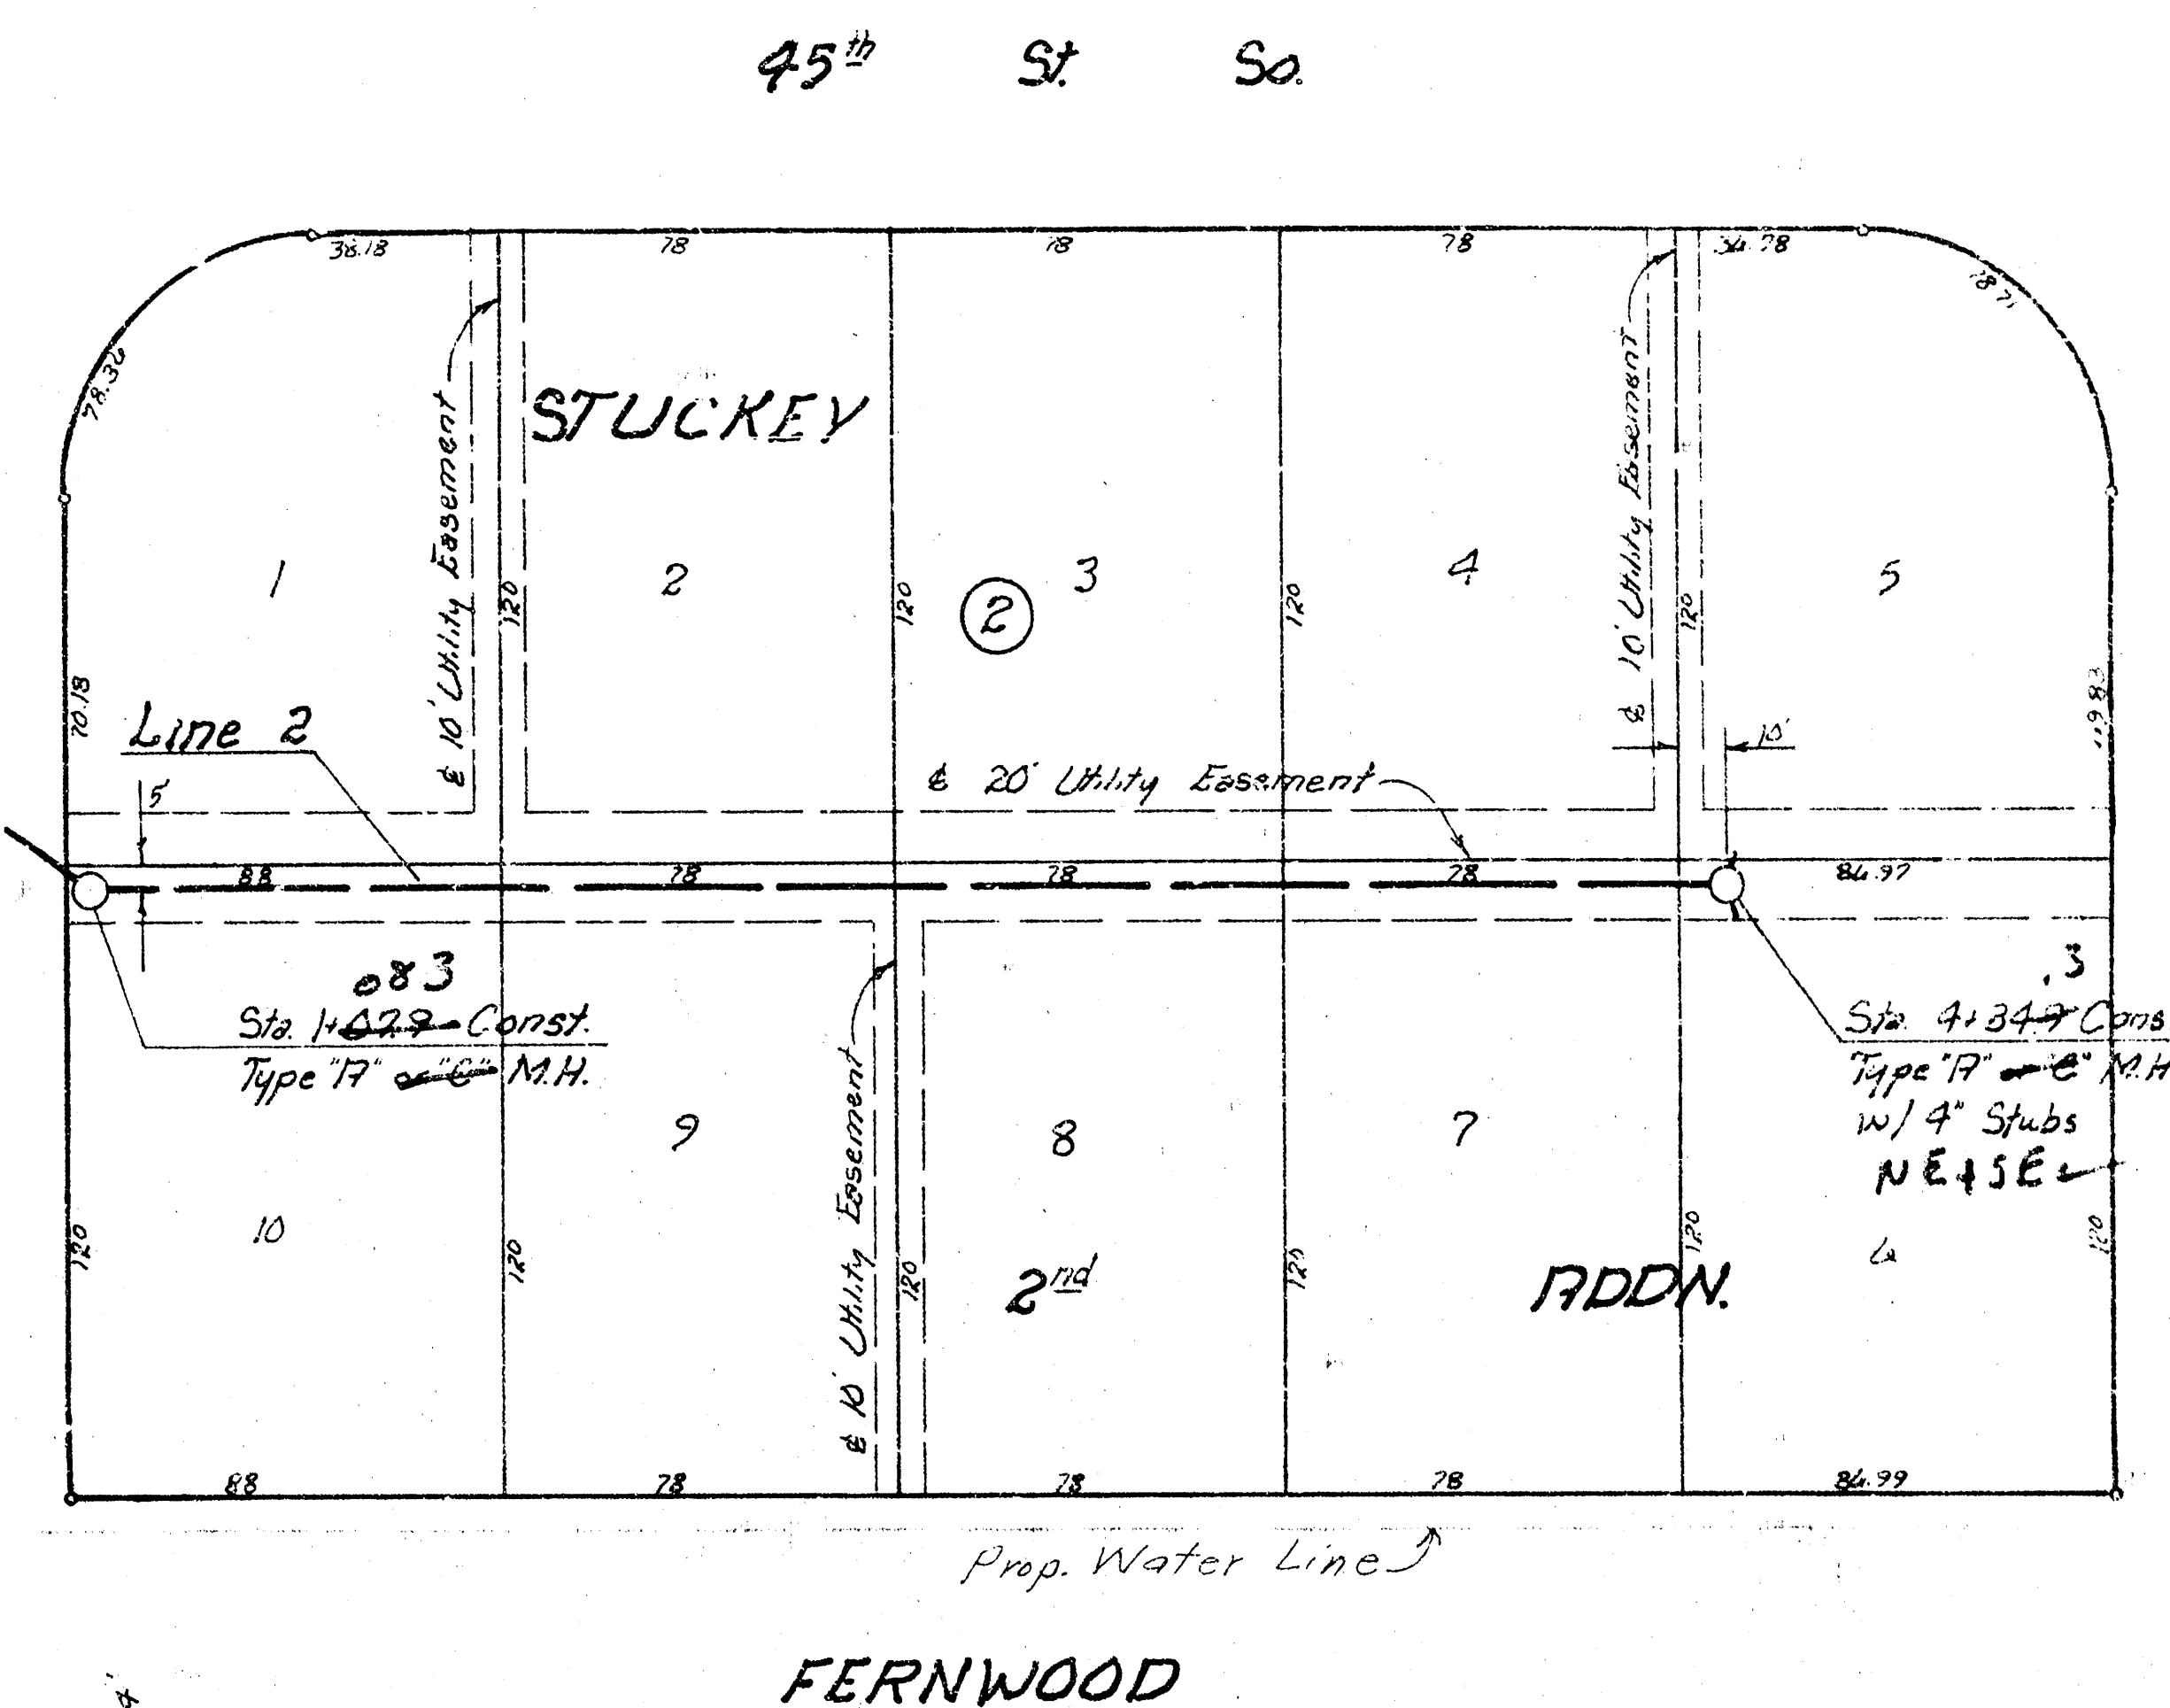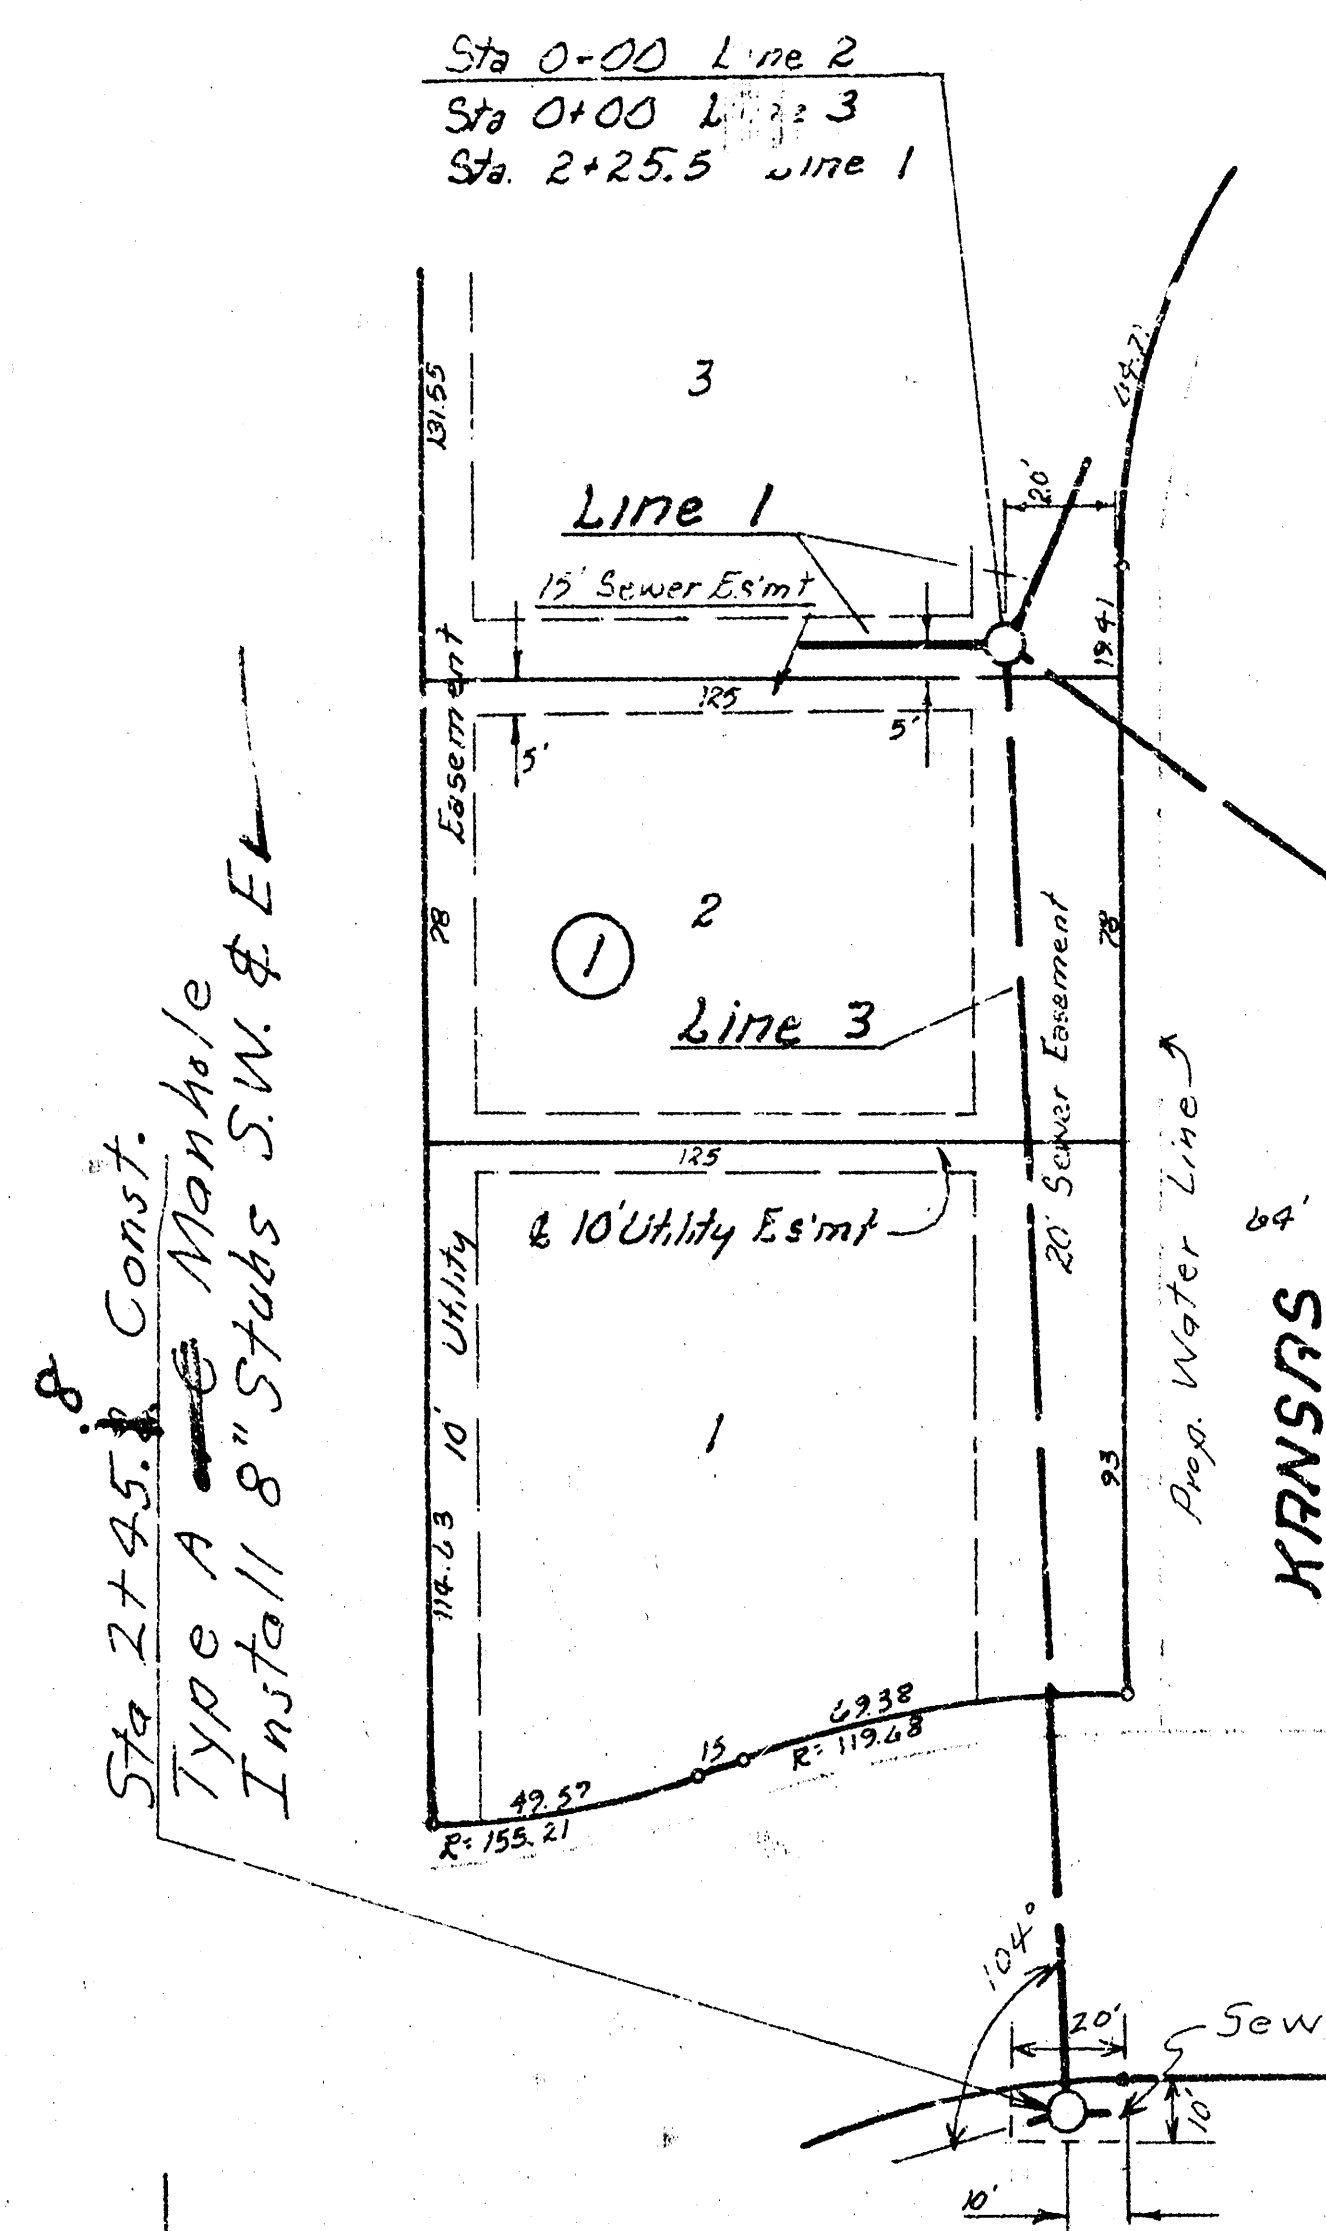

MINNERPOLIS




SCALE

Plan 1" = 40'

Profile 1" = 40'

Horz. 1" = 40'

Vert. 1" = 5'

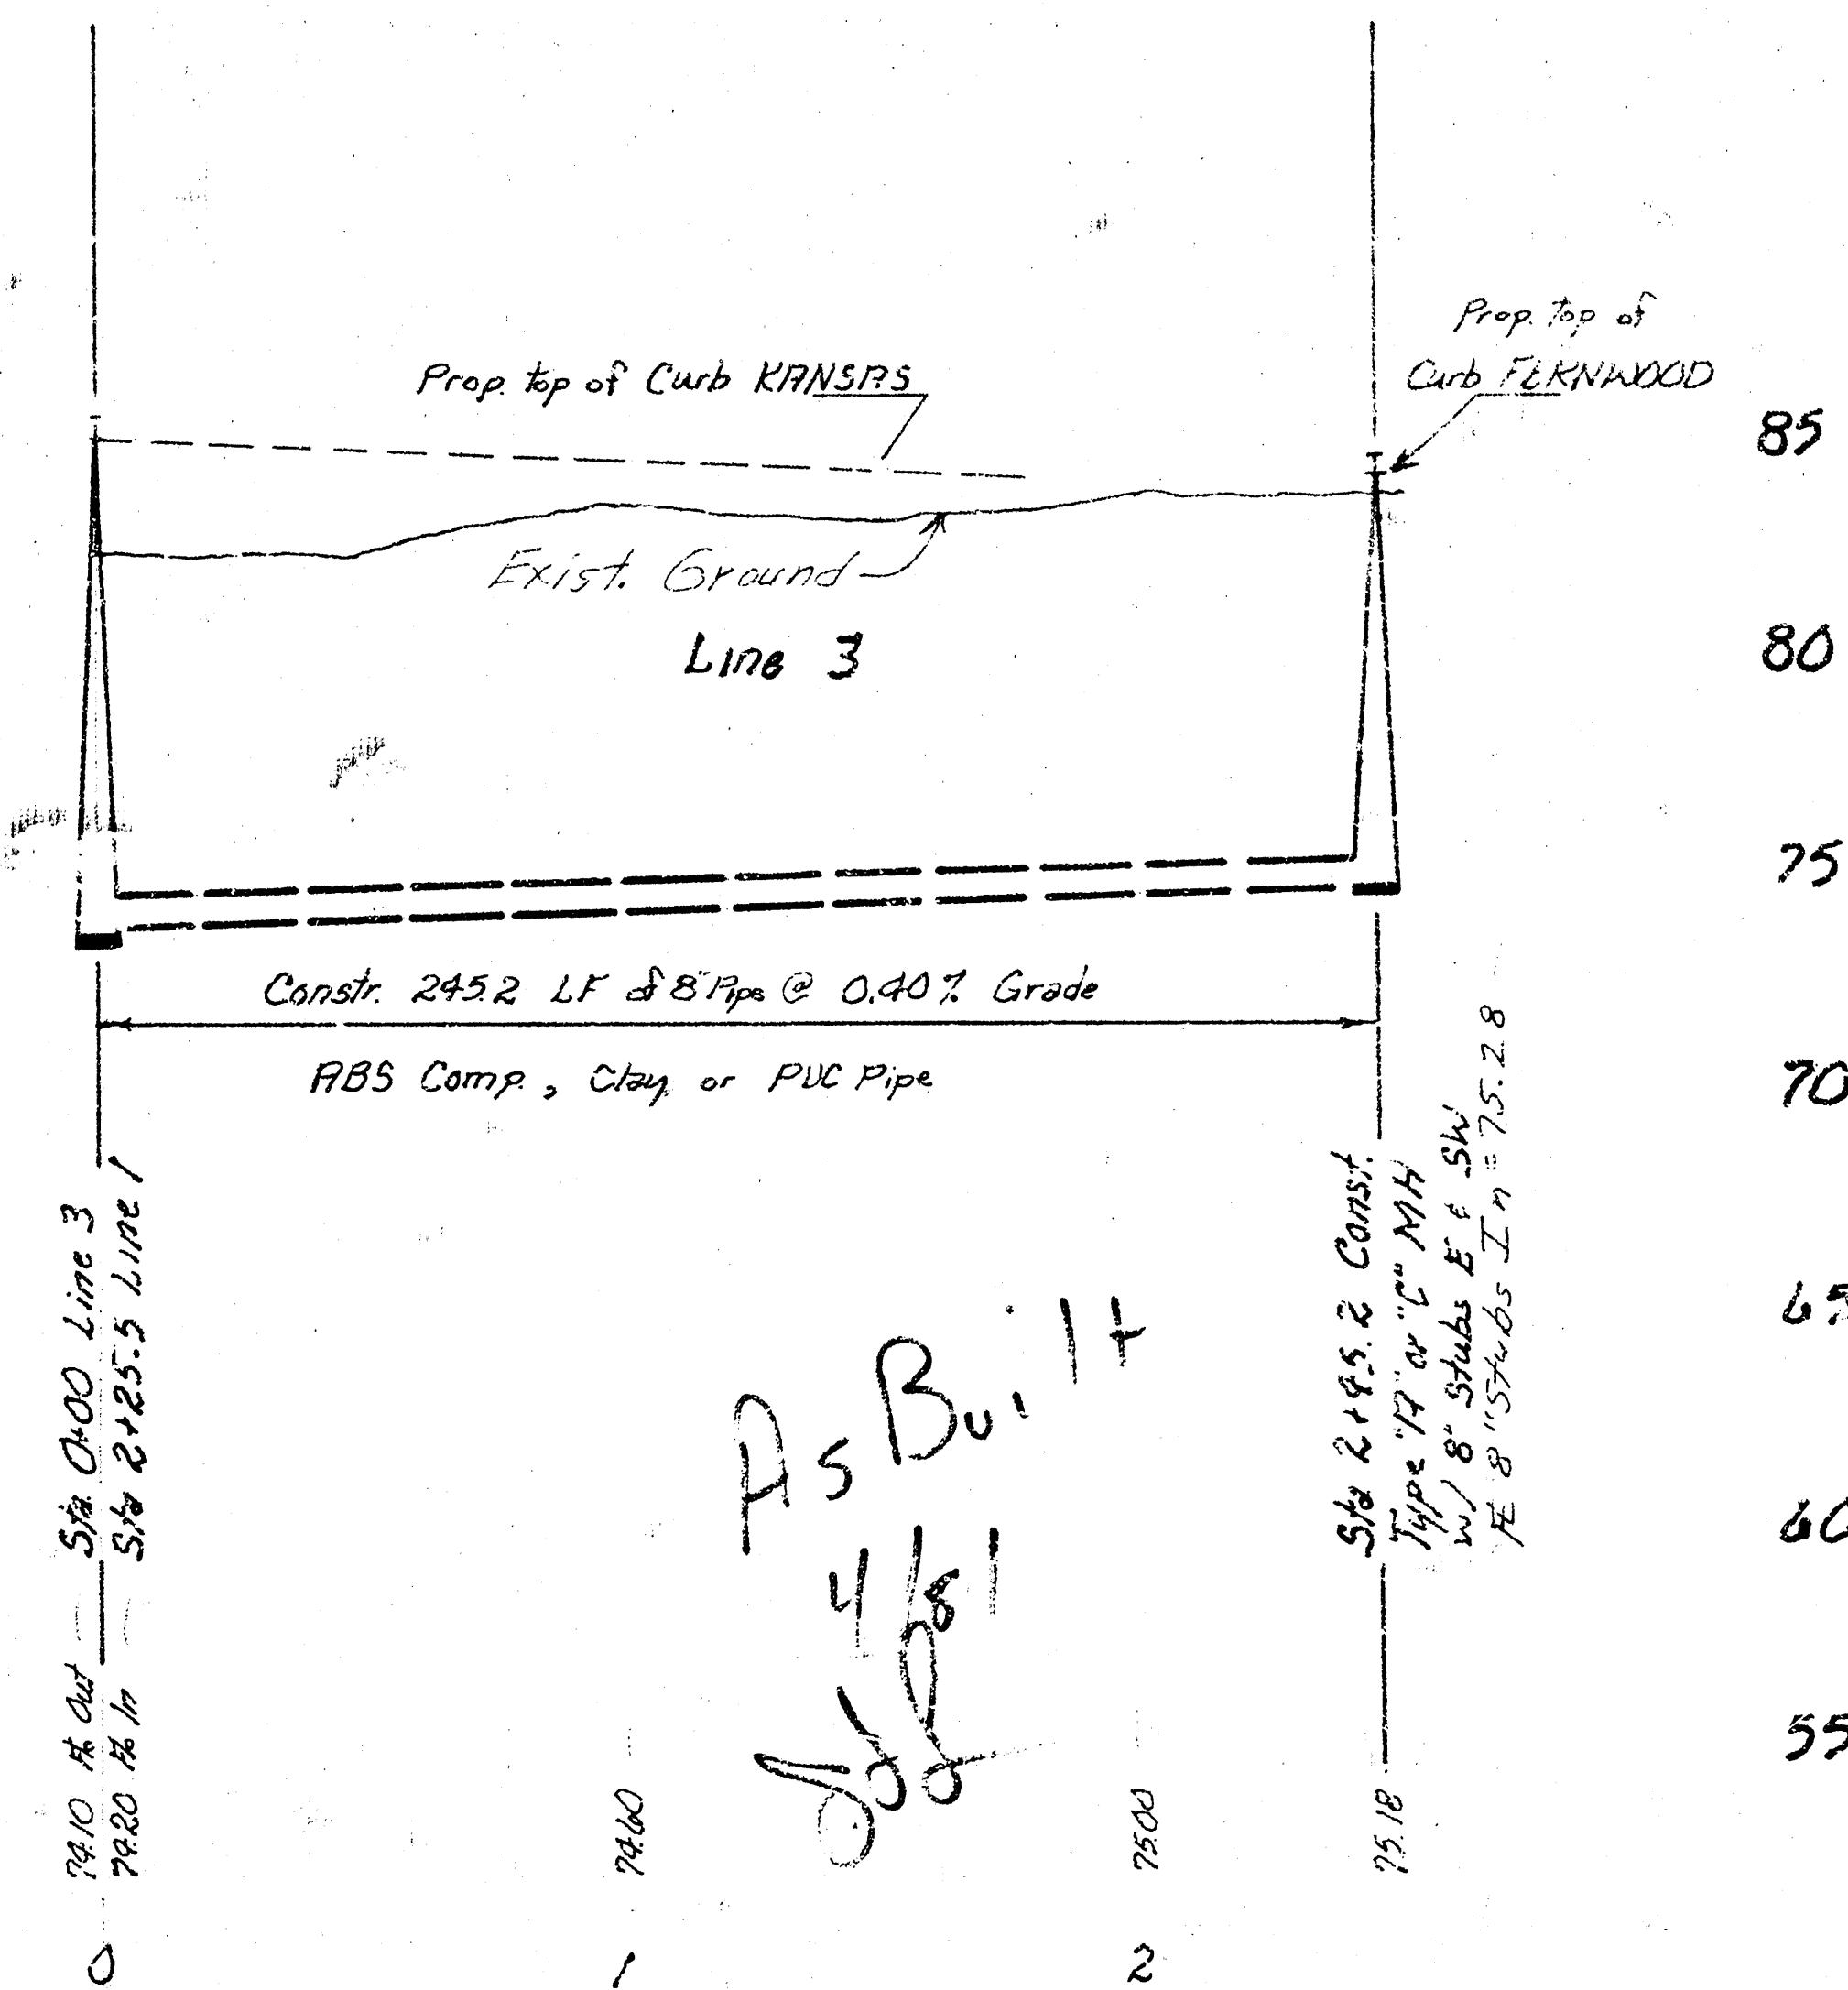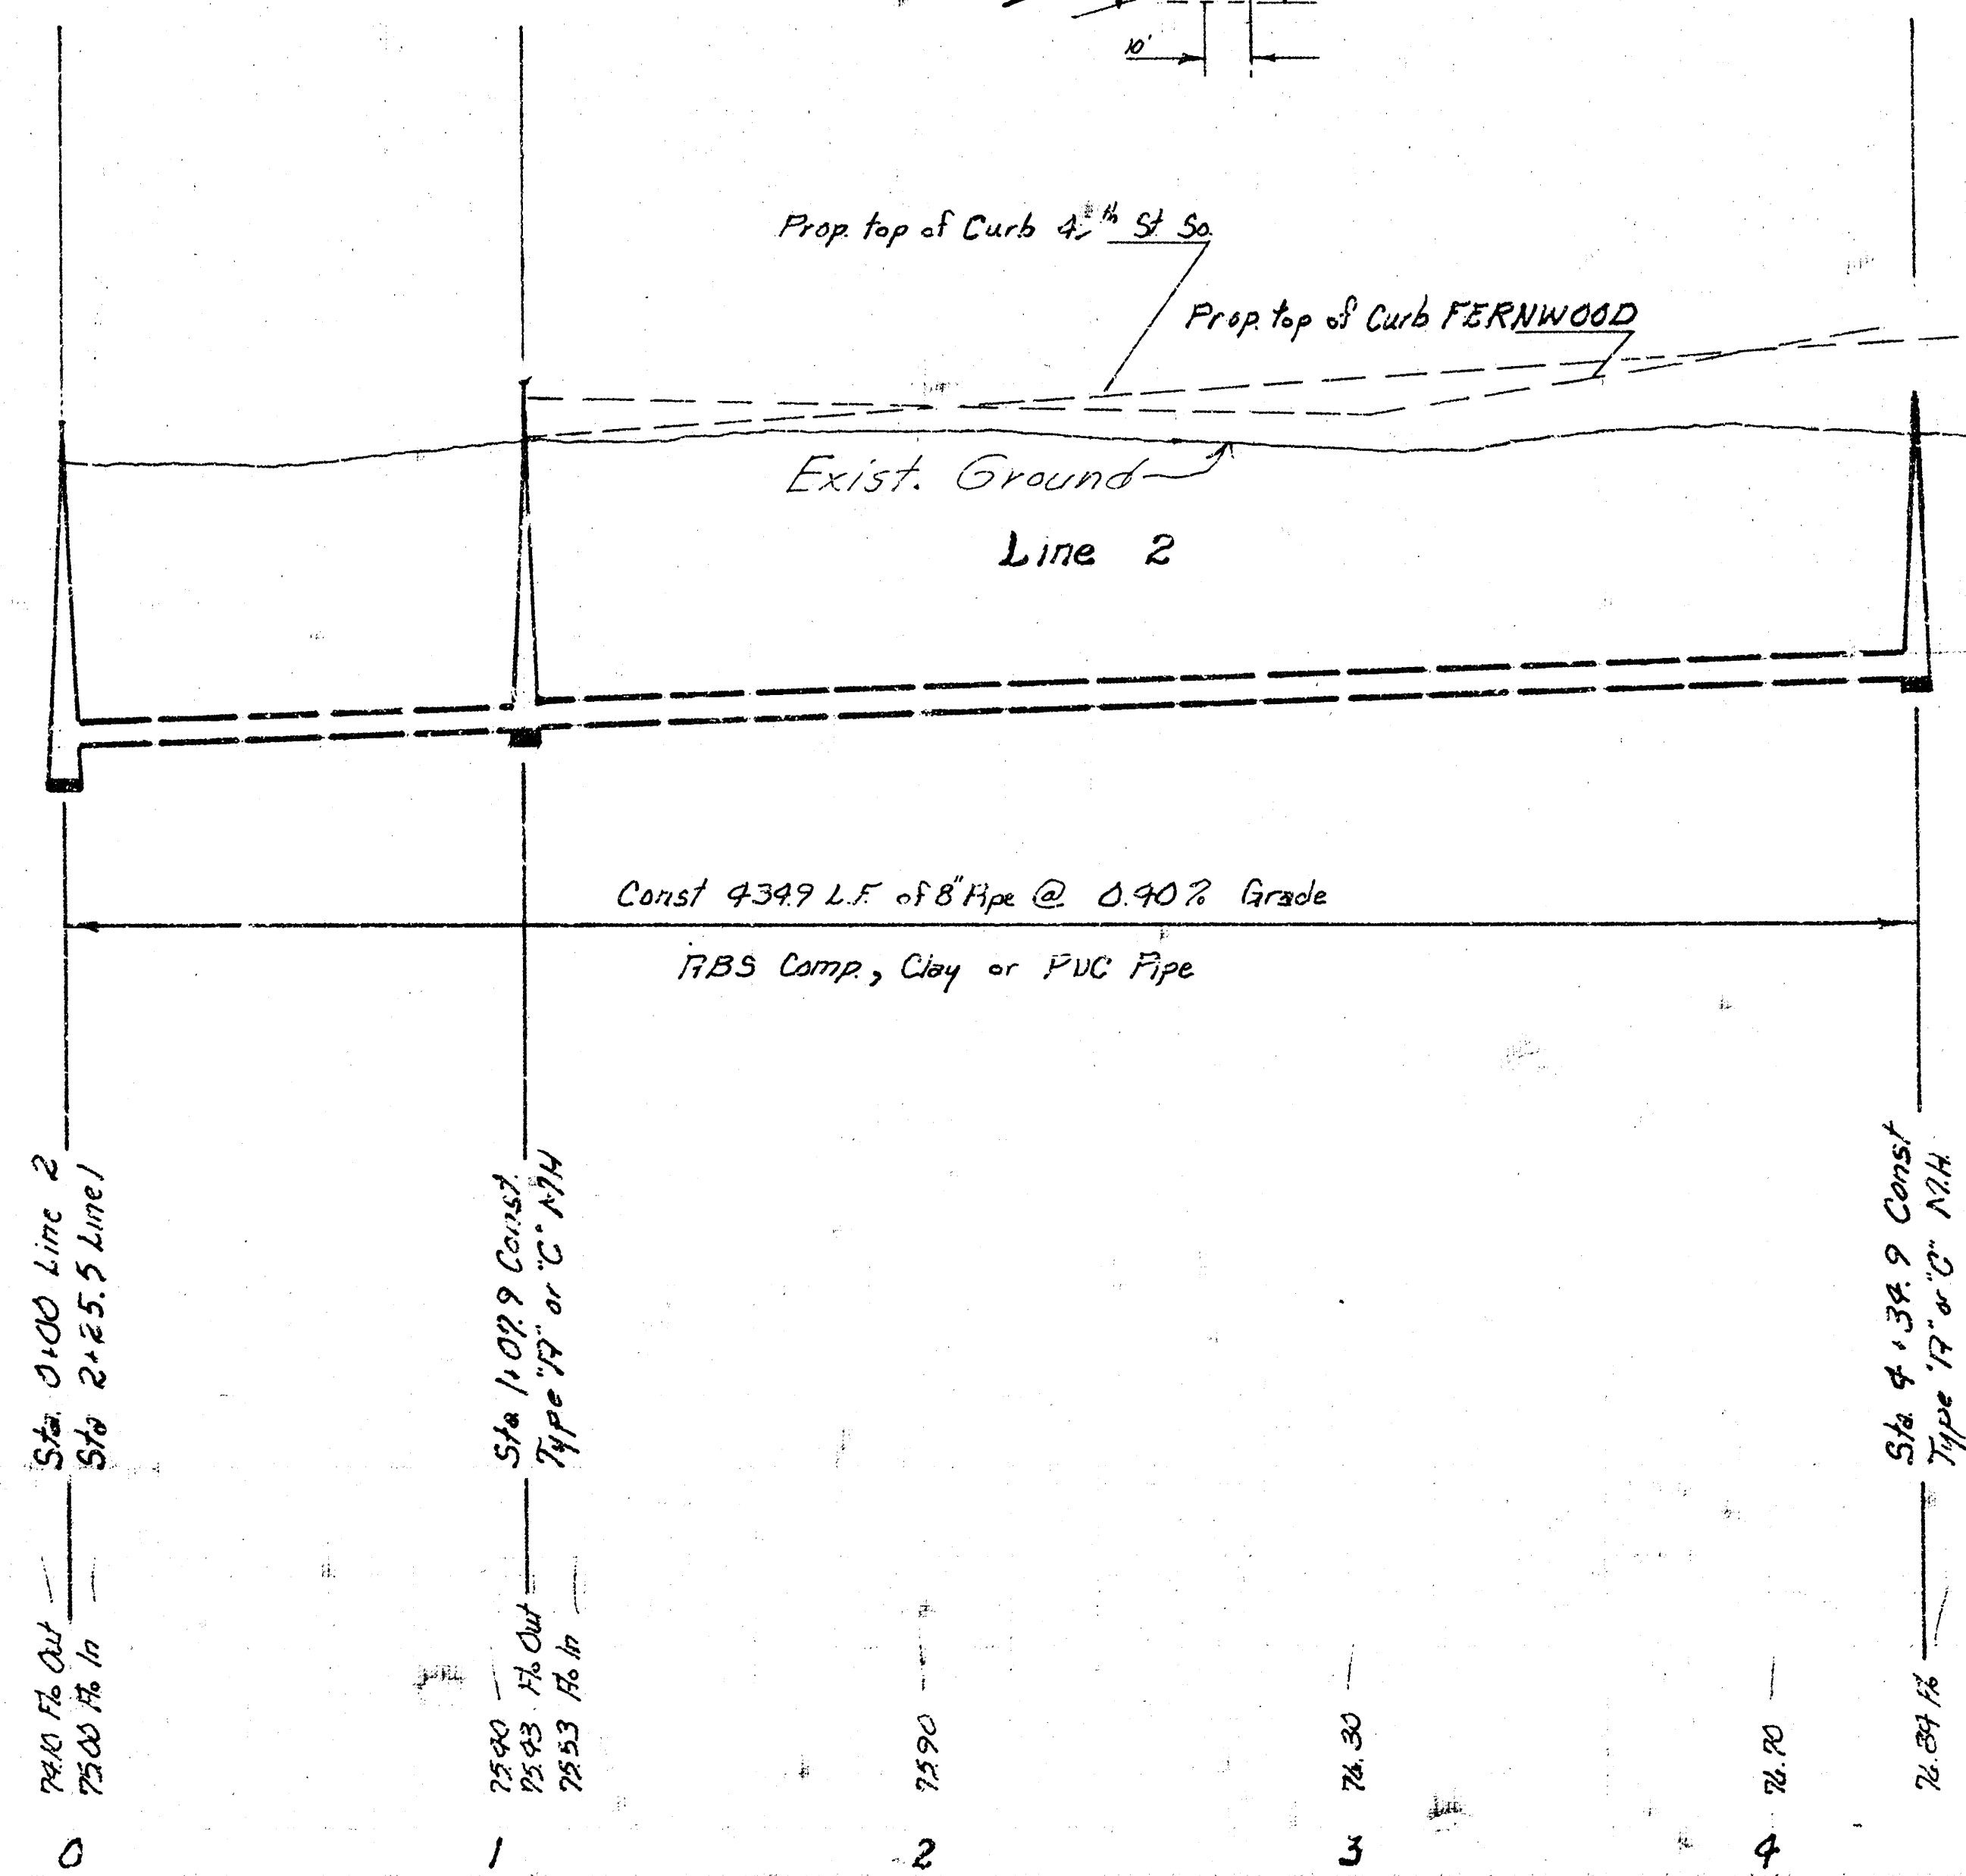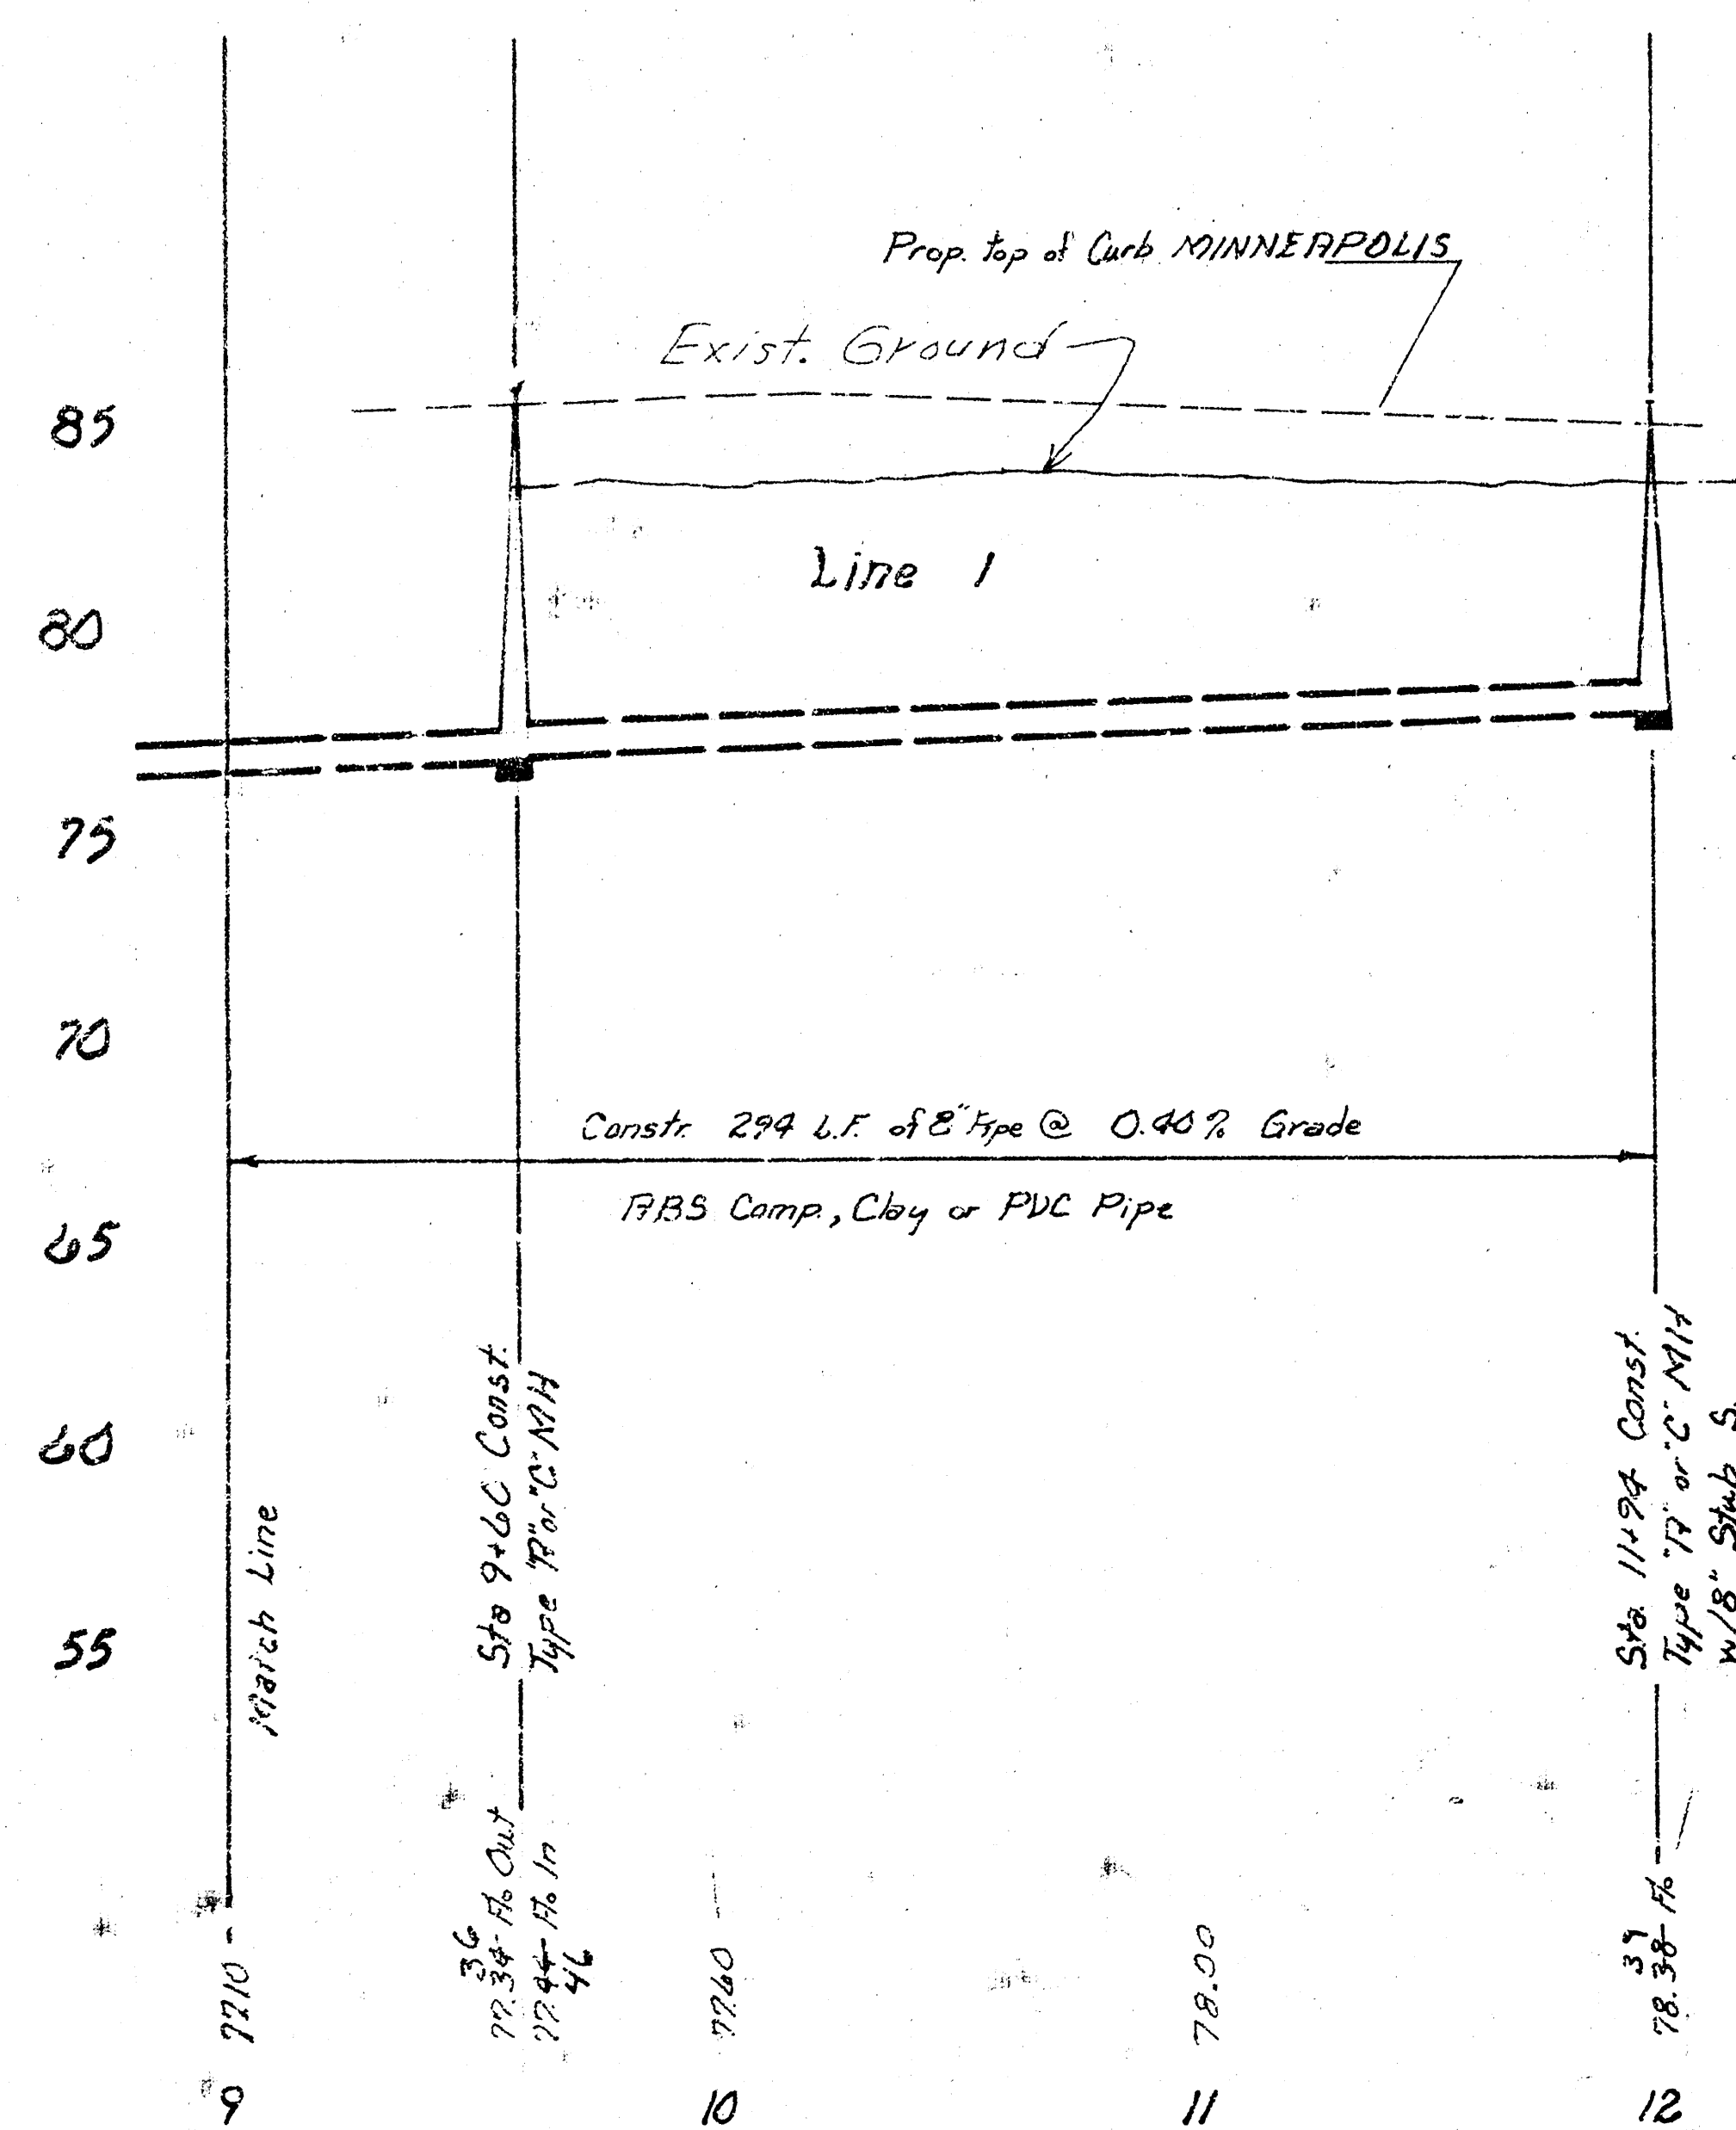

As Built

4/16/1

John

Lateral 57, Main 1, Southwest Interceptor Sewer

Proj. No: 448-74-245-80901 000-000-001

