

LATERAL 61, MAIN 1 SOUTHWEST INTERCEPTOR

468-76-245-81099-000-000-001

CITY OF WICHITA, KS.

R.W. BRUGGEMAN — DIR. ENGINEERING

SCALE: 1" = 200'



LOCATION MAP

INDEX TO DRAWINGS


LINE	SH NO.
LINE 1	2-4
LINE 2	6
LINE 3	5
LINE 4	3
LINE 5	5

Note -
Trees to be Removed are marked with a tree symbol, any tree which in the opinion of the Engineer can be spared, shall be saved.
Clearing Right-of-Way shall be a lump sum bid and will include tree removal and fence removed & replaced.
Contractor to verify utility crossings located thruout the project.
Fences are to be replaced in the same condition as they were prior to construction.
Contractor to use caution when crossing the City Service Pipeline at the two locations. Clearance is minimal on Line 3.

NOTE: REINFORCED CONCRETE ENCASUREMENT WHICH DOES NOT EXTEND TO MANHOLES SHALL BEGIN OR END AT JOINTS IN THE CLAY PIPE IN SUCH A MANNER WHICH WILL MAINTAIN THE FLEXIBILITY OF THE PIPE JOINT.

NOTE:

THE CONTRACTOR SHALL BE RESPONSIBLE FOR PRESERVING PROPERTY IRONS. THE CONTRACTOR SHALL BE REQUIRED TO RE-ESTABLISH ANY PROPERTY IRONS WHICH ARE DAMAGED OR DESTROYED BY HIS CONSTRUCTION OPERATIONS. SUCH IRONS SHALL BE RE-ESTABLISHED BY A LICENSED LAND SURVEYOR OR A LICENSED PROFESSIONAL ENGINEER IN ACCORDANCE WITH STATE LAWS.

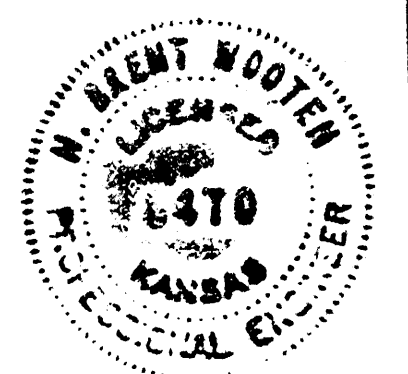

DATE

BAUGHMAN COMPANY, P.A.
SURVEYING & ENGINEERING
316/262-7271 • 320 LAURA • WICHITA, KANSAS 67211

*As Built
JJB
12/81*

LOT 1, OVERHOLT ADDITION

UNPLATTED

Scale: Horiz: 1"=40'
Vert: 1"=5'

AVE.

Remove 31 L.F. Ex. 18" C.M.P.
Replace 31 L.F. 18" C.M.P.
(Fully Coated).

Sta. 0+00 Const. Std. Type 'A' Manhole
on Ex. 8" San. Sewer. Remove
8" Pipe as Required to Make
New Connection

Note: Contractor to Regrade Parking Lot & Dr.
Entrance from Hydraulic and to install both with a good
cover of Road Gravel. Engineer to insure that this
area is adequately reworked.

60' Cities Service
Pipeline Esmt.

Remove & Replace
20 L.F. 4' Chain Link
Fence

Remove & Replace
20 L.F. 2 Str. Barbed
Wire Fence

60' Cities Service
Pipeline Esmt.

Remove & Replace
20 L.F. 4' Chain Lk. Fc. w. Wood Inserts
Replace Road Gravel Inside Fence.

FAIRHAVEN AVE.

12" Gas Line
8" Water Line Iron

Sta. 0+00.54-Exist.
Manhole

B.M. "a" Cut SE Cor. Conc.
Porch Harmony
Southern Baptist
Church - El. 88.65

20' Utility
Easement

Exist. 8"
V.C.P.

UNPLATTED

UNPLATTED

Sta. 3+80.0 Const.
Std. Type 'A' Manhole

Remove & Replace
20 L.F. 7' Chain Link
Fence

20' Temporary
Easement

LINE 1

Sta. 7+22.60 Const.
Std. Type 'A' Manhole

Remove & Replace
20 L.F. 2 Str. Barbed
Wire Fence

UNPLATTED

B.M. Top F.H. 48' RT. Sta.
7+07 - El. 85.01


LINE 1


LINE 2
See Sh. 6



20' Utility
Easement

LOT 1, 47TH STREET
SOUTH S.O.C. ADDITION



Sta. 10+00 Line 1
Sta. 0+00 Line 2
Const. Std. Type 'A'
Manhole

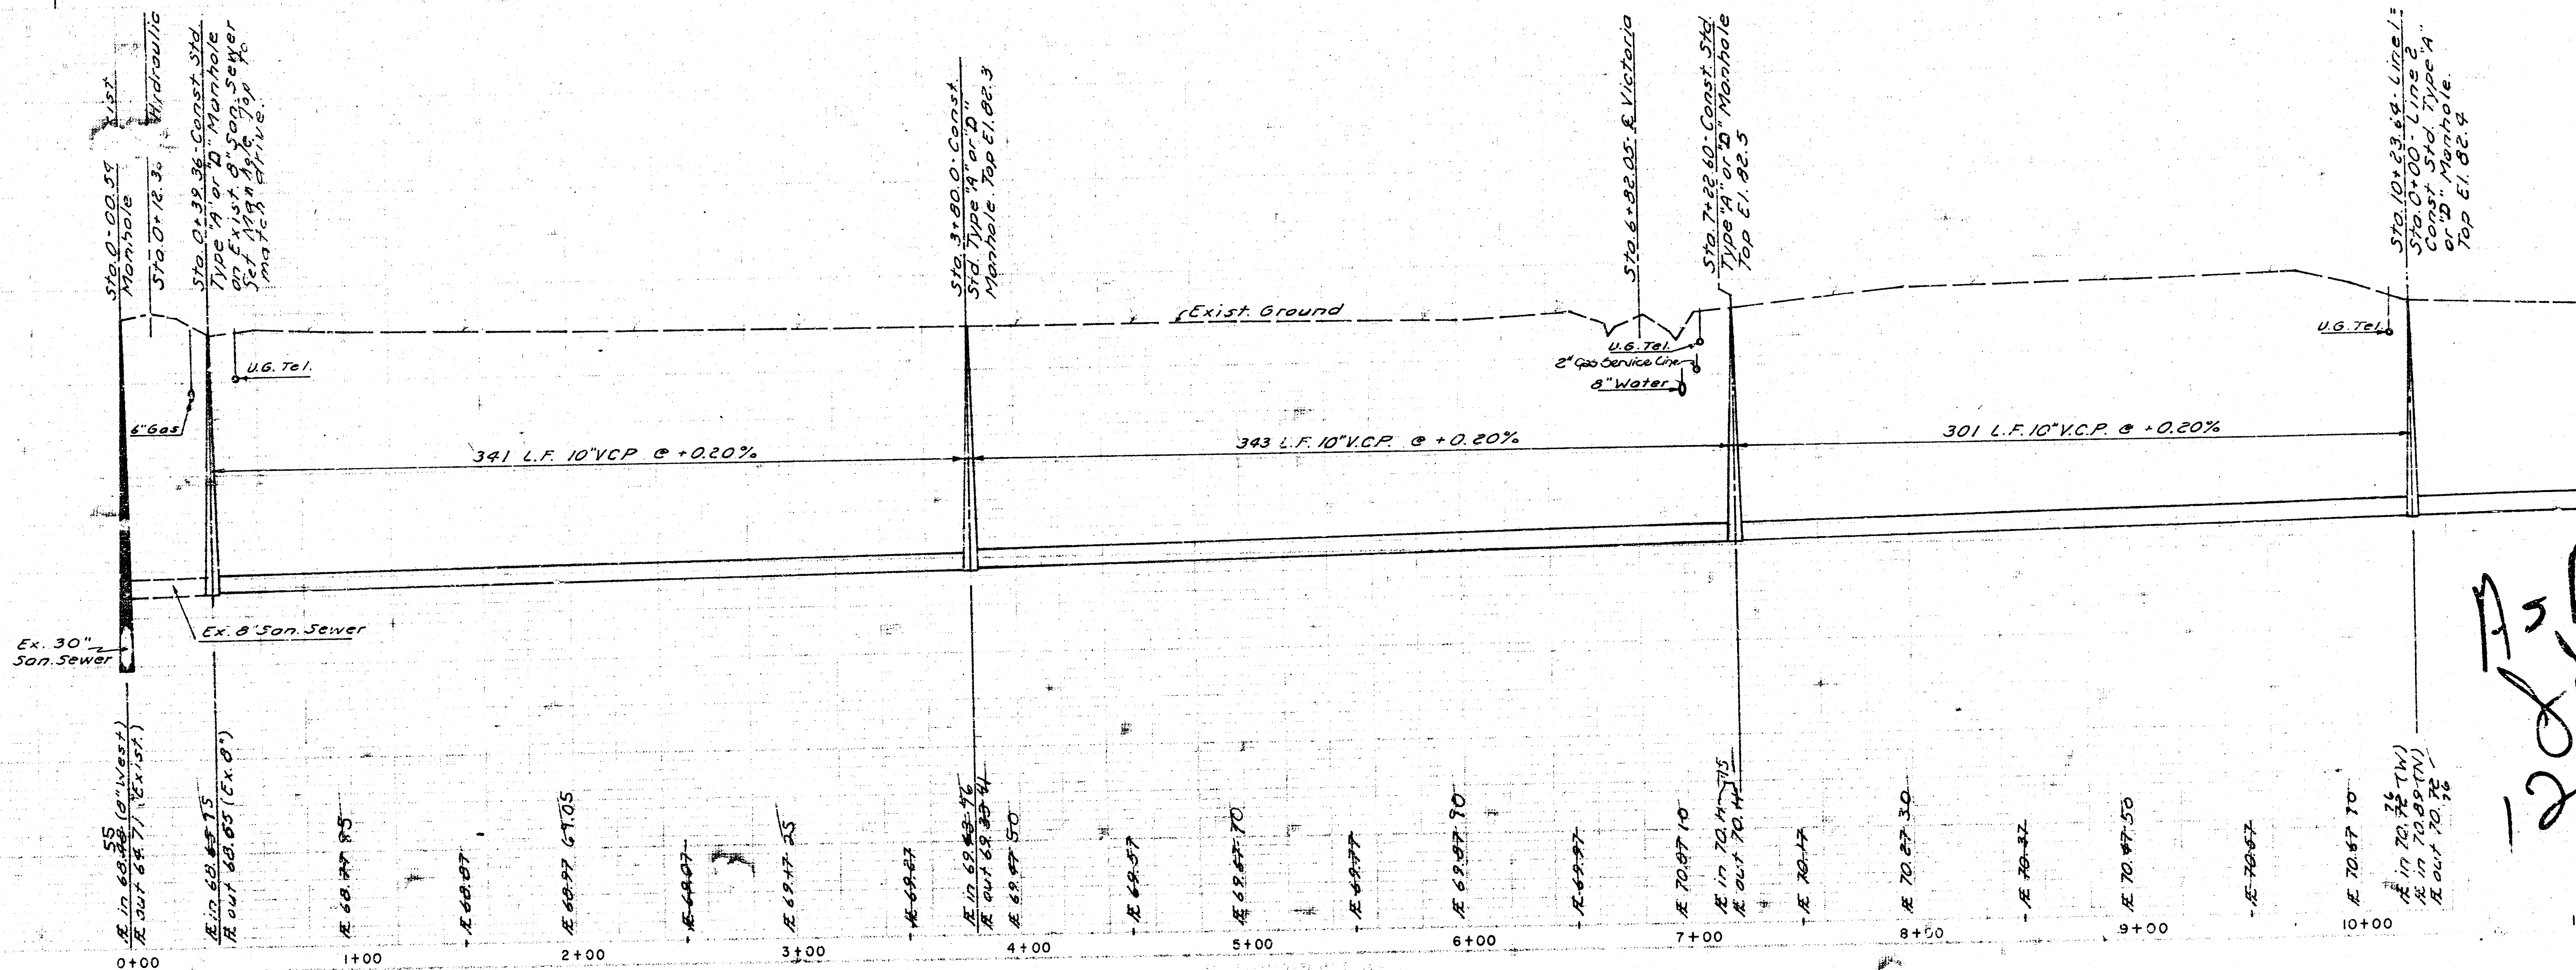


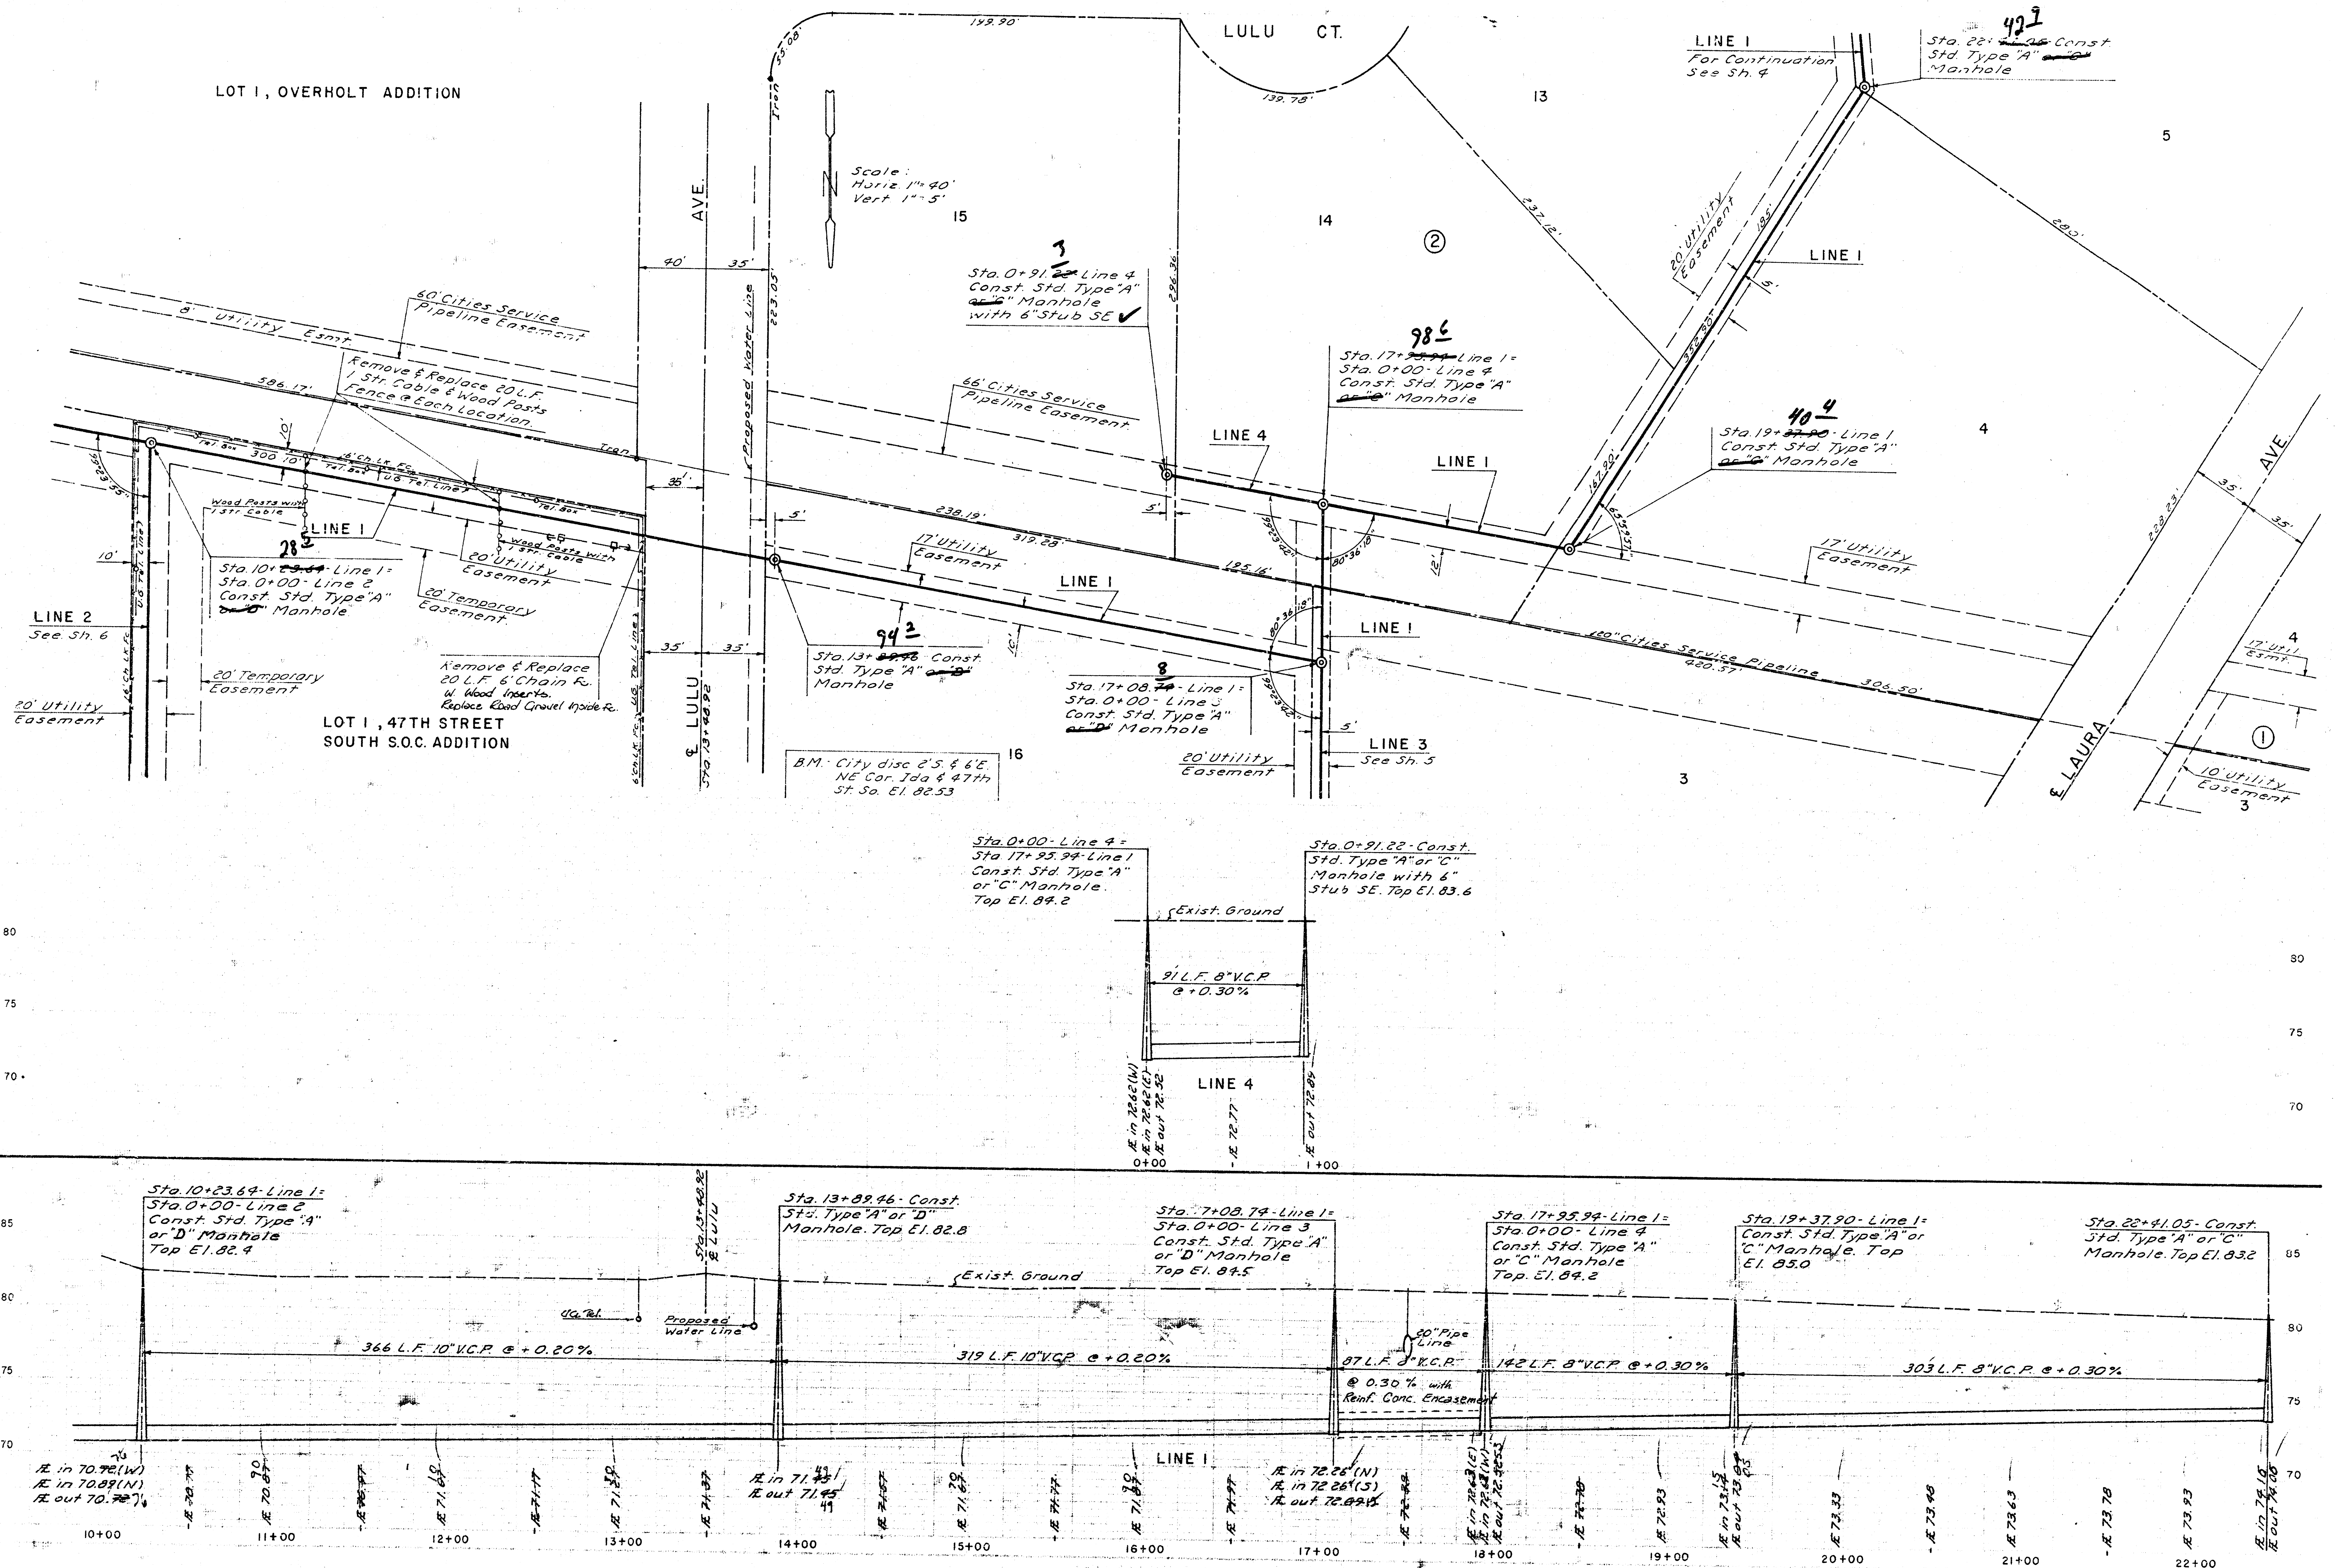

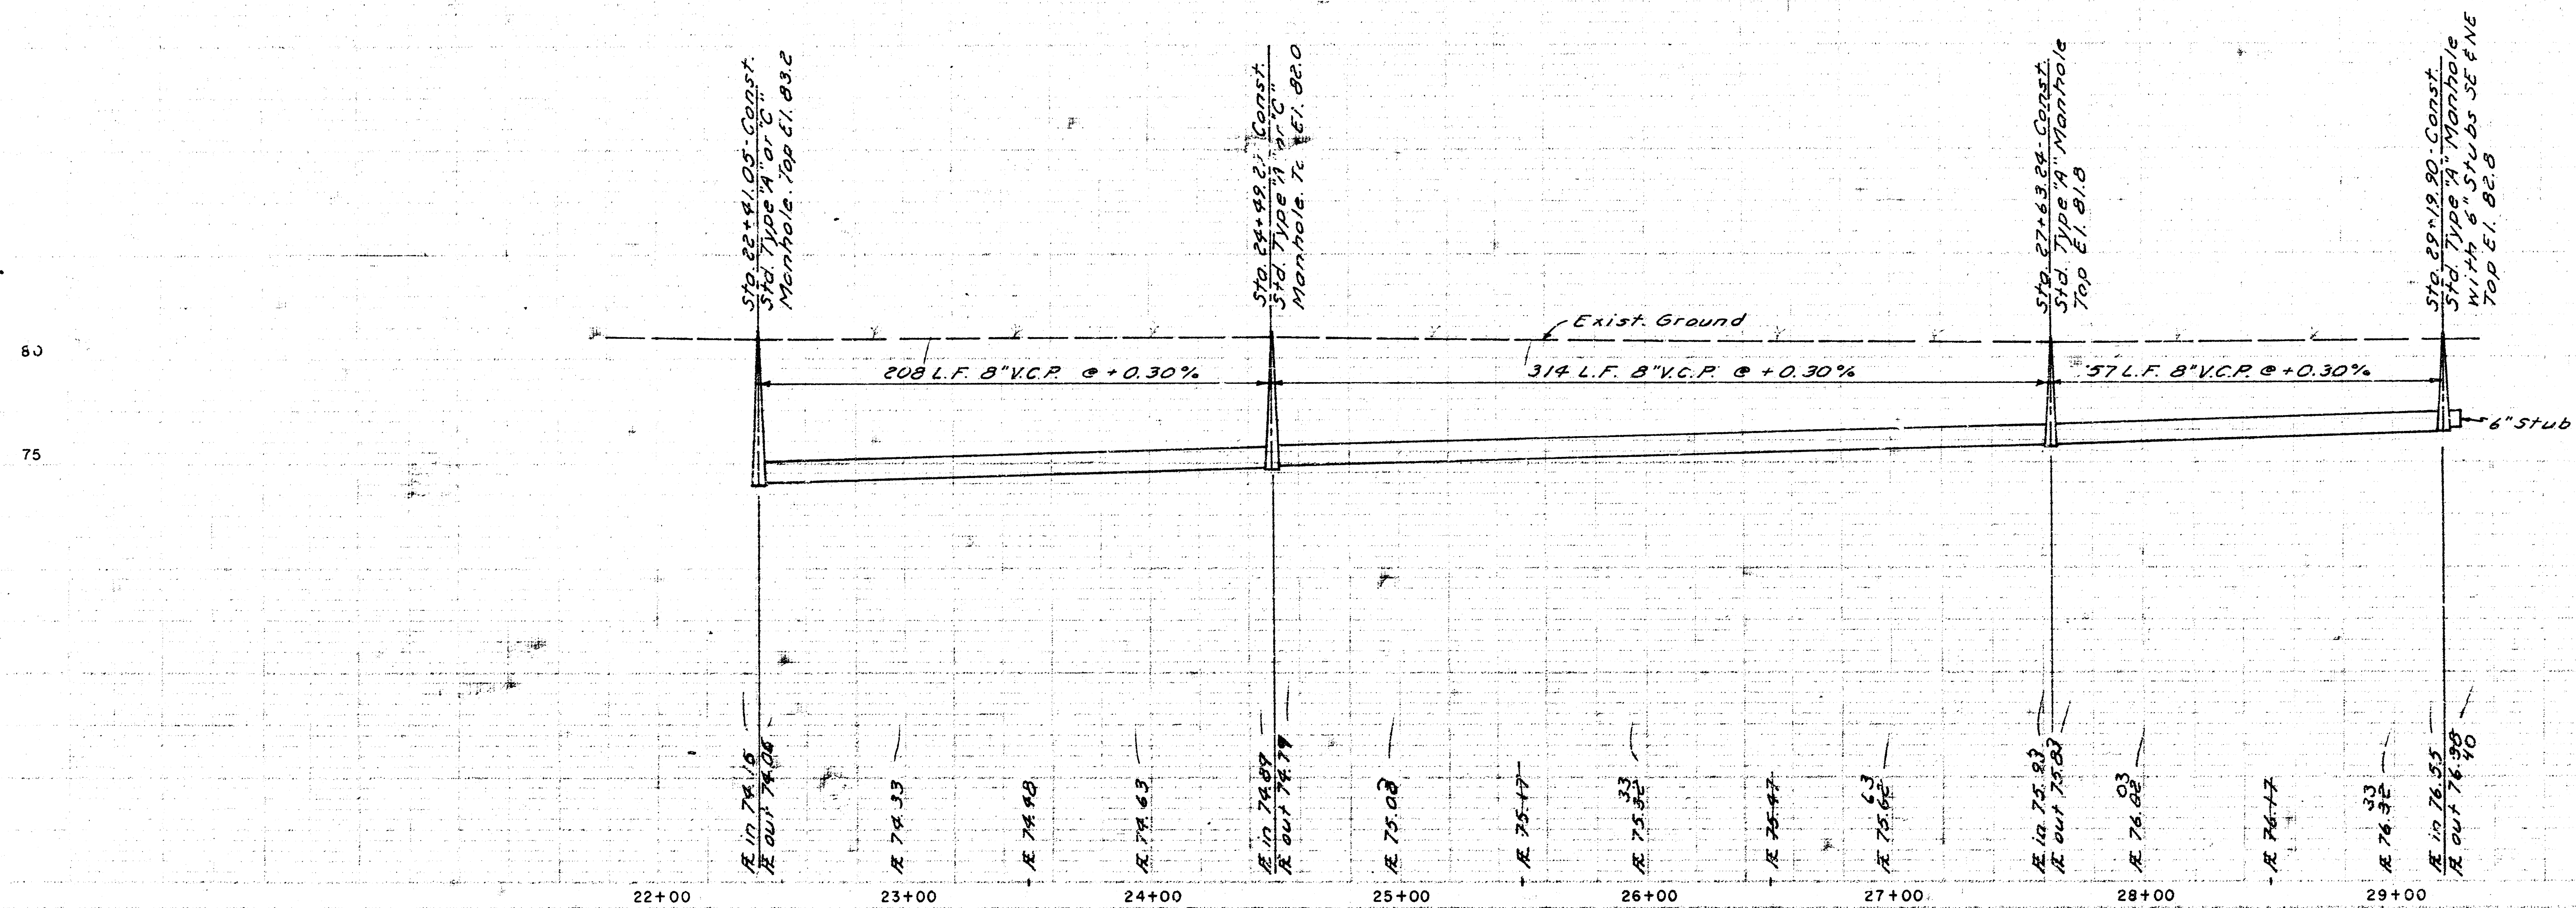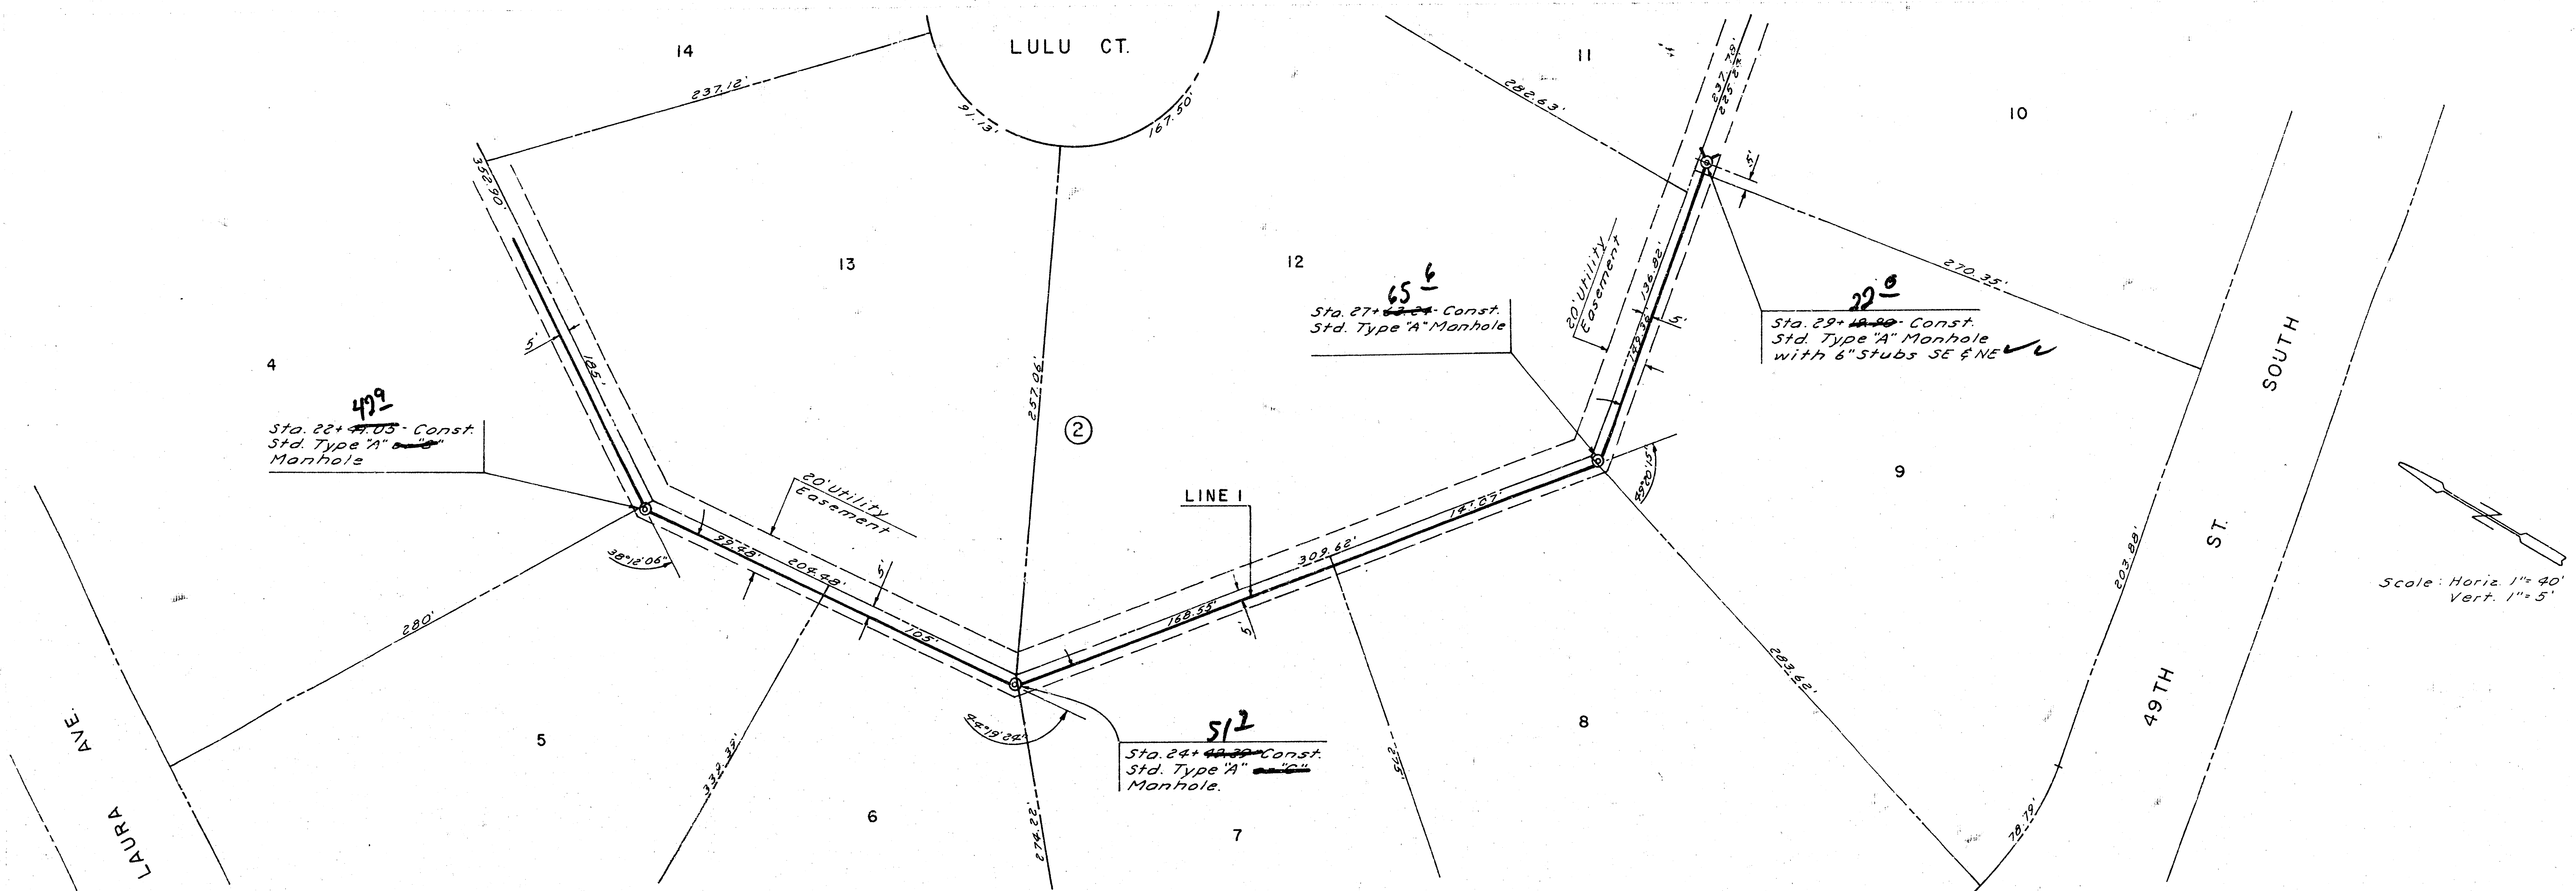


As Built
12/8/1

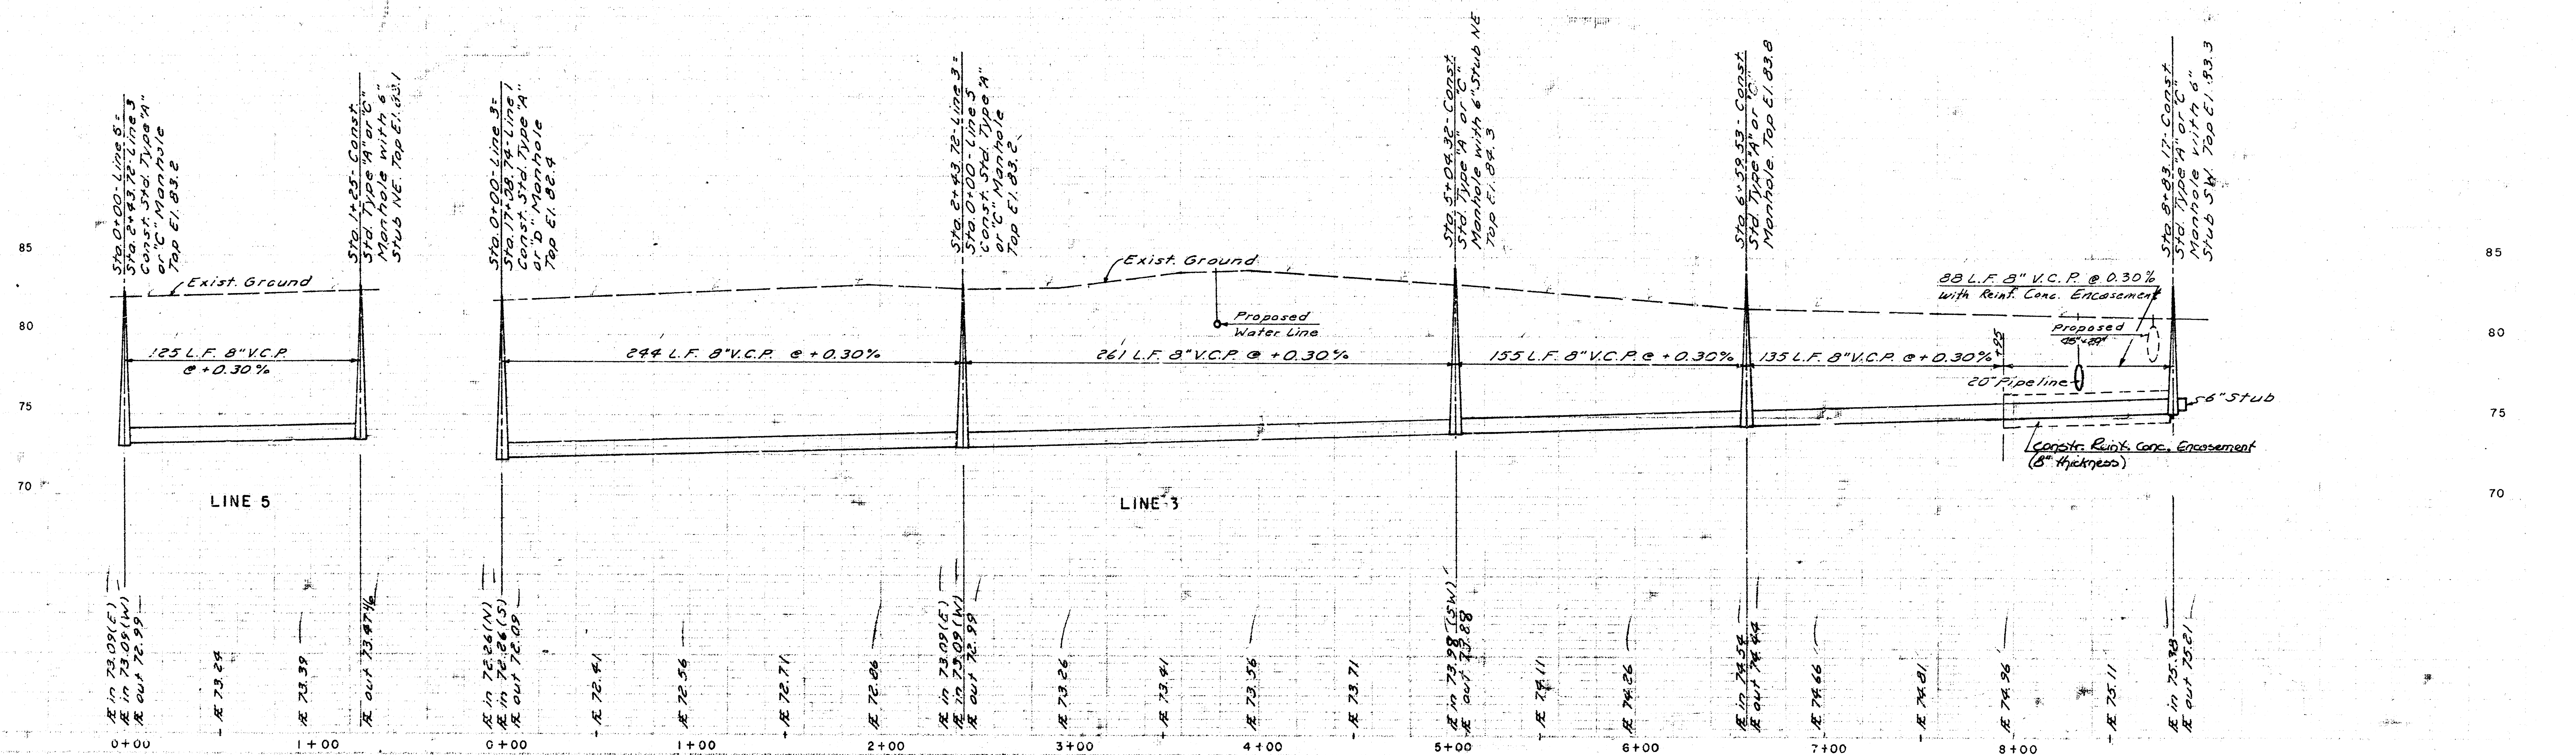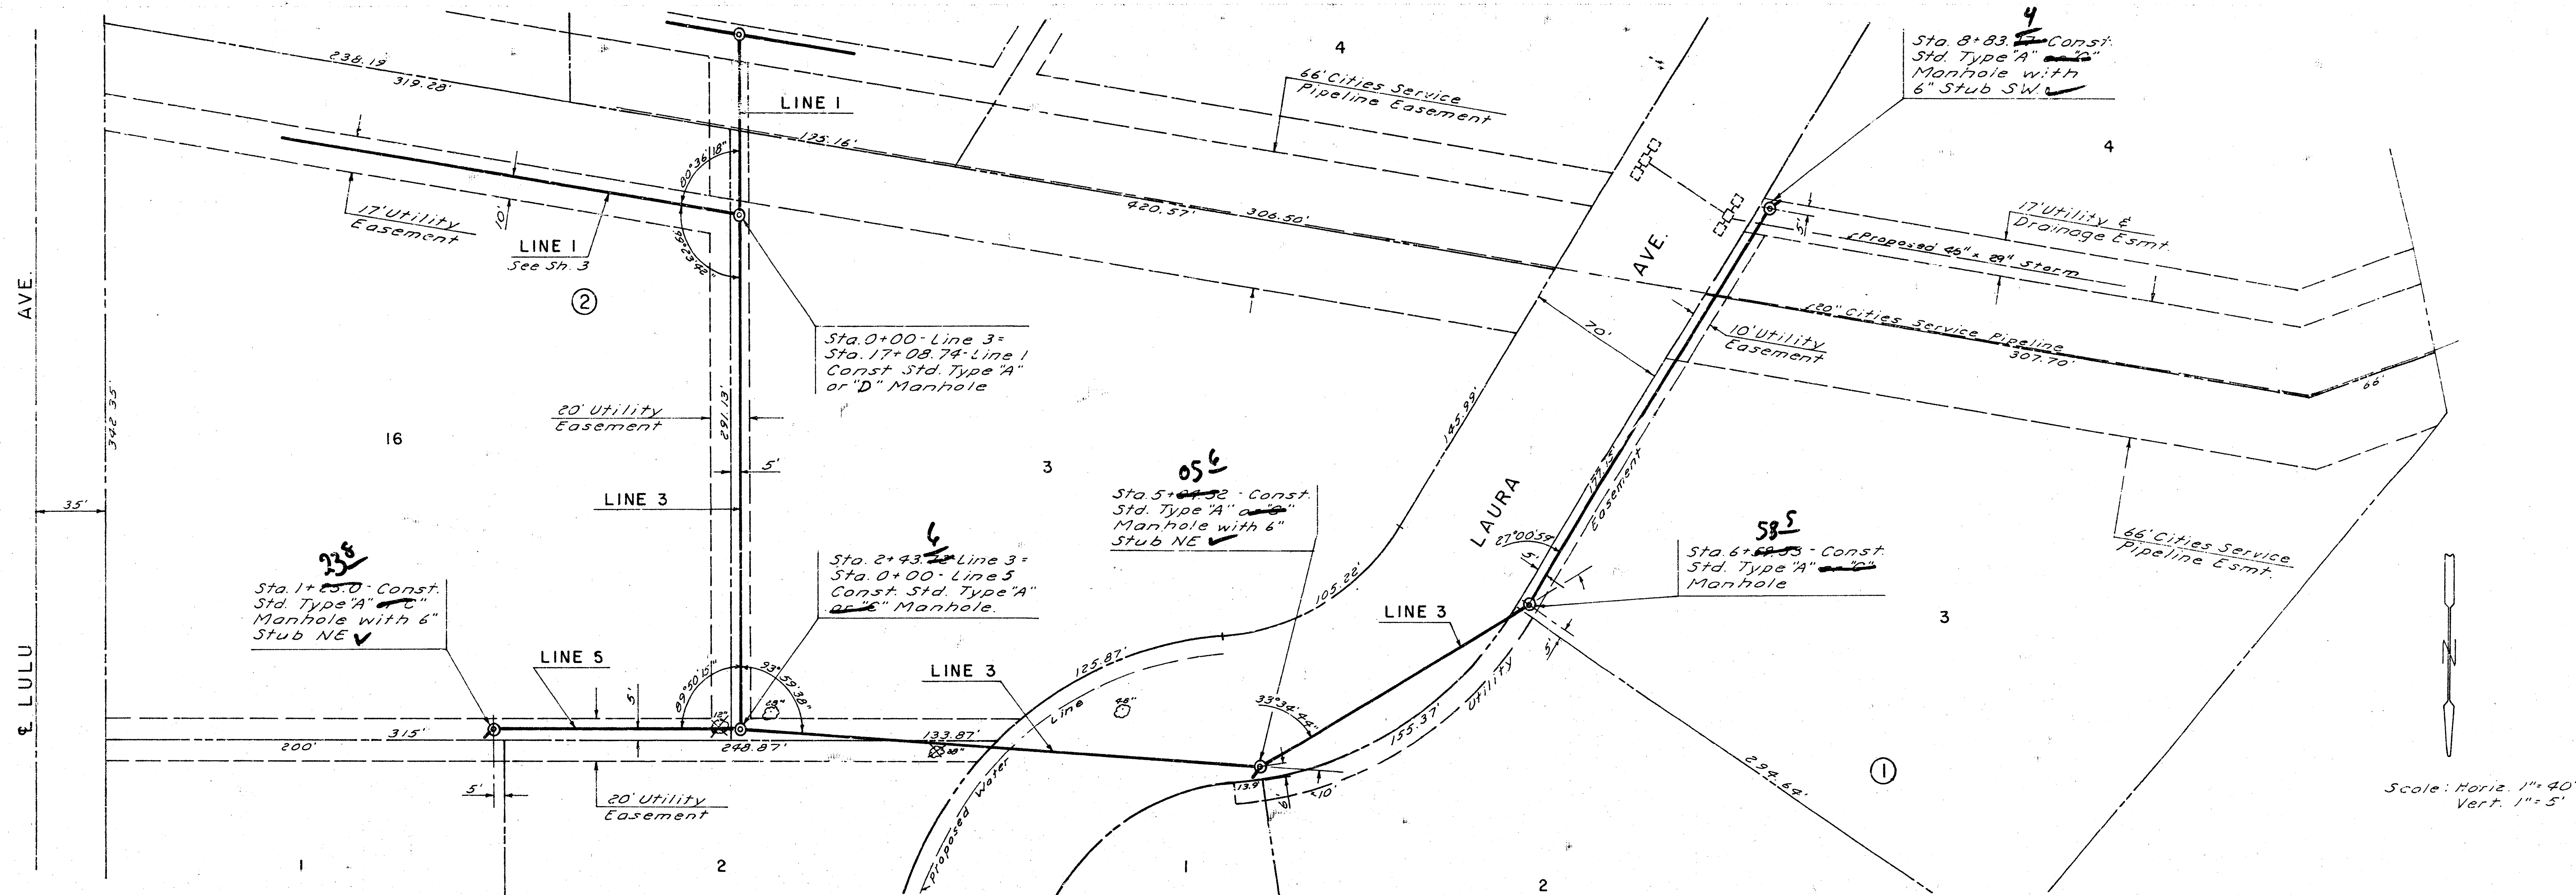

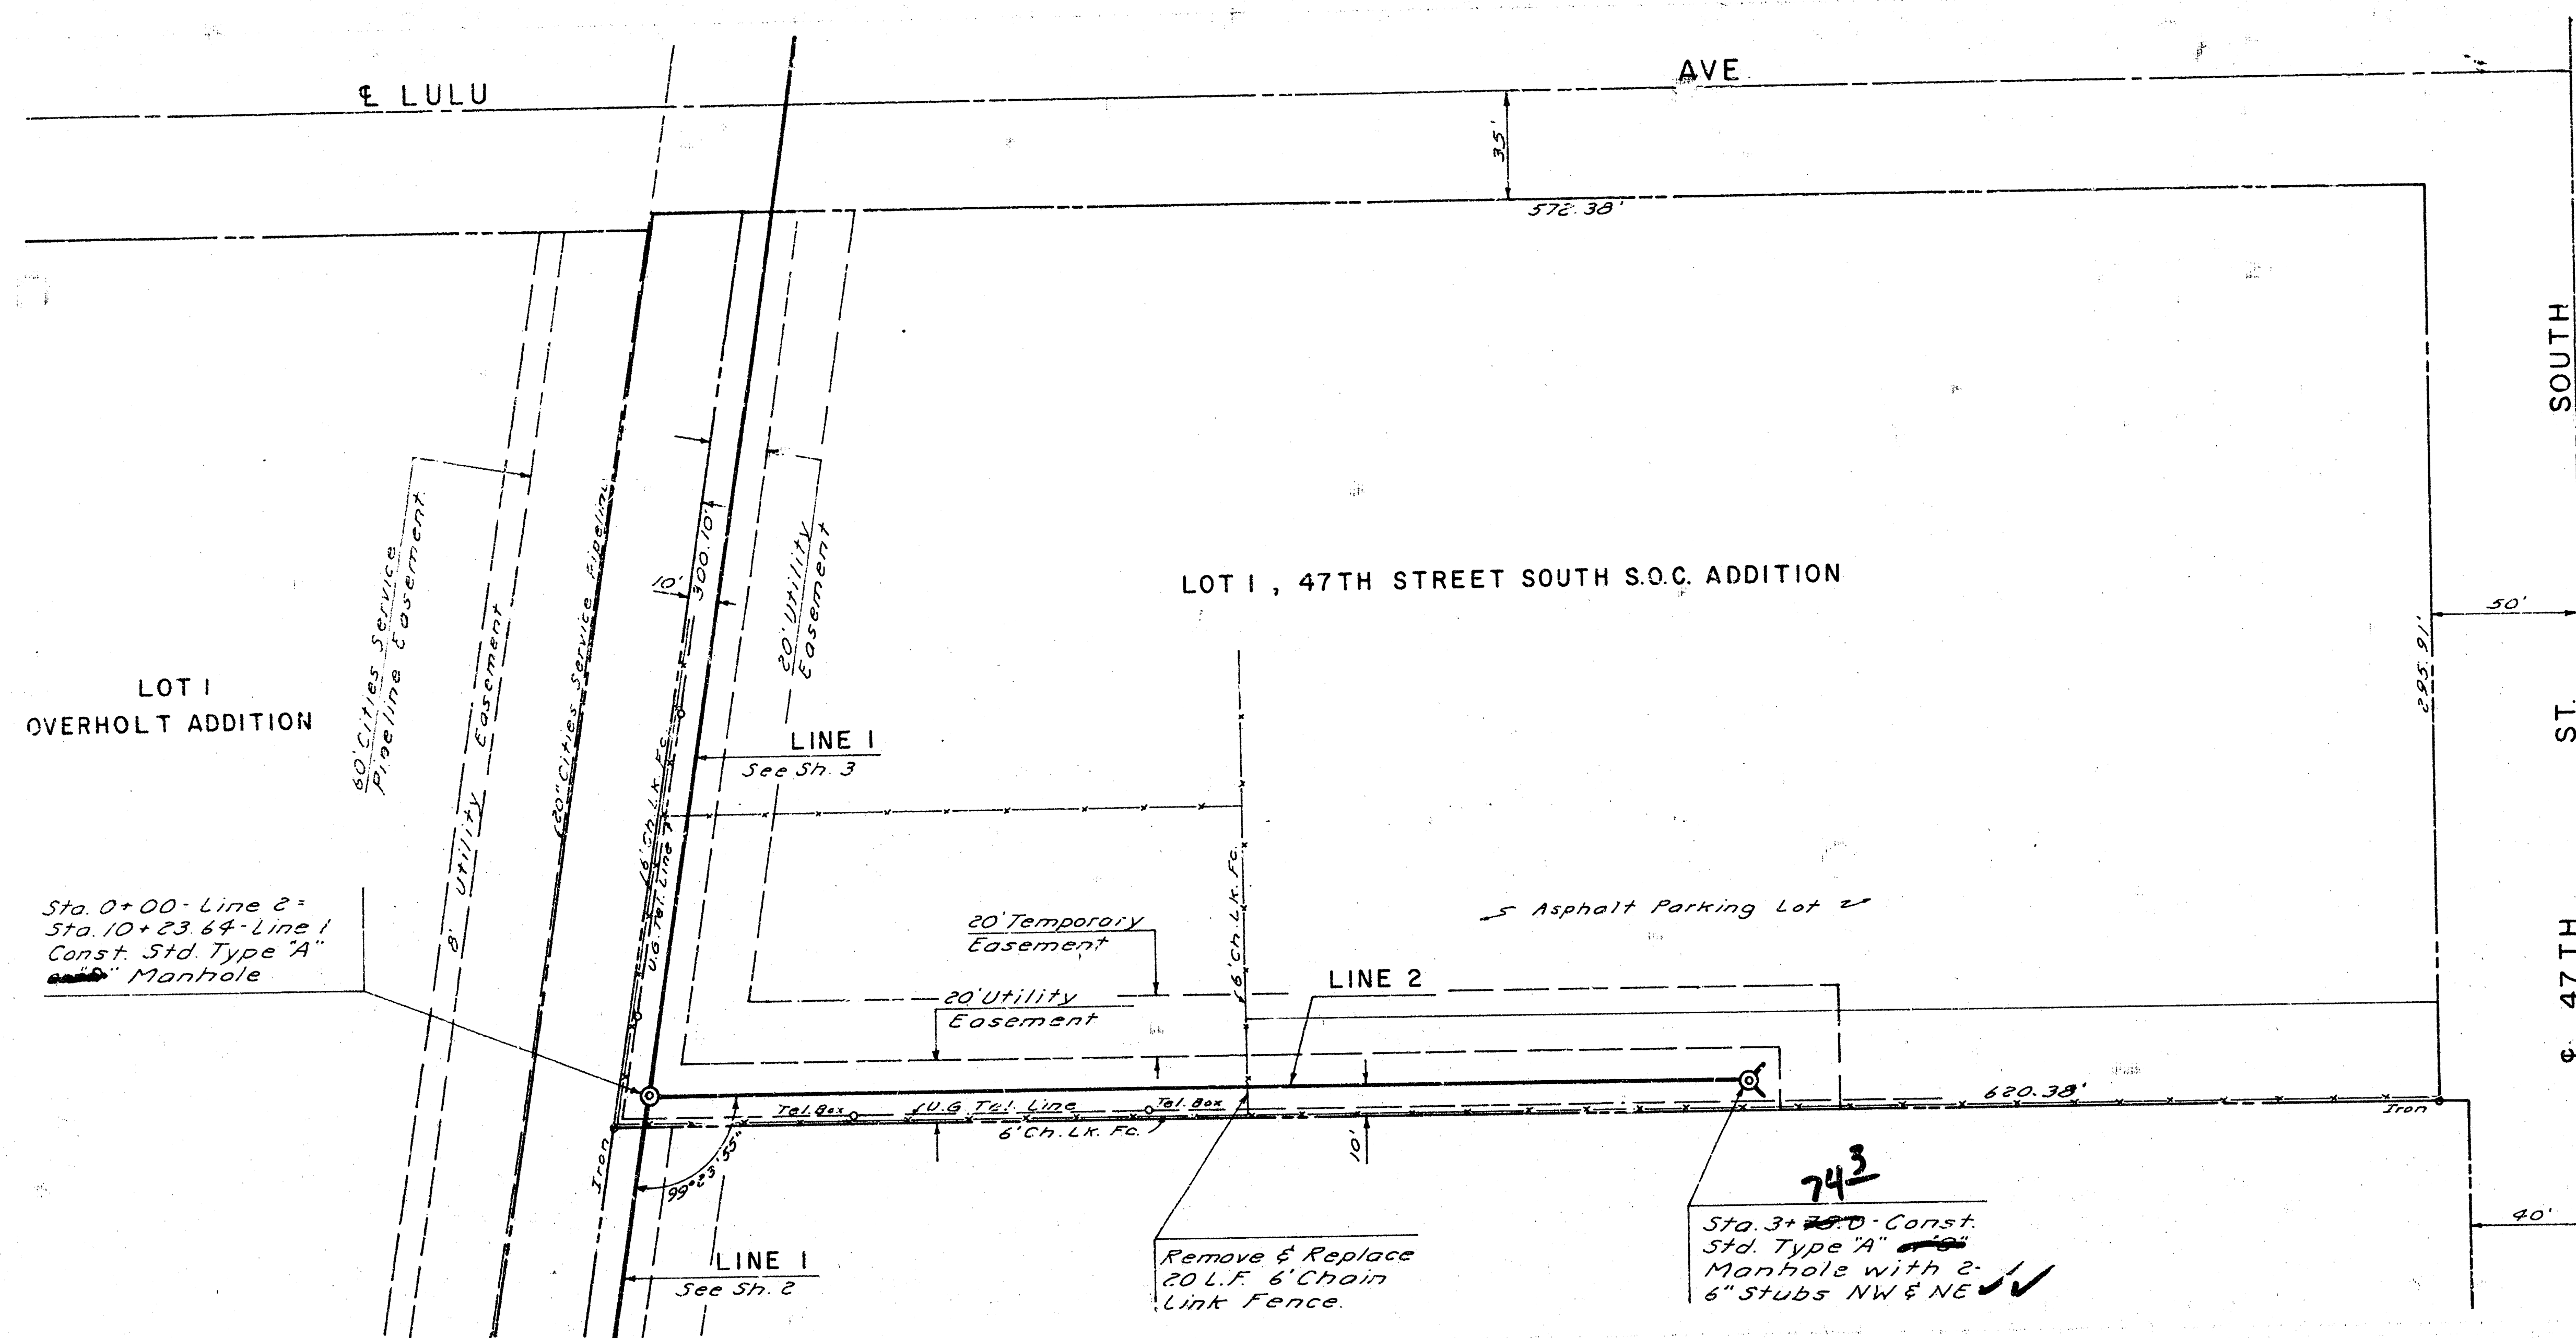

Scale: Horiz. 1"=40'
Vert. 1"=5'

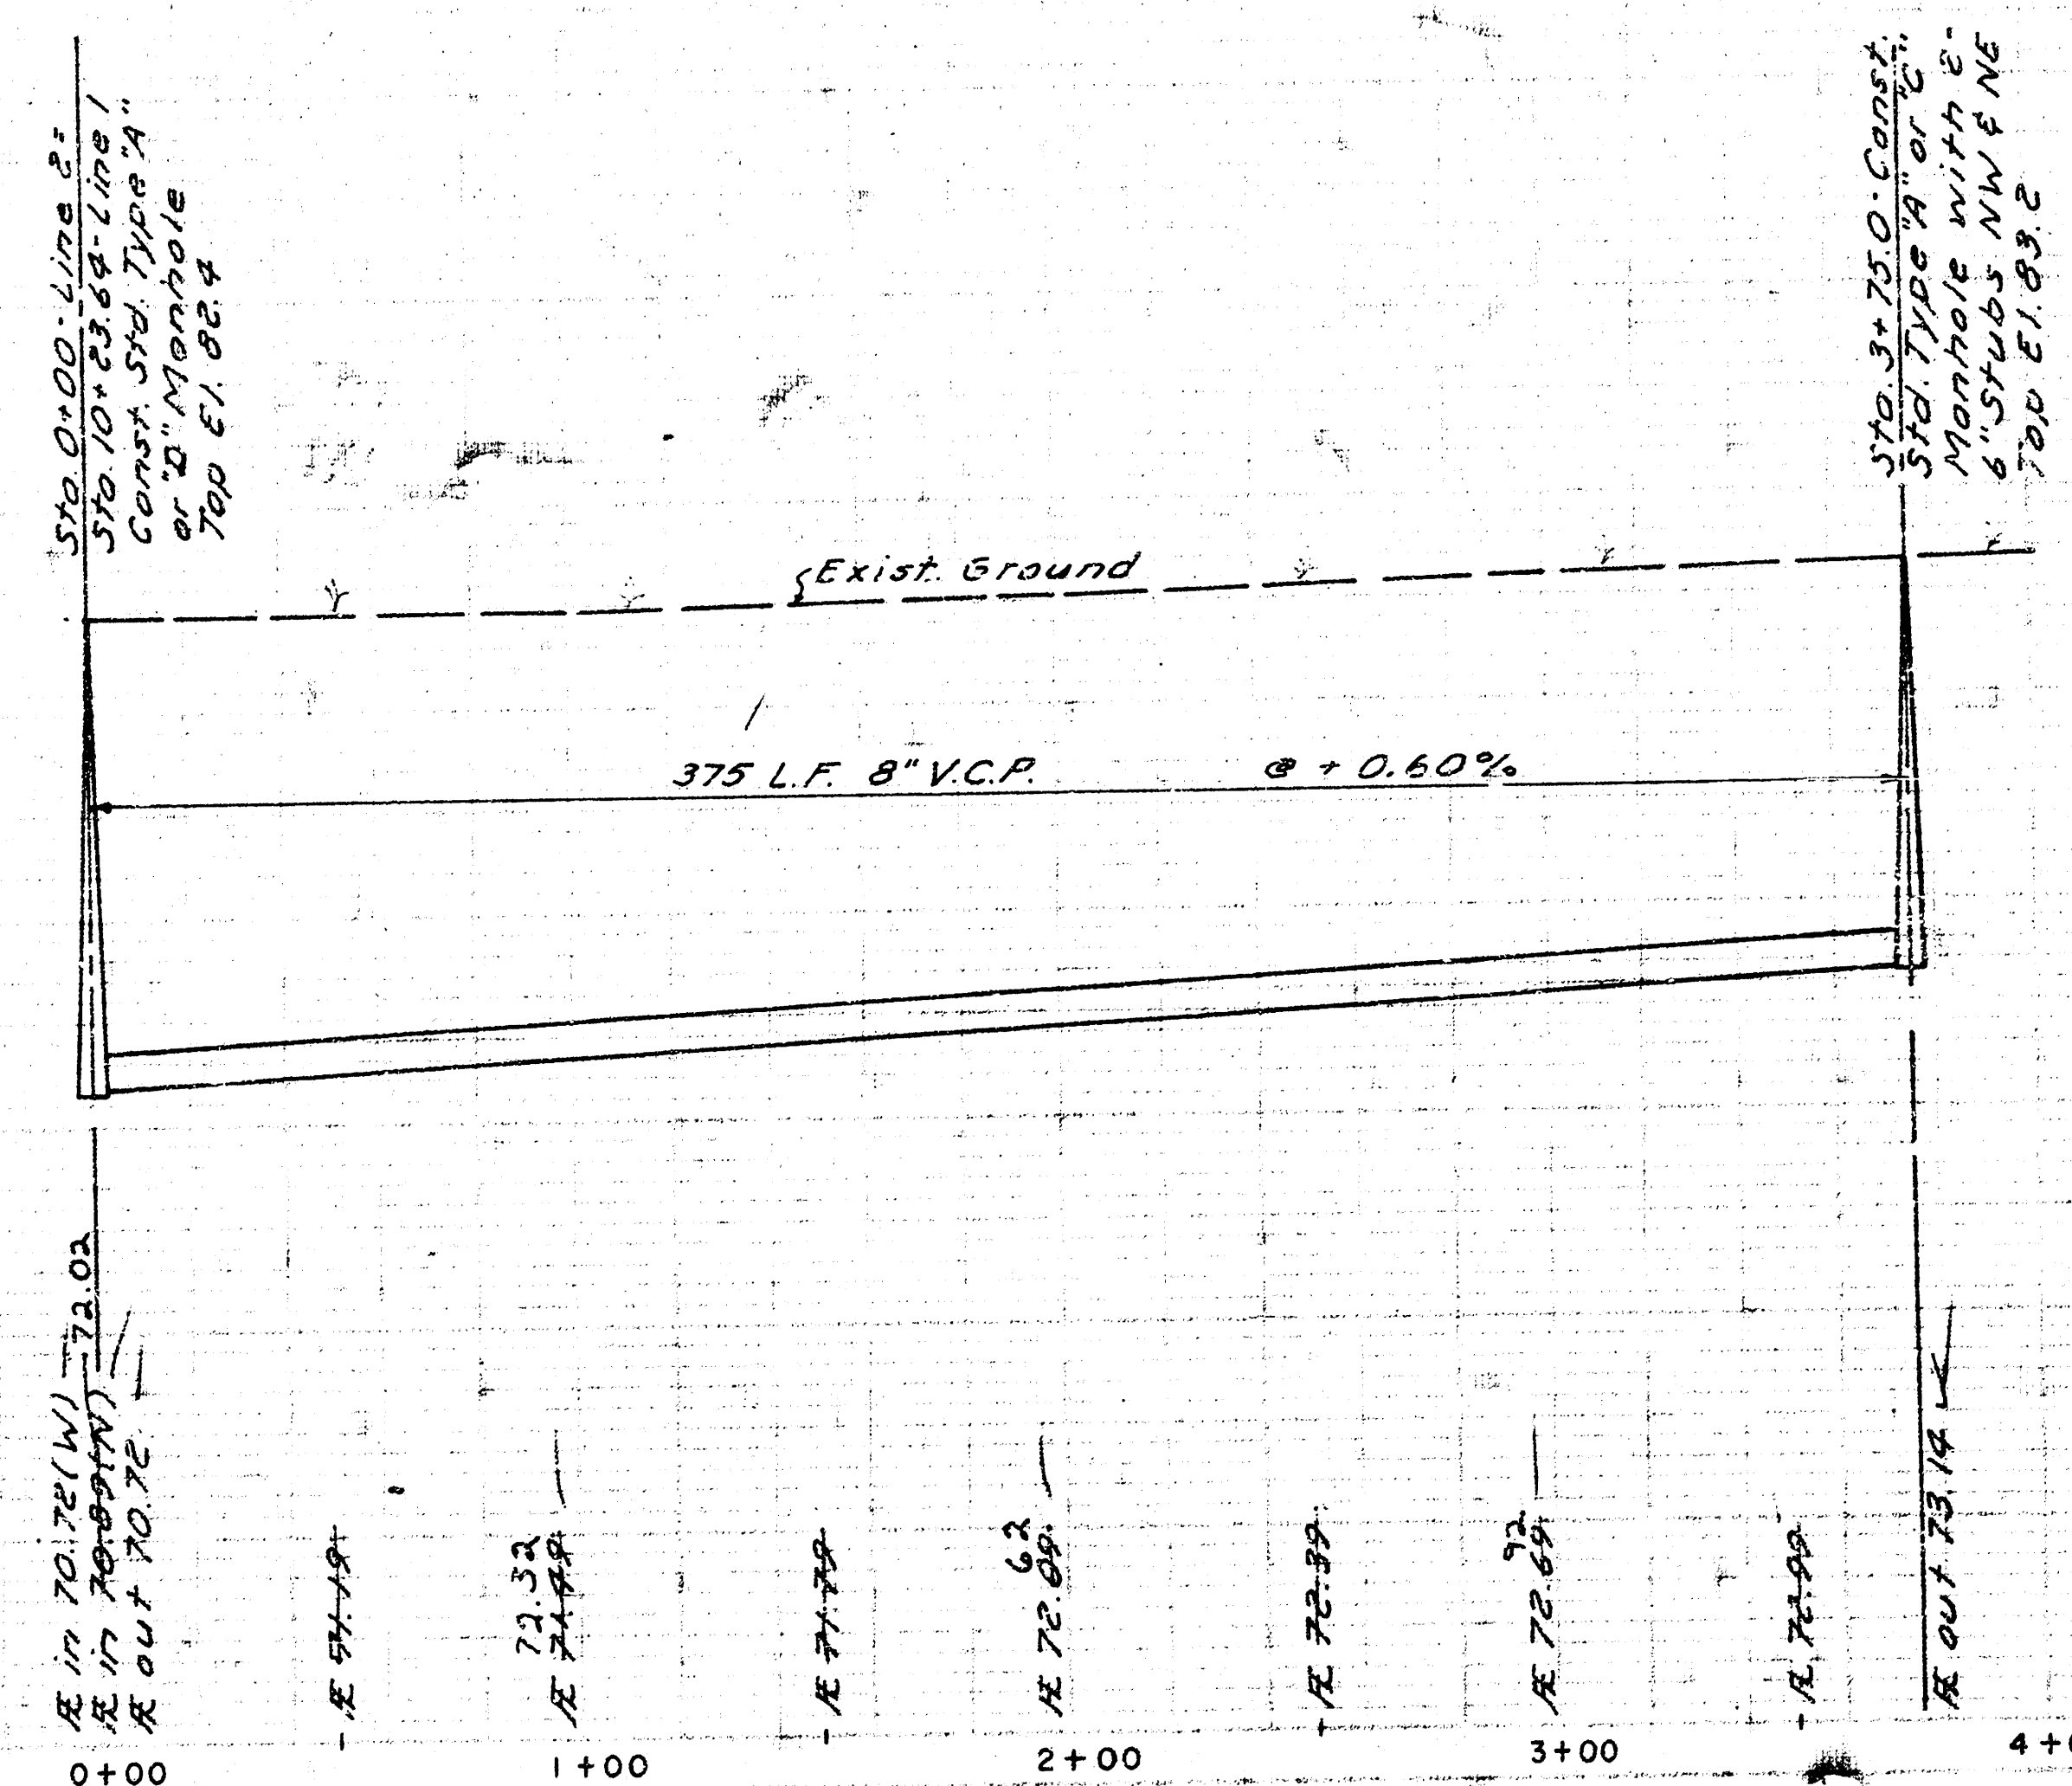

As Built
12/81