




Scale:
1" = 40' Plan
1/8" = 40' Horiz. Profile
1" = 5' Vert.

Bench Marks: 56.195 - 62" Nail on N. Face of Power Pole, W. R. Ellis and 190 ± N. of @ A.T.A.
Elev. 190 ± W. of @ Ellis, N. Side of MacArthur Rd. S. Spk. on N. Face of E. Power Pole.


CAUTION
UNDERGROUND UTILITIES
Please Check with K.C.G.E. or Southwestern Bell Telephone Co. for Location

THE CONTRACTOR SHALL BE RESPONSIBLE FOR PRESERVING PROPERTY IRONS. THE CONTRACTOR SHALL BE REQUIRED TO RE-INSTALL ANY PROPERTY IRONS WHICH ARE DAMAGED OR DESTROYED BY HIS CONSTRUCTION OPERATIONS. SUCH IRONS SHALL BE RE-INSTALLED BY A LICENSED LAND SURVEYOR OR A LICENSED PROFESSIONAL ENGINEER IN ACCORDANCE WITH STATE LAWS.



SOUTH FIELD
ADDITION

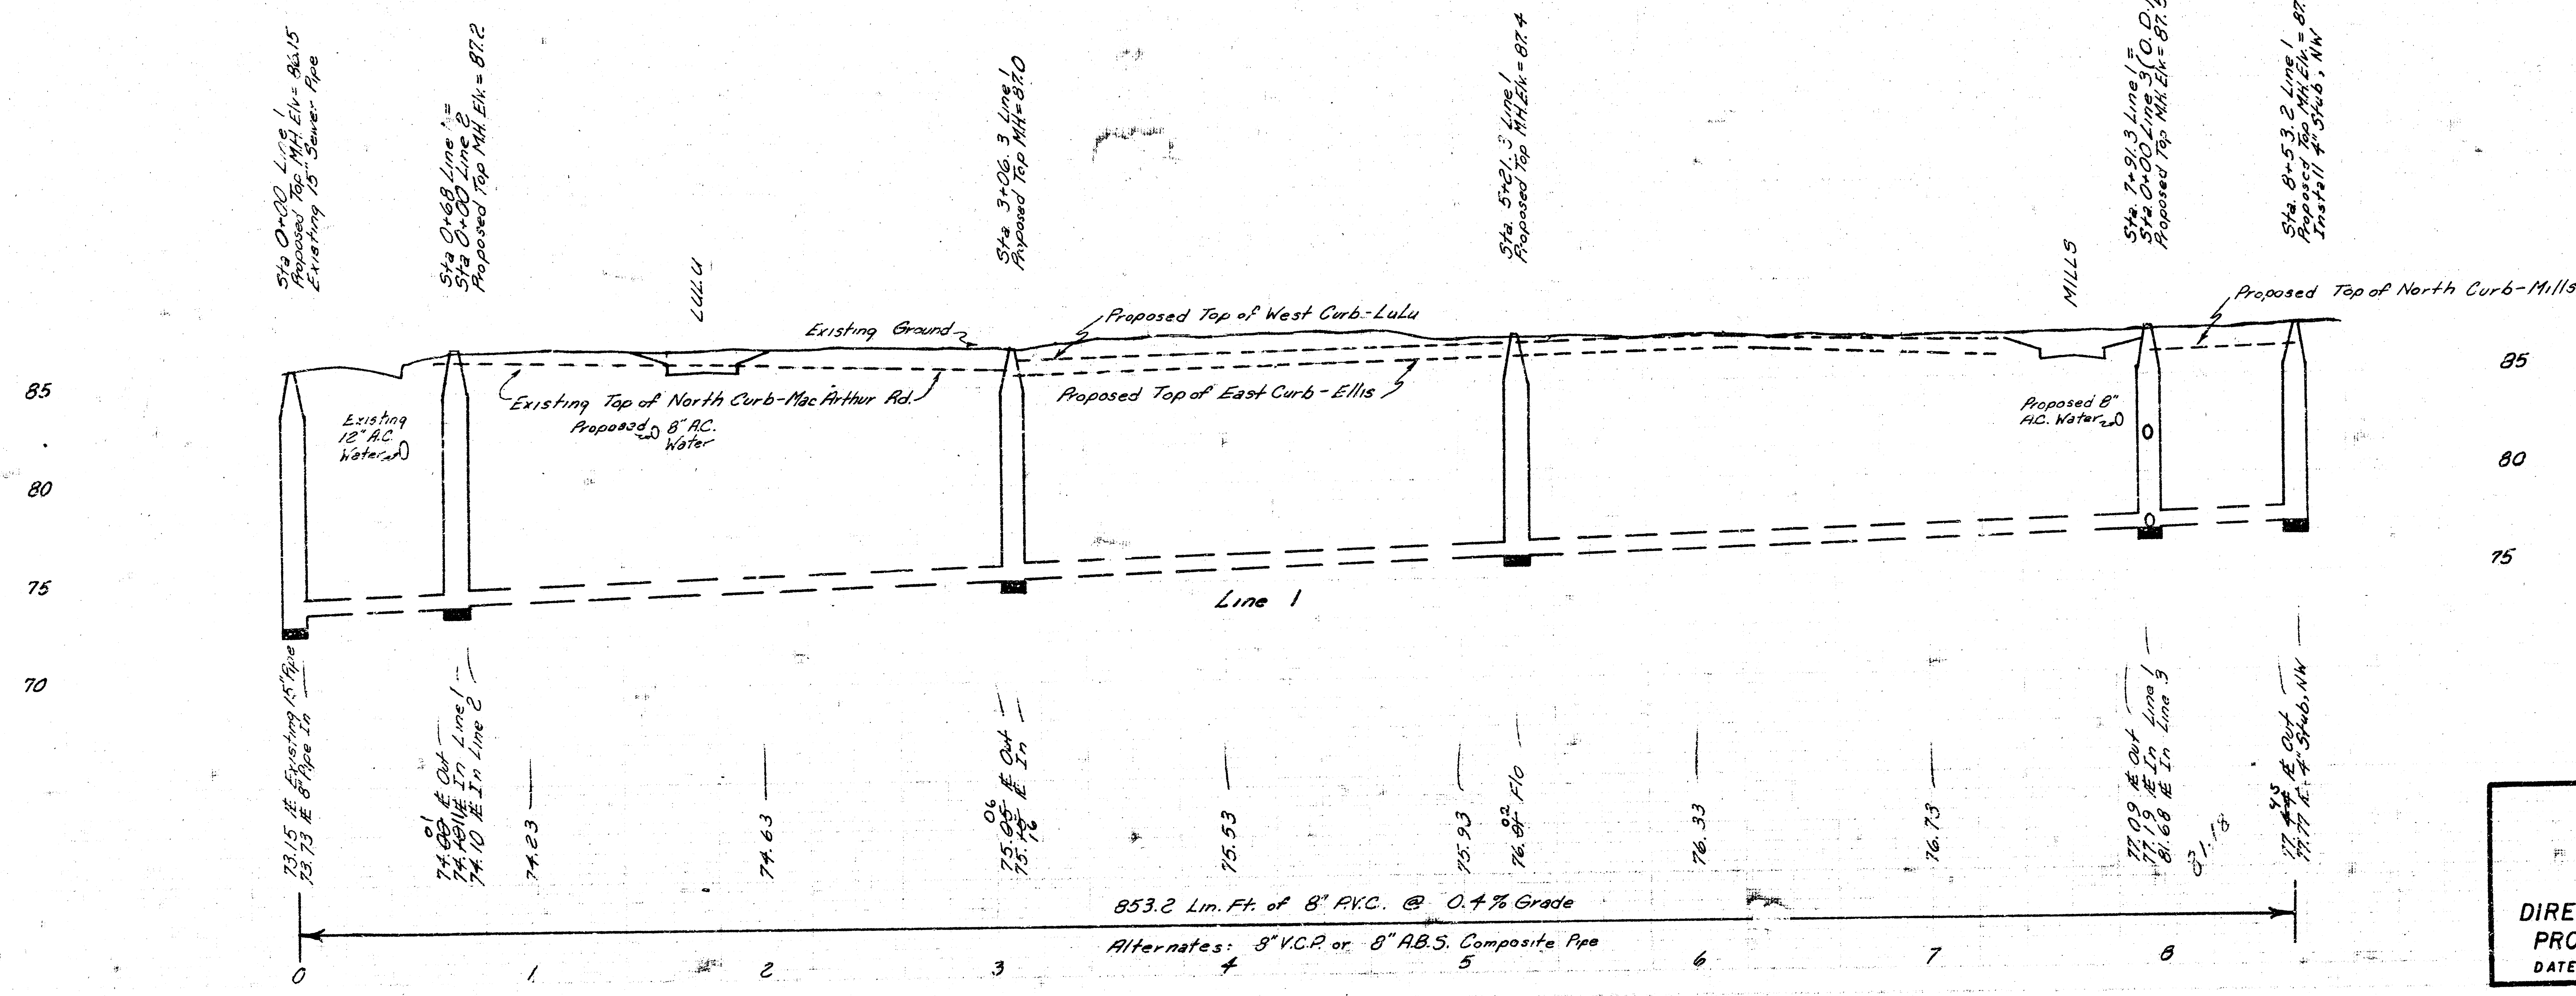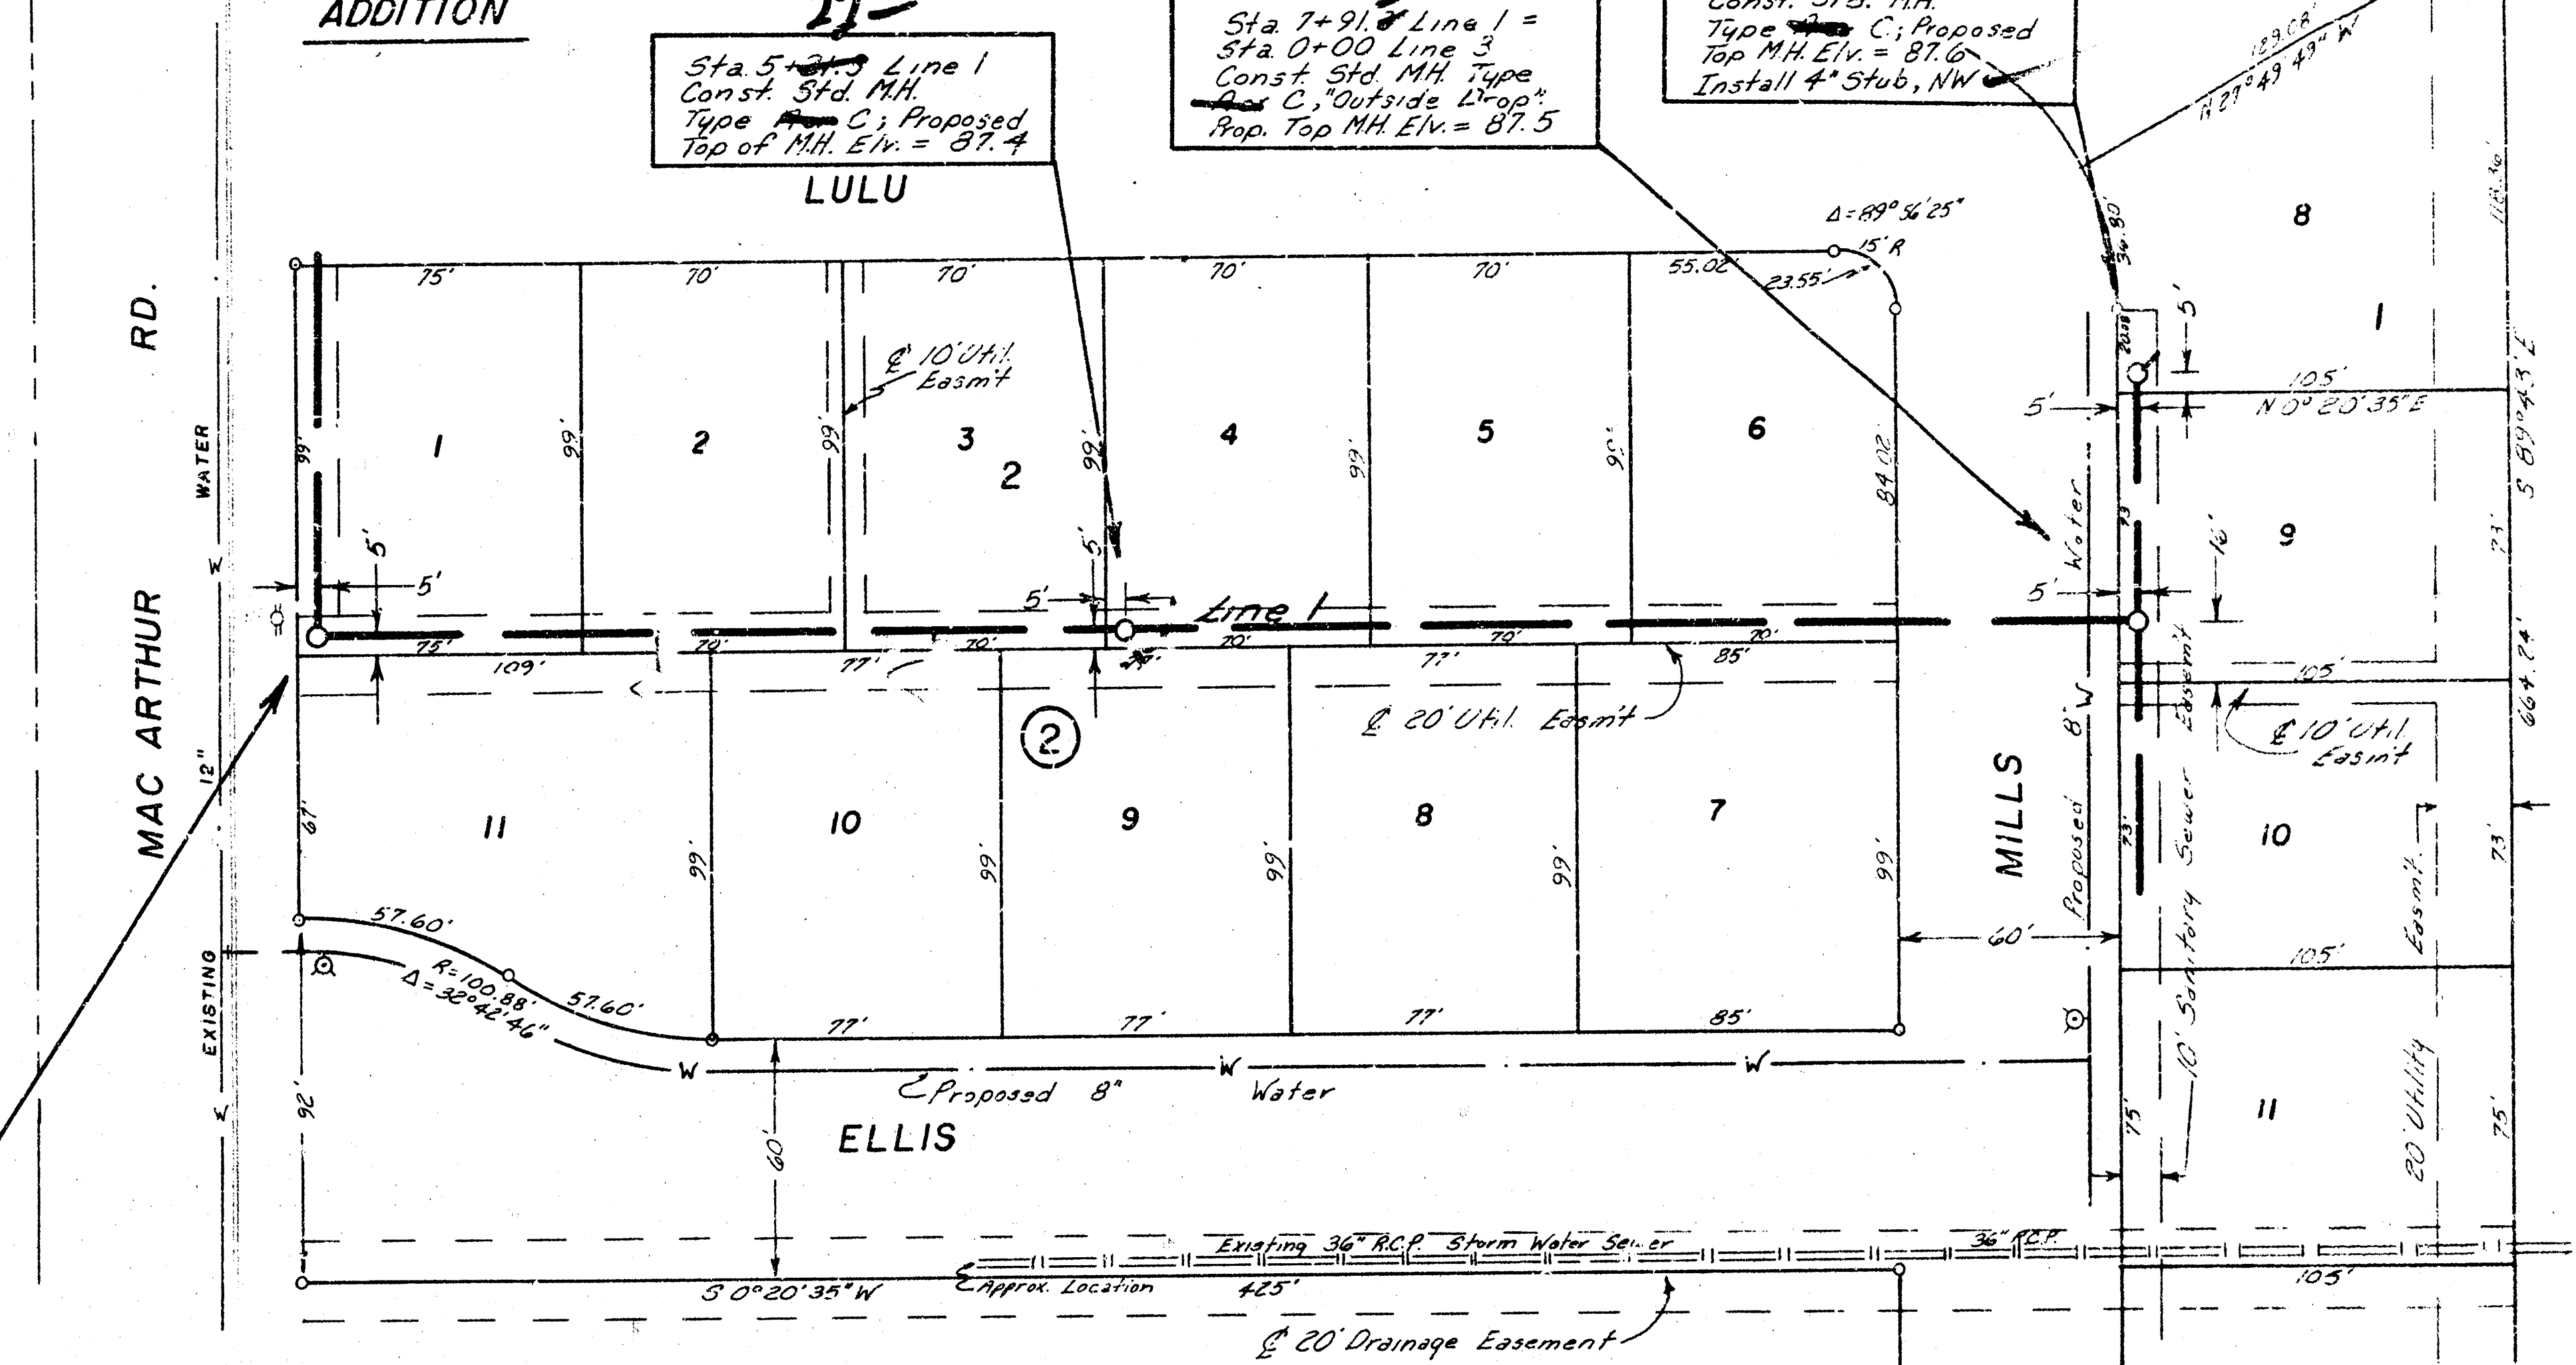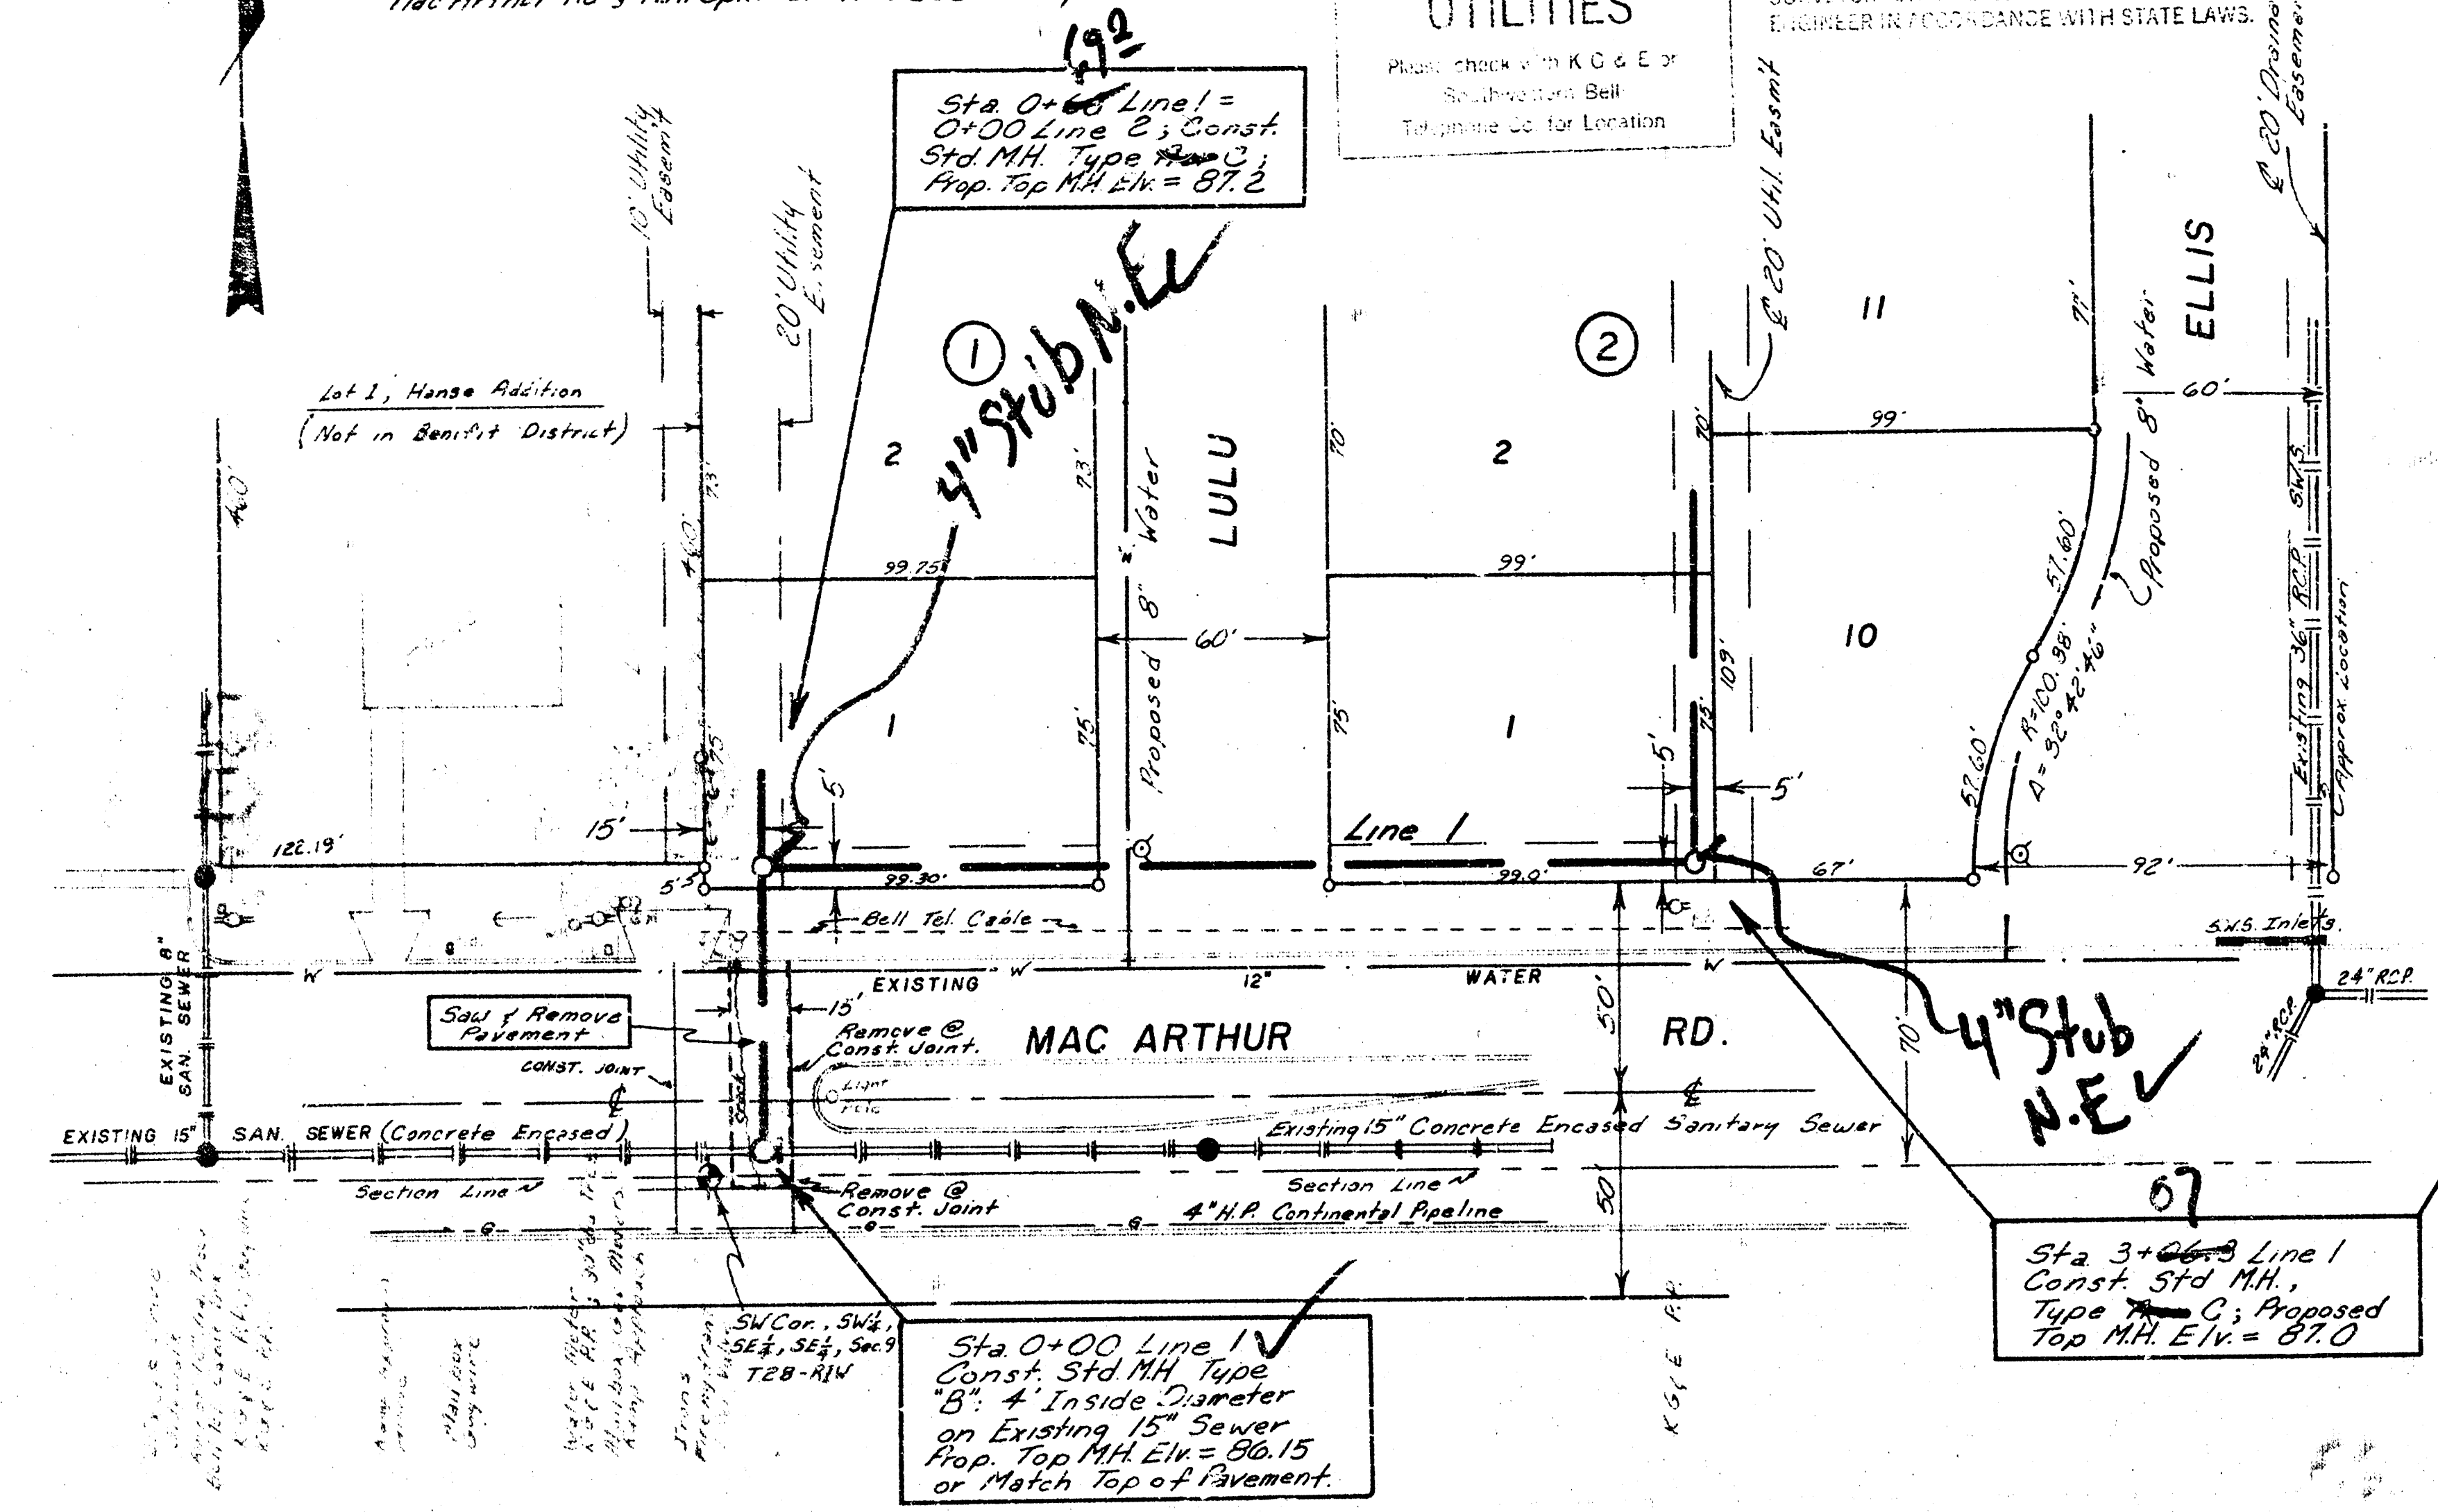



Handwritten signature and date: 12/81

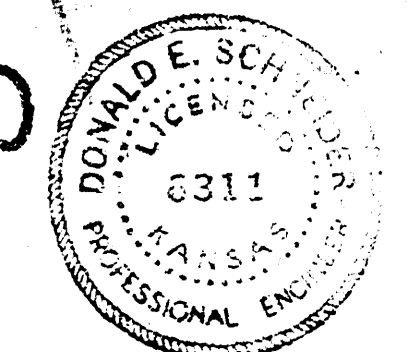

LAT. 62, MAIN 1, S.W.I.
CITY OF WICHITA, KANSAS
R. W. BRUGGEMAN
DIRECTOR OF ENGINEERING / CITY ENGINEER
PROJ. NO. 46876-245-81121-000-000-001
DATE _____ SHEET 1 of 2

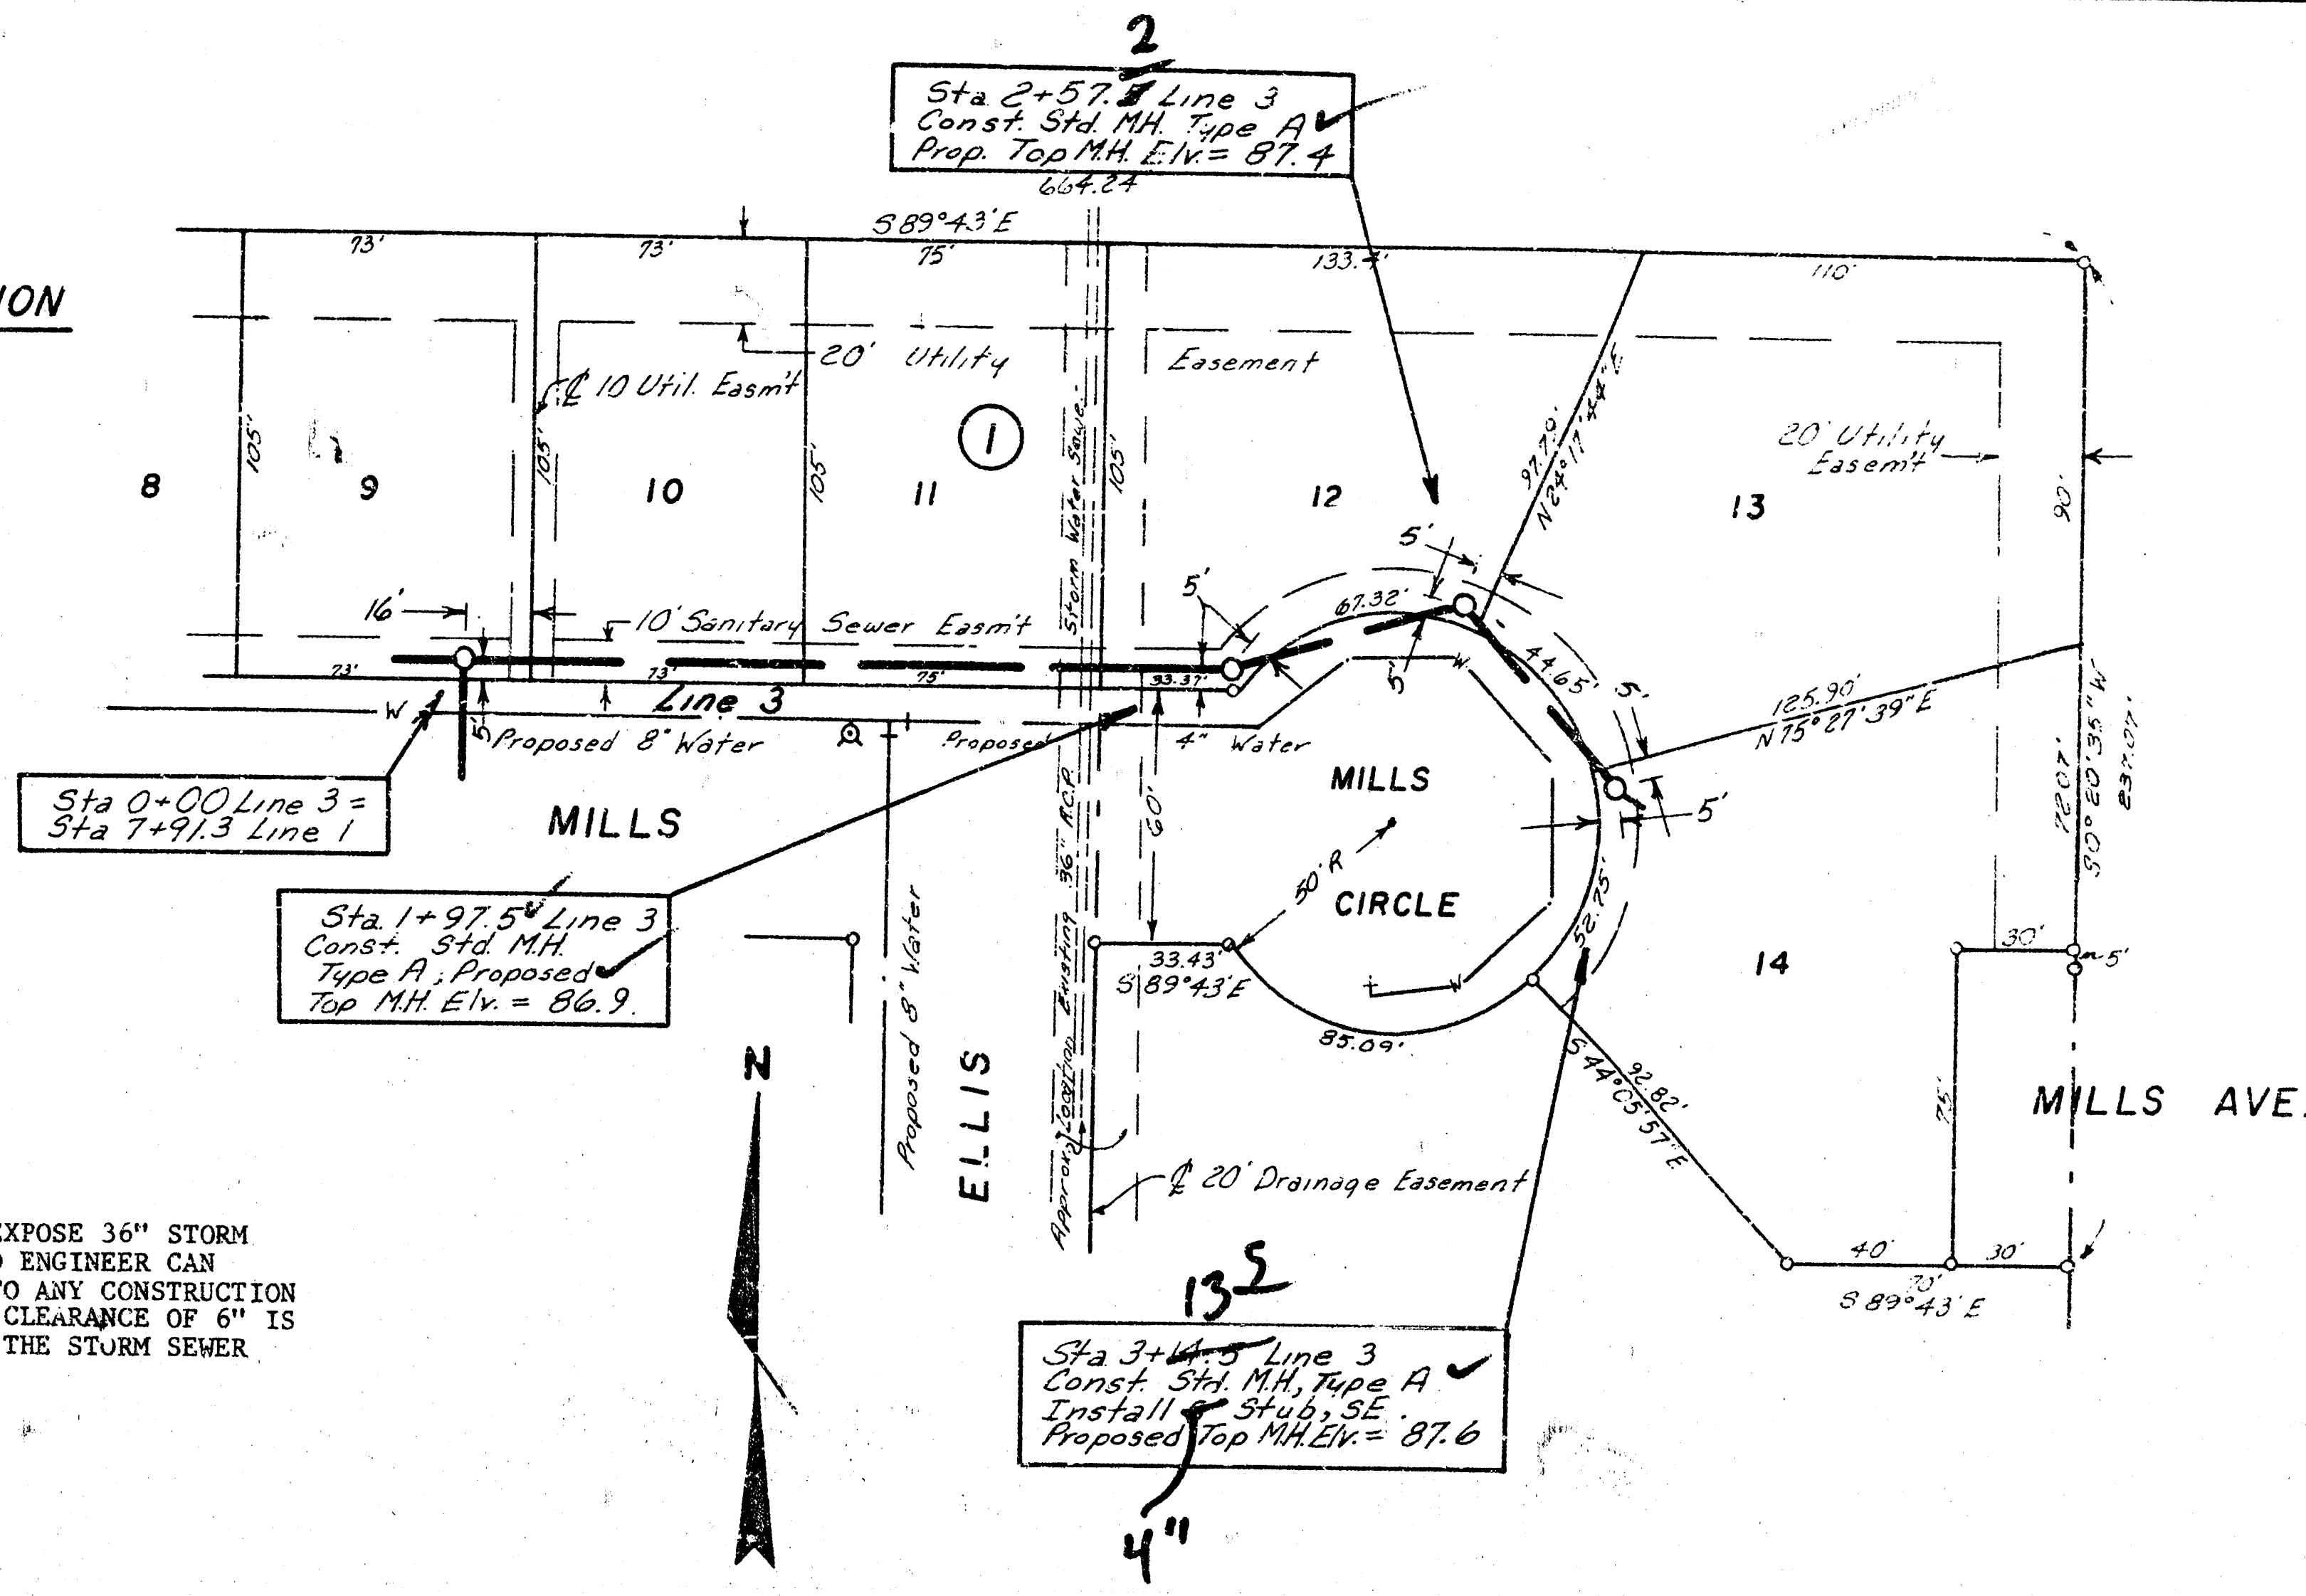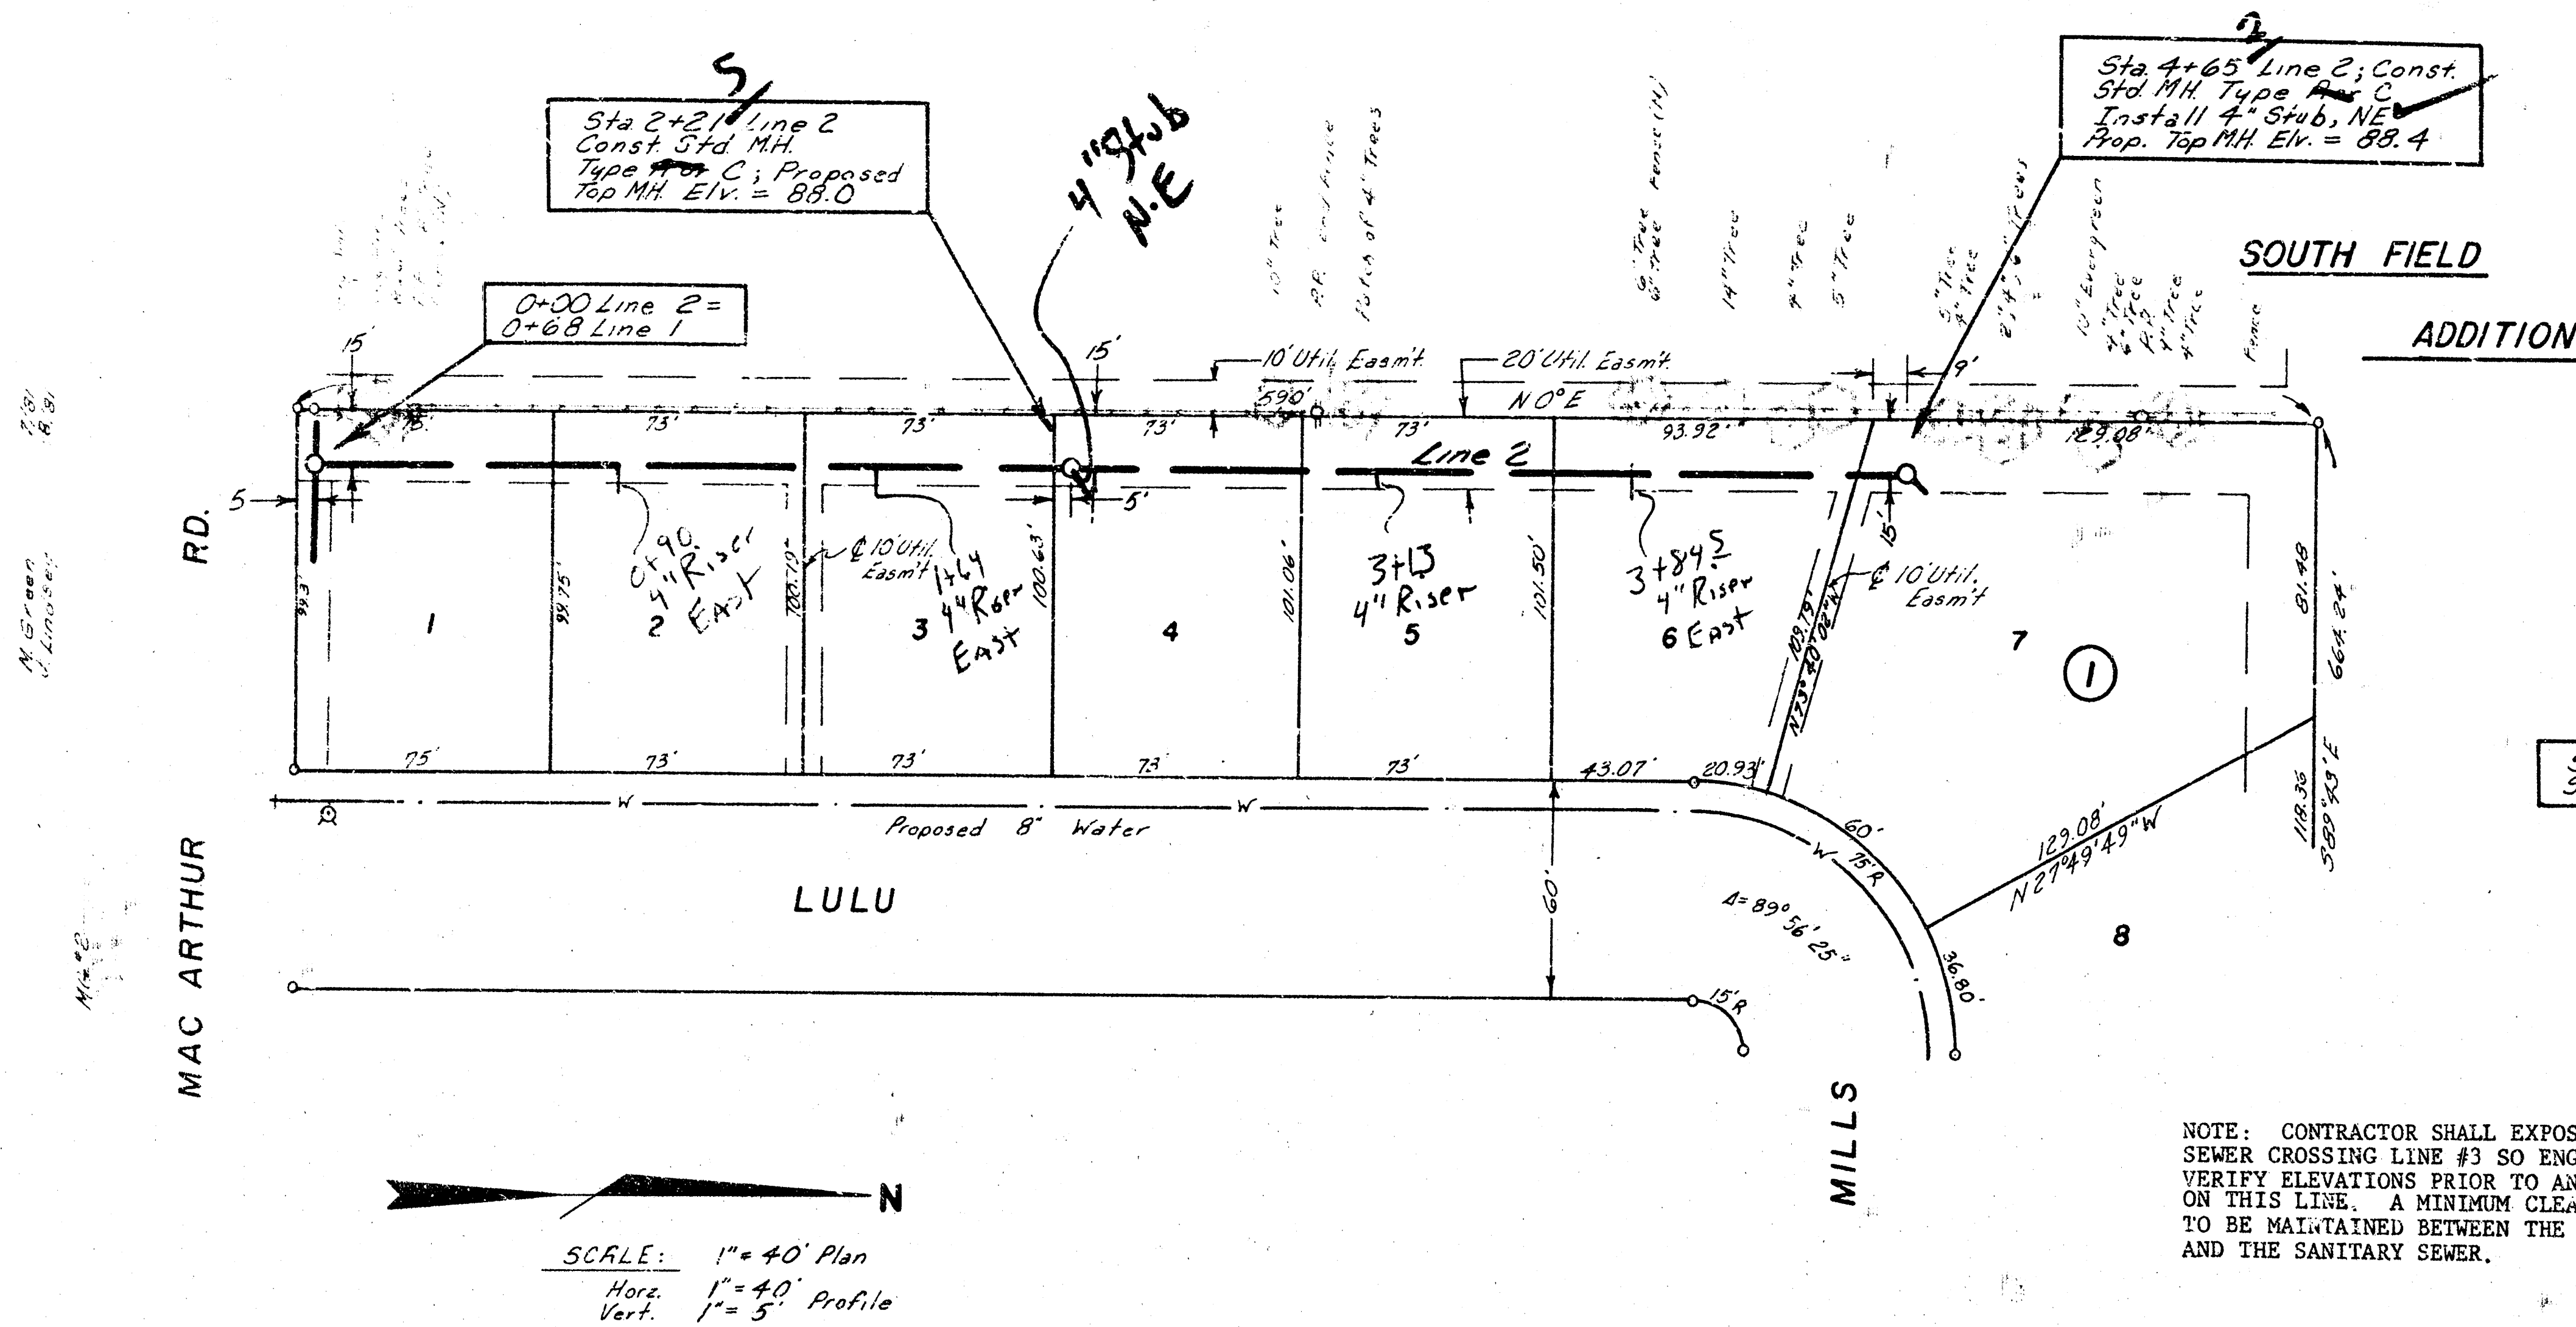

NOTE: CONTRACTOR SHALL EXPOSE 36" STORM SEWER CROSSING LINE #3 SO ENGINEER CAN VERIFY ELEVATIONS PRIOR TO ANY CONSTRUCTION ON THIS LINE. A MINIMUM CLEARANCE OF 6" IS TO BE MAINTAINED BETWEEN THE STORM SEWER AND THE SANITARY SEWER.

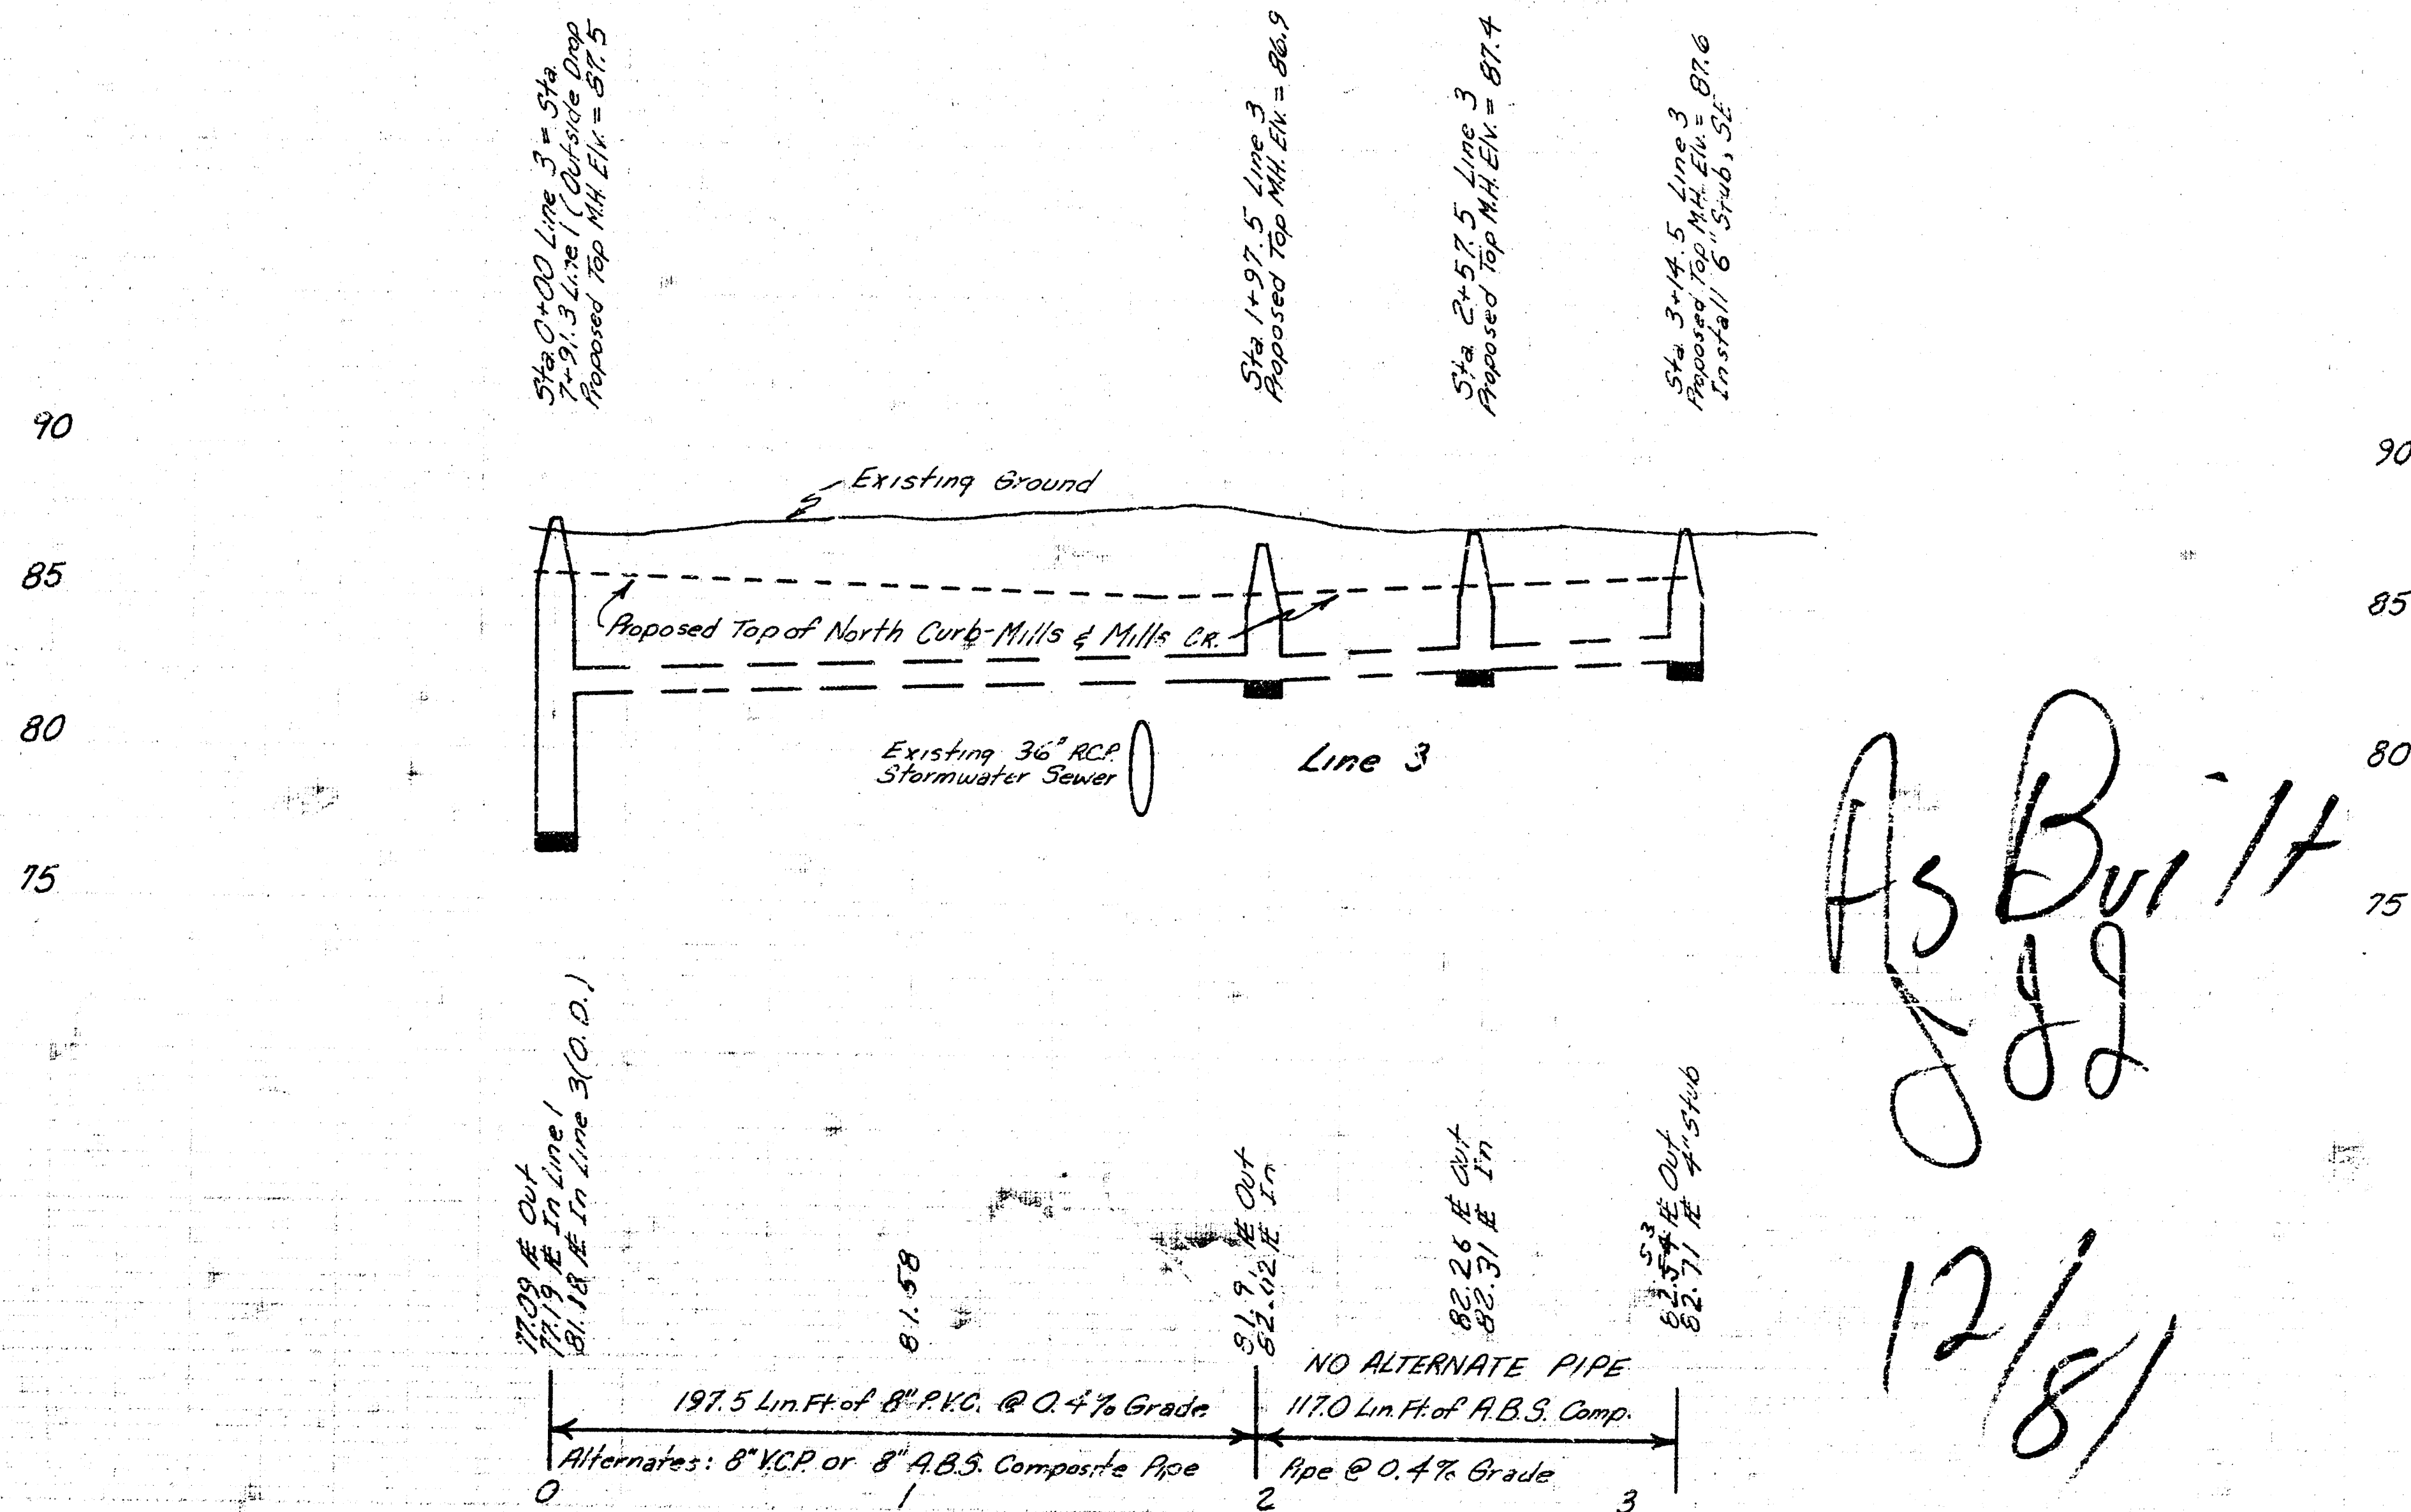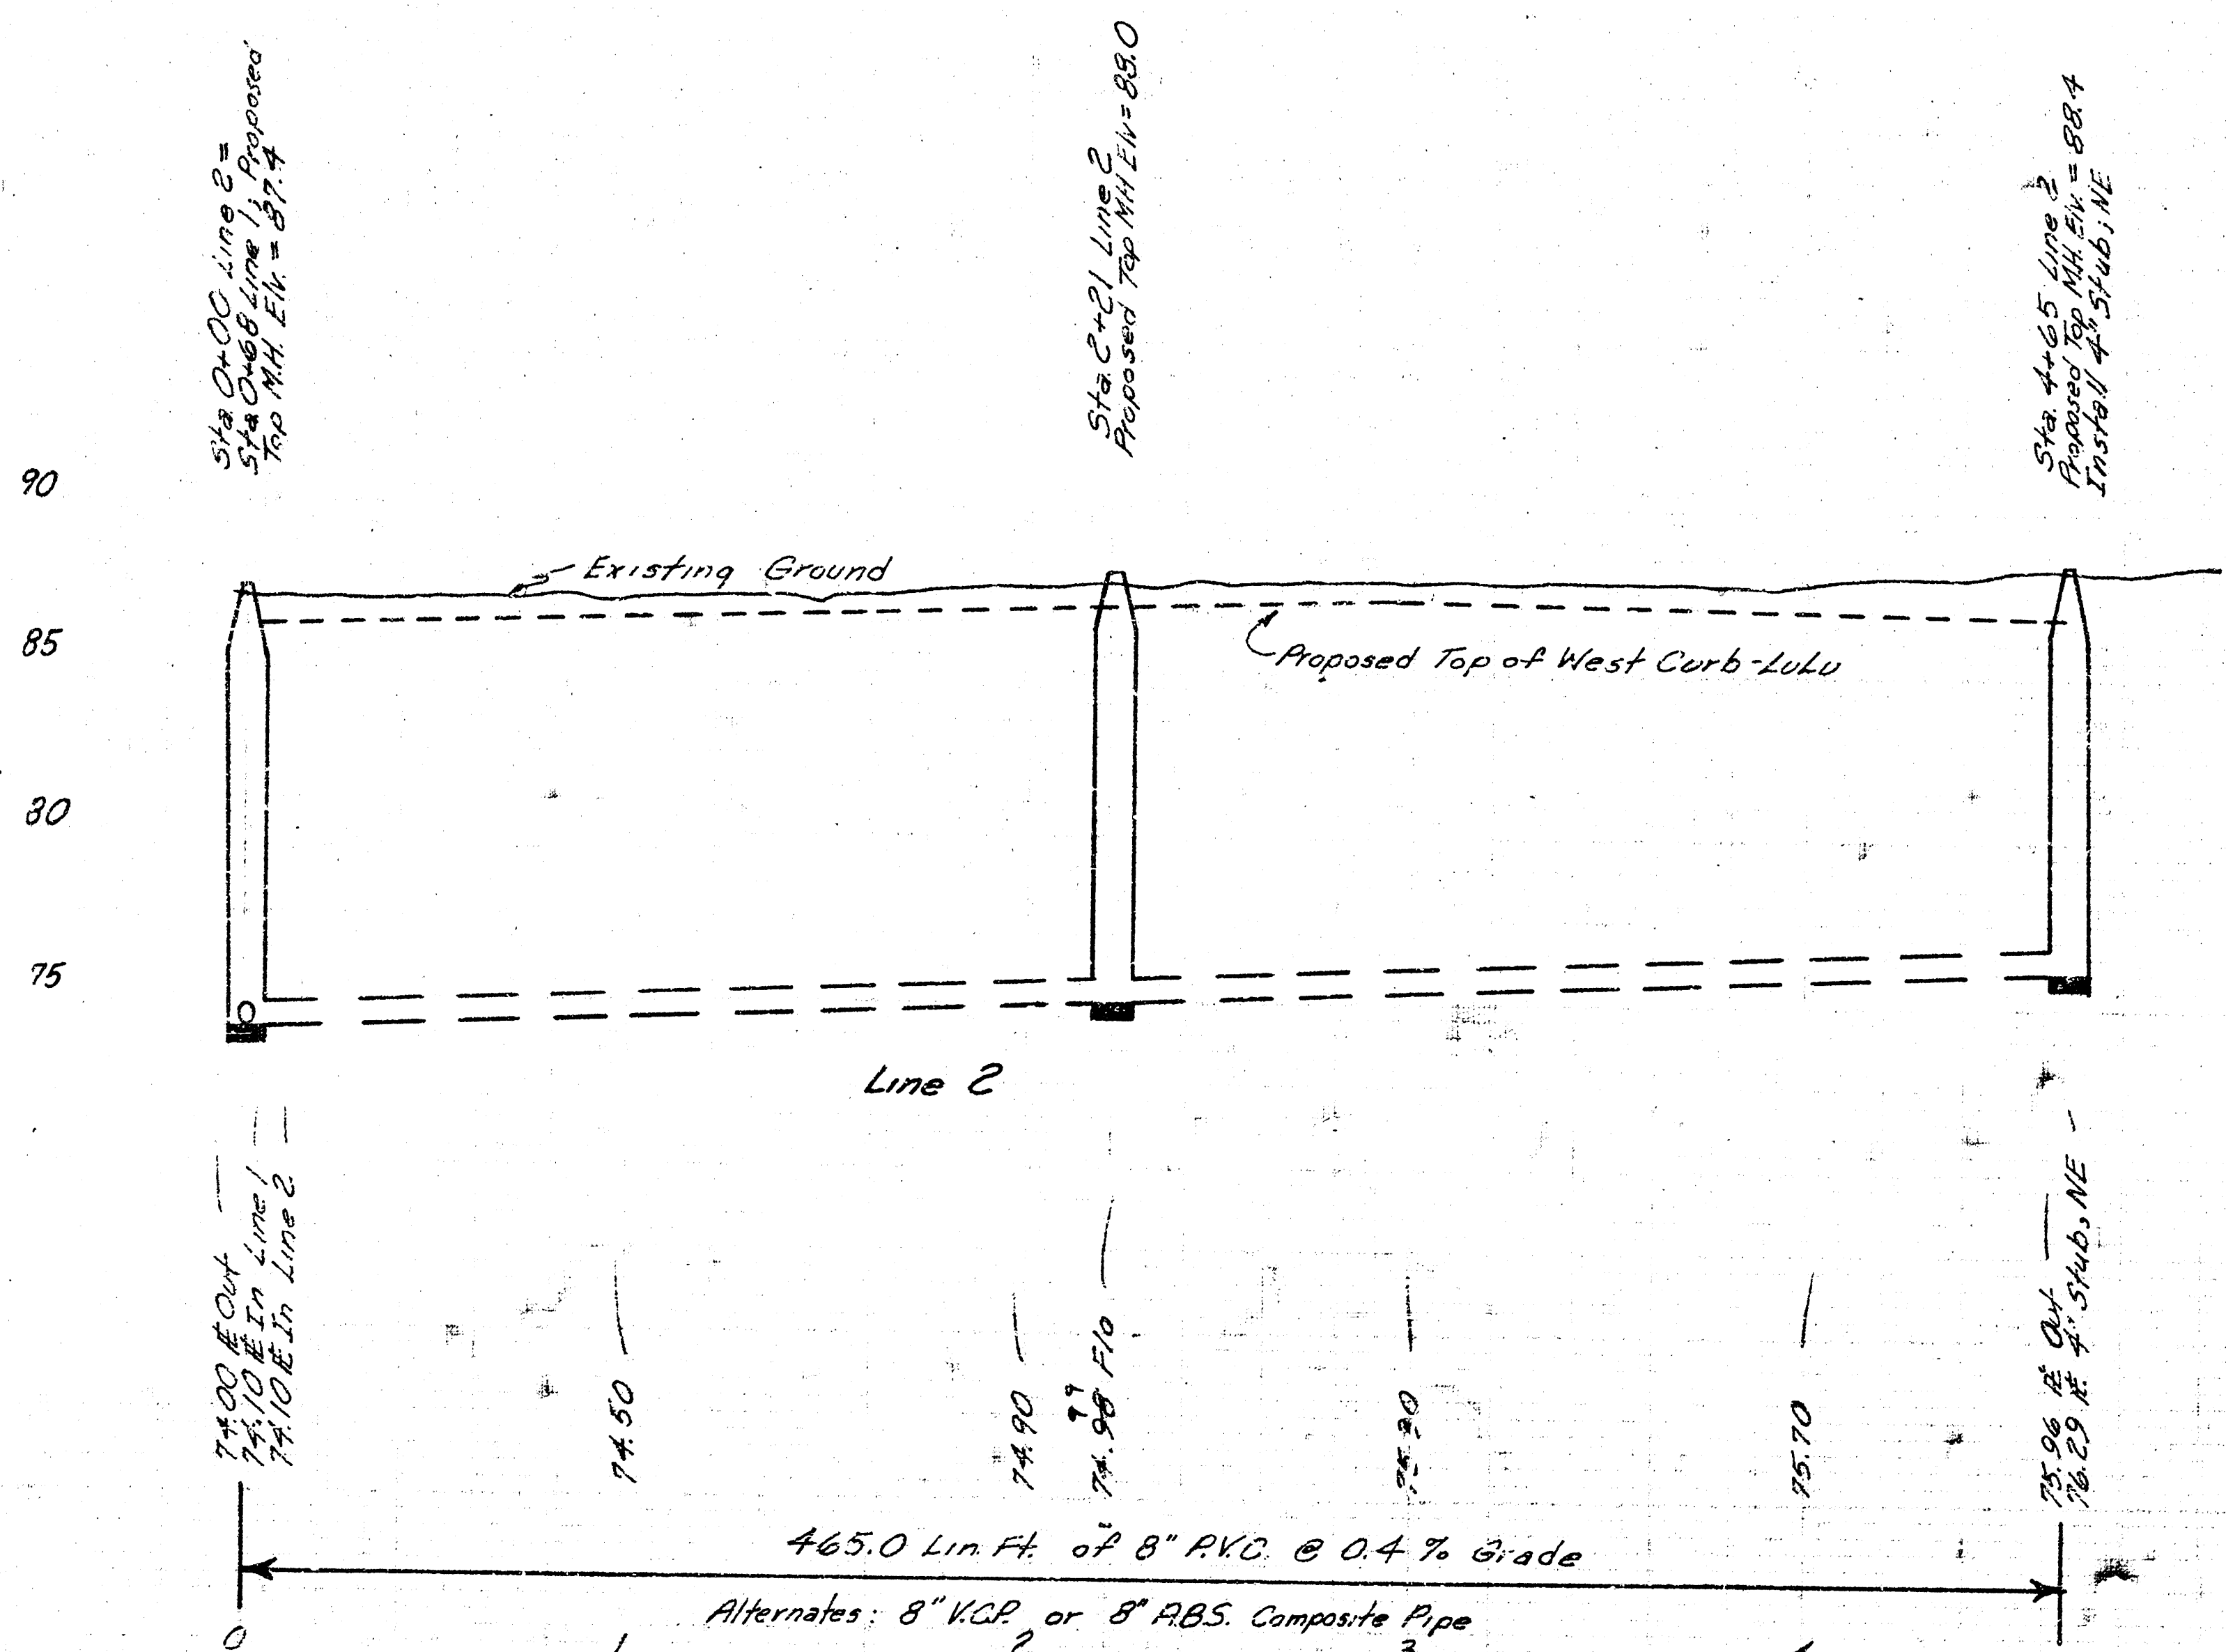

As Built
 12/8/1