


7




The contractor shall be responsible for preserving property irons. The contractor shall be required to re-establish any property irons which are damaged or destroyed by his construction operations. Such irons shall be re-established by a licensed land surveyor or a licensed professional engineer in accordance with state laws.

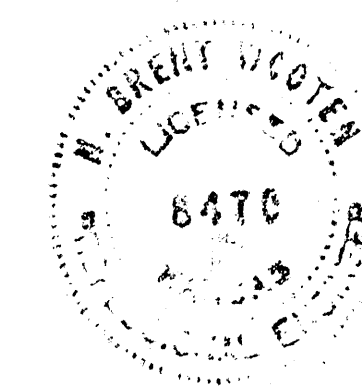

— CITY OF WICHITA


—R. W. BRUGGEMAN—
DIRECTOR OF ENGINEERING

BAUGHMAN COMPANY, P.A.
SURVEYING & ENGINEERING
316/262-7771 • 359 LAURA • WICHITA, KANSAS 67211

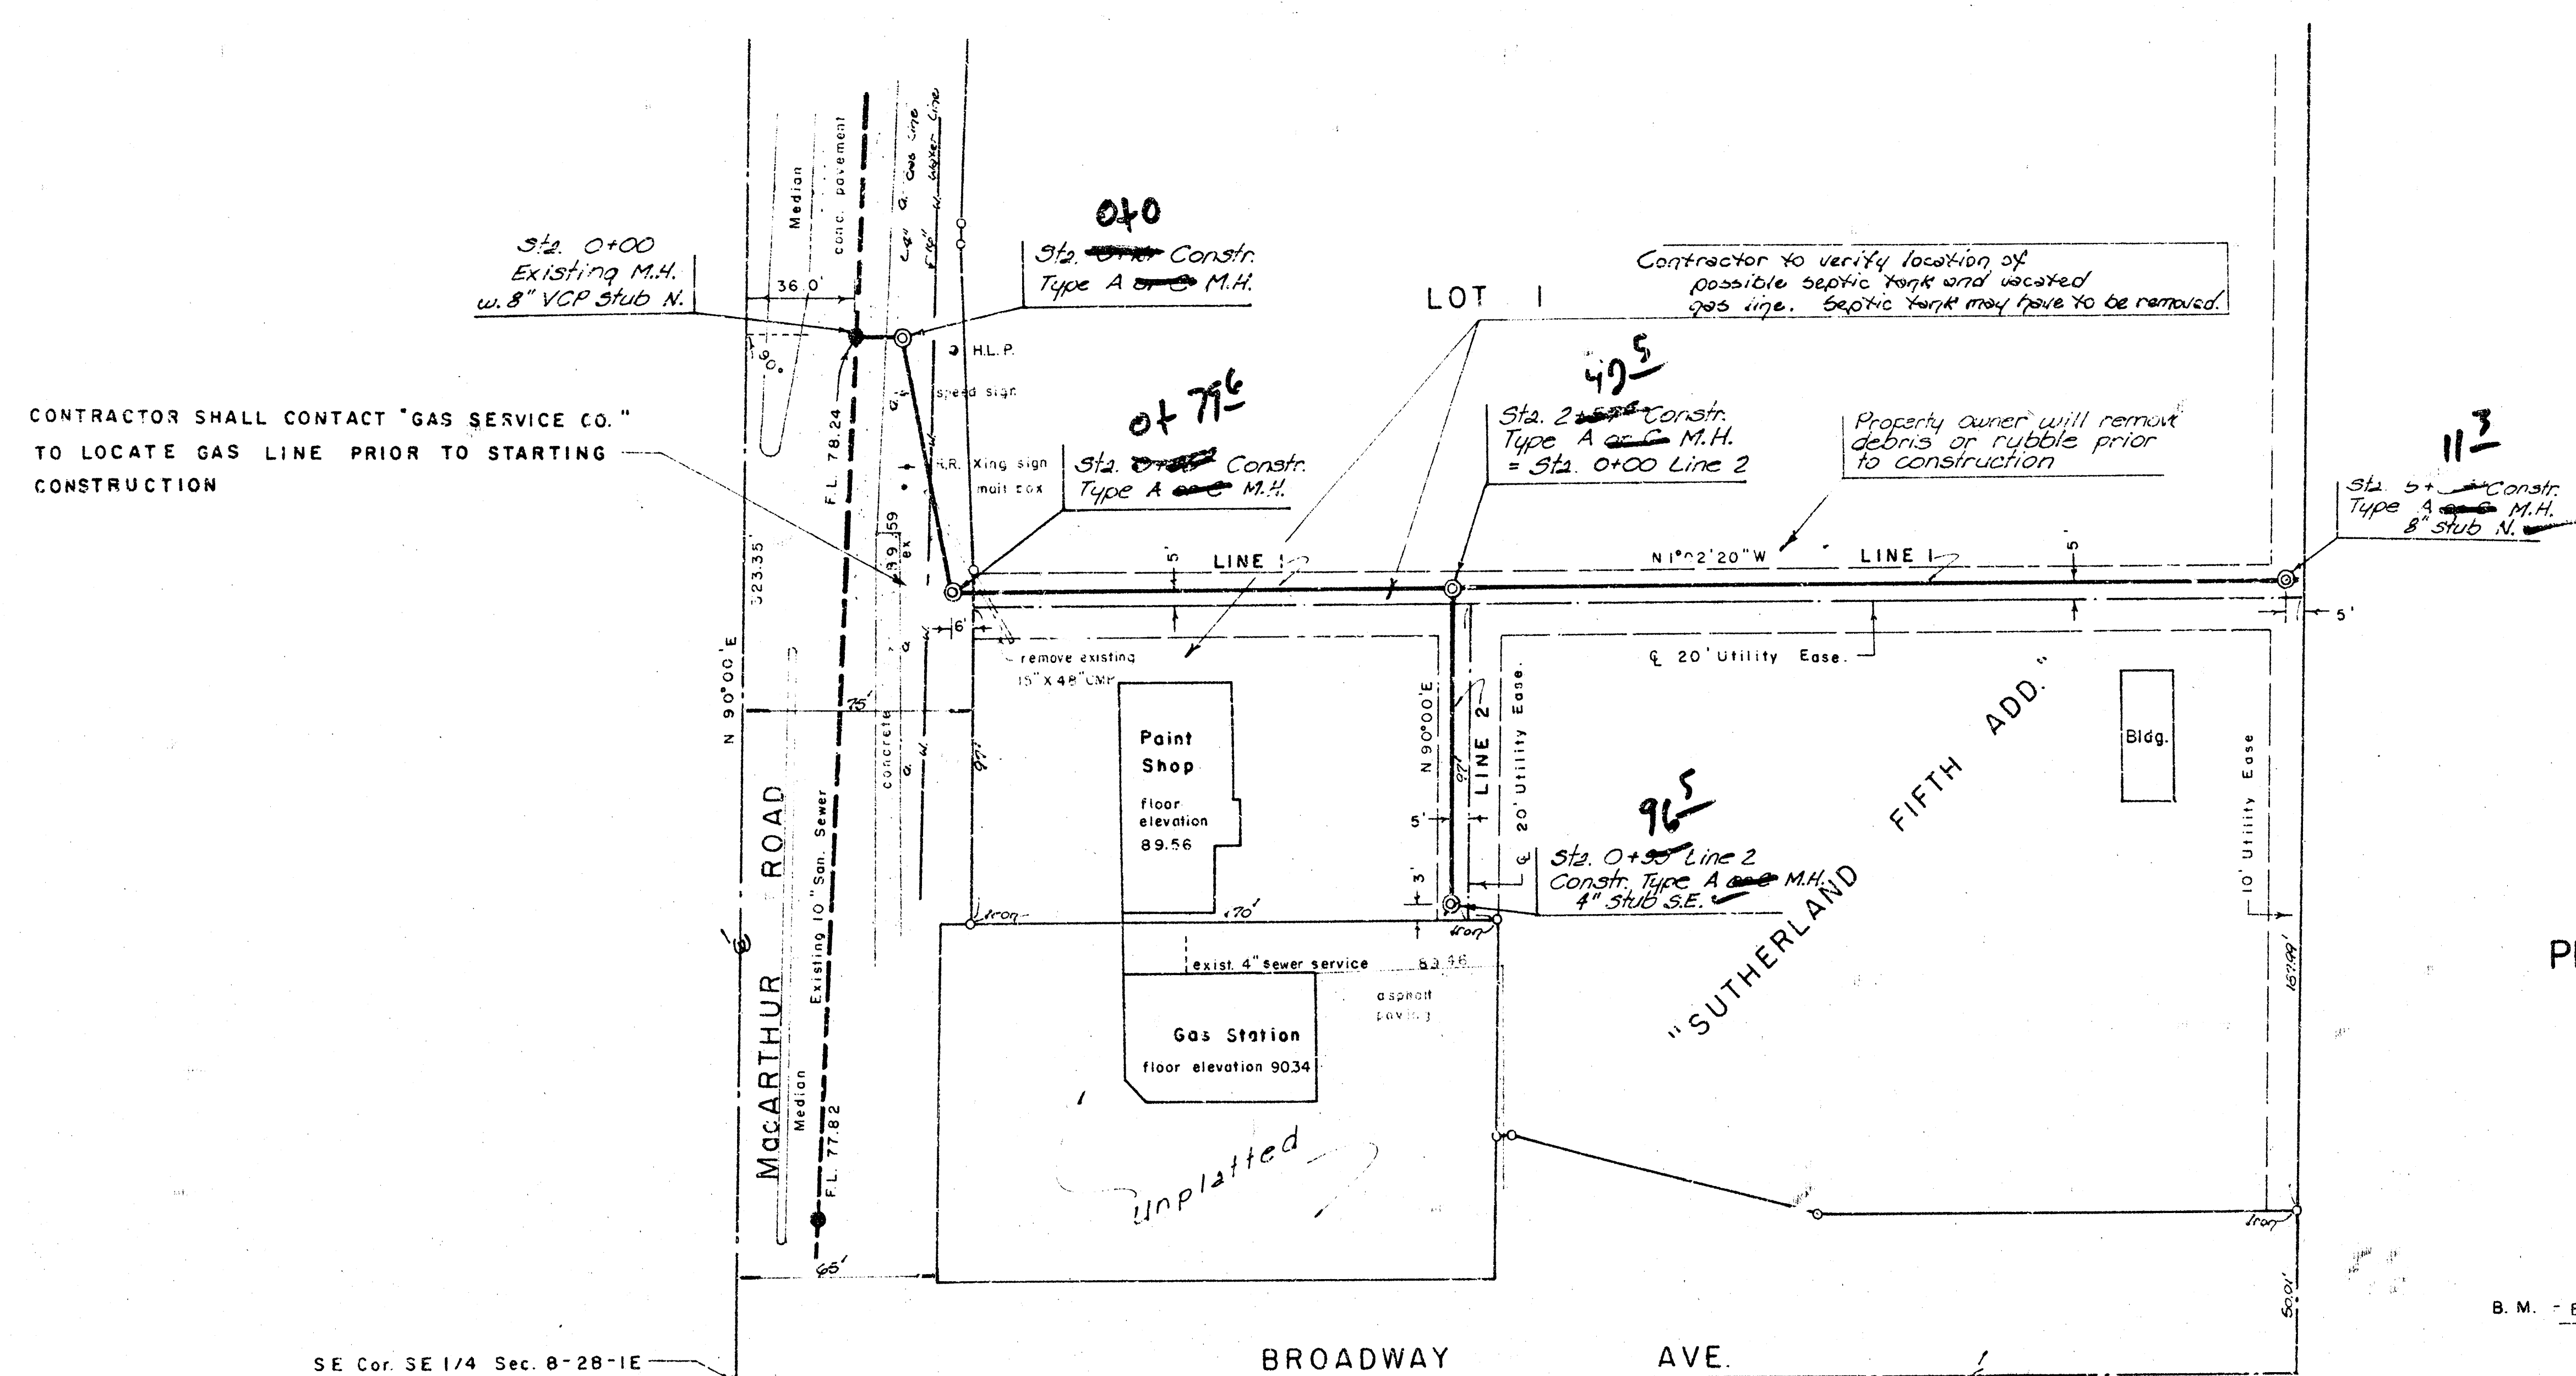


LATERAL 65
MAIN I
SOUTHWEST INTERCEPTOR
PROJECT NO. 468 76 245 81159 000 000 001

As Built
8/82
1/82

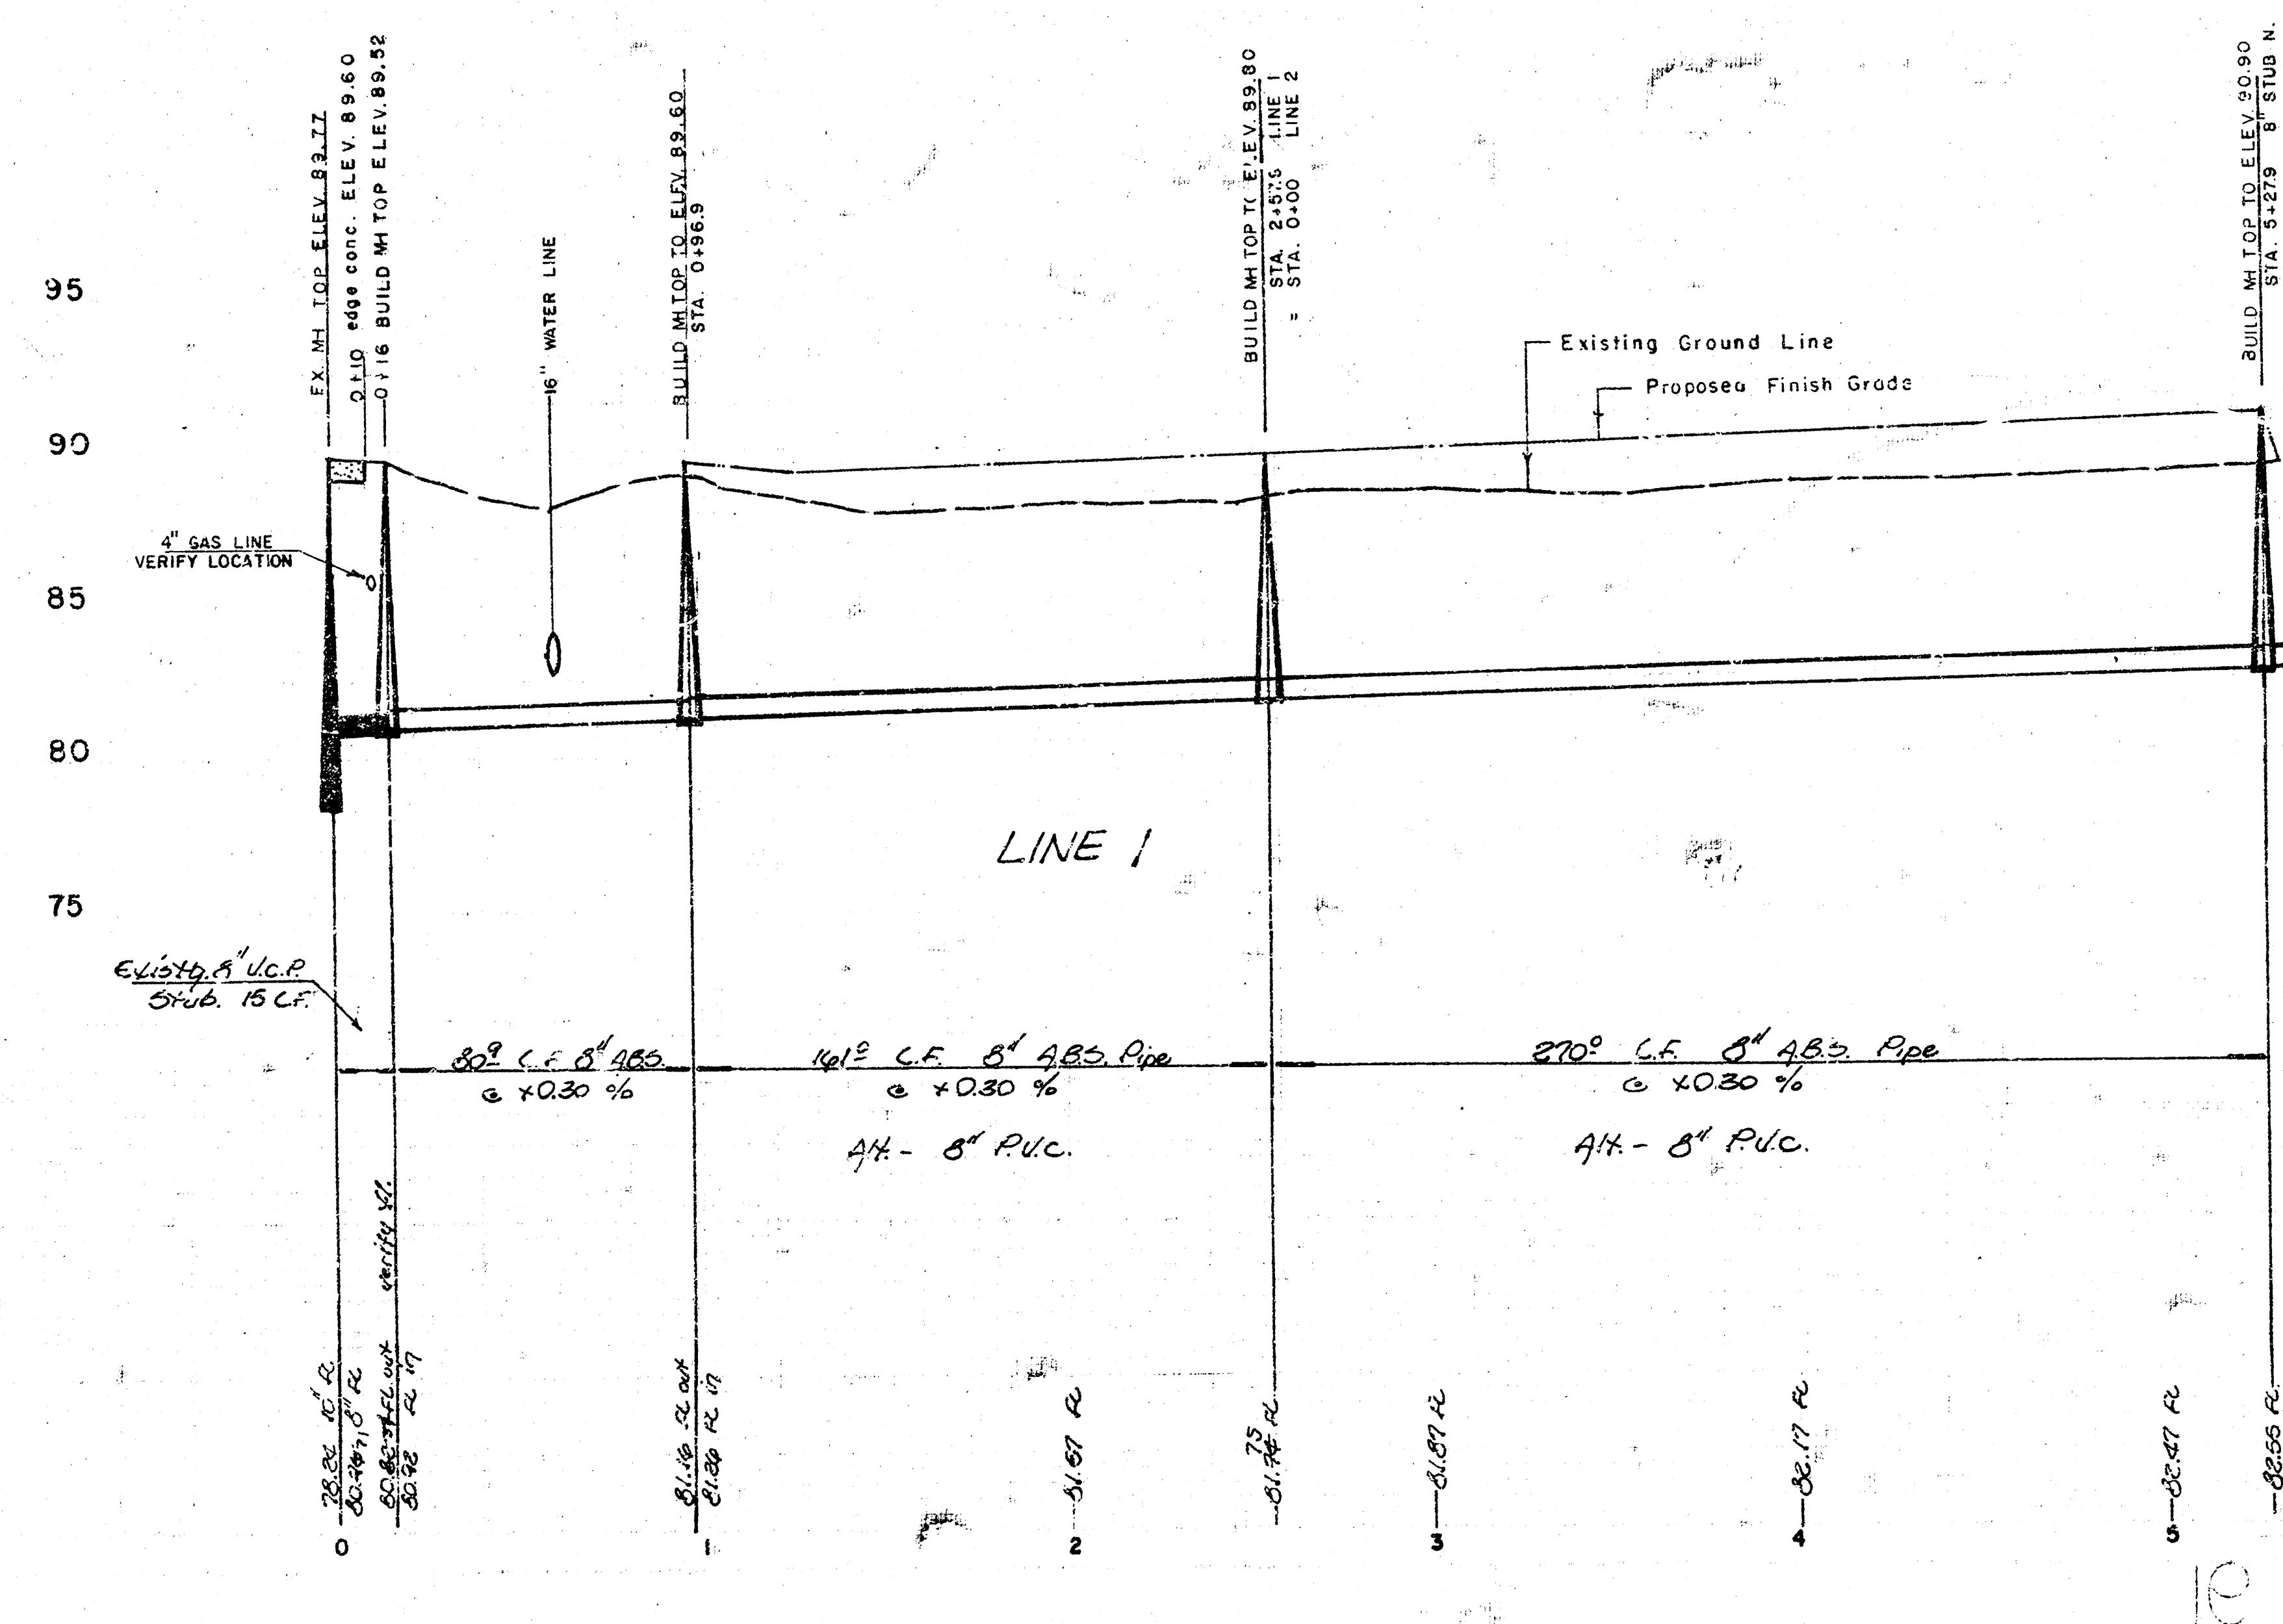

95 95
90 90
85 85
80 80
75 75

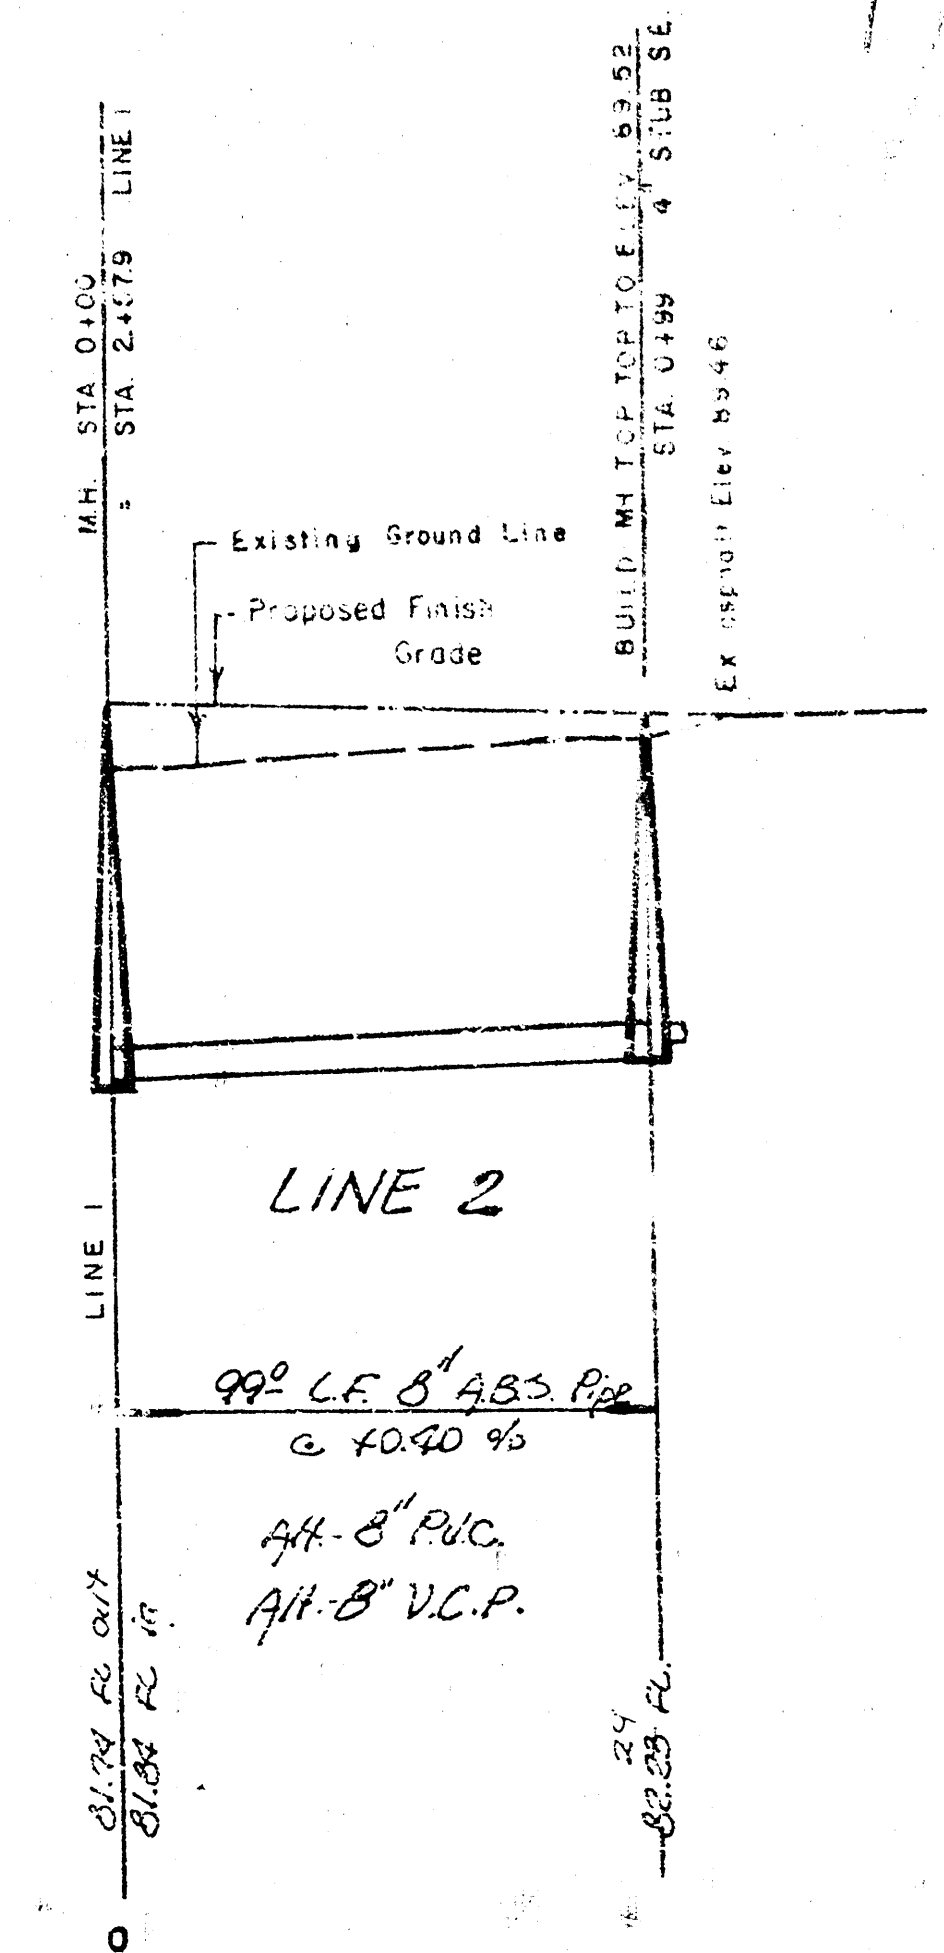

95
90
85
80
75

LAT. 65, M. I., S.W.I.