


B. M. 88.30 "d" cut top, S.E. cor.
conc. base for Bidwell Village
Sign on N.W. cor. Broadway &
43rd St. So.

B. M. 87.72 N.E. cor. Conc. Patch
Ho # 4401 So. Market.

Sta. 0100.0 Beg. Siphon
Exist. manhole.
Exist. 8.5"-8" Ductile Iron
pipe (PE-MU) east.

Field Engineer to make 'ties' to all irons.
Irons disturbed or destroyed are to be replaced.

Contractor shall not remove any trees without
prior approval from the Field Engineer.

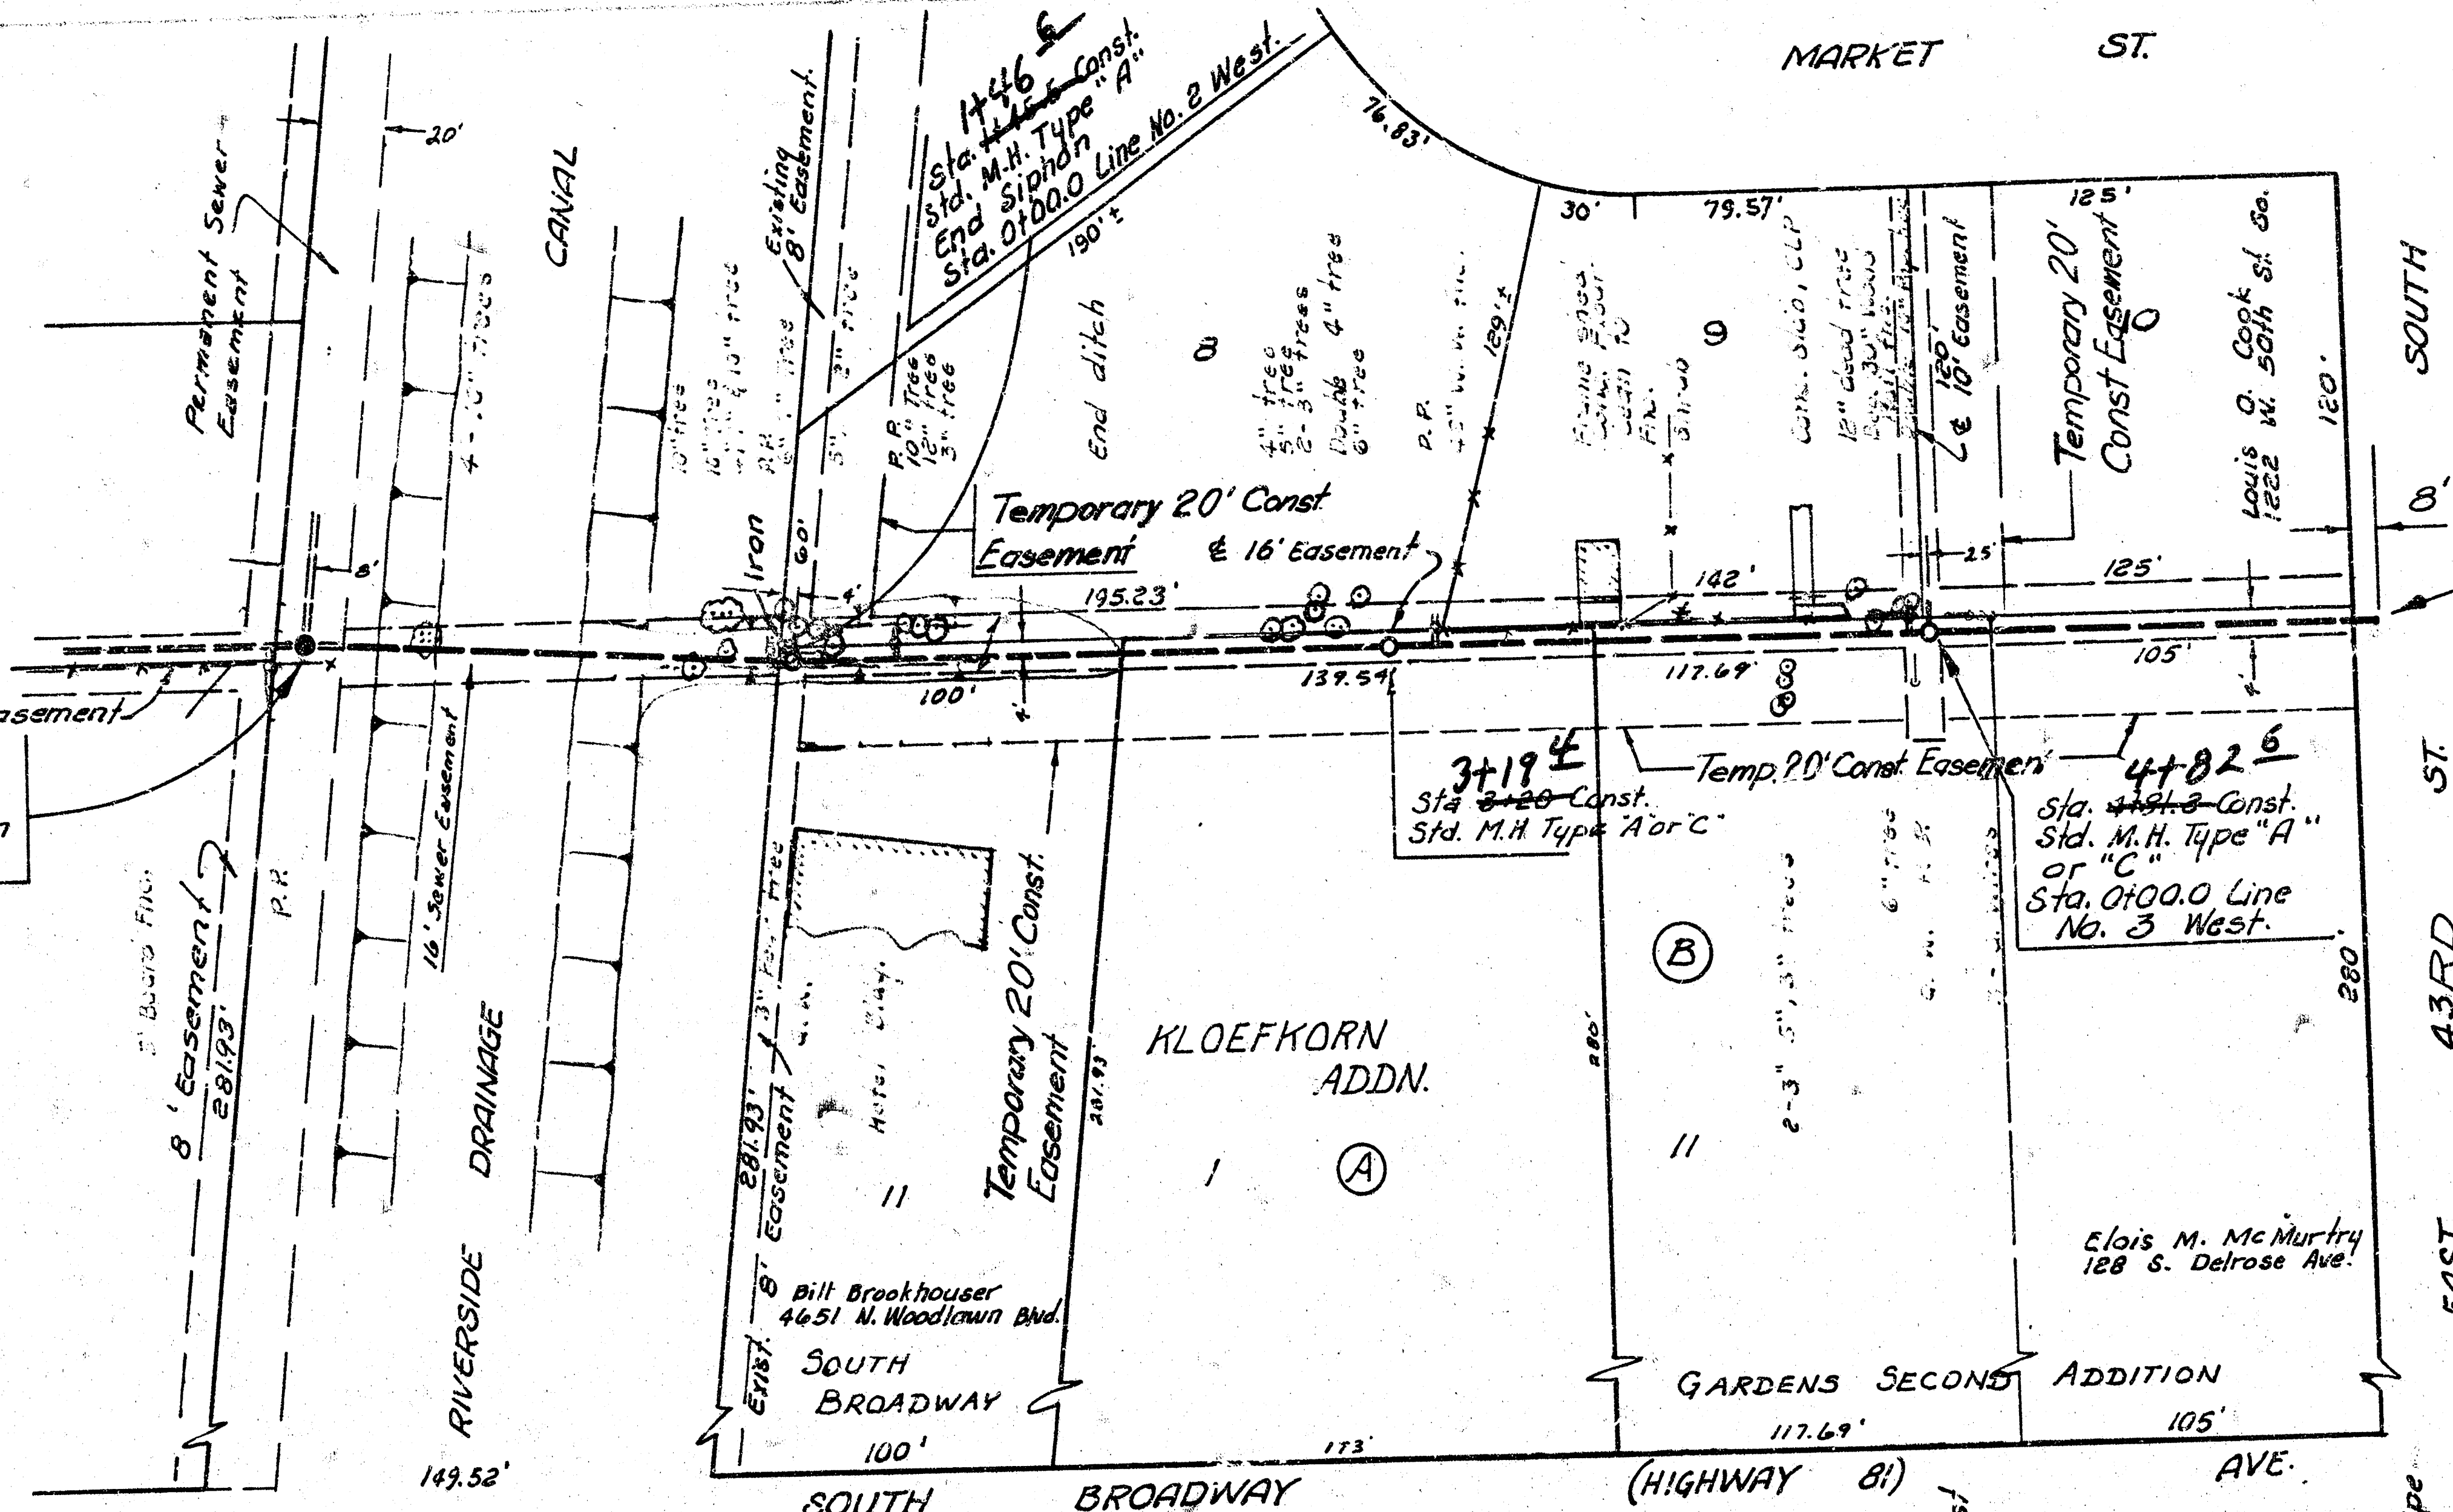


Plan Scale 1" = 40' Horiz.
Profile Scale 1" = 5' Vert.

NOTE:
Owner of lot 8 and the south
100 ft. of lot 11 Block B wants
all trees removed for fire waste
wood.
City lateral across south 100 ft.
of lot 11 Block B will cut Septic
tank main line and lateral field.

GENERAL NOTES


BACKFILL IN CHANNEL RIGHT-OF-WAY SHALL BE EXCAVATED MATERIAL COMPACTED TO A MINIMUM DENSITY OF 90% OF STANDARD DENSITY. COMPACTION OF EXCAVATED BACKFILL MATERIAL SHALL BE CONSIDERED AS SUBSIDIARY TO THE OTHER ITEMS OF WORK. TEMP SUM BID FOR SIFON DOES NOT INCLUDE MANHOLE. AS SUBSIDIARY TO THE OTHER ITEMS OF WORK, CONTRACTOR WILL BE REQUIRED TO NOTIFY PROPERTY OWNERS MANHOLE WILL BE PAID FOR SEPARATELY. CONTRACTOR WILL BE REQUIRED TO NOTIFY PROPERTY OWNERS ADJACENT TO AND ALONG THE NORTH SIDE OF THE RIVERSIDE DRAINAGE CANAL SUFFICIENTLY IN ADVANCE OF CONSTRUCTION OF LINE #2 SUCH THAT THESE PROPERTY OWNERS MAY HAVE THE OPPORTUNITY TO TRANSPLANT TREES AND TREES OR OTHERWISE SALVAGE IMPROVEMENTS ENDANGERED BY THE SEWER CONSTRUCTION. CONTRACTOR WILL ALSO BE REQUIRED TO NOTIFY THE OWNER OF LOT 6, BLOCK 8 OF THE NECESSITY OF MOVING THE SHED WITH A CONCRETE FLOOR PRIOR TO CONSTRUCTION OF THE SEWER. OWNER SHALL BE GIVEN AN OPPORTUNITY TO MOVE THIS SHED WITH A CONCRETE FLOOR AS A PART OF THIS CONTRACT IF IT IS NOT MOVED BY THE PROPERTY OWNER. THE SHED AND ITS CONCRETE FLOOR IN ITS NEW LOCATION SHALL BE EQUAL TO OR BETTER THAN ITS CONDITION IN THE ORIGINAL LOCATION. THE BID PRICE OF SHED MOVED (CONCRETE FLOOR) SHALL INCLUDE ALL COSTS FOR MOVING THIS SHED INCLUDING REMOVING AND REPLACING THE CONCRETE FLOOR.

NOTE:
Use mechanical
joints fittings
in Siphon.

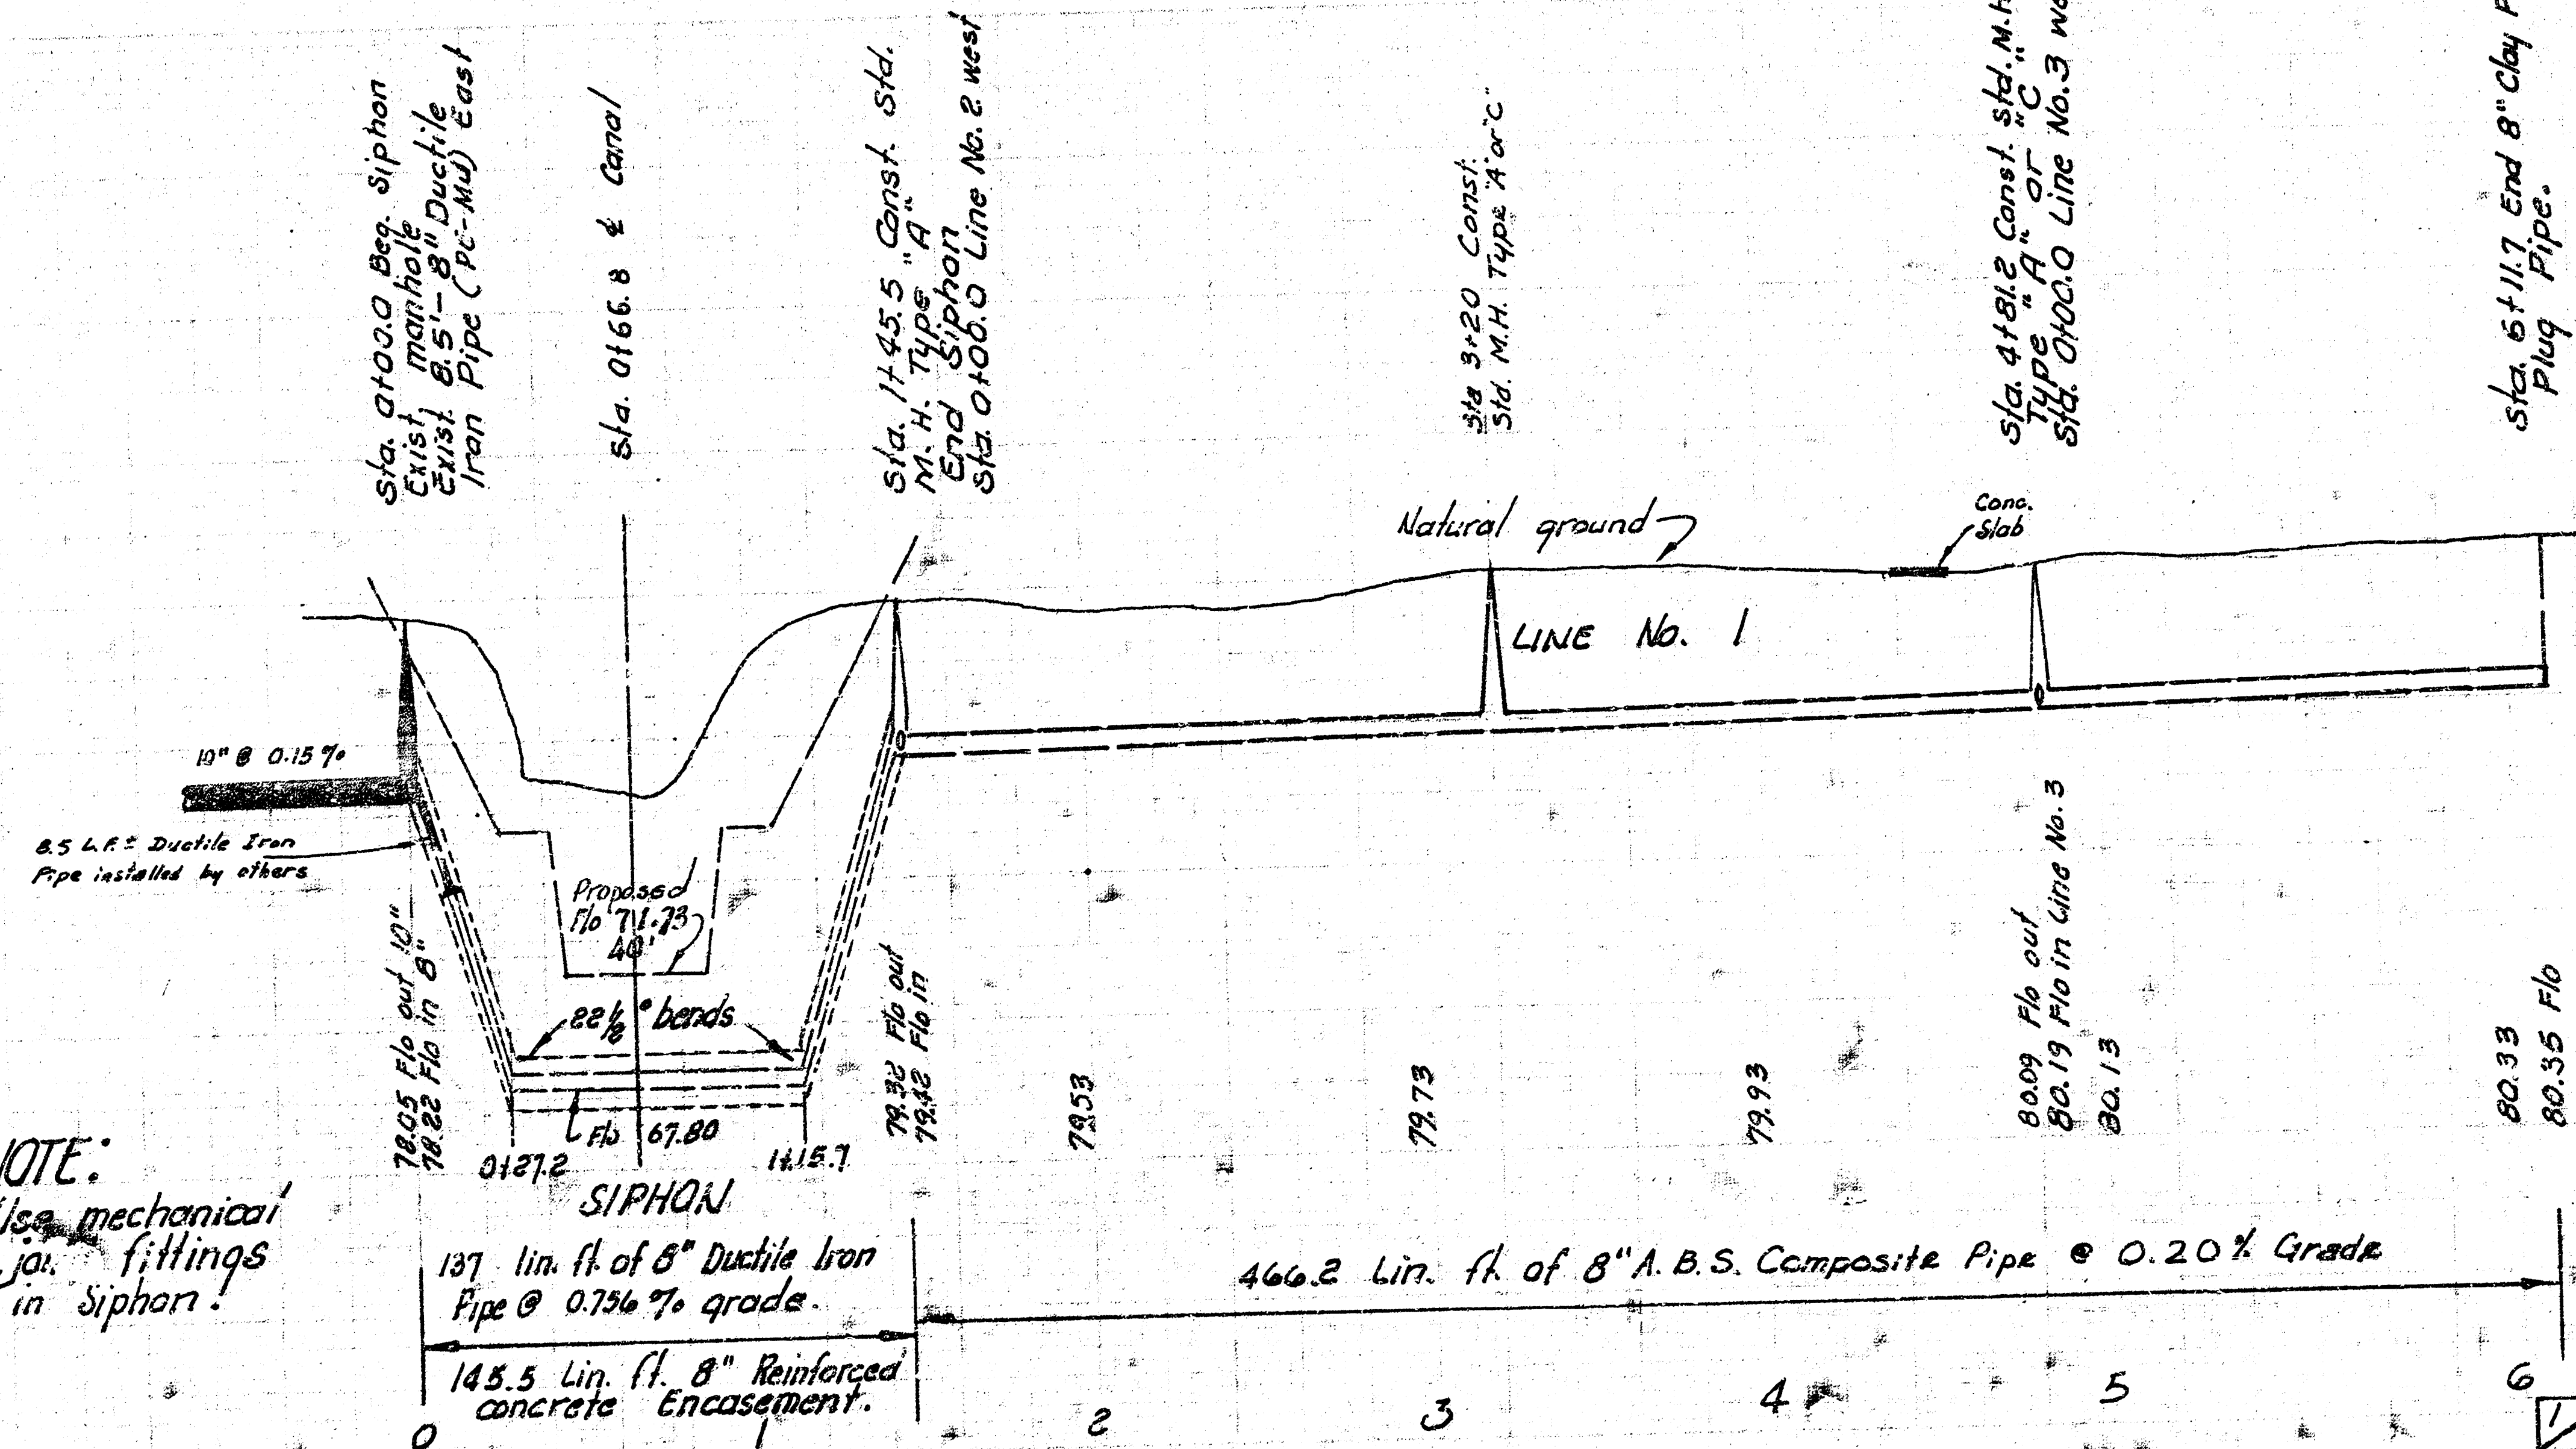



As built 4-27-77

LAT. 6, MAIN 2, S. W. INTERCEPTOR SEWER	
CITY OF WICHITA, KANSAS	
R. W. LINN	CITY ENGINEER
MARCH 1975	PROJECT NO. DBKL 57 20 2

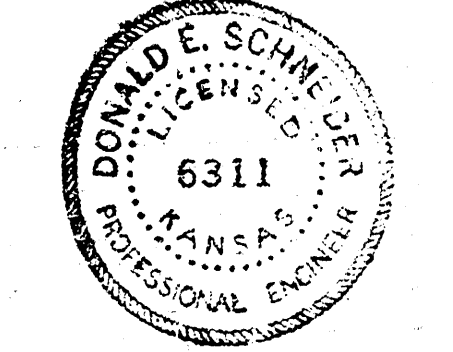

B. M. 8998 R. R. Spike N.W. Side P. File
on S.E. cor. Main & 43rd St. So.



Sta. 0+00.0 Line No. 2 =
Sta. 1+45.5 Line No. 1

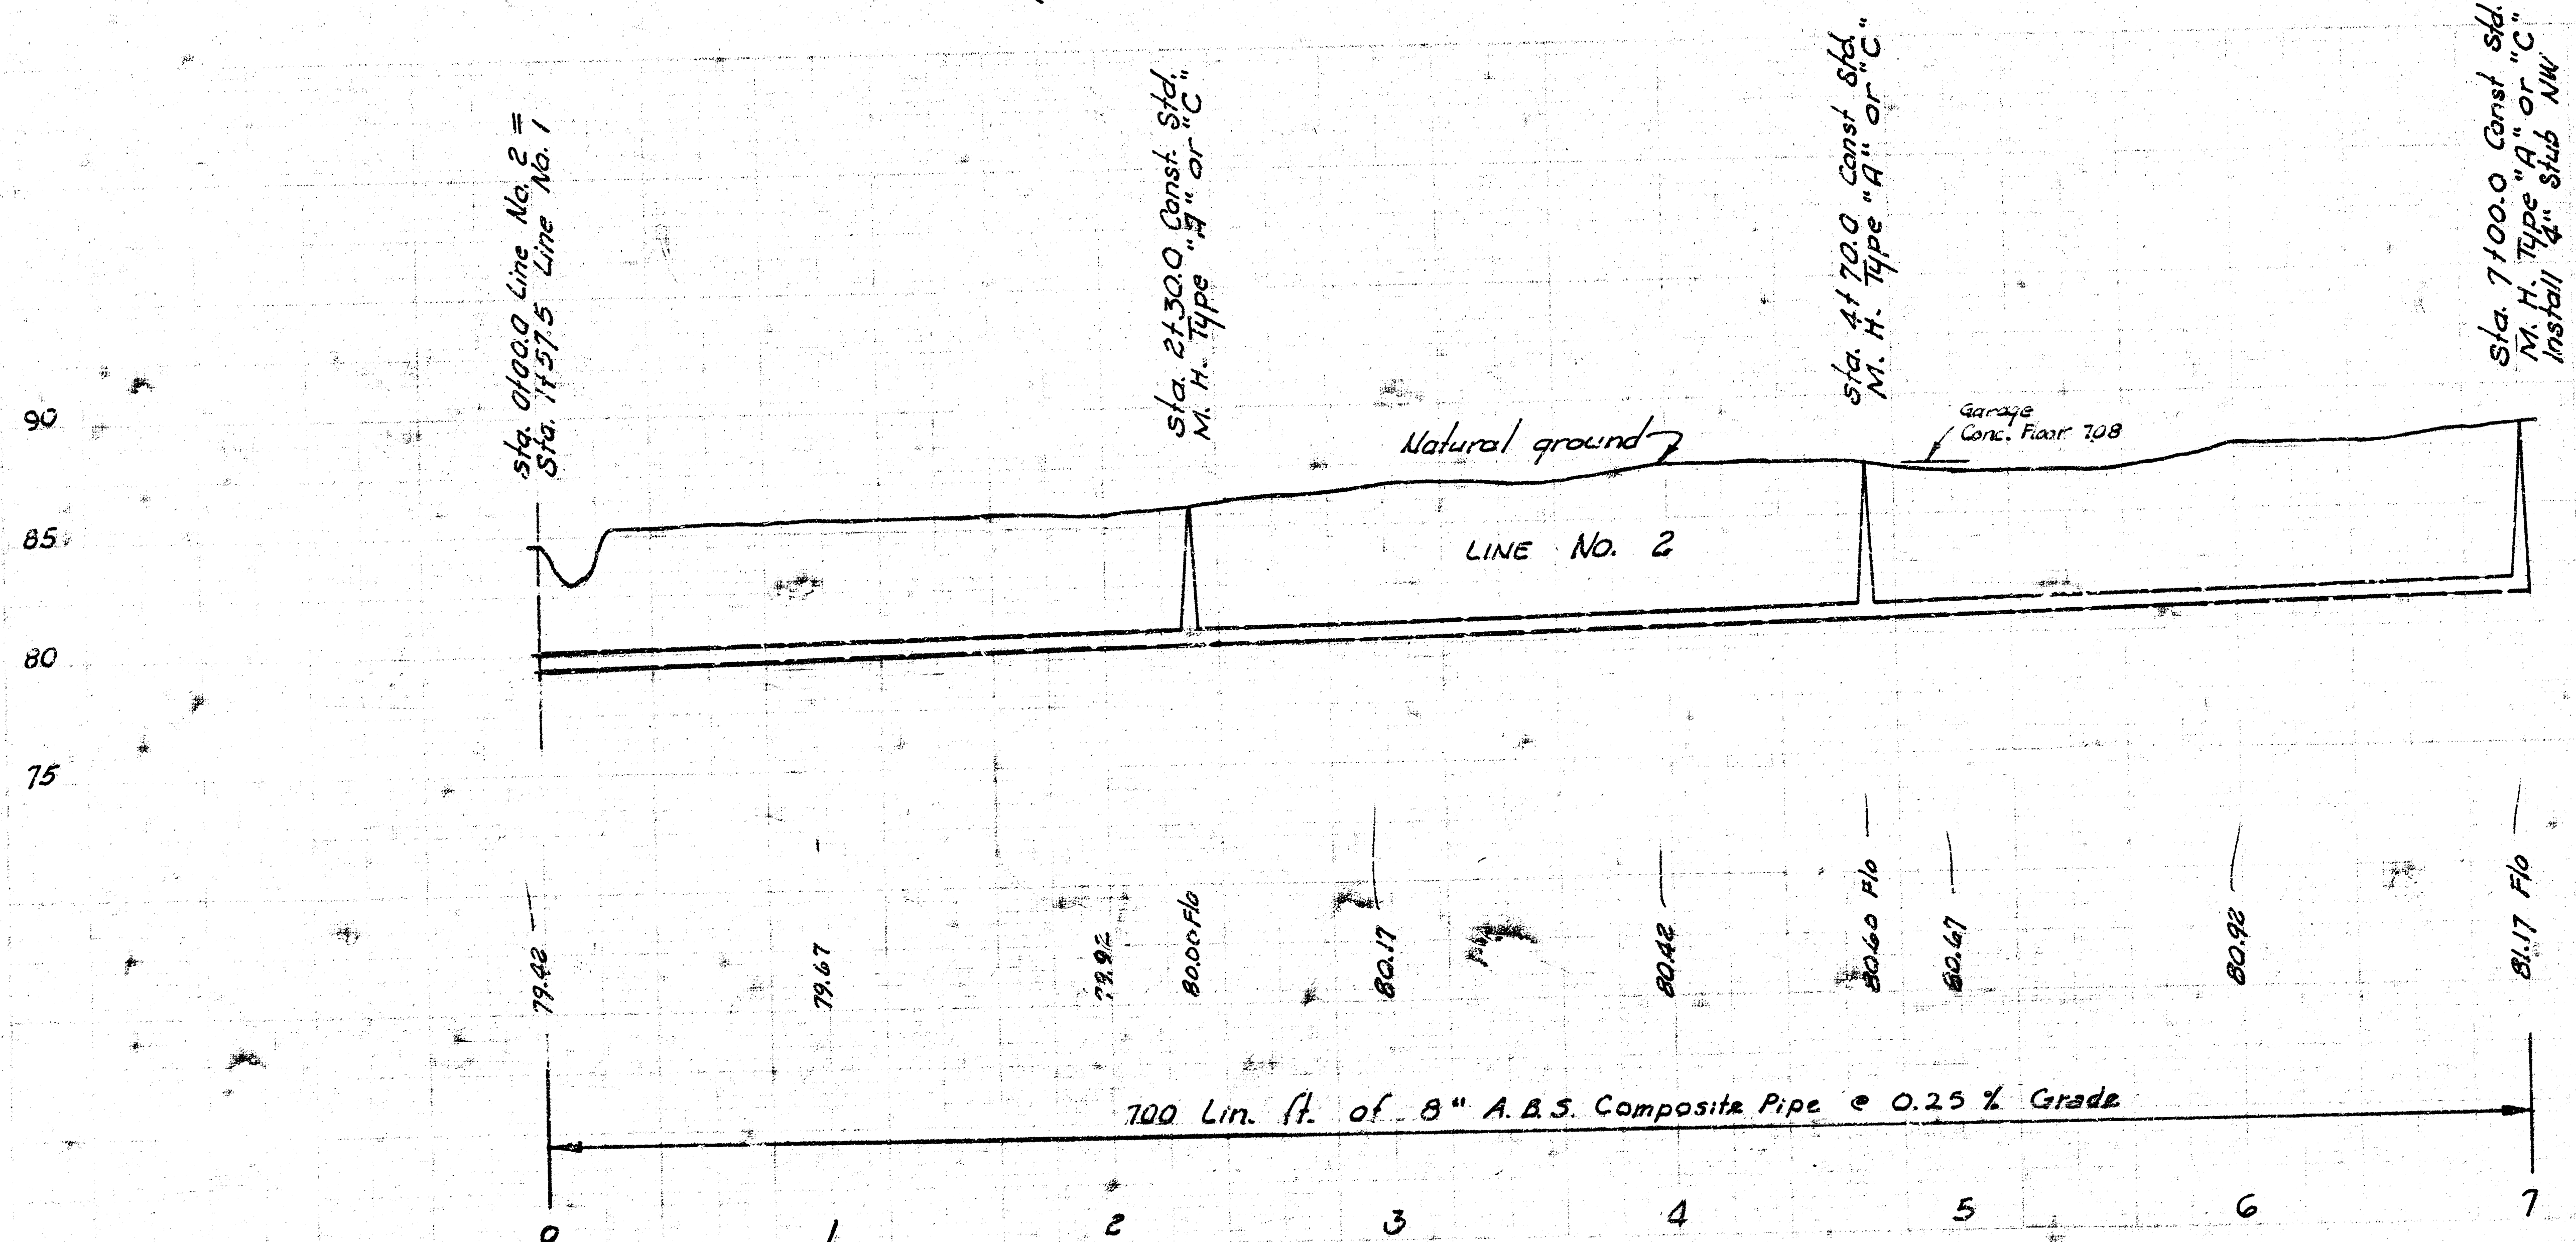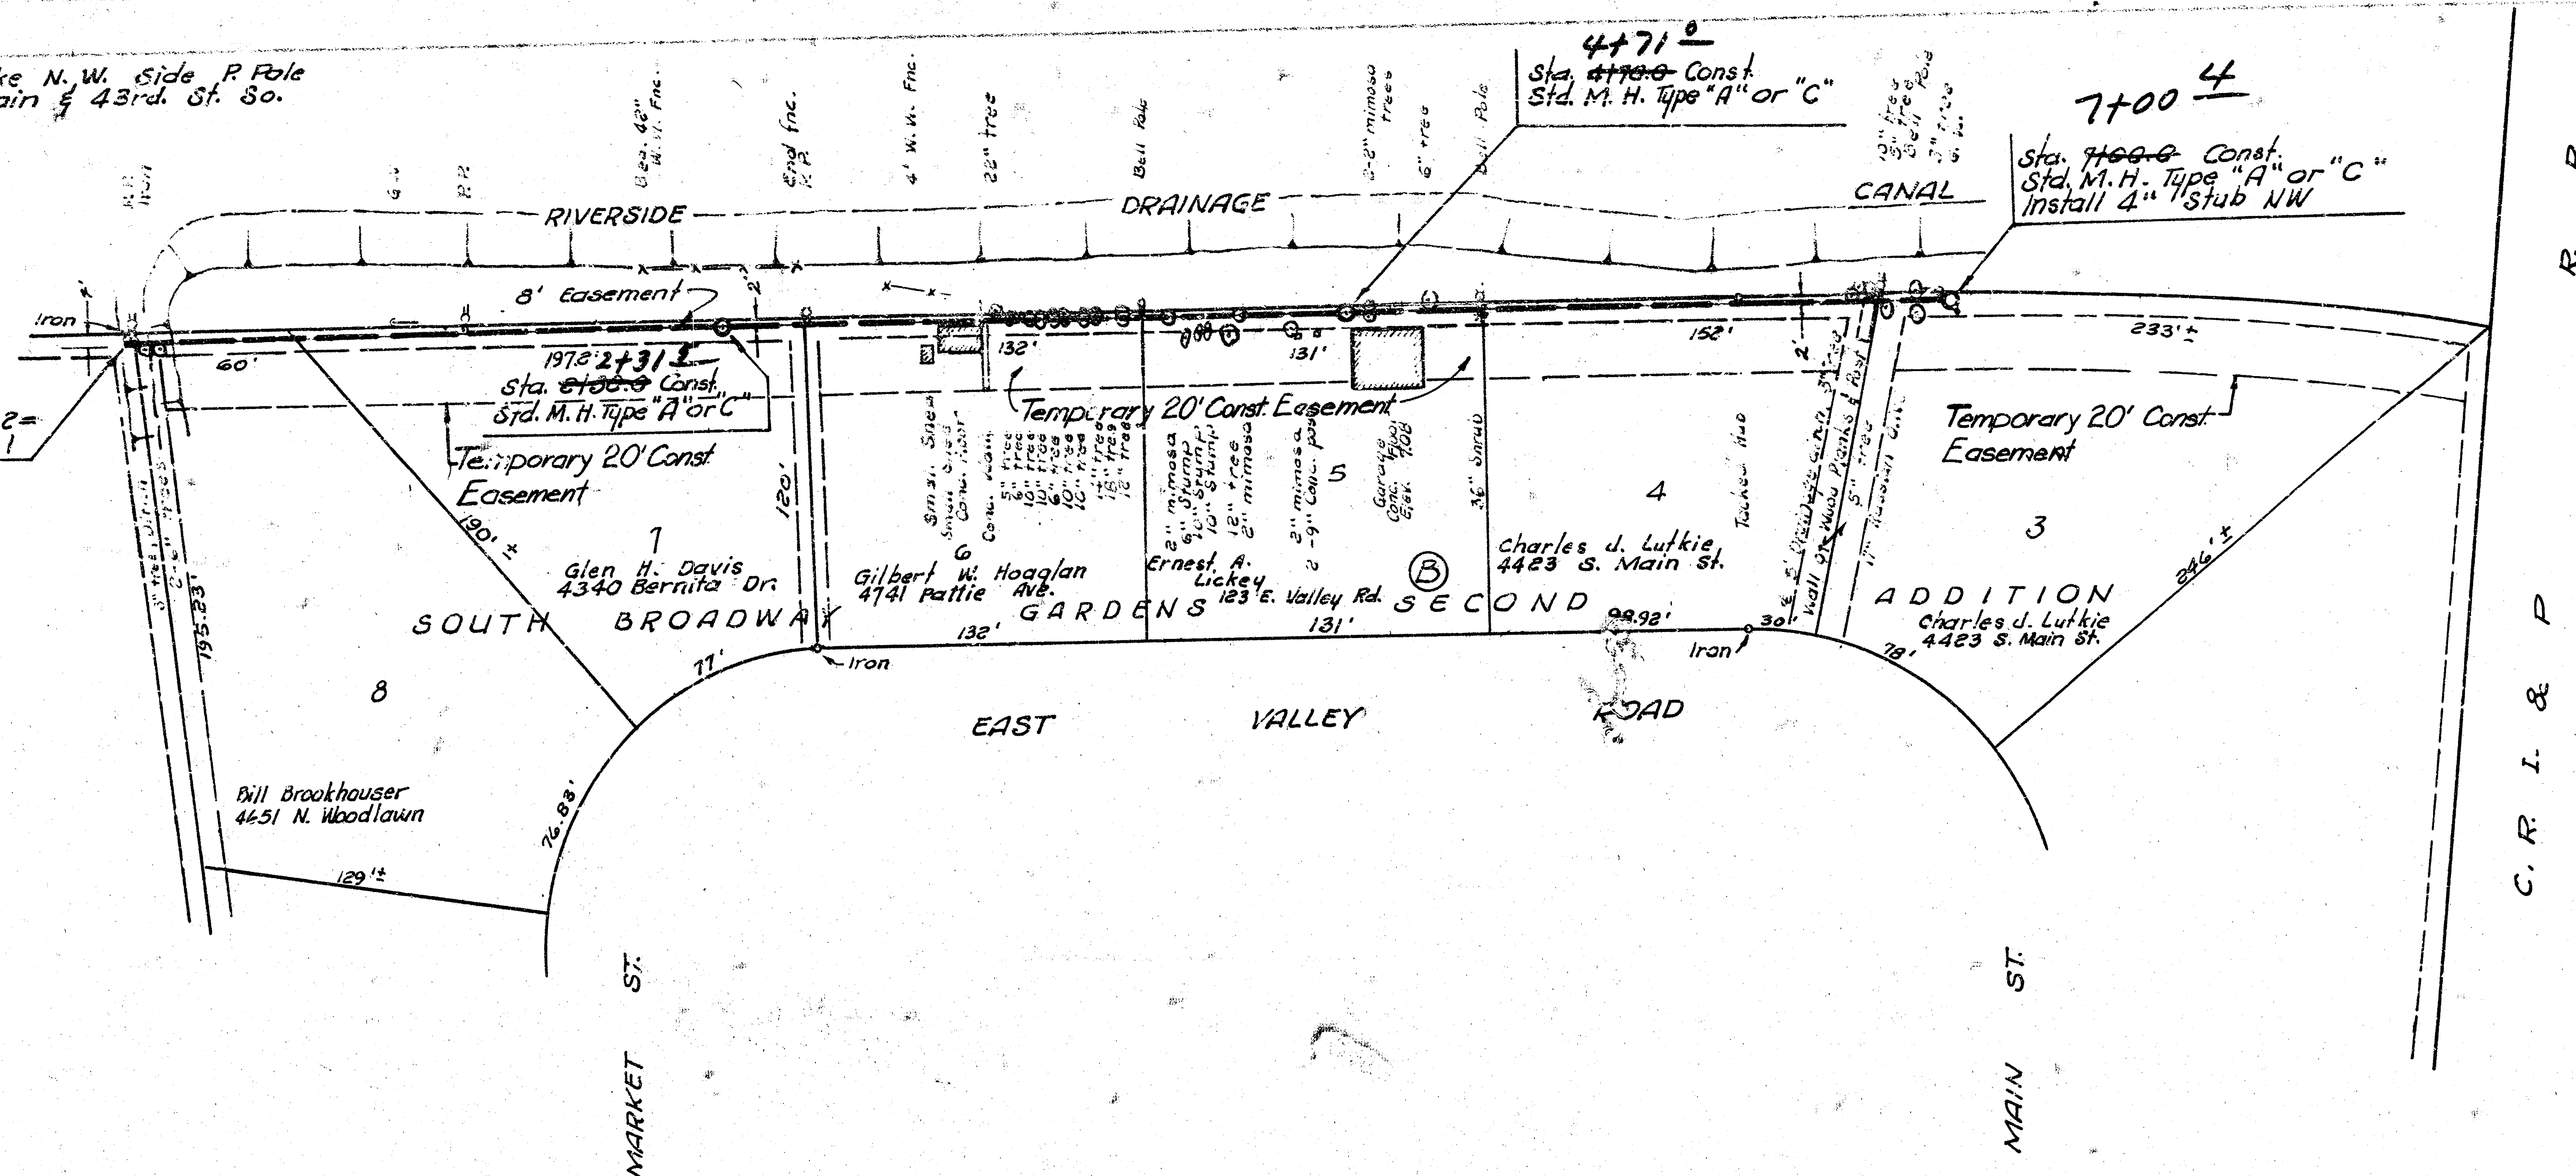

LAT. 6, MAIN 2, S.W. INTERCEPTOR SEWER
PROJECT NO. DBKL572023

B. M. 85.98 R. R. Spike N. W.
side P. Pole on S. E. cor.
Main & 43rd St. So.

SOUTH BROADWAY GARDENS SECOND ADDITION

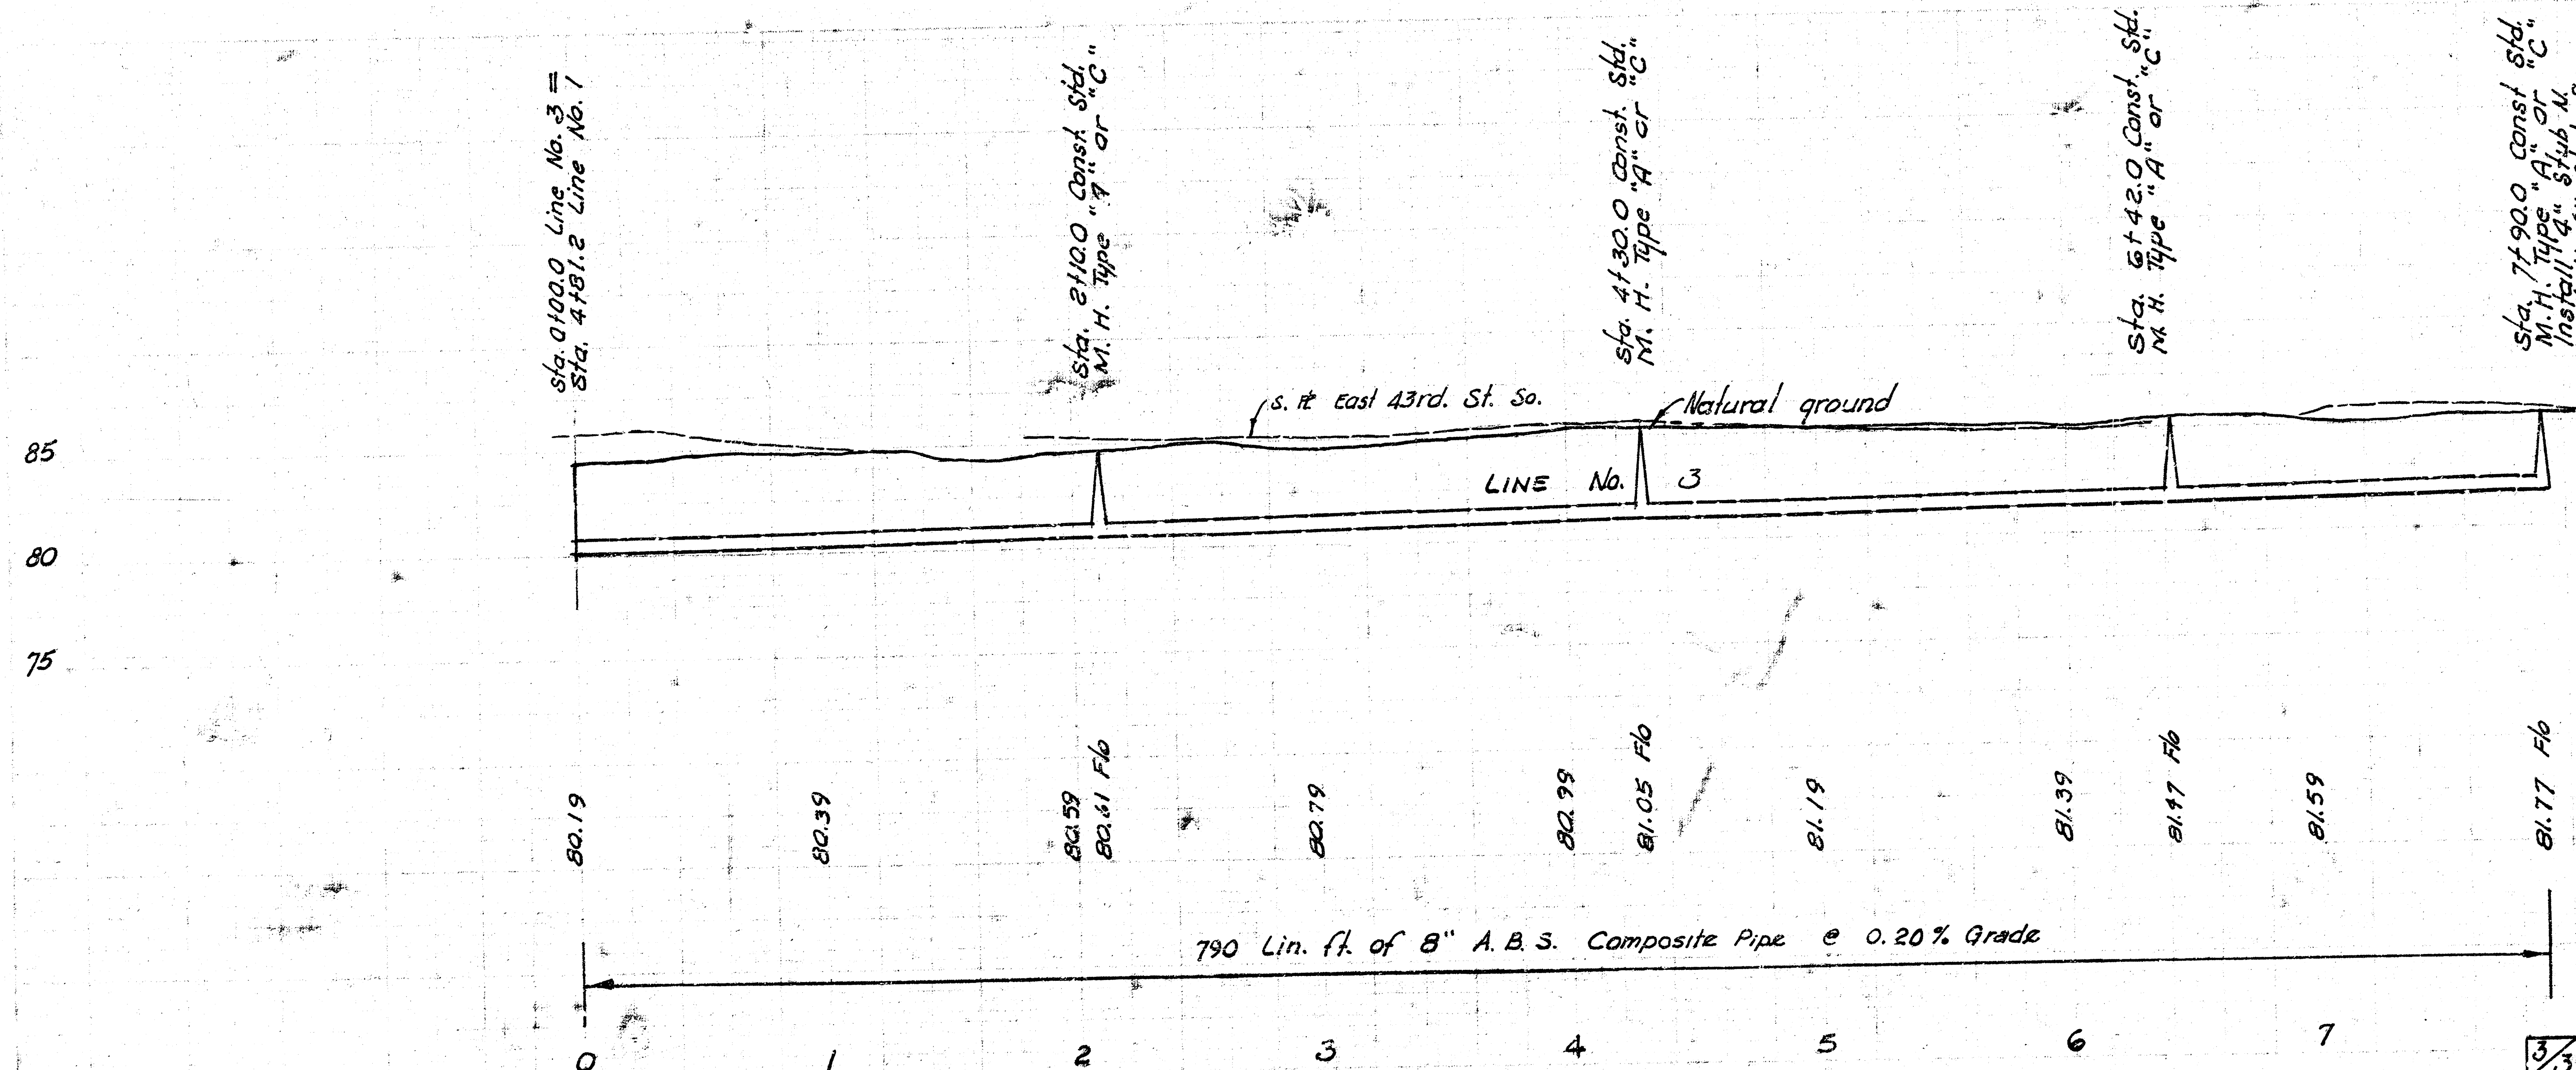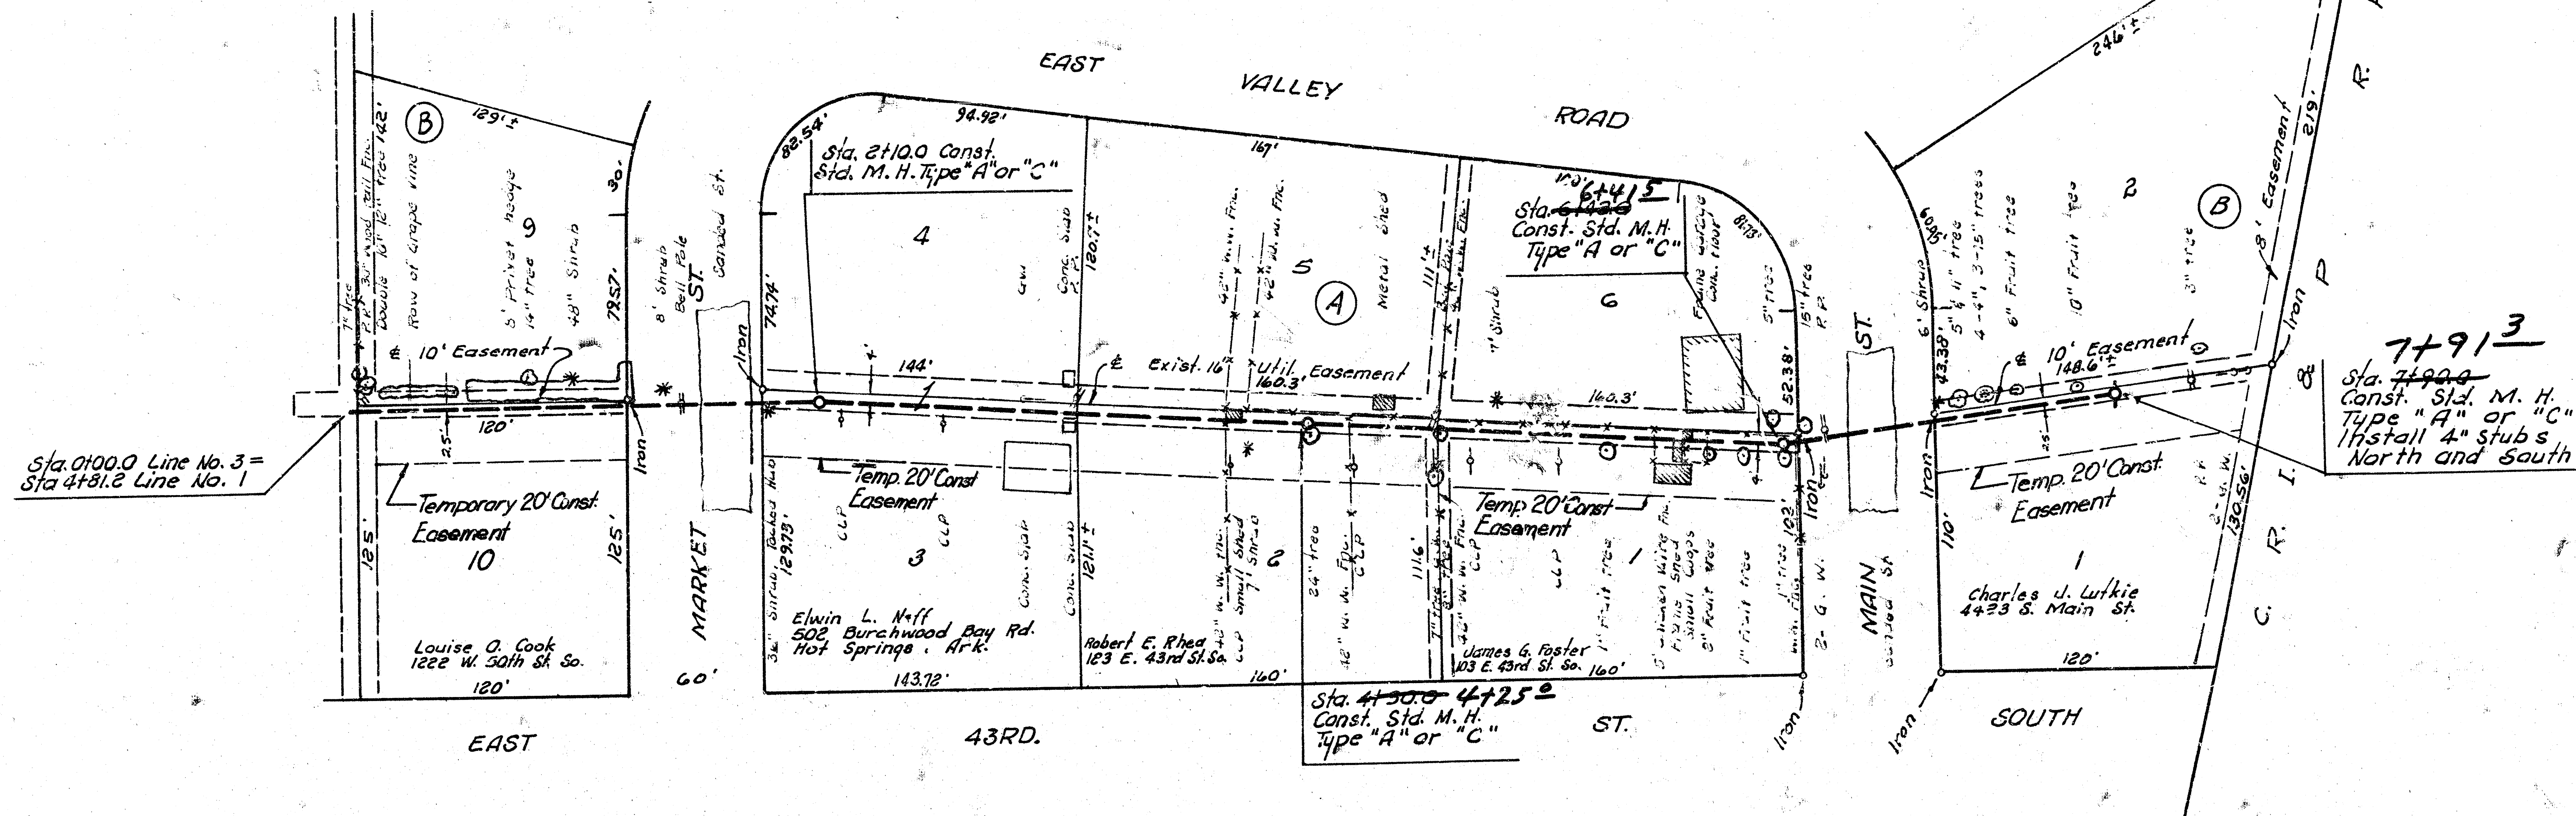

LAT. 6, MAIN 2, S. W. INTERCEPTOR SEWER
PROJECT NO DBKL 572023