


Riverside 4TH Addition

SCALE: 1"=40' Plan
 Horiz. 1"=40' Profile
 Vert. 1"=5'



Bench Mark: 81.23 - City Std. Disc. South Side of
 Conc. Wk. North Side of Bridge on
 55th St. South, approx. 550' West
 of Washington.

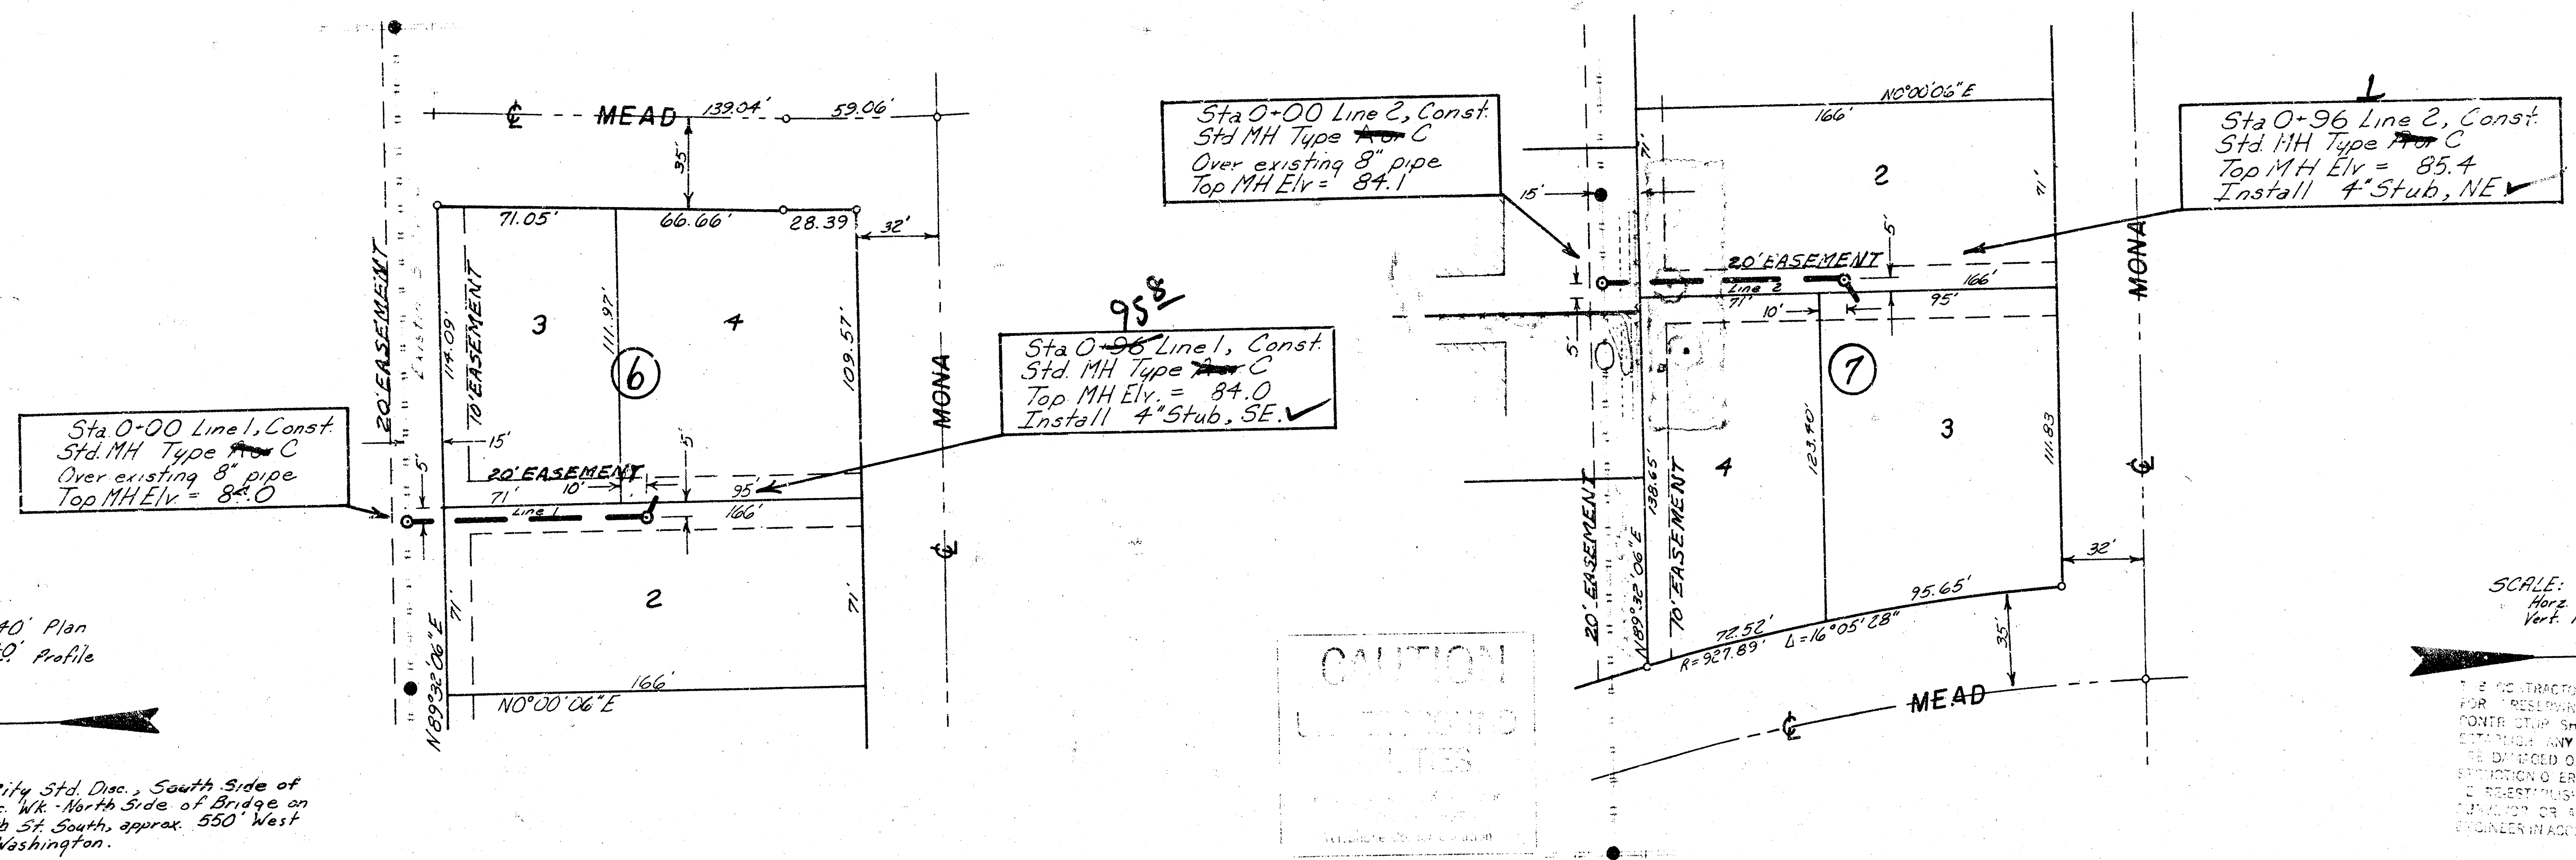

CAUTION
 UNDERGROUND
 UTILITIES


SCALE: 1"=40' Plan
 Horiz. 1"=40' Profile
 Vert. 1"=5'

CONTRACTOR SHALL BE RESPONSIBLE
 FOR REMAINING AND CITY IRONS. THE
 CONTRACTOR SHALL BE REQUIRED TO
 EXTERIORIZE ANY EXISTING IRONS WHICH
 ARE DAMAGED OR DESTROYED BY HIS CON-
 STRUCTION OPERATIONS SUCH IRONS SHALL
 BE REINSTALLED BY A LICENSED
 PLUMBER OR A LICENSED PROFESSIONAL
 ENGINEER IN ACCORDANCE WITH STATE LAWS.

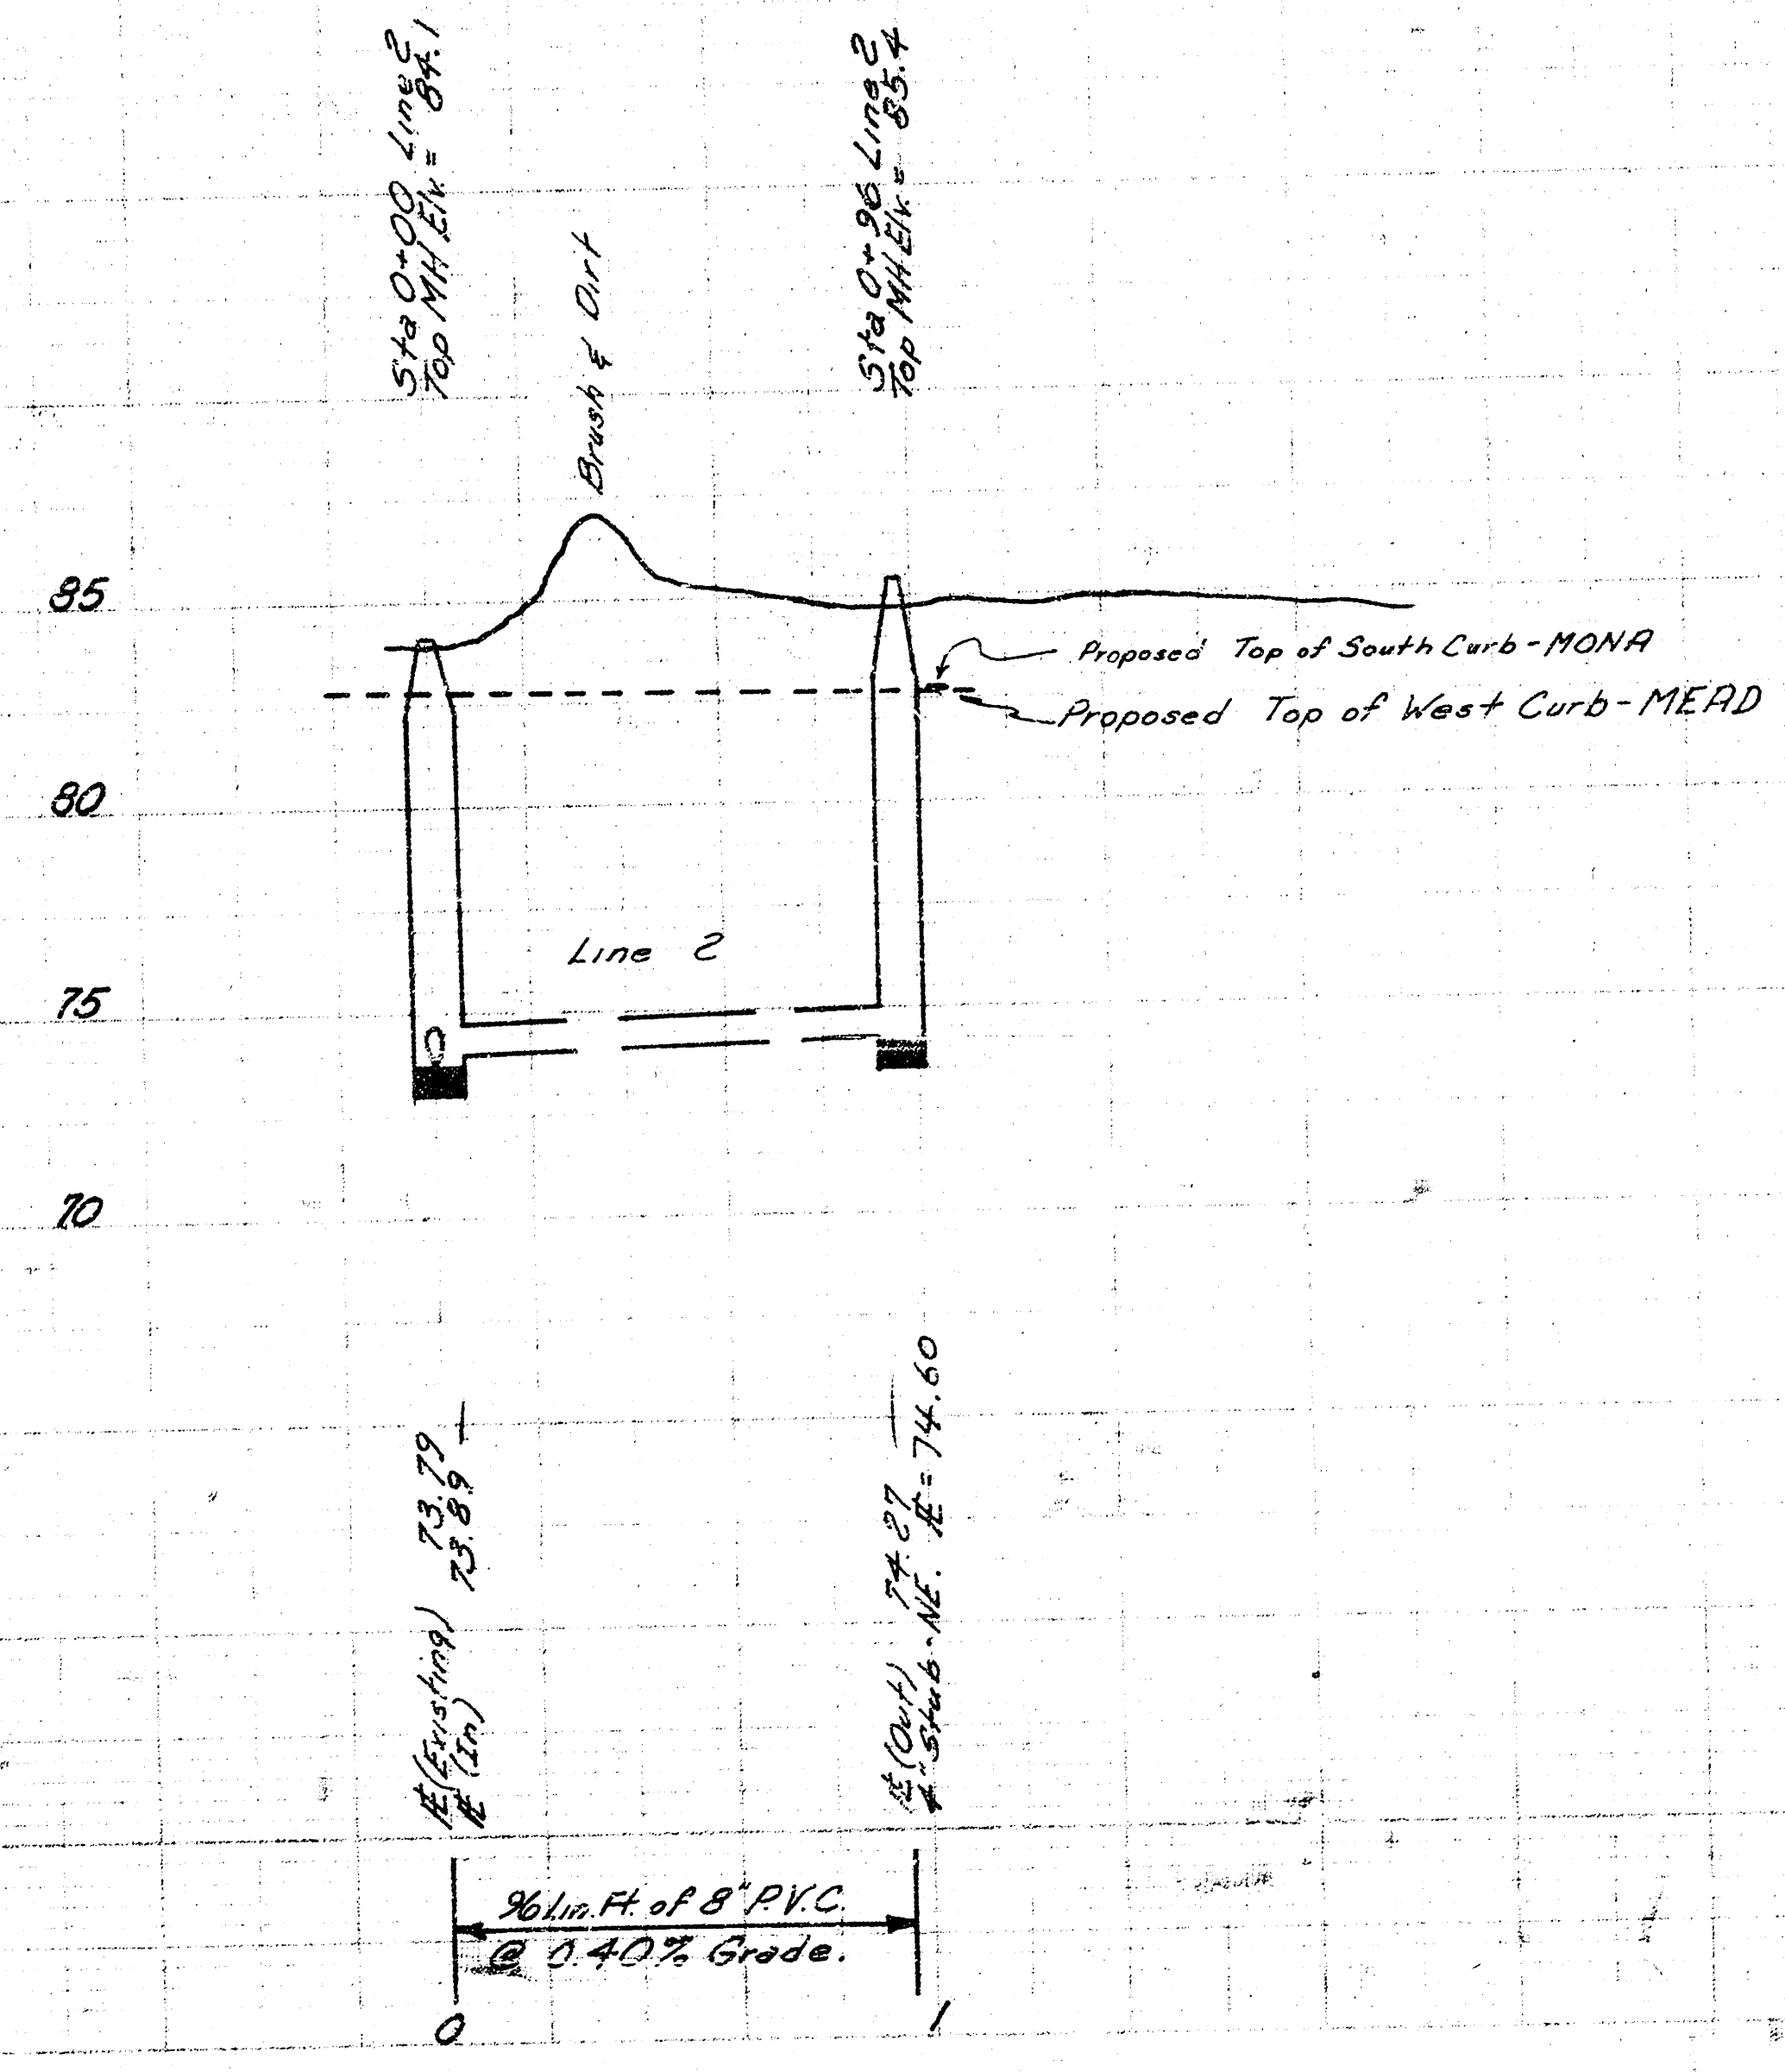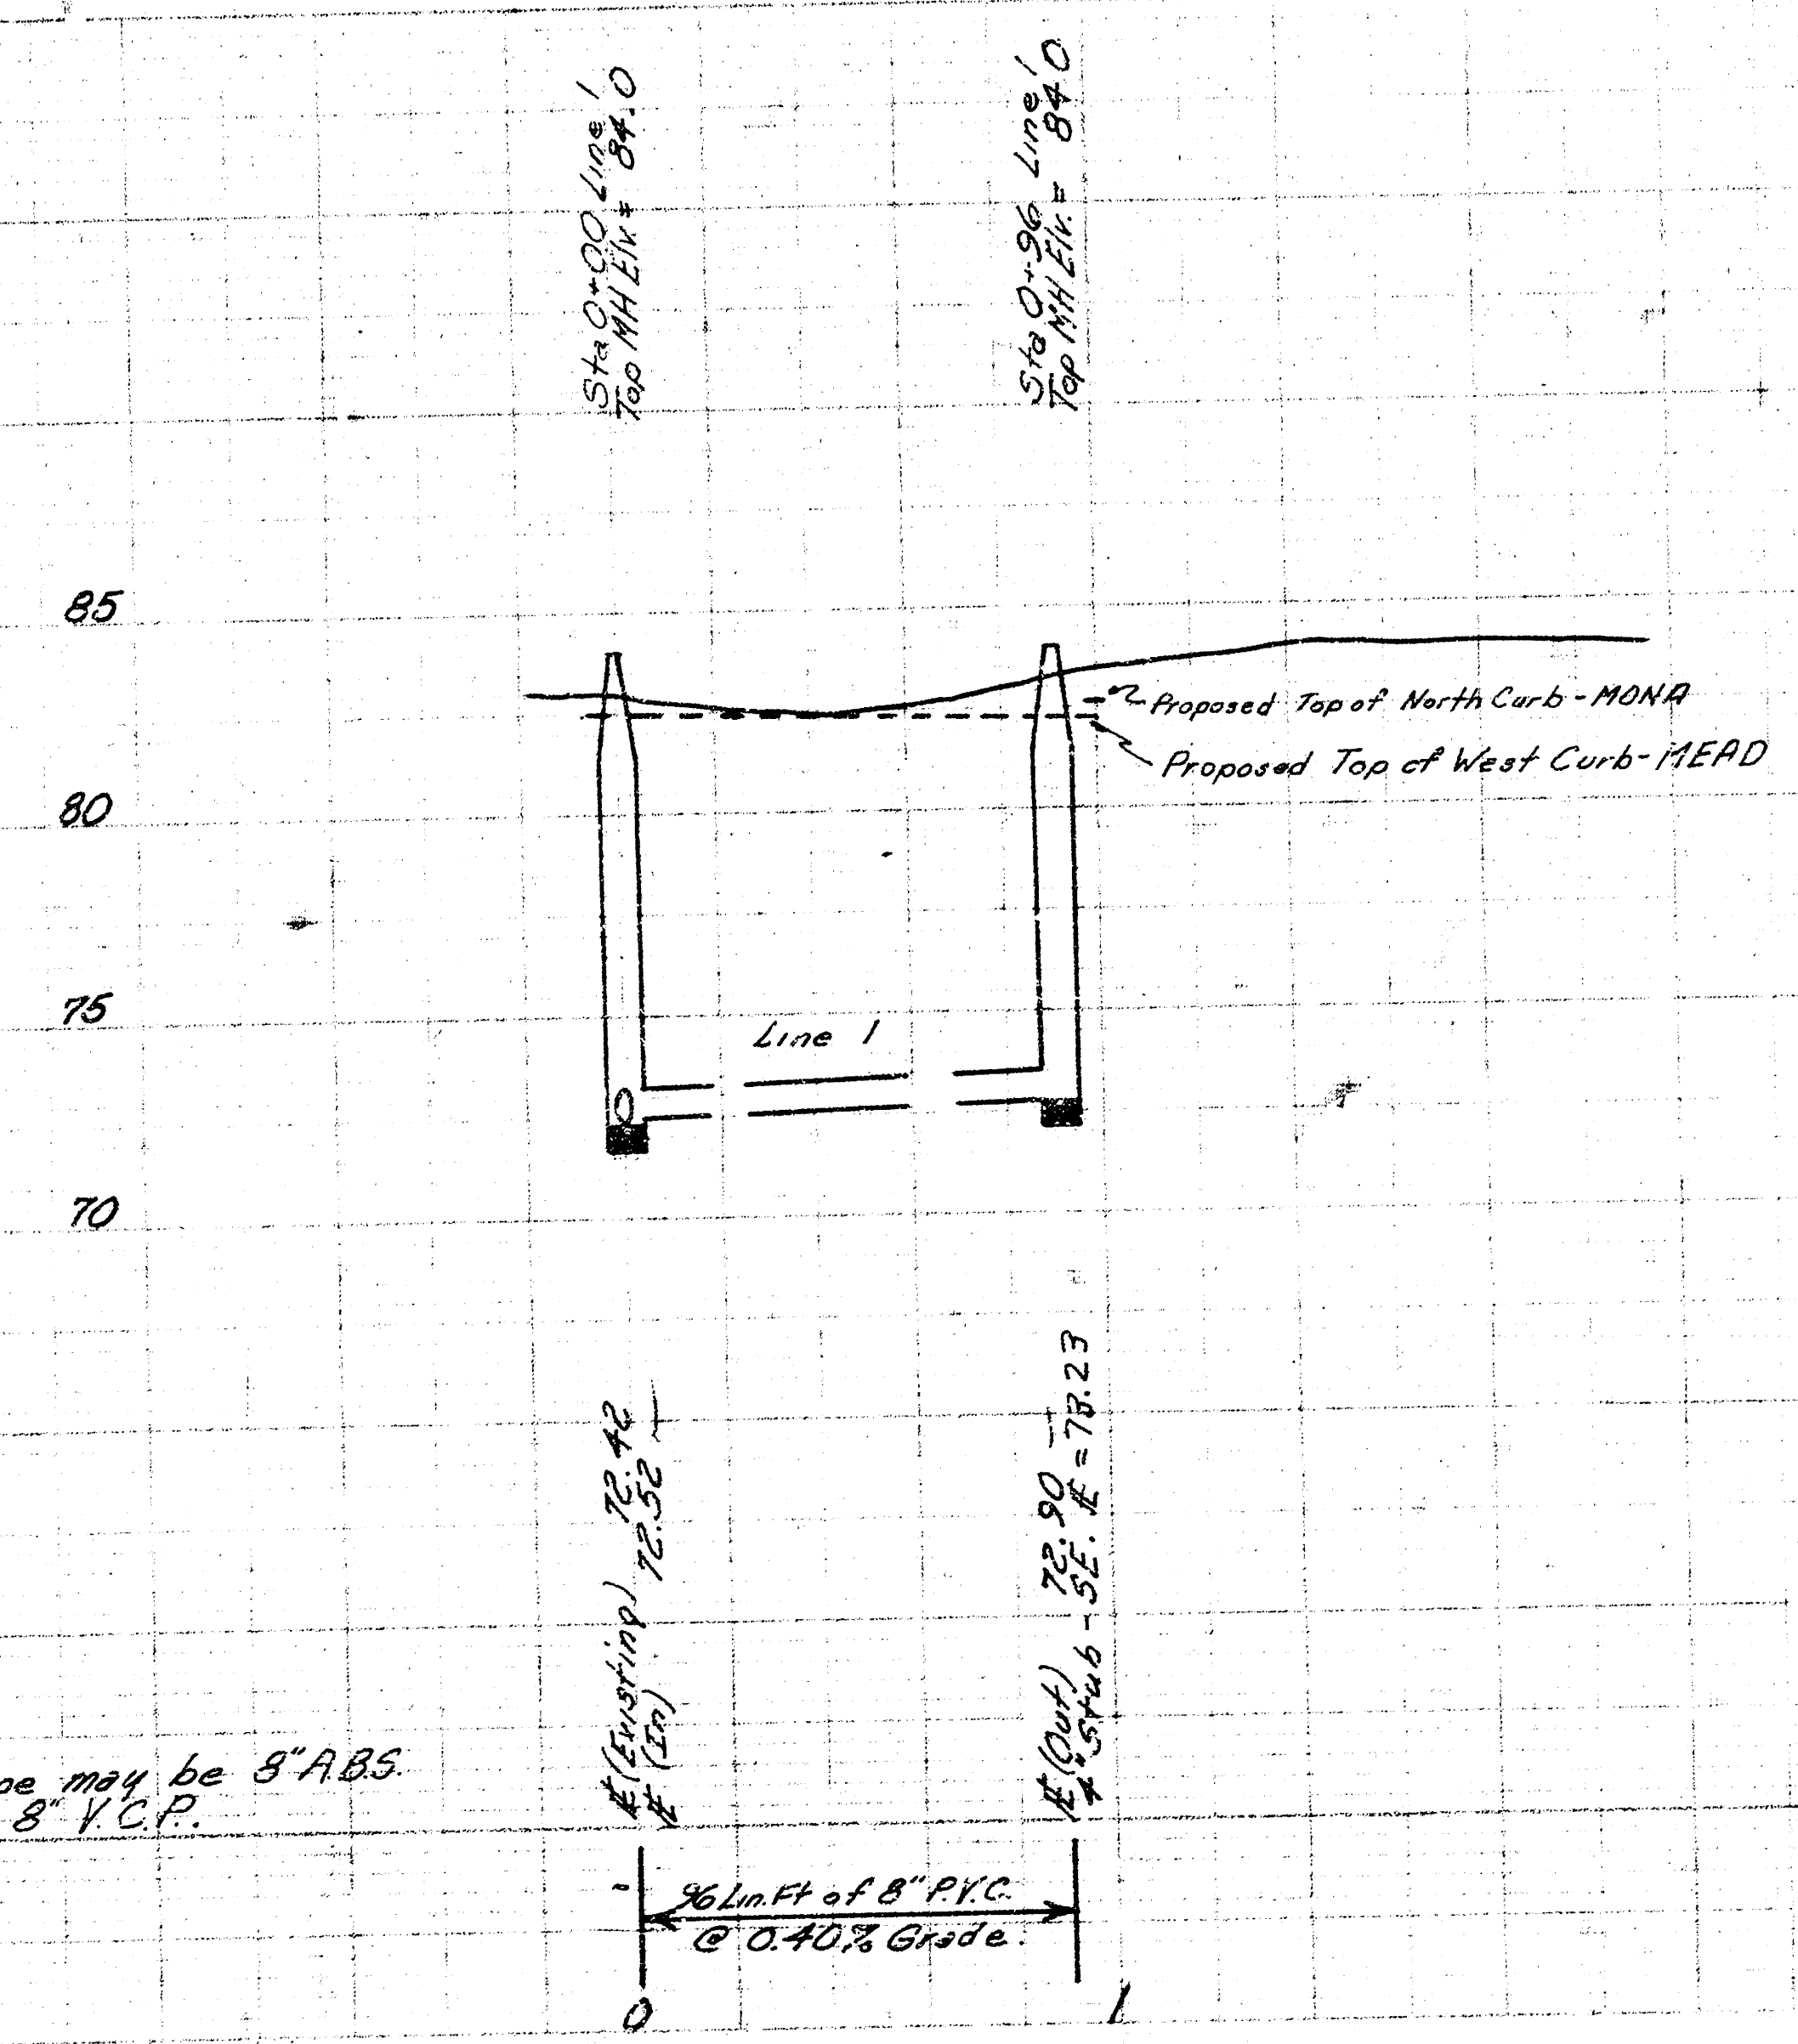

Note: Alternate pipe may be 8" ABS
 Comp. Pipe or 8" V.C.P.

As Built
 11/81

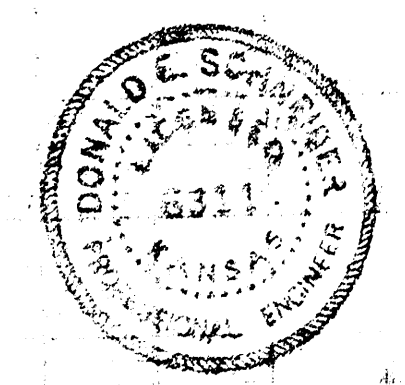

SHEET 1 of 1
 LAT. 21, MAIN 2, S.W.
 CITY OF WICHITA, KANSAS
 R.W. BRUGGEMAN
 DIRECTOR OF ENGINEERING/CITY ENGINEER
 PROJ. NO. 468-76-245-81087-000-000-001