


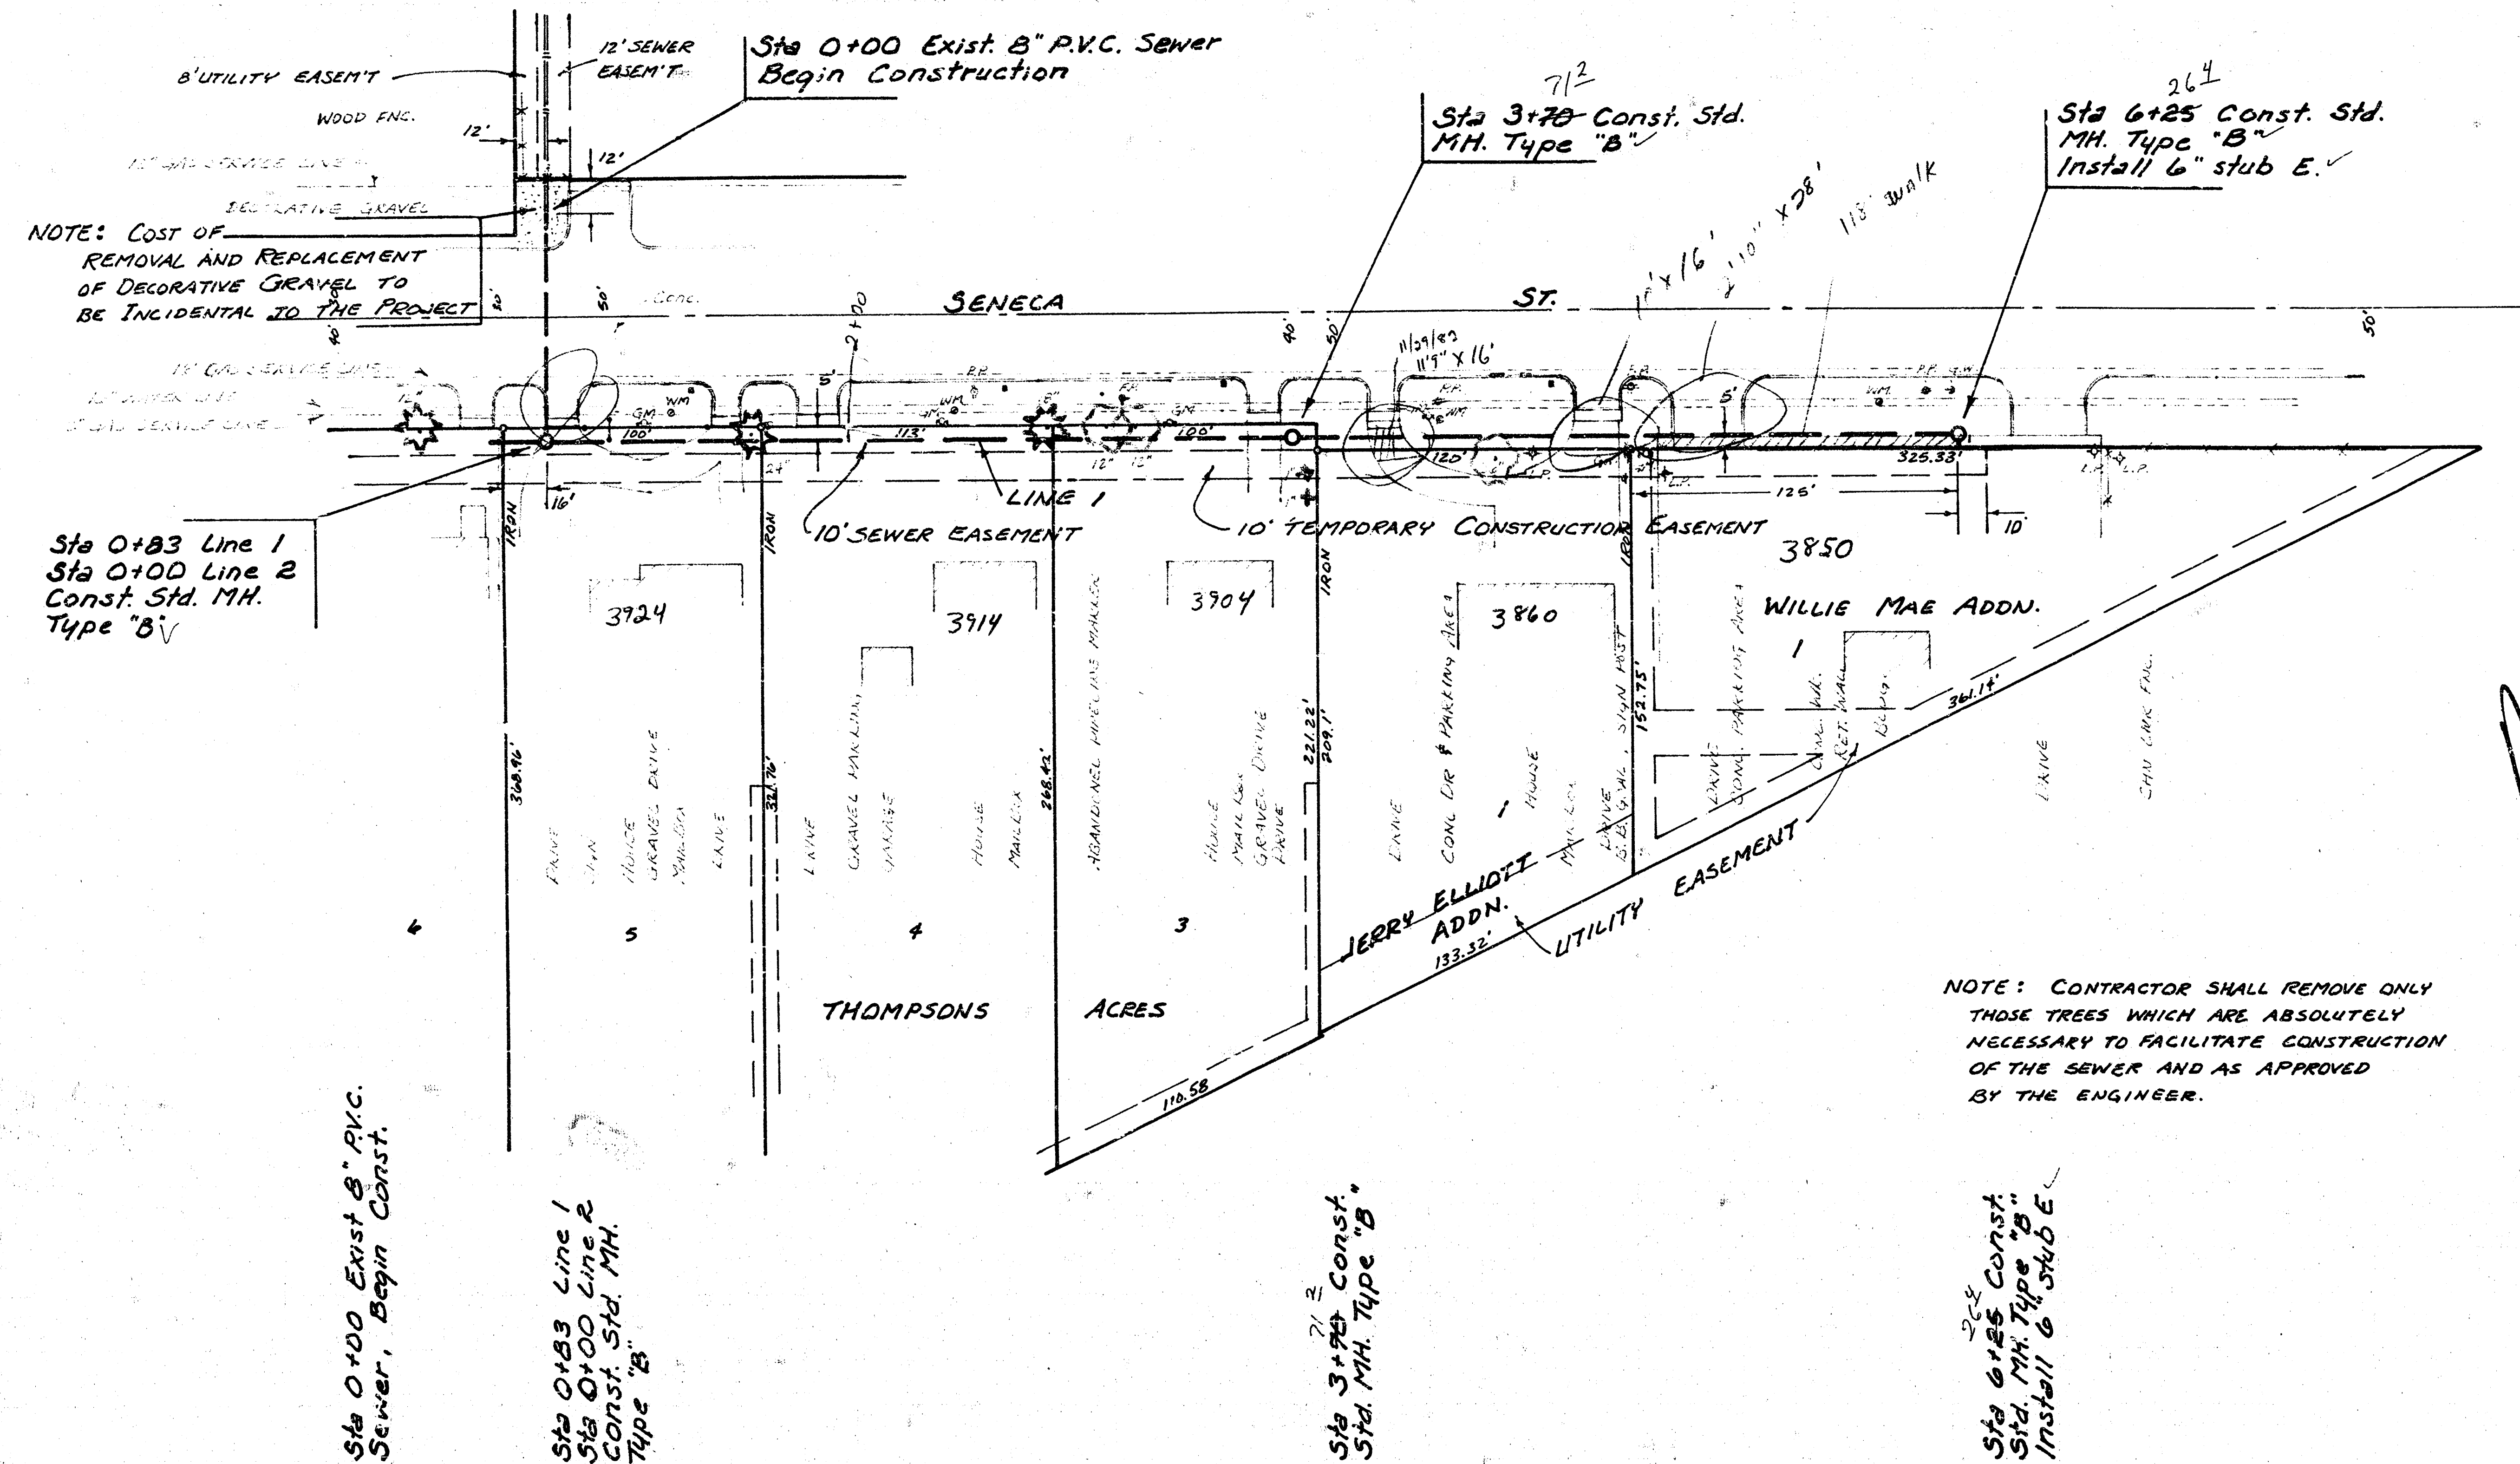


SCALE PLAN 1" = 40'
PROFILE 1" = 40' HORIZ
1" = 5' VERT.

CAUTION
UNDERGROUND
UTILITIES
Please check with K G & E or
Southwestern Bell
Telephone Co. for Location

THE CONTRACTOR SHALL BE RESPONSIBLE FOR PRESERVING PROPERTY IRONS. THE CONTRACTOR SHALL BE REQUIRED TO RE-ESTABLISH ANY PROPERTY IRONS WHICH ARE DAMAGED OR DESTROYED BY HIS CONSTRUCTION OPERATIONS. SUCH IRONS SHALL BE REESTABLISHED BY A LICENSED LAND SURVEYOR OR A LICENSED PROFESSIONAL ENGINEER IN ACCORDANCE WITH STATE LAWS.


As Built
J.L.
1/83

B.M. 90.37 CITY STD. DISC. 67' N. & MACARTHUR RD.
AND 28.5' W. OF SENECA.
B.M. 92.03 NE. COR. CONC. WK. 111' FRONT OF RESTAURANT
AT 3835 S. SENECA.


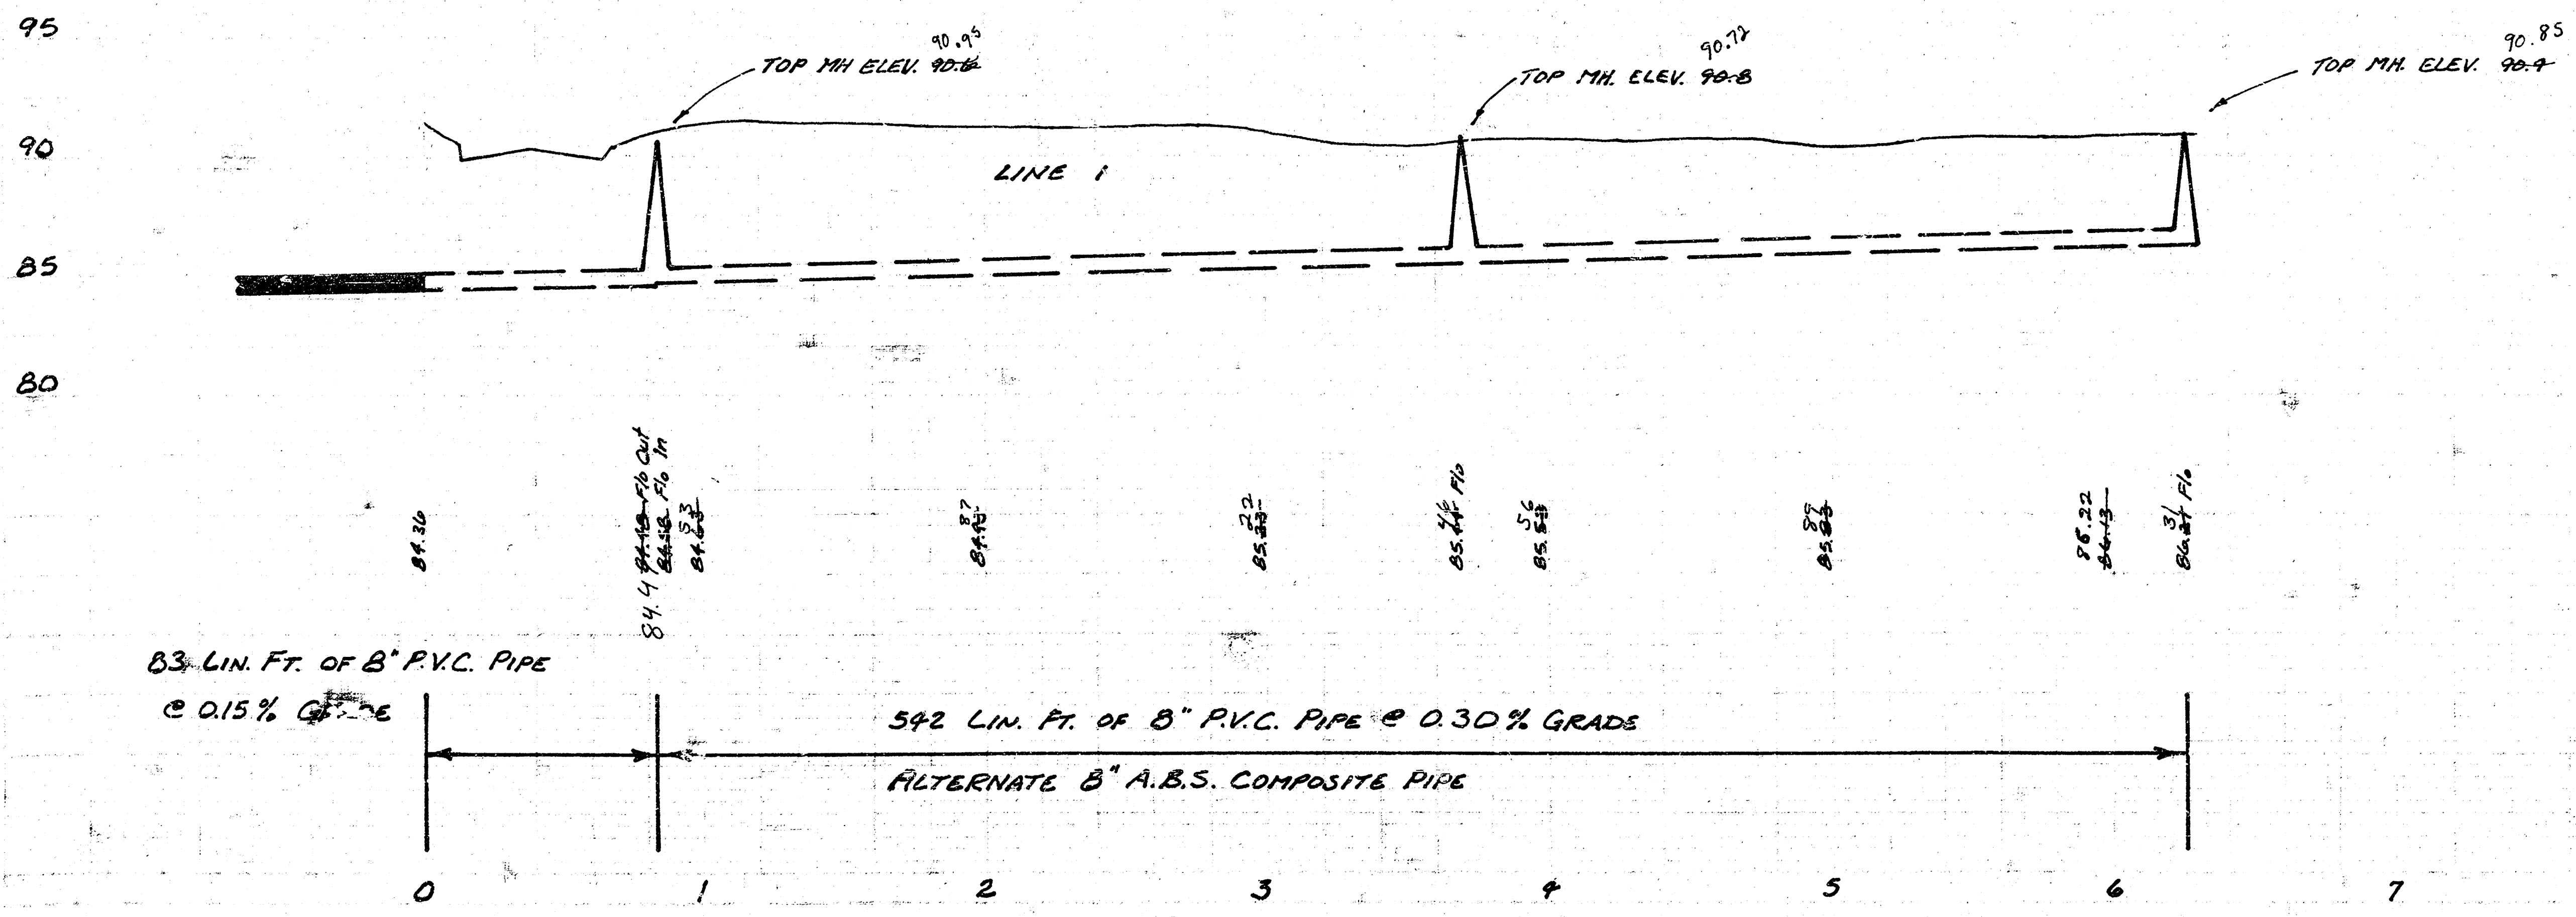


PROJECT DESCRIPTION			
LAT 3, SUB 3, SW. INTERCEPTOR			
PROJECT NUMBER			
468-76-245-80035-000-009-081			
BOOK NO. 13P-22	APPROVED BY	DATE	REVISED
DRAWN BY LDM/IS			
CITY OF WICHITA DEPARTMENT OF ENGINEERING			SCALE
DIRECTOR OF ENG./CITY ENGINEER R. W. BRUGGEMAN			



FILMED FROM THE BEST COPY

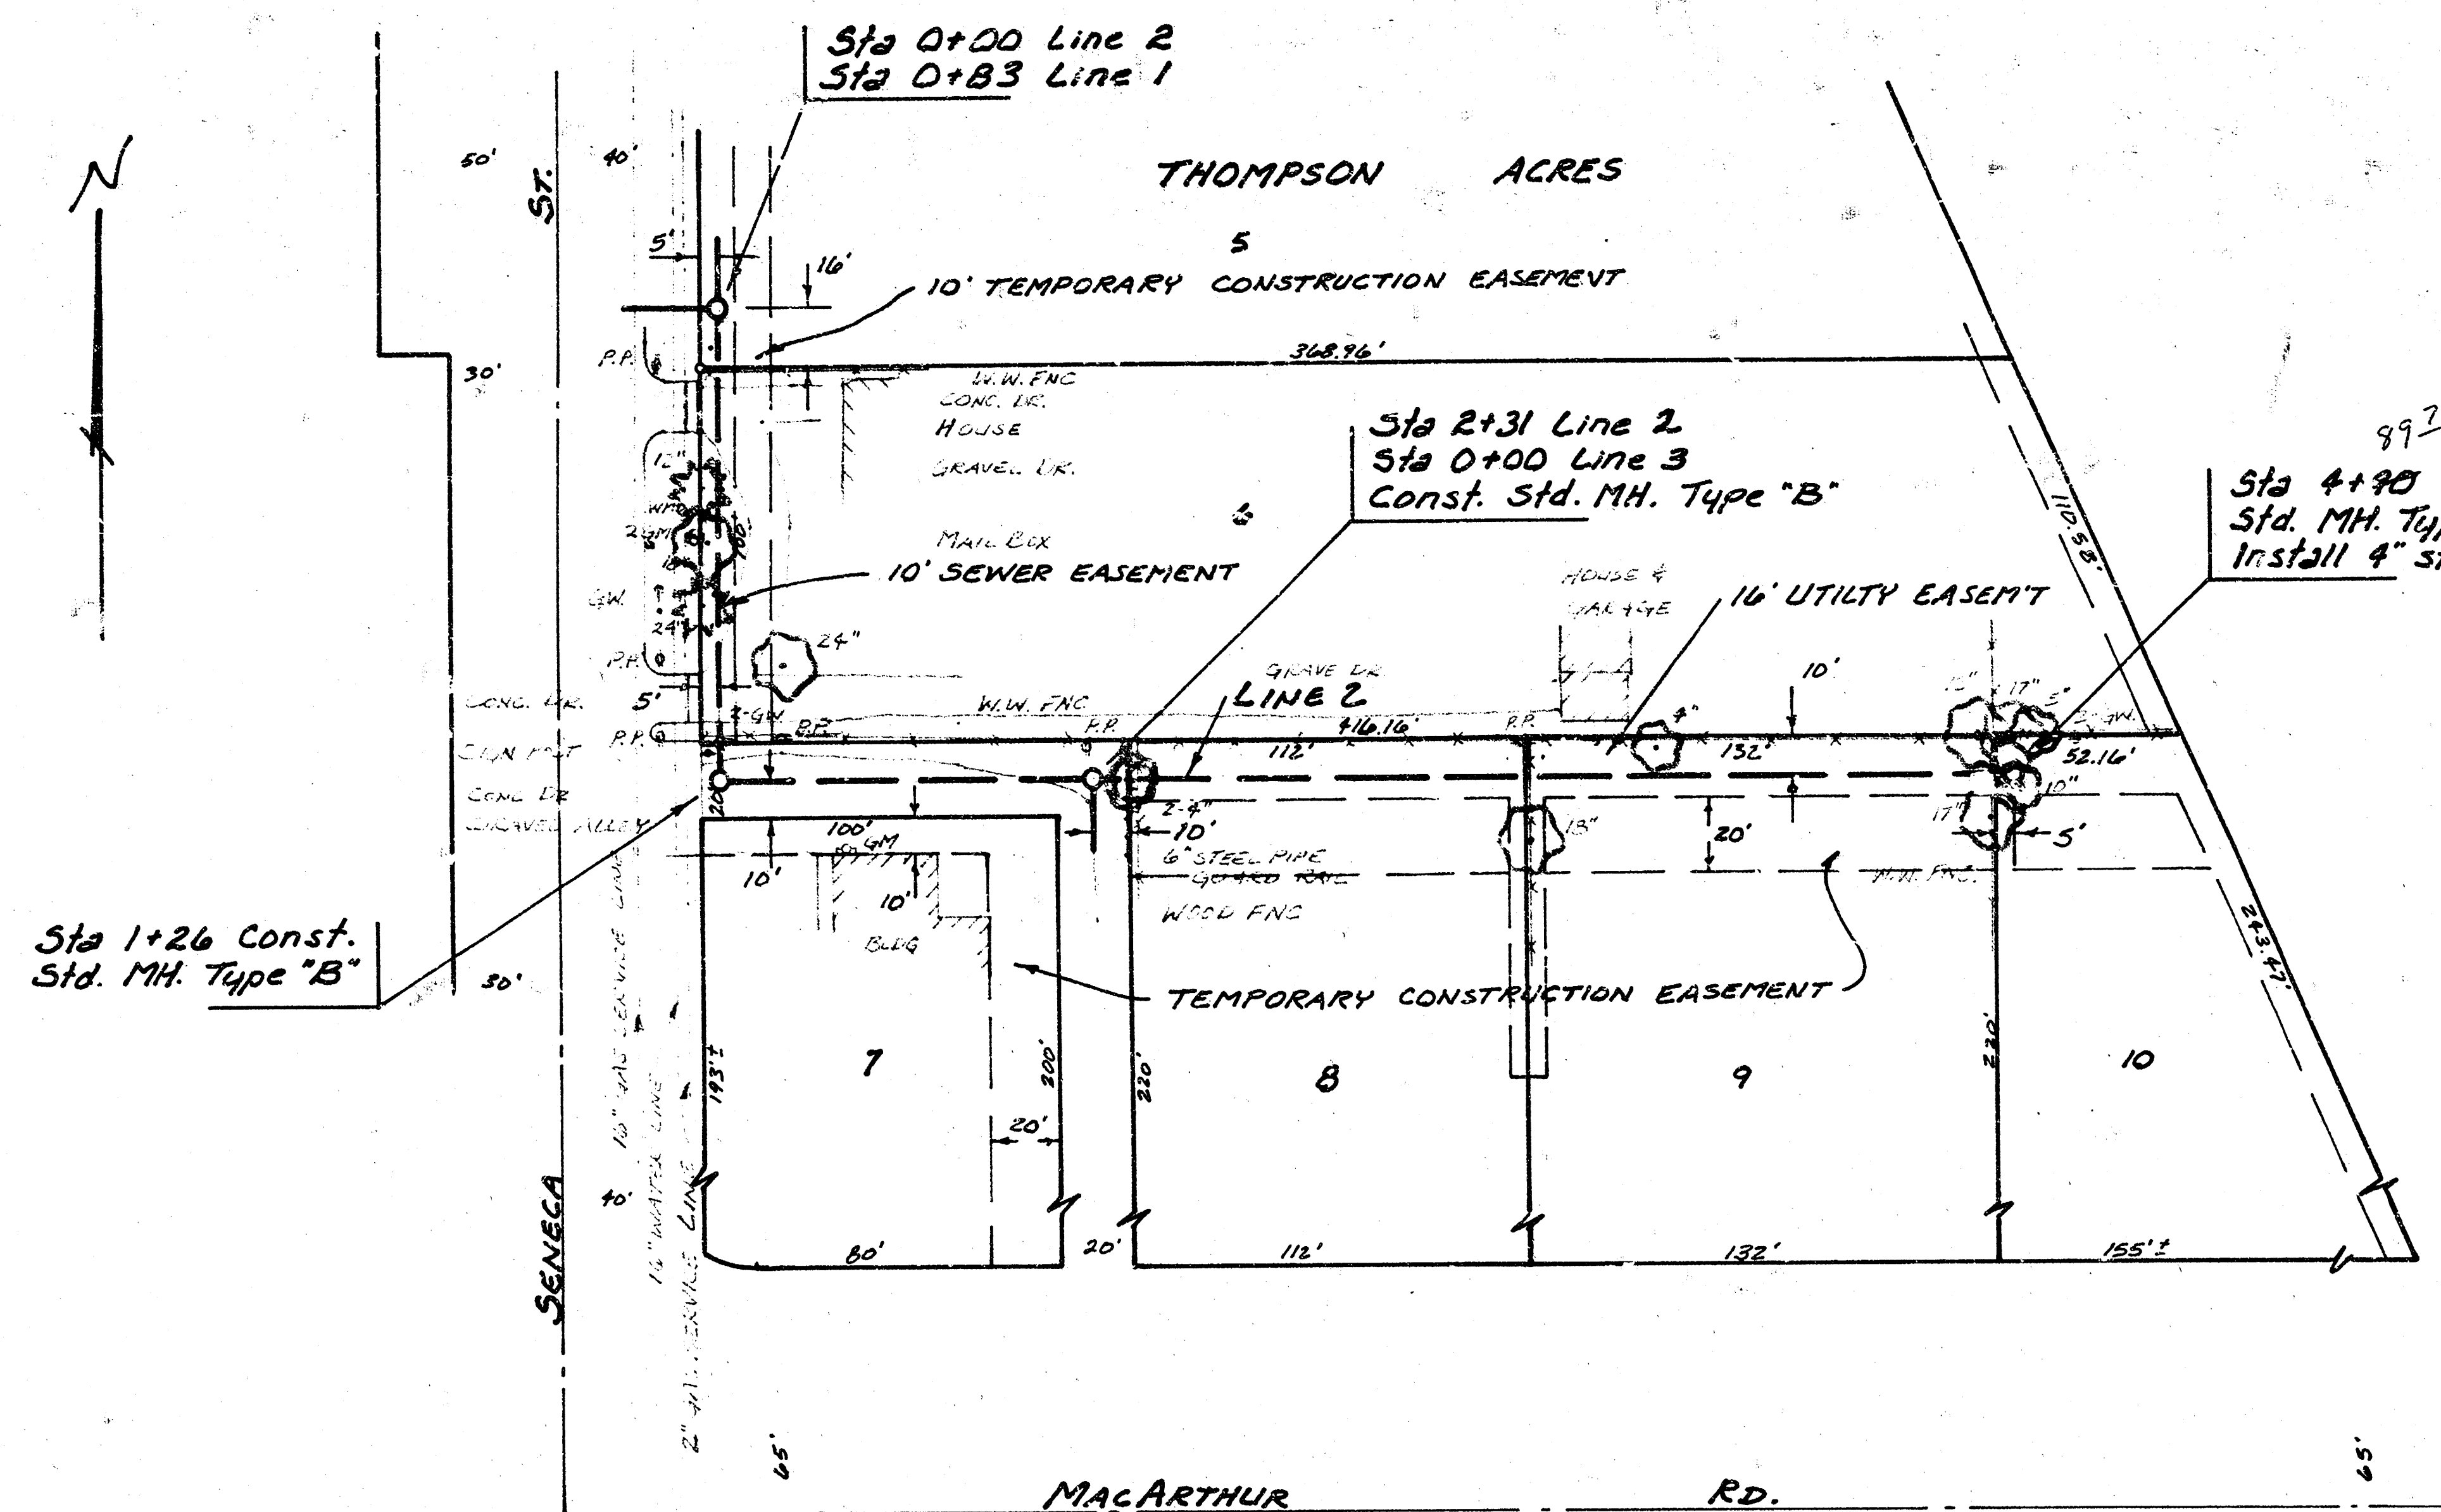

SCALE PLAN 1" = 40'
PROFILE 1" = 40' HORIZ.
1" = 5' VERT.

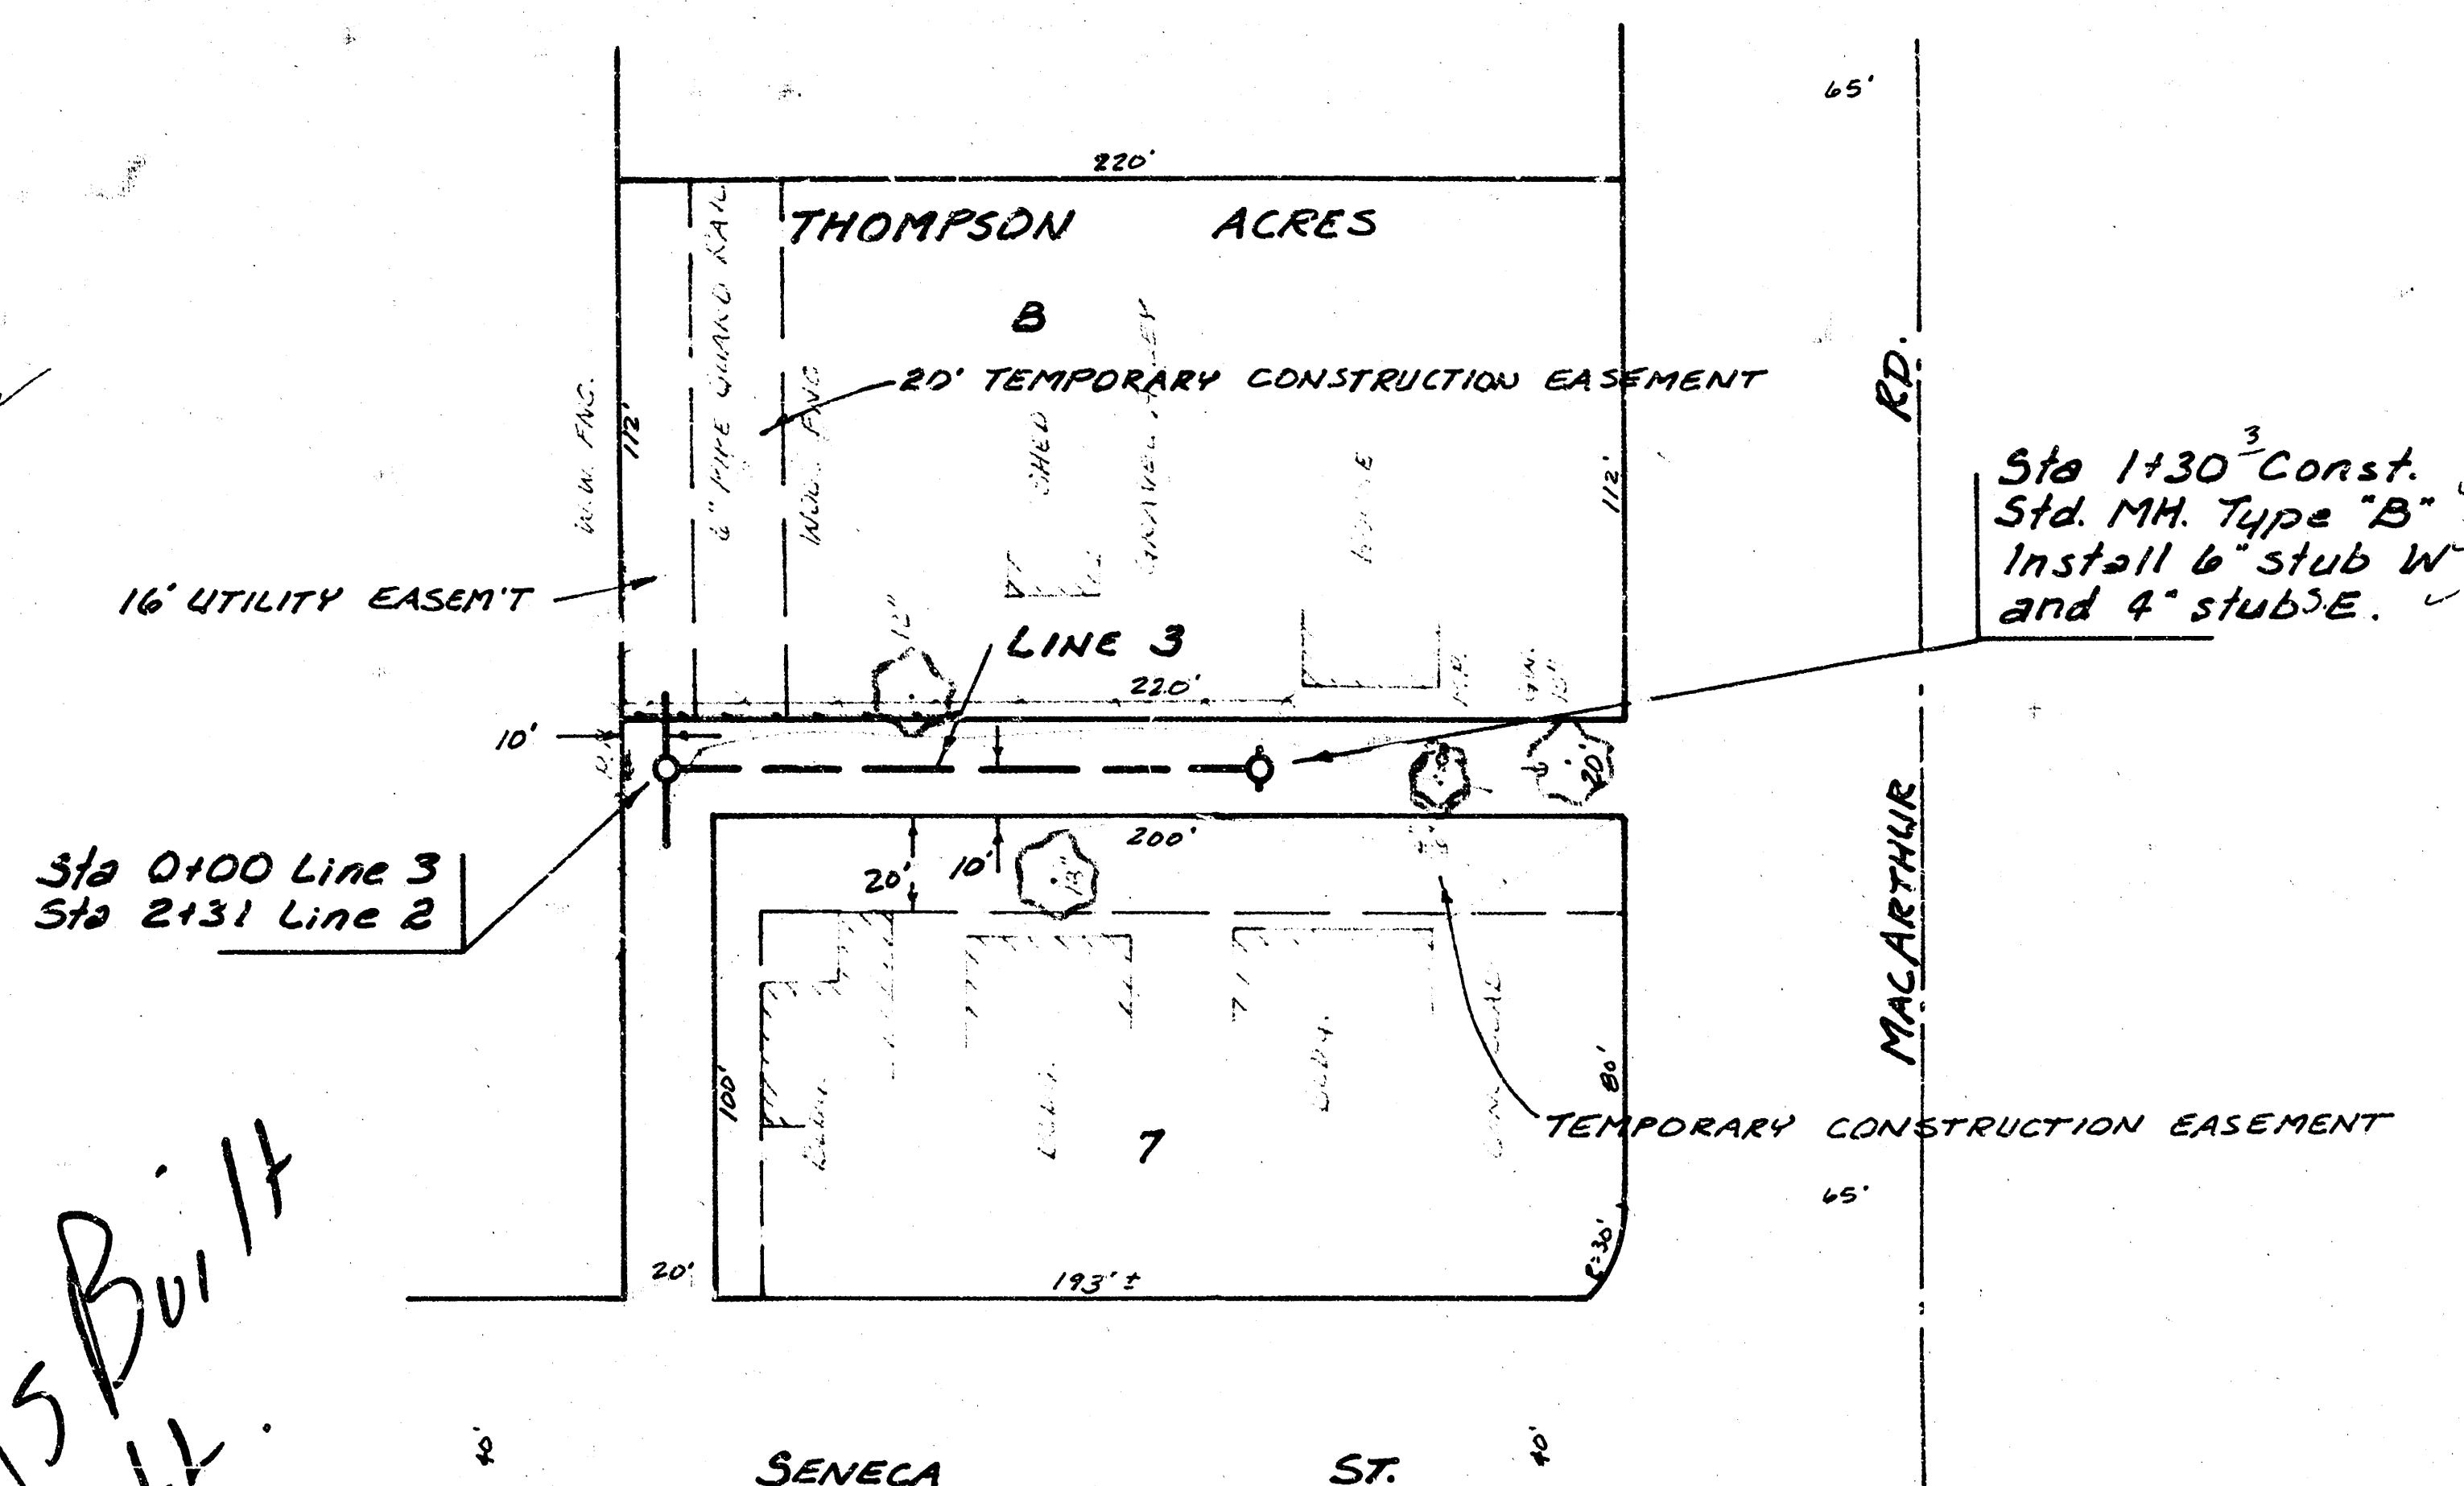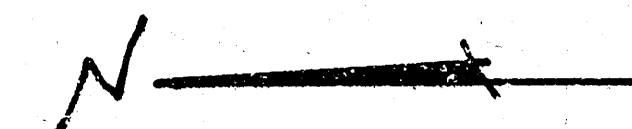

As Built
J.H.
1/83

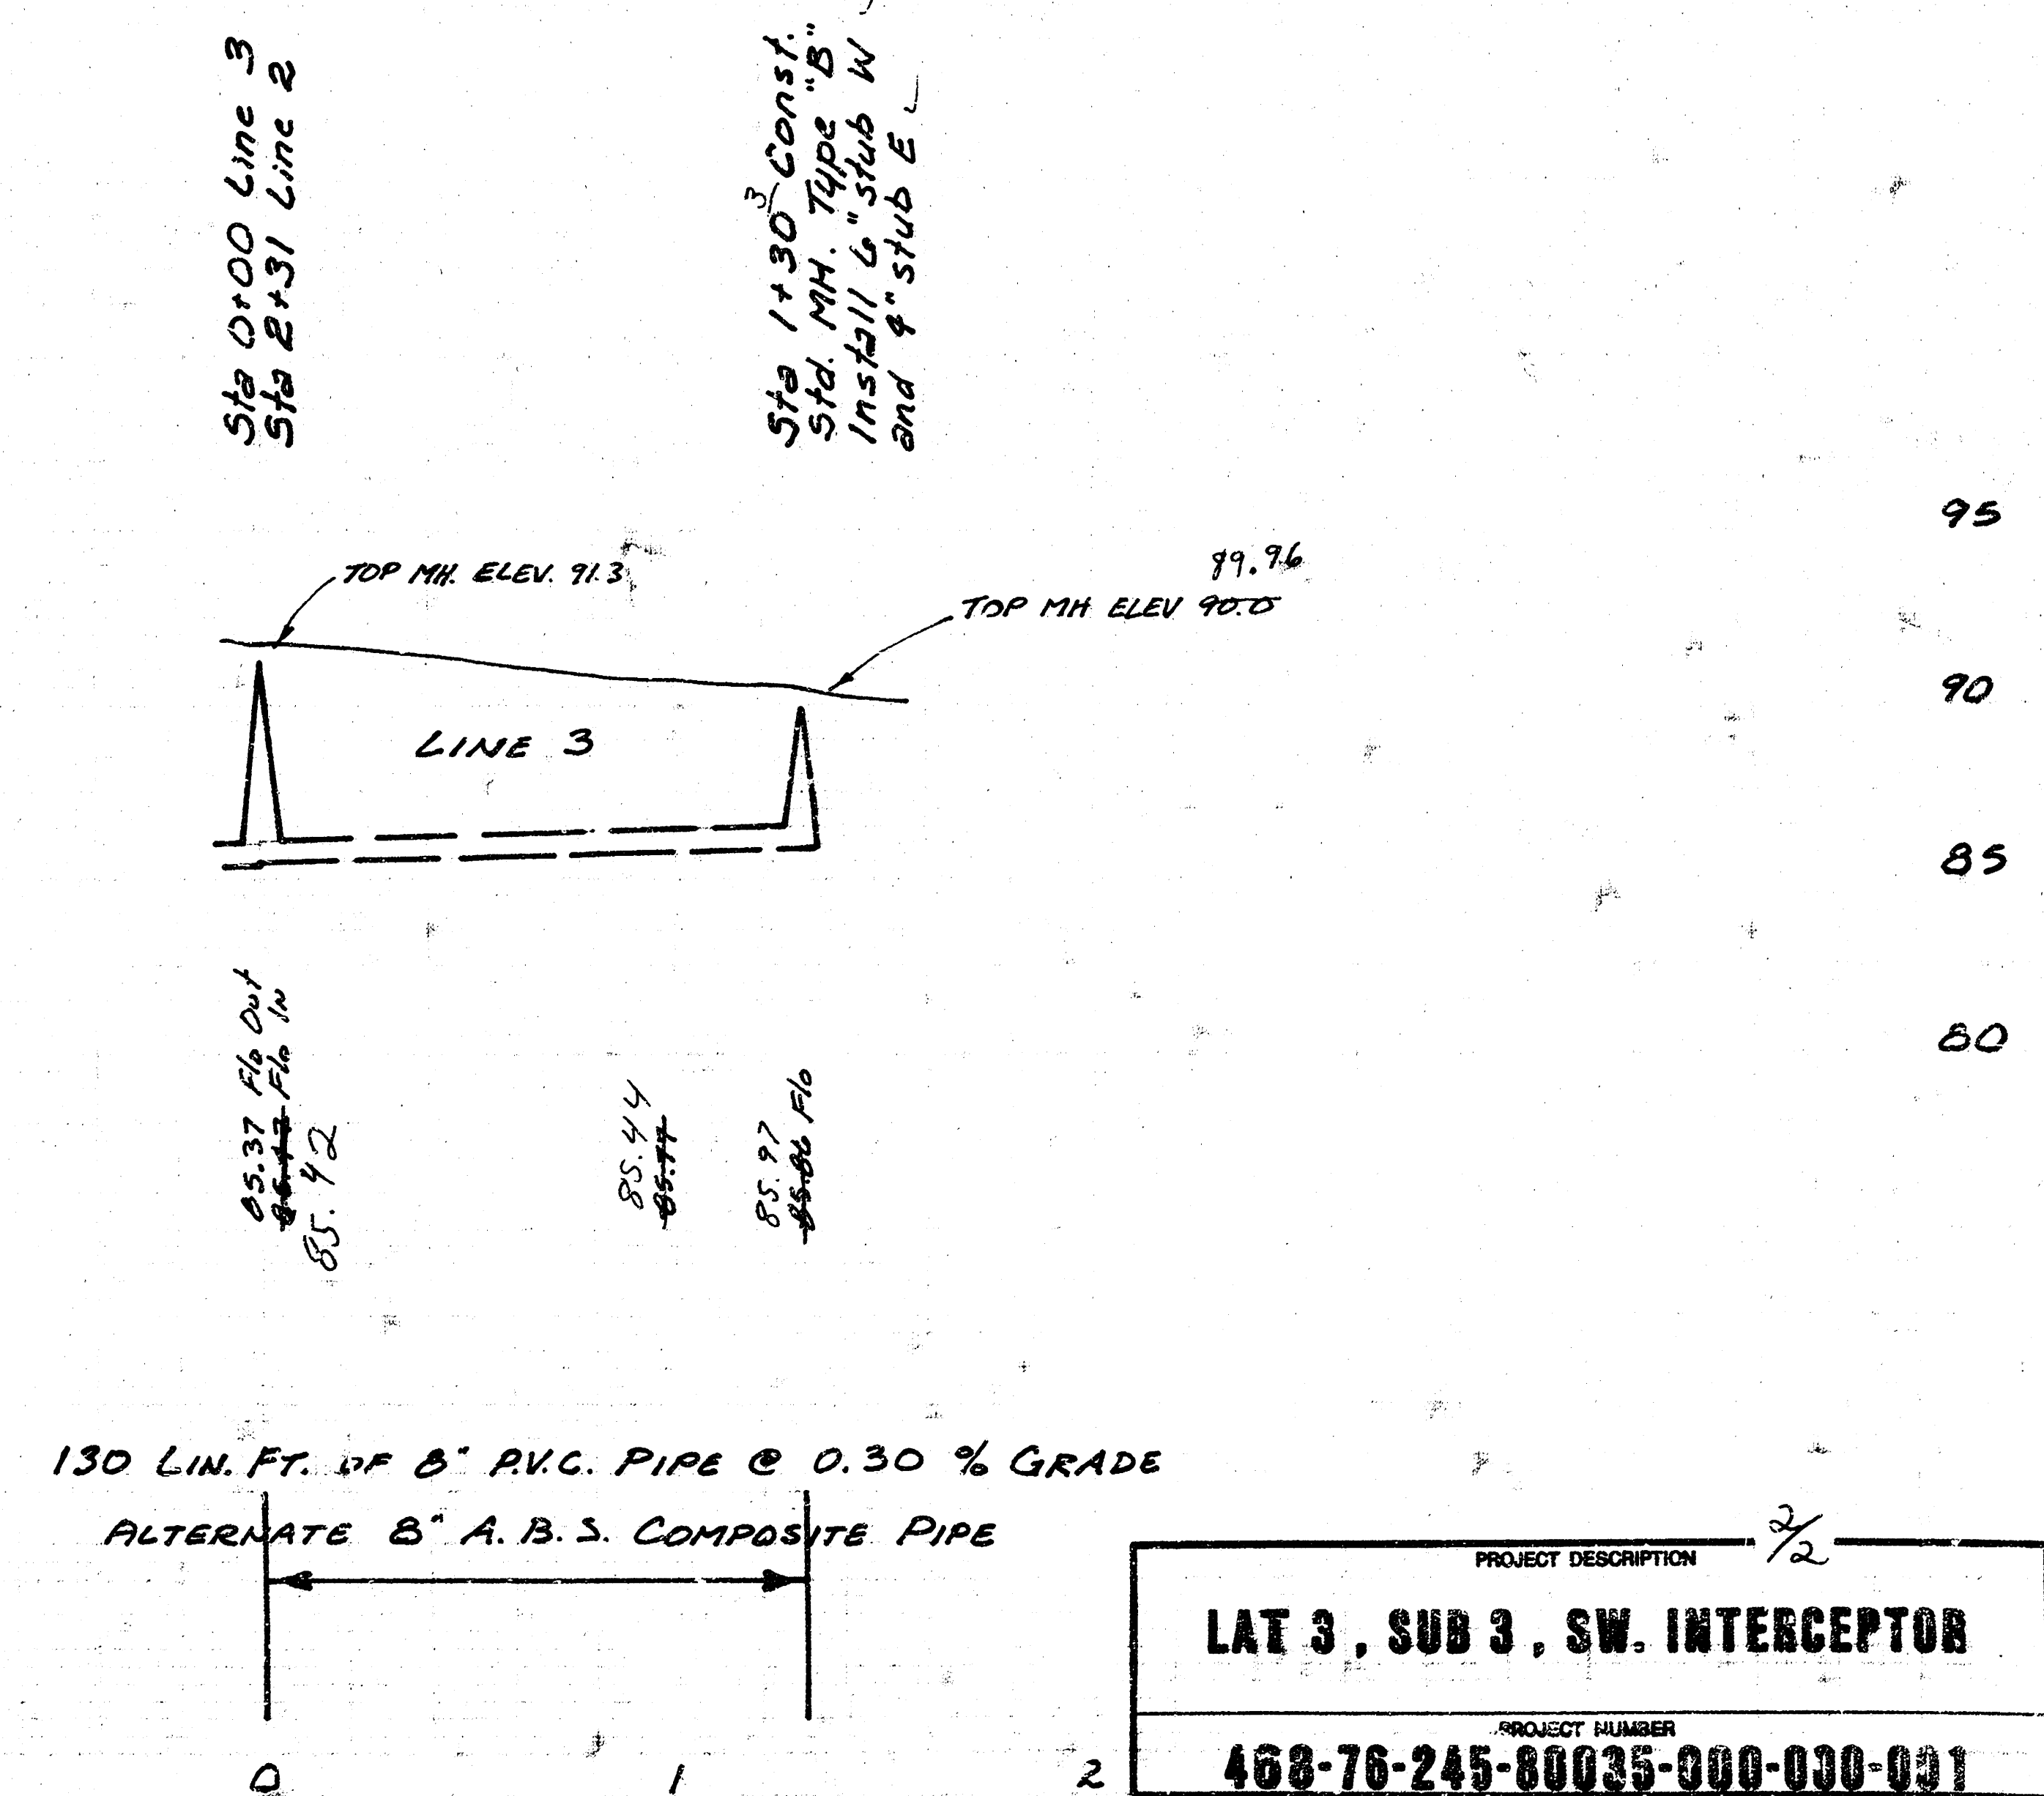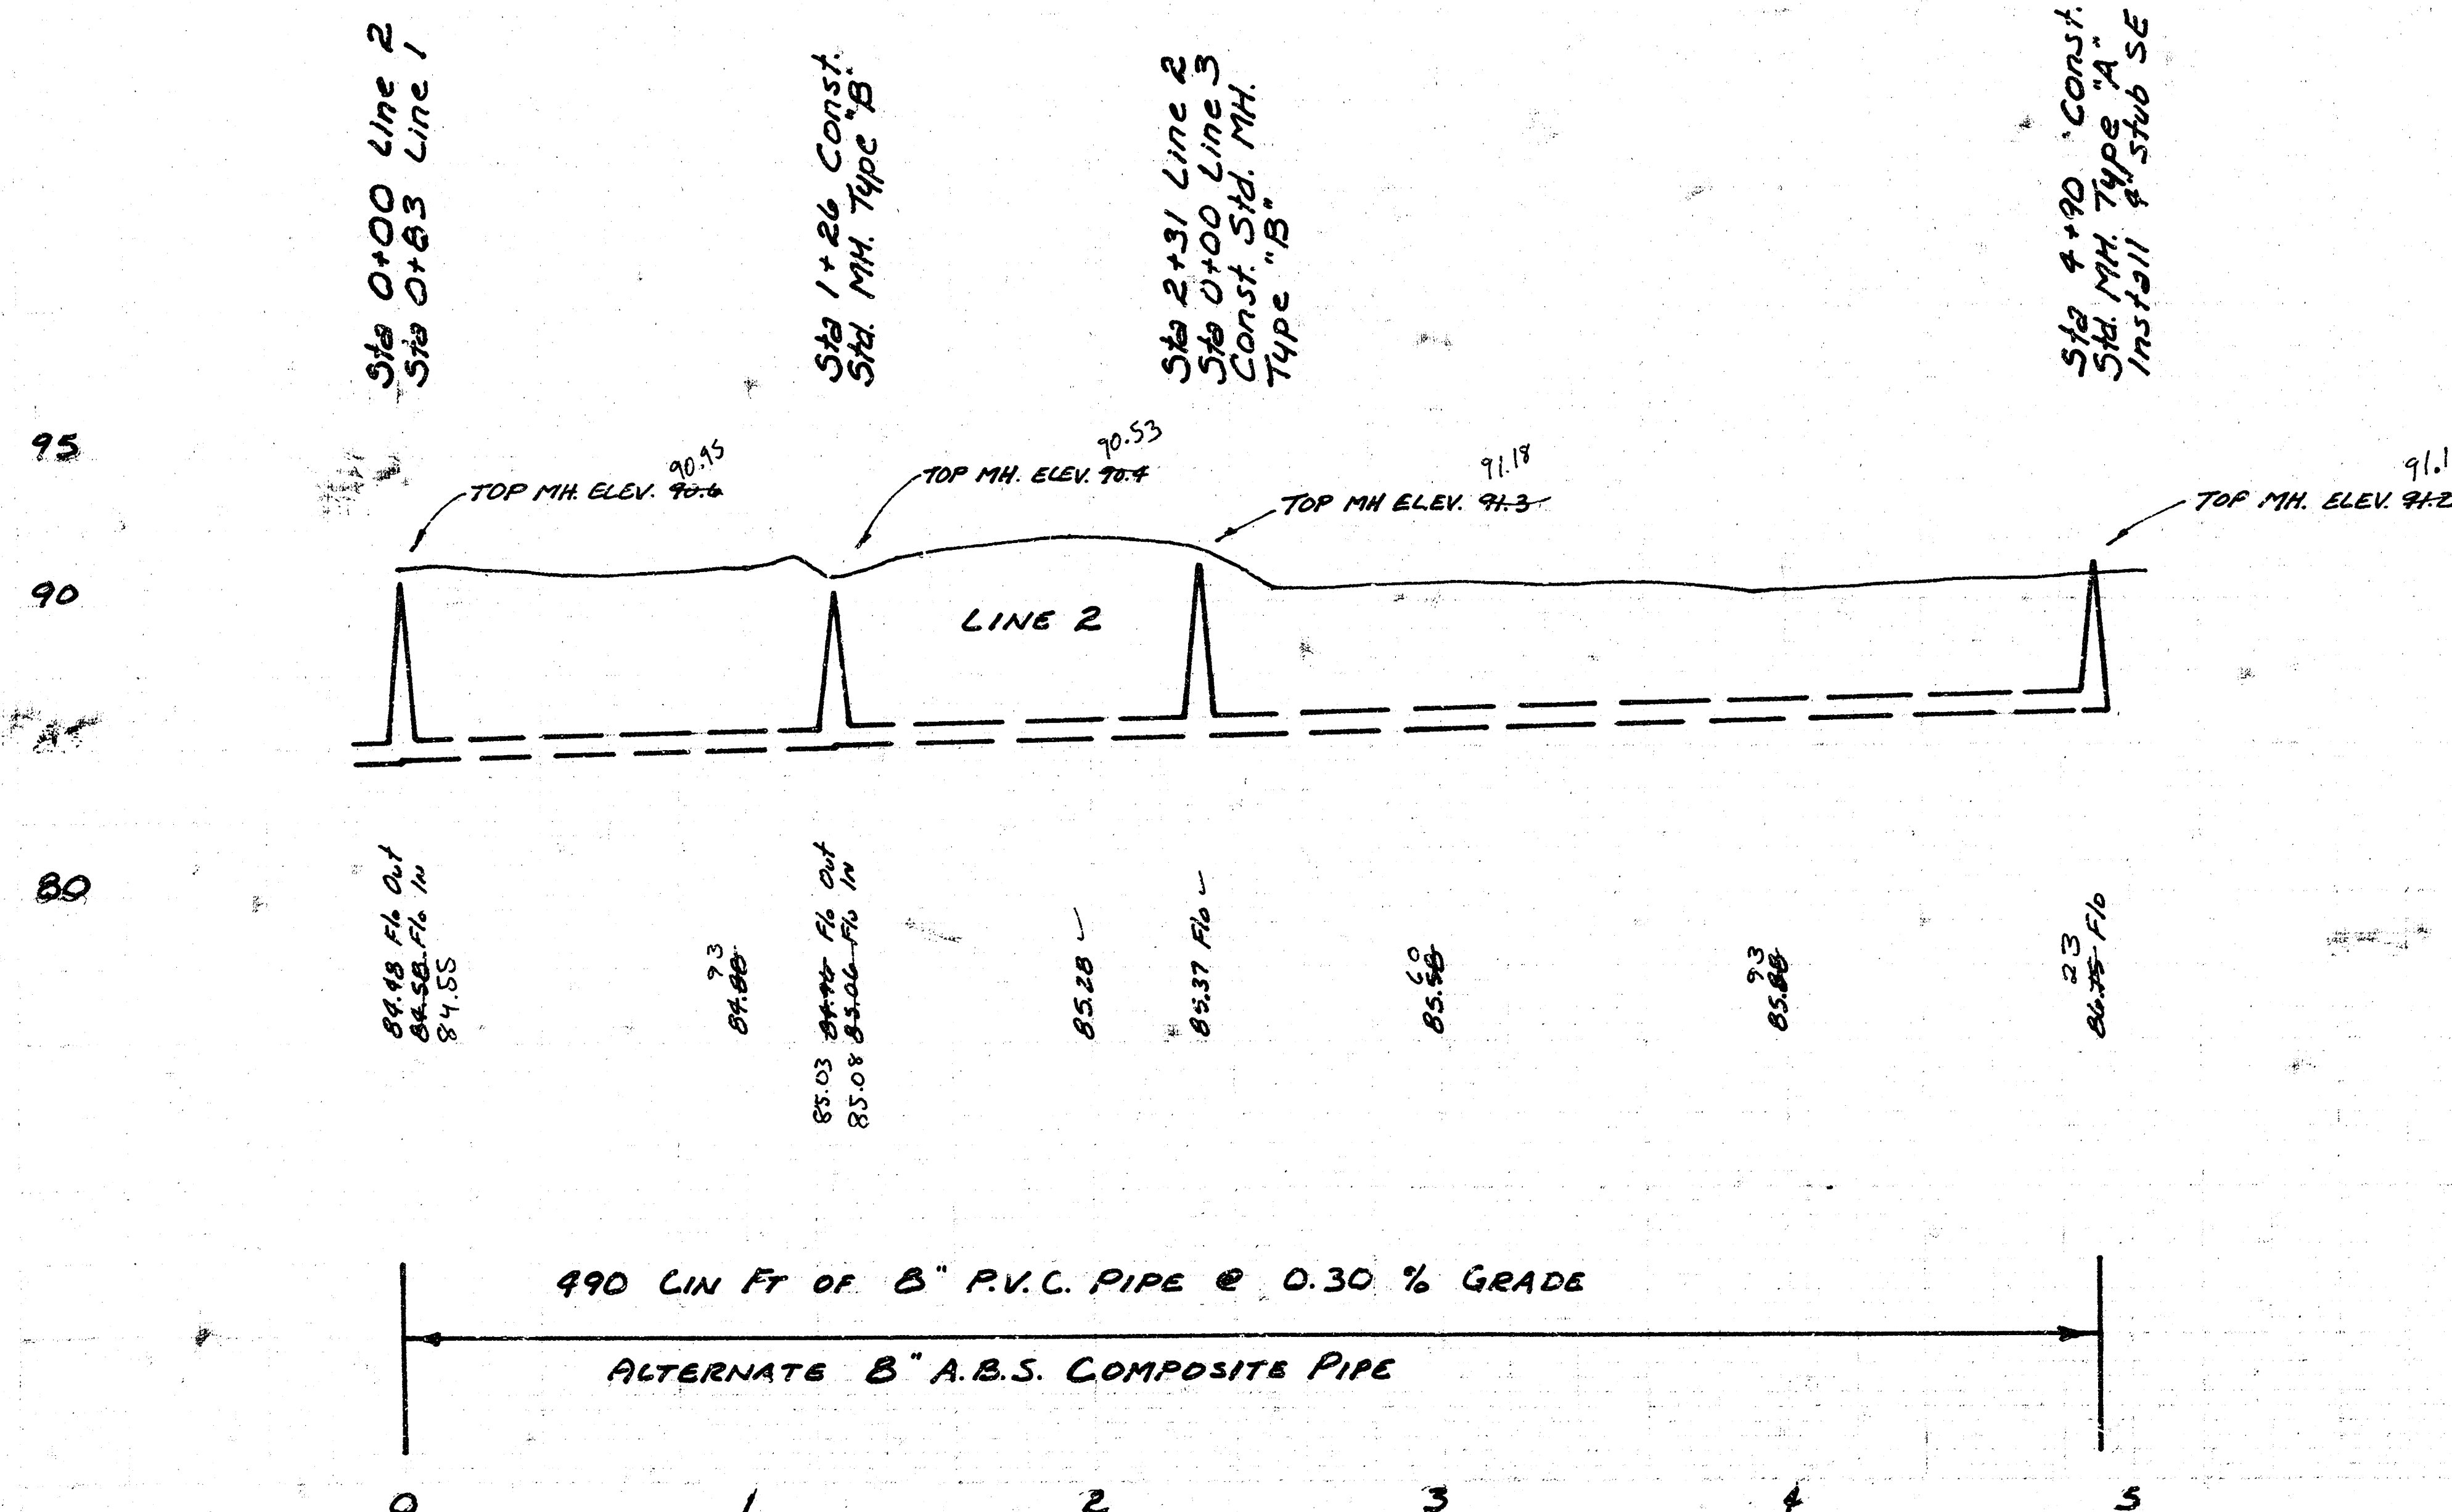

PROJECT DESCRIPTION	LAT 3, SUB 3, SW. INTERCEPTOR
PROJECT NUMBER	468-76-245-80035-000-030-031