


PLAN	DATE	BY	CHECKED	DATE	BY
NOT BOOK	8/12	R. Loomis	J. Linney	8/89	

PROFILE	DATE	BY	CHECKED	DATE	BY
NOT BOOK	8/12	R. Loomis	J. Linney	8/89	

B.M. 85.30 NE Corner of Cont. porch
House # 5319 S. Osage


B.M. 81.19 R.R. spike in S. side of L.P.
on the W. corner of the intersection
of Lockwood St & Southwind St.

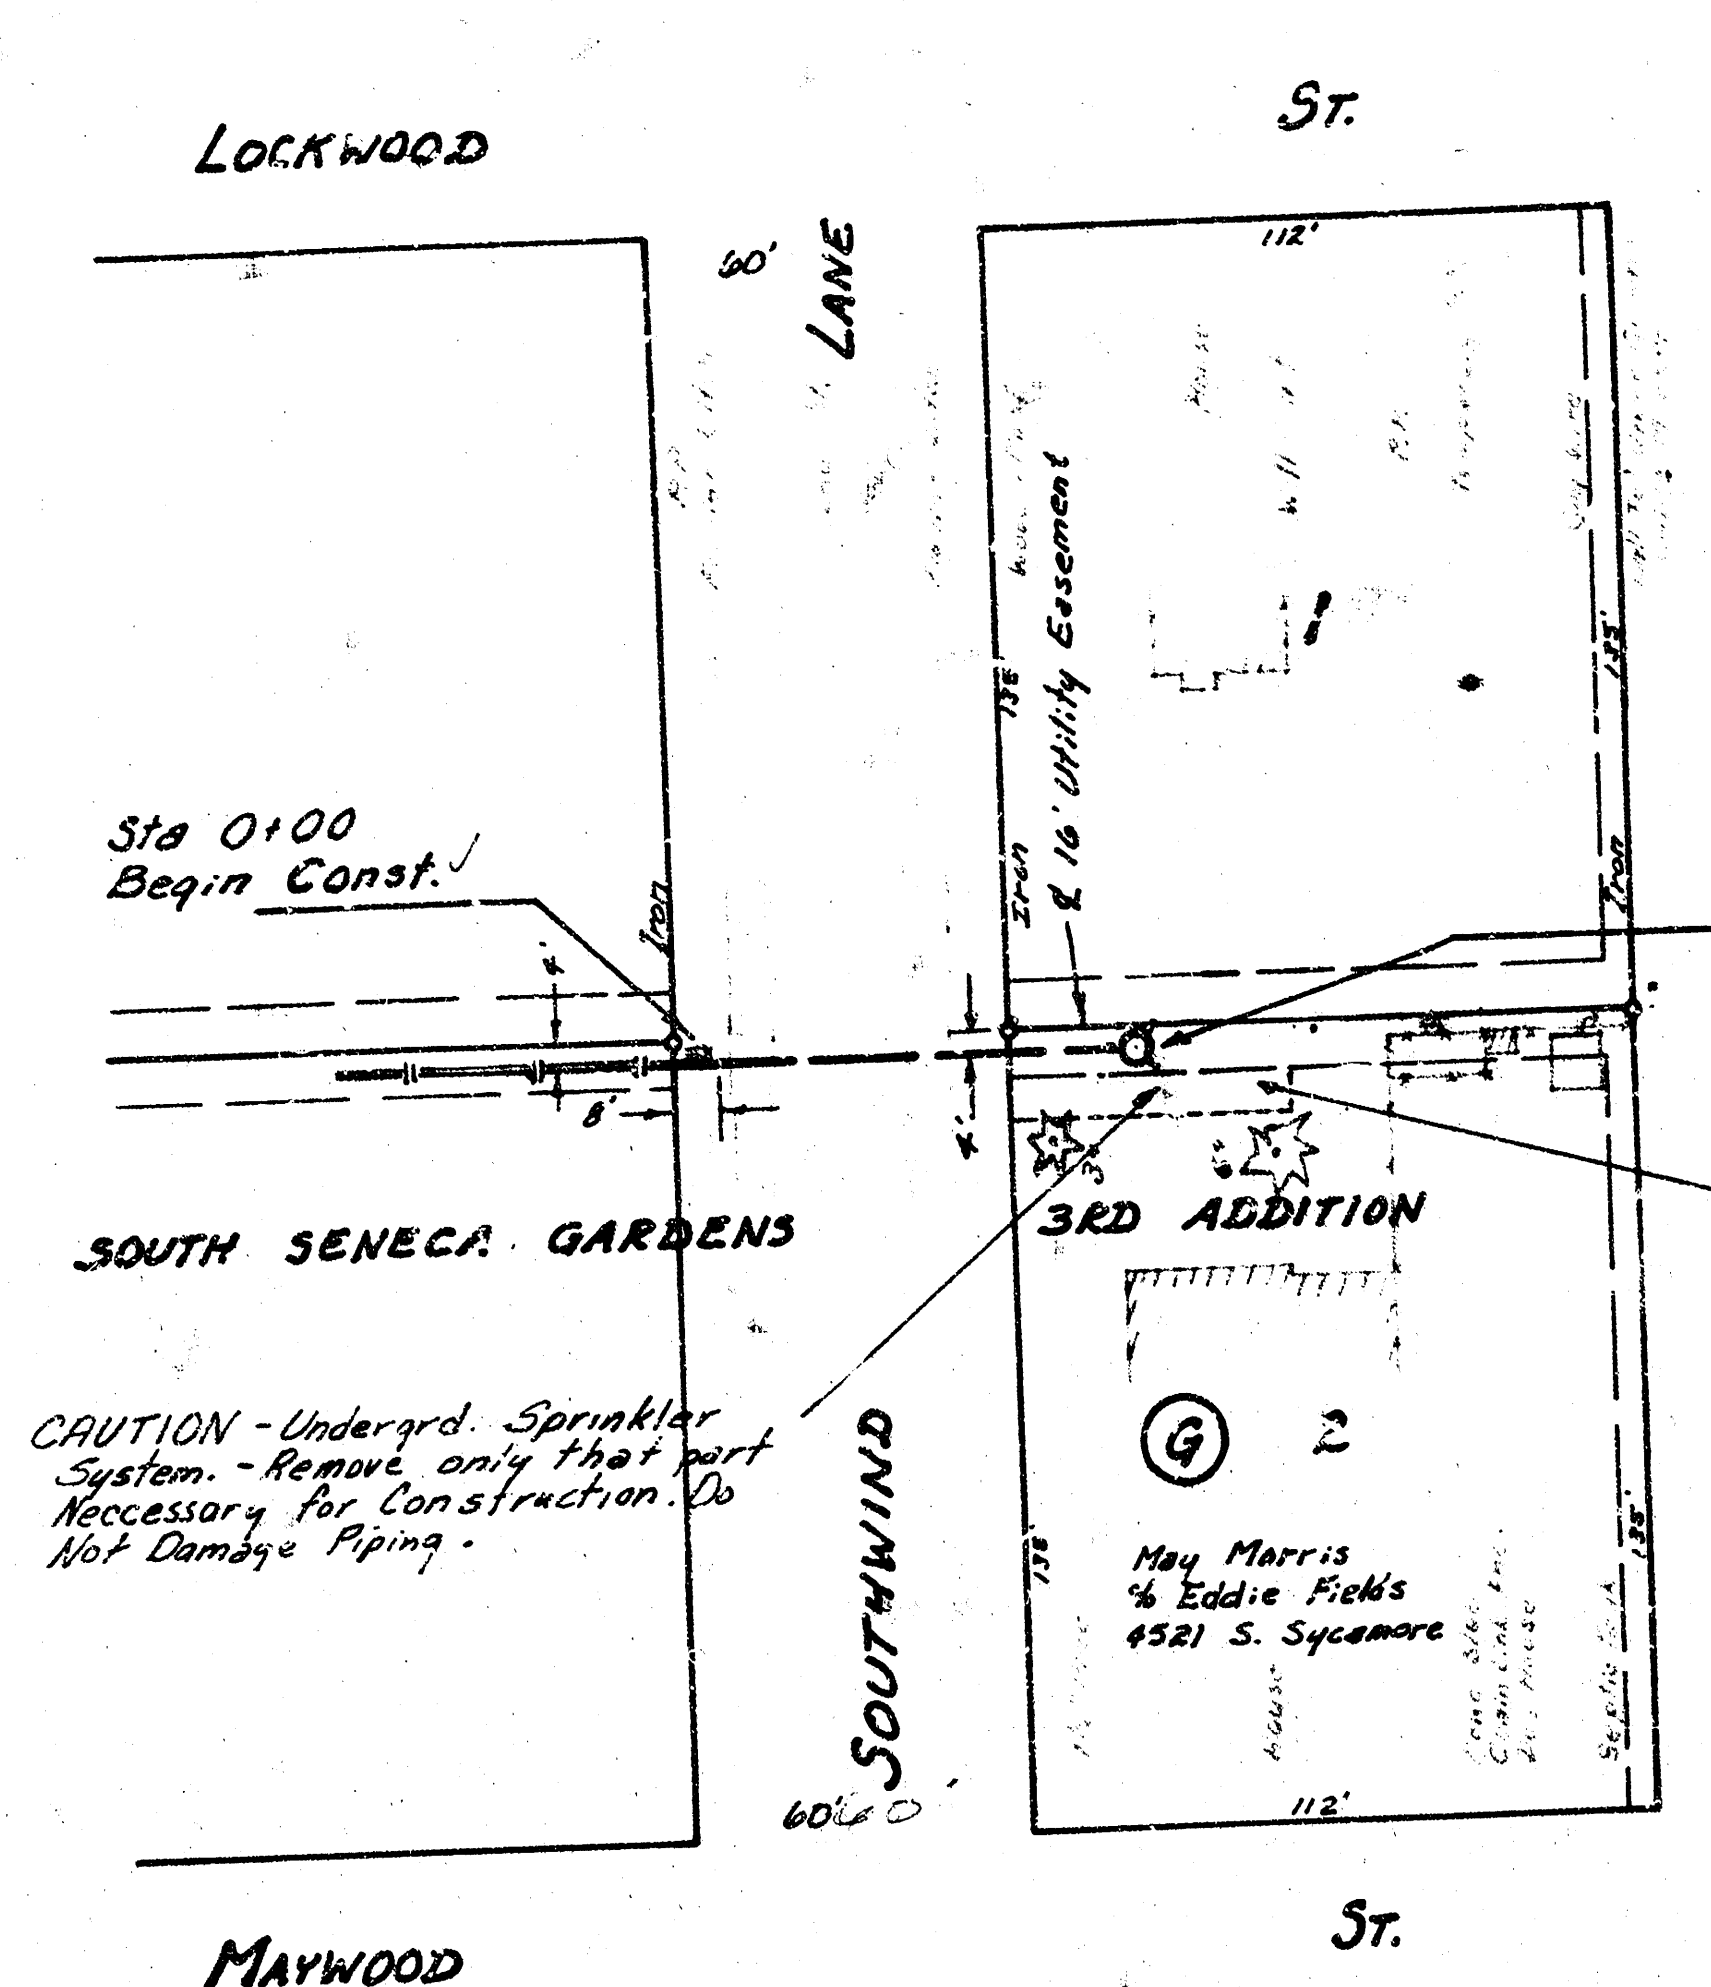


Scale Plan 1" = 40'
Profile 1" = 40' Horiz.
1" = 5' Vert.

THE CONTRACTOR SHALL BE RESPONSIBLE FOR PRESERVING PROPERTY IRONS. THE CONTRACTOR SHALL BE REQUIRED TO RE-ESTABLISH ANY PROPERTY IRONS WHICH ARE DAMAGED OR DESTROYED BY HIS CONSTRUCTION OPERATIONS. SUCH IRONS SHALL BE RE-ESTABLISHED BY A LICENSED LAND SURVEYOR OR A LICENSED PROFESSIONAL ENGINEER IN ACCORDANCE WITH STATE LAWS.

As Built
J.L.
1/43

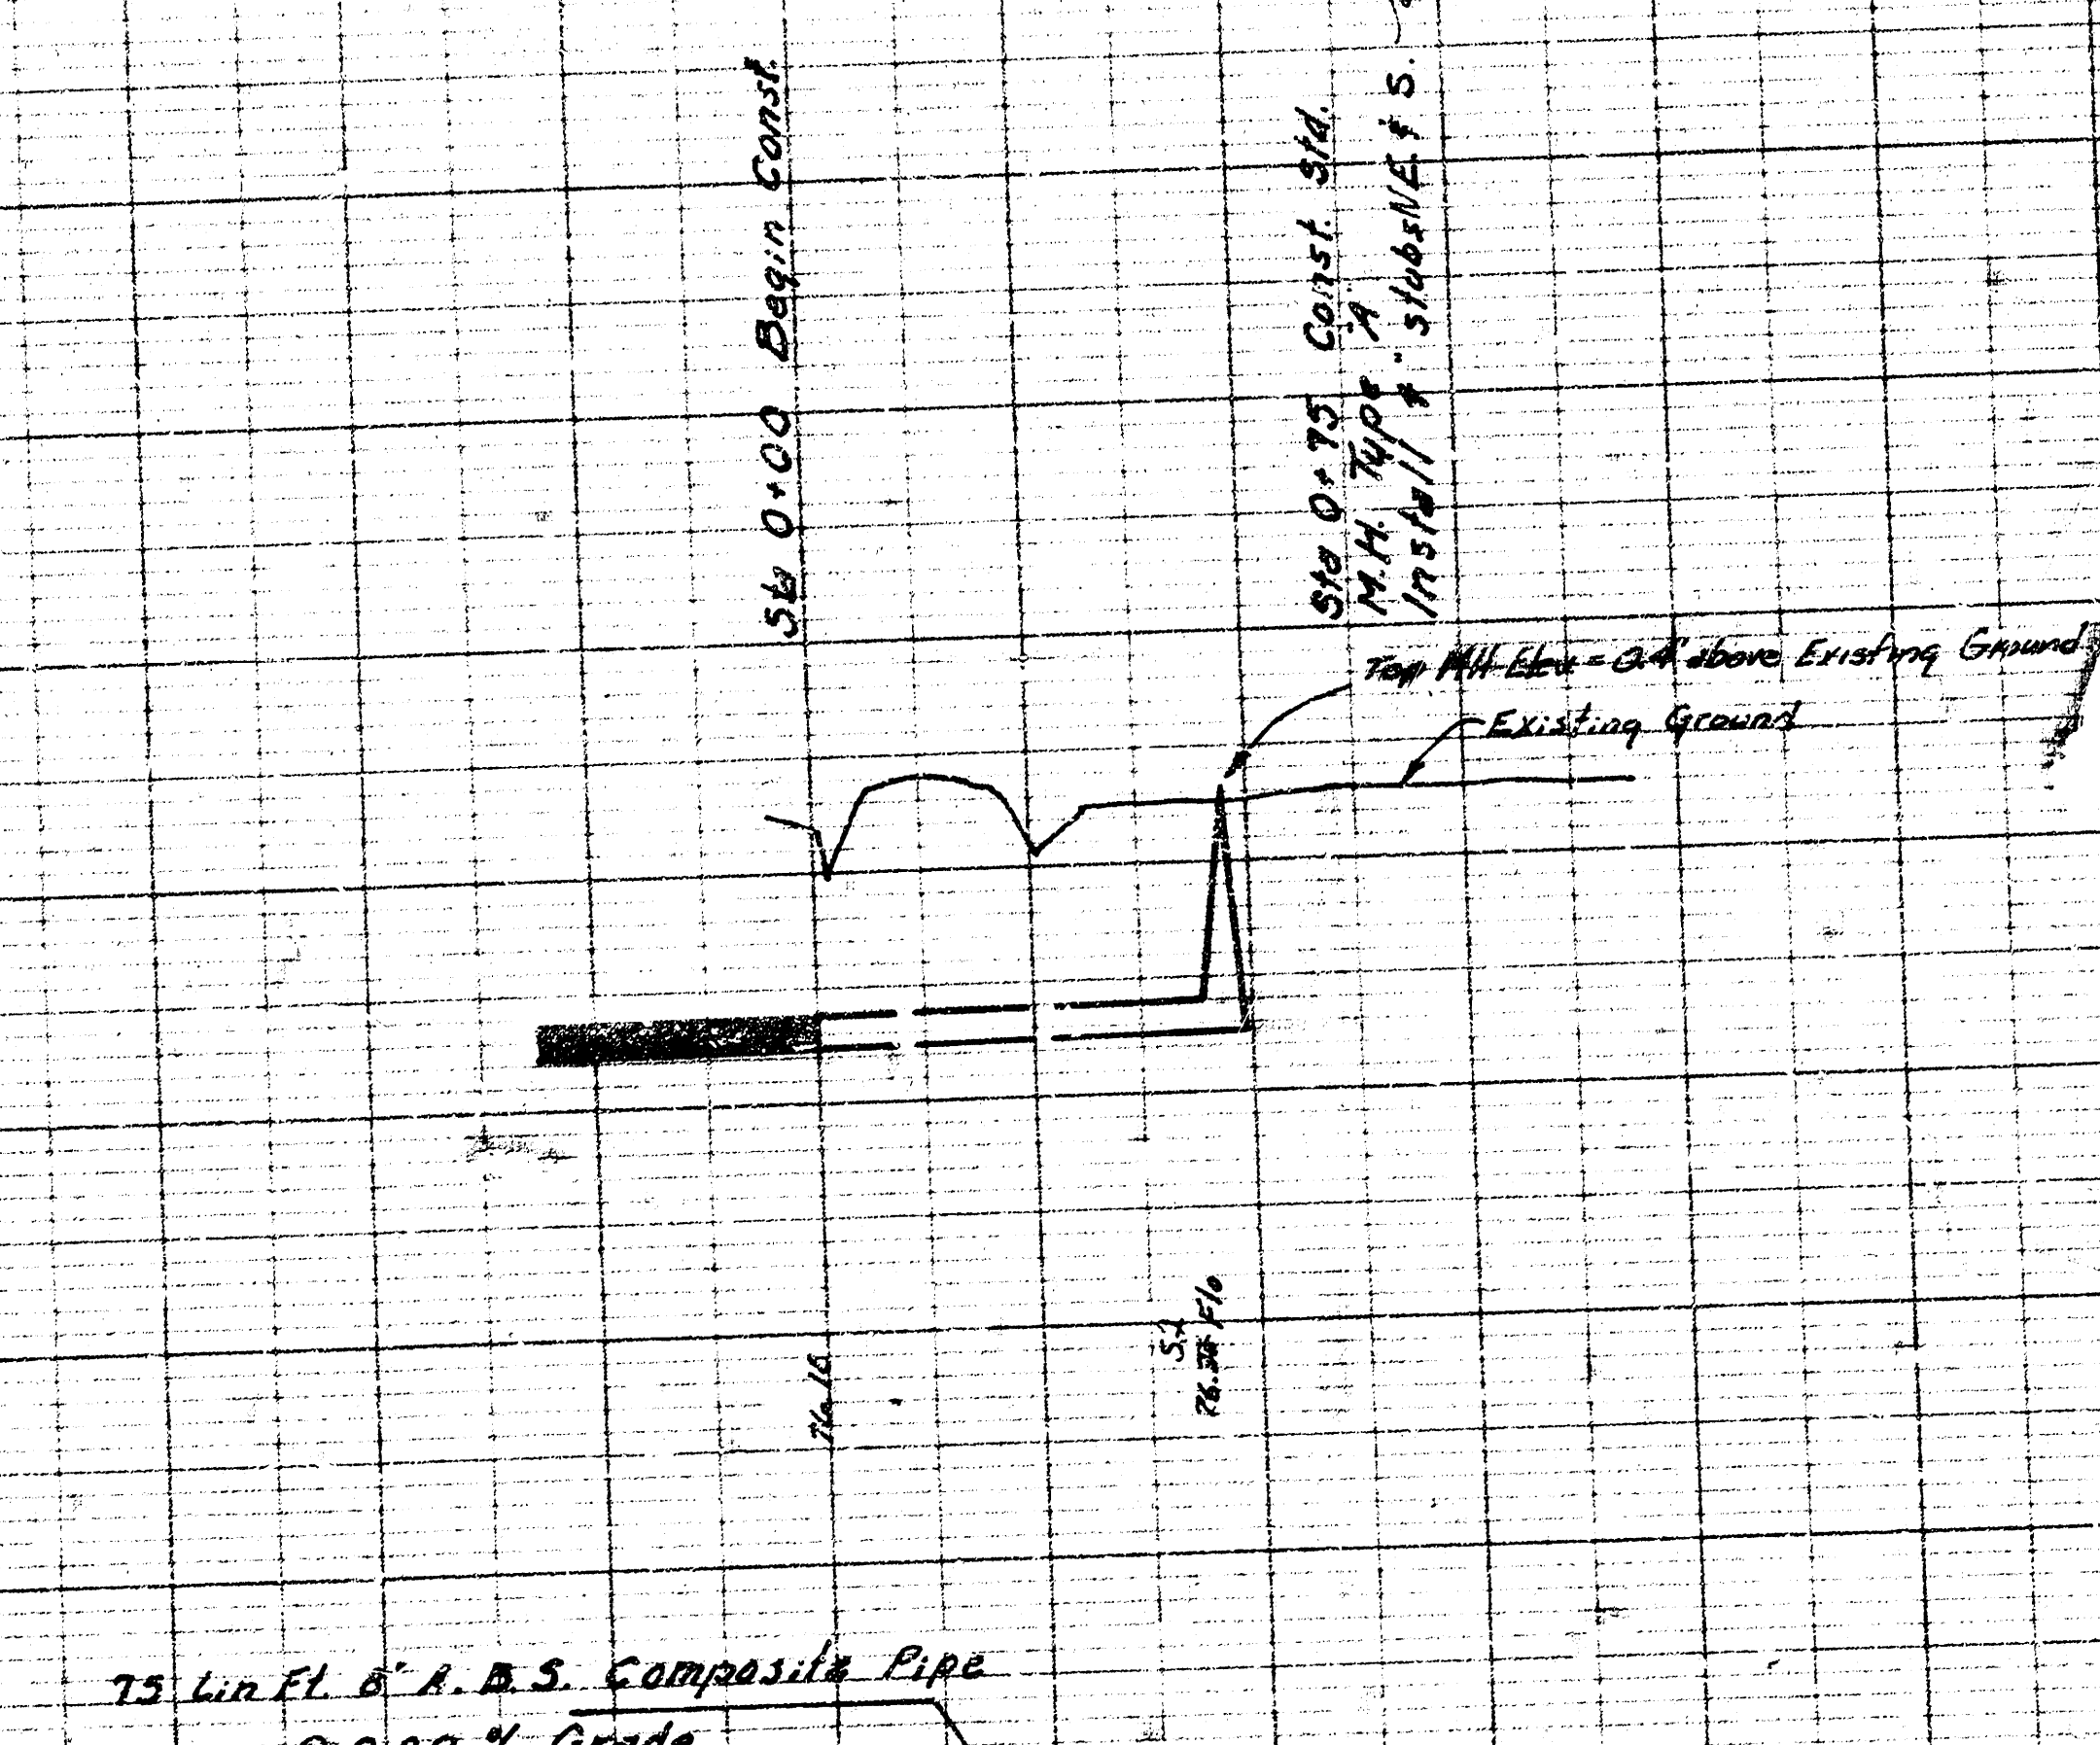


LAT 26, MAIN 3, S.W. INTERCEPTOR
CITY OF WICHITA, KANSAS
R. W. BRUGGEMAN — CITY ENGINEER
PROJECT NO. 468 76 245 80399-000

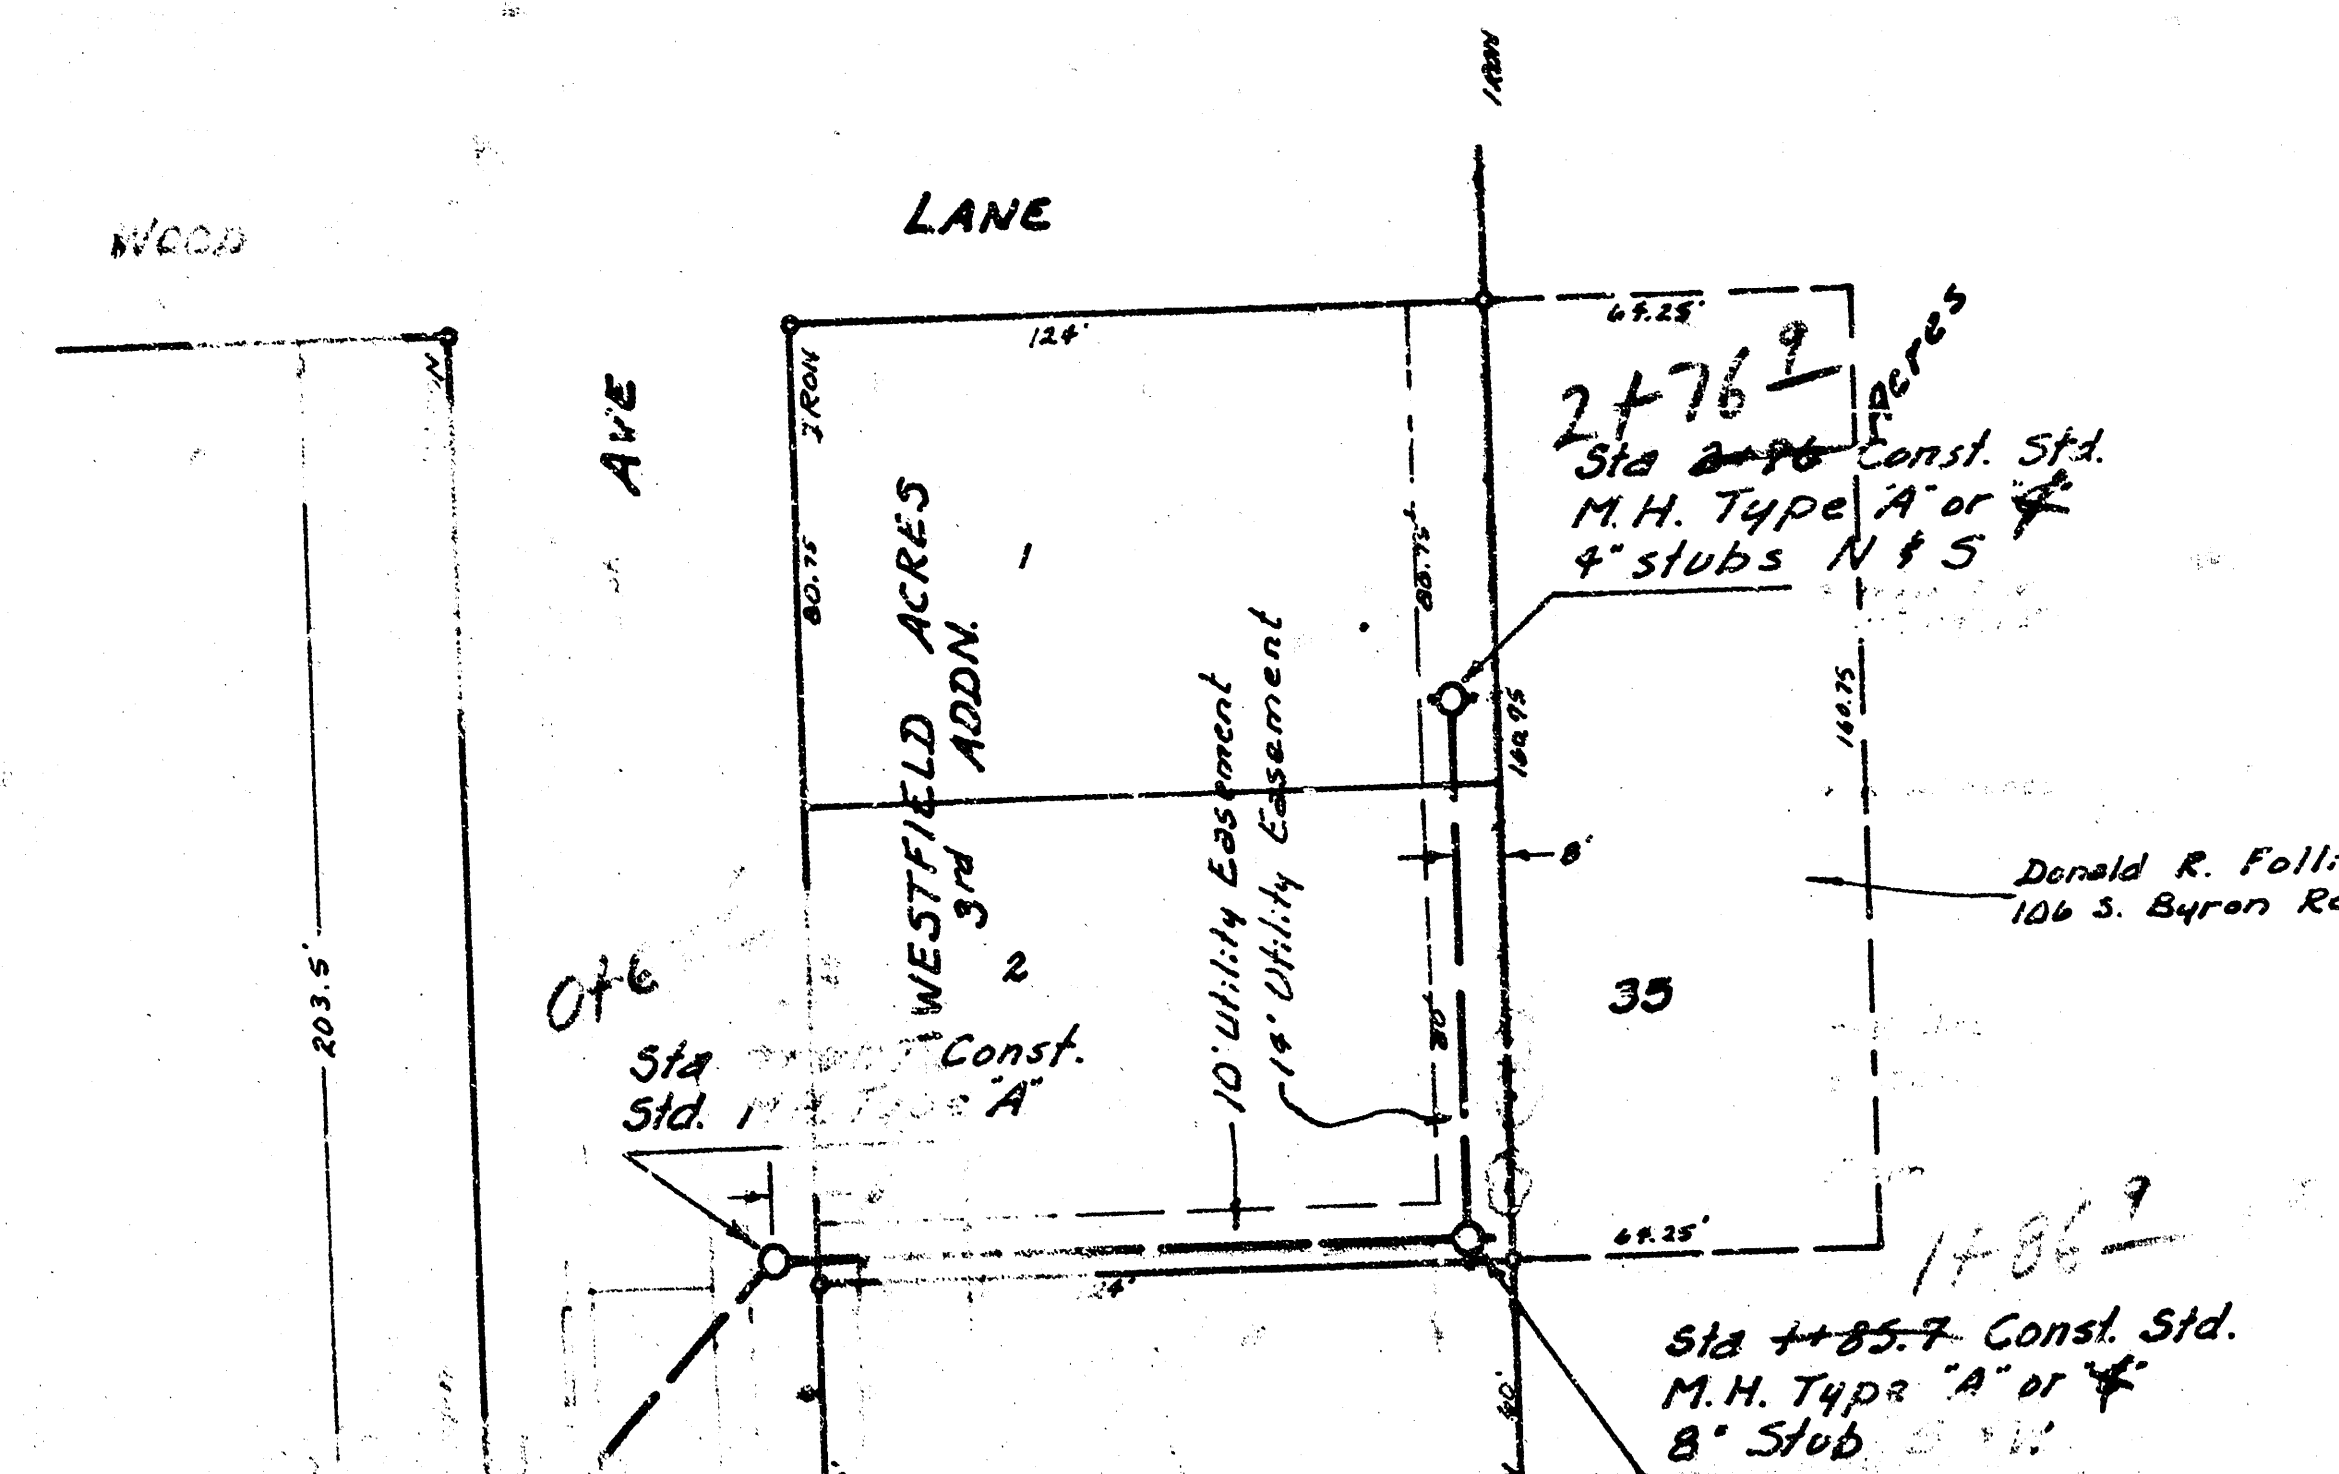


Scale Plan 1" = 40'
Profile 1" = 40' Horiz.
1" = 5' Vert.

ONLY
FROM BLUE PRINTS

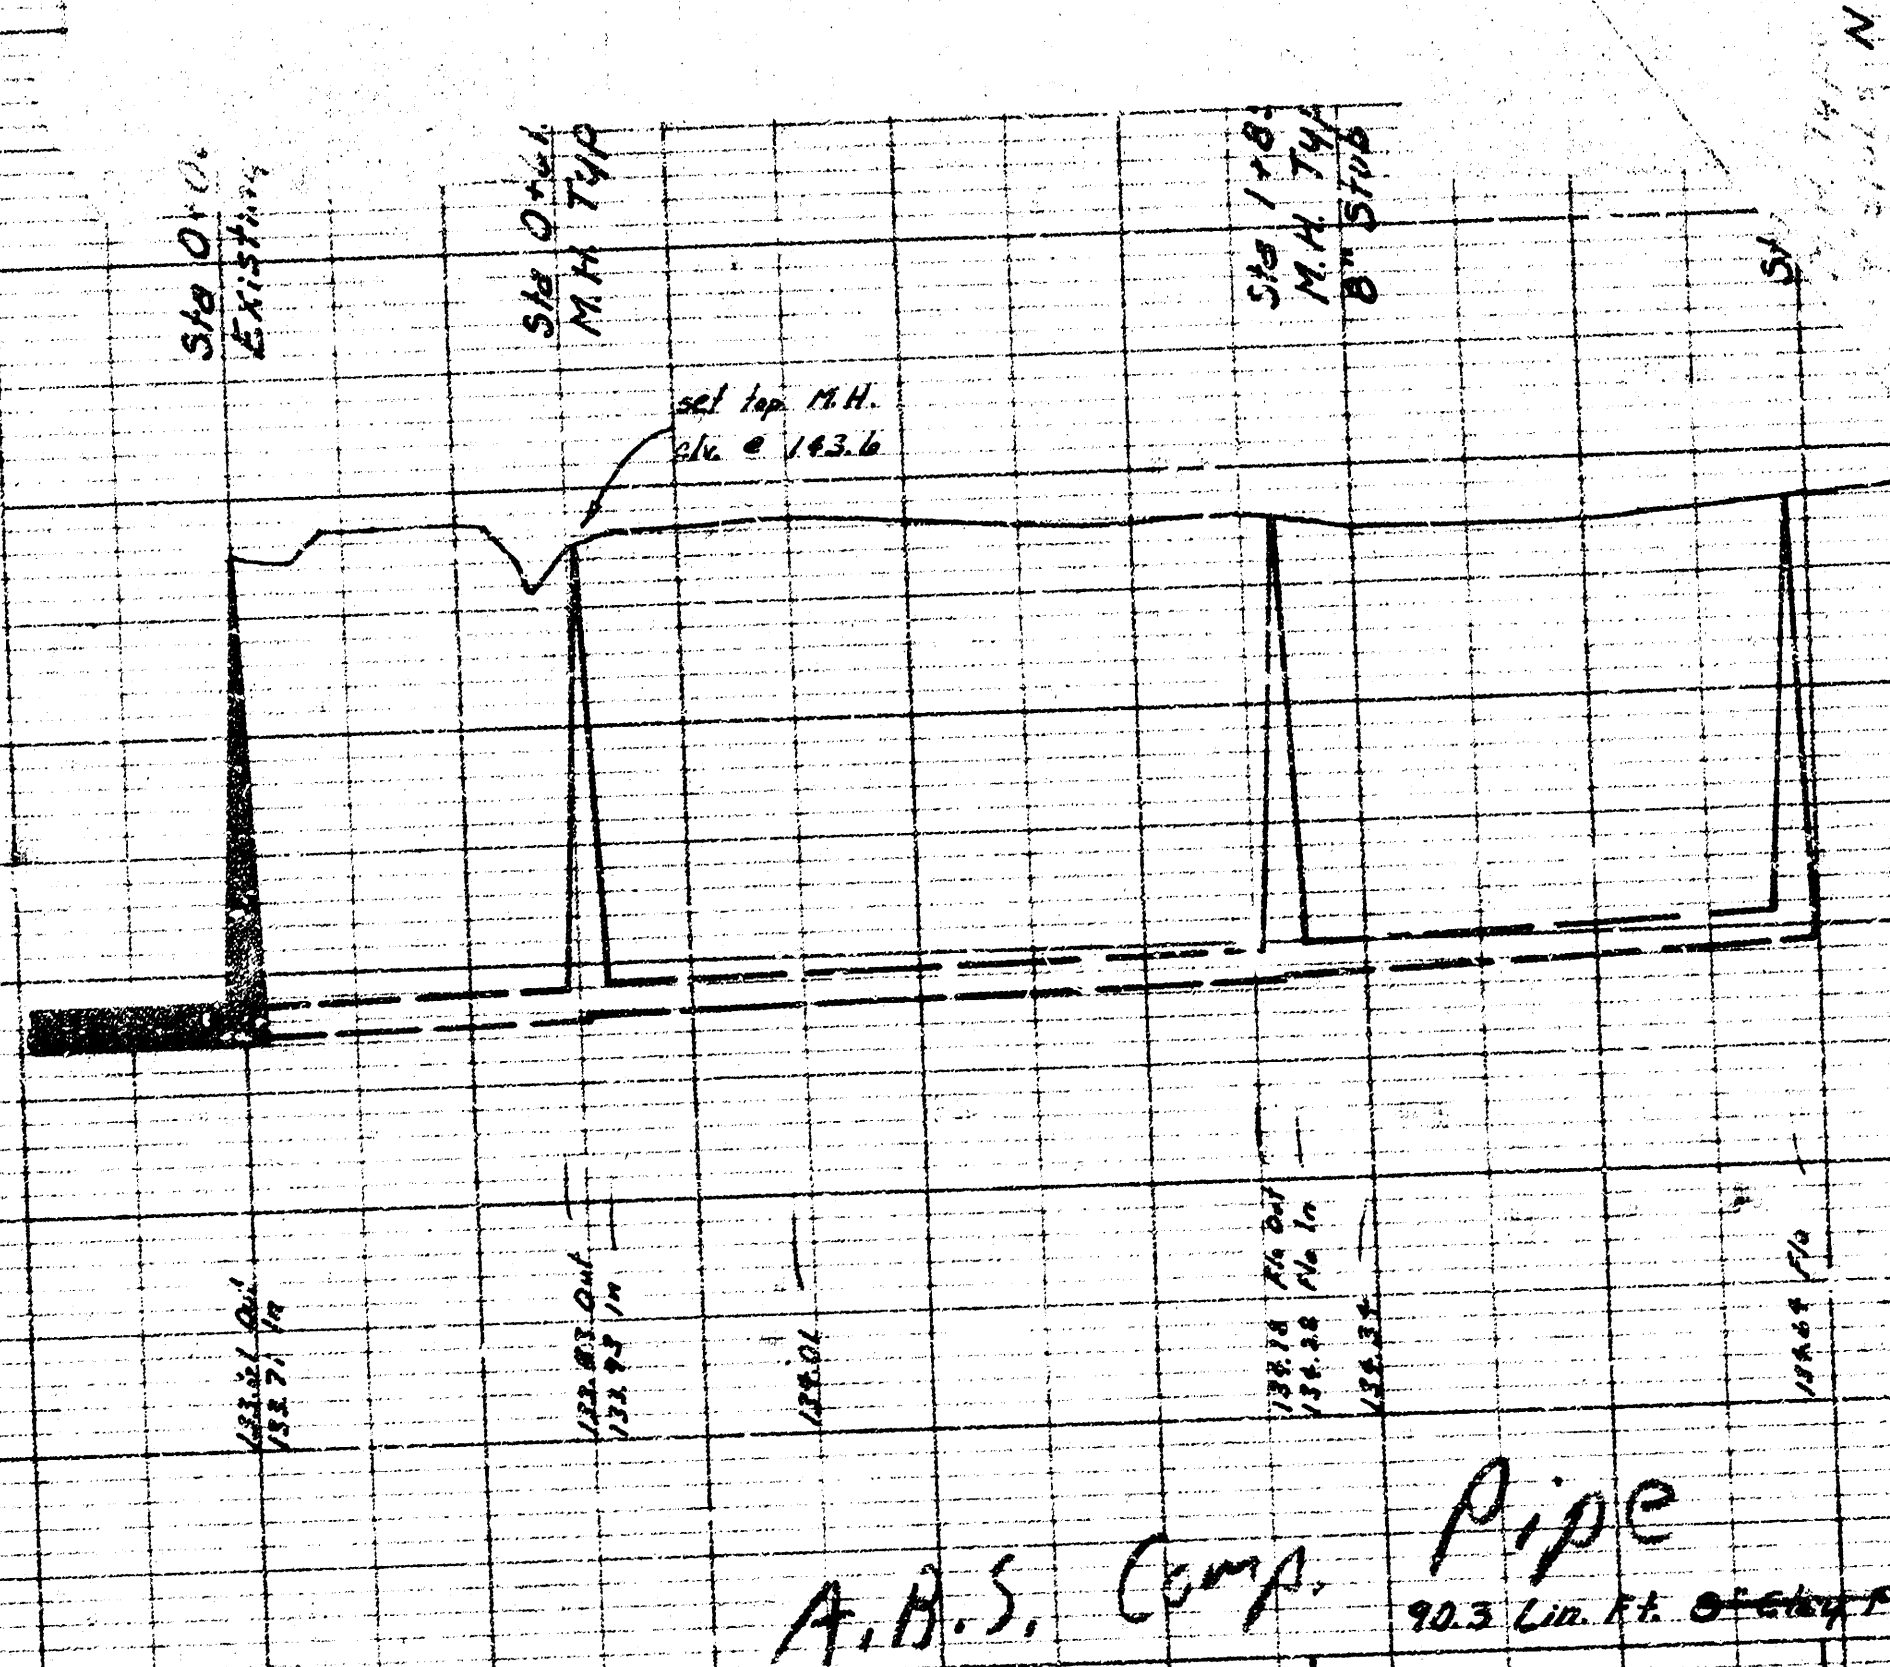

LAT 15, MAIN 1, WESTLINK SEWER
CITY OF WICHITA, KANSAS
R. W. LINN — CITY ENGINEER
PROJECT NO. DBK 571022

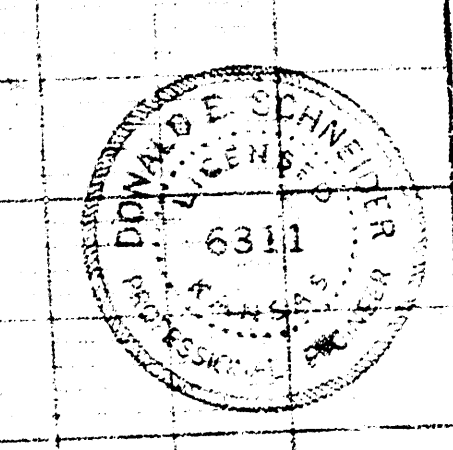

FILMED FROM THE BEST AVAILABLE COPY