






SCALE PLAN 1"=40' HORIZ.
PROFILE 1"=5' VERT.

THE CONTRACTOR SHALL BE RESPONSIBLE FOR PRESERVING PROPERTY IRONS. THE CONTRACTOR SHALL BE REQUIRED TO RE-ESTABLISH ANY PROPERTY IRONS WHICH ARE DAMAGED OR DESTROYED BY HIS CONSTRUCTION OPERATIONS. SUCH IRONS SHALL BE RE-ESTABLISHED BY A LICENSED LAND SURVEYOR OR A LICENSED PROFESSIONAL ENGINEER IN ACCORDANCE WITH STATE LAWS.

C.M. 86.85 CITY STD. 47th ST. SO. & GOLD.
128 ft. W. AND 35 ft. N OF 1/4 SEC. CORNER.
B.M. 87.69 R.R. SPIKE NW FACE R.P. SE.
CORNER 47th ST. SO. AND LACLEDE.

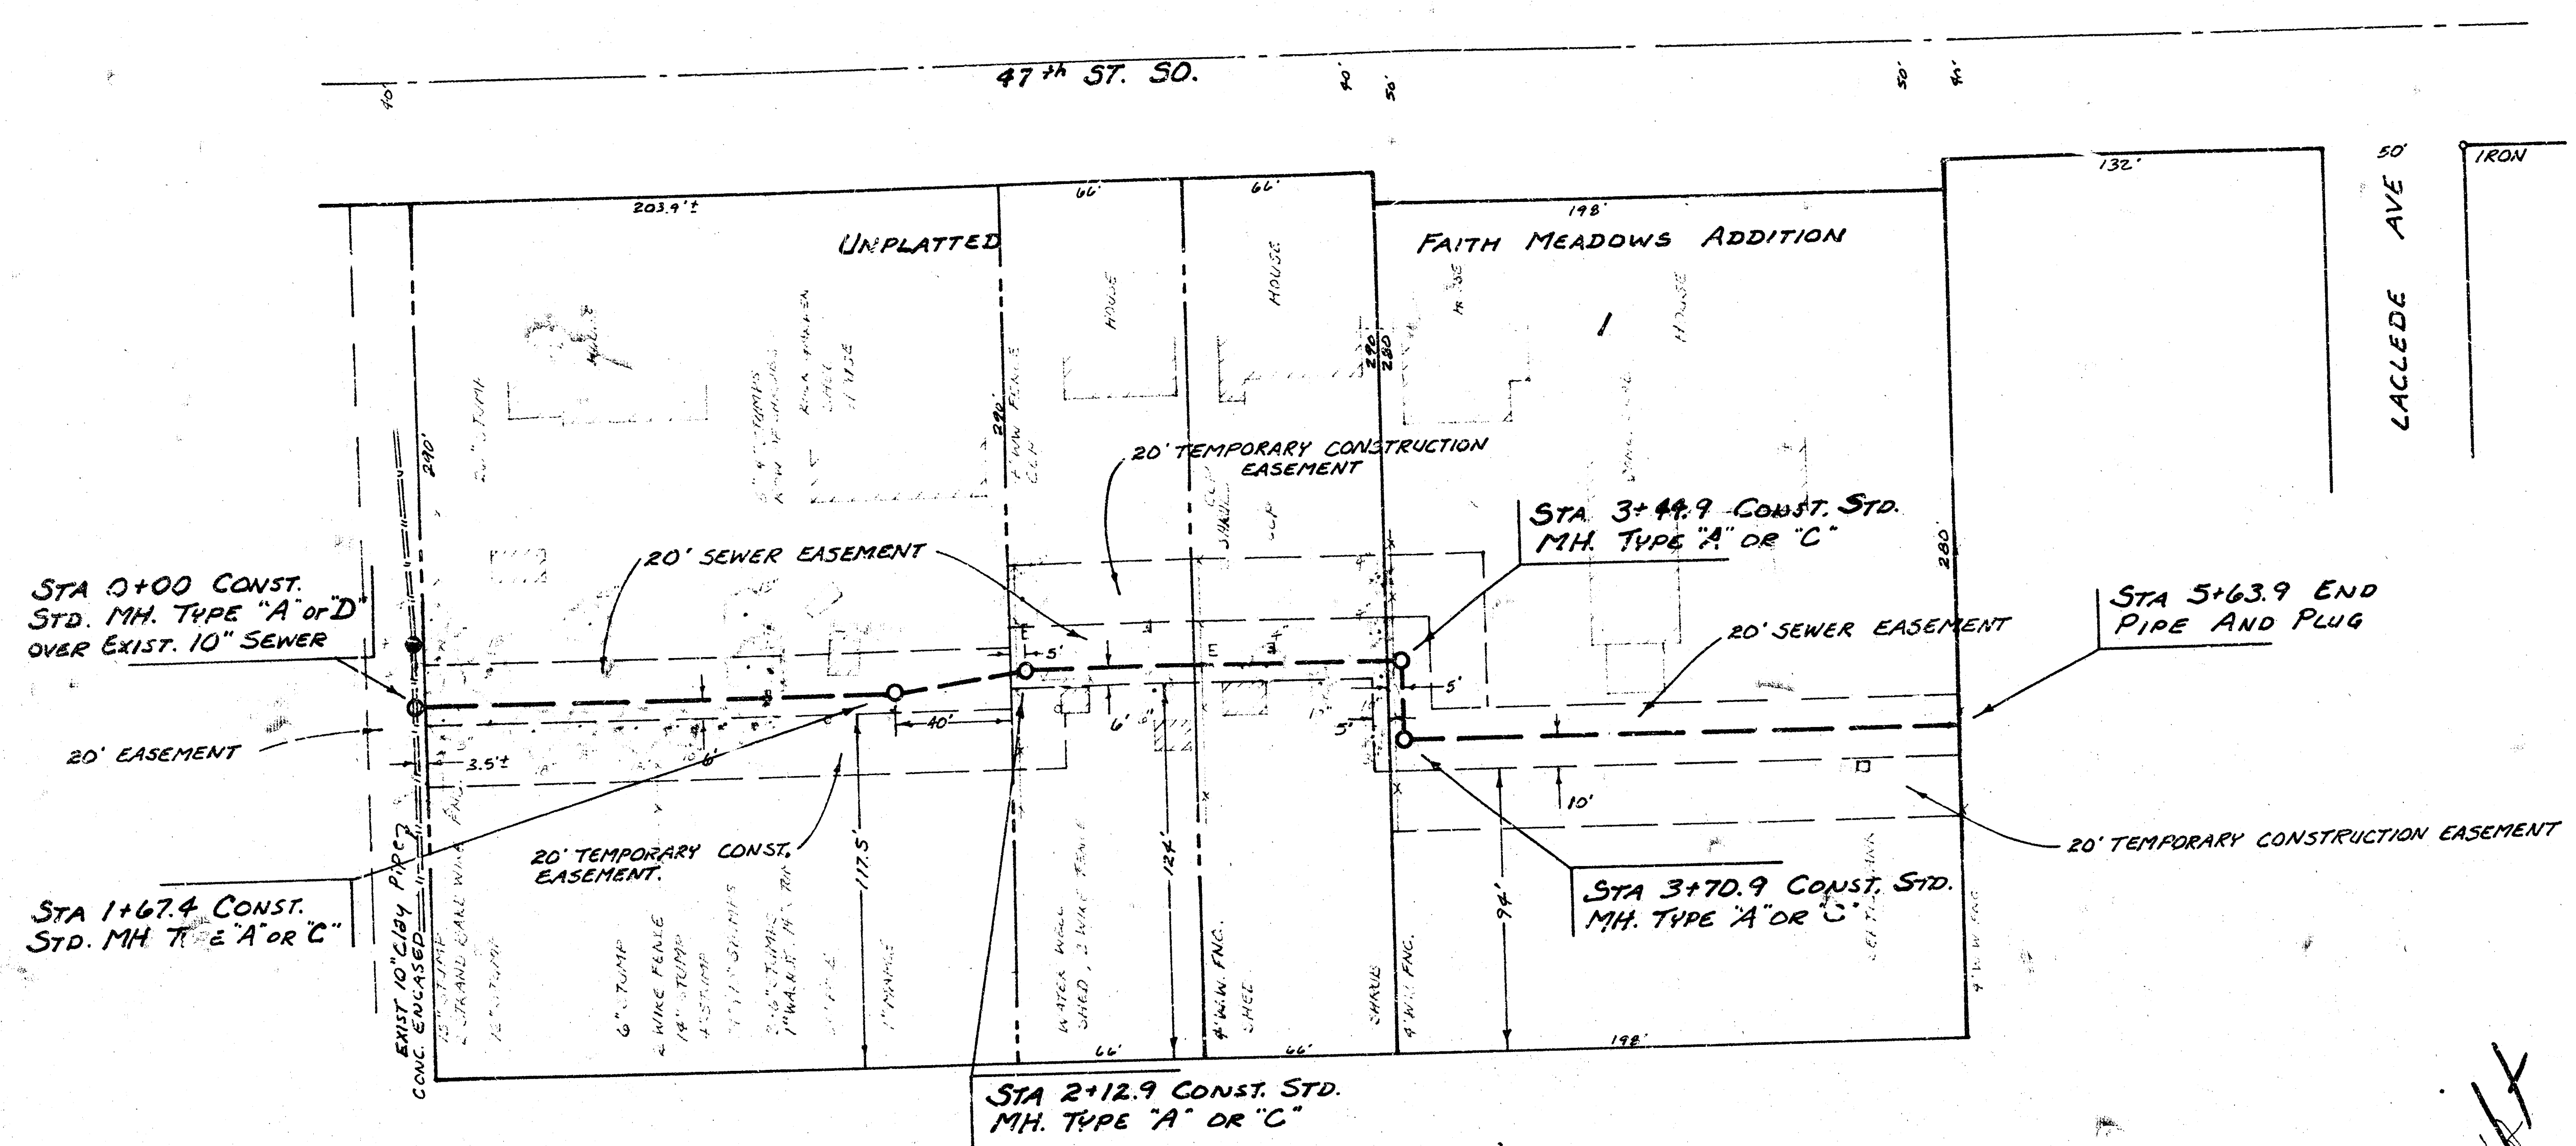

*As Built
1-83
J.L.T.*

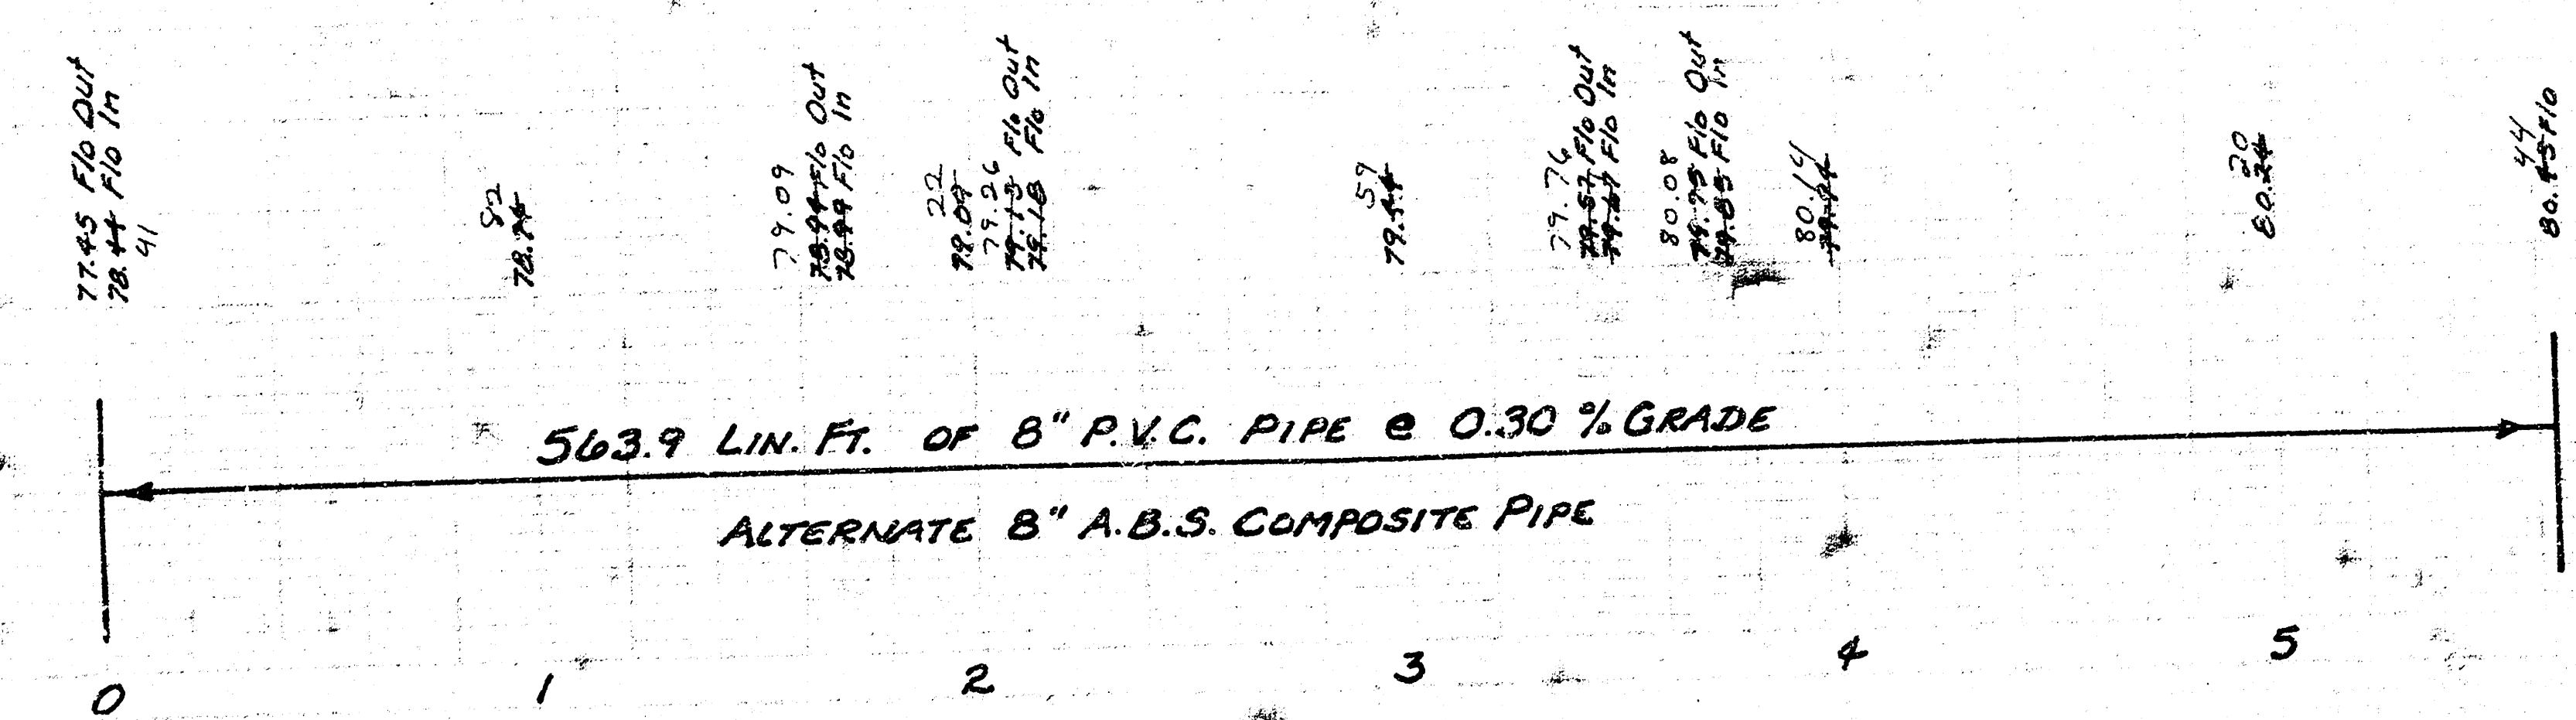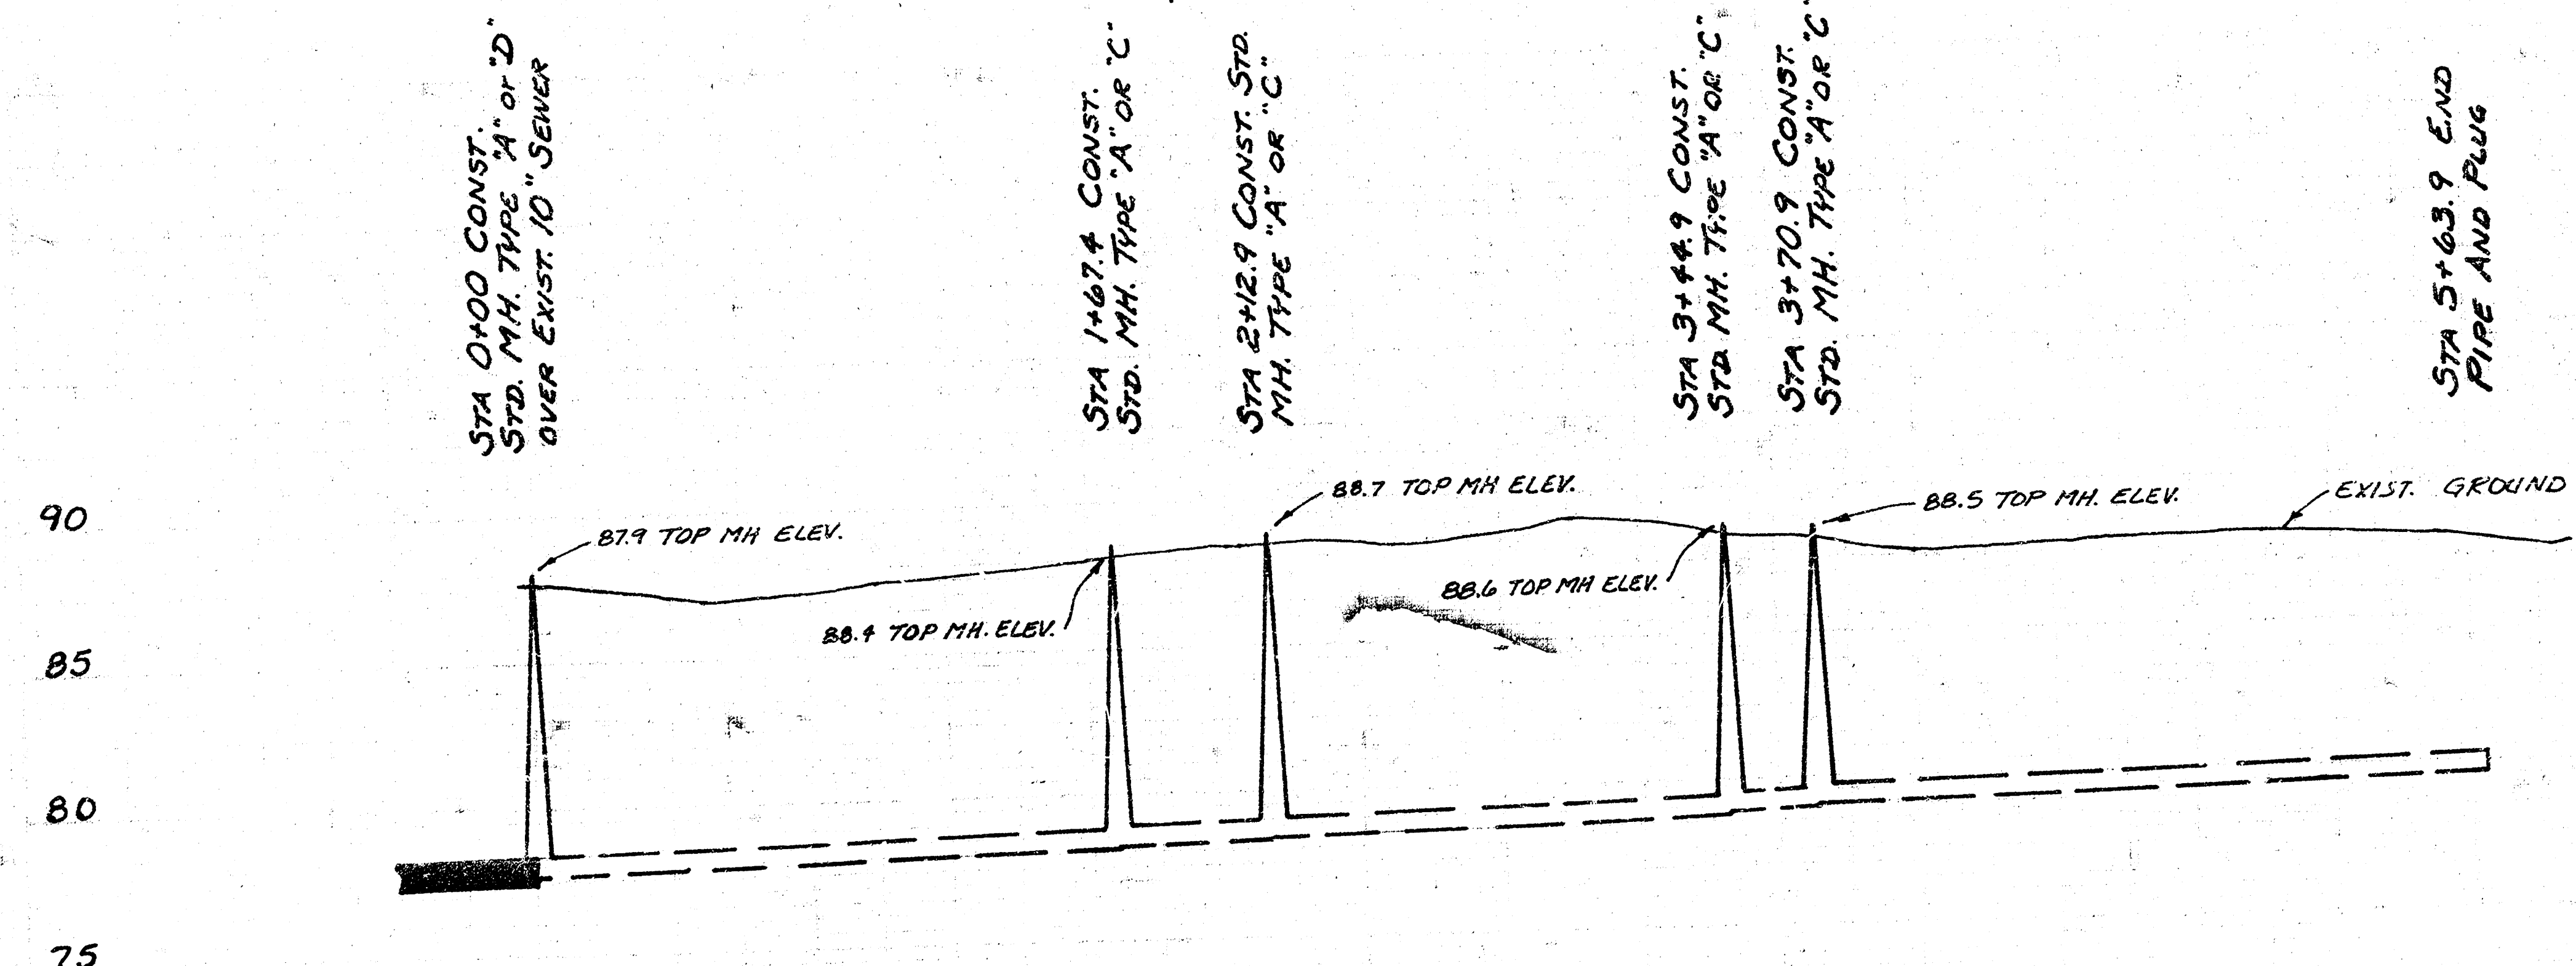

PROJECT DESCRIPTION			
LAT 34, MAIN 3, SW INTERCEPTOR			
PROJECT NUMBER			
458-75-245-81079-000-001			
BOOK NO. 116-15	APPROVED BY	DATE	REVISION
DRAWN BY LCOM15		12/5/82	
CITY OF WICHITA			
DEPARTMENT OF ENGINEERING			
DIRECTOR OF ENG./CITY ENGINEER			
R. W. BRUGGEMAN			
SCALE			

10 5 0 10 1/2