

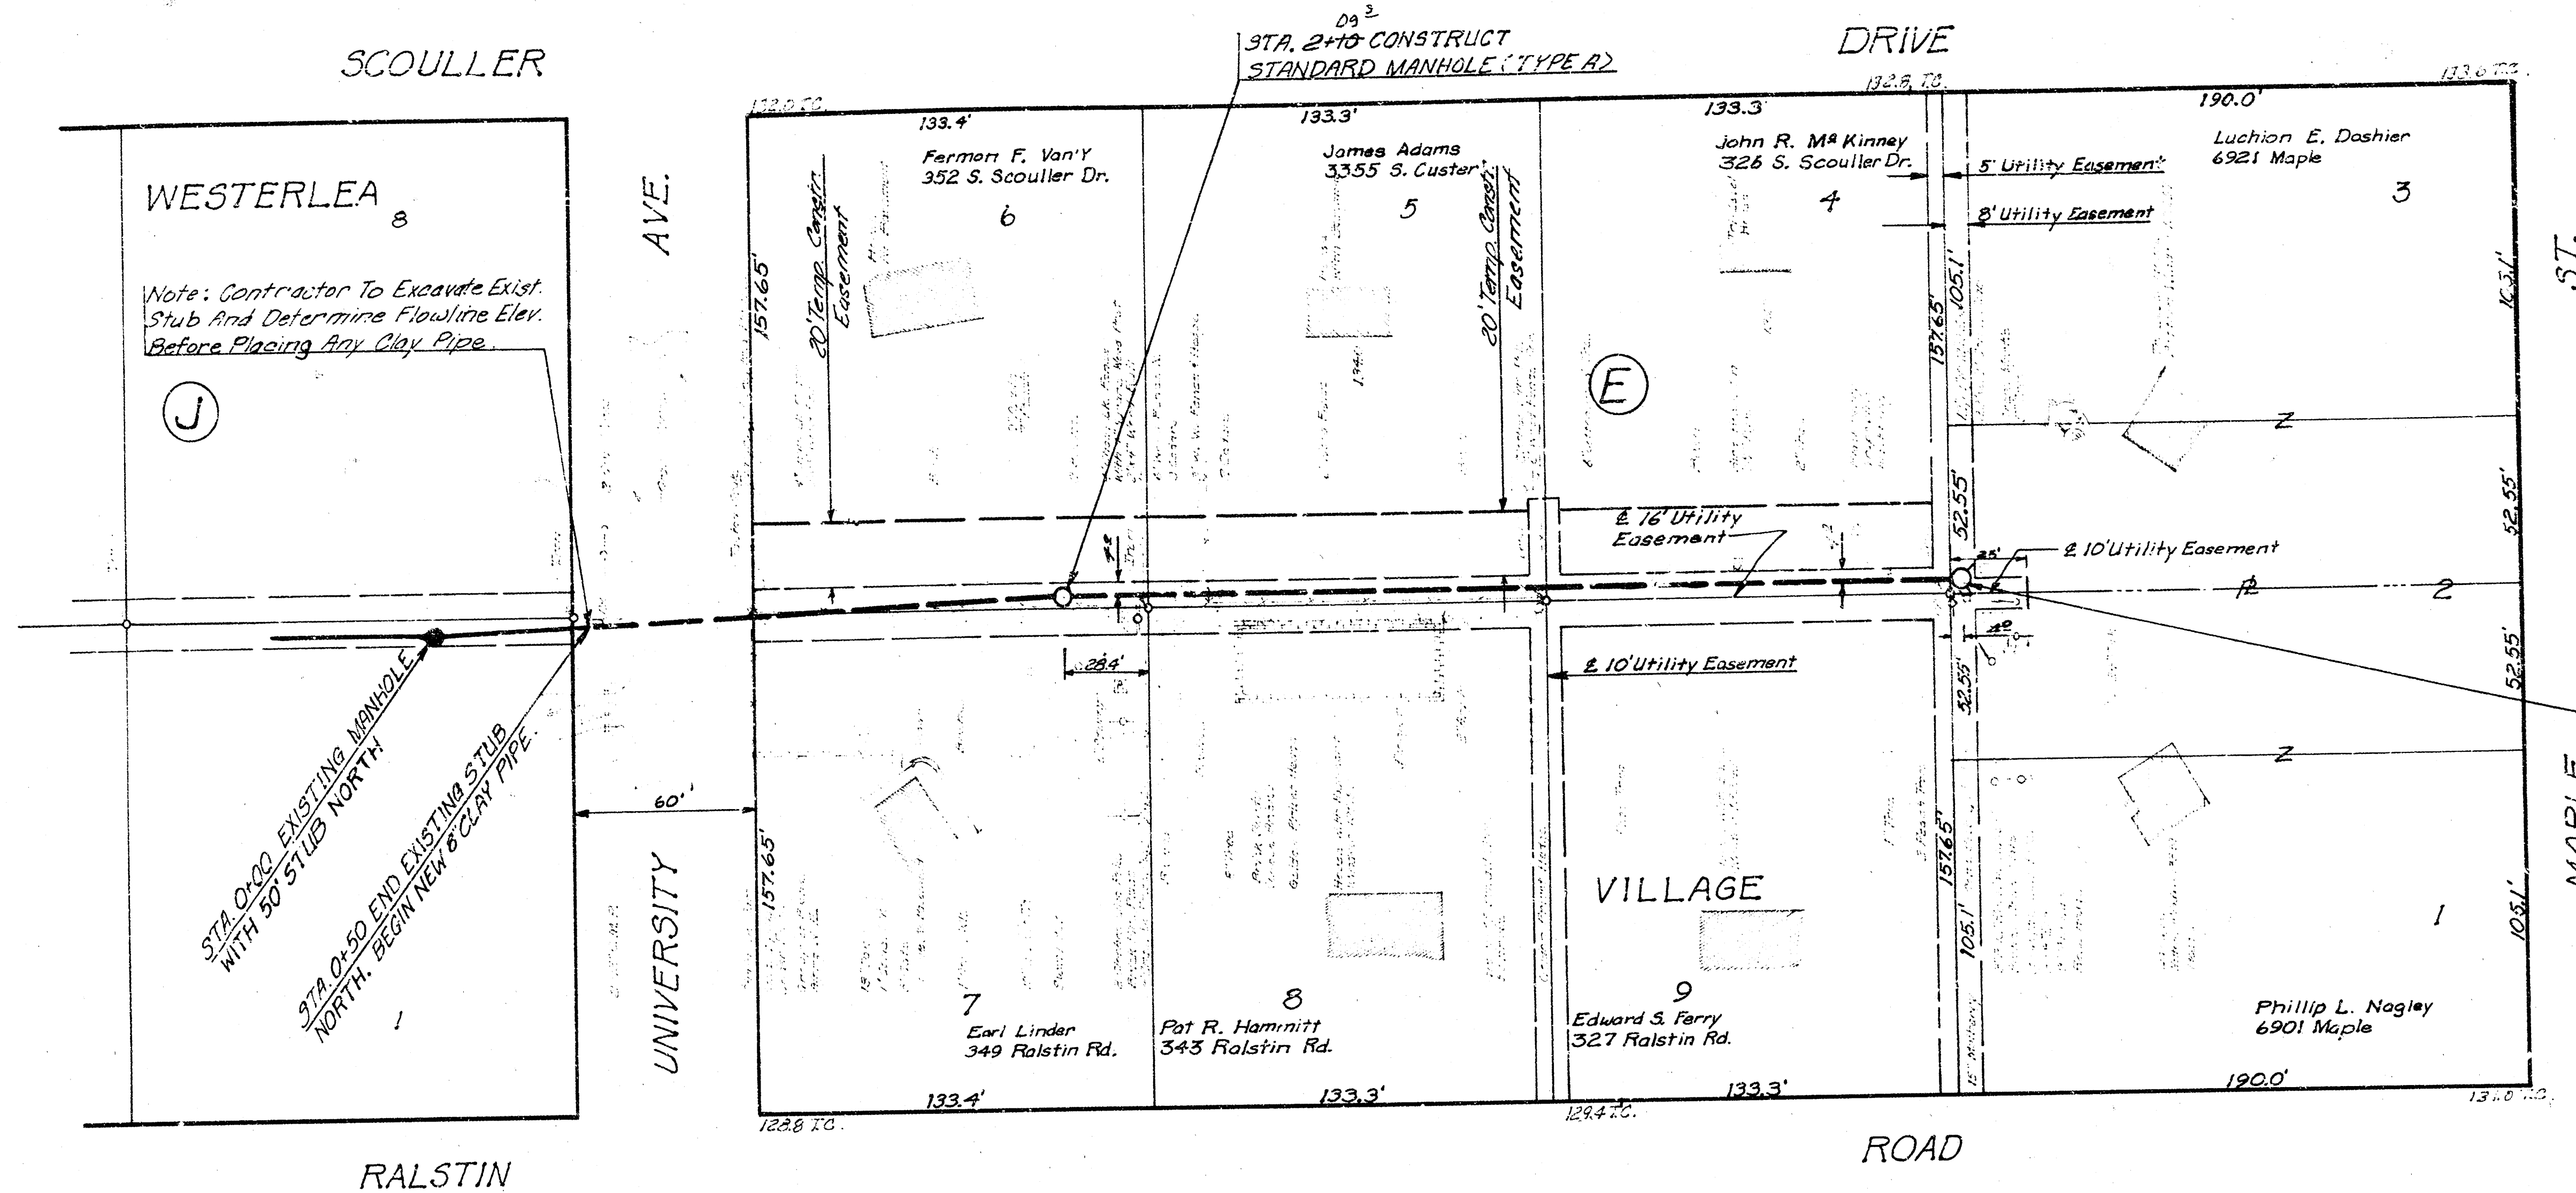


B. M. 130.58 R. R. Spk. S.- Side P.P. on N. E. cor. Taft & Ralstin.

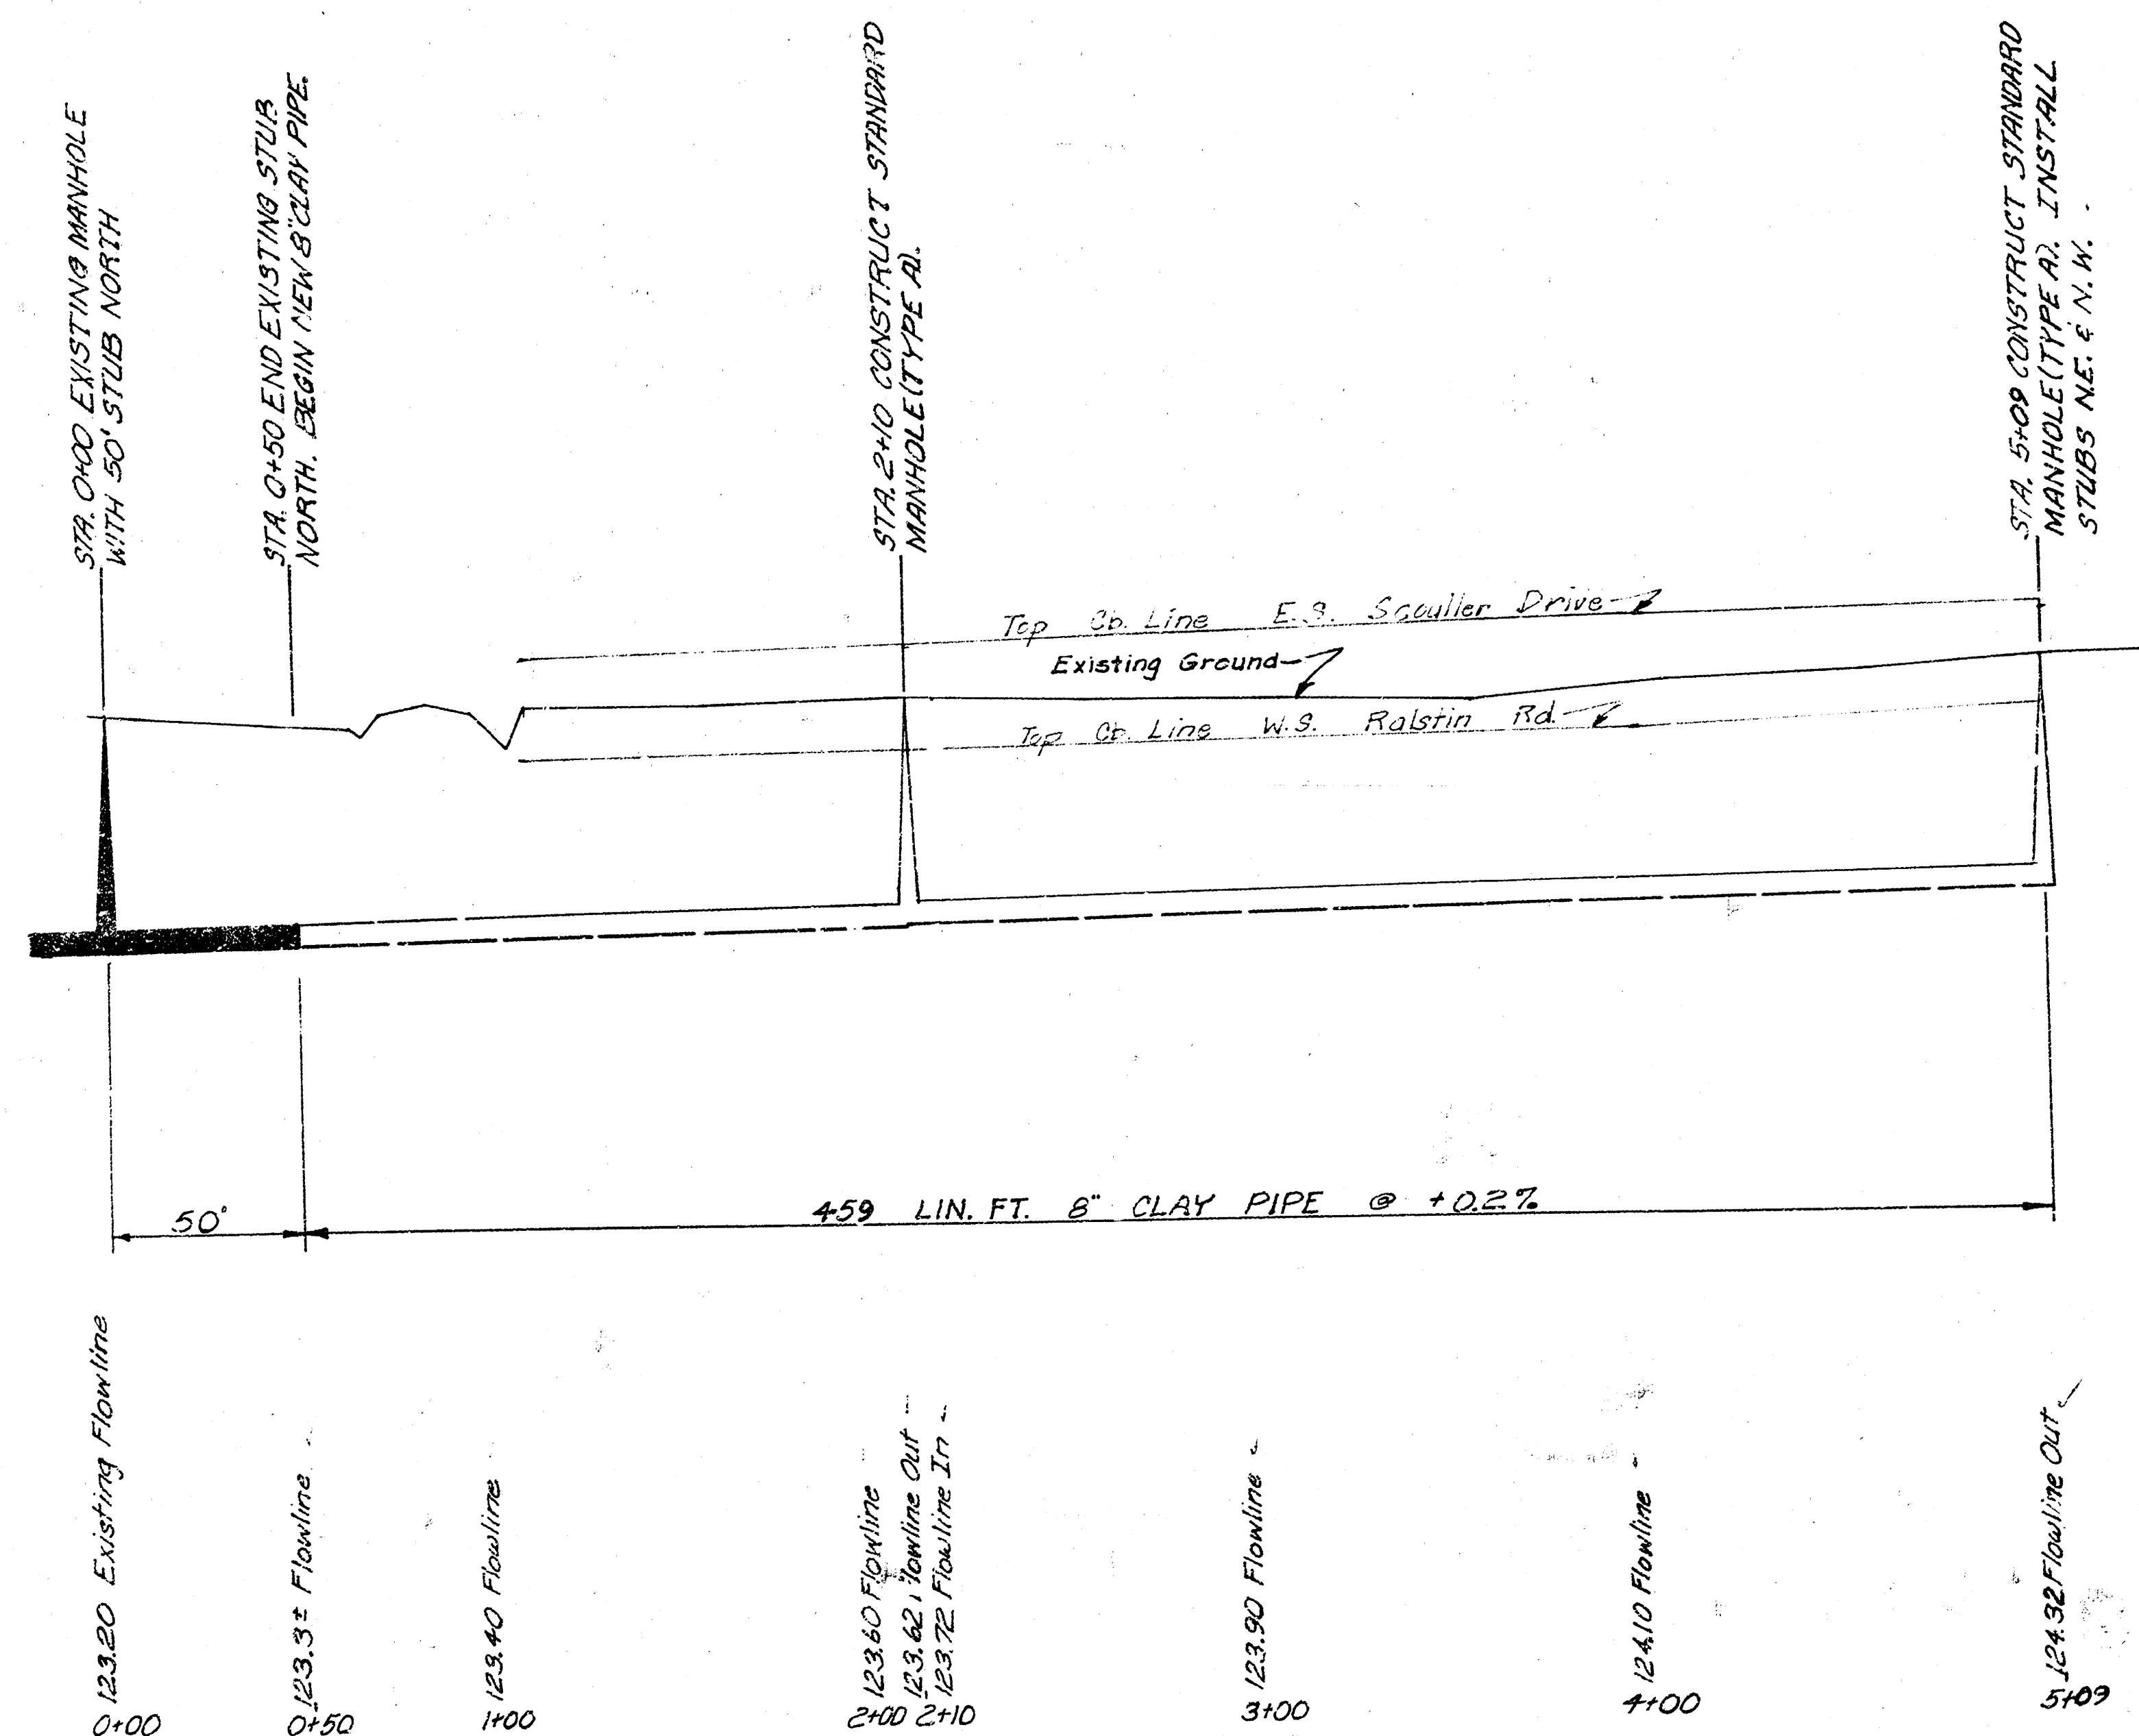

Note: All Property Irons That May Be Disturbed Shall Have Tags Taken To Them Where They May Be Replaced If Disturbed.

PLAN SCALE : 1"=40' HORIZ.
PROFILE SCALE : 1"=5' VERT.

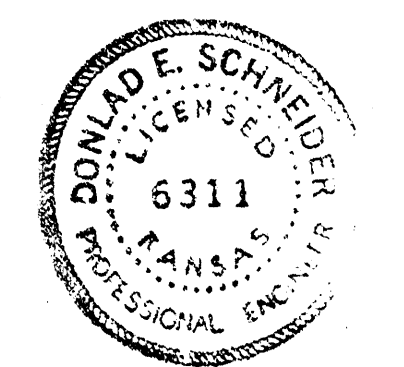

"As Built" Final Measurements K-103

LAT. 5, MAIN 4, S.W. INTERCEPTOR SEWER
CITY OF WICHITA, KANSAS
R. W. LINN — CITY ENGINEER
SEPT. 1972 PROJECT NO. DBKL 571028