


776-180


Exist. 40' stub removed and replaced

UNPLATTED

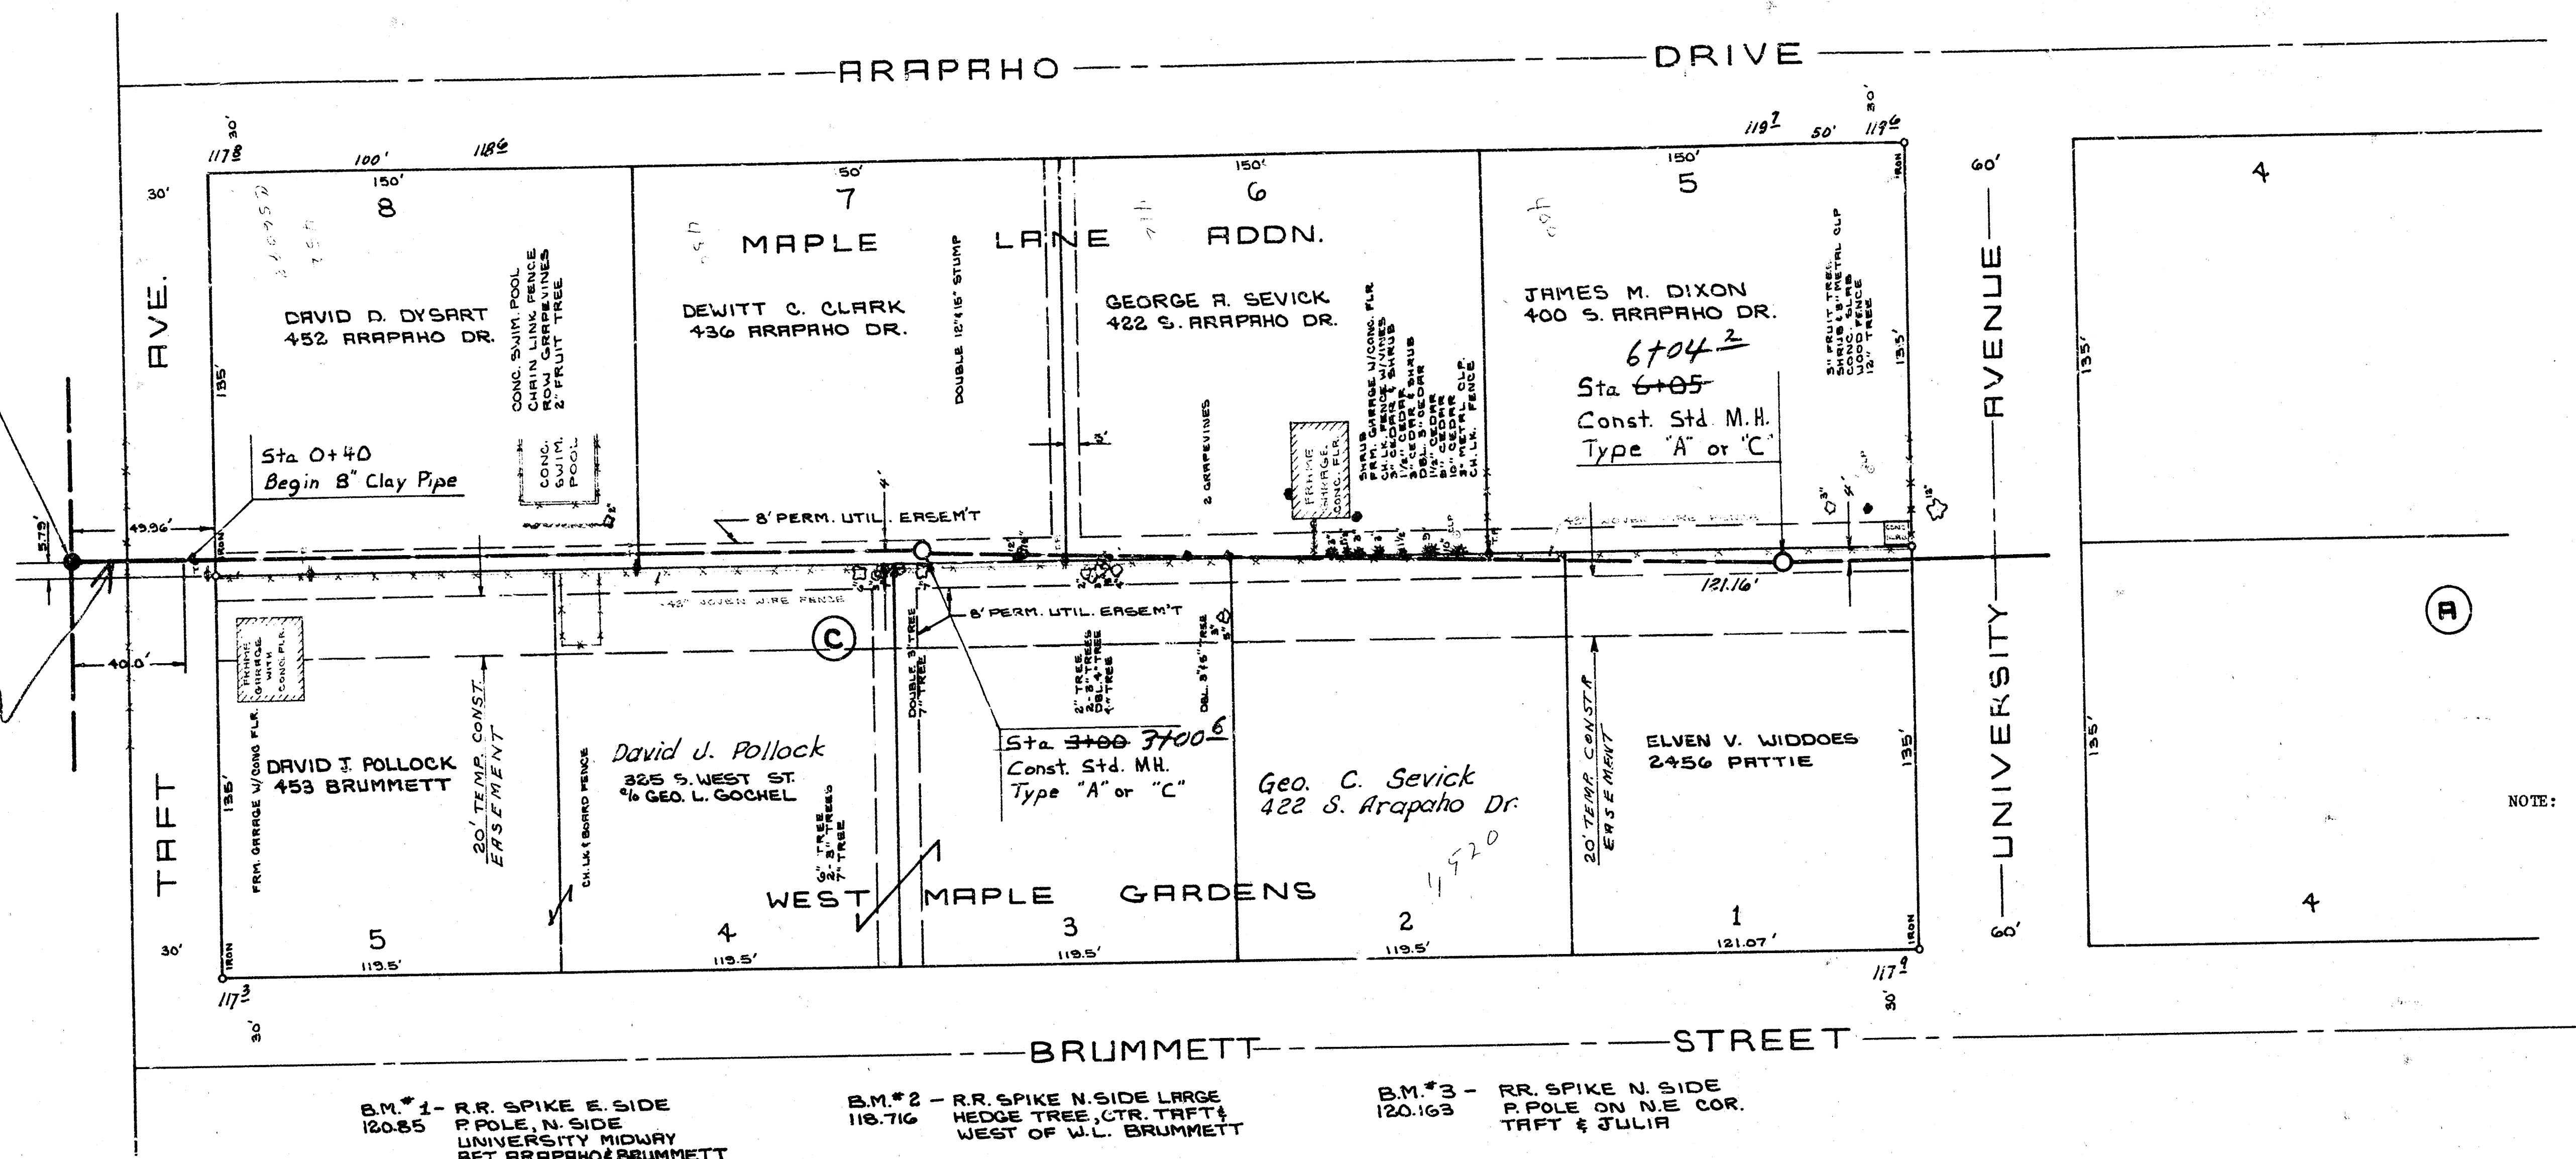


SCALE  
VERTICAL ~ 1" = 5'  
HORIZONTAL ~ 1" = 40'

NOTE: ALL FENCES REMOVED BY THE CONTRACTOR TO FACILITATE CONSTRUCTION OF THE SANITARY SEWER SHALL BE REPLACED.

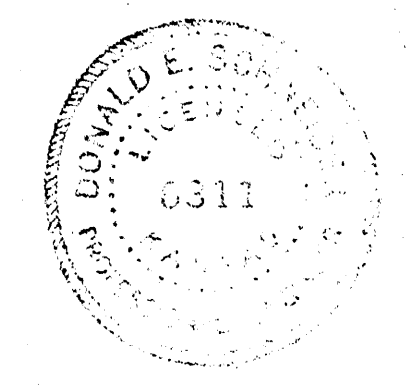


125  
120  
115  
110  
105  
100


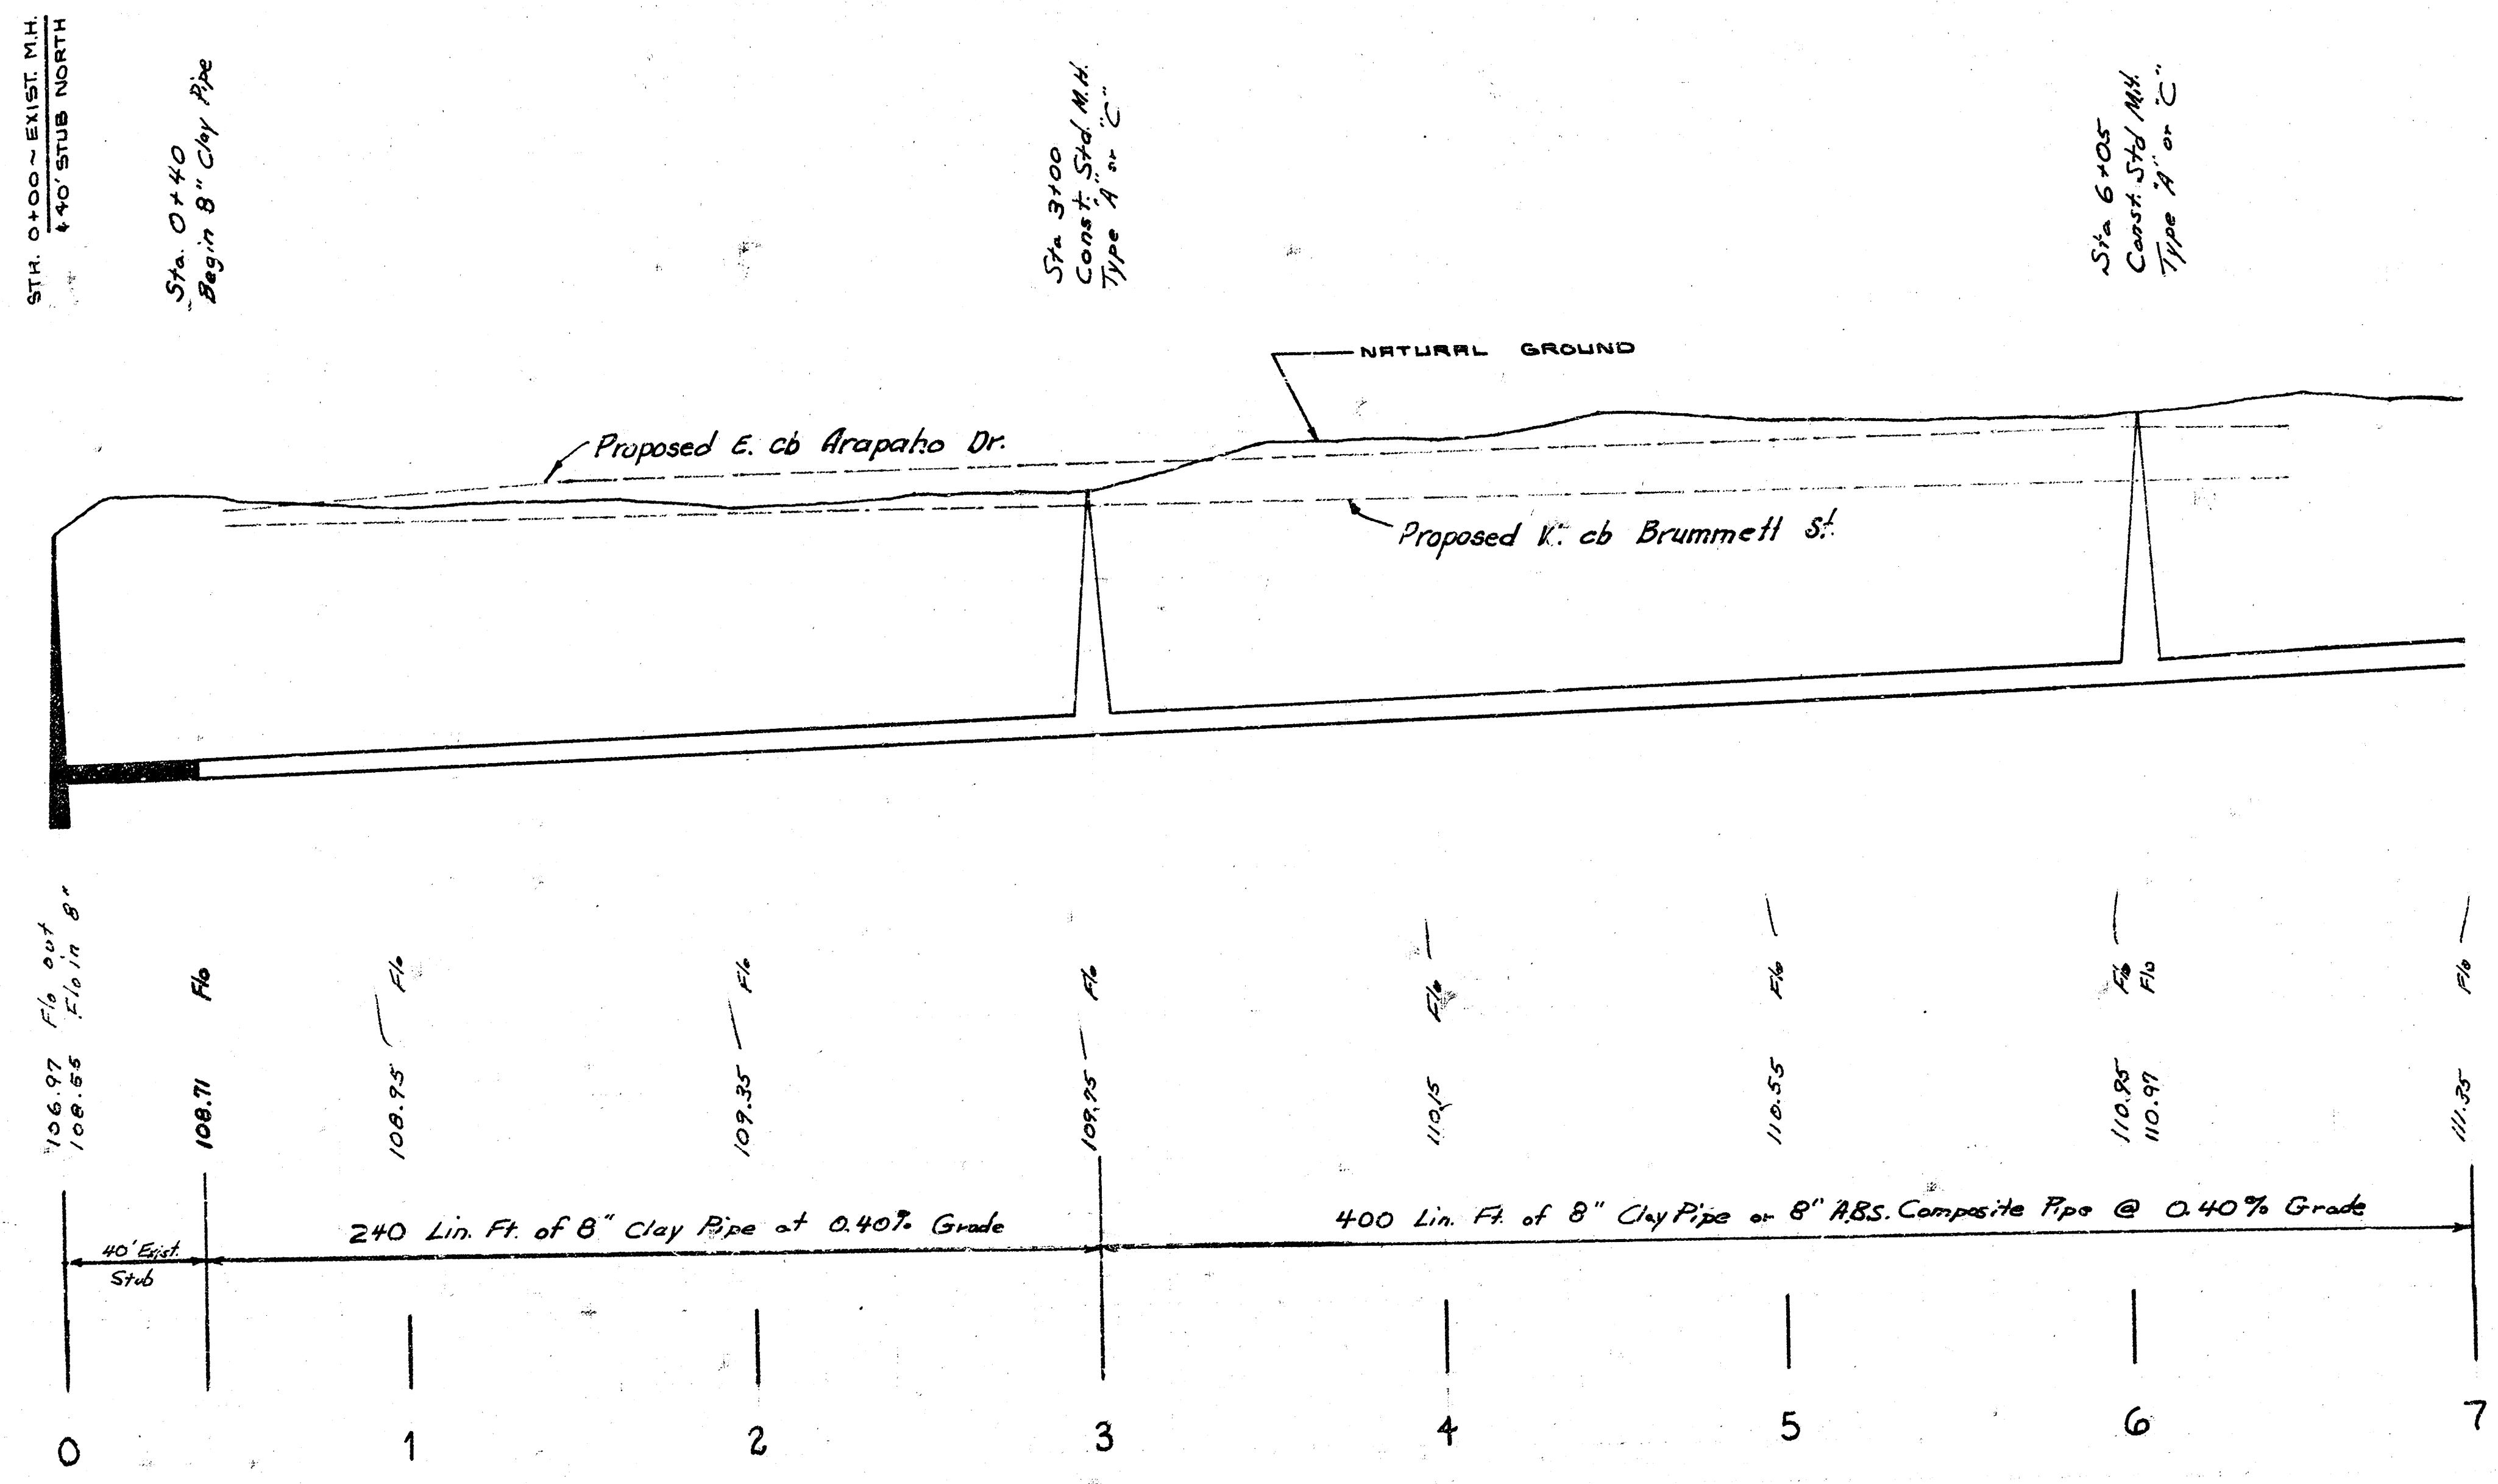


125  
120  
115  
110  
105  
100


As Built 7-12-76

LAT. 9, MAIN 4, S.W. INTERCEPTOR SEWER  
CITY OF WICHITA, KANSAS  
R.W. LINN CITY ENGINEER  
DATE MARCH, 1976 PROJECT NO. DBKL 571043

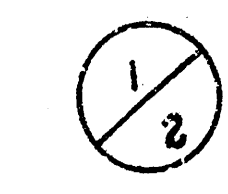

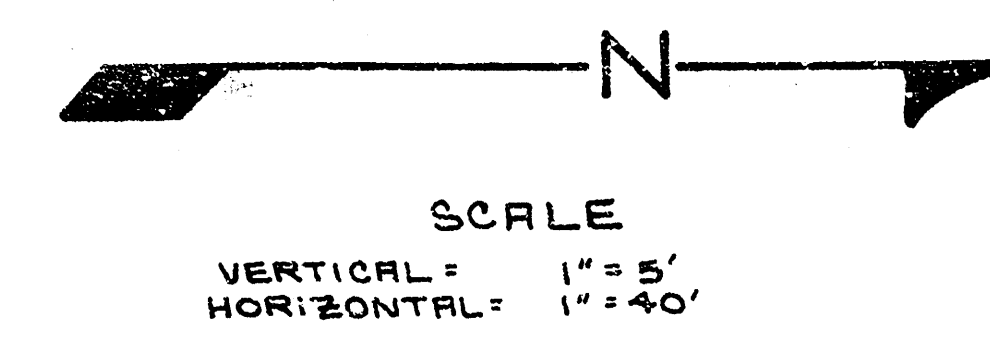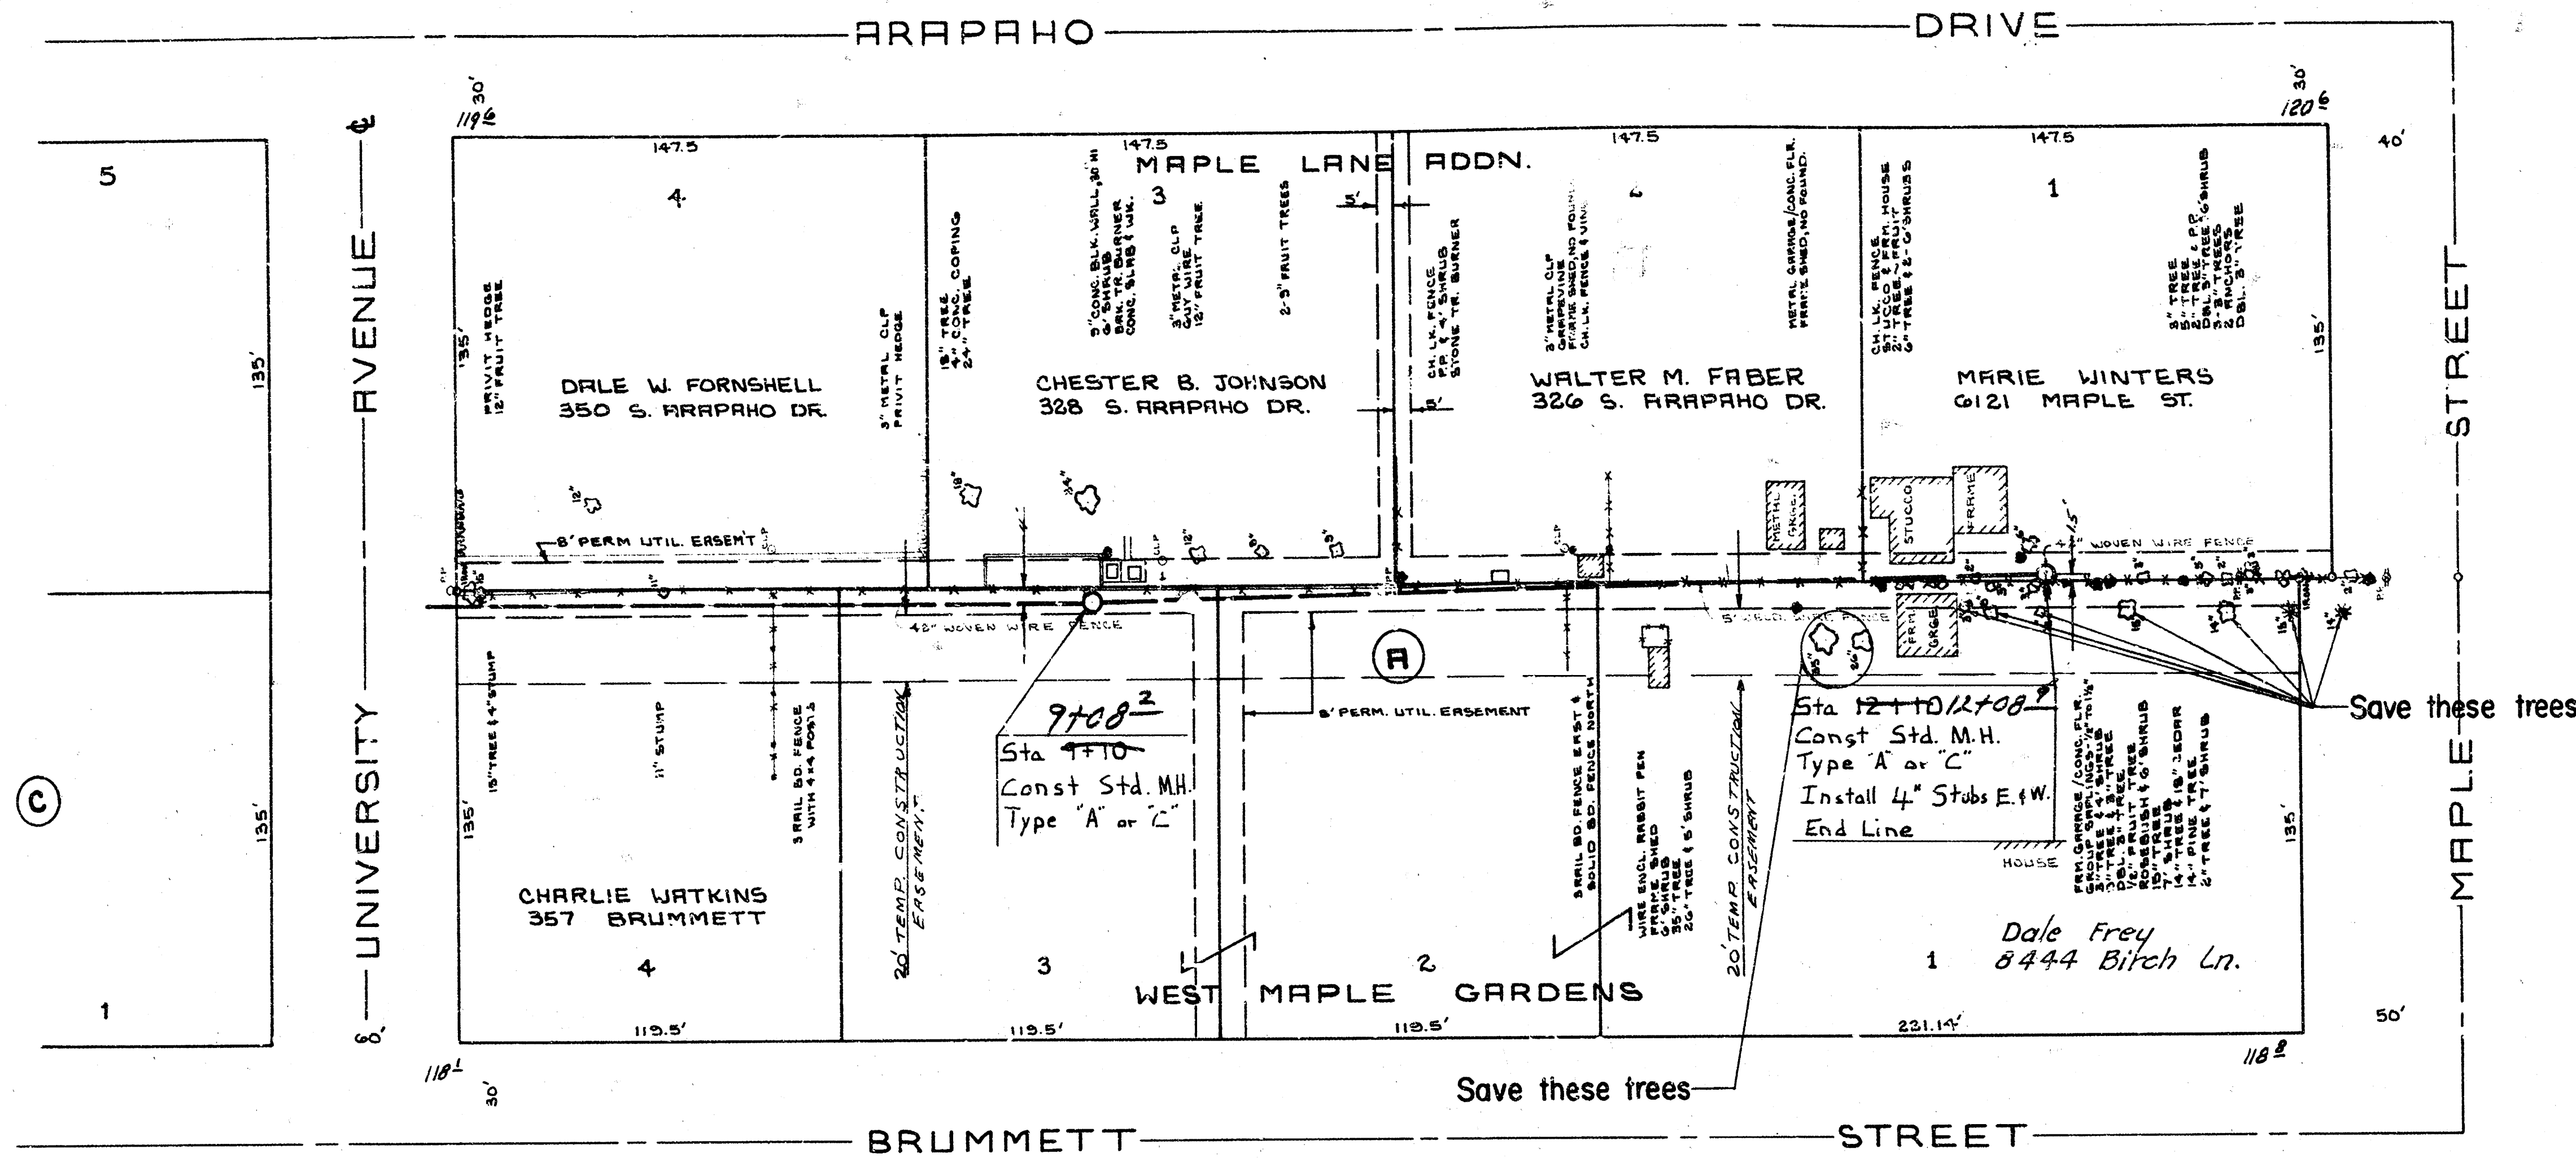

NOTE: CONTRACTOR'S CONSTRUCTION METHODS BETWEEN STA. 11+00 AND STA. 12+10 SHALL BE SUCH THAT WILL PROTECT GARAGES AND HOUSE FROM ANY DAMAGE DUE TO CONTRACTOR'S OPERATION.

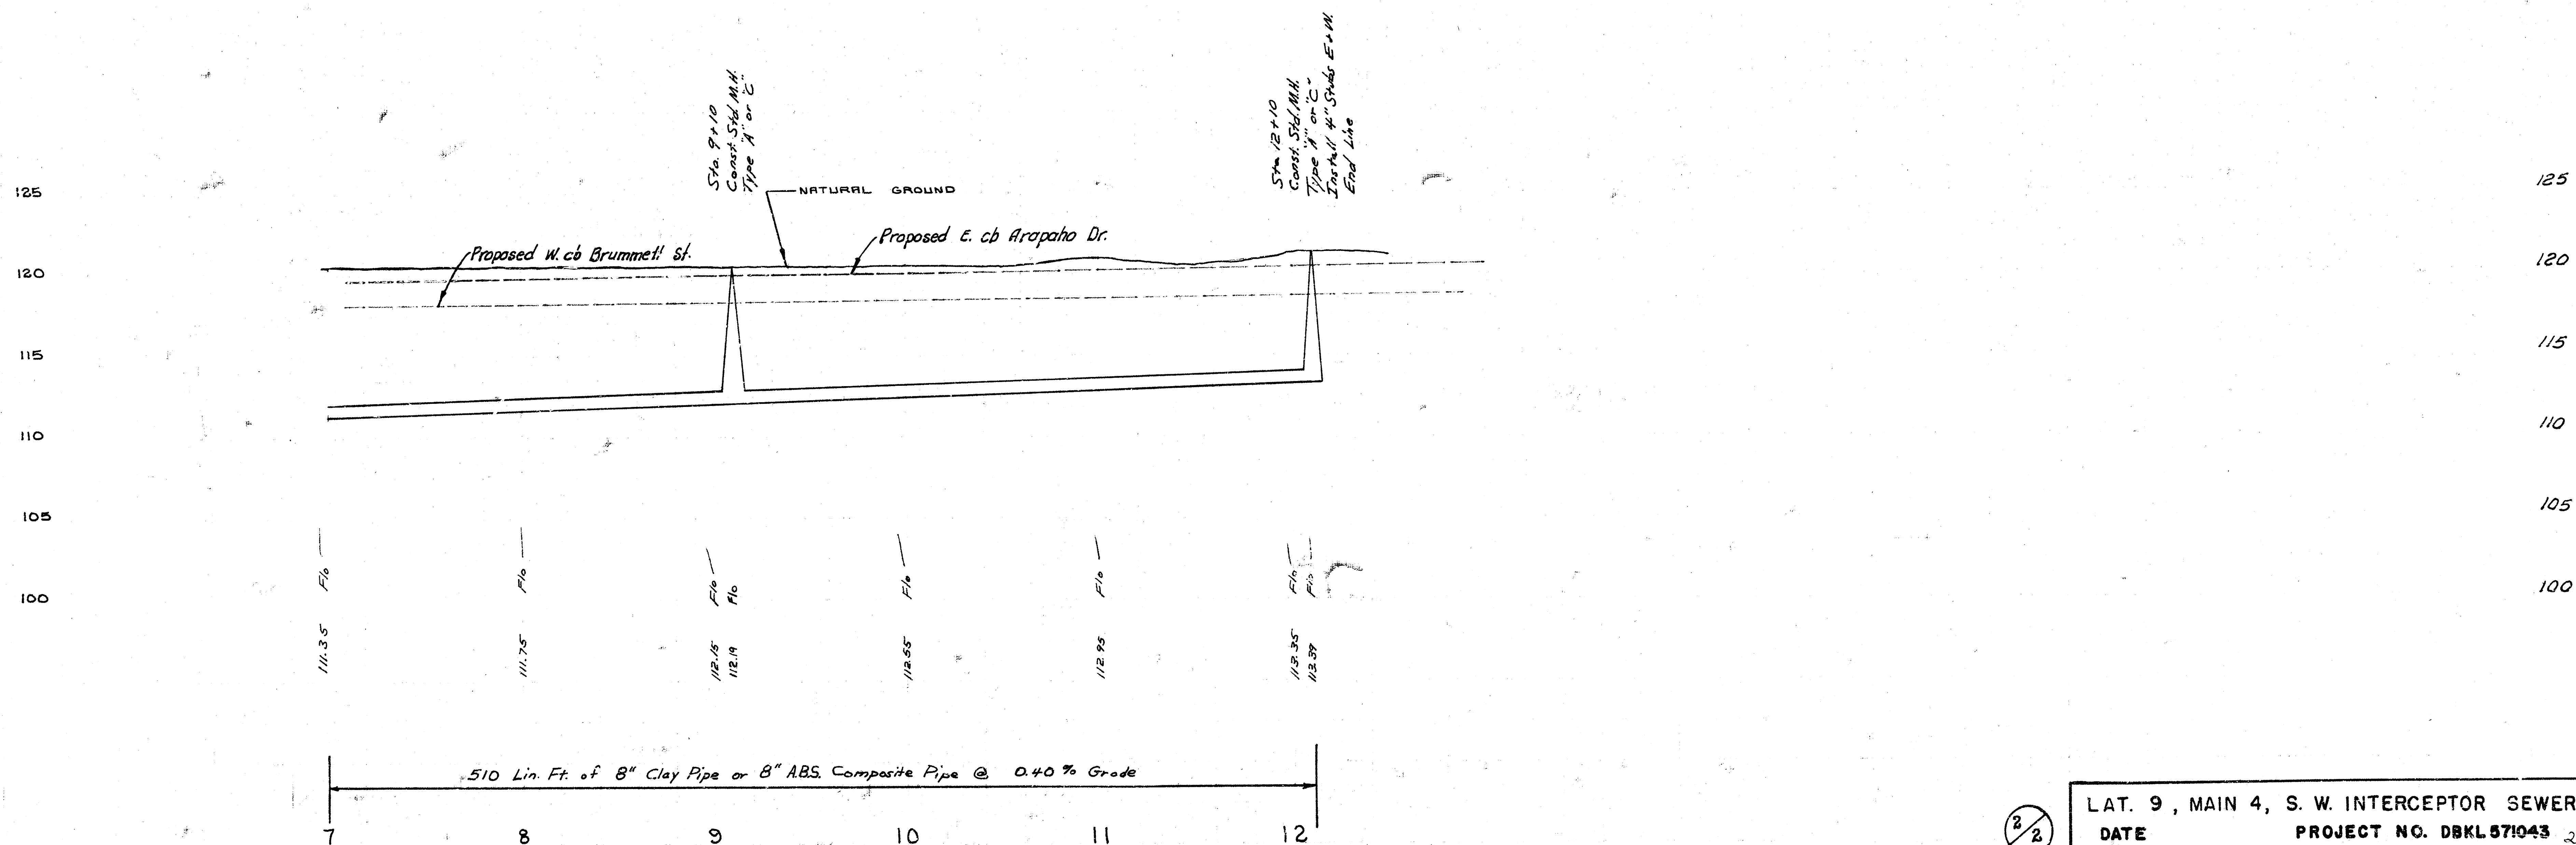

LAT. 9, MAIN 4, S. W. INTERCEPTOR SEWER  
DATE PROJECT NO. DBKL571043