

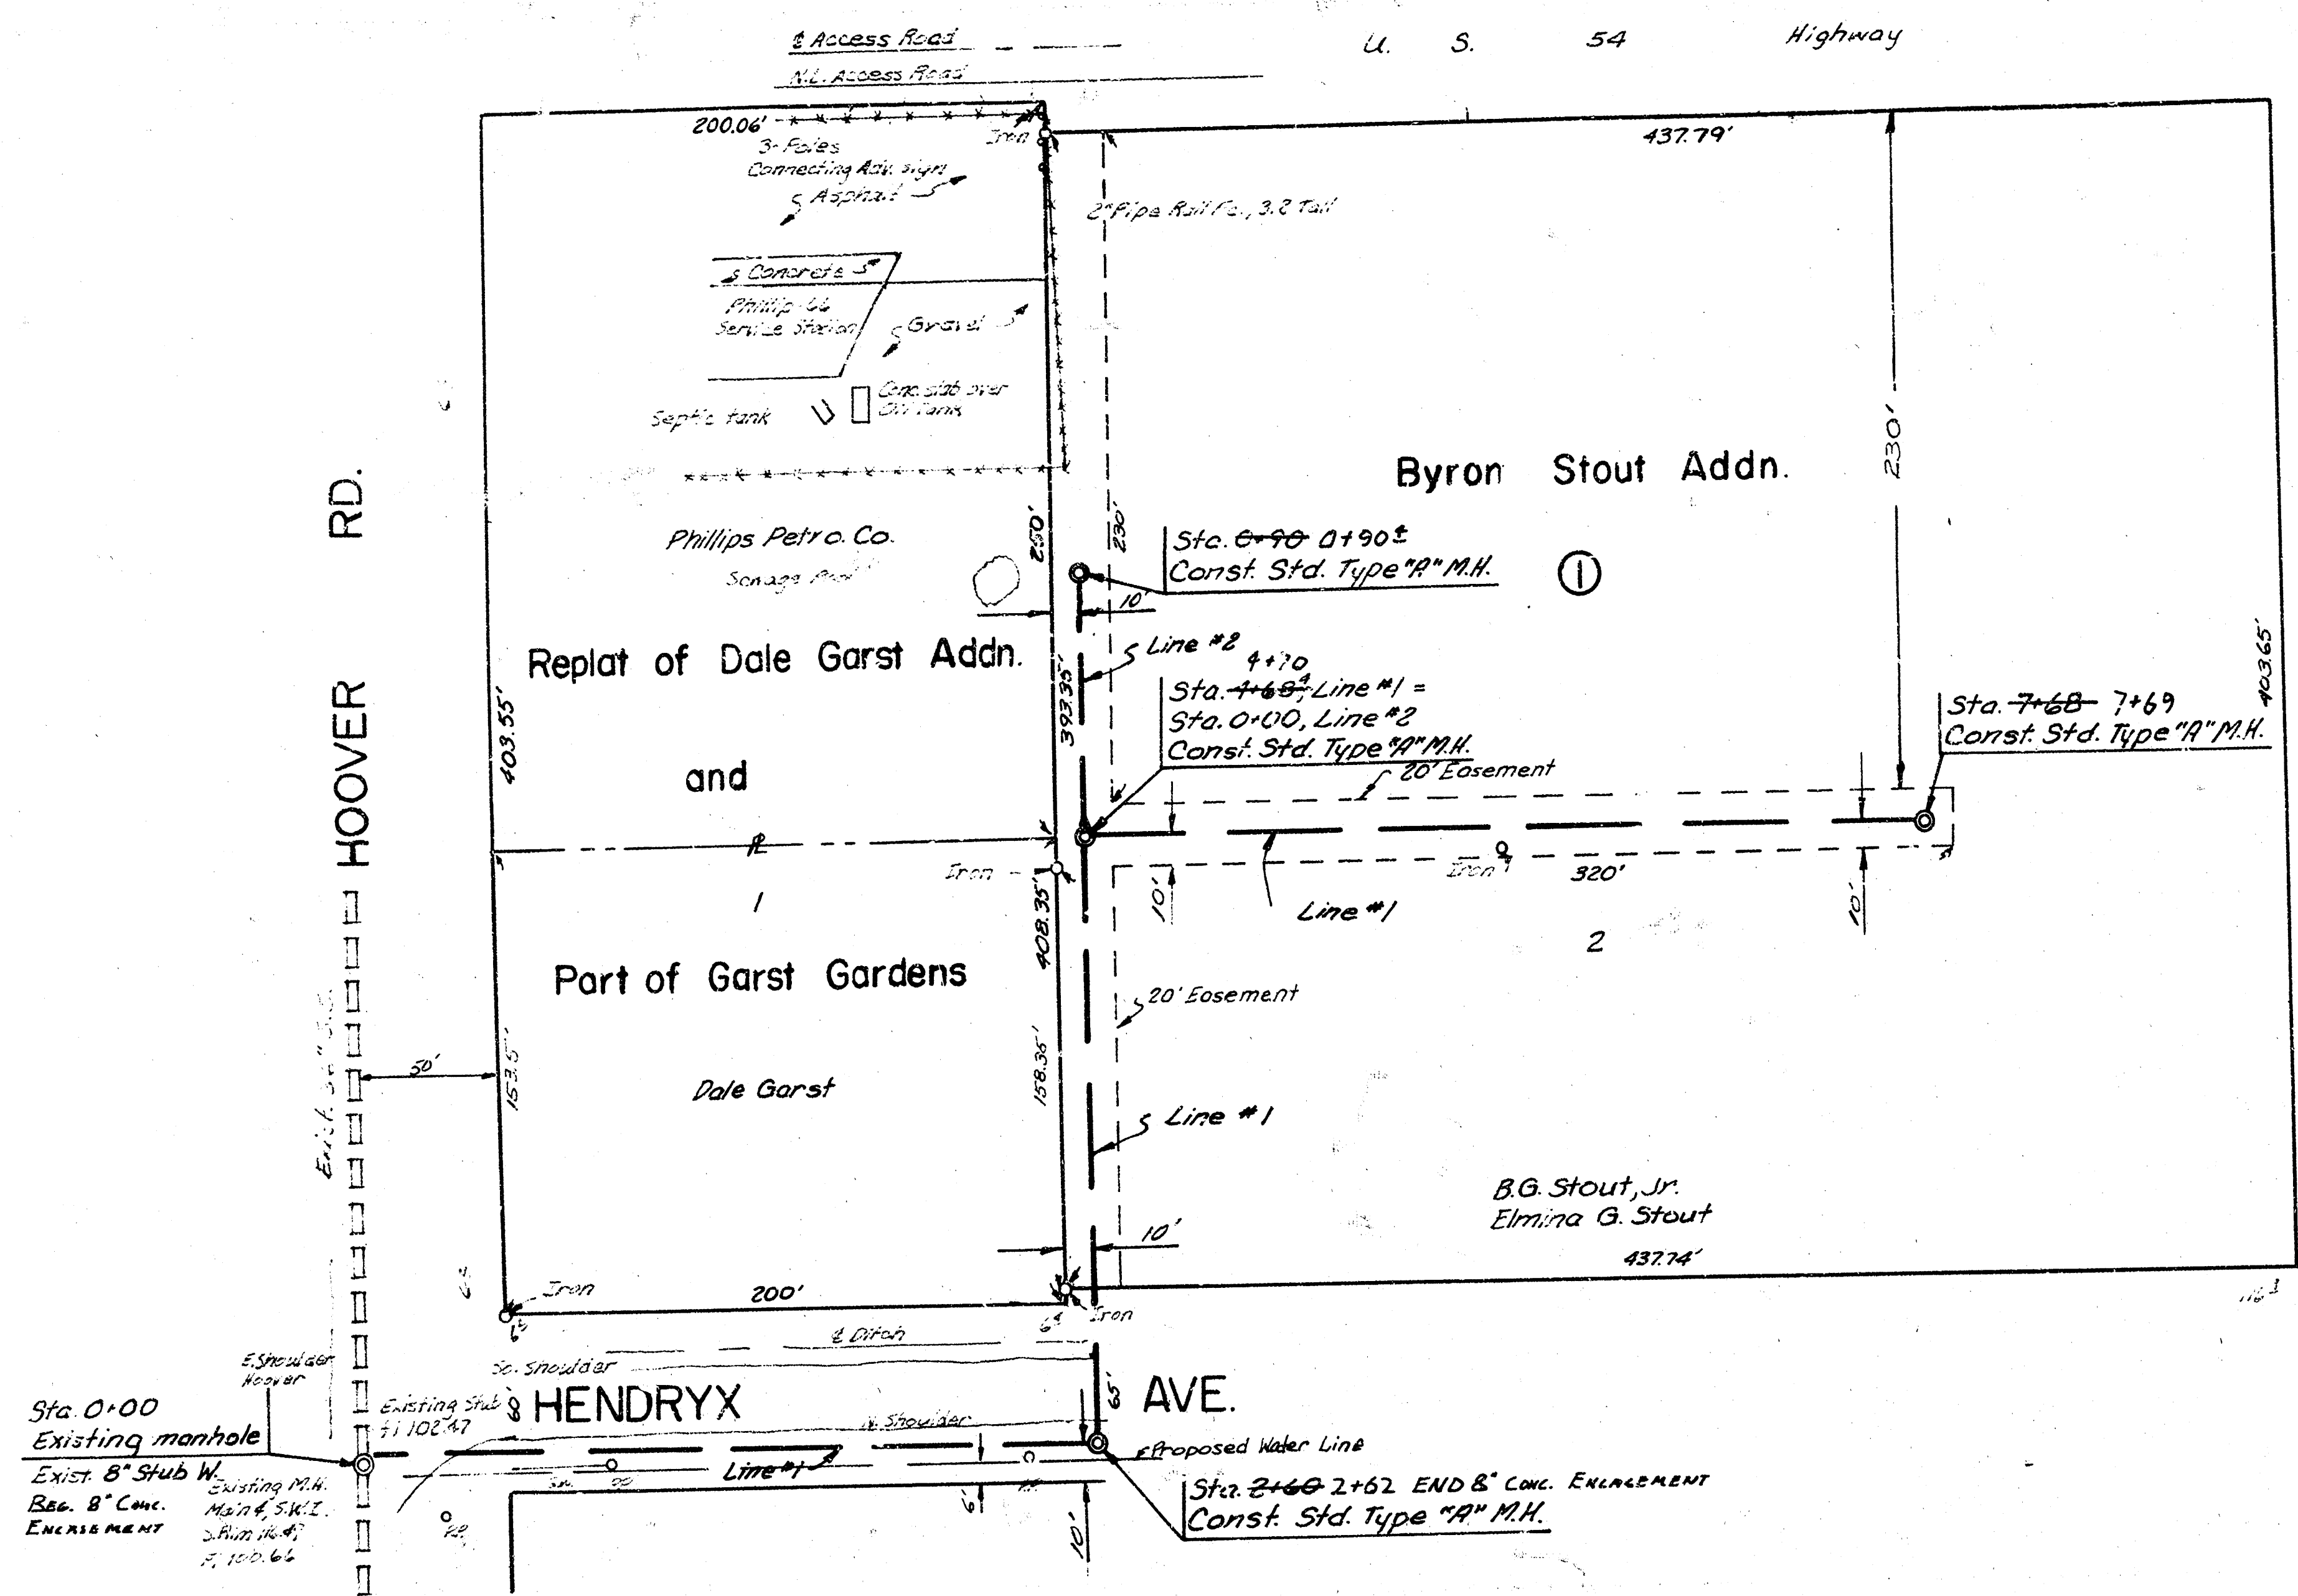


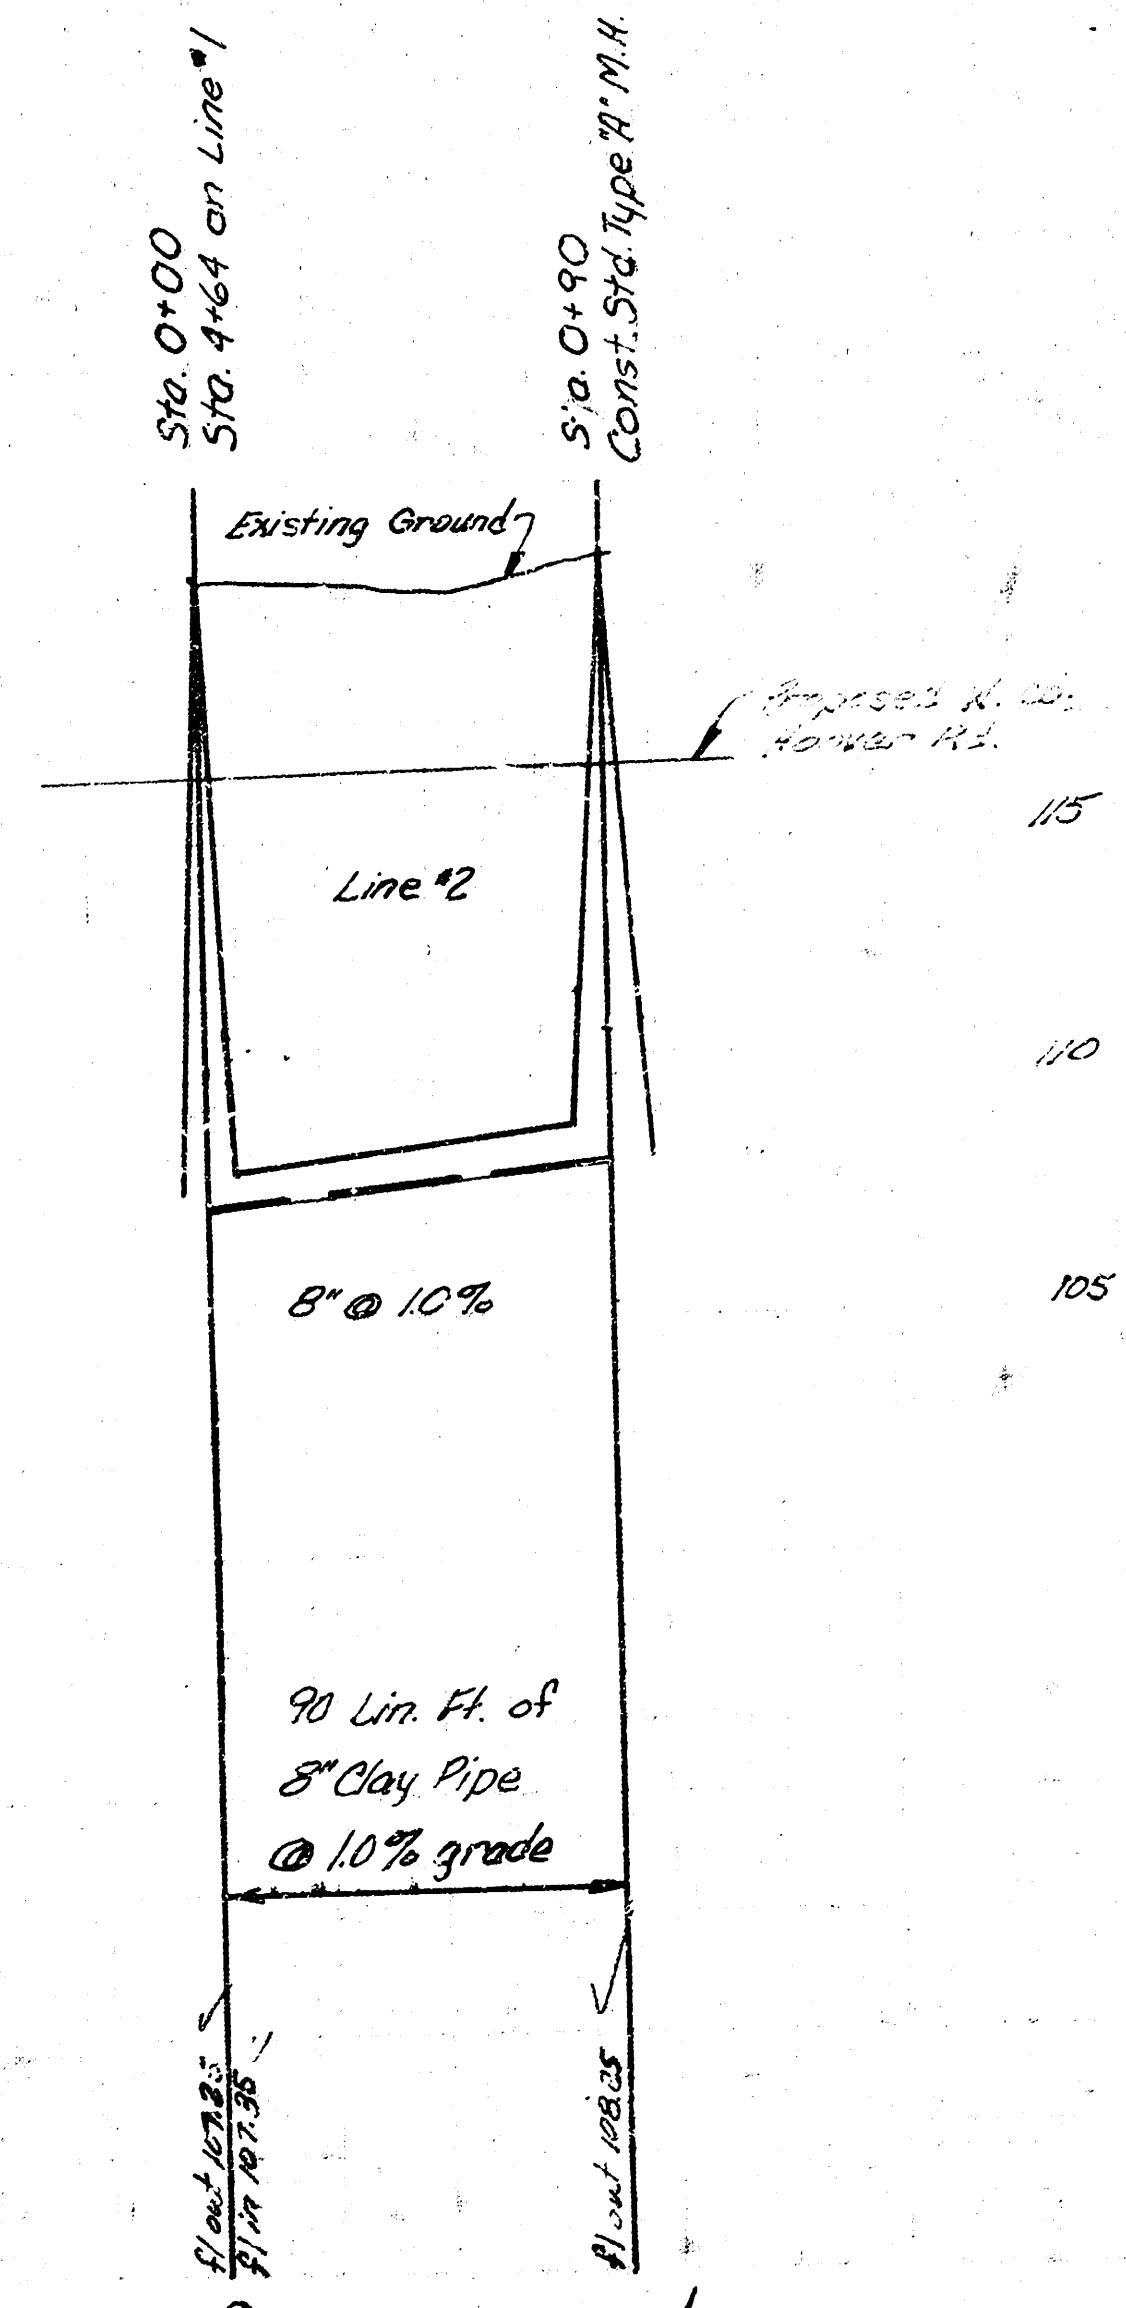

B.M. 116.05 R.R. spike W. face R.P. SE. corner Lot 6, Block C, Garst Garden.
 B.M. 22.726 17" cut on N.W. corner concrete Plume on S.W. corner Hoover & U.S. 54.

Note: Field Engineer shall check stub's flow elevation prior to construction of sanitary sewer.

Plan Scale 1"=50'
 Profile Scale Ver. 1"=50'
 Profile Scale Hor. 1"=5'

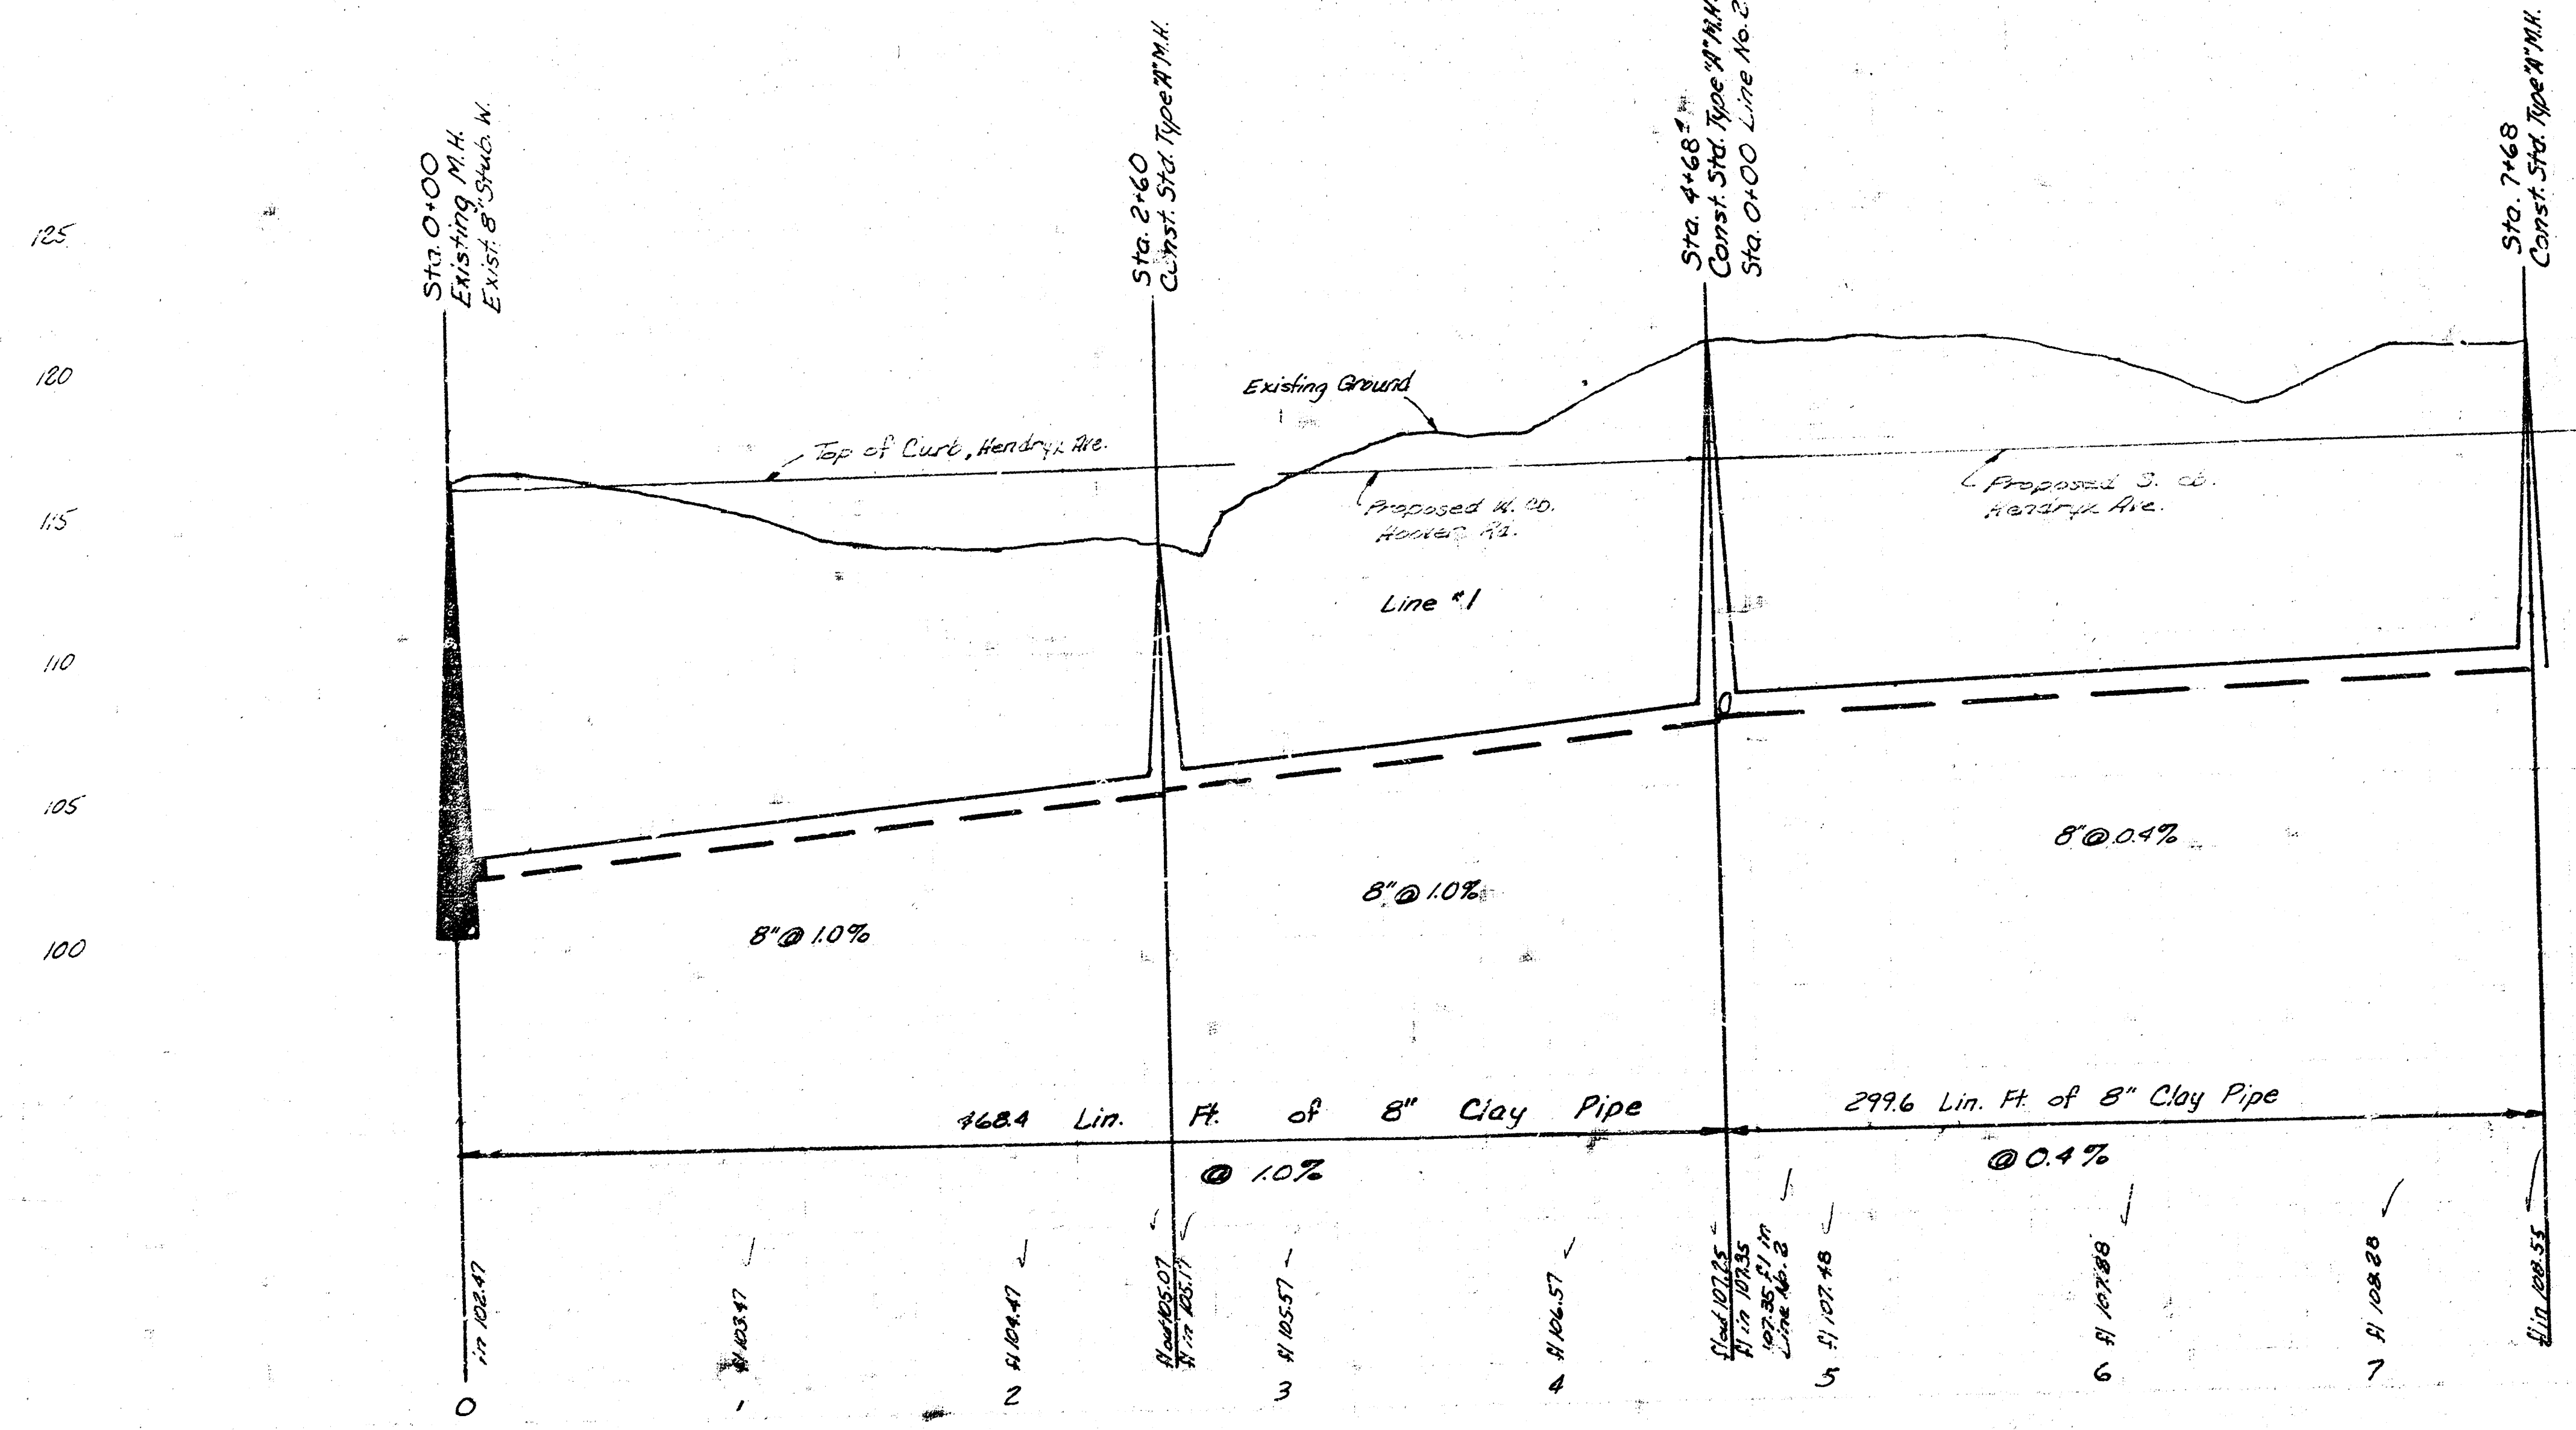

"As Built" FINAL MEASUREMENTS K-88
 LAT 15, MAIN 4, S.W. INTERCEPTOR LINES 1 & 2
 R. W. LINN CITY ENGINEER
 CITY OF WICHITA, KS.
 PR. NO. D-572025 DATE 7-72