

MAIN 5, SOUTHWEST INTERCEPTOR SEWER
PARTS I & II

PROJ. NO. DBKM572018


CITY OF WICHITA, KANSAS

INDEX OF SHEETS

1	TITLE SHEET
2	LOCATION MAP PART I
3	LOCATION MAP PART II
4-8	PLAN & PROFILE PART I
9-12	PLAN & PROFILE PART II
13	SIPHON DETAILS PART I
14 & 15	REINF. CONC. MANHOLE DETAILS PARTS I & II
16	PRECAST & CAST IN PLACE MANHOLE DETAILS PARTS I & II
17	SEWER APPURTENANCES & BRICK MANHOLE DETAILS PARTS I & II

PLANS PREPARED BY
DEPARTMENT OF PUBLIC WORKS
ENGINEERING DIVISION
CITY OF WICHITA, KANSAS
R. W. BRUGGEMAN, DIRECTOR OF PUBLIC WORKS
R. W. LINN, CITY ENGINEER


R. W. Linn DATE: _____
R.W. LINN CITY ENGINEER

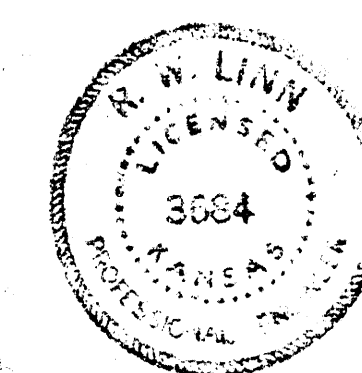

As Built 1-10-76

SH. NO. 1 OF 17

1/17

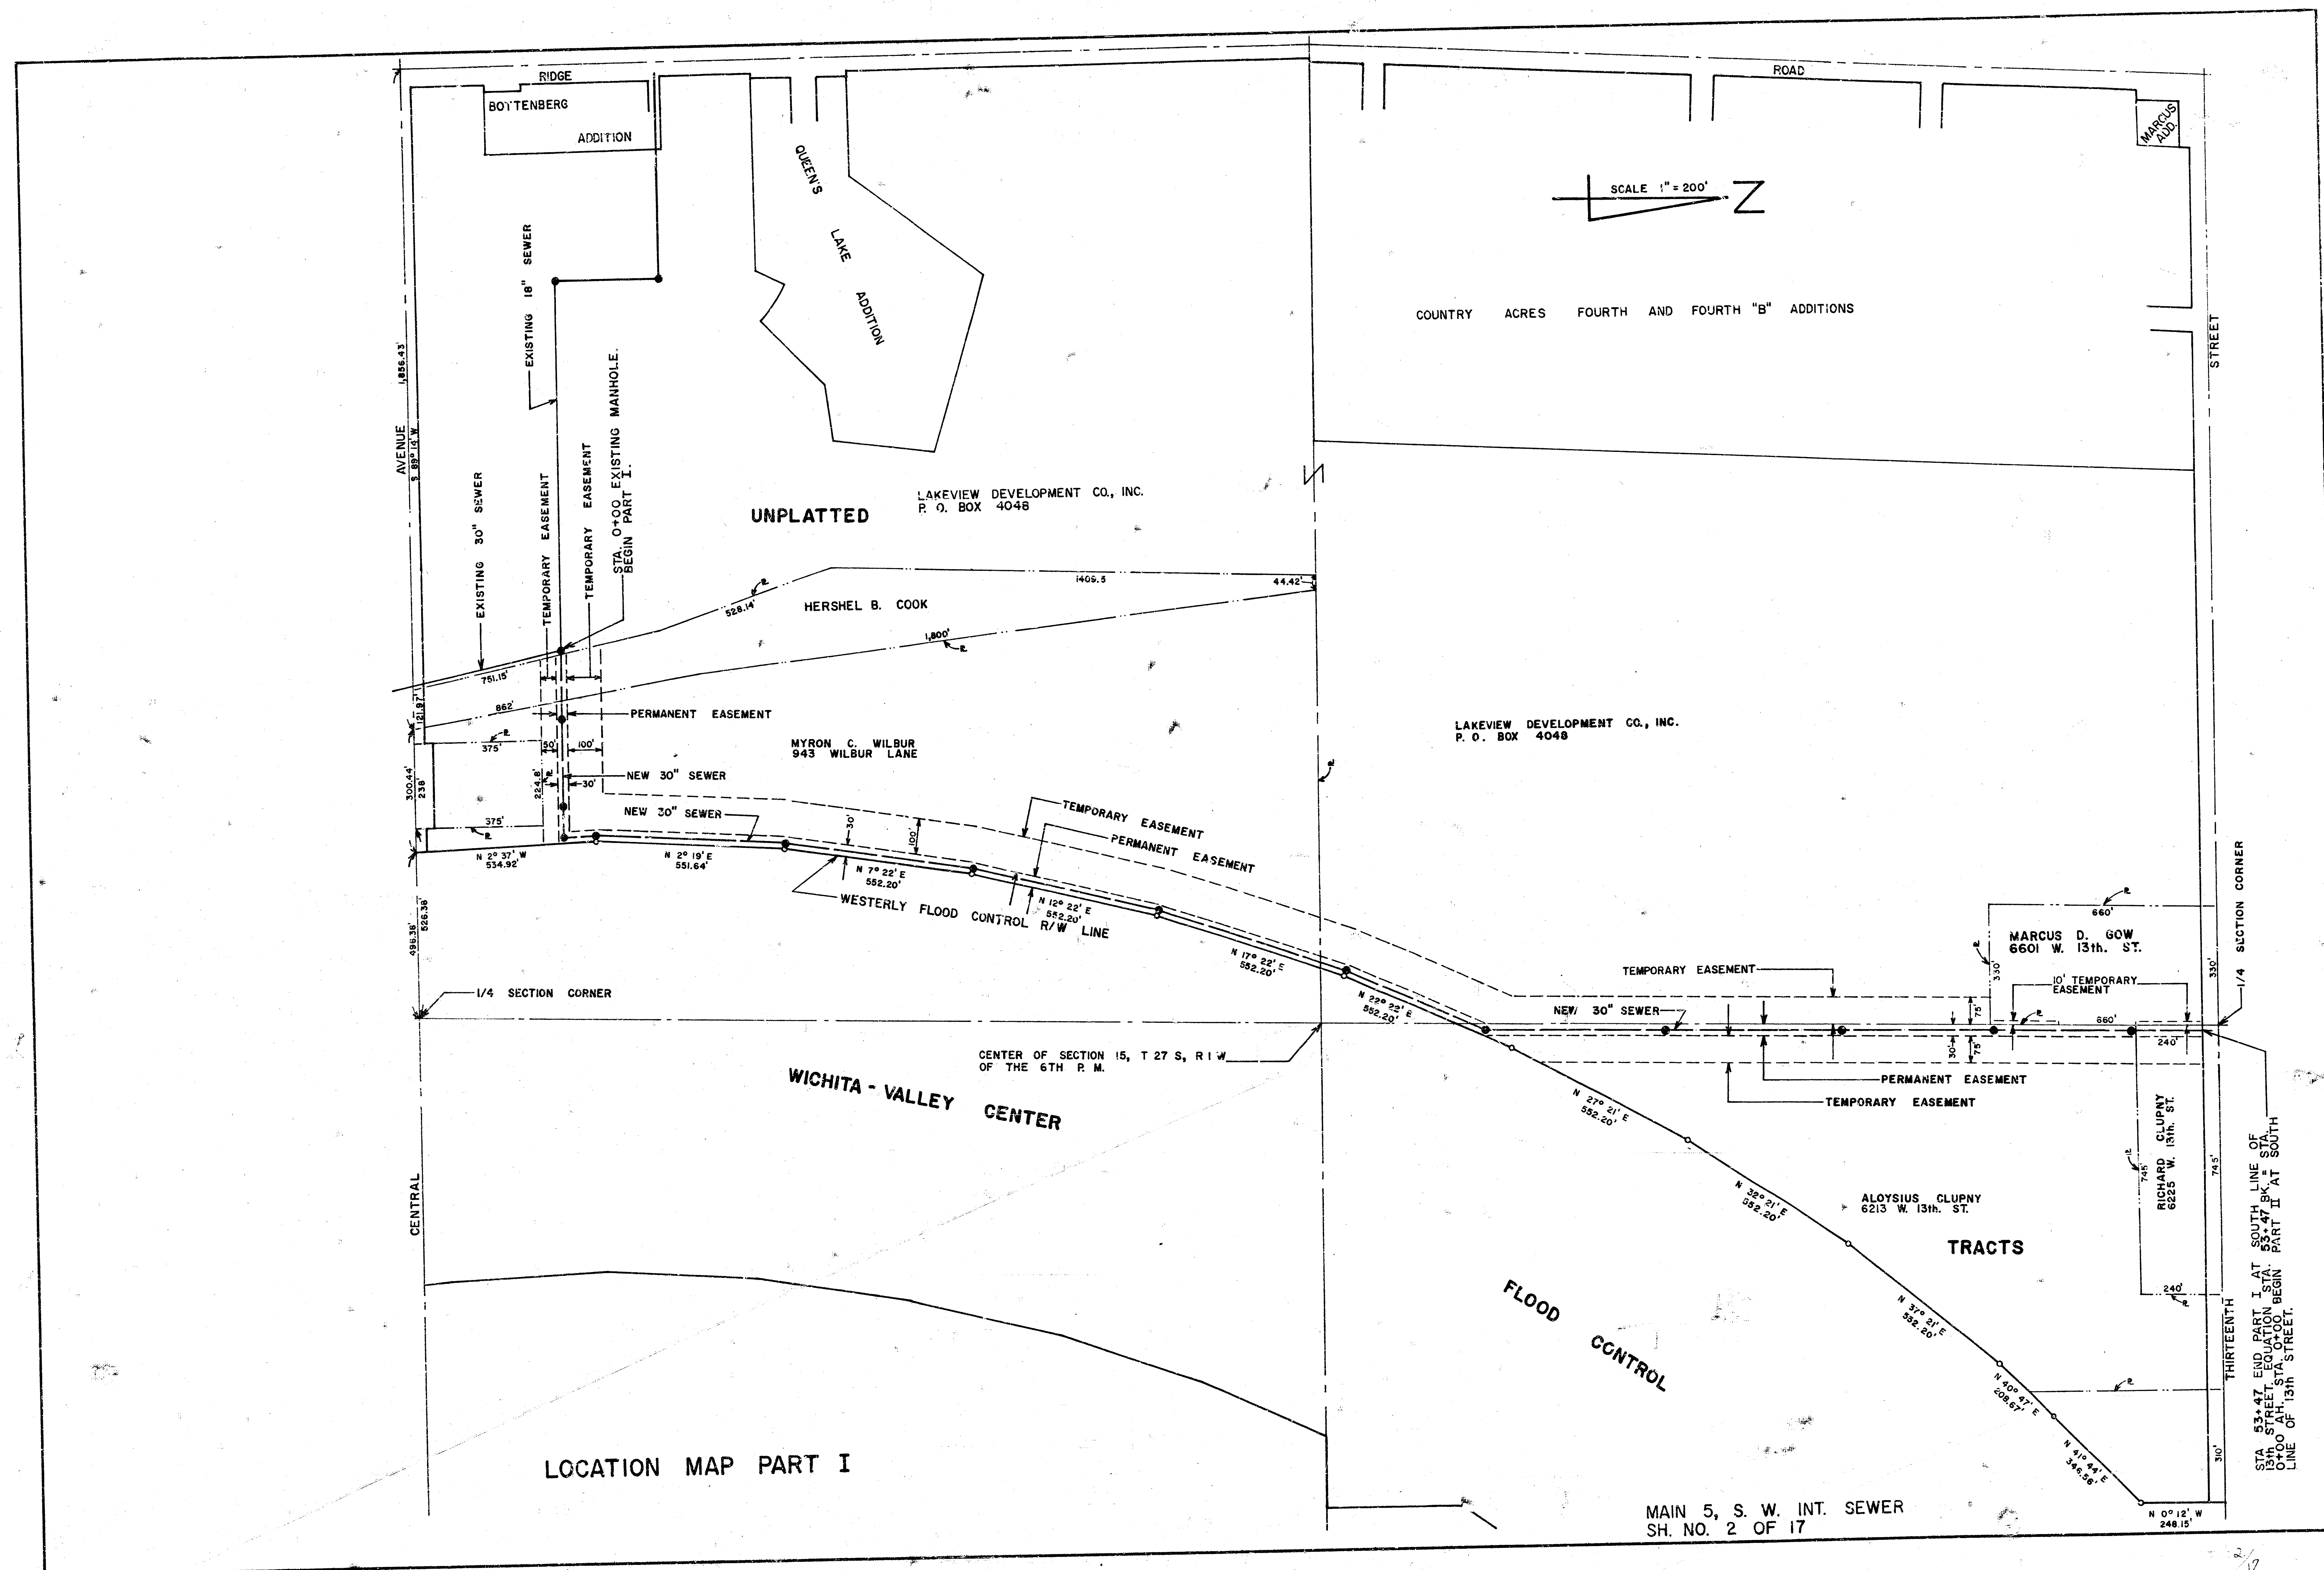

STA. 53+47 END PART I AT SOUTH LINE OF
ST. STREET LOCATION STA. 53+47 BK. 1 STA.
0+00 AN. STA. 0+00 BEGIN PART II AT SOUTH
LINE OF 13th STREET.

LOCATION MAP PART II

SEDGWICK COUNTY ZOO

LOT 2

BLOCK "A"

LOT 1

SECOND ADDN.

MAIN 5, S. W. INT. SEWER
SH. NO. 3 OF 17

SCALE 1"=200'

N

N. 1/4 COR. OF SEC. 10,
T27S, R1W OF 6TH P.M.

ST. NO.

21ST.

CENTER OF SEC. 10,
T27S, R1W OF 6TH P.M.

ST. NO.

13TH

S. 1/4 COR. SEC. 10,
T27S, R1W OF 6TH P.M.

NEW 30" SEWER

20' SEWER EASEMENT

NEW 24" SEWER

20' UTILITY EASEMENT

30' SEWER EASEMENT

50' PIPELINE EASEMENT

30' UTILITY EASEMENT

BASE LINE FOR 50' PIPELINE EASMT.

EXISTING 10" SEWER

EXISTING 10" SEWER

EXISTING 6" SEWER

SECTION CORNER

1/4 SECTION CORNER

SECTION CORNER

WINDMILL

RD.


ZOO

MO. PAC. R.R.

BLVD.

FILMED FROM THE BEST
AVAILABLE COPY


26.60
S. Corner

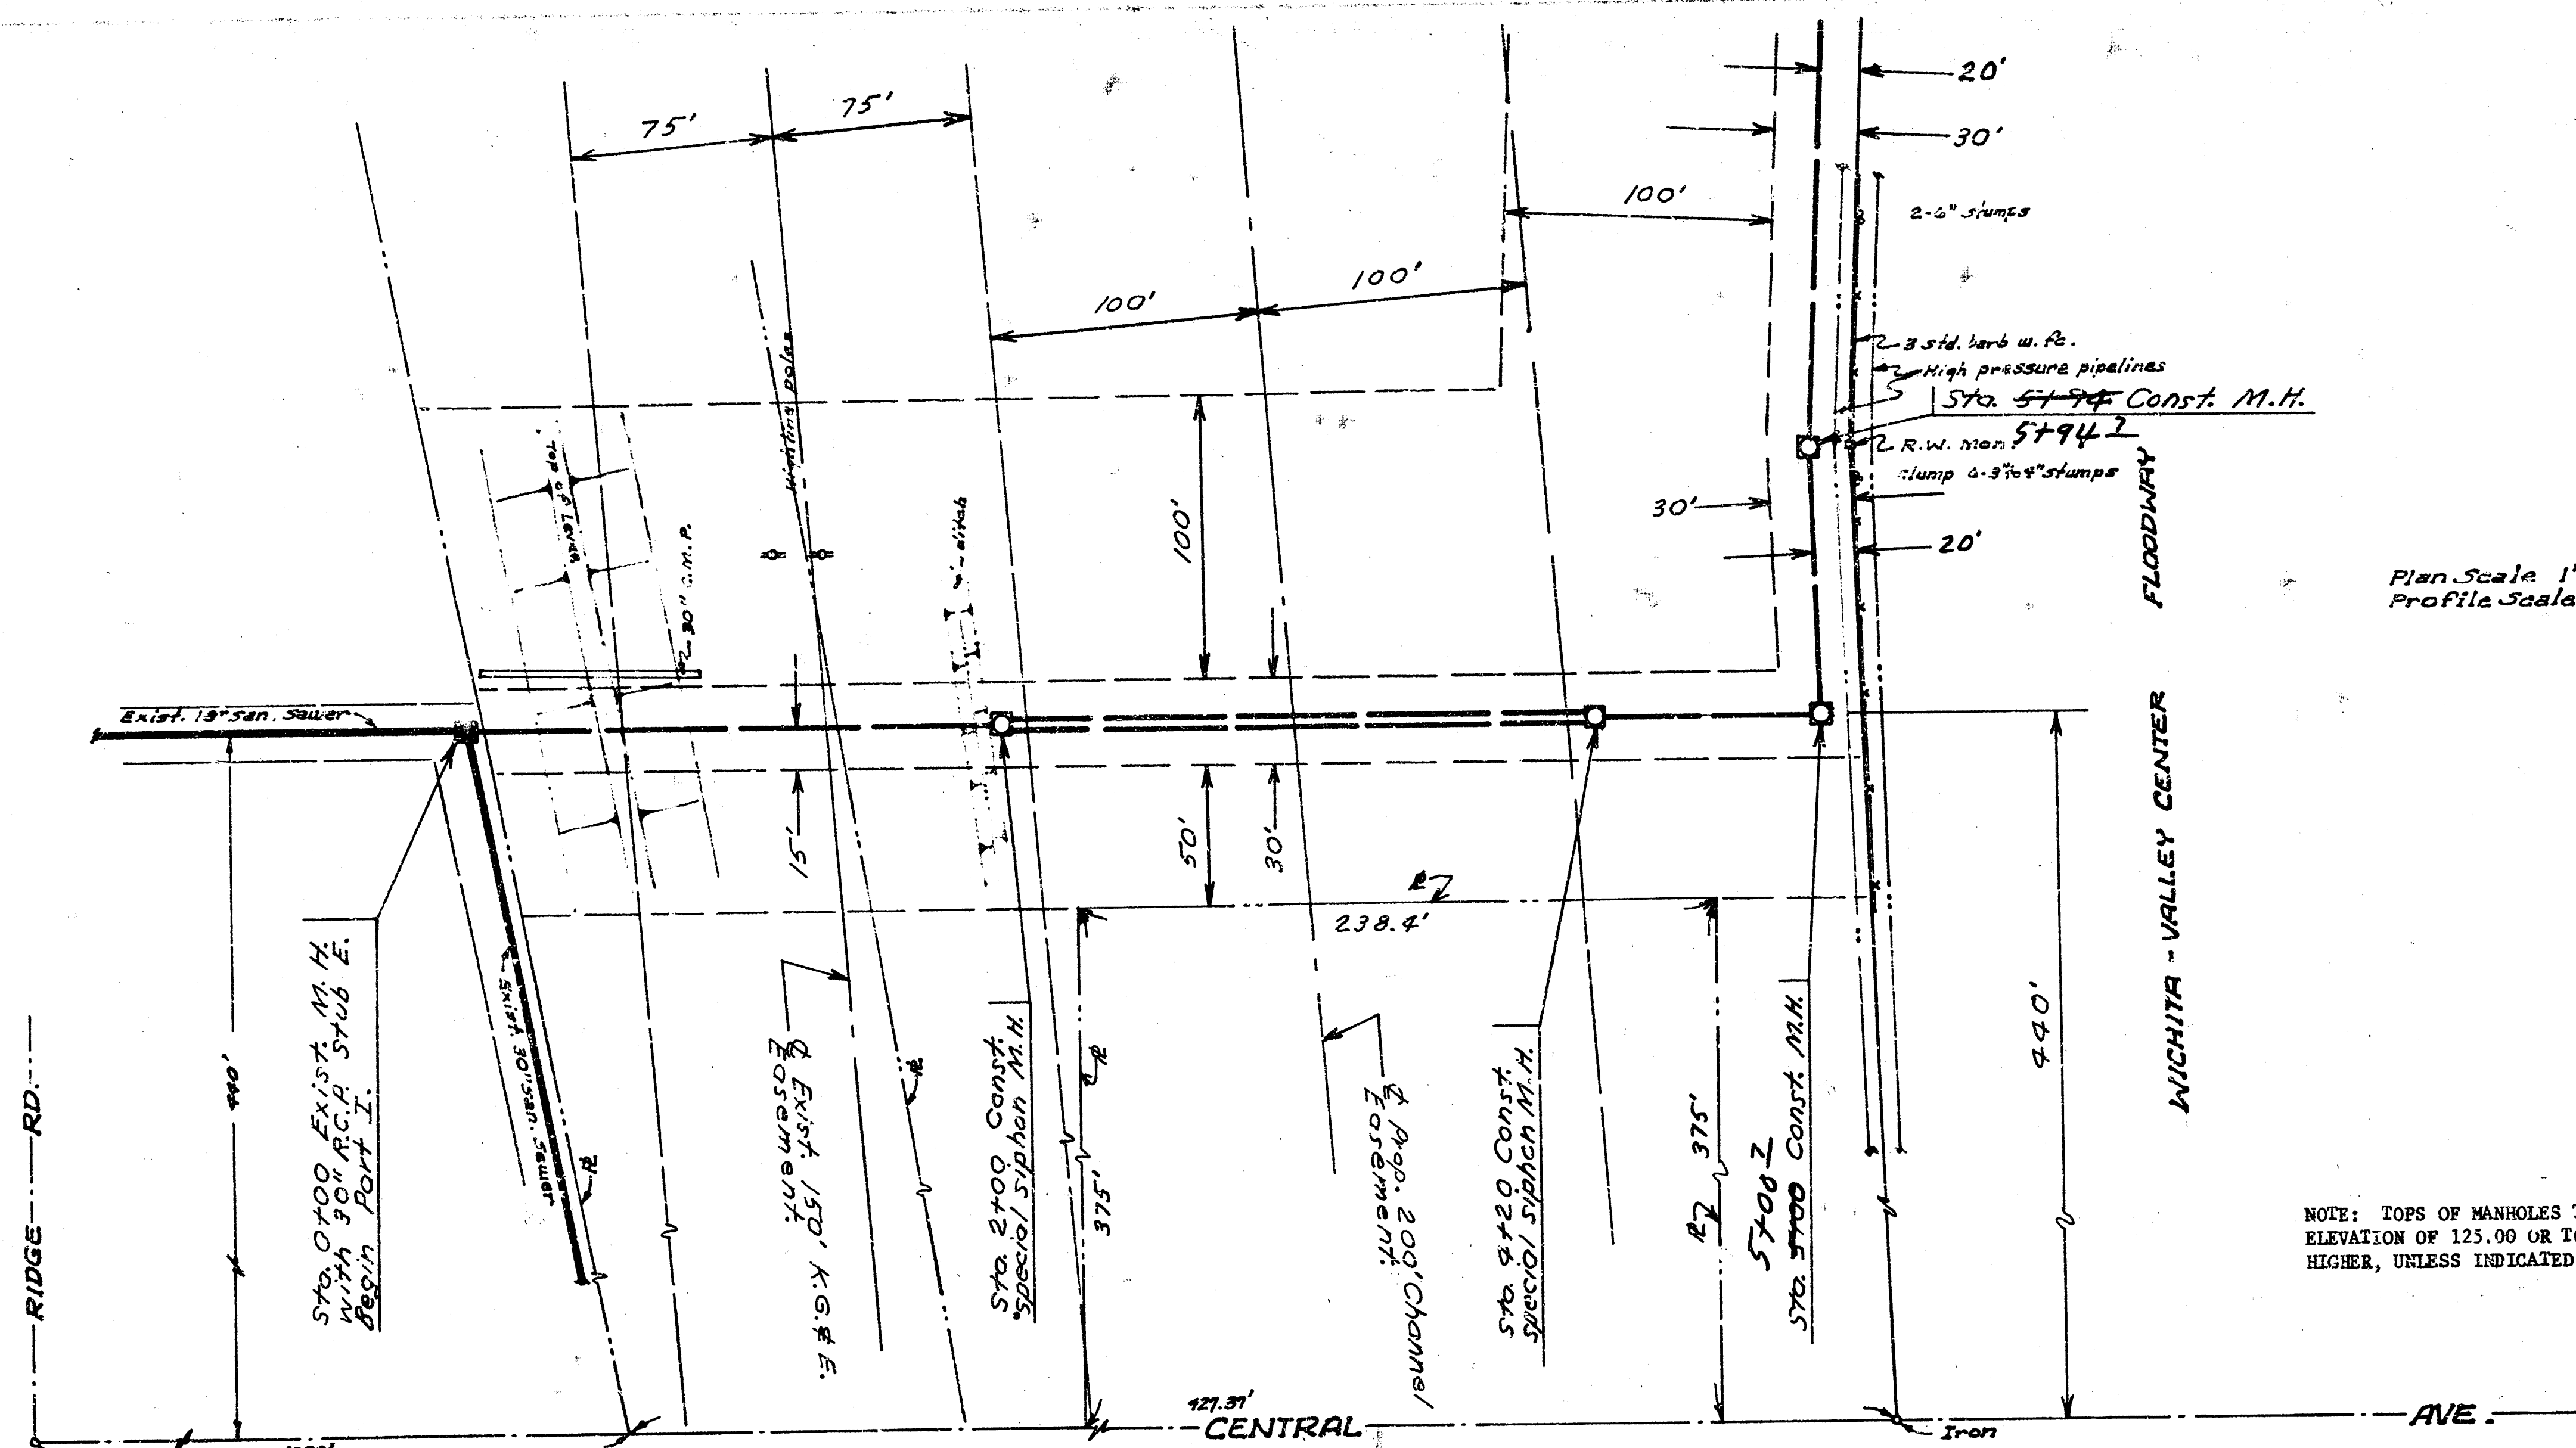

B.M. 123.39 "X" on Bridge deck N.W. cor. conc. Bridge @ Central & Big Ditch
B.M. 128.49 R.R. Spike S.W. Side P.P. Front of dog cat Hosp. 6608 W. Central



GENERAL NOTES


1. REINFORCED CONCRETE PIPE FOR SANITARY SEWER SHALL BE LINED WITH PLASTIC EXCEPT FOR THE BOTTOM SEGMENT SUBTENDED BY A 60° ARC. SEE SHEET NO. 16 FOR DETAIL SHOWING PLASTIC LINING. PLASTIC LINING SHALL BE AMER-PLATE T-LOCK LINER PLATE AS MANUFACTURED BY AMERON CORPORATION, LOK-RIB KOROSEAL CONCRETE PIPE LINING AS MANUFACTURED BY B. F. GOODRICH, OR AN APPROVED EQUAL.
2. SHOP DRAWINGS FOR CONCRETE PIPE AND PRECAST MANHOLES SHALL BE SUBMITTED TO THE ENGINEER FOR APPROVAL.
3. FLOORS OF ALL CAST IN PLACE CONCRETE MANHOLES AND ALL BRICK MANHOLES ARE TO BE SHAPED TO INCREASE HYDRAULIC EFFICIENCY USING CONCRETE FILL. CONCRETE FILL SHALL CONTAIN FINE AGGREGATE ONLY AND EIGHT SACKS OF CEMENT PER CUBIC YARD.
4. ALL COSTS FOR REMOVING AND REPLACING FENCES WILL NOT BE PAID FOR DIRECTLY AND THIS COST SHALL BE CONSIDERED AS SUBSIDIARY TO THE OTHER ITEMS OF WORK.
5. CLAY PIPE 30" AND 24" IN DIAMETER SHALL BE STANDARD STRENGTH. CLAY PIPE 8" AND 10" IN DIAMETER SHALL BE EXTRA STRENGTH.

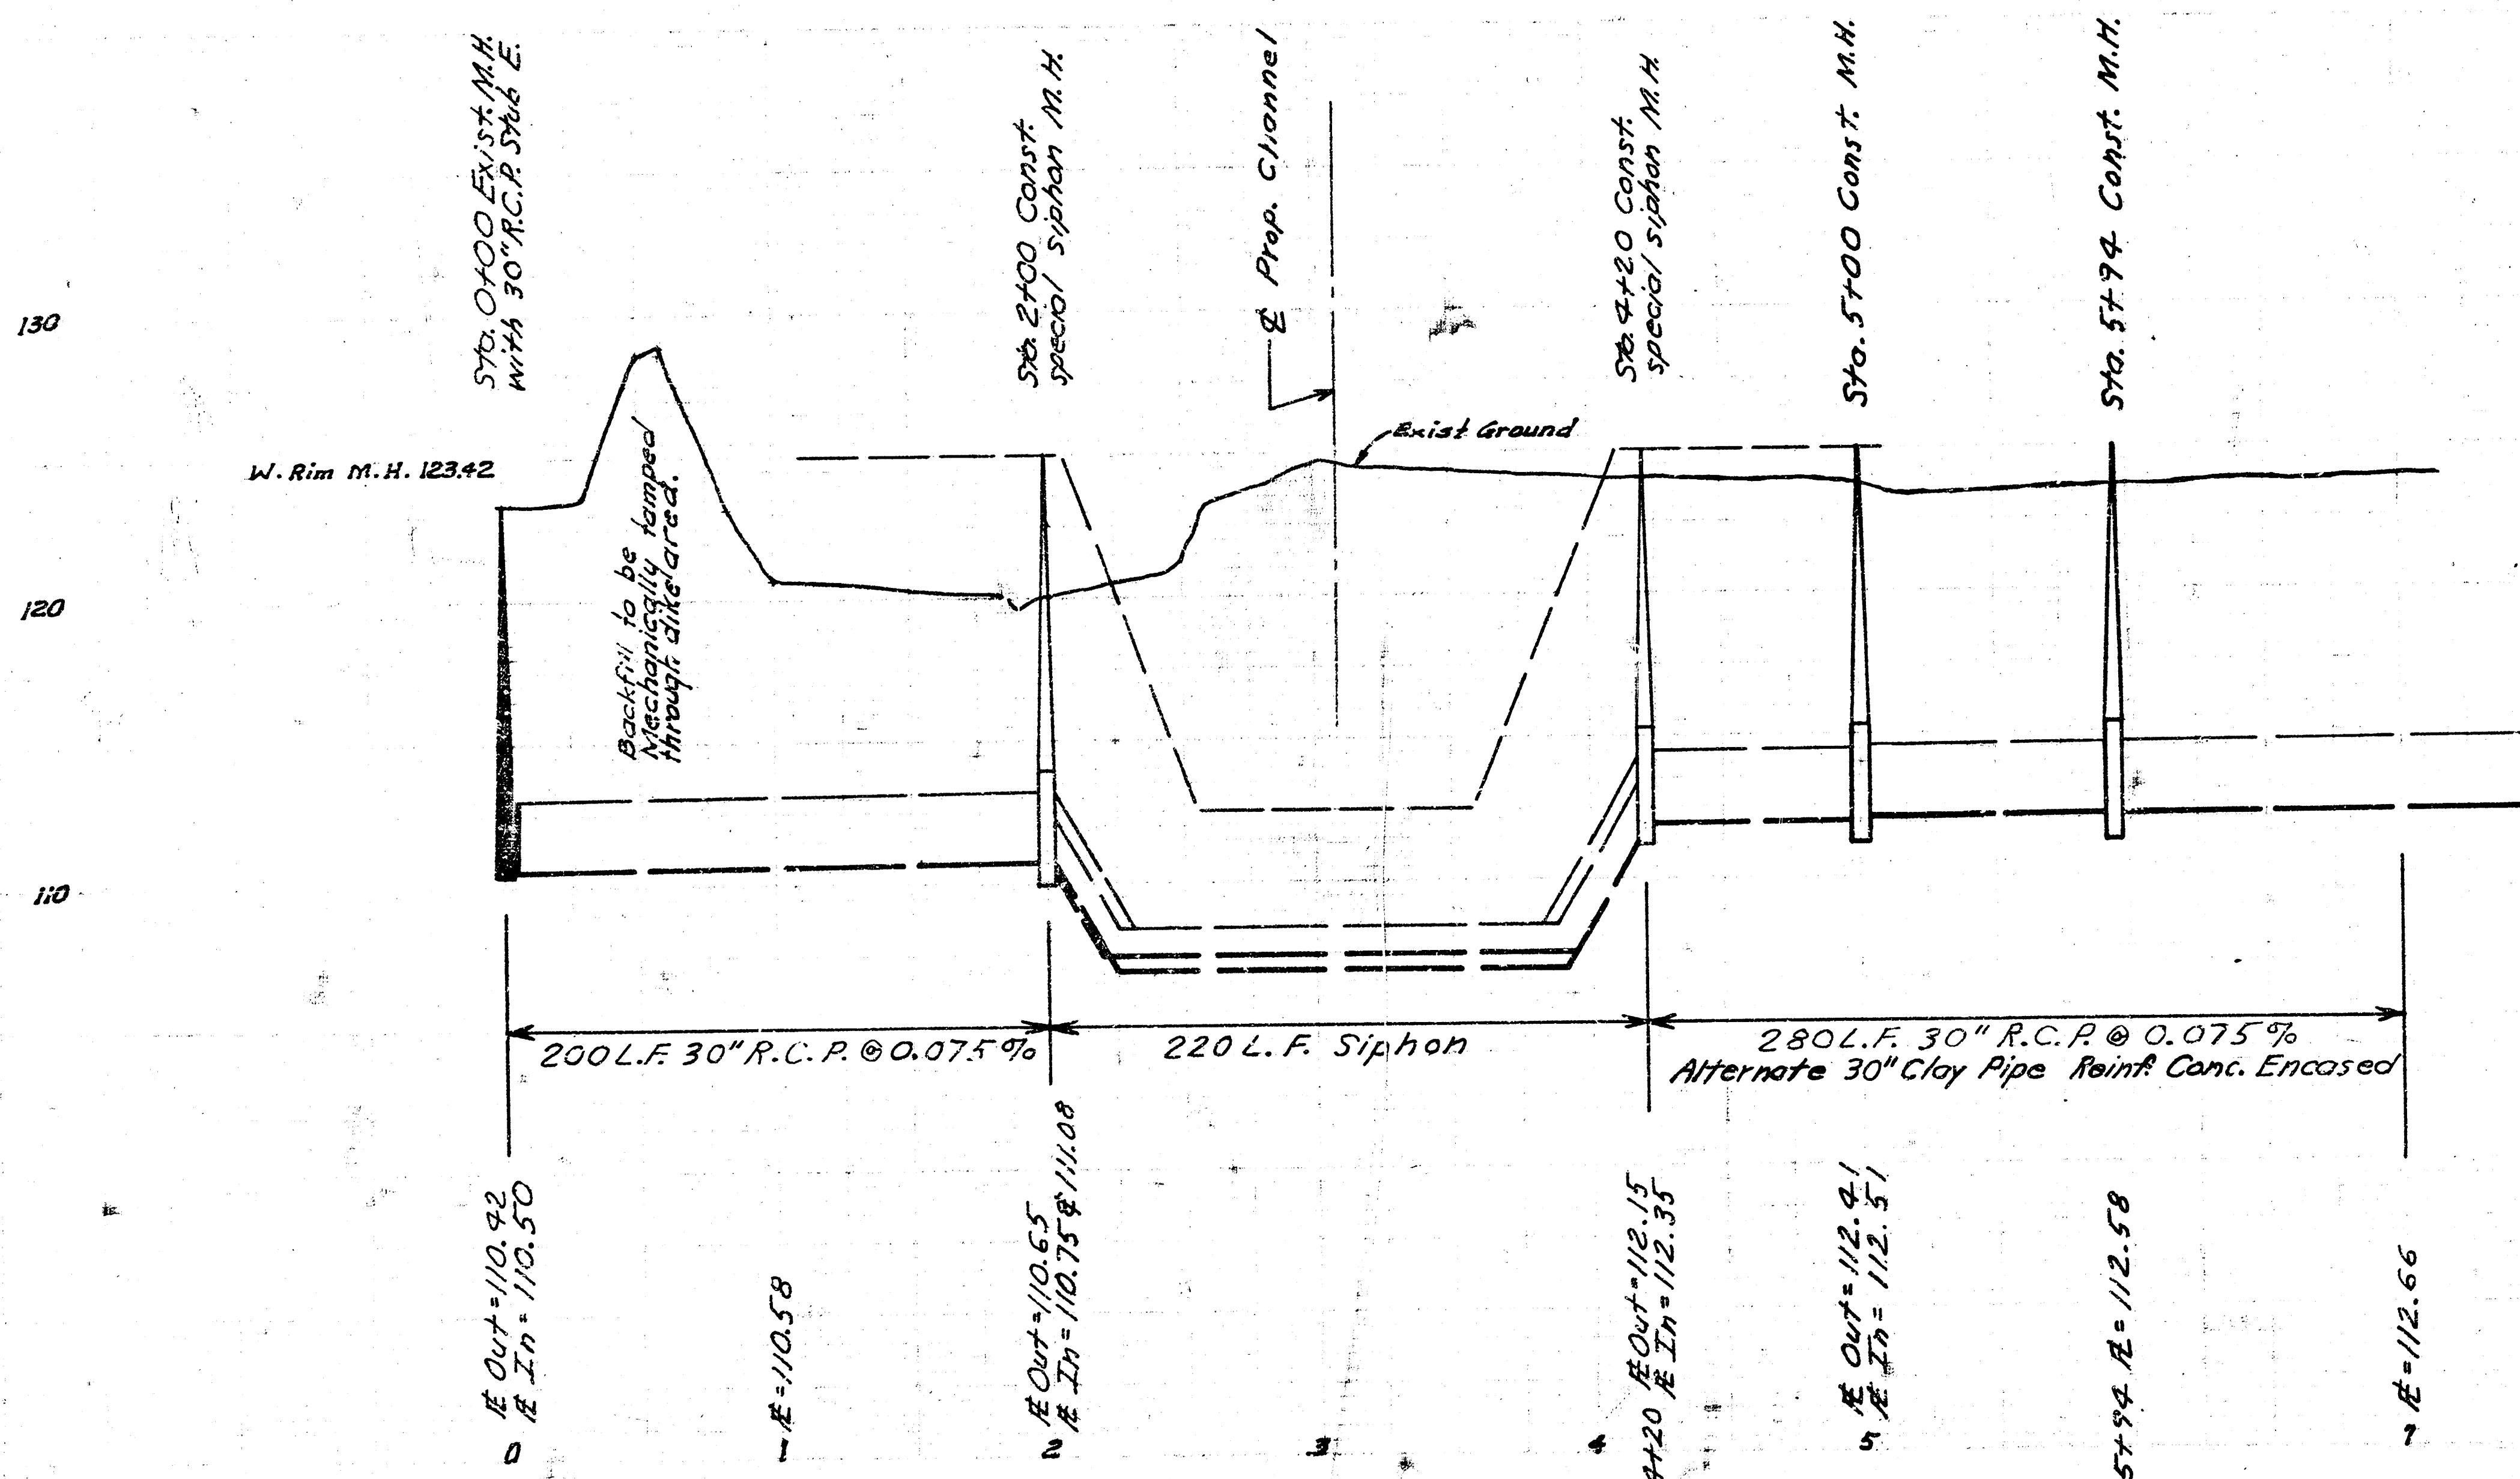


MAIN 5, S. W. INT. SEWER
SH. NO. 4 OF 17

FILMED FROM THE BEST
AVAILABLE COPY

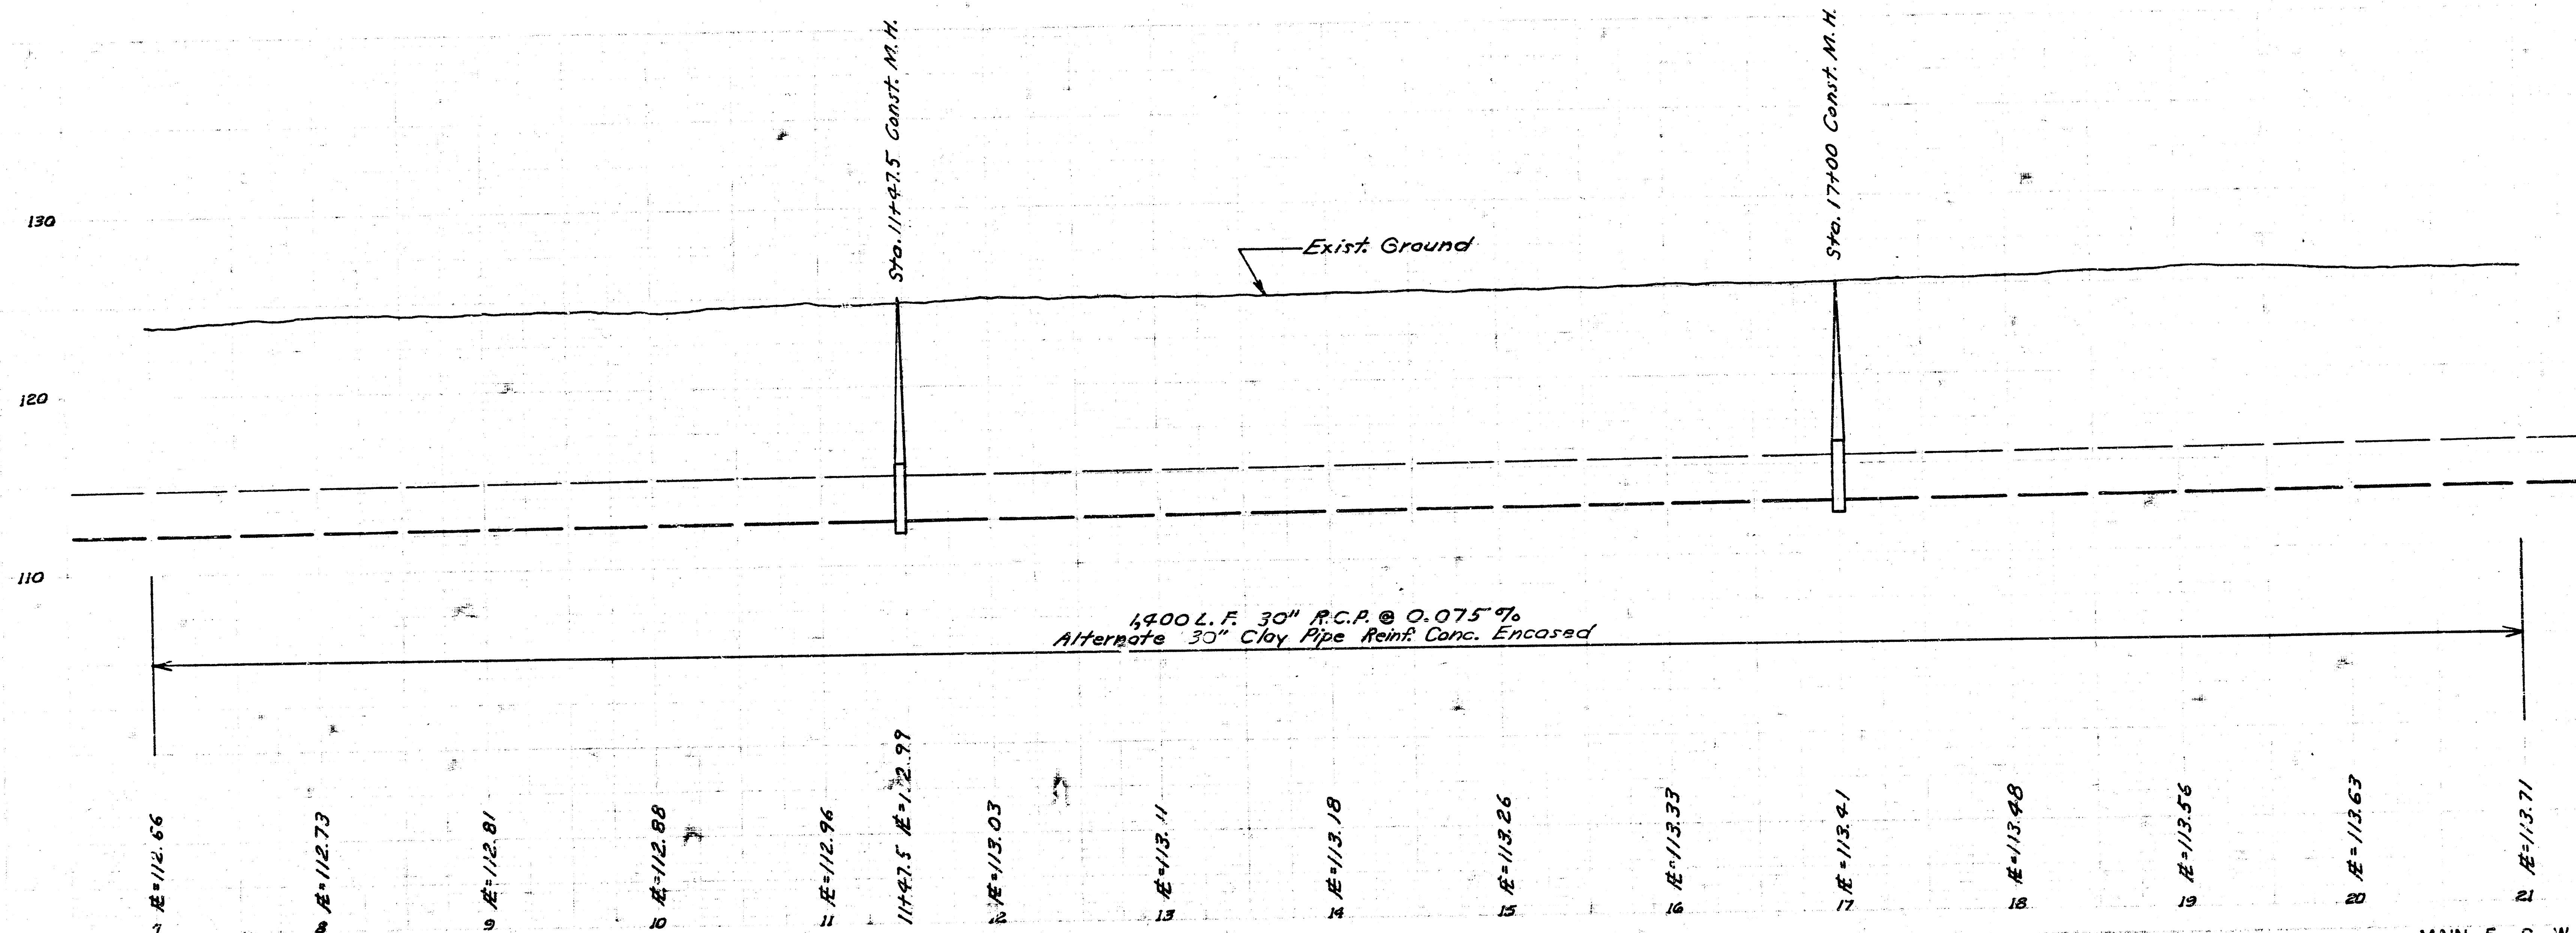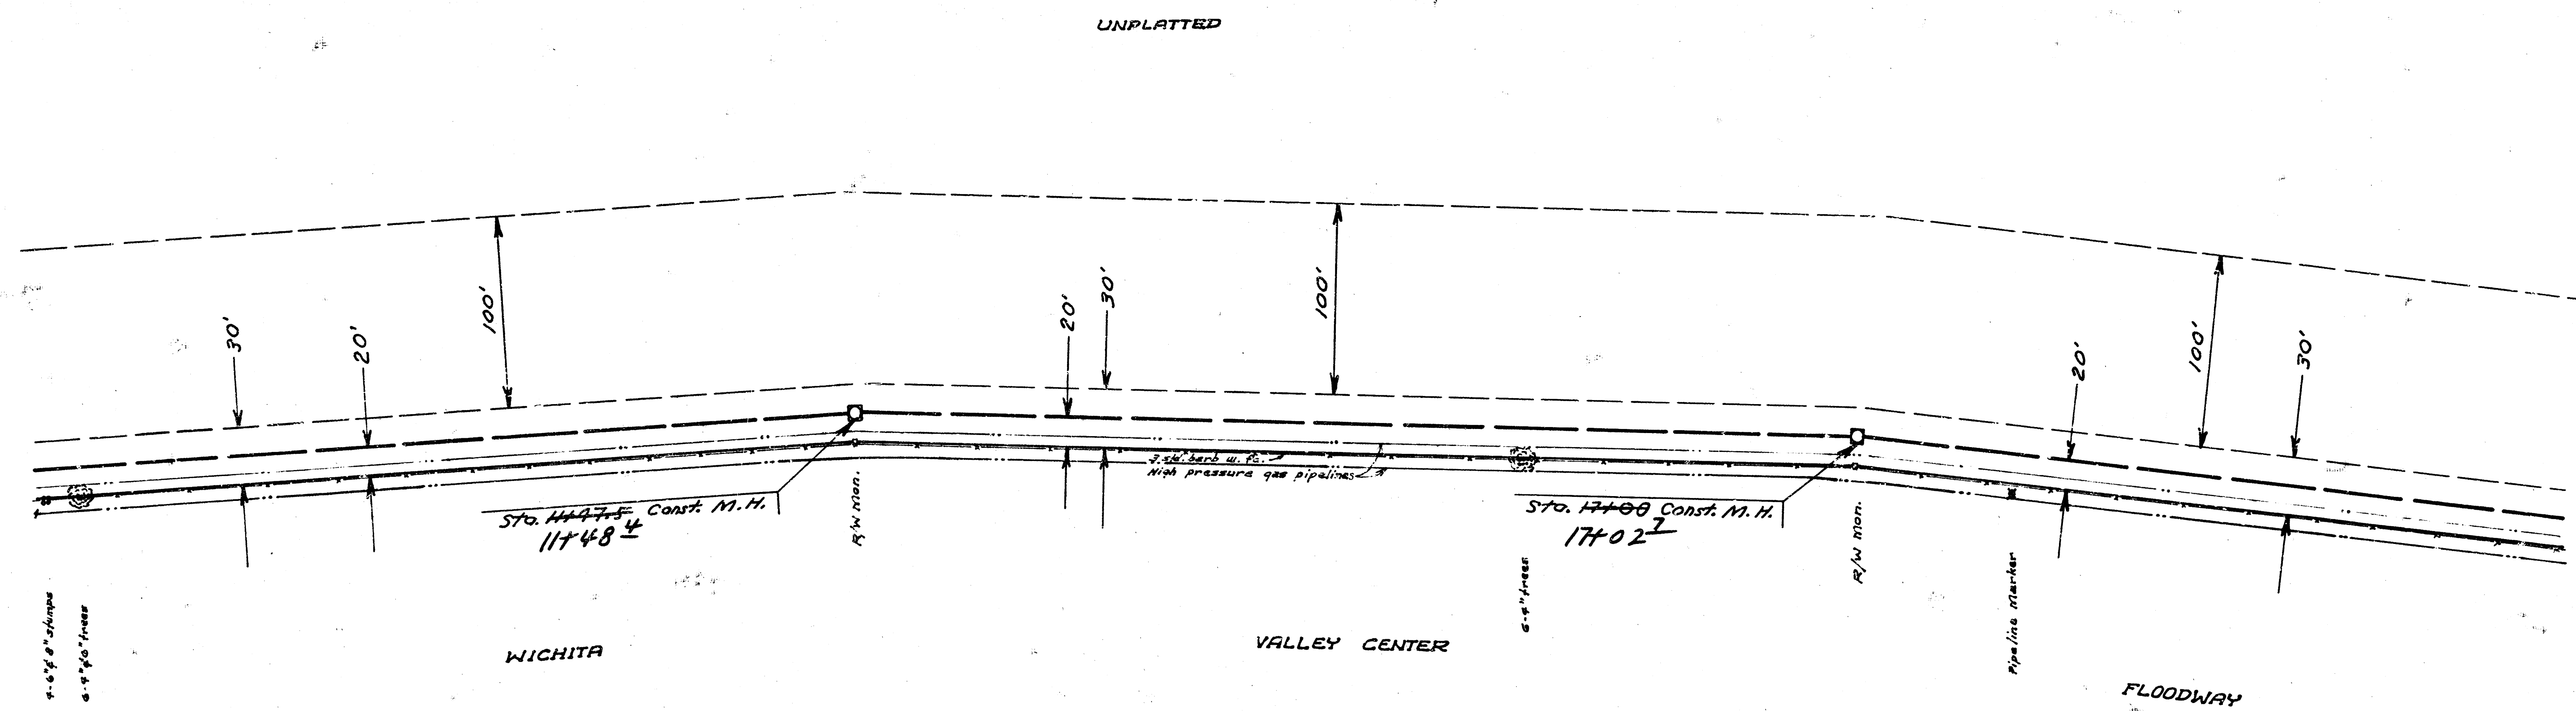

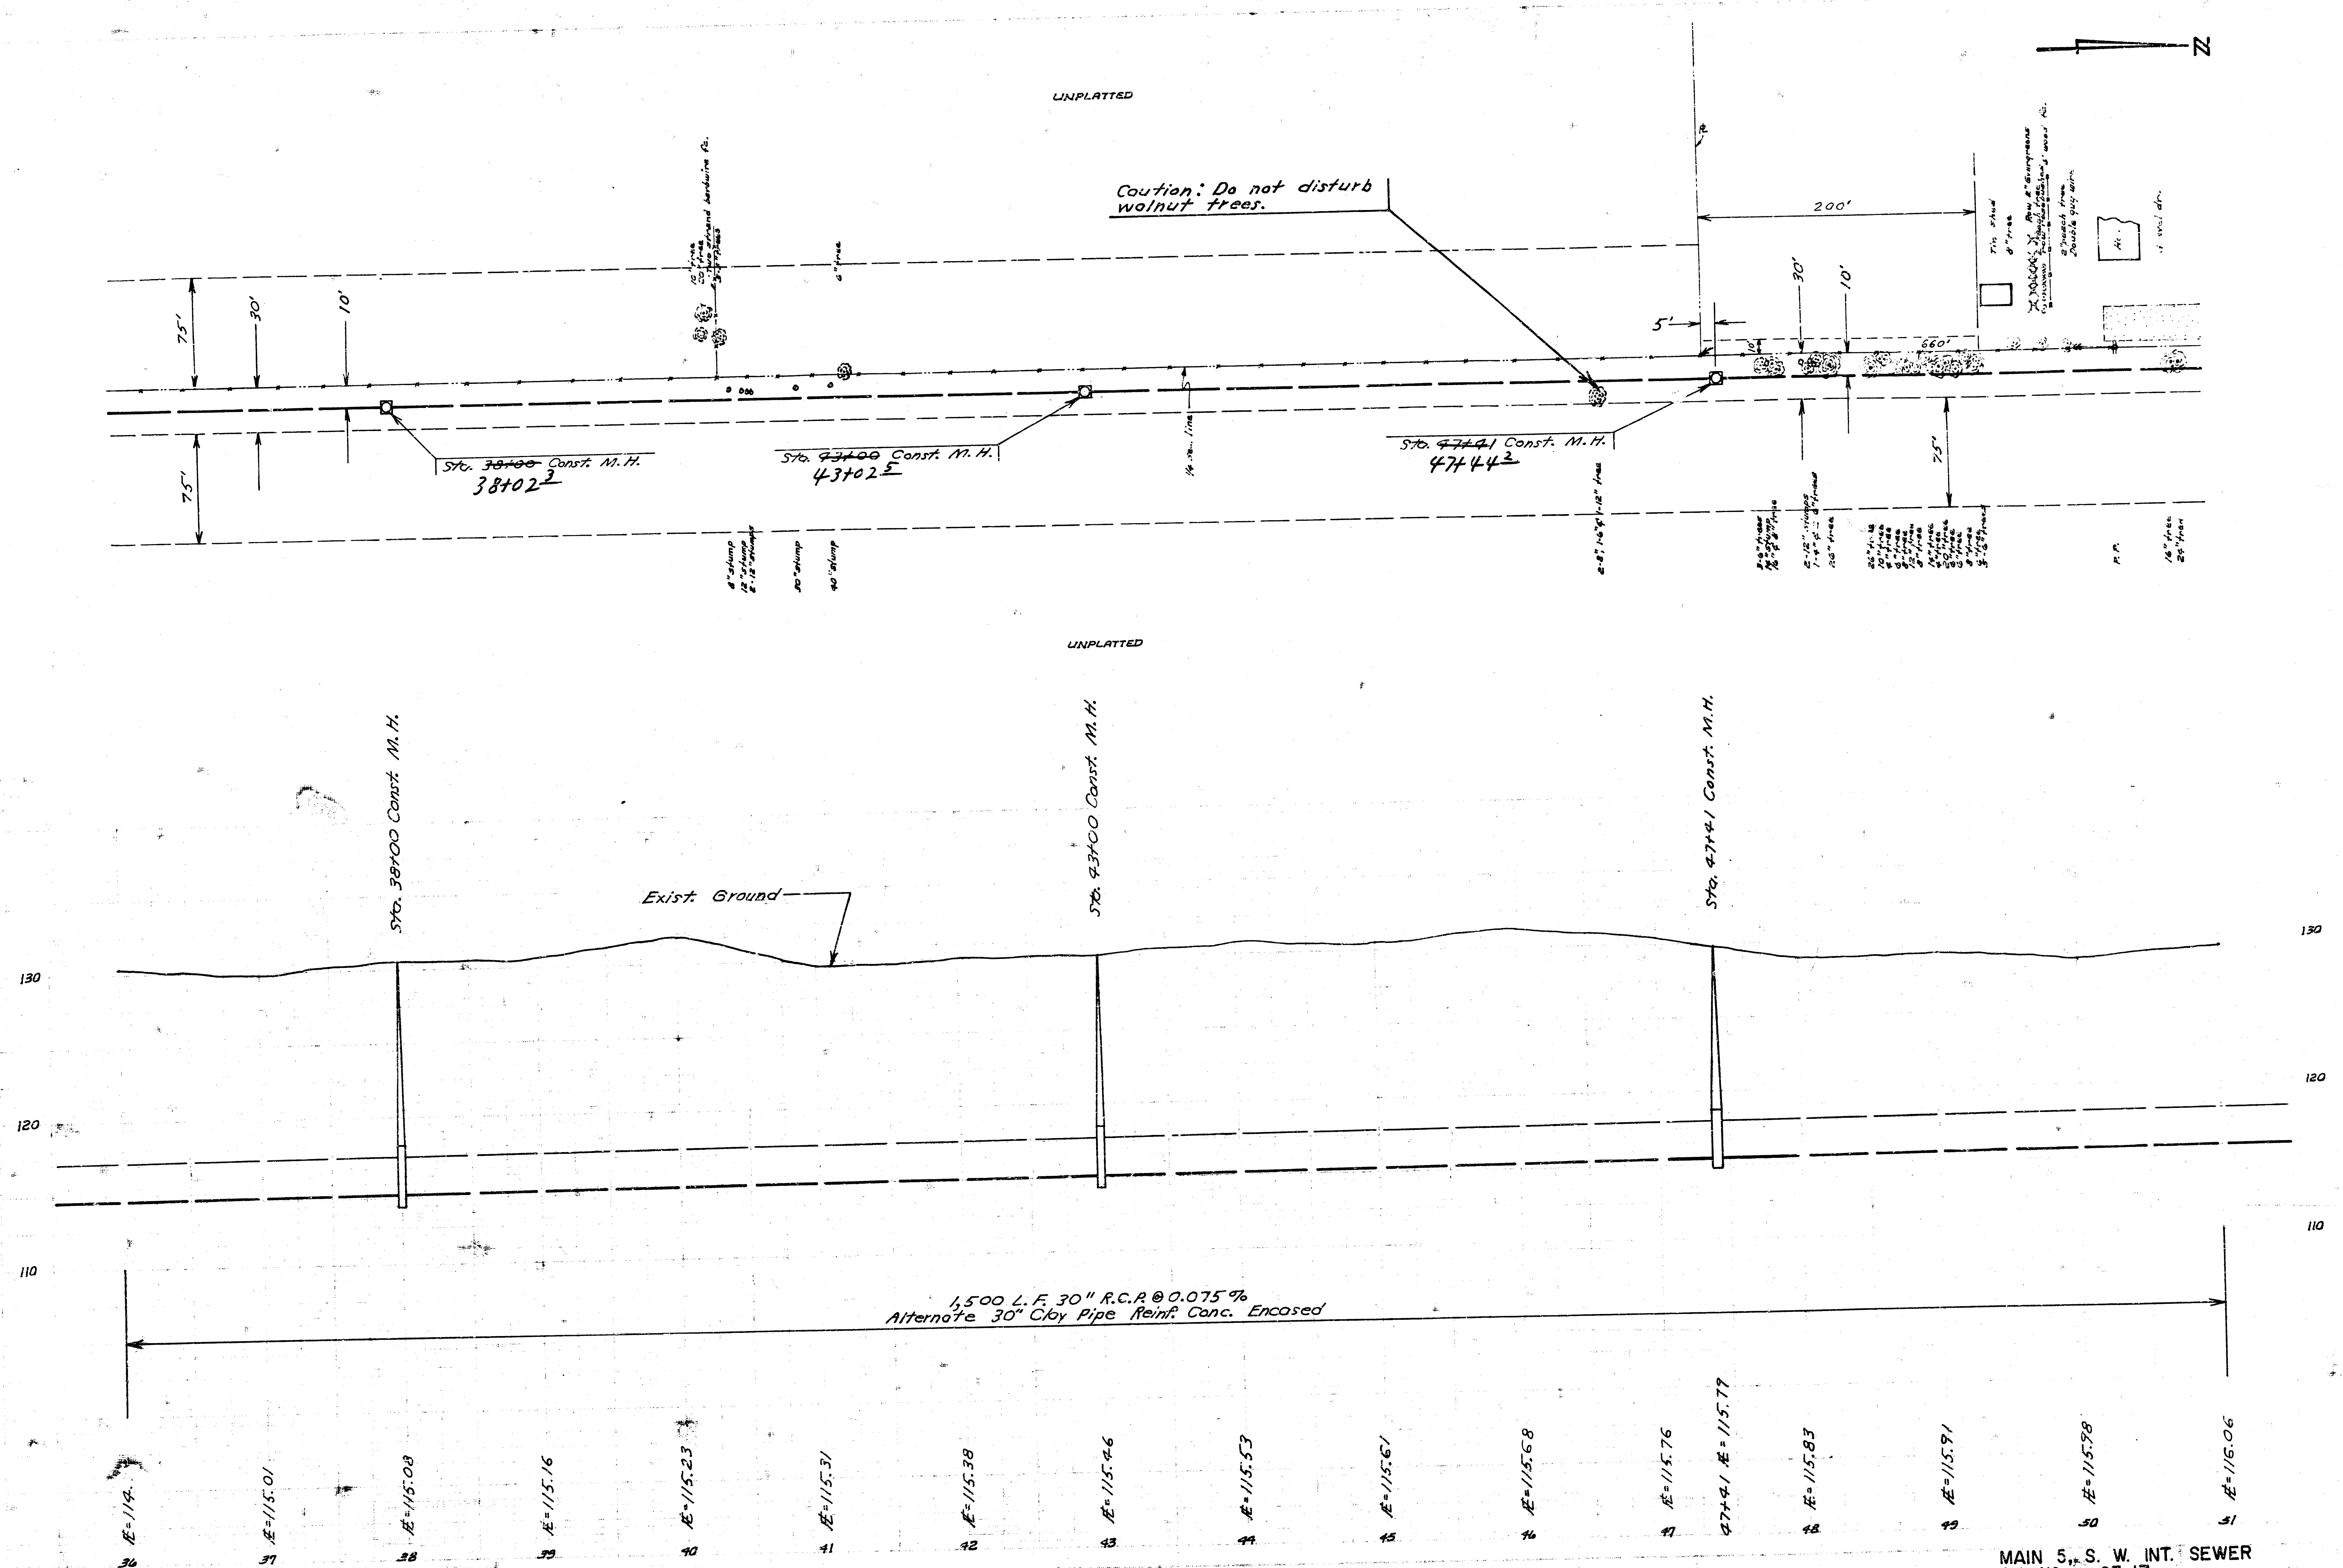

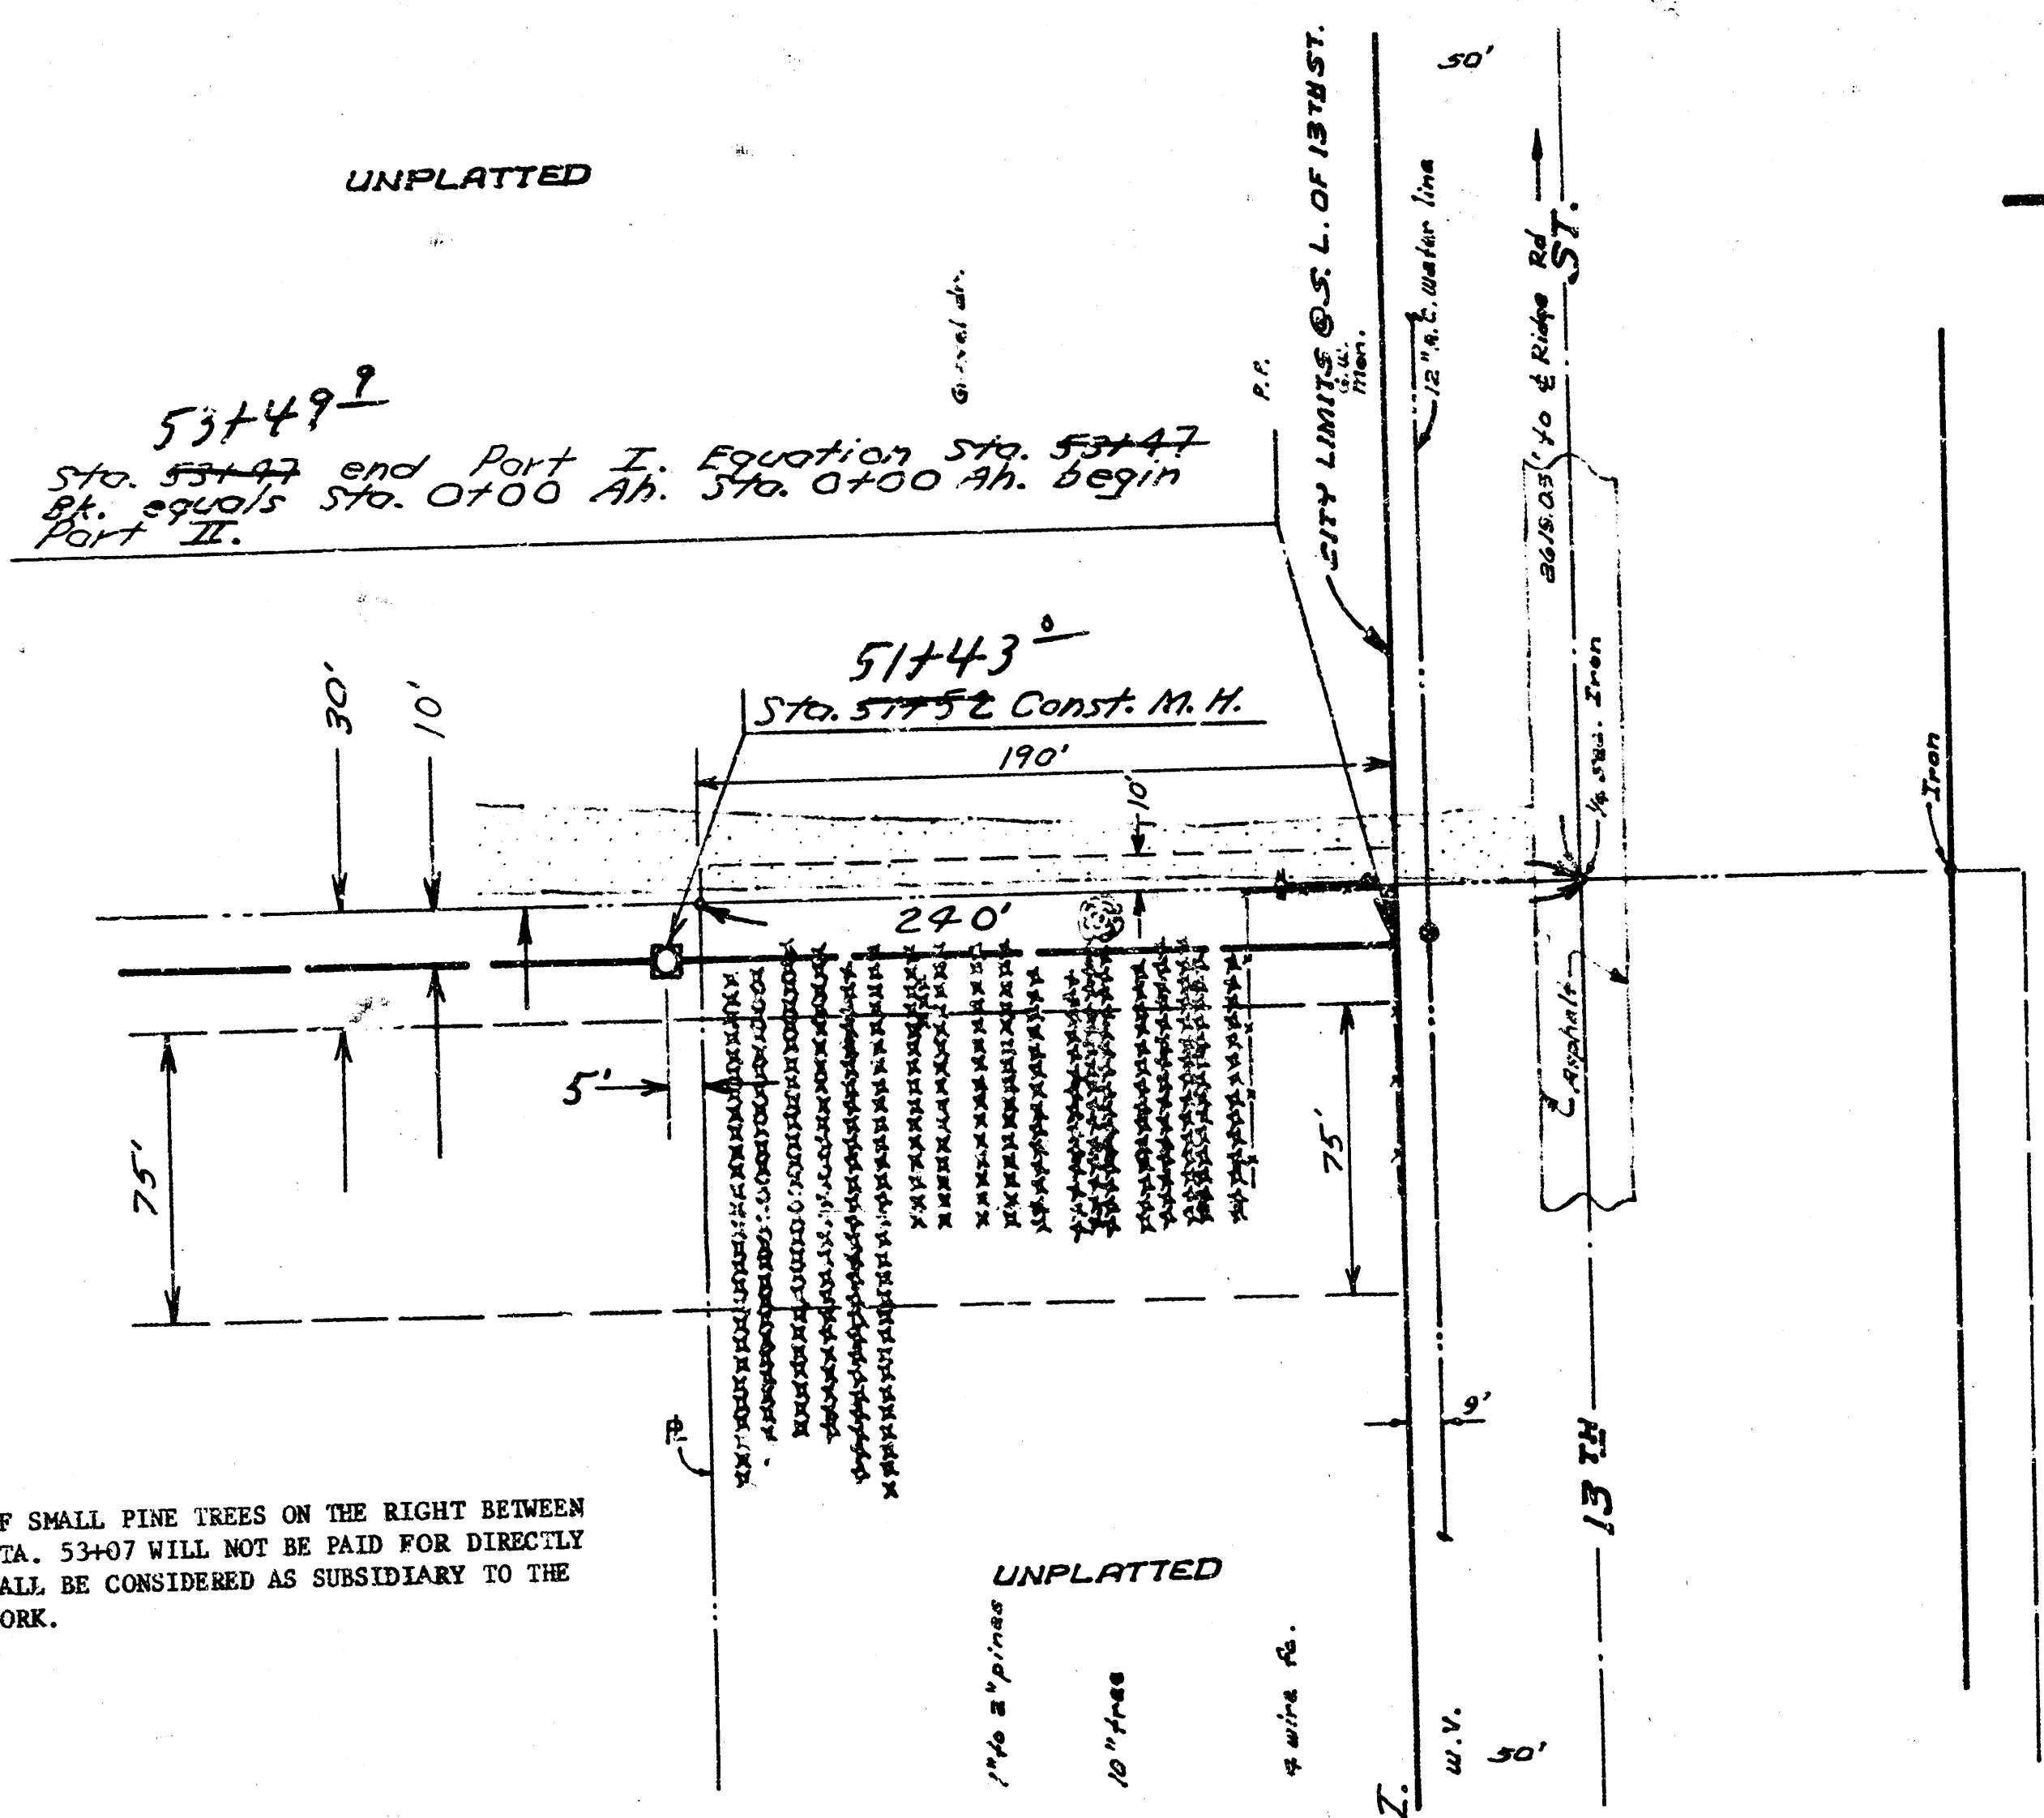

NOTE: REMOVAL OF SMALL PINE TREES ON THE RIGHT BETWEEN STA. 51+57 AND STA. 52+07 WILL NOT BE PAID FOR DIRECTLY AND THIS WORK SHALL BE CONSIDERED AS SUBSIDIARY TO THE OTHER ITEMS OF WORK.

SEDGWICK CO. 200

LOT 2

2nd ADDN.

B. M. 130.53 Top R/W Mon. 55' So. of 1/4 sec. cor. & 13th & 2619.05' E. of & Ridge Rd.

Manhole Schedule Part I		
Location	Type	Location of Openings for Future Sewers
2+00.00	Special Reinf. Conc. No Alternate	None
4+20.00	Special Reinf. Conc. No Alternate	8" South E=114.18
5+00.00	Reinf. Conc. Alternate 5' Dia. Type B	8" South E=114.34
5+94.00	Reinf. Conc. Alternate 5' Dia. Type B	8" West E=114.41
11+47.50	Reinf. Conc. Alternate 5' Dia. Type B	8" West E=114.83
17+00.00	Reinf. Conc. Alternate 5' Dia. Type B	8" West E=115.24
22+54.00	Reinf. Conc. Alternate 5' Dia. Type B	8" West E=115.95
27+43.00	Special Reinf. Conc. Alternate 5' Dia. Type B	10" West E=116.70
32+78.00	Reinf. Conc. Alternate 5' Dia. Type B	8" West E=116.52
38+00.00	Structural Tee Alternate 5' Dia. Type B	8" West & 8" East E=116.91
43+00.00	Structural Tee Alternate 5' Dia. Type B	8" West & 8" East E=117.29
47+41.00	Structural Tee Alternate 5' Dia. Type B	8" West & 8" East E=117.63
51+52.00	Structural Tee Alternate 5' Dia. Type B	8" West & 8" East E=117.93

NOTE: ALL STUBS AND OPENINGS FOR FUTURE 8" SEWER CONNECTIONS SHALL BE INSTALLED TO PERMIT CONSTRUCTION OF THE FUTURE 8" SEWERS ON A 0.42 GRADE. ALL STUBS AND OPENINGS FOR FUTURE 10" SEWER CONNECTIONS SHALL BE INSTALLED TO PERMIT CONSTRUCTION OF THE FUTURE 10" SEWERS ON A 0.37 GRADE. ALL WORK AND MATERIALS NECESSARY TO CONSTRUCT OPENINGS OR STUBS FOR FUTURE SEWER CONNECTIONS WILL NOT BE PAID FOR DIRECTLY AND SHALL BE CONSIDERED AS SUBSIDIARY TO THE OTHER ITEMS OF WORK. ALTERNATE BRICK MANHOLES TO BE USED ONLY WITH REINFORCED CONCRETE ENCASED CLAY PIPE.

NOTE: CONTRACTOR SHALL CONSTRUCT AND MAINTAIN A TEMPORARY GRAVEL DRIVE TO PROVIDE ACCESS TO HOUSE LEFT OF STA. 50+40 WHILE CONSTRUCTING SEWER ADJACENT TO THIS PROPERTY. TEMPORARY DRIVE SHALL BE REMOVED AND THE PREMISES RESTORED TO THE ORIGINAL CONDITION UPON COMPLETION OF THE WORK. CONTRACTOR SHALL CONSTRUCT AN ASPHALT DRIVEWAY TWELVE (12) FEET WIDE TO REPLACE THE ORIGINAL GRAVEL DRIVE. THE DRIVEWAY SHALL CONSIST OF 4" COMPACTED ASPHALT PLACED IN TWO 2" LIFTS. ASPHALT DRIVEWAY CONSTRUCTION SHALL CONFORM TO THE APPLICABLE SECTIONS OF THE CITY OF WICHITA STANDARD SPECIFICATIONS FOR ASPHALT PAVEMENT. ASPHALTIC MATERIALS SHALL CONFORM TO THE REQUIREMENTS SPECIFIED FOR ASPHALT SURFACE COURSE (TYPE SC-1). THE APPROXIMATE QUANTITY OF ASPHALT DRIVEWAY CONSTRUCTION IS 500 SQ. YDS. THE WORK CONSISTING OF CONSTRUCTION AND MAINTENANCE OF A TEMPORARY GRAVEL DRIVE; REMOVAL OF TEMPORARY GRAVEL DRIVE; RESTORATION OF AREA TO ORIGINAL CONDITION; AND CONSTRUCTION OF ASPHALT DRIVE TO REPLACE ORIGINAL GRAVEL DRIVE WILL NOT BE PAID FOR DIRECTLY AND THIS WORK SHALL BE CONSIDERED AS SUBSIDIARY TO THE OTHER ITEMS OF WORK.

130

120

110

42 L.F. 30" R.C.P. @ 0.075%
Alternate 30" Clay Pipe
Reinf. Conc. Encased

205 L.F. 30" Clay Pipe @ 0.075%
Reinf. Conc. Encased
No Alternate

51 E=116.06

51+42 E=116.09

52 E=116.13

53 E=116.21

52+47 E=116.25




MAIN 5, S. W. INT. SEWER
SH. NO. 8 OF 17

FILMED FROM THE BEST
AVAILABLE COPY.....

SEDGWICK COUNTY ZOO

(A)

LOT 2

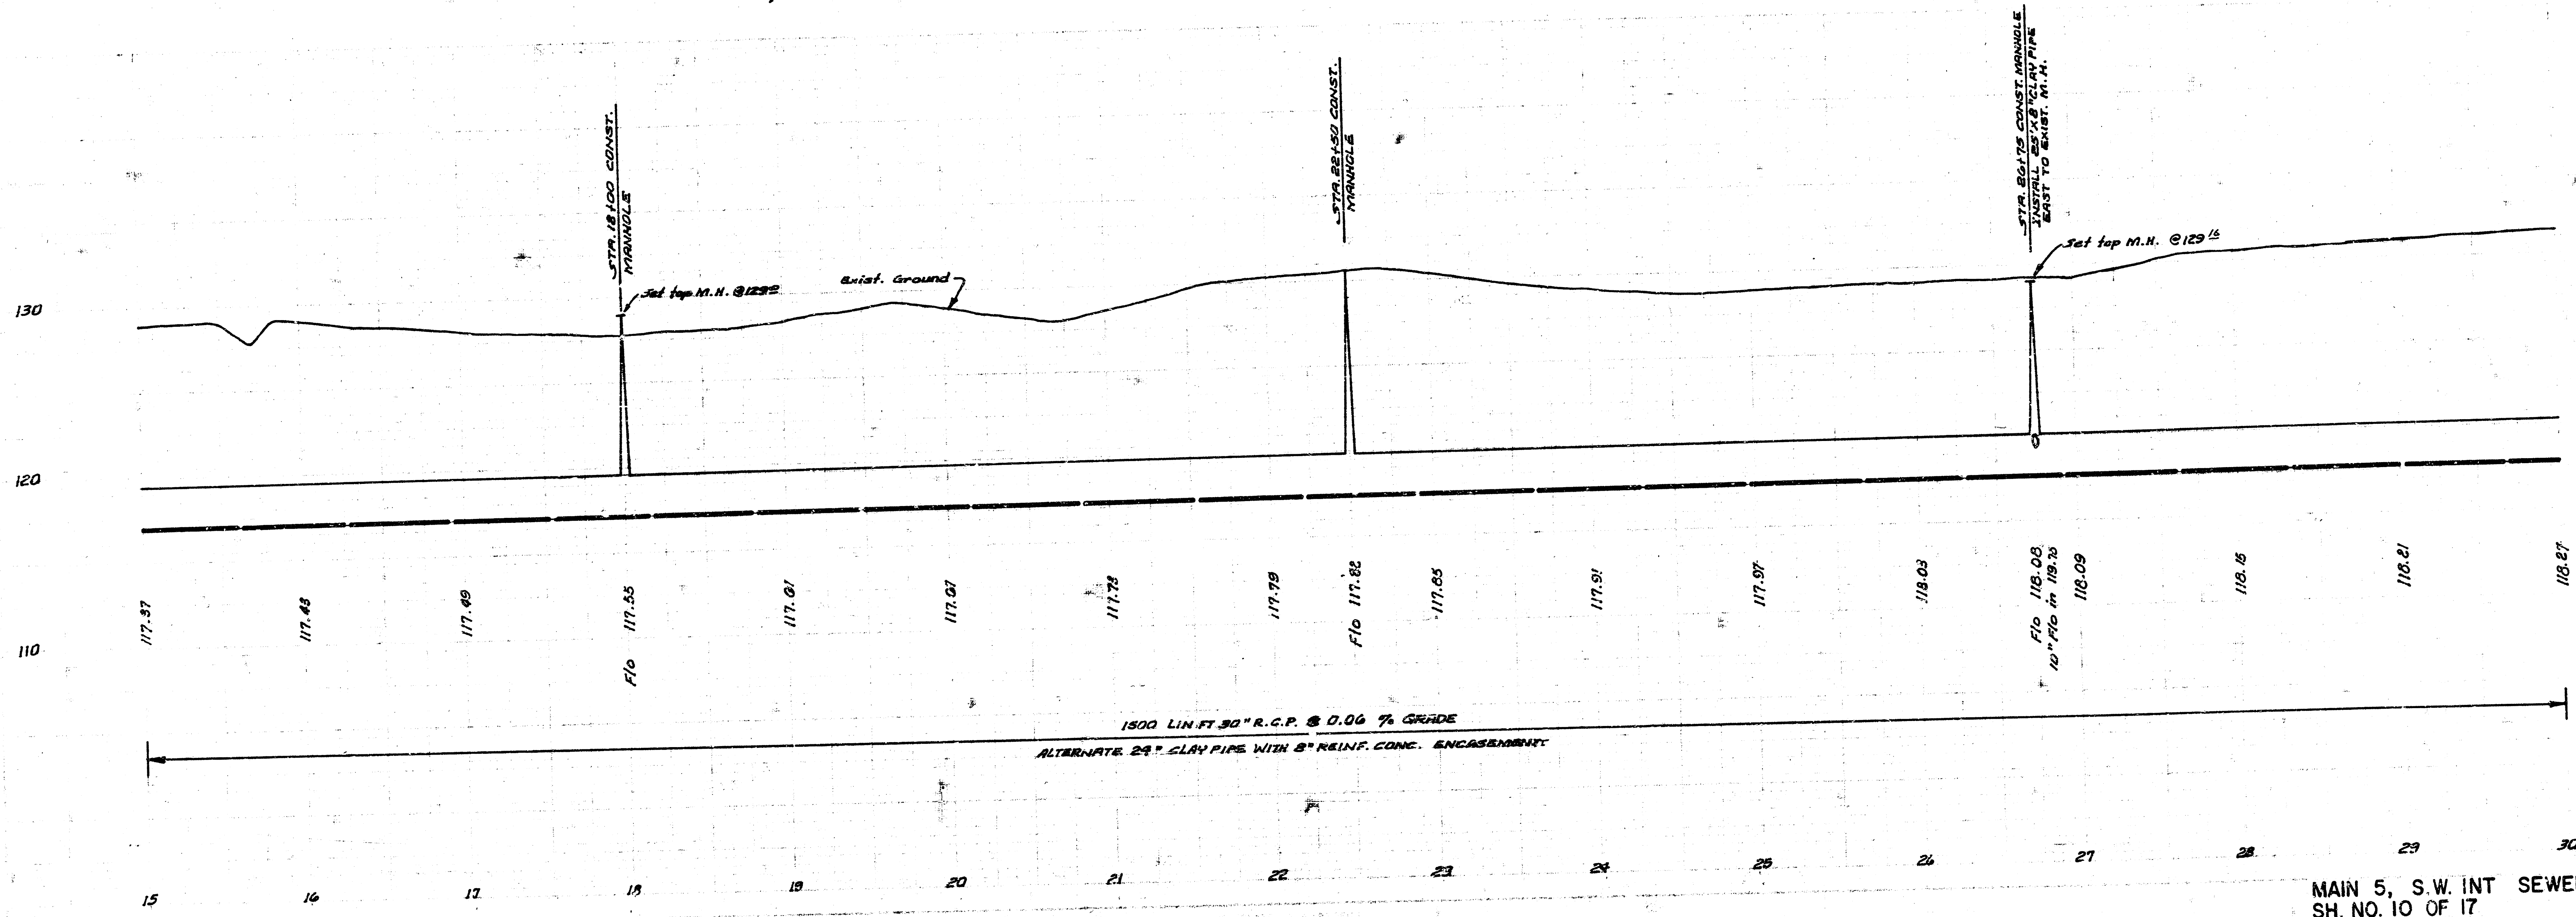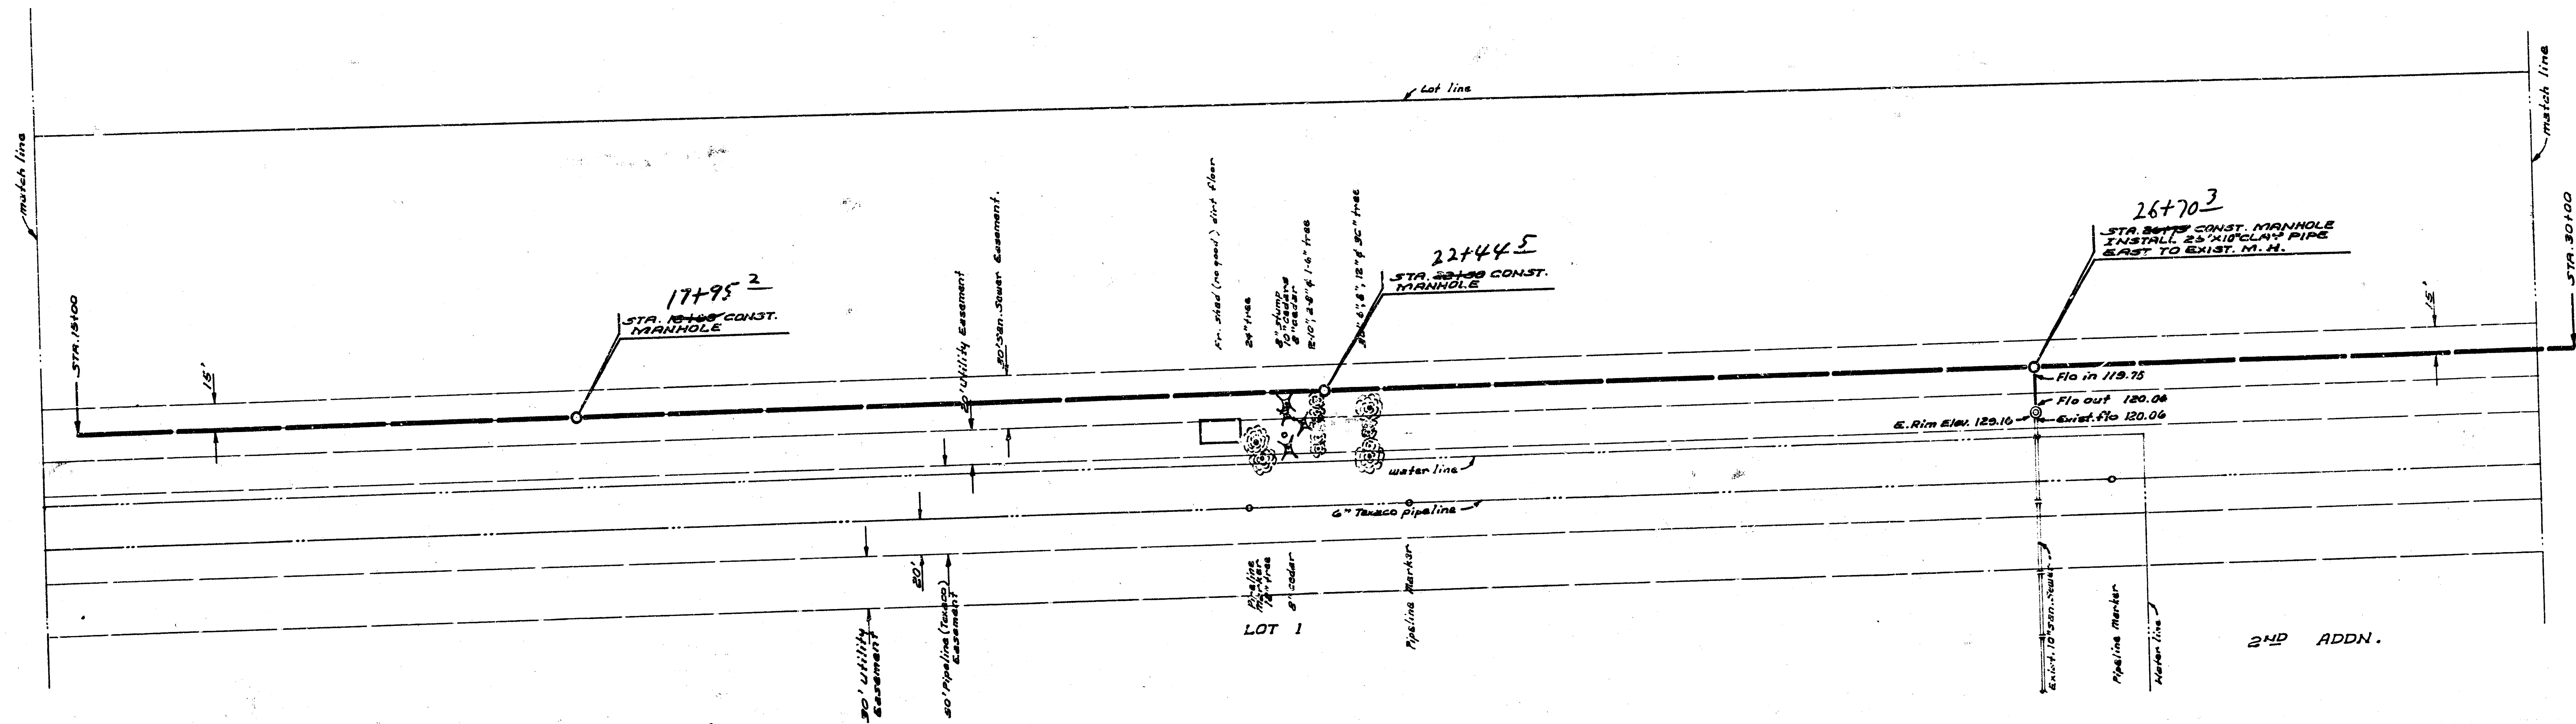
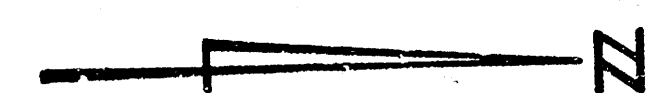


MAIN 5, S.W. INT. SEWER
SH. NO. 10 OF 17

10/17


FILMED FROM THE BEST
AVAILABLE COPY.....

AN-60

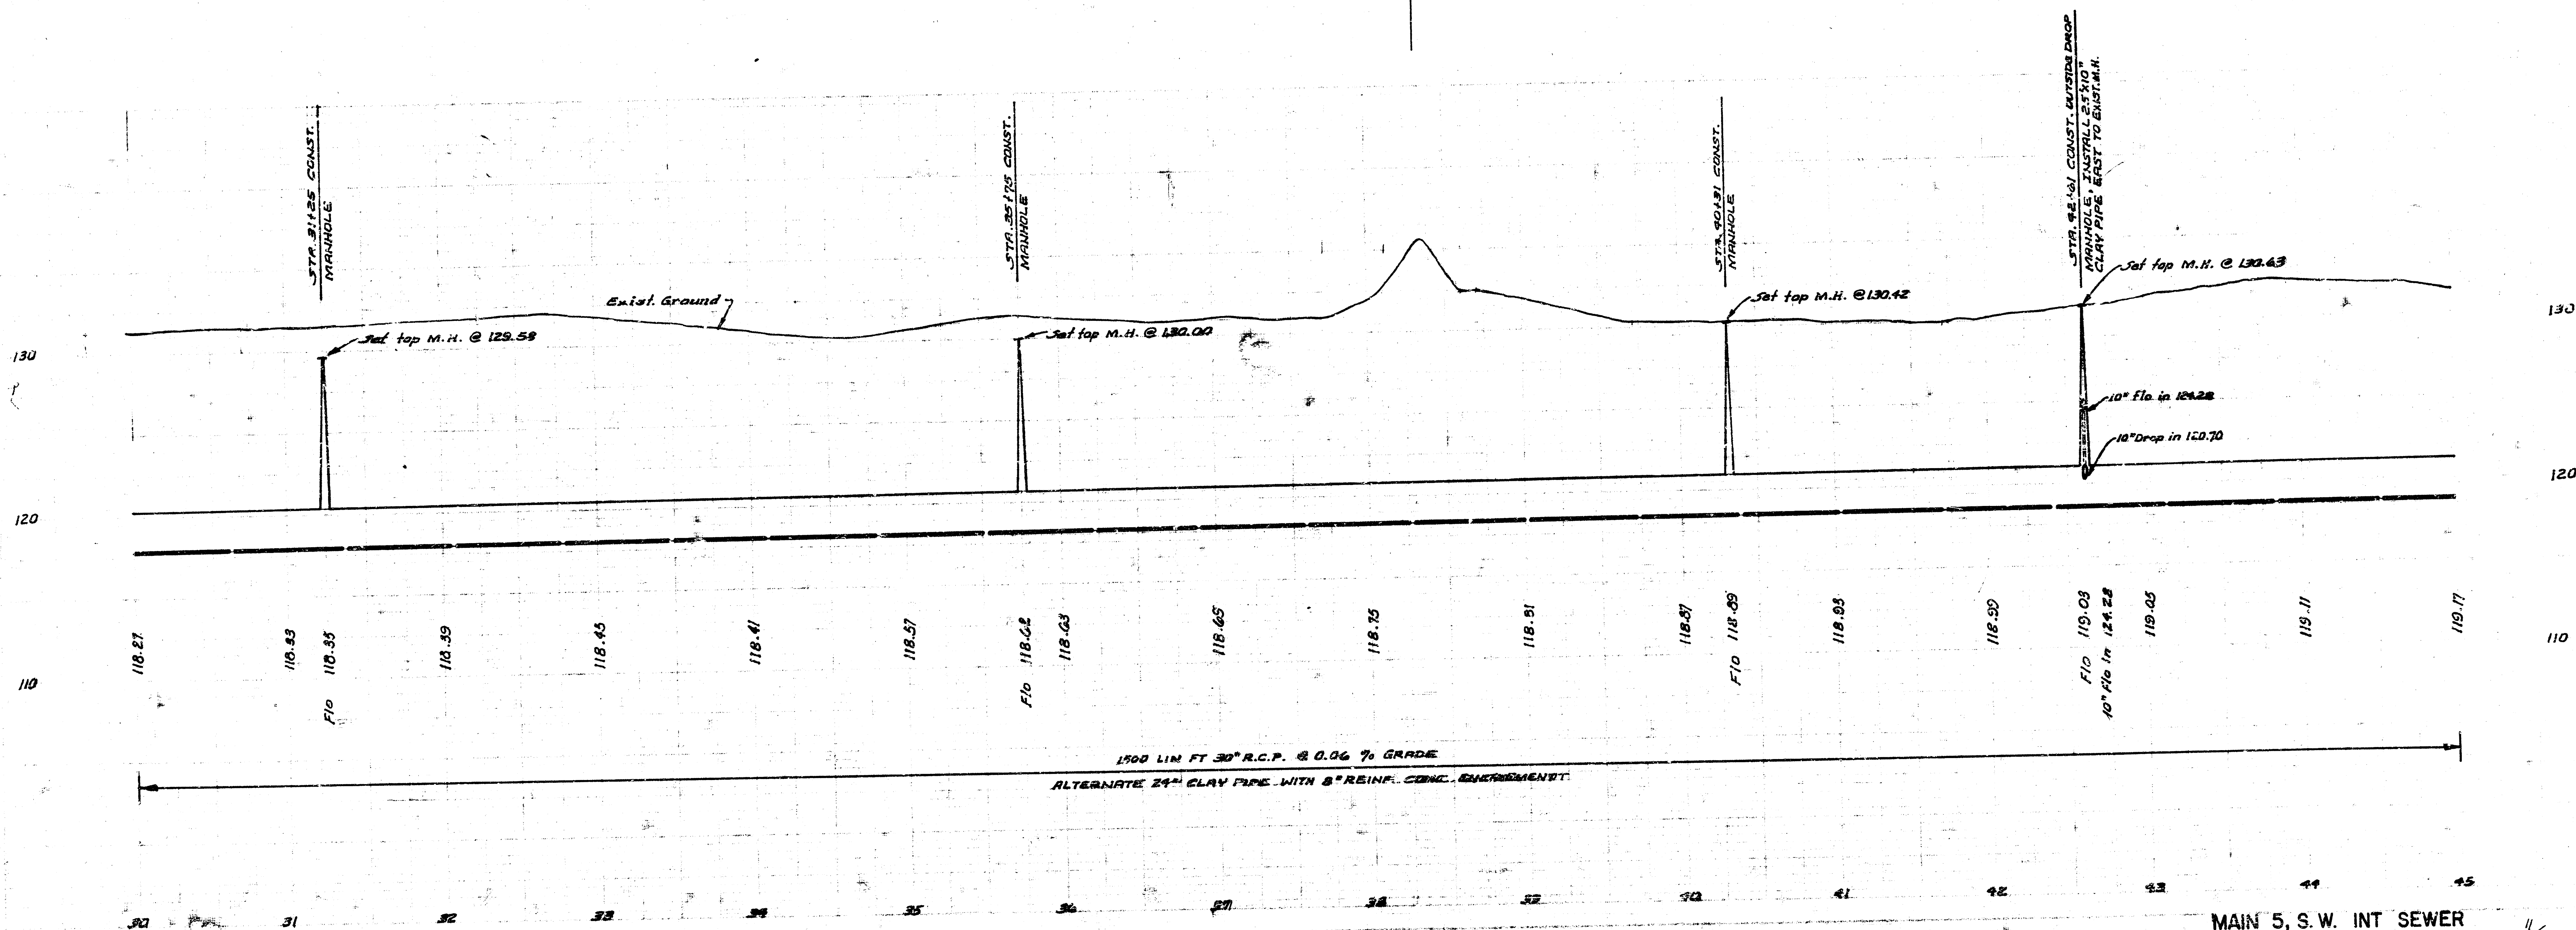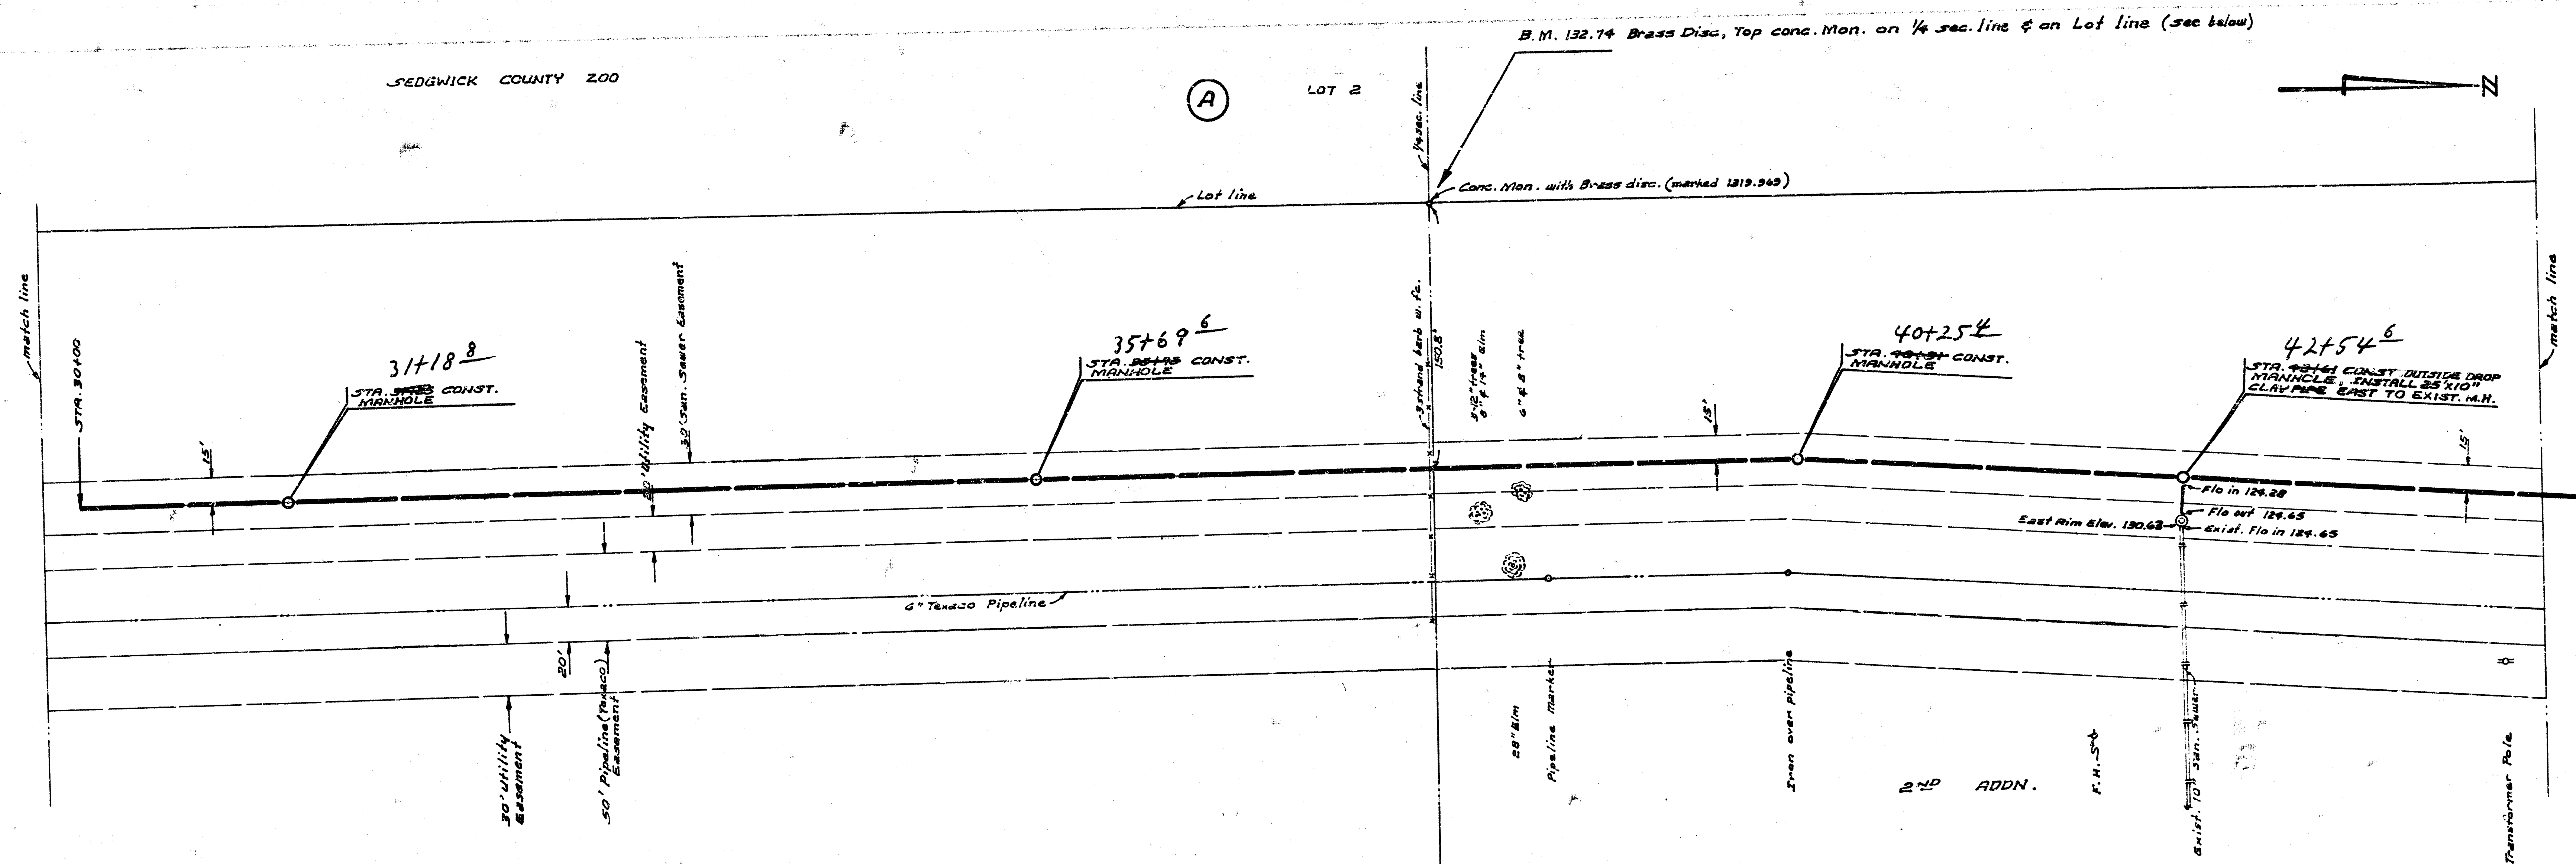


MAIN 5, S.W. INT SEWER
SH. NO. 11 OF 17

FILMED FROM THE BEST
AVAILABLE COPY

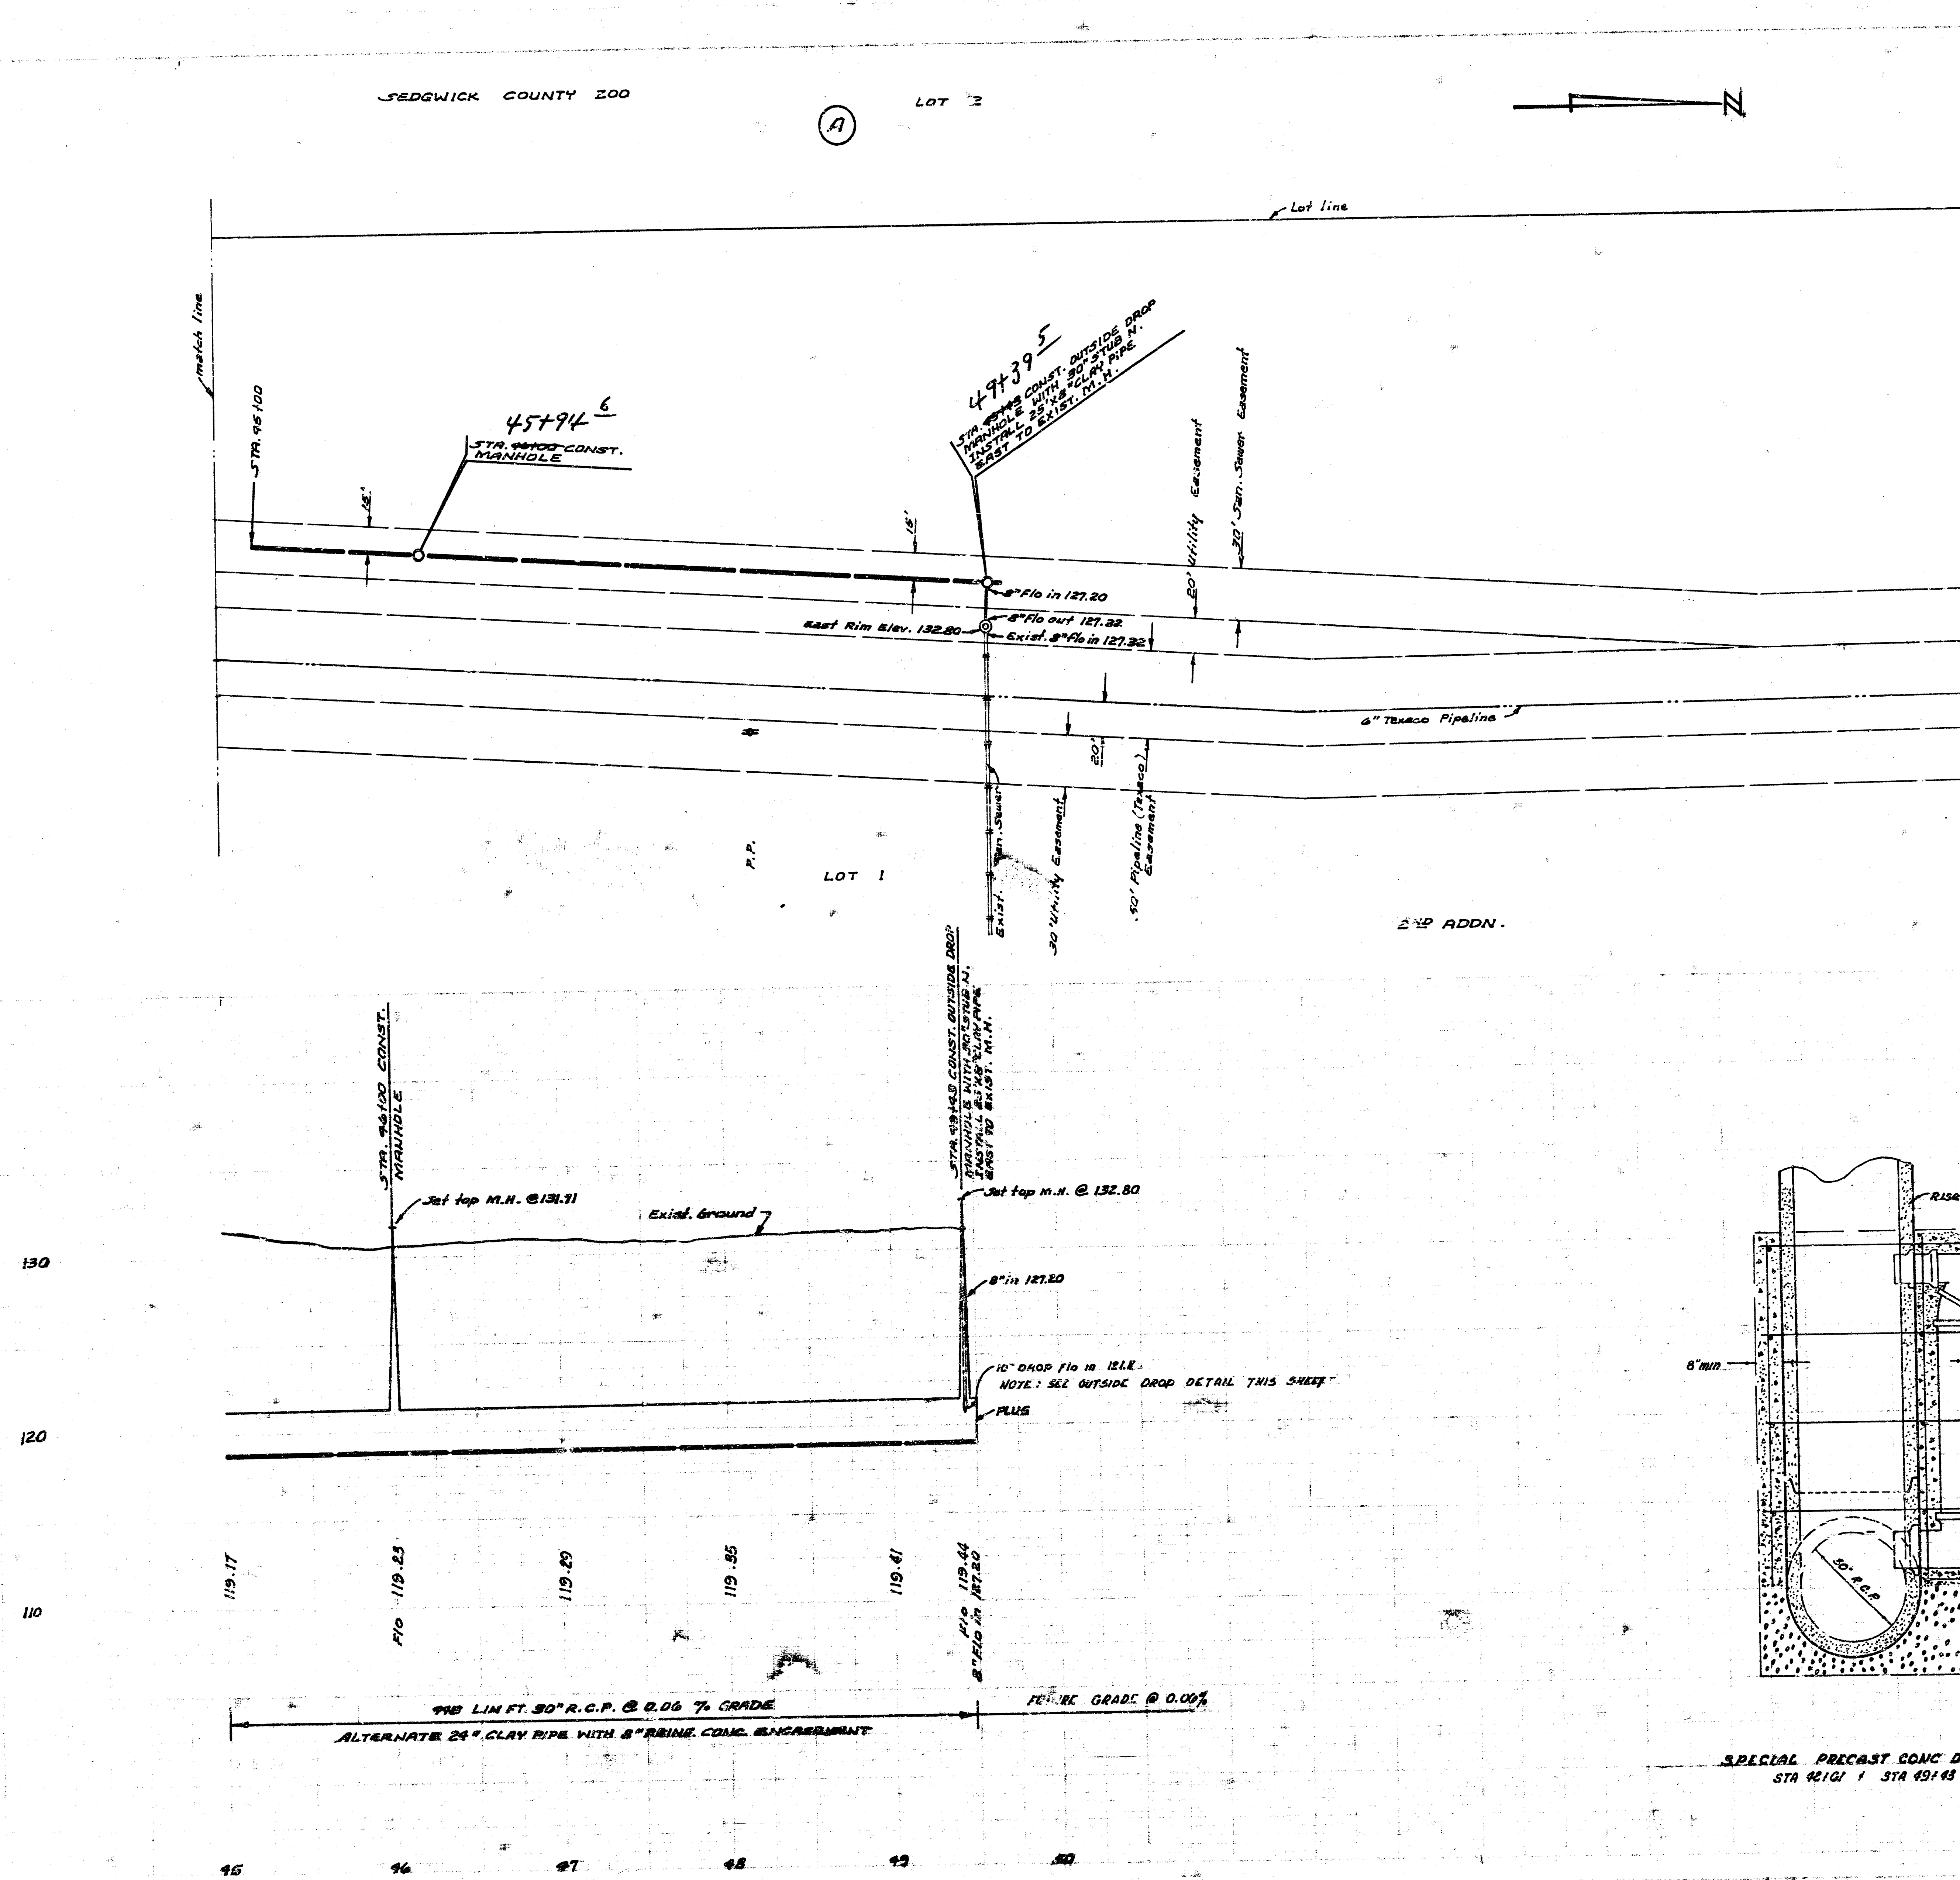


MANHOLE SCHEDULE PART II		
LOCATION	TYPE	LOCATION OF OPENINGS FOR FUTURE SEWERS.
1108	REINF CONC - Alternate 5' Dia Type B	Block out for future 8\" west
9150	STRUCTURAL TEE - Alternate 5' Dia Type B	8\" North E. 11087
7125	STRUCTURAL TEE - Alternate 5' Dia Type B	8\" North E. 11074
9170	REINF CONC - Alternate 5' Dia Type B	8\" North E. 11078
11179	REINF CONC - Alternate 5' Dia Type B	
13100	REINF CONC - Alternate 5' Dia Type B	
13100	STRUCTURAL TEE - Alternate 5' Dia Type B	8\" West E. 11039
22150	STRUCTURAL TEE - Alternate 5' Dia Type B	8\" West E. 11905
20175	STRUCTURAL TEE - Alternate 5' Dia Type B	10\" East E. 11075 8\" West E. 11091
31125	STRUCTURAL TEE - Alternate 5' Dia Type B	8\" West E. 12018
35175	STRUCTURAL TEE - Alternate 5' Dia Type B	8\" West E. 12005
40131	REINF CONC - Alternate 5' Dia Type B	8\" West E. 12005
42101	STRUCTURAL TEE - OUTSIDE DROP Alternate 5' Dia Type B	8\" West E. 12080 - 10\" East E. 12100 10\" East OUTSIDE DROP 12070 E.
44100	STRUCTURAL TEE - Alternate 5' Dia Type B	8\" West + East E. 12004
45143	STRUCTURAL TEE - OUTSIDE DROP Alternate 5' Dia Type B	8\" West E. 12127 - 8\" East E. 12120 10\" East OUTSIDE DROP E. 12111


NOTE: ALL STUBS AND OPENINGS FOR FUTURE 8\" SEWER CONNECTIONS SHALL BE INSTALLED TO PERMIT CONSTRUCTION OF THE FUTURE 8\" SEWERS ON A 0.4% GRADE. ALL STUBS AND OPENINGS FOR FUTURE 10\" SEWER CONNECTIONS SHALL BE INSTALLED TO PERMIT CONSTRUCTION OF THE FUTURE 10\" SEWERS ON A 0.3% GRADE. ALL WORK AND MATERIALS NECESSARY TO CONSTRUCT OPENINGS OR STUBS FOR FUTURE SEWER CONNECTIONS WILL NOT BE PAID FOR DIRECTLY AND SHALL BE CONSIDERED AS SUBSIDIARY TO THE OTHER ITEMS OF WORK. ALTERNATE BRICK MANHOLES TO BE USED ONLY WITH REINFORCED CONCRETE ENCASED CLAY PIPE.

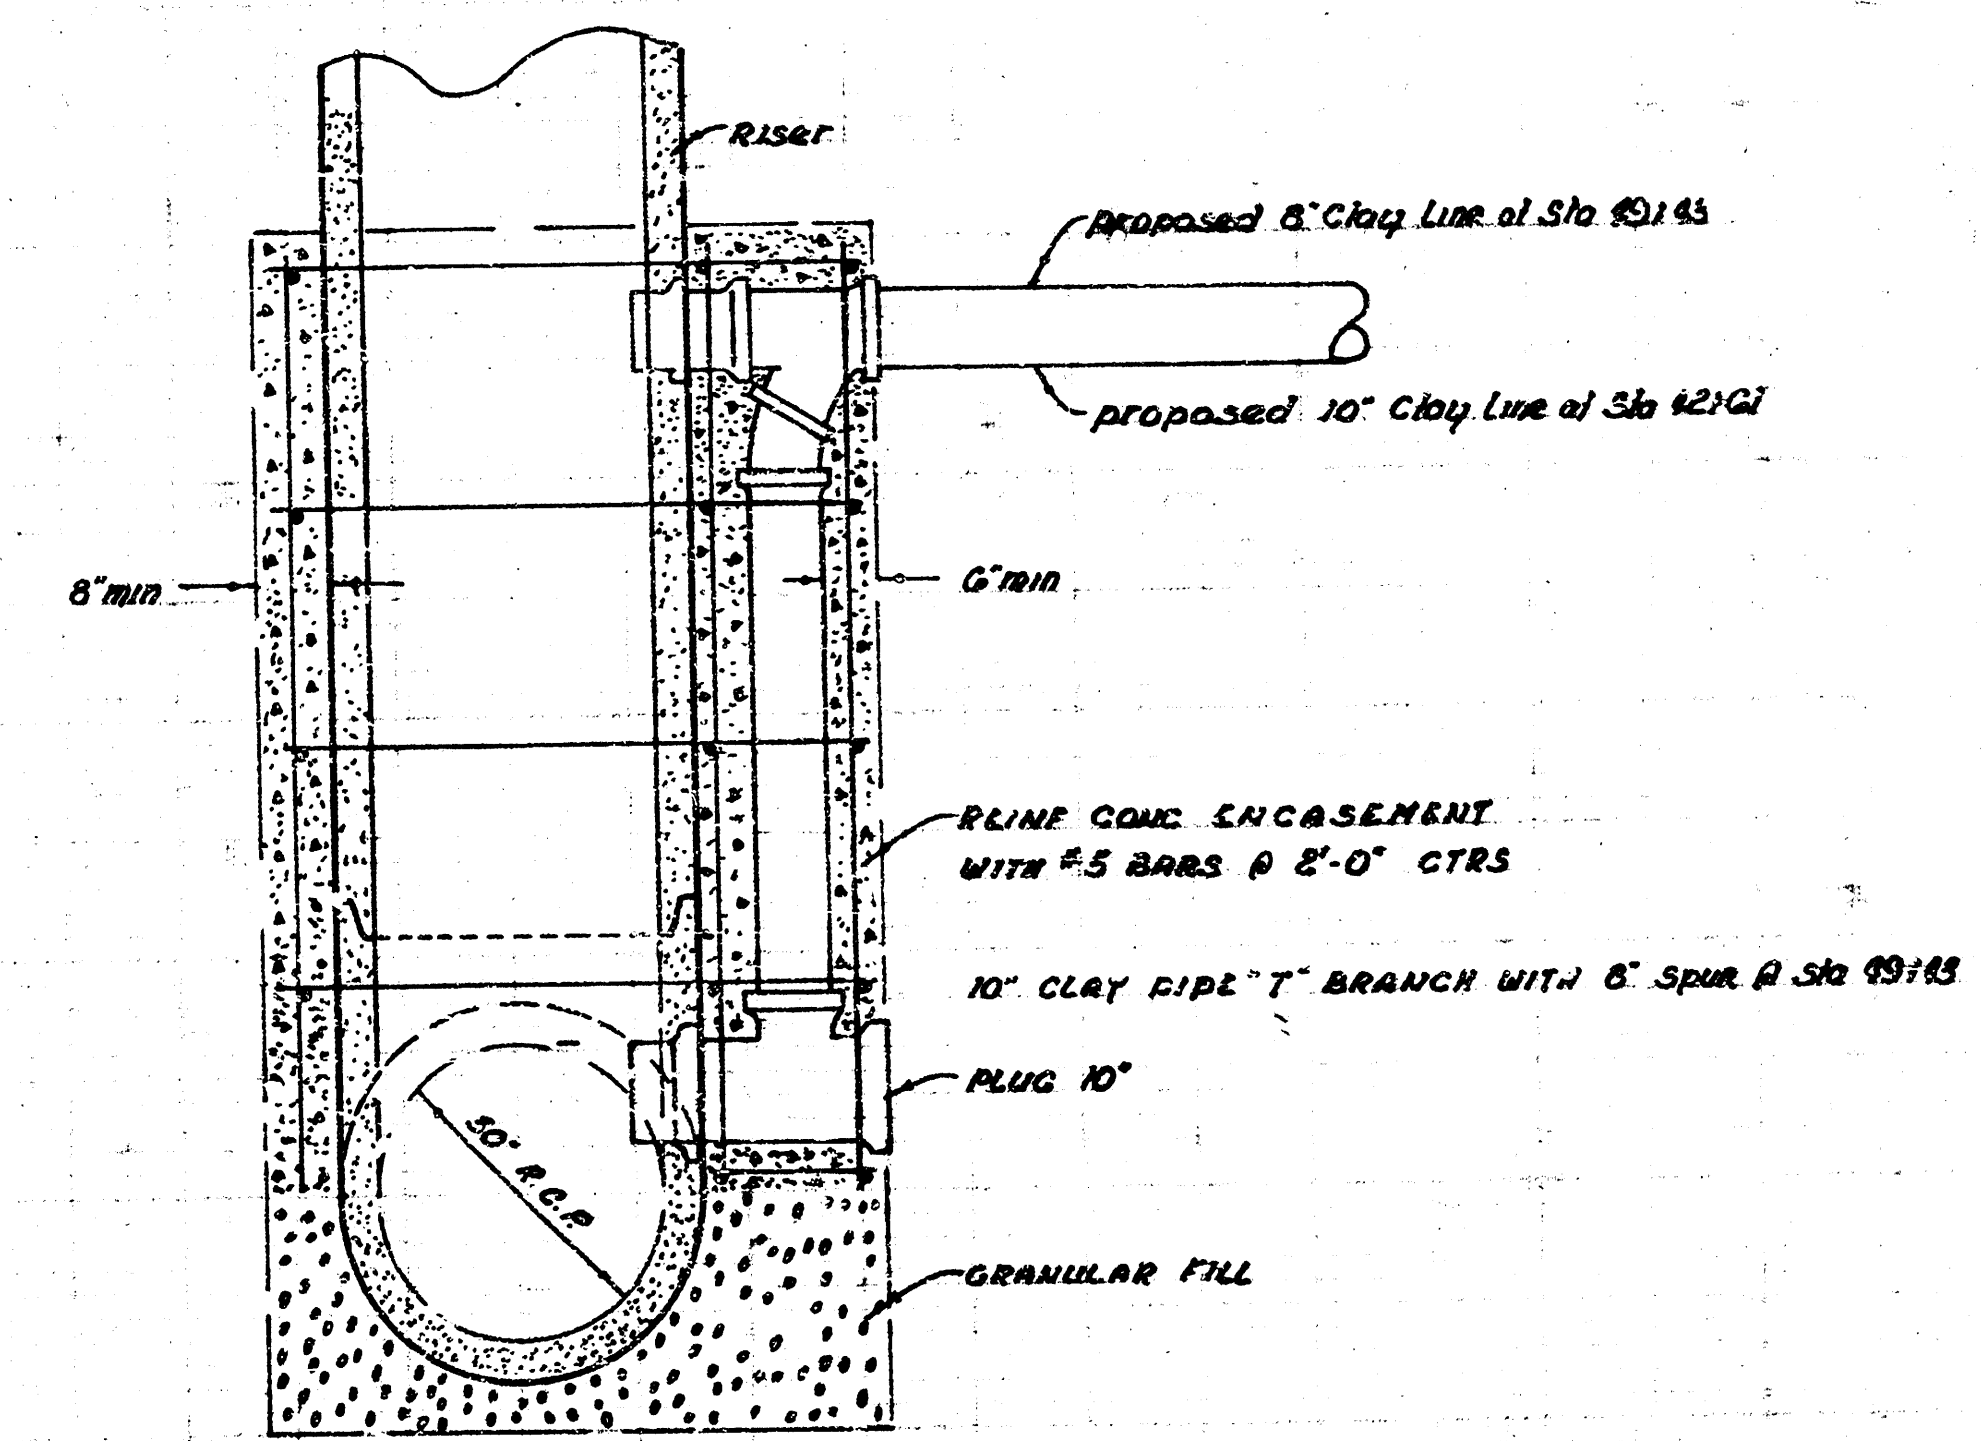


SPECIAL PRECAST CONC DROP MANHOLE
STA 42101 + STA 49143

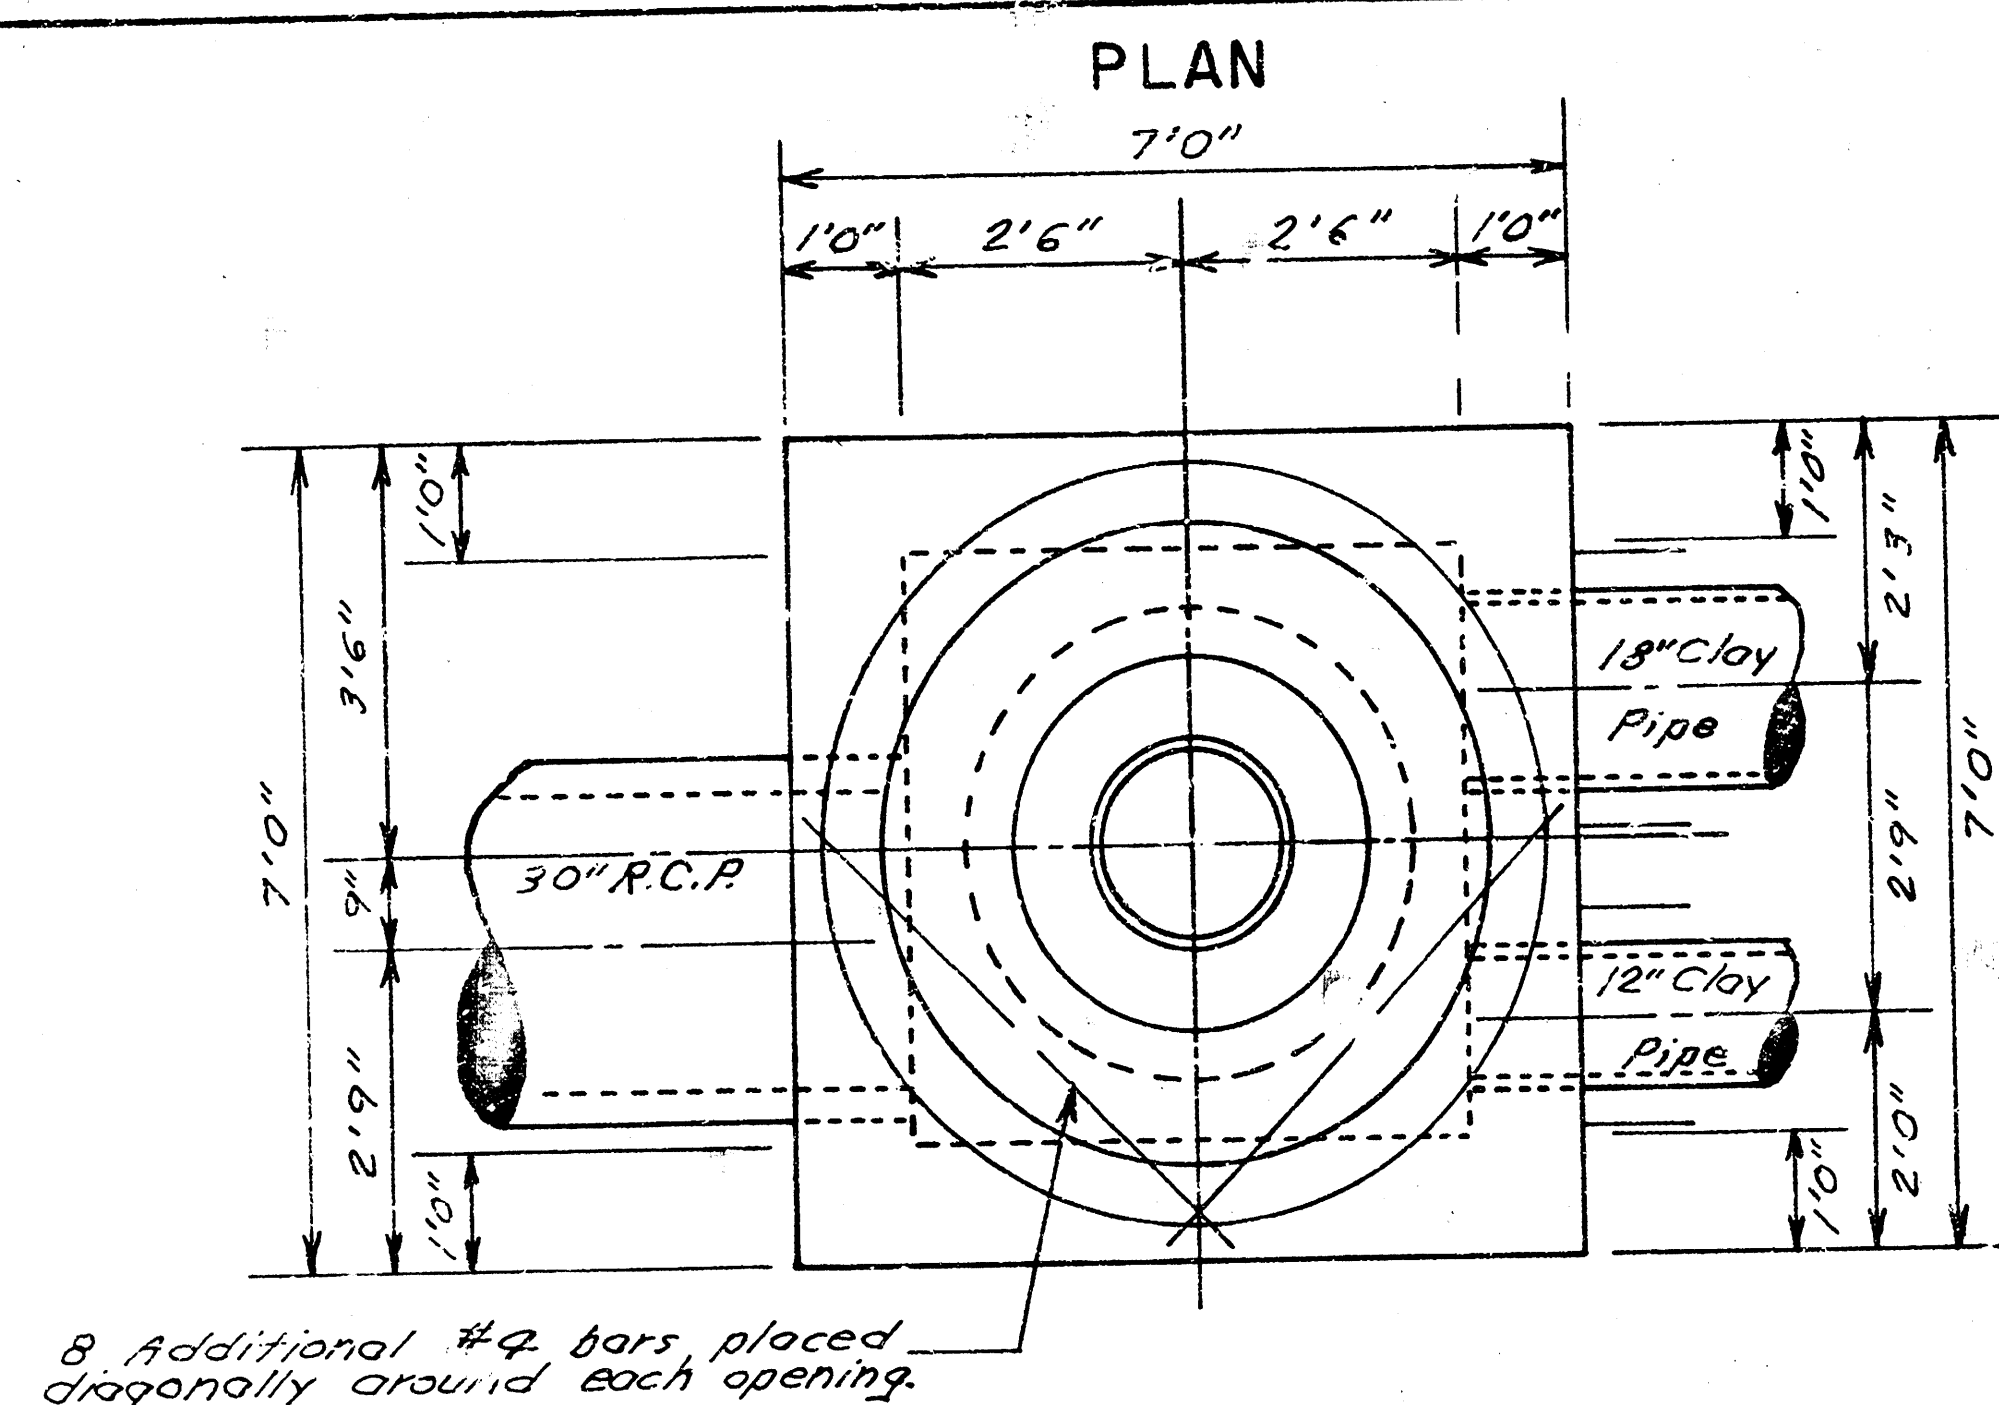


SECTIONAL PLAN

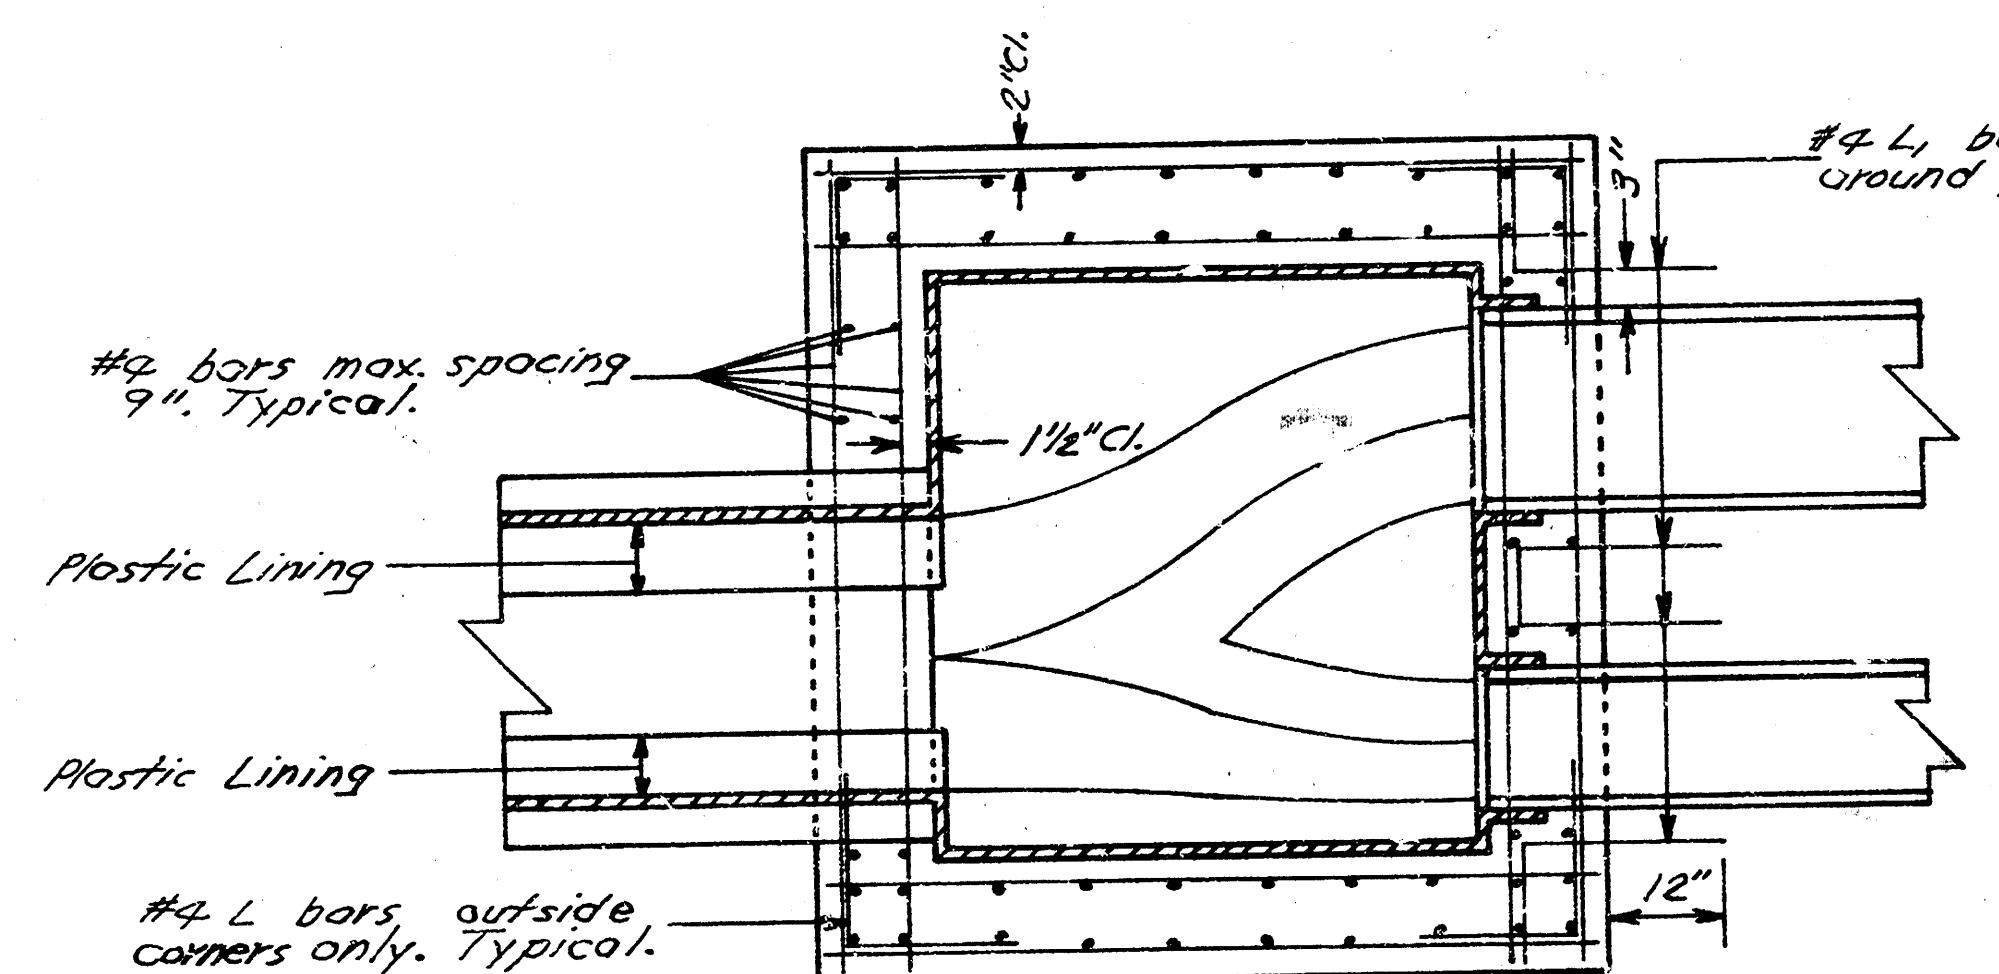


SECTIONAL ELEVATION

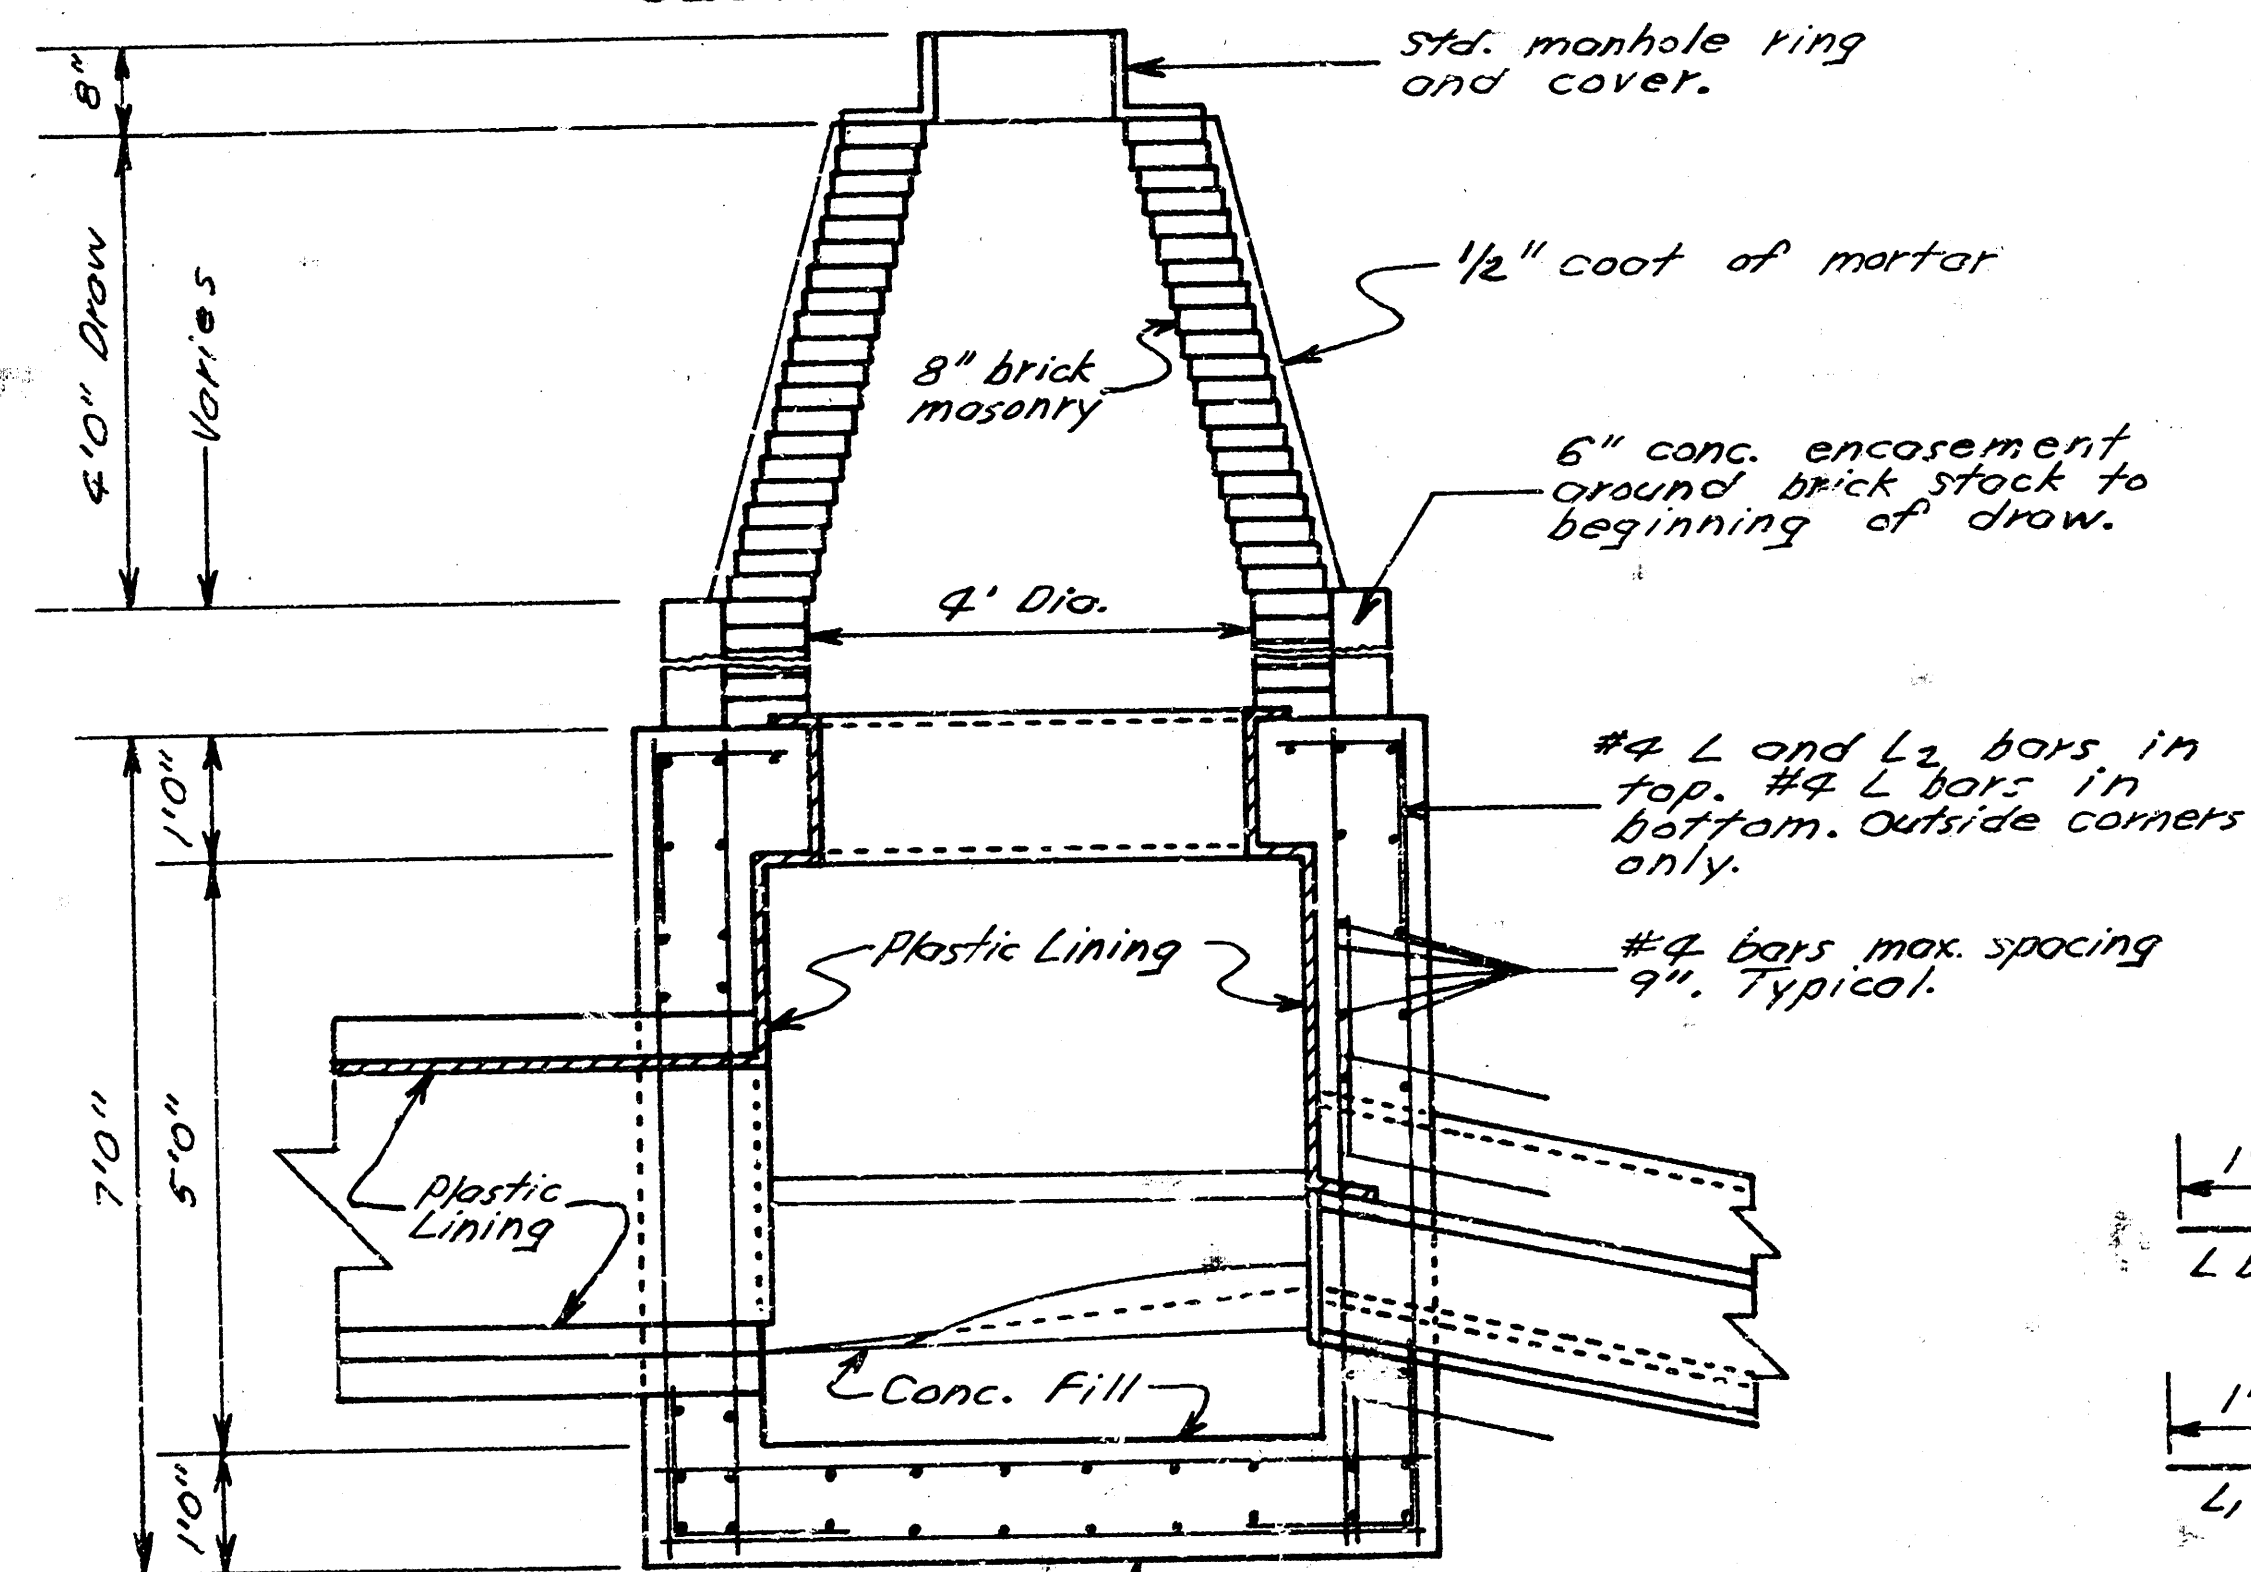


SPECIAL REINF. CONC. MANHOLE
STA. 2+00
PHASE I

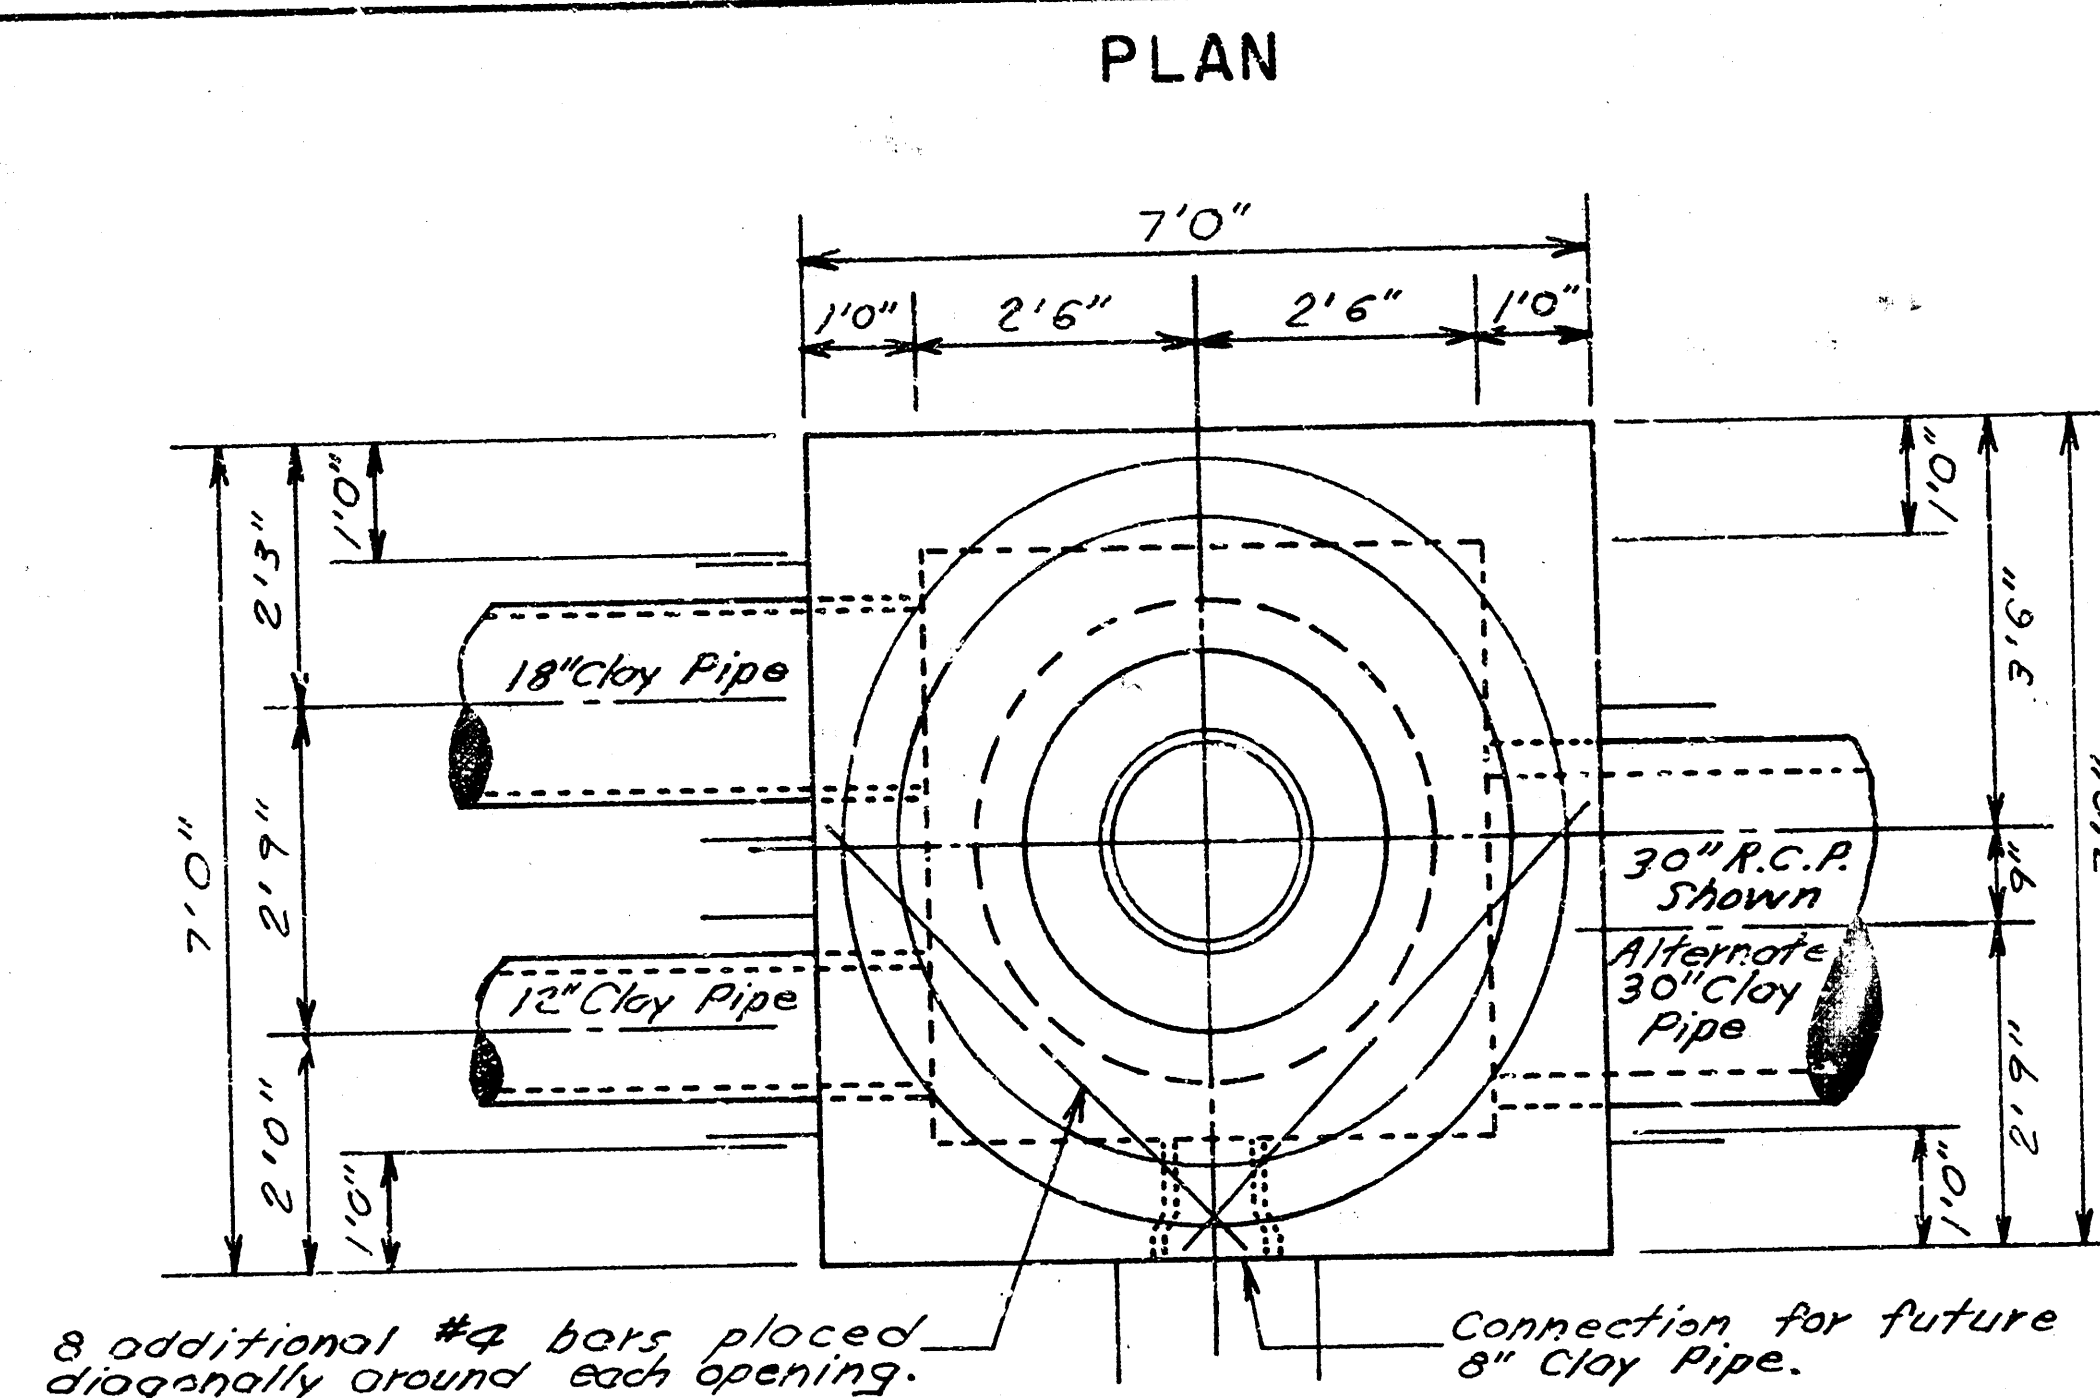



SECTIONAL PLAN

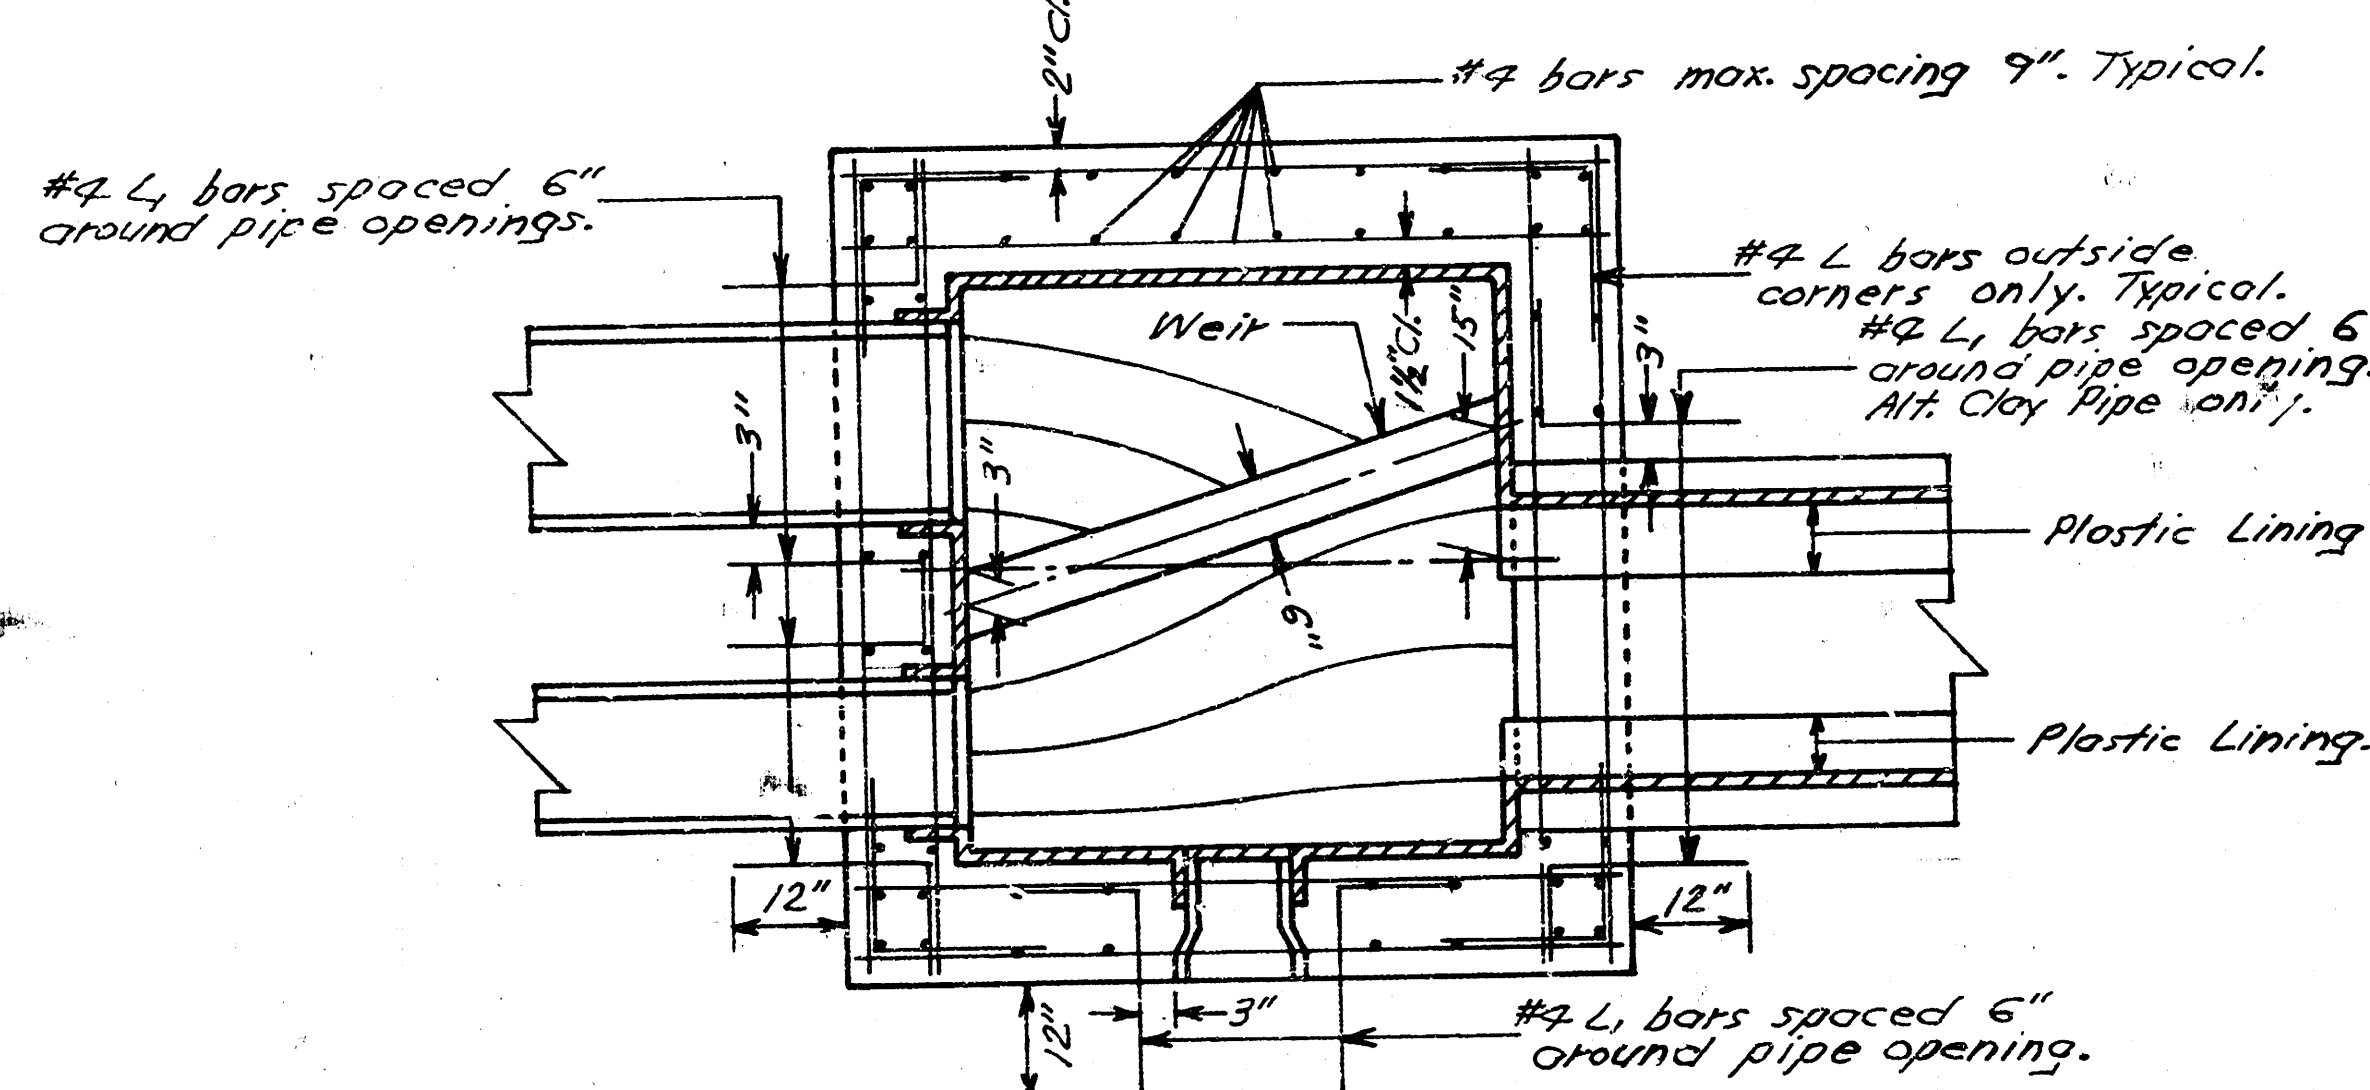


SECTIONAL ELEVATION

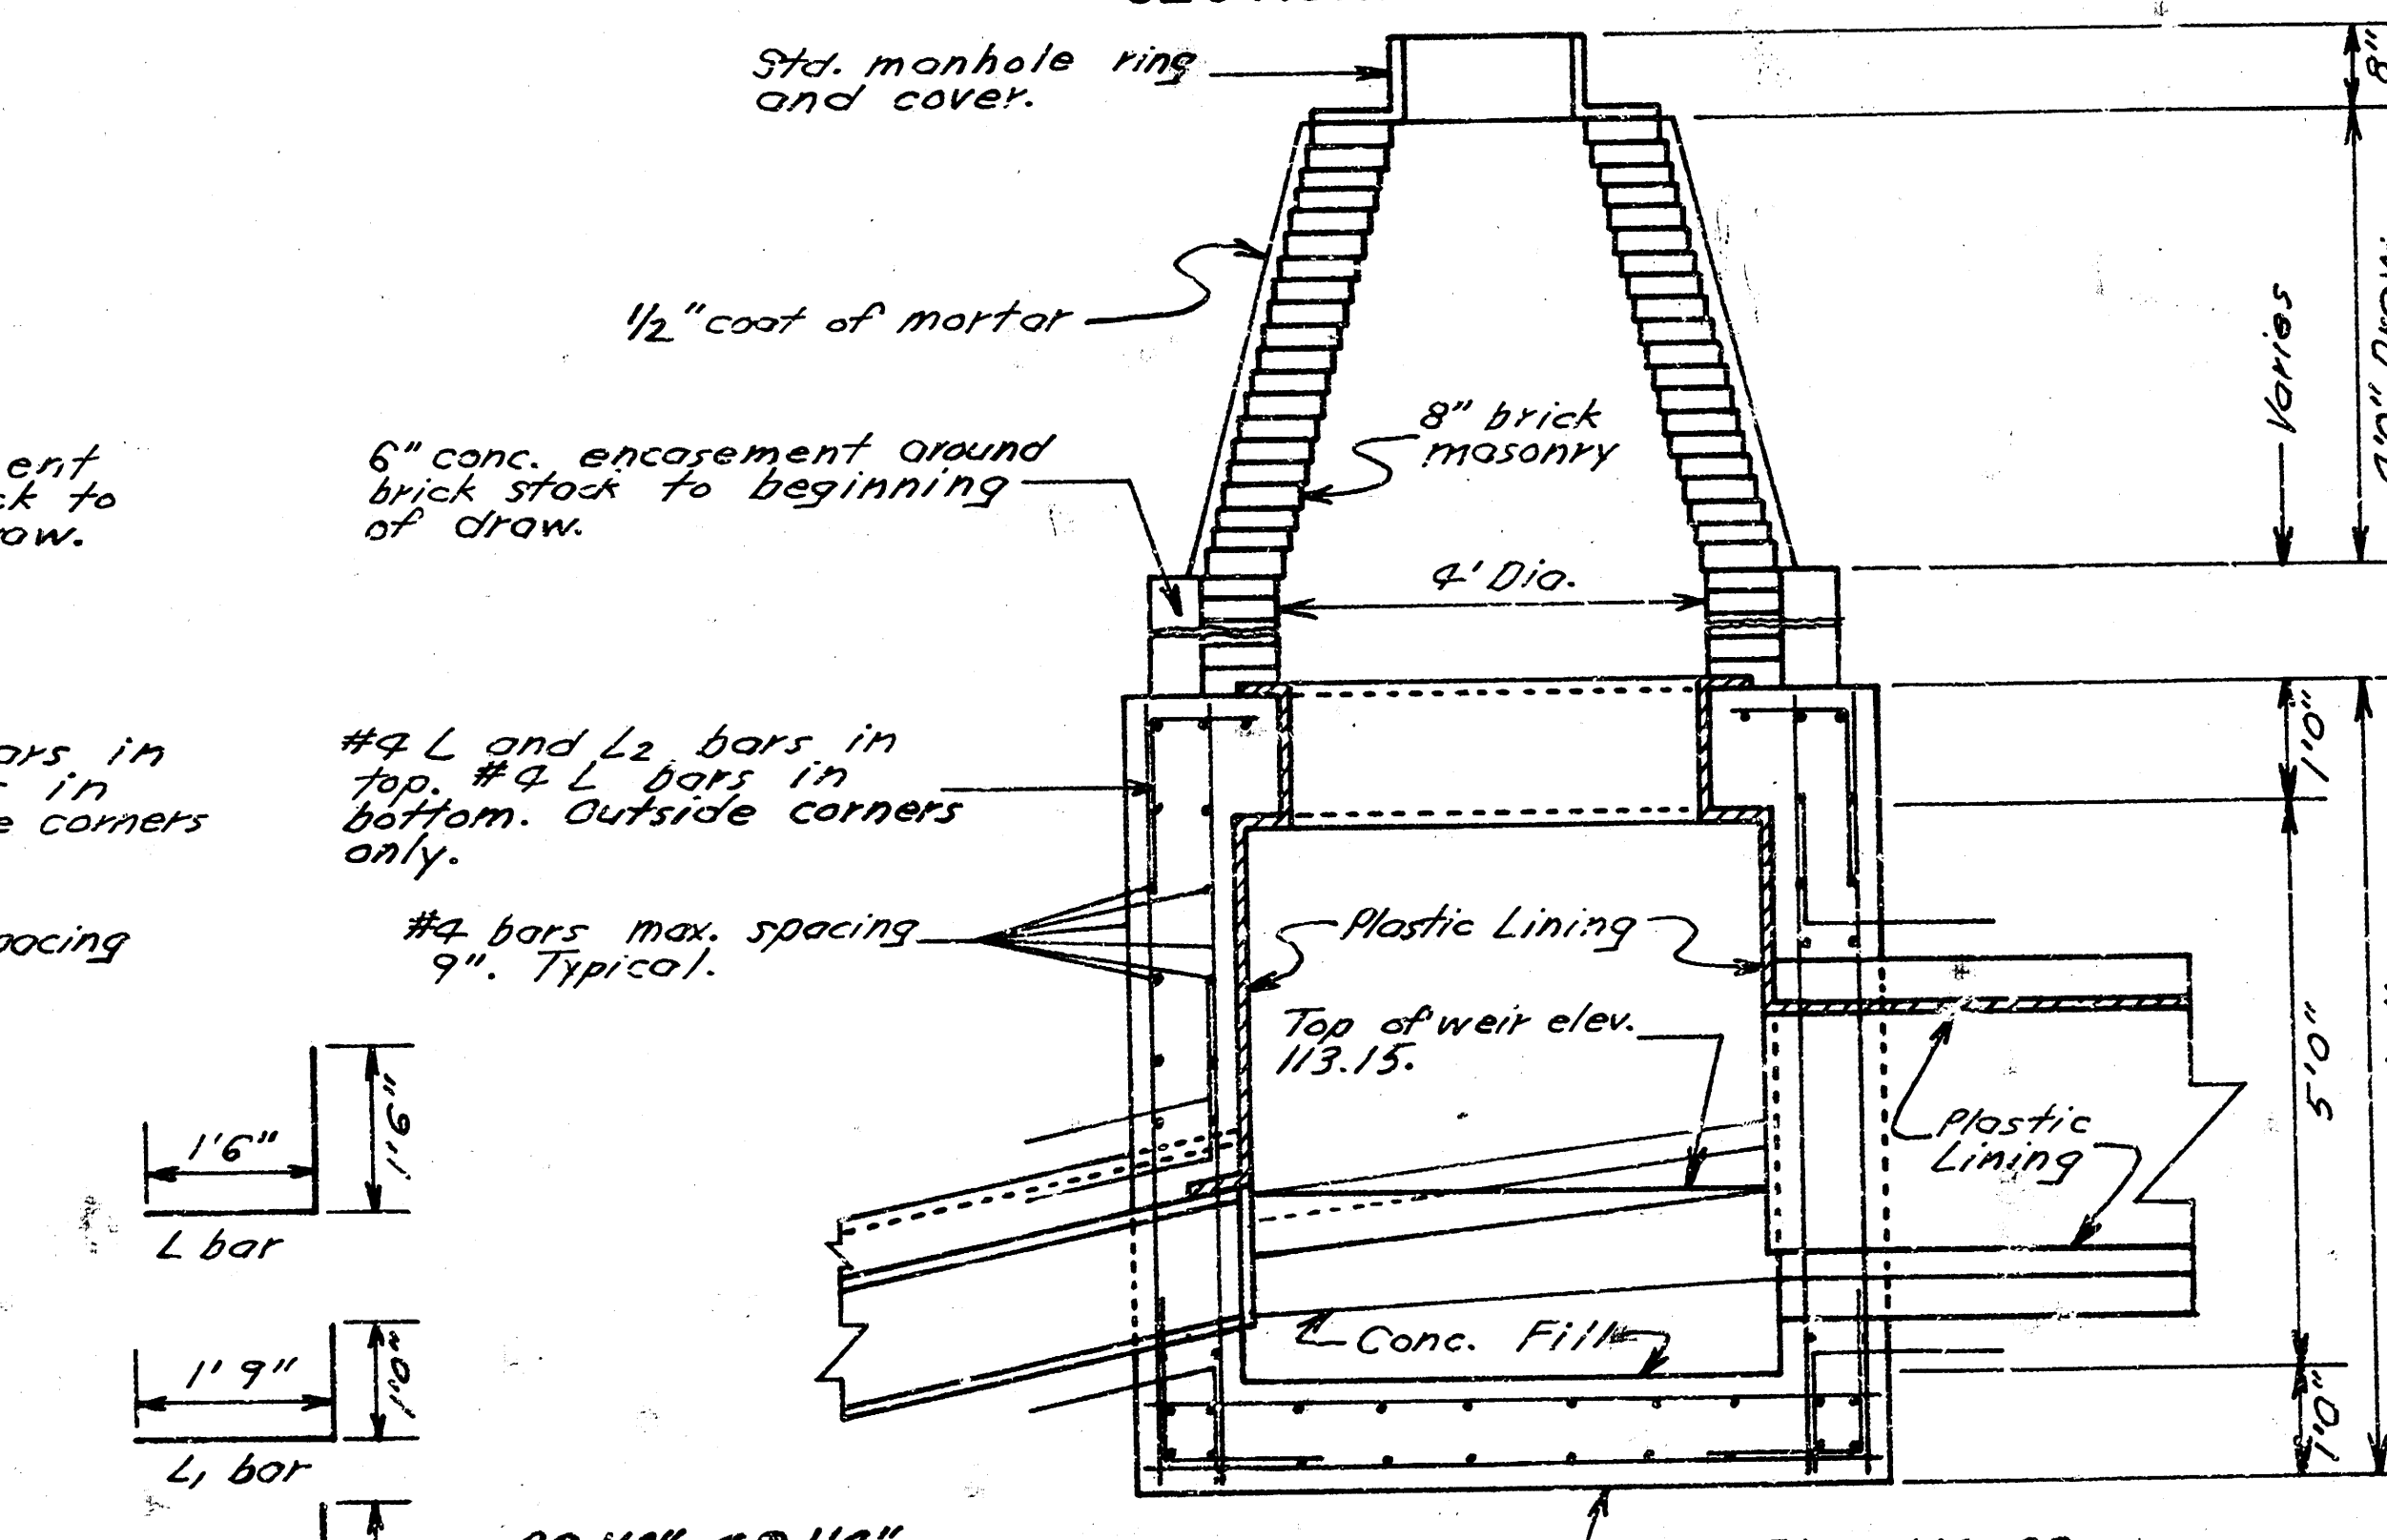


SPECIAL REINF. CONC. MANHOLE
STA. 4+20
PHASE I

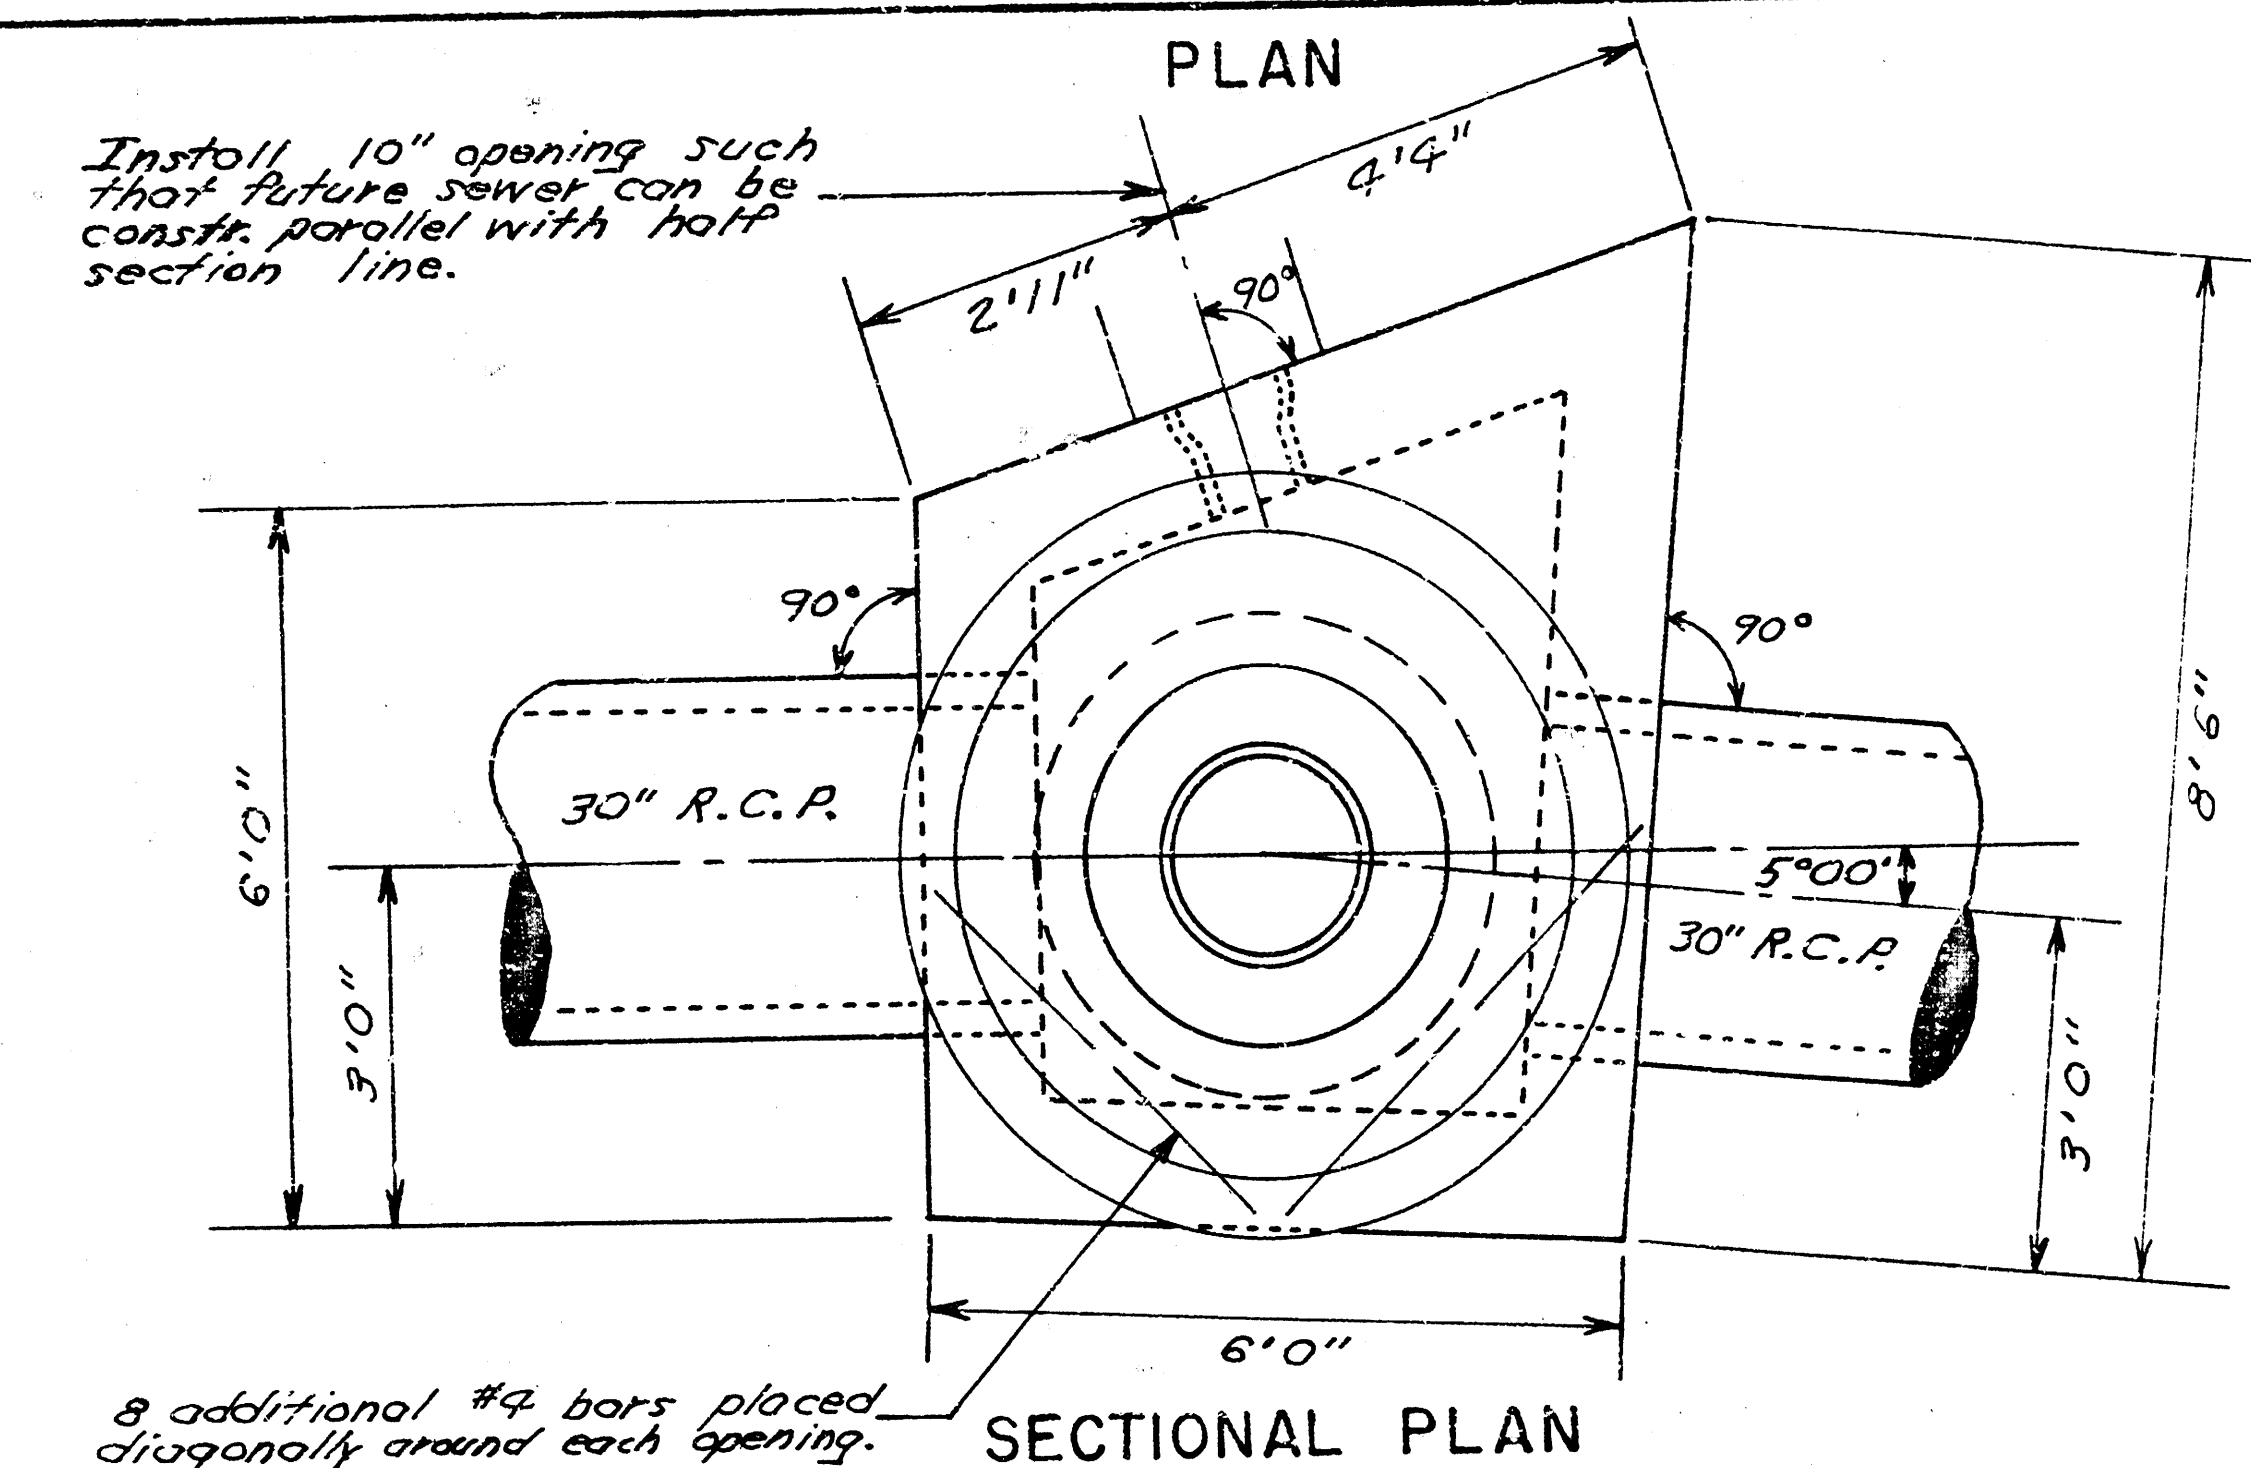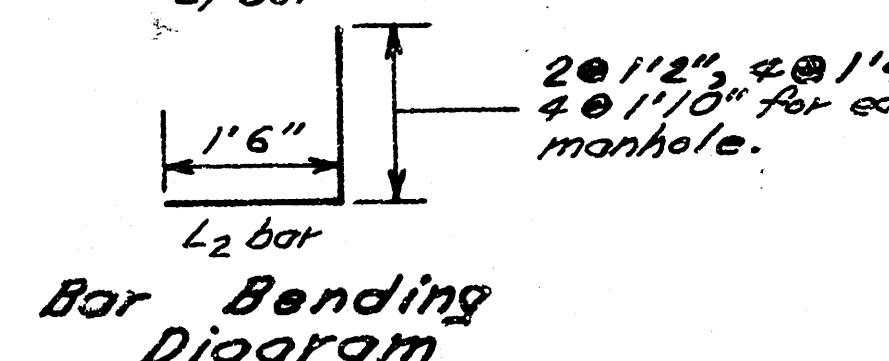

SECTIONAL PLAN

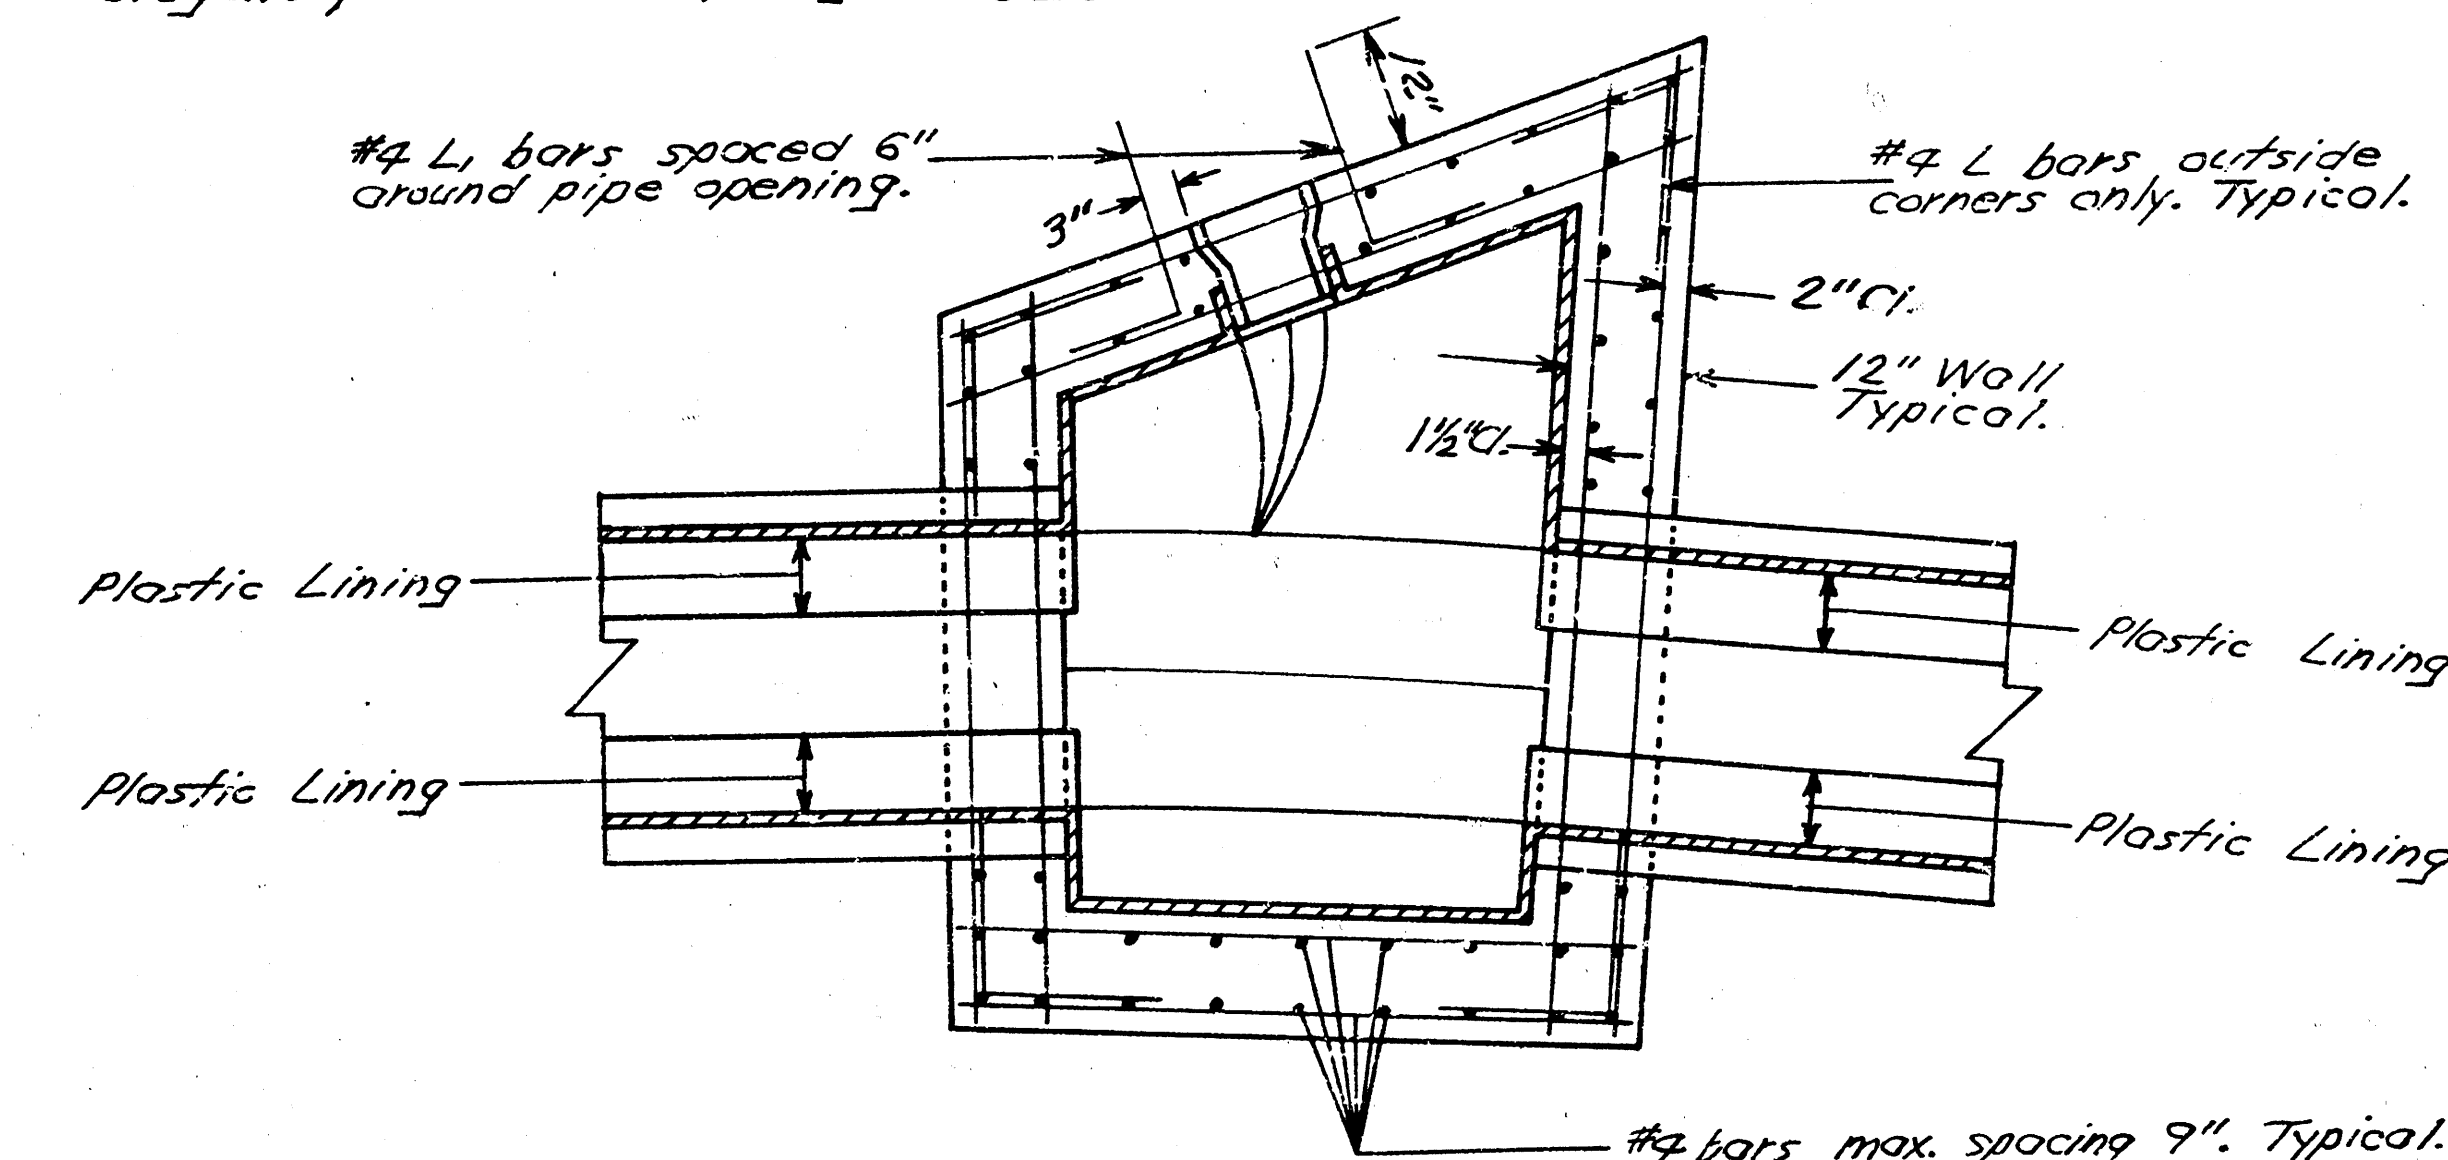


SECTIONAL ELEVATION

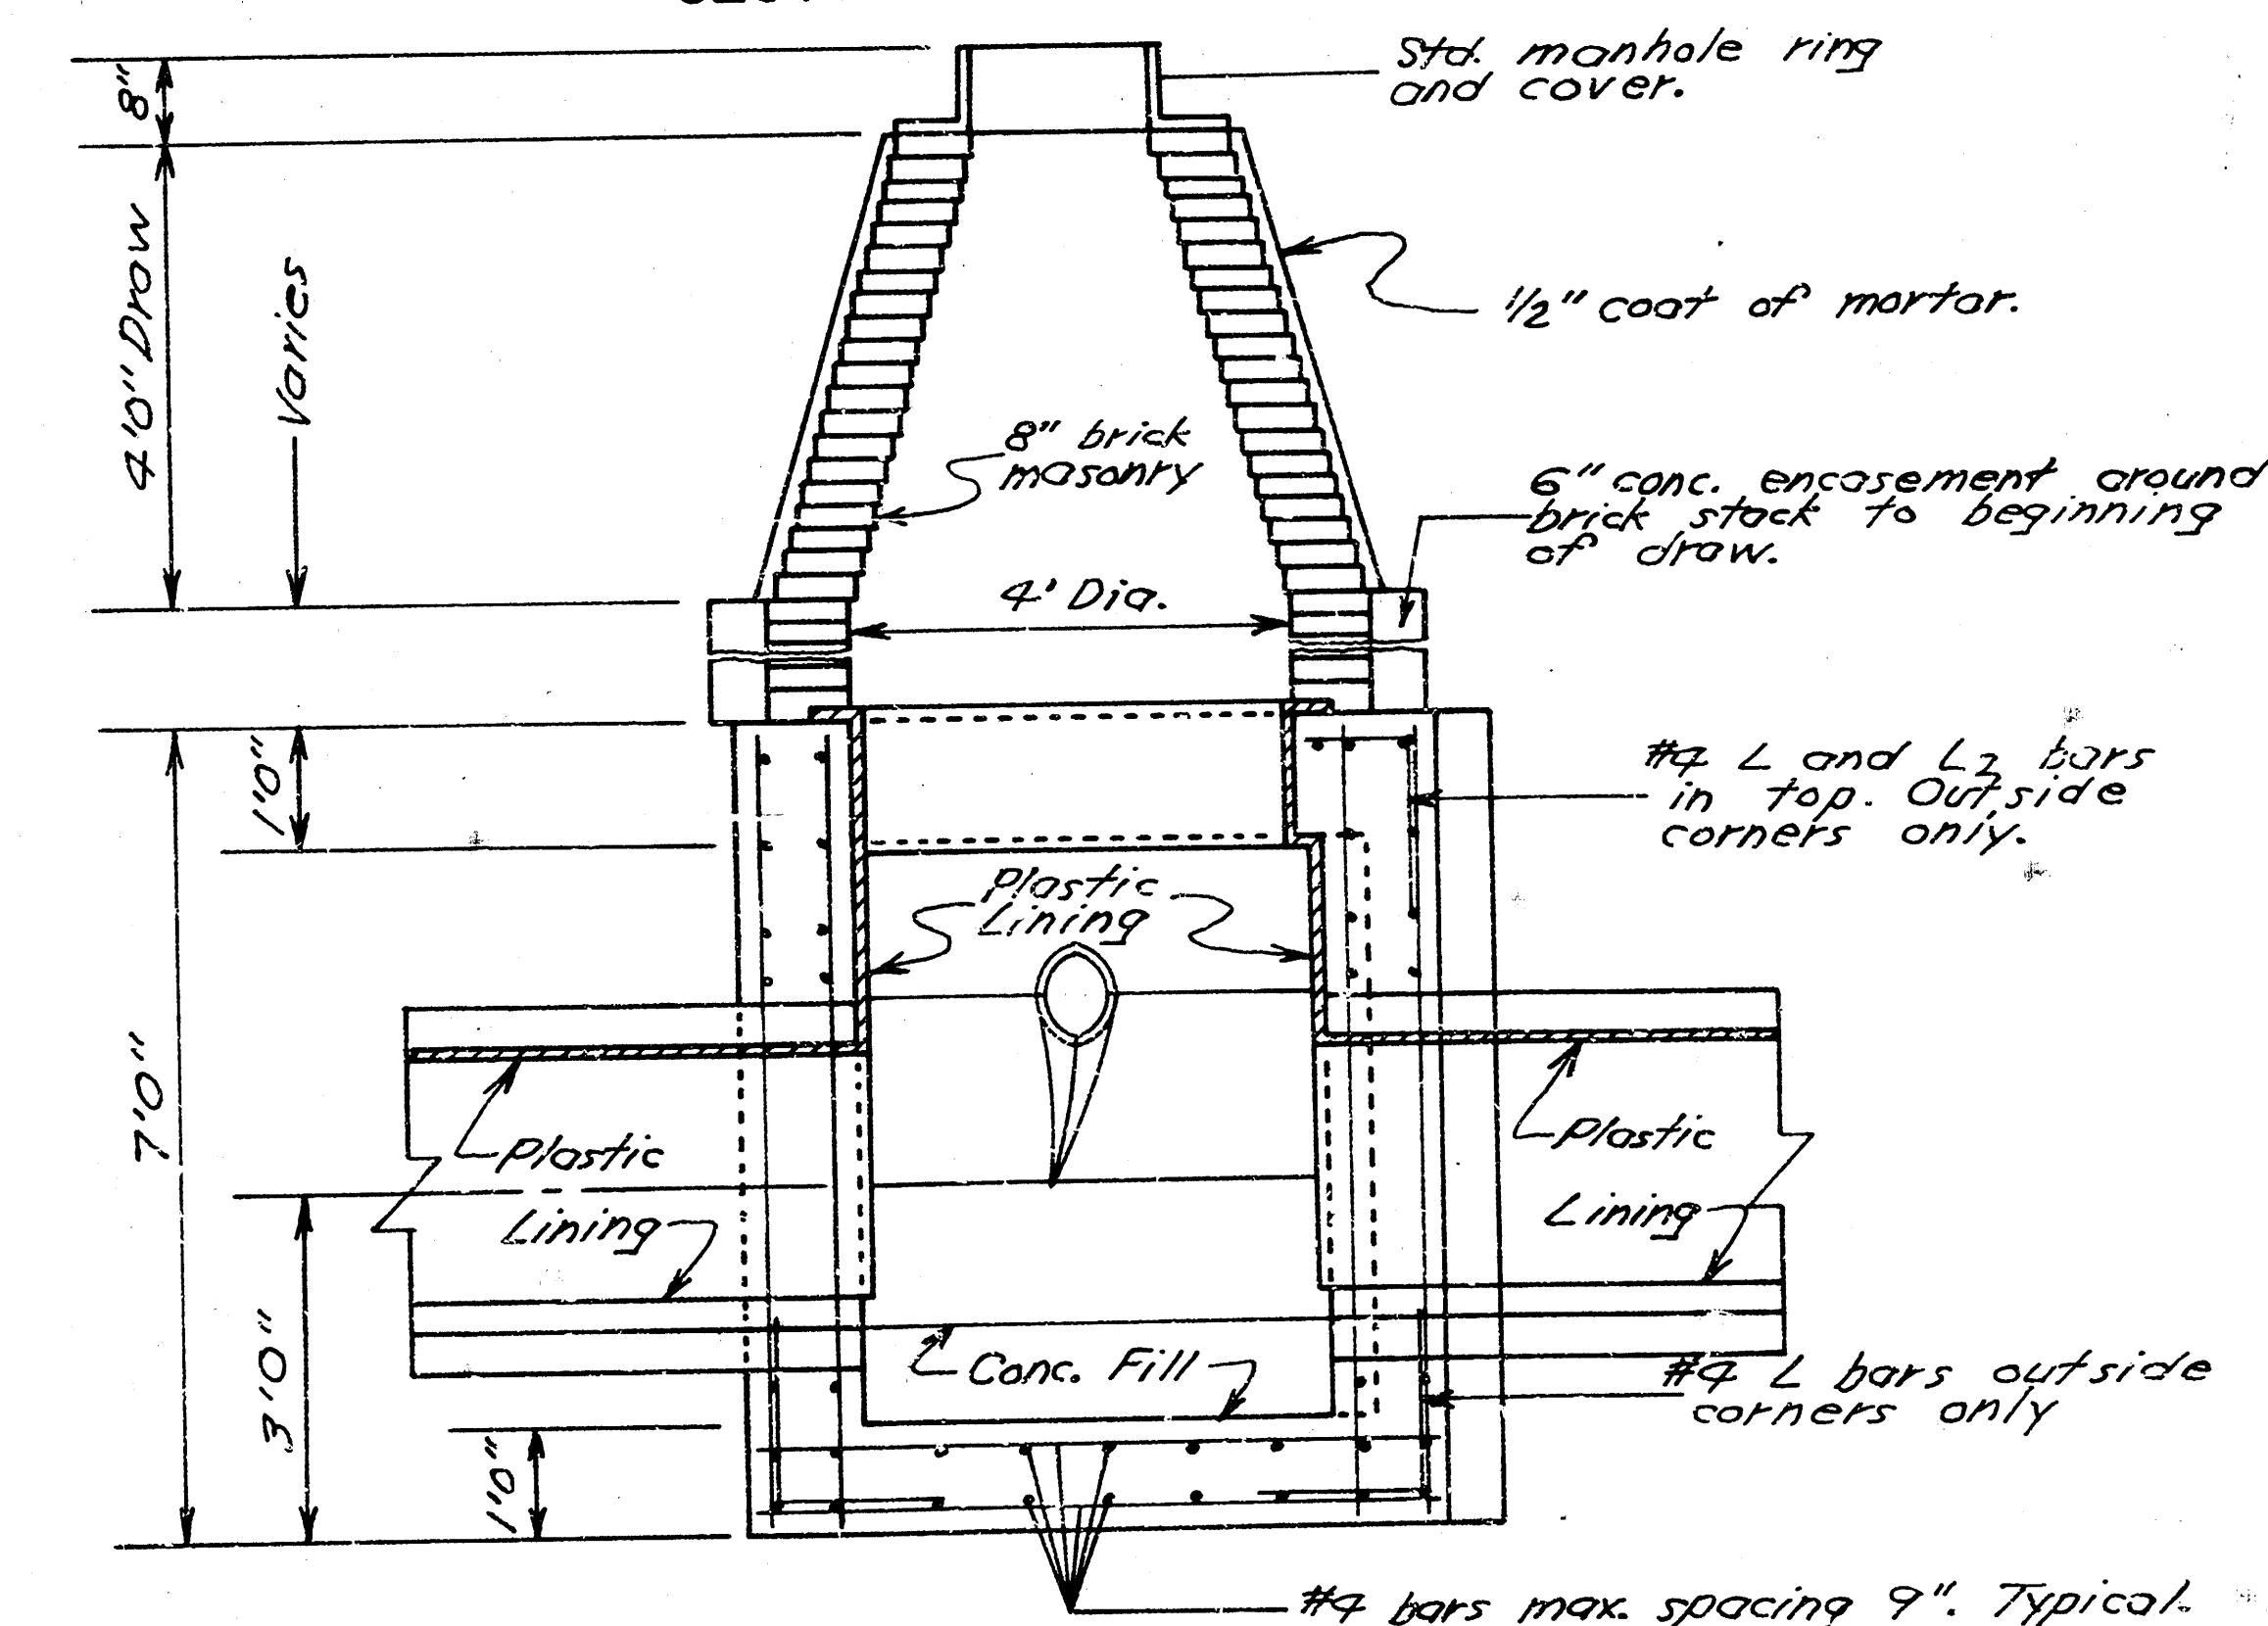


SPECIAL REINF. CONC. MANHOLE
STA. 27+43
PHASE I


Note: Contractor may construct poured concrete manholes as shown, or at his option, the poured concrete manholes may be constructed to a minimum of one foot above water table elev. and conc. encasement omitted around brick stack.

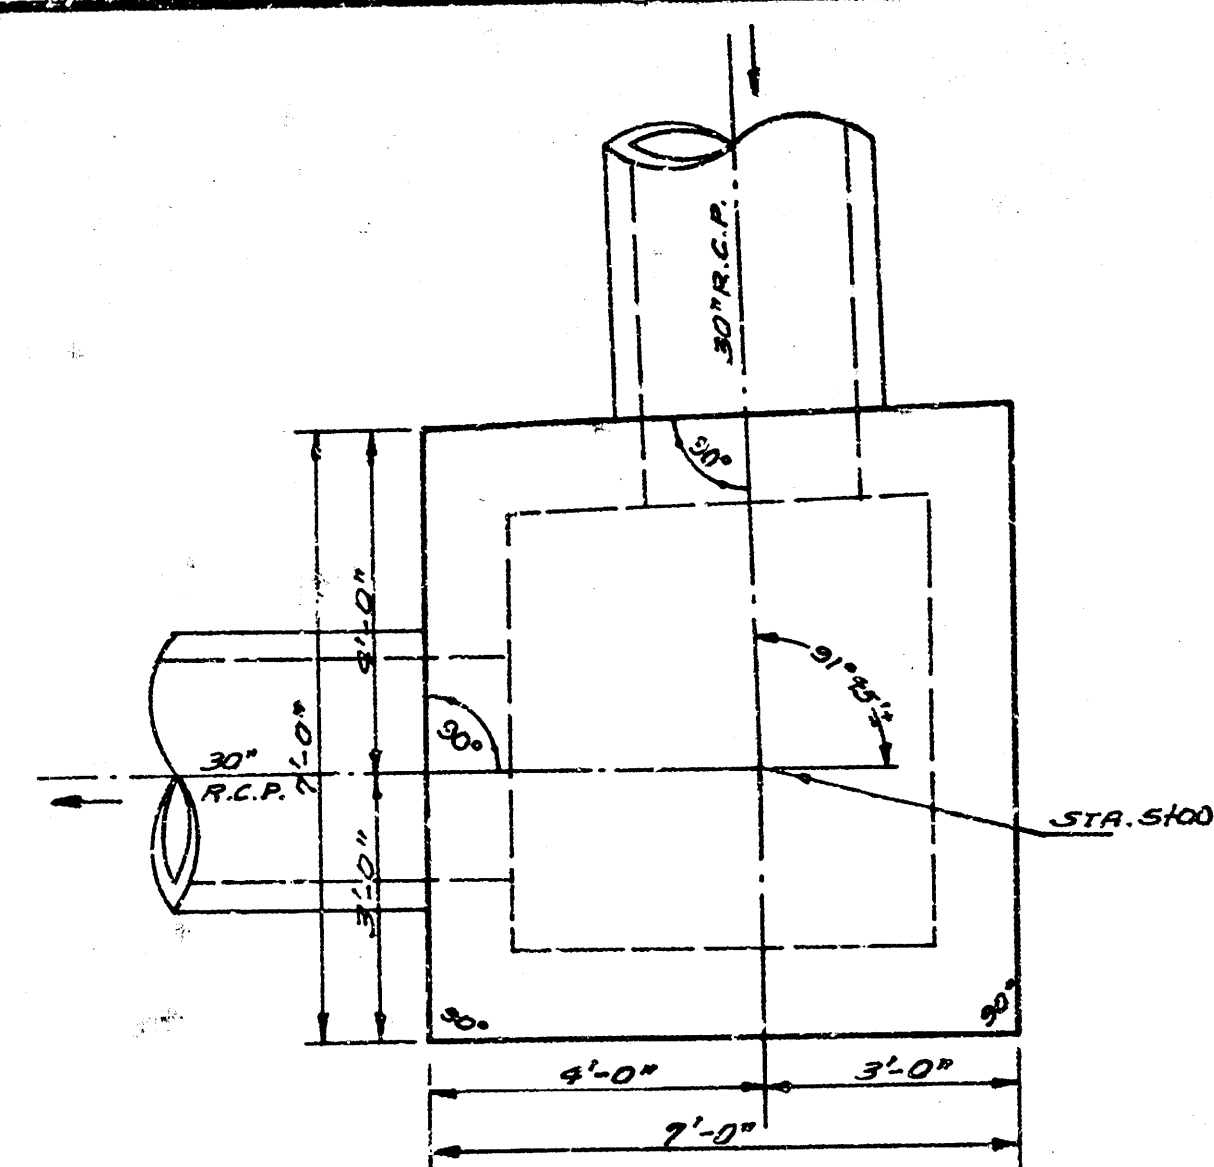


SECTIONAL PLAN OF SPECIAL REINF. CONC. M.H. STA. 5100 (PHASE I).
Scale $\frac{3}{8}'' = 1'-0''$

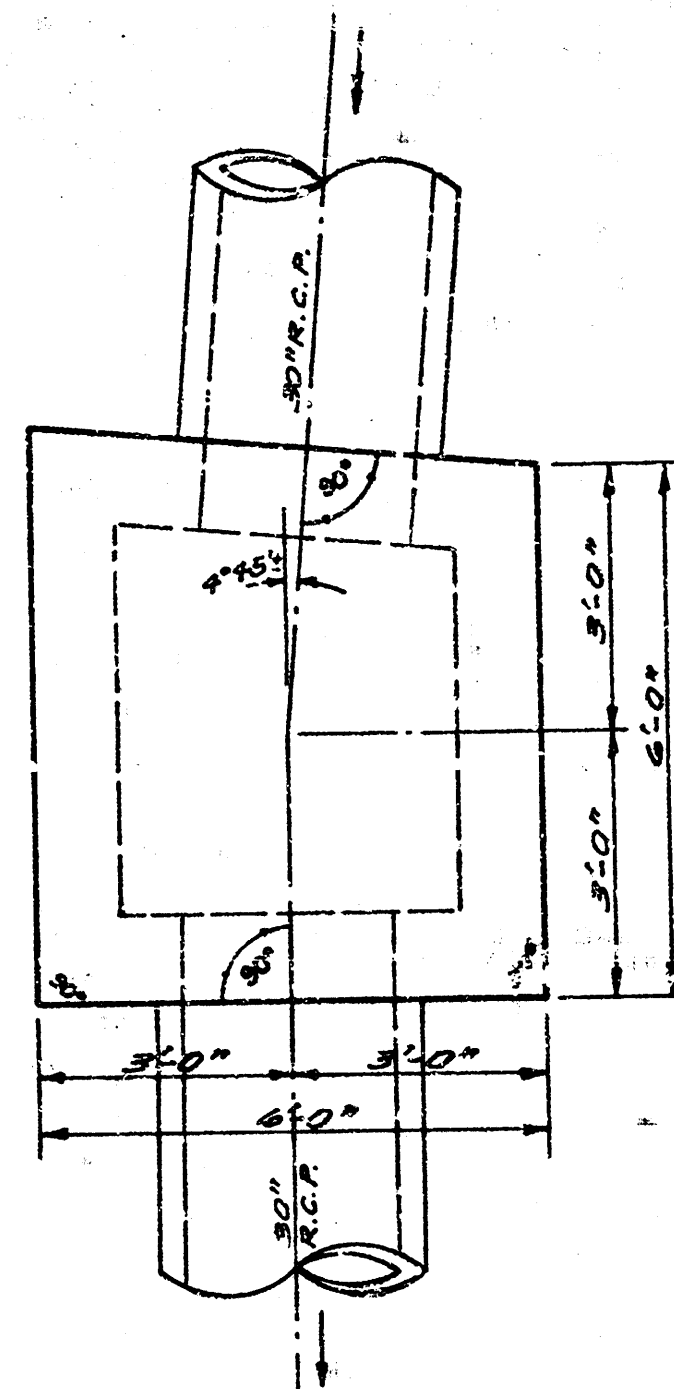


SECTIONAL PLAN OF SPECIAL REINF. CONC. M.H. STA. 22154 (PHASE I).
Scale $\frac{3}{8}'' = 1'-0''$

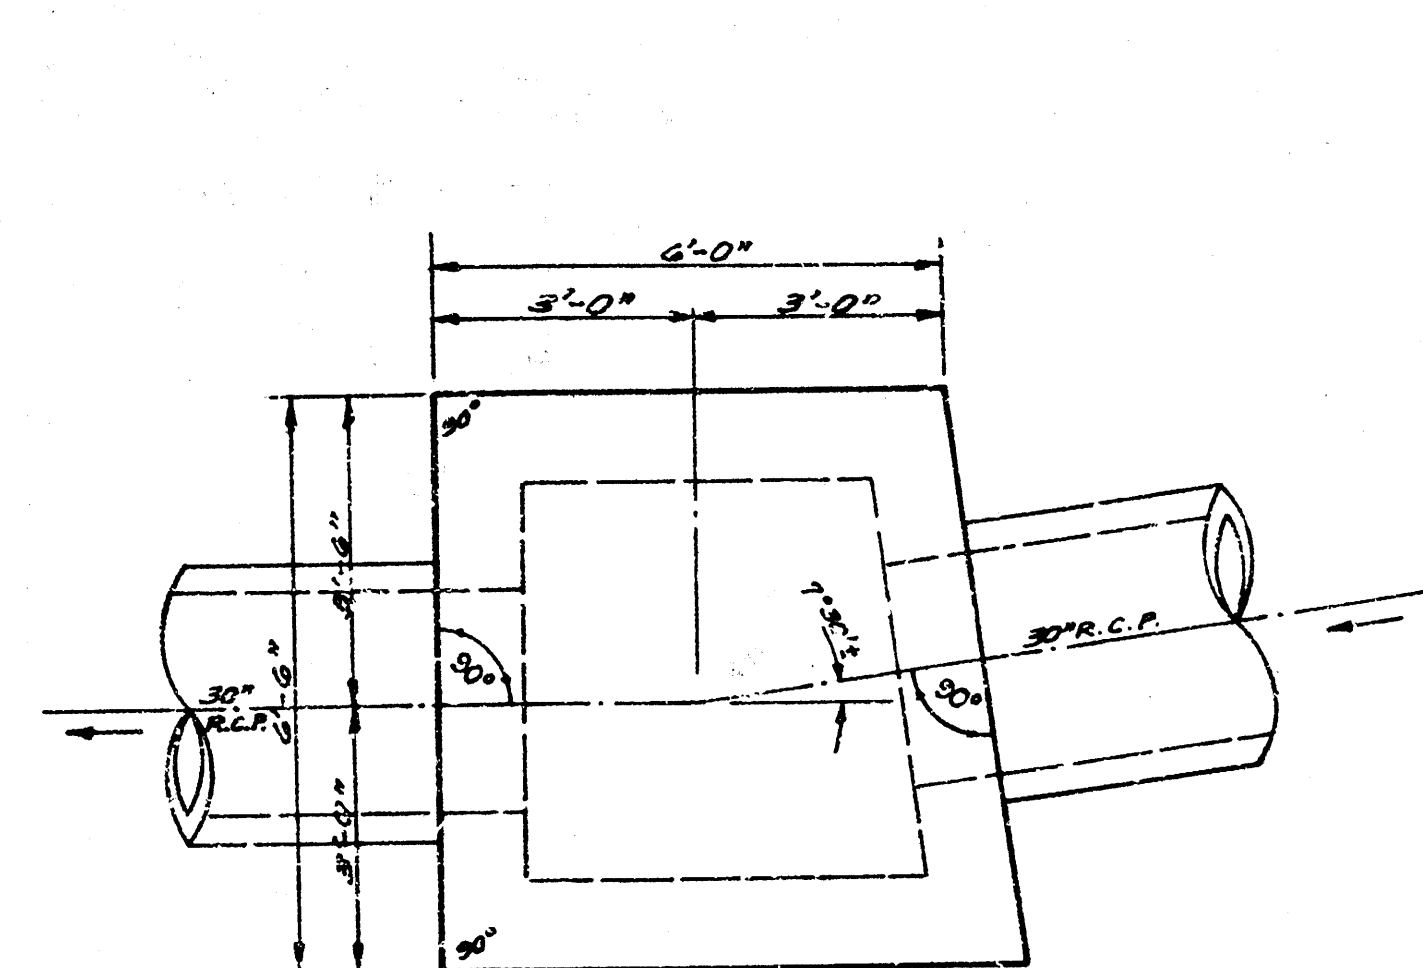


SECTIONAL PLAN OF SPECIAL REINF. CONC. M.H. STA. 9170 (PHASE II).
Scale $\frac{3}{8}'' = 1'-0''$

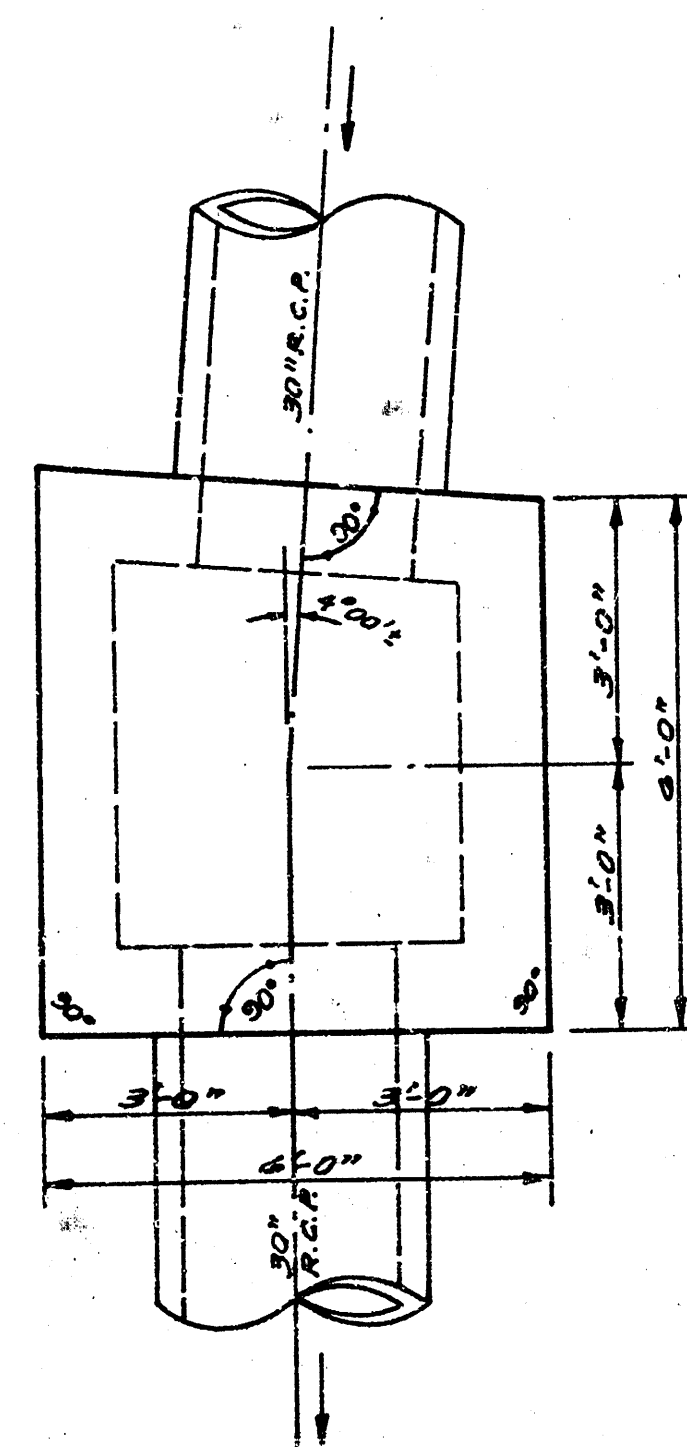


SECTIONAL PLAN OF SPECIAL REINF. CONC. M.H. STA. 5194 (PHASE I) & STA. 10131 (PHASE II).
Scale $\frac{3}{8}'' = 1'-0''$

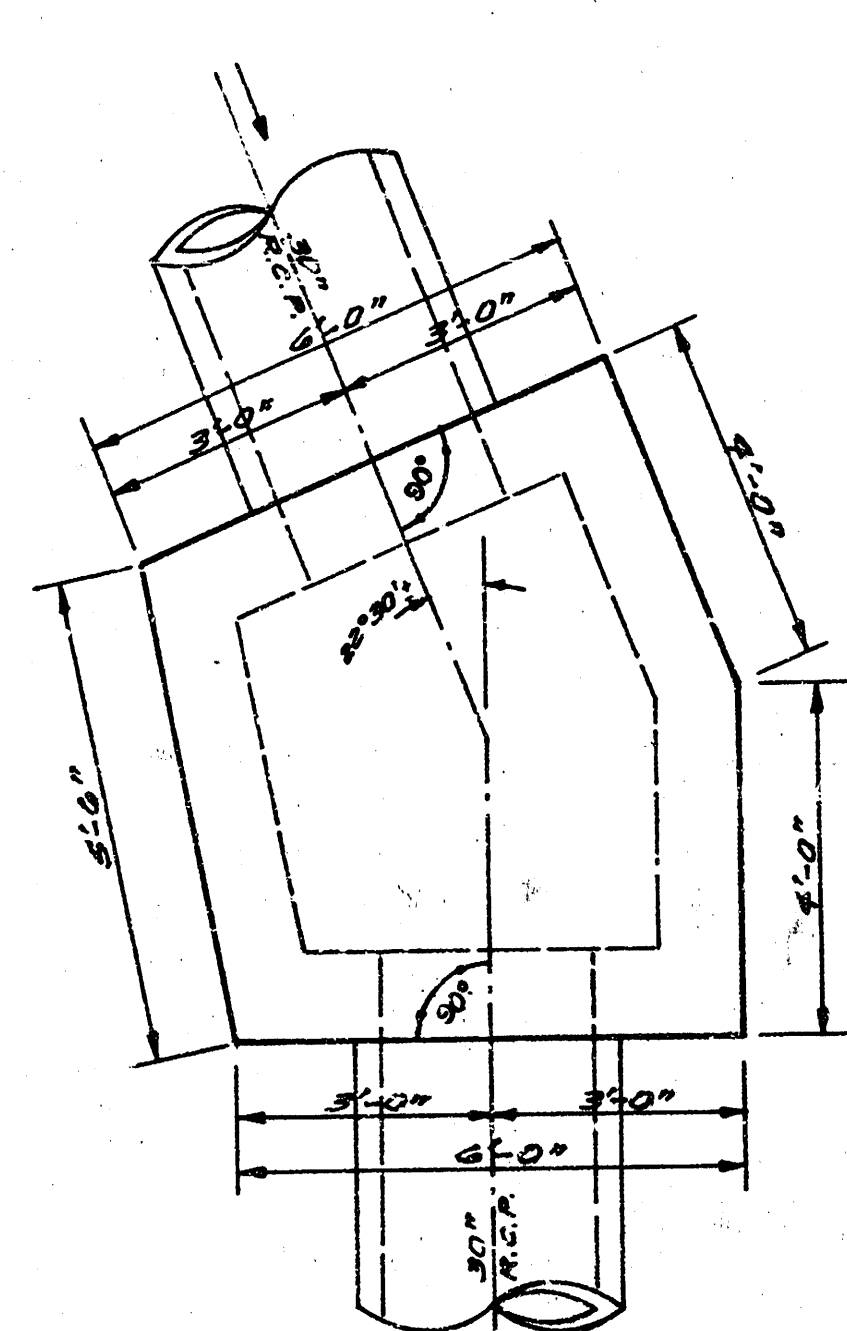

SECTIONAL PLAN OF SPECIAL REINF. CONC. M.H. STA. 32170 (PHASE I).
Scale $\frac{3}{8}'' = 1'-0''$

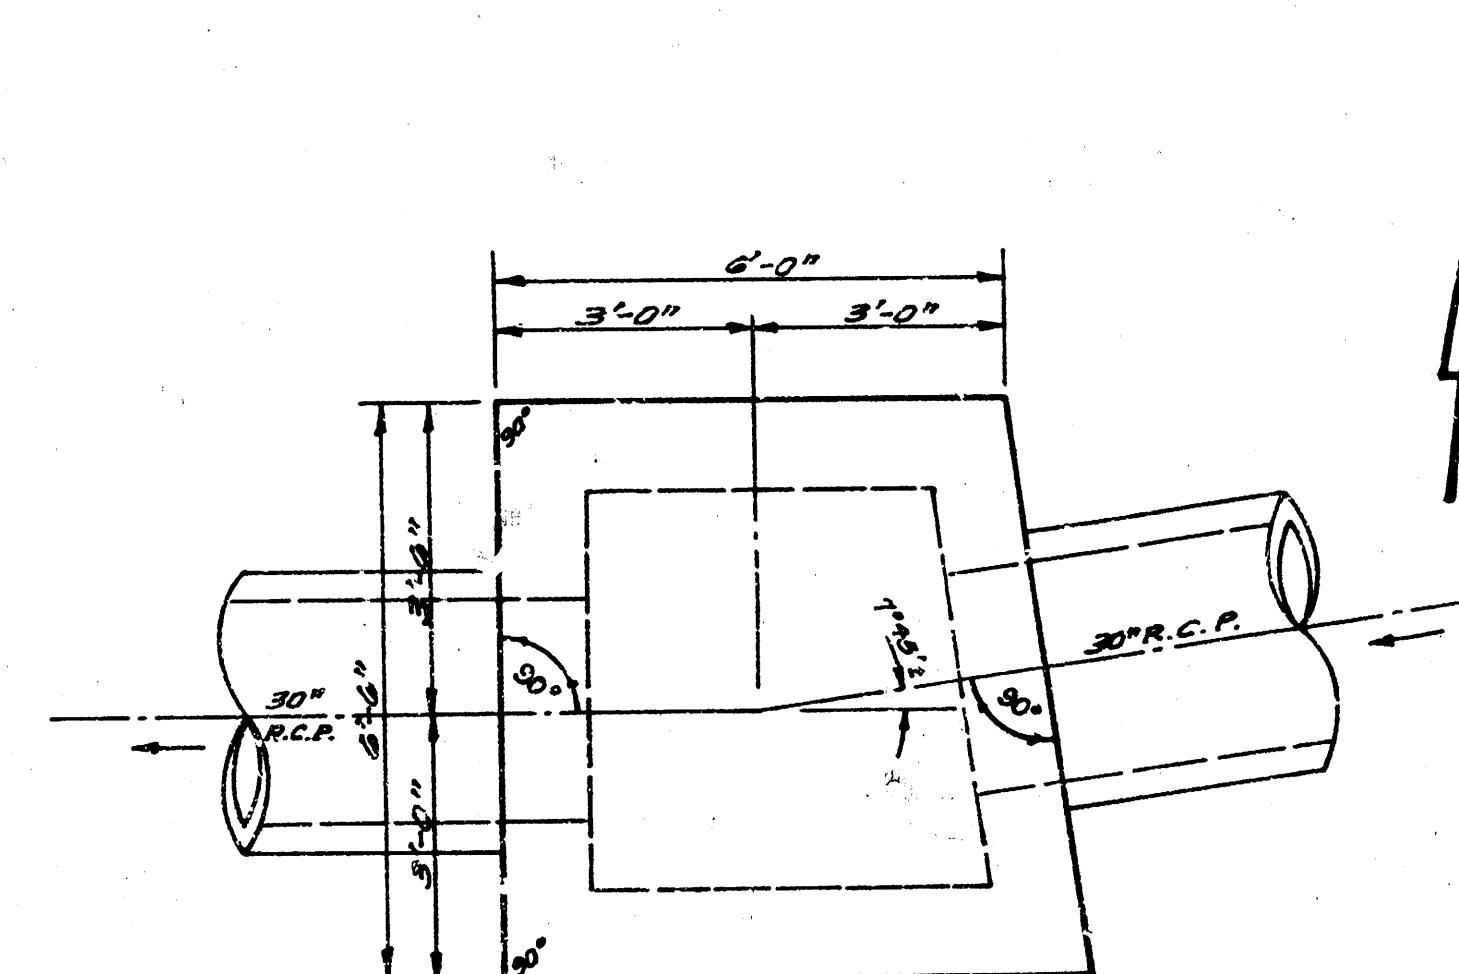


SECTIONAL PLAN OF SPECIAL REINF. CONC. M.H. STA. 11179 (PHASE II).
Scale $\frac{3}{8}'' = 1'-0''$

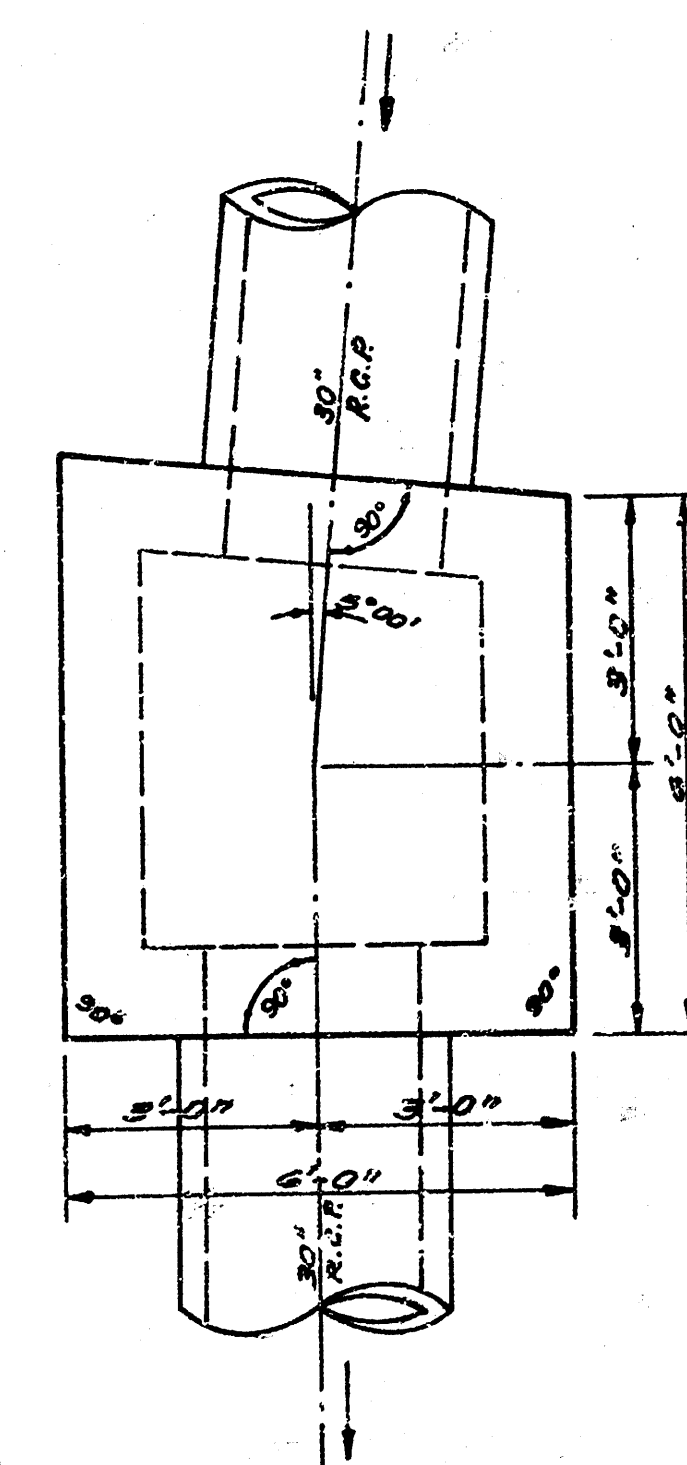


SECTIONAL PLAN OF SPECIAL REINF. CONC. M.H. STA. 11481 & STA. 17405 (PHASE II).
Scale $\frac{3}{8}'' = 1'-0''$

NOTE: SEE SHEET 19, STA. 27143 FOR REINF. CONC. MANHOLE DETAILS OF TYPICAL STEEL PATTERNS, WALL THICKNESS AND DIMENSIONS, BRICK STACK, ETC. FOR MANHOLES ON THIS SHEET.





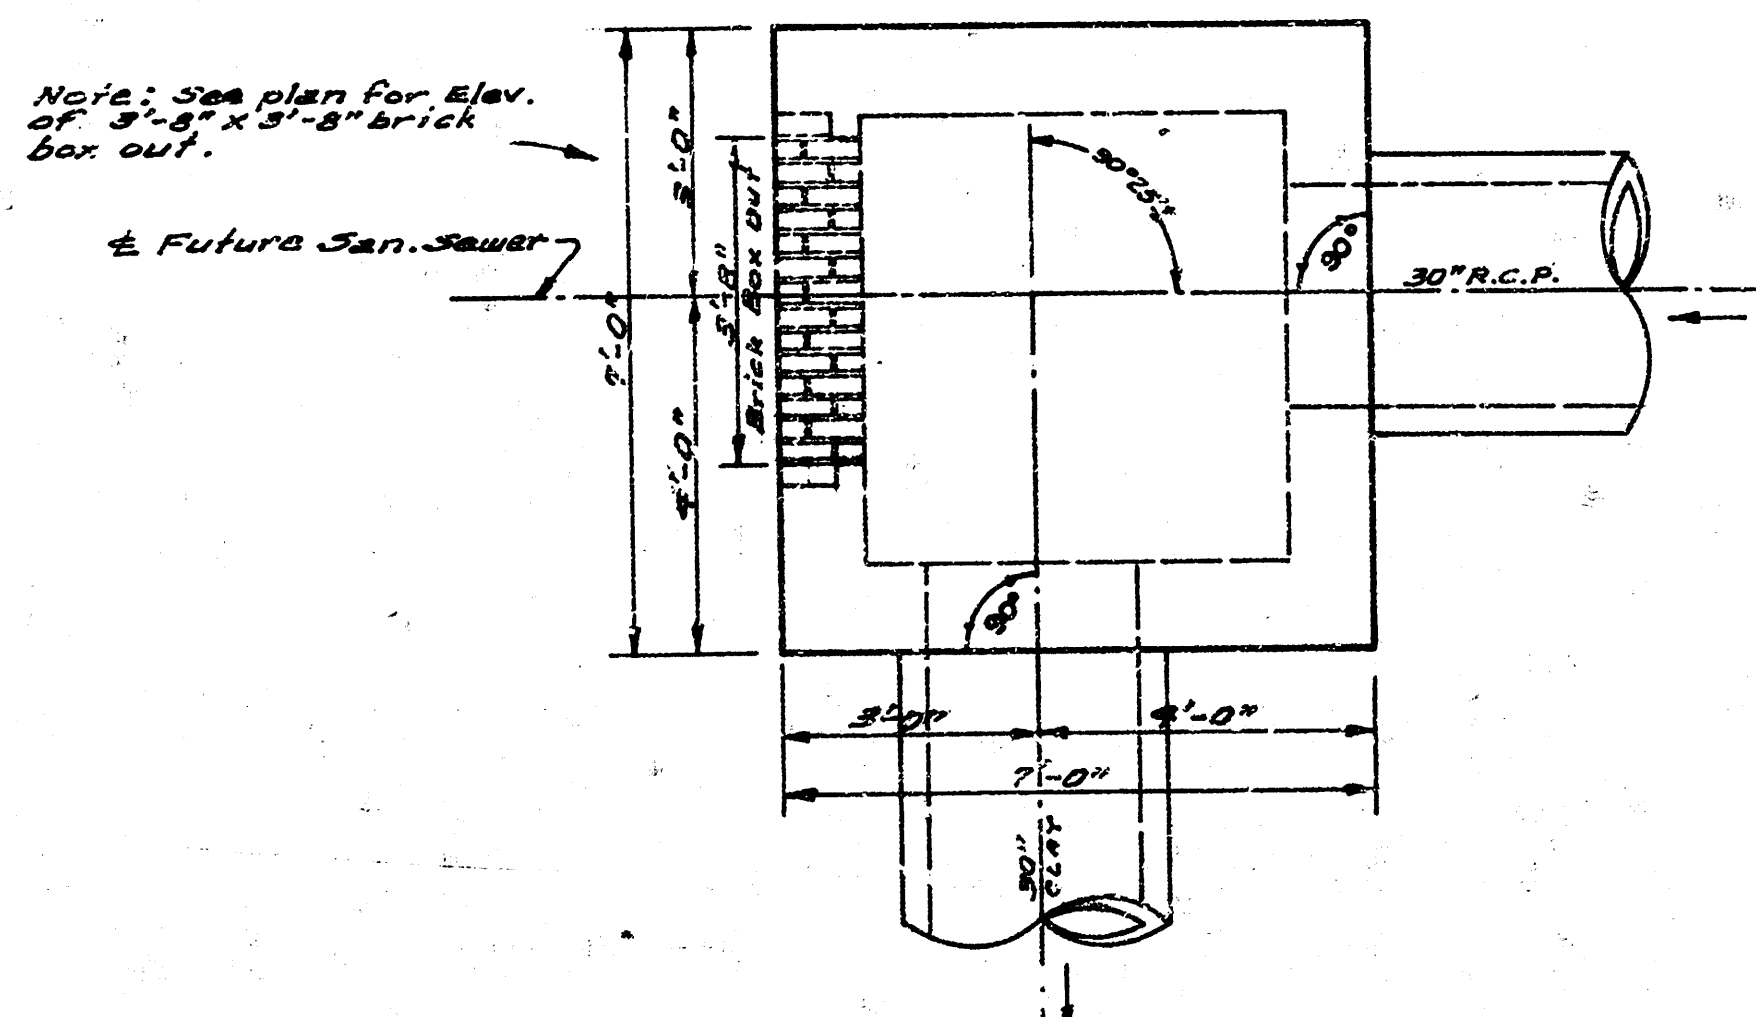


SECTIONAL PLAN OF SPECIAL REINF. CONC. M.H. STA. 1462 BR. STA. 1457 AN (PHASE II).
Scale $\frac{3}{8}'' = 1'-0''$

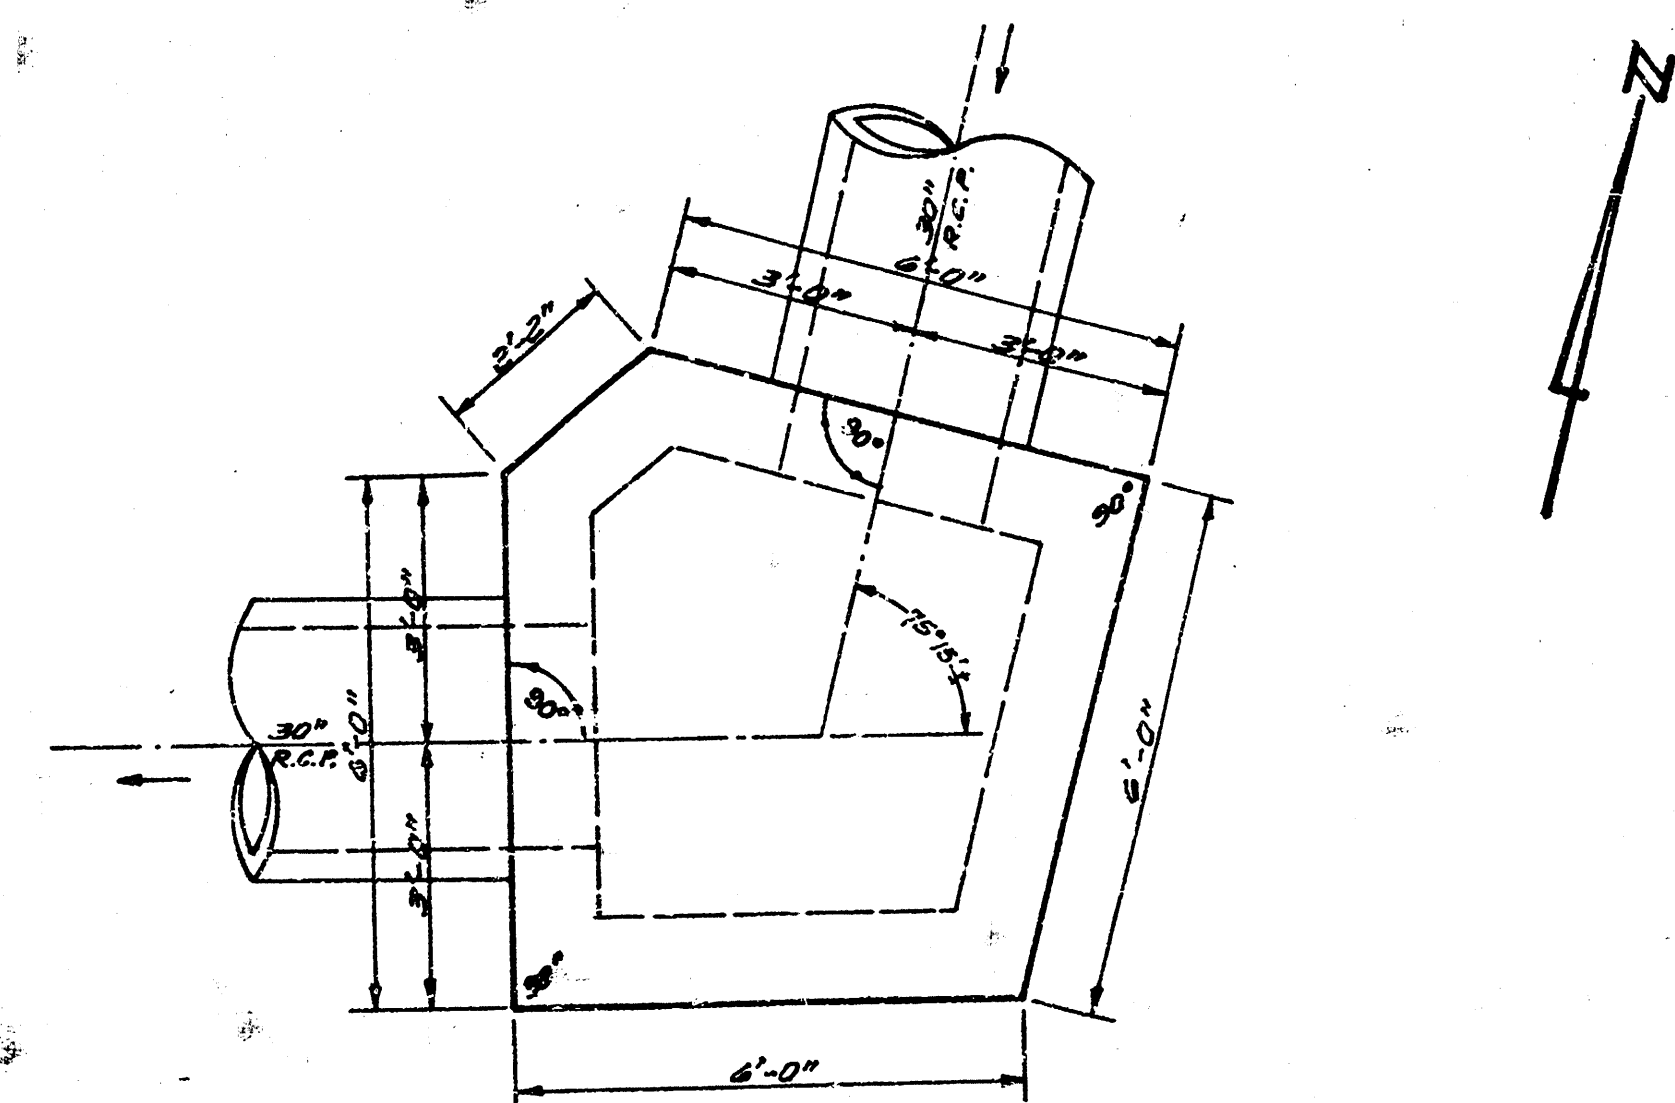


SECTIONAL PLAN OF SPECIAL REINF. CONC. M.H. STA. 13166 (PHASE II).
Scale $\frac{3}{8}'' = 1'-0''$


MAIN 5, S.W. INT. SEWER
SH. NO. 15 OF 17
15/17

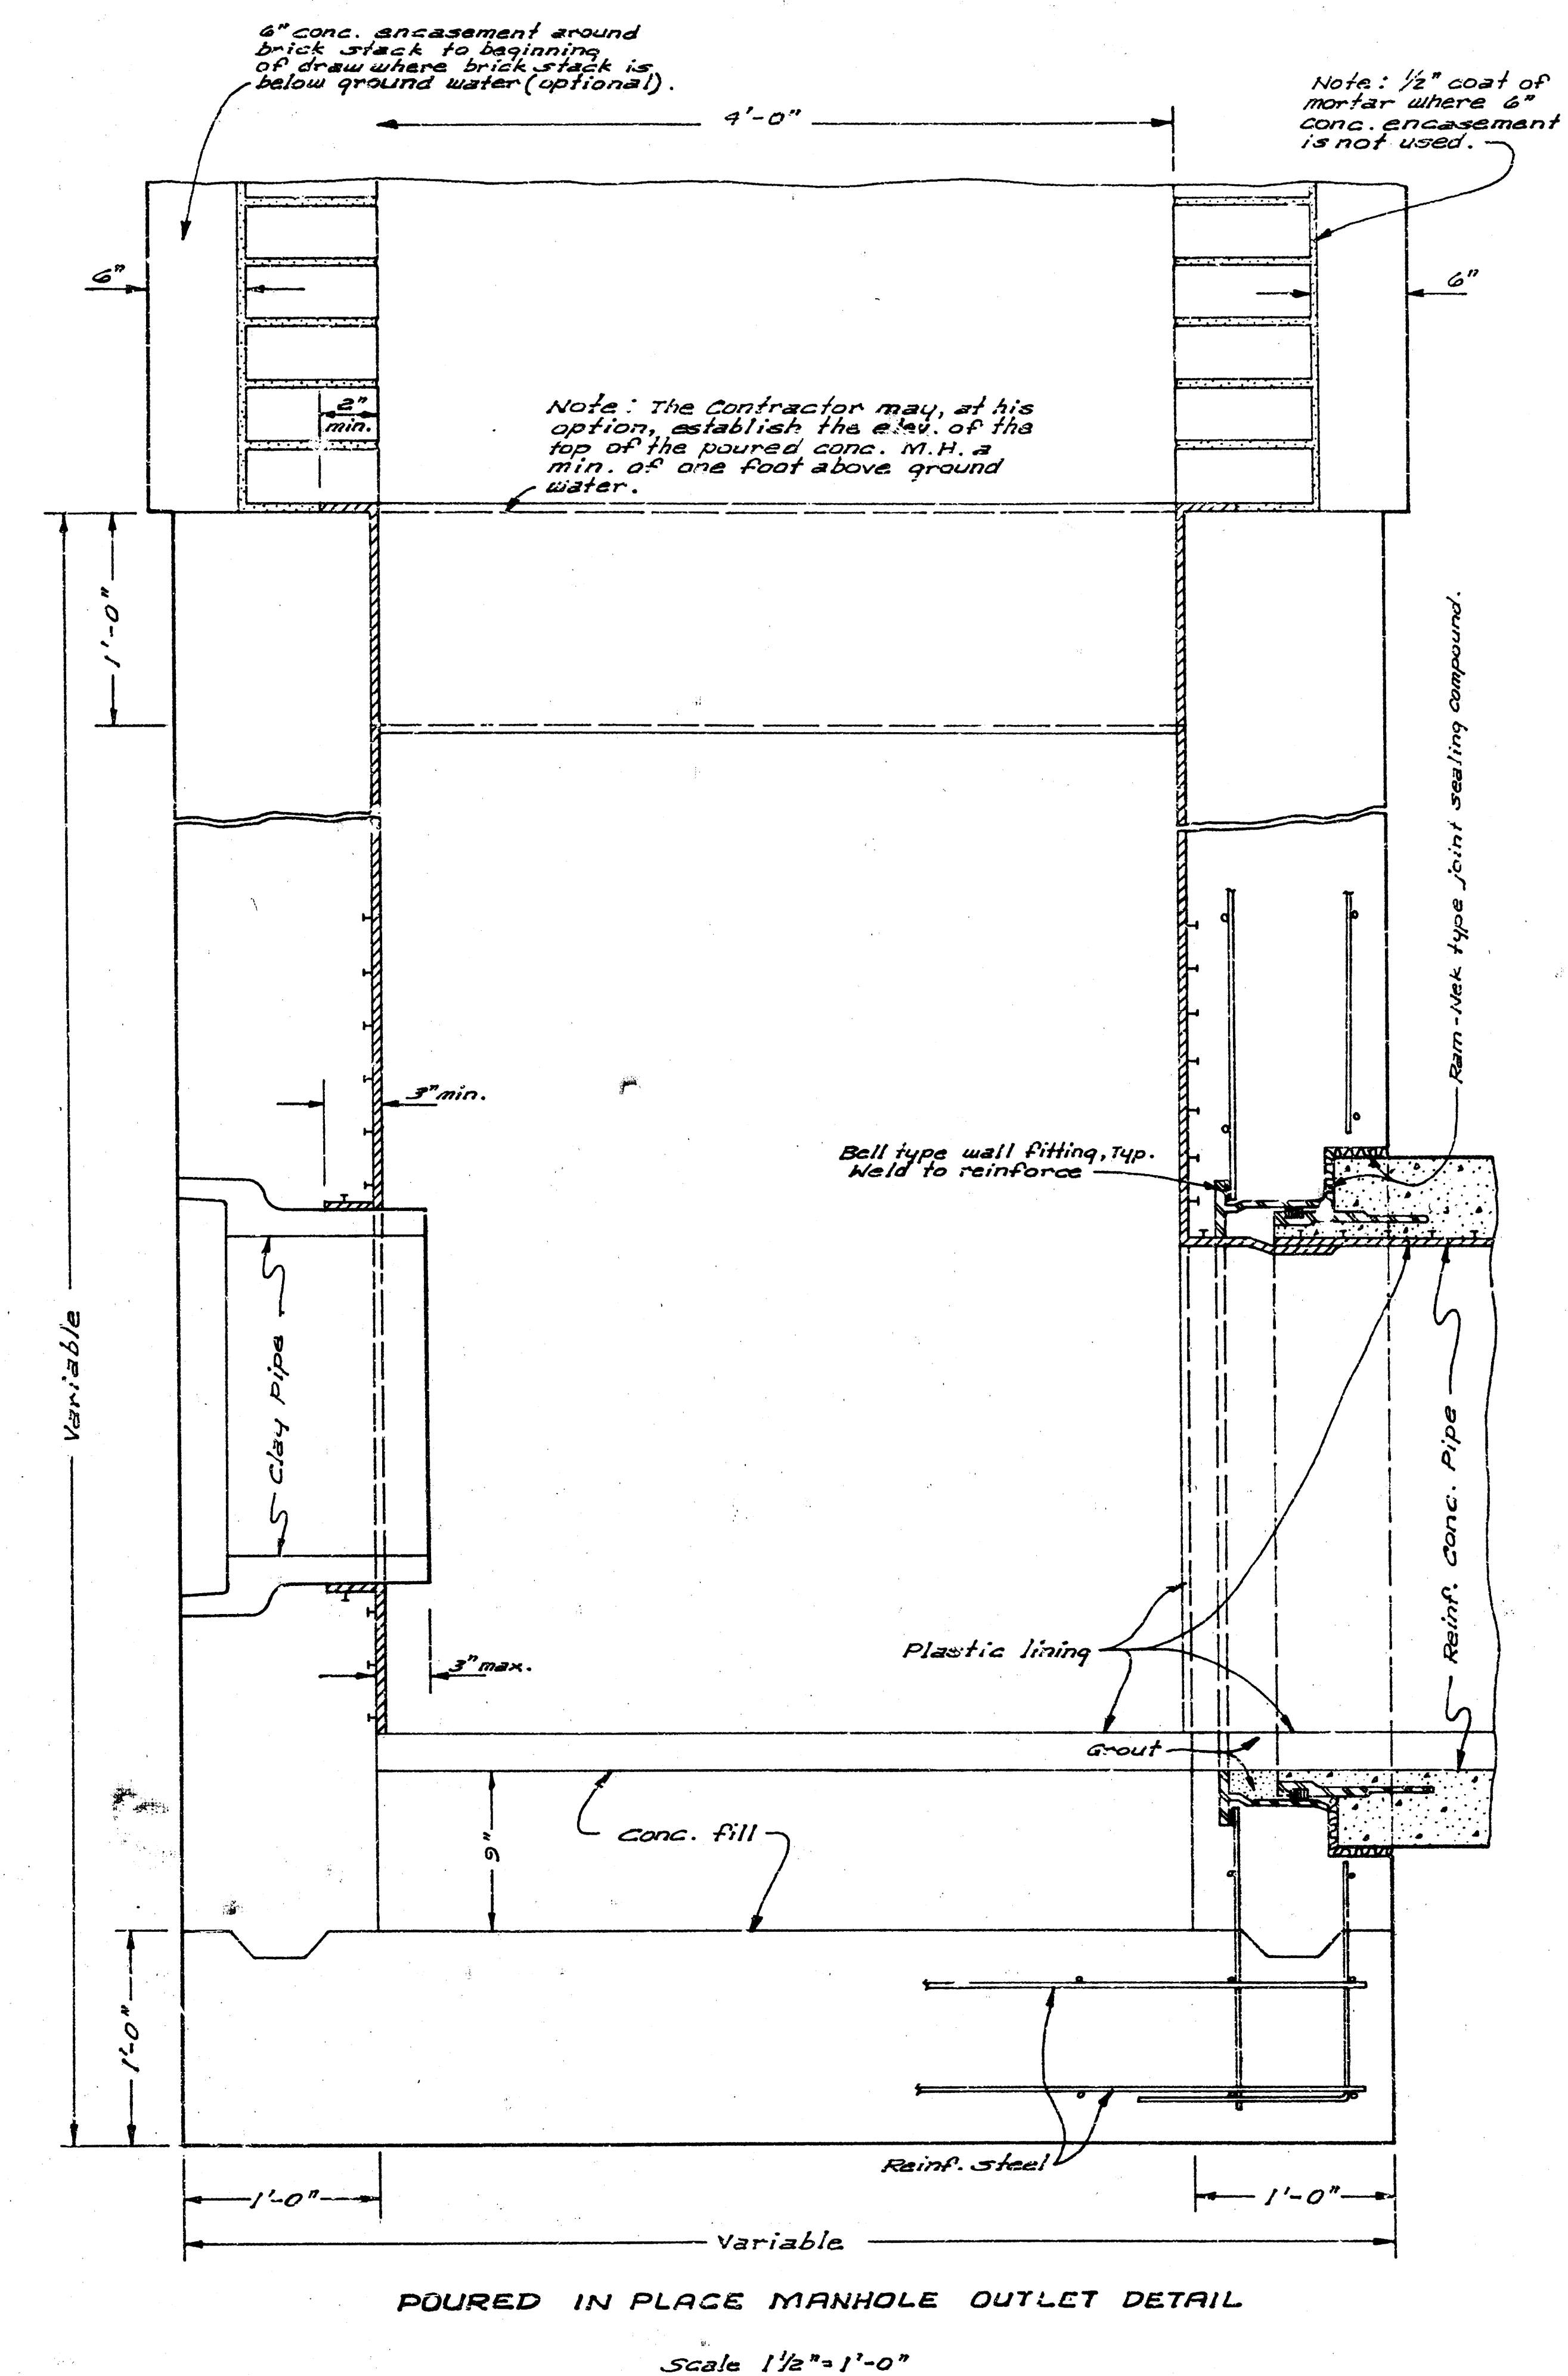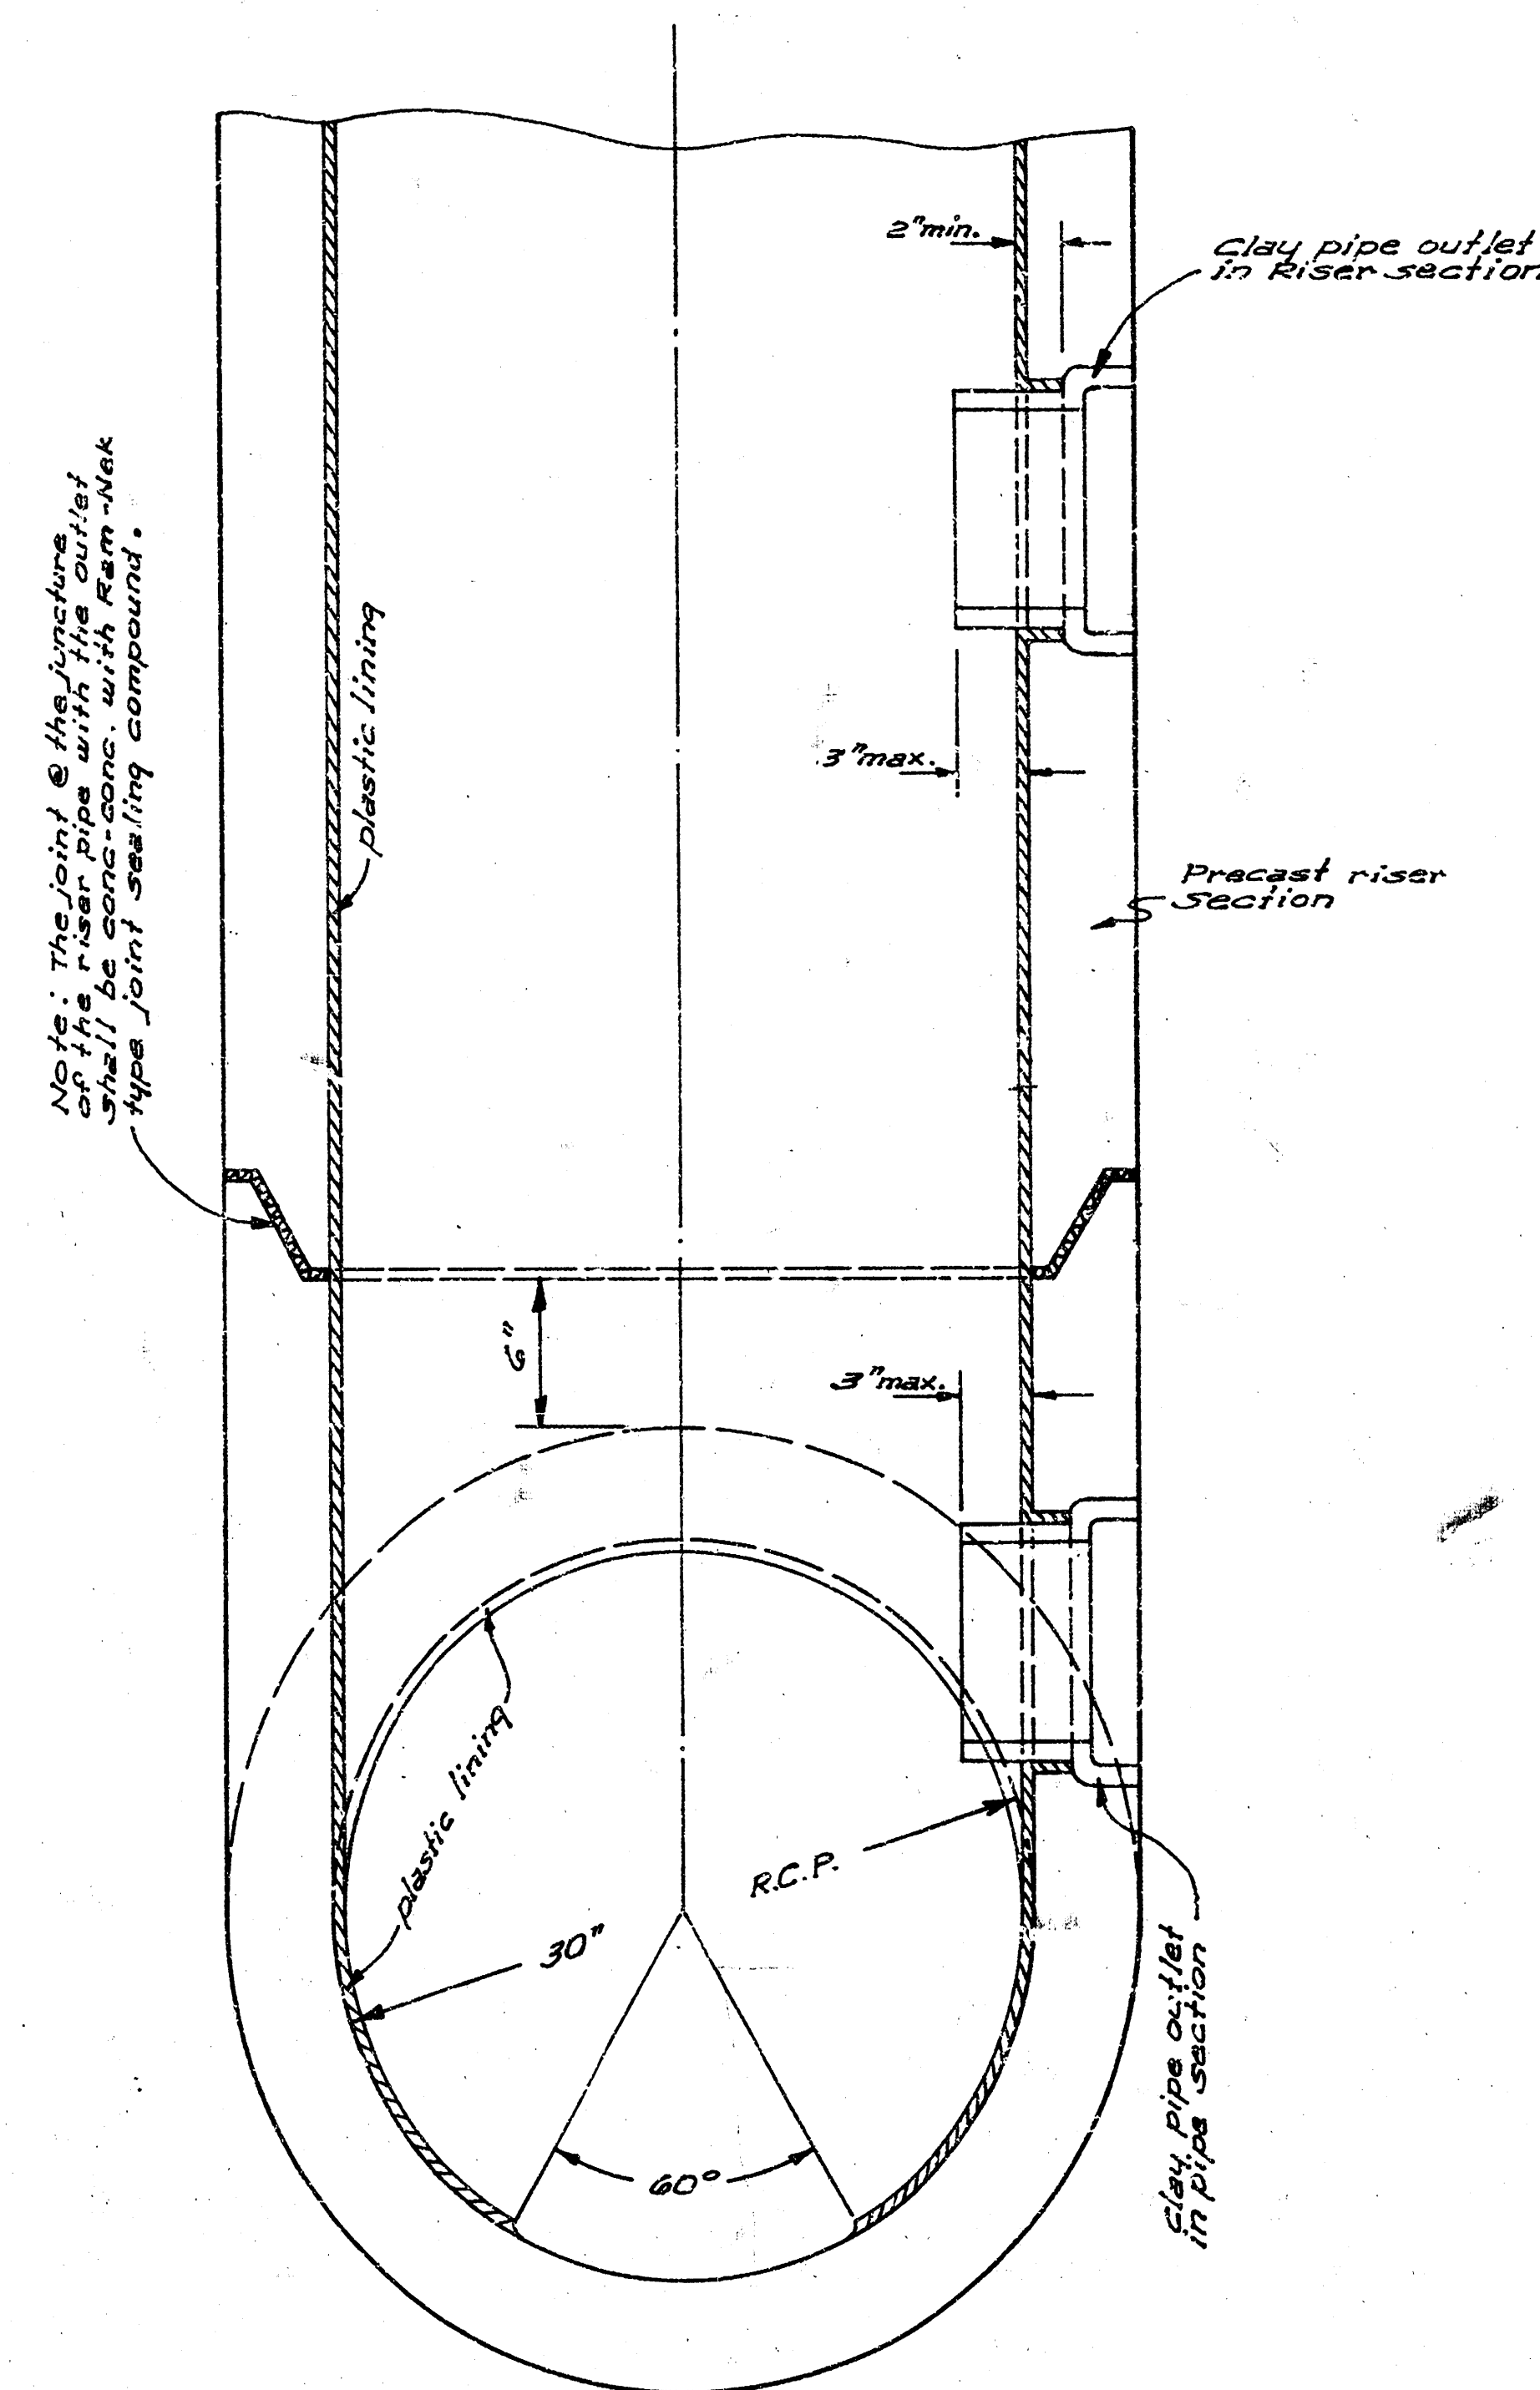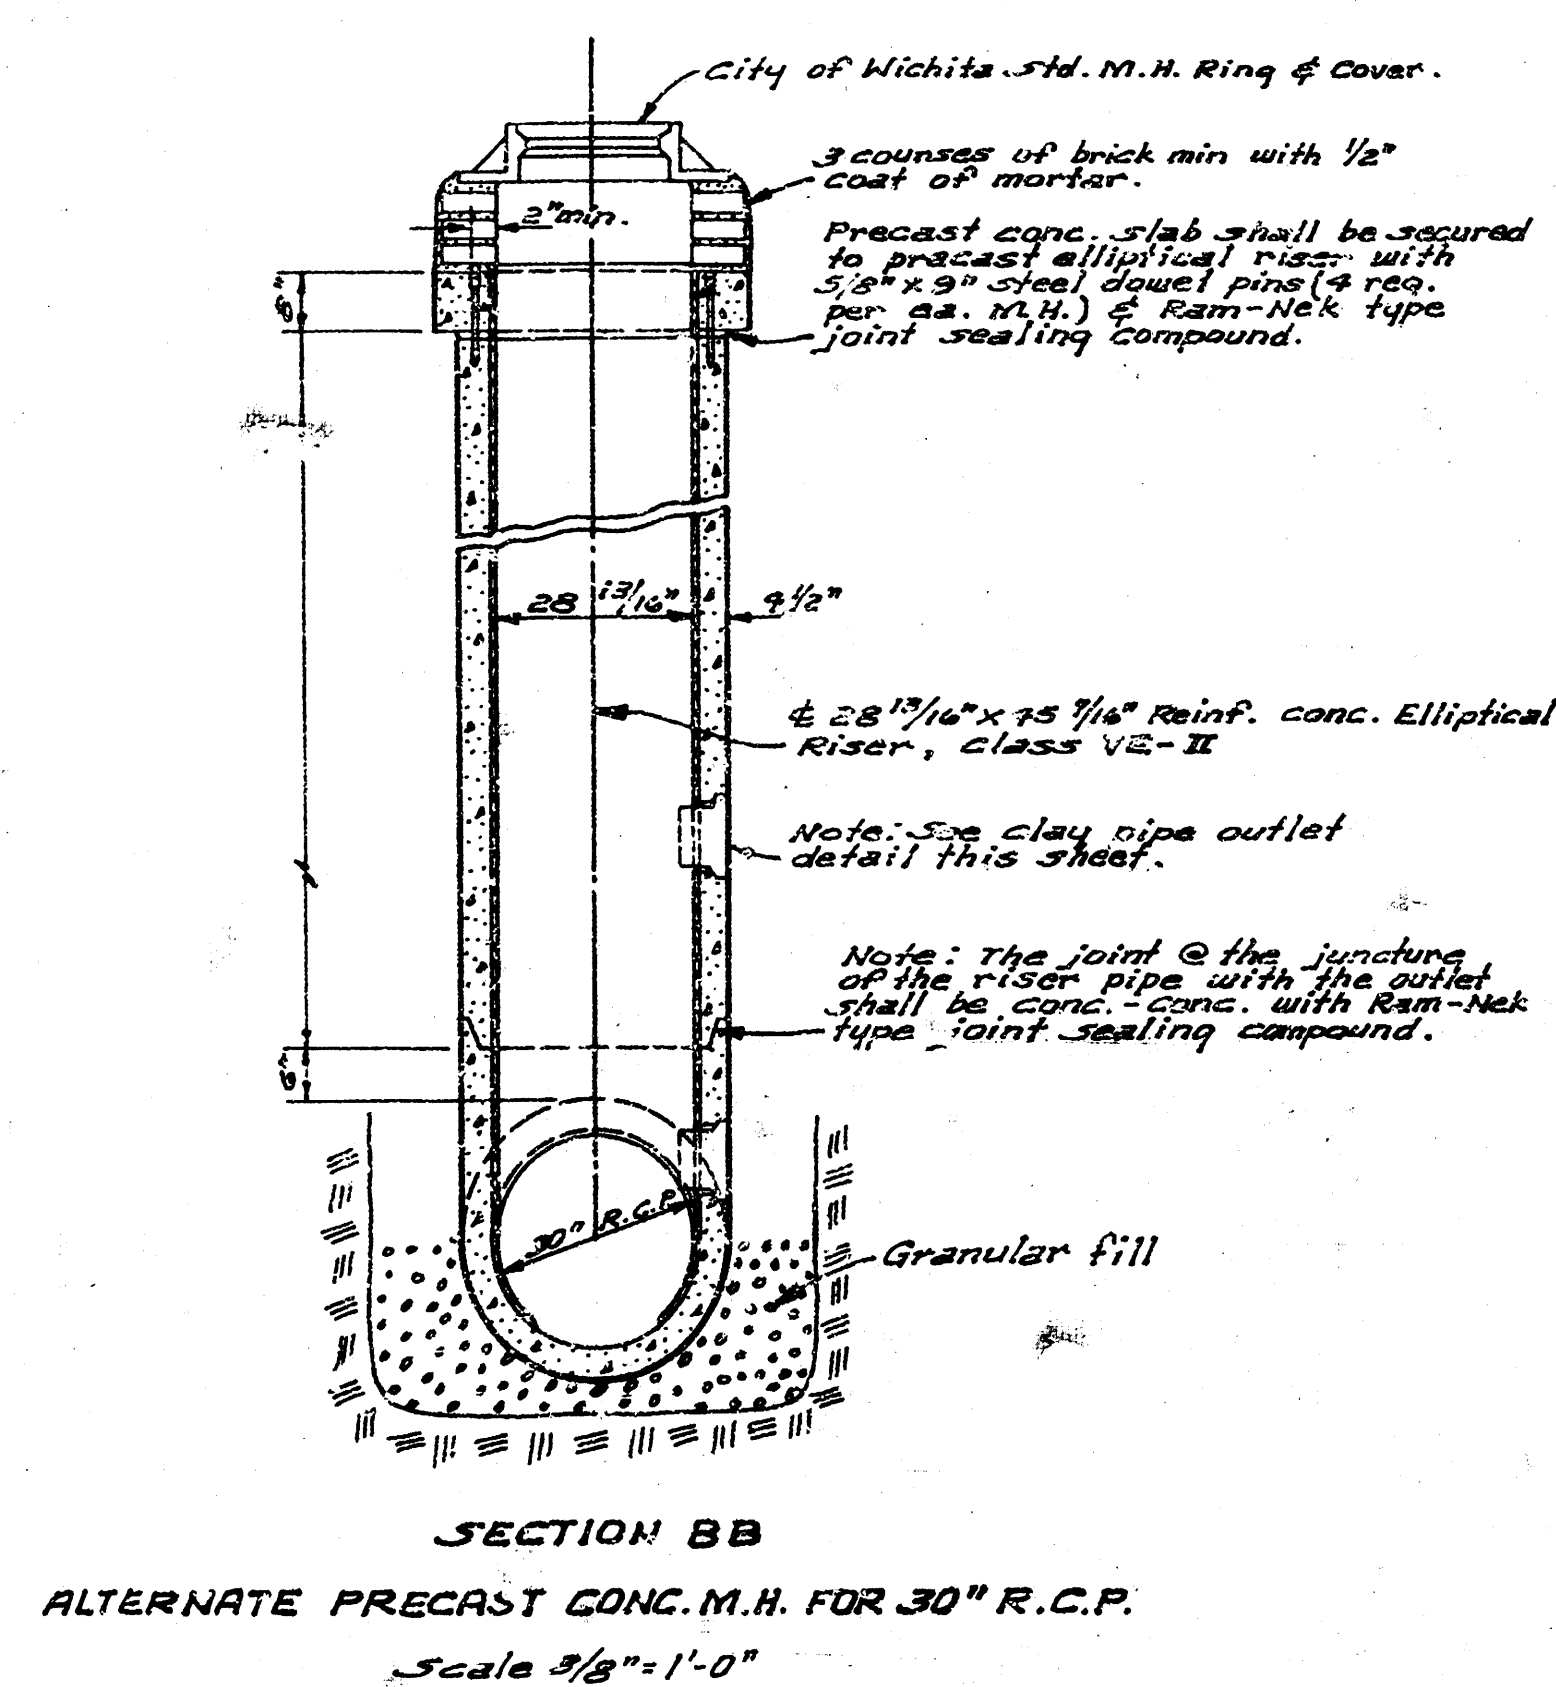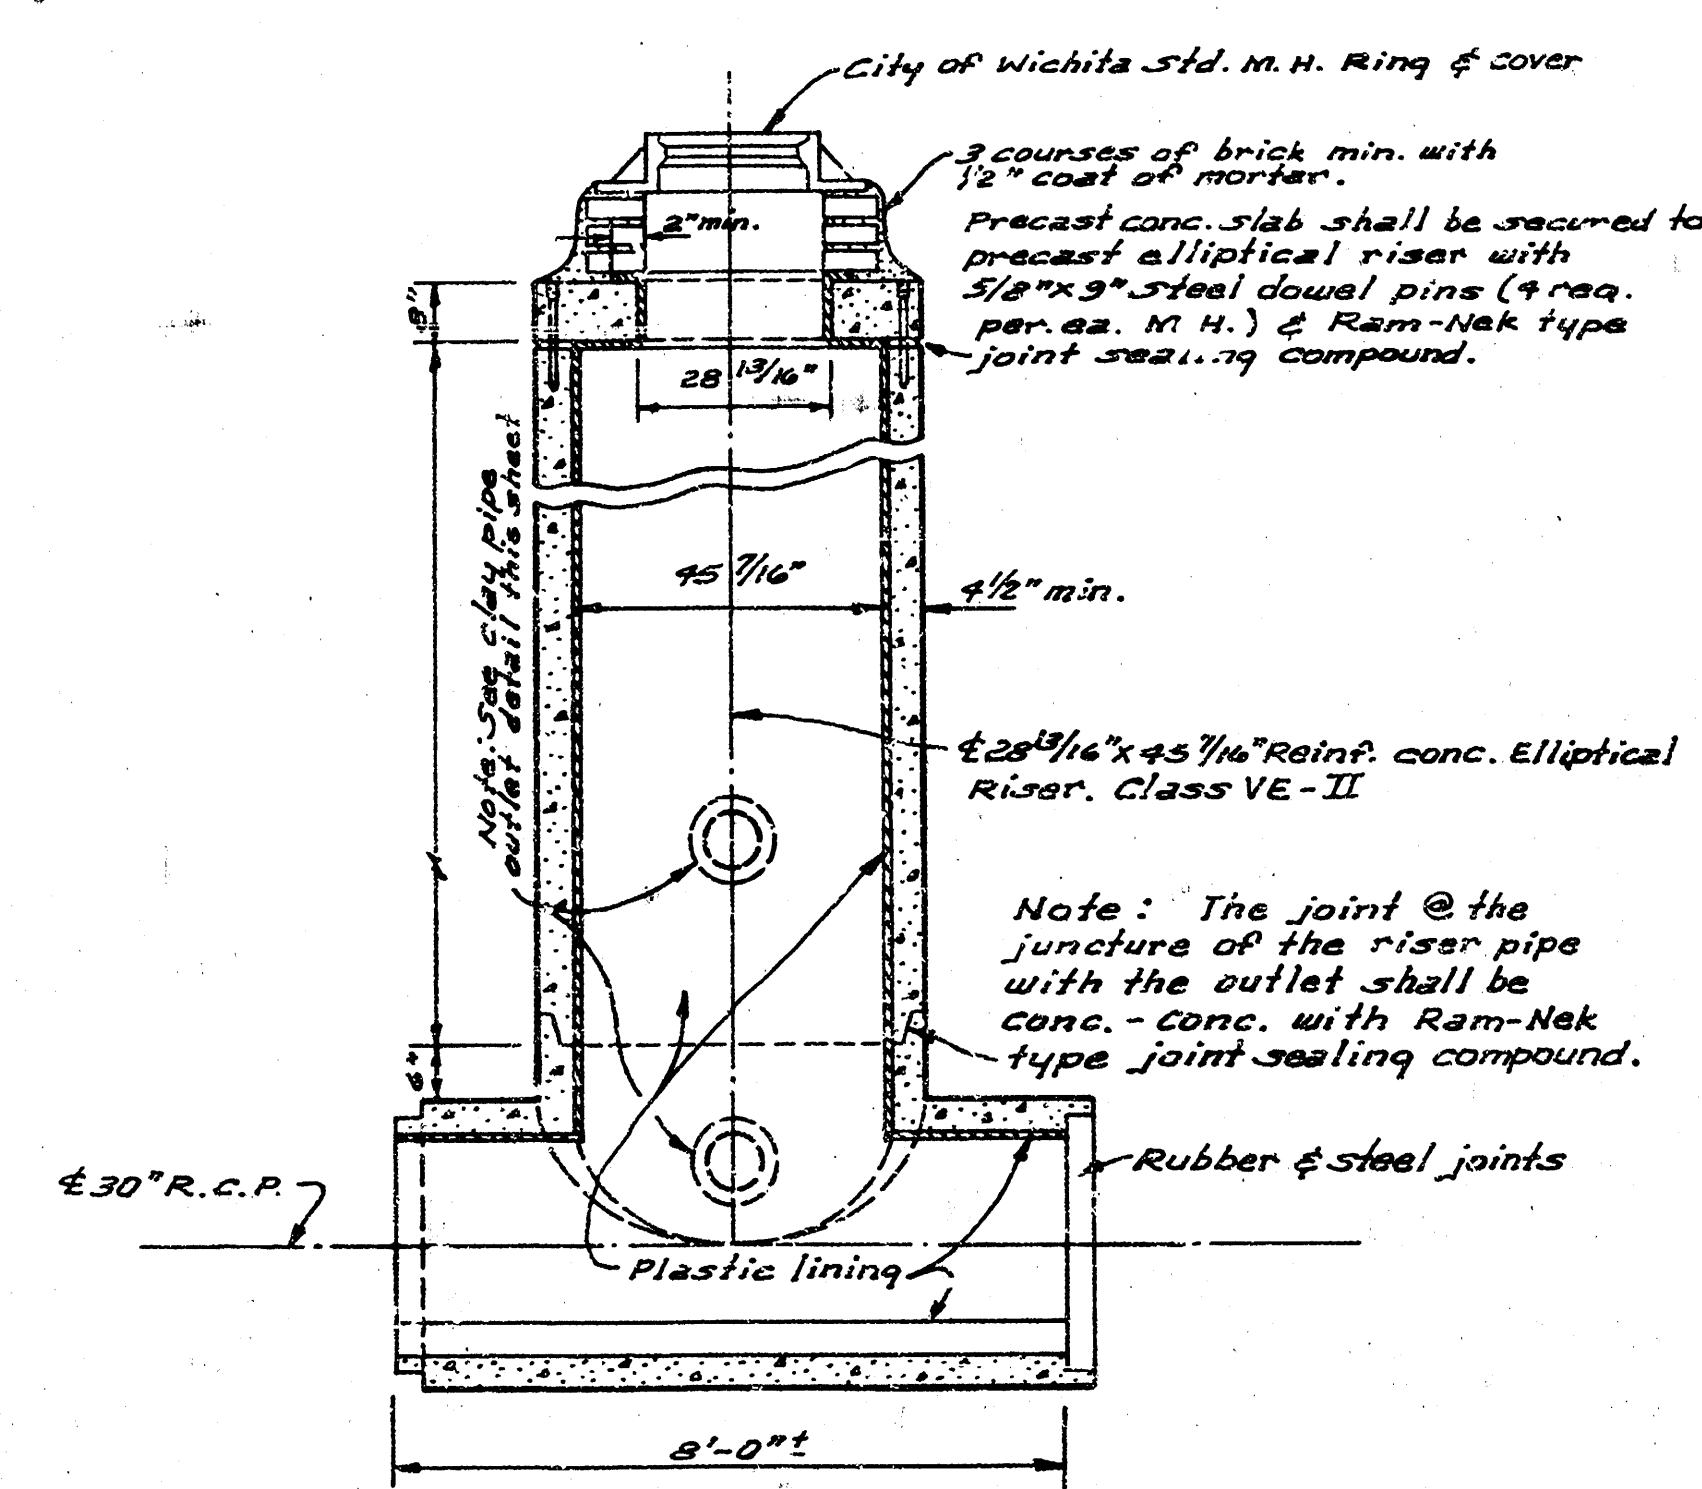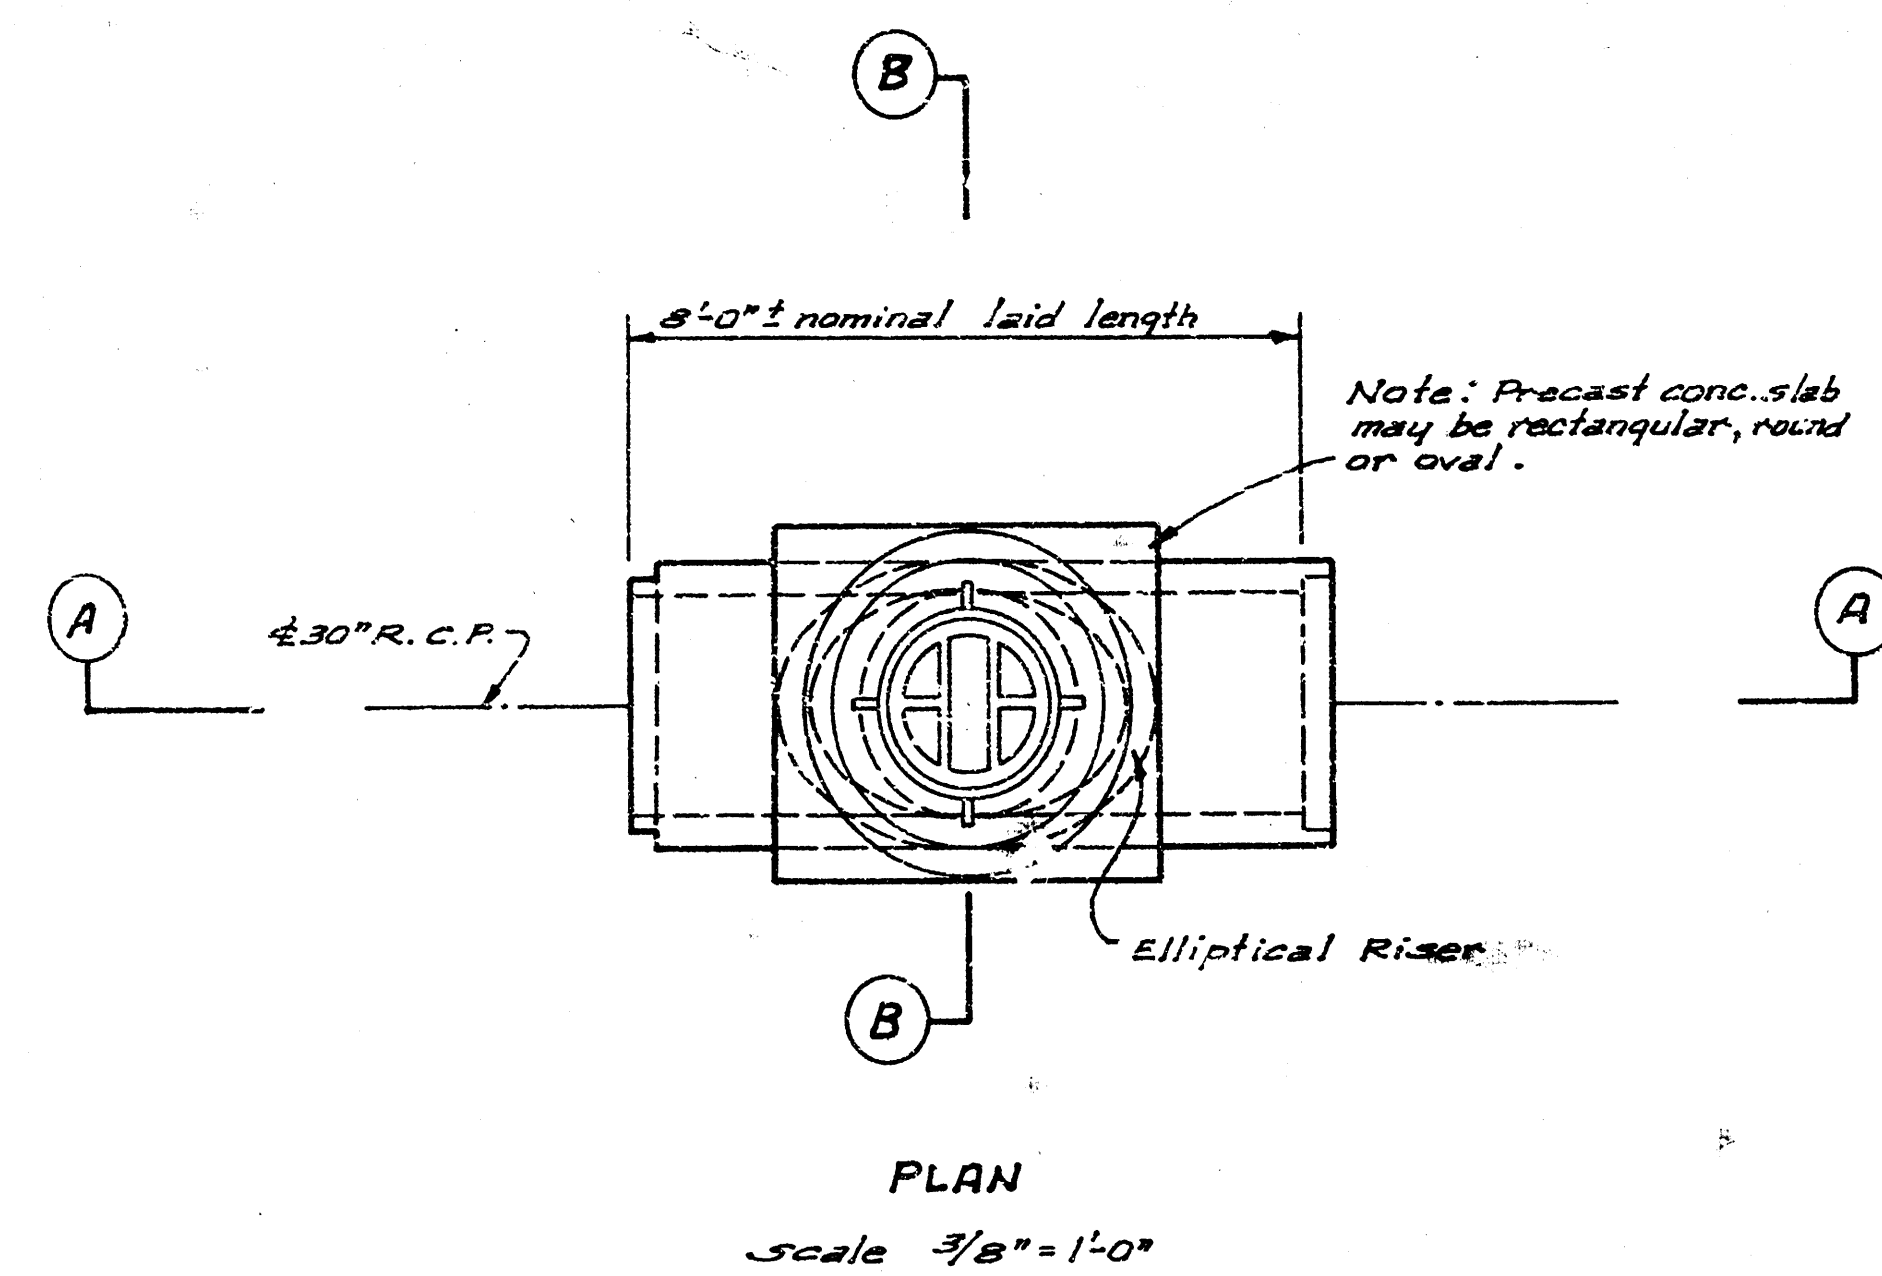


CROUT TO BE PLACED AROUND MANHOLE RING ONLY WHEN MANHOLE IS CONSTRUCTED IN UNPAVED AREAS. (TYPICAL ALL MANHOLES)

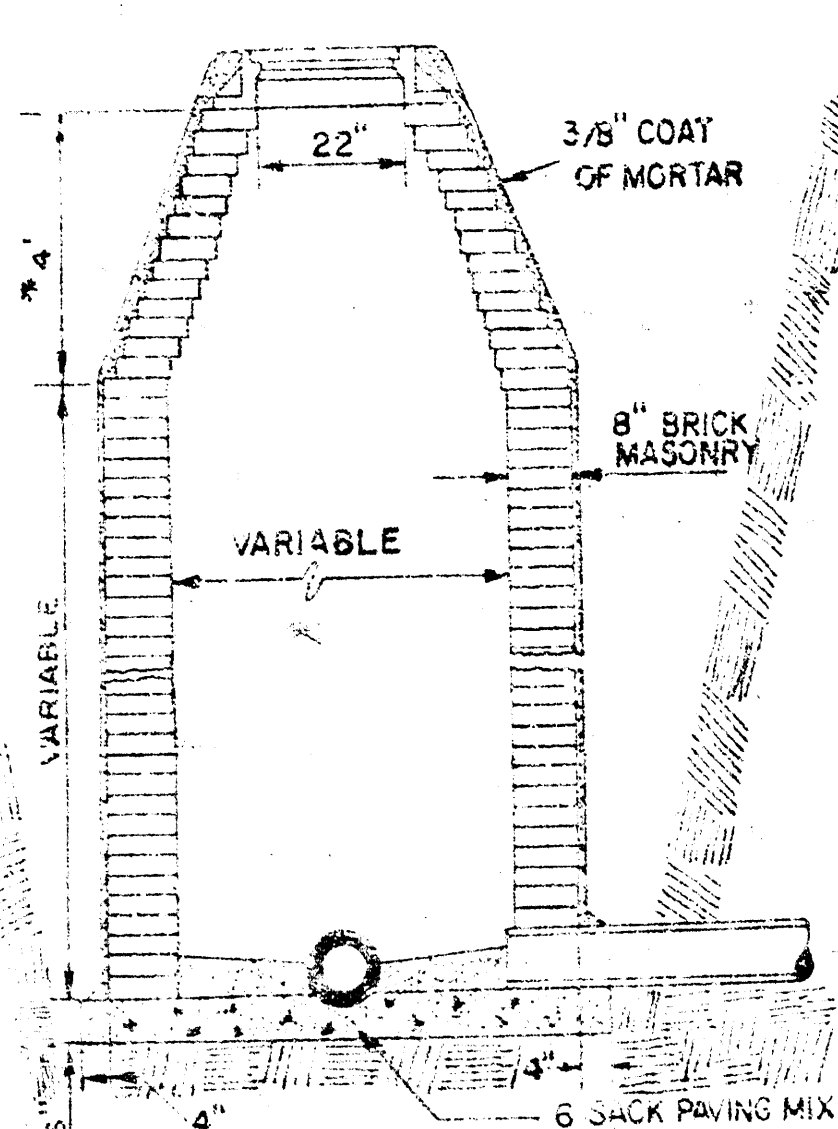


STANDARD MANHOLE
TYPE "A"

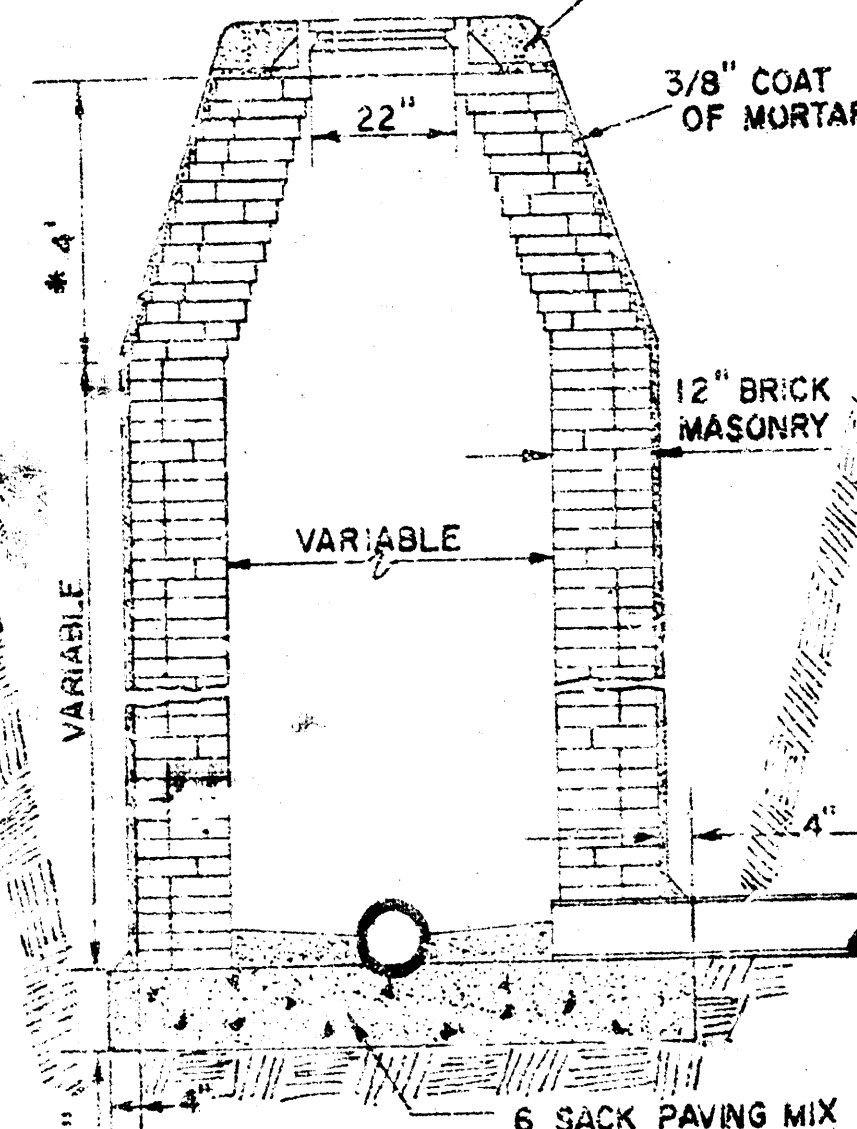


STANDARD MANHOLE
TYPE "B"

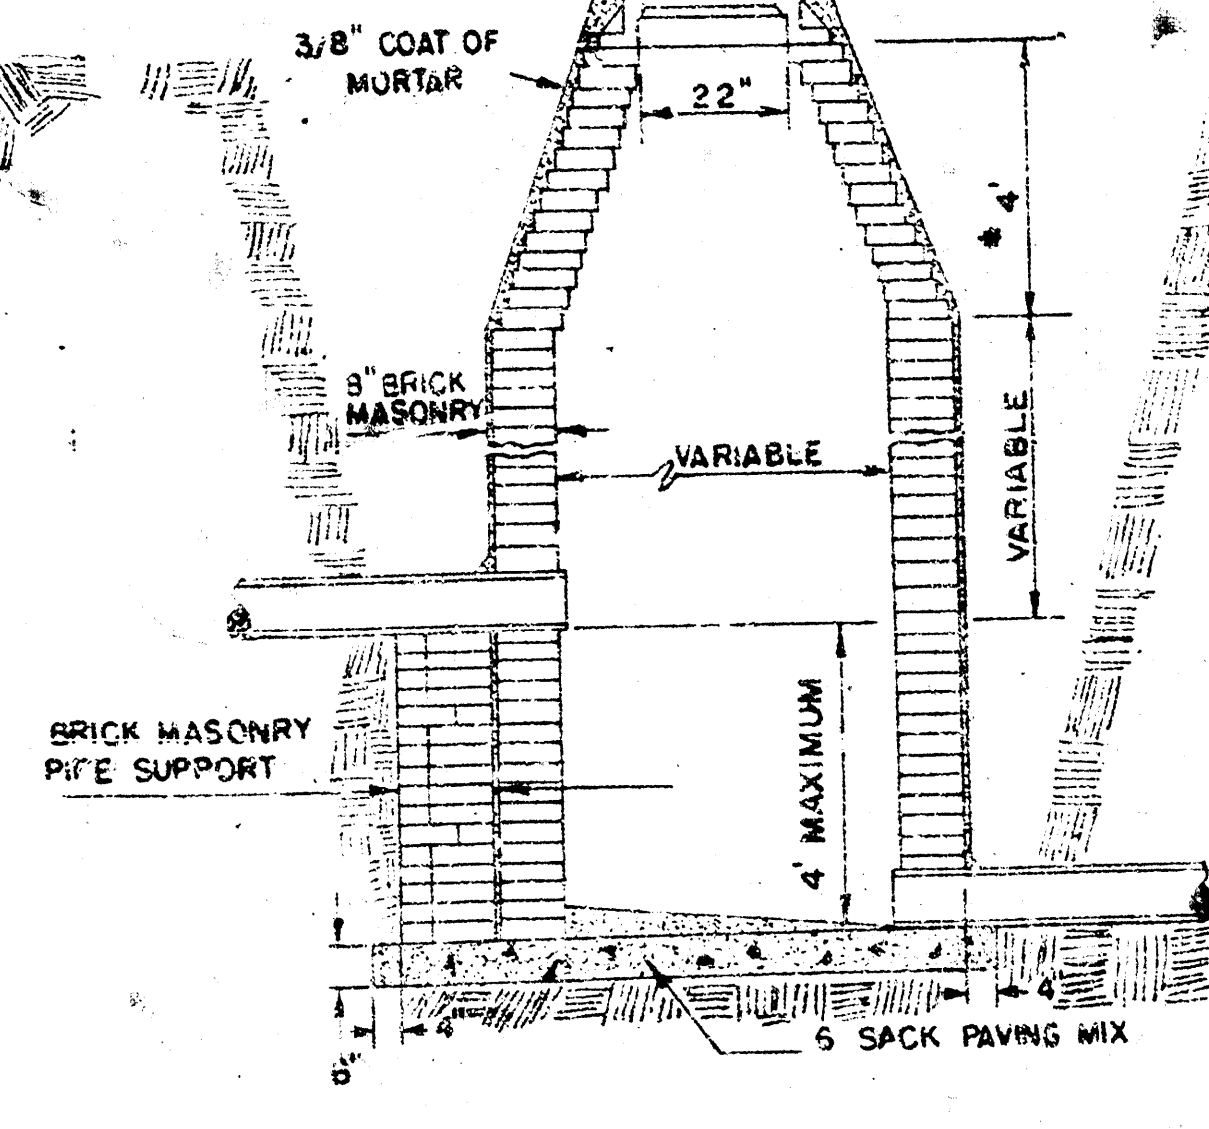


DROP MANHOLE
TYPE "A"

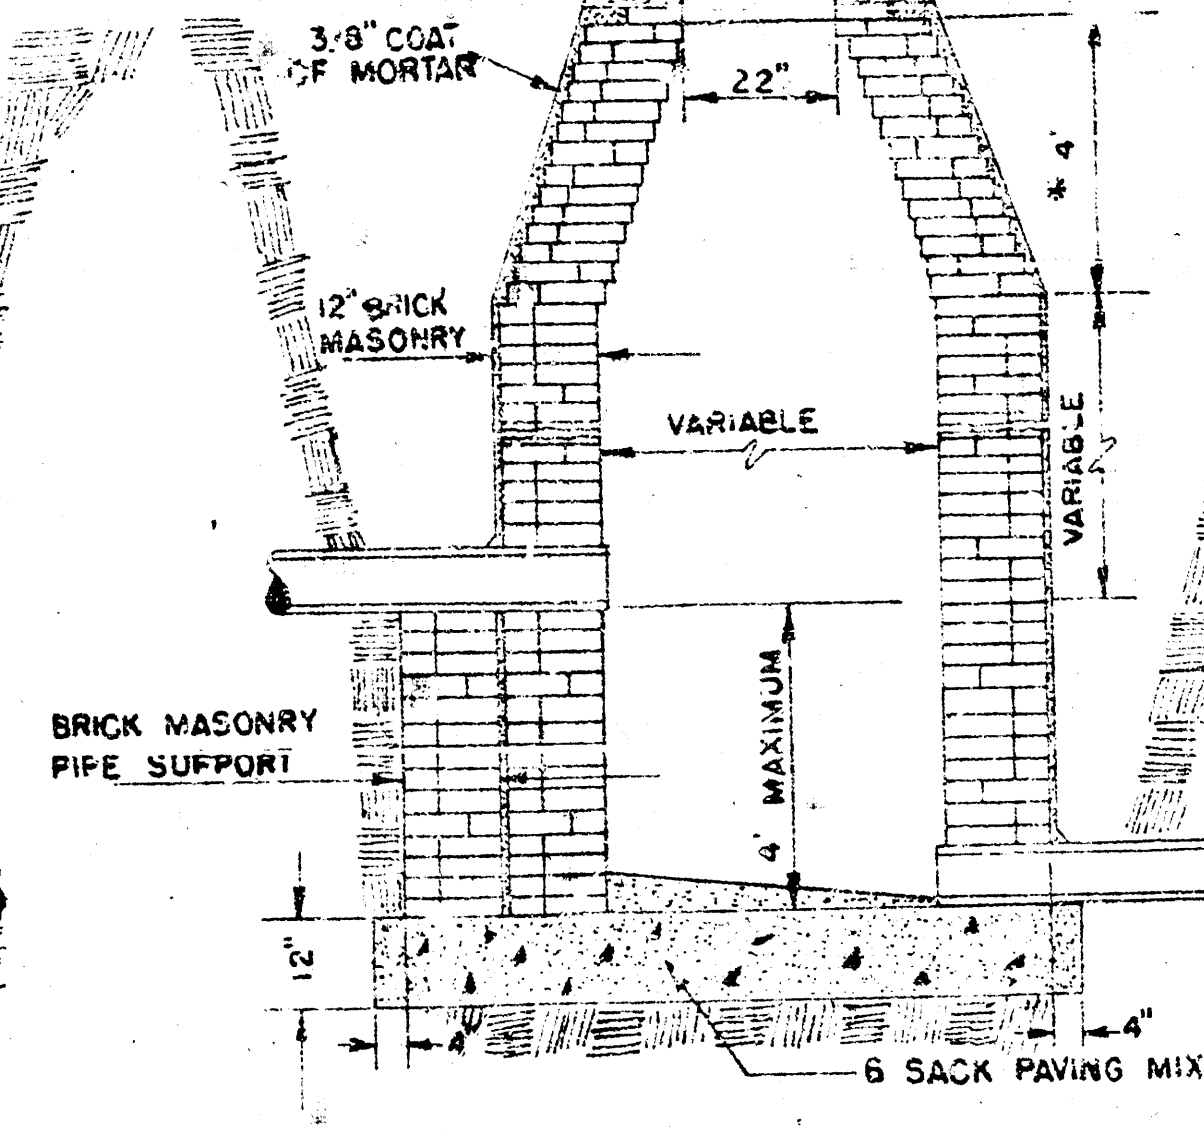

DROP MANHOLE
TYPE "B"

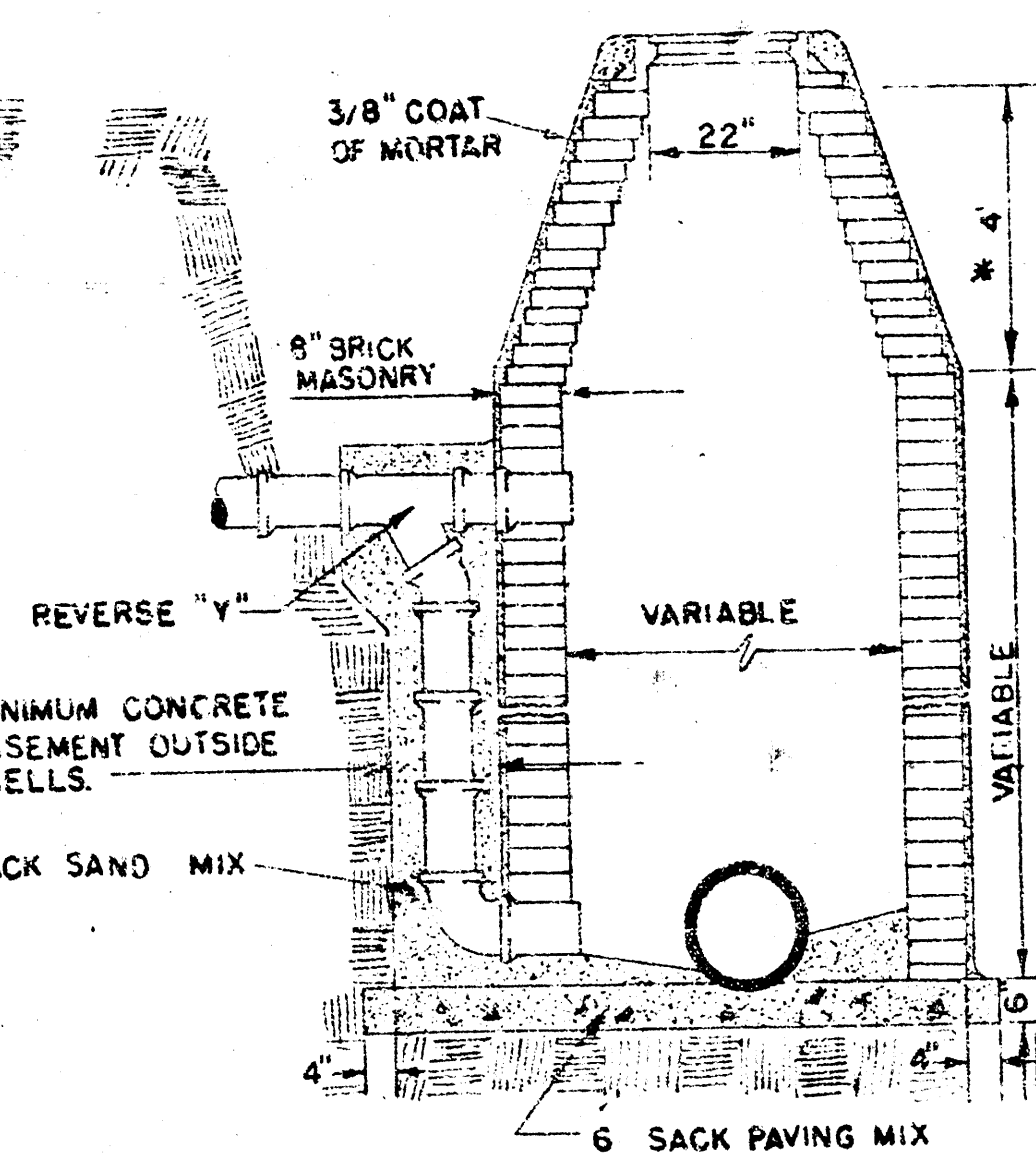


OUTSIDE DROP MANHOLE
TYPE "A"

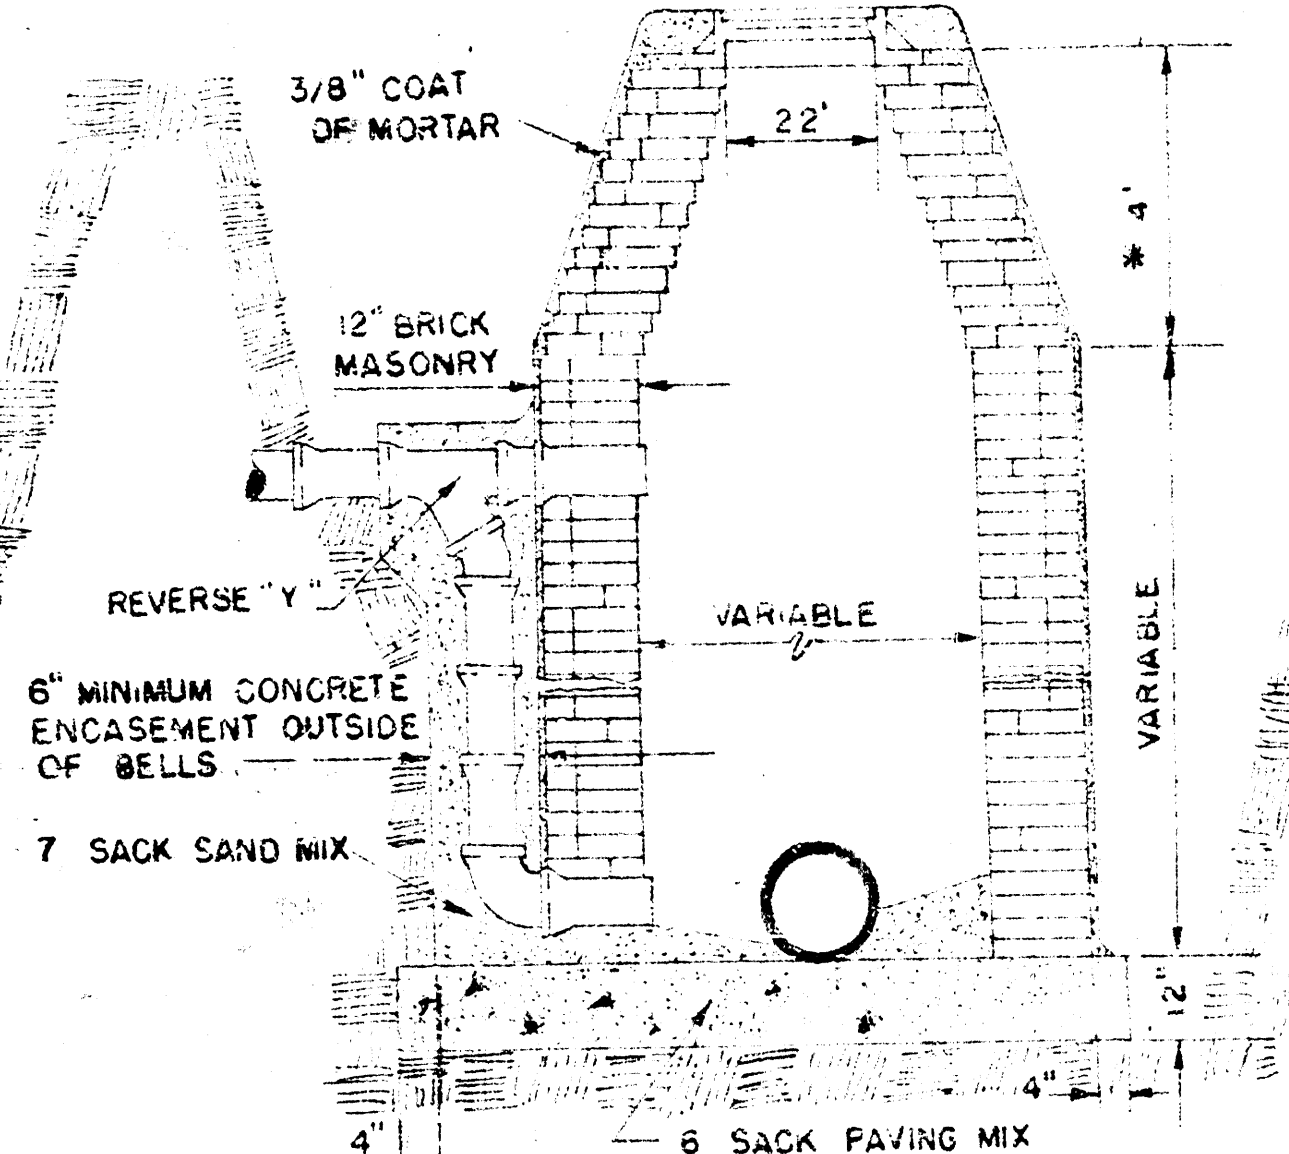

OUTSIDE DROP MANHOLE
TYPE "B"


* DRAW = 6" ON 5' DIA. M.H.

NOTE: ALL BRICK MANHOLES SHALL BE ENCASED WITH 6" CONCRETE ENCASEMENT TO A MINIMUM ELEVATION OF 1 FOOT ABOVE THE WATER TABLE ELEVATION AS DETERMINED BY THE ENGINEER. CONCRETE ENCASEMENT TO BE INCLUDED IN THE BID PRICE OF BRICK MANHOLE.

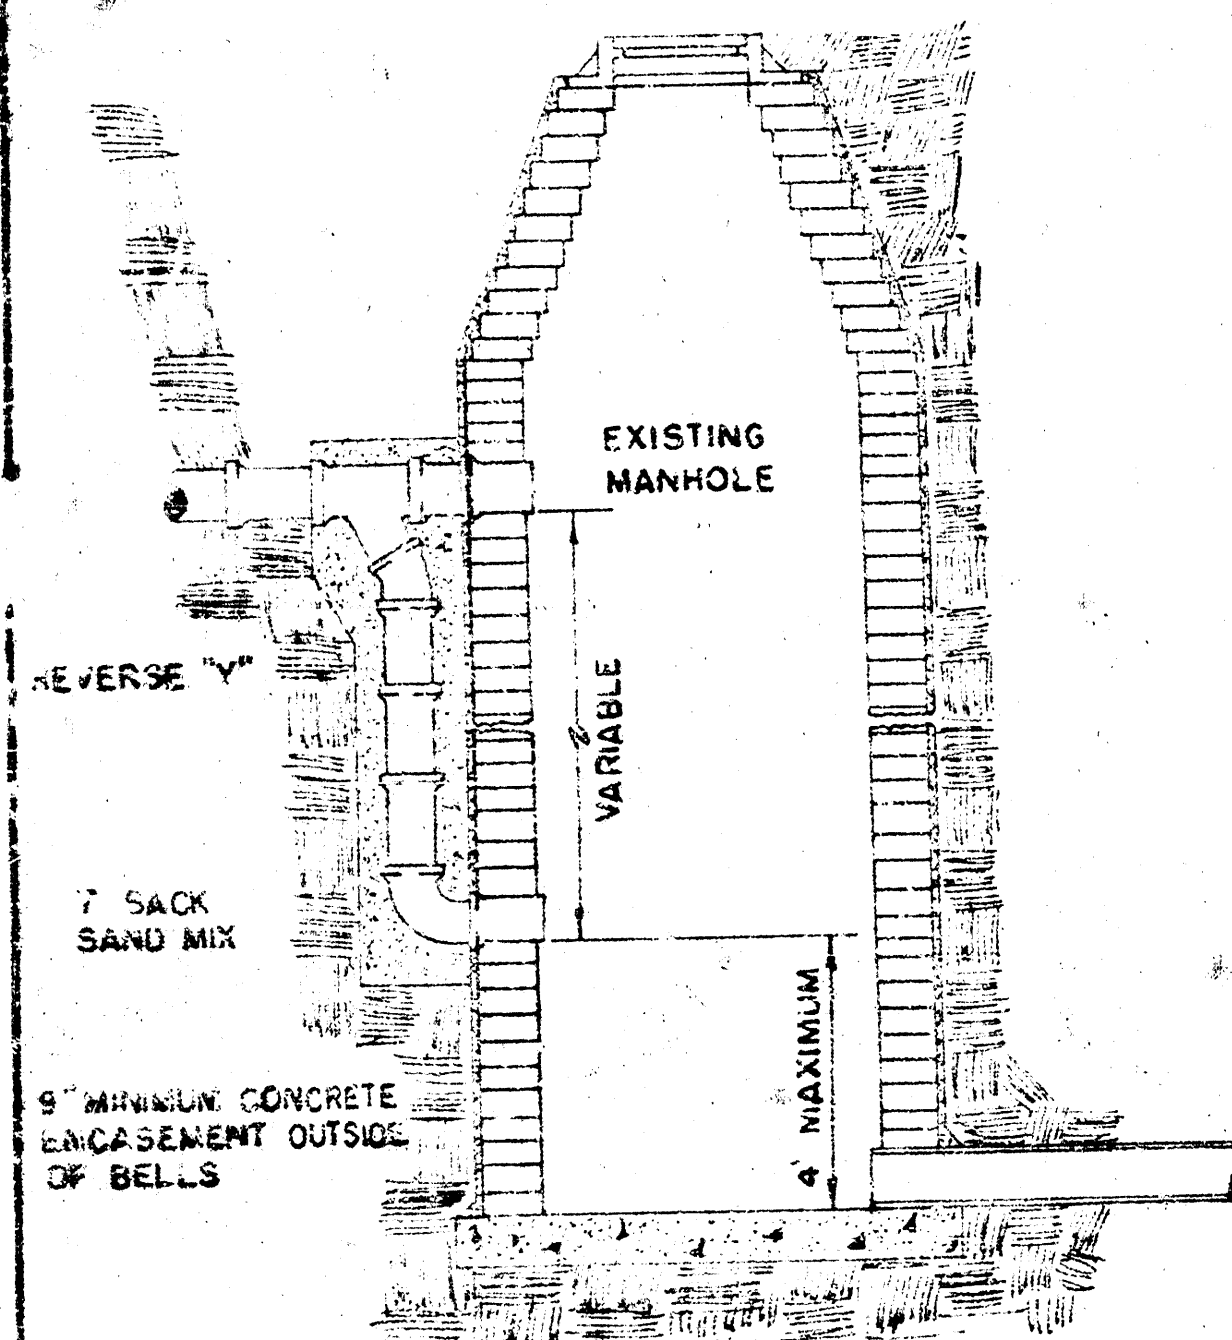


DETAIL OF DROP STACK

FOR EXISTING MANHOLES IN GROUND WATER

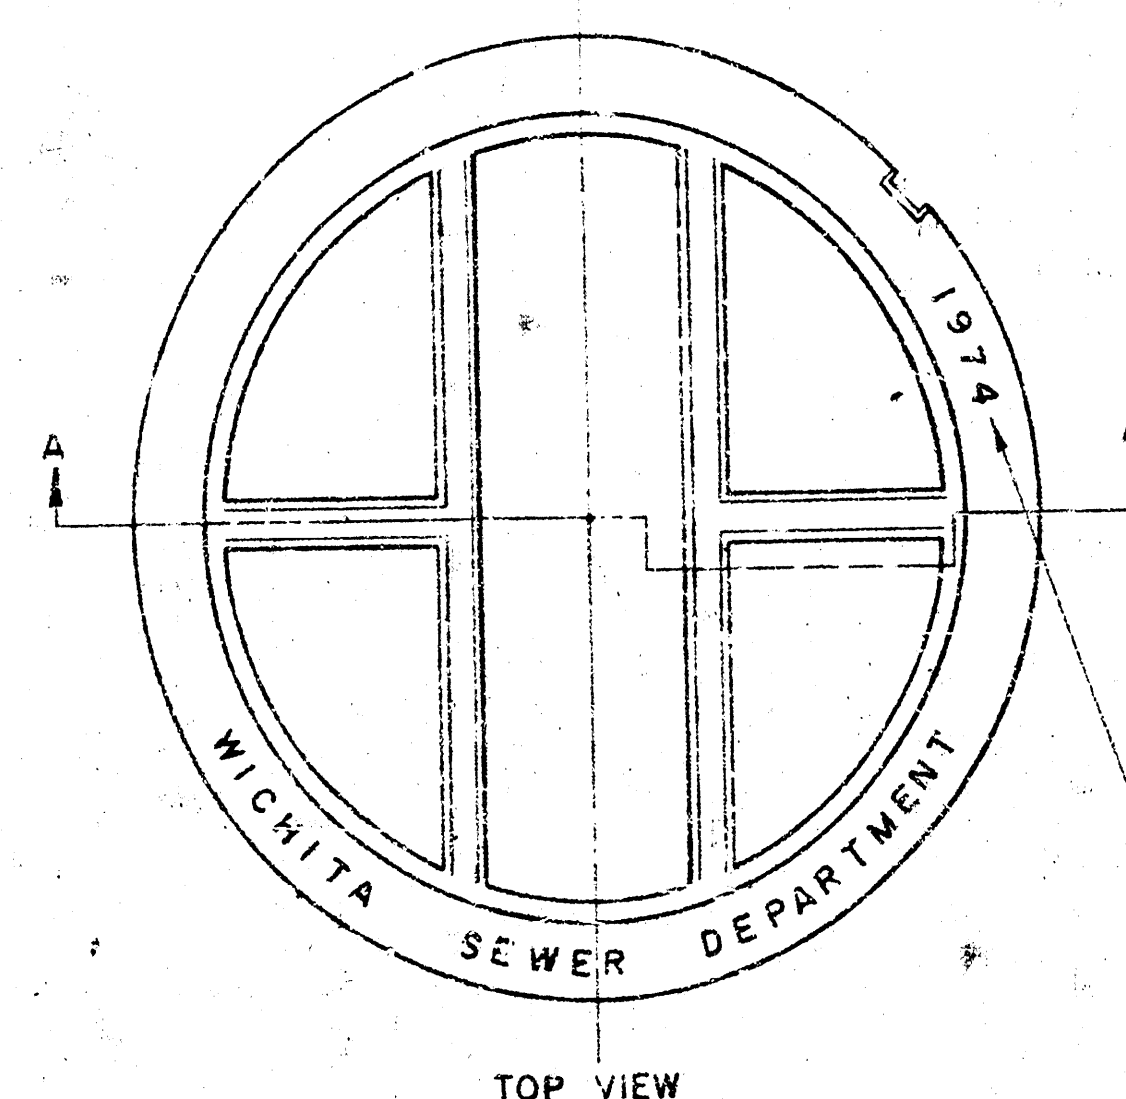


MANHOLE COVER
WEIGHT 110 LBS.

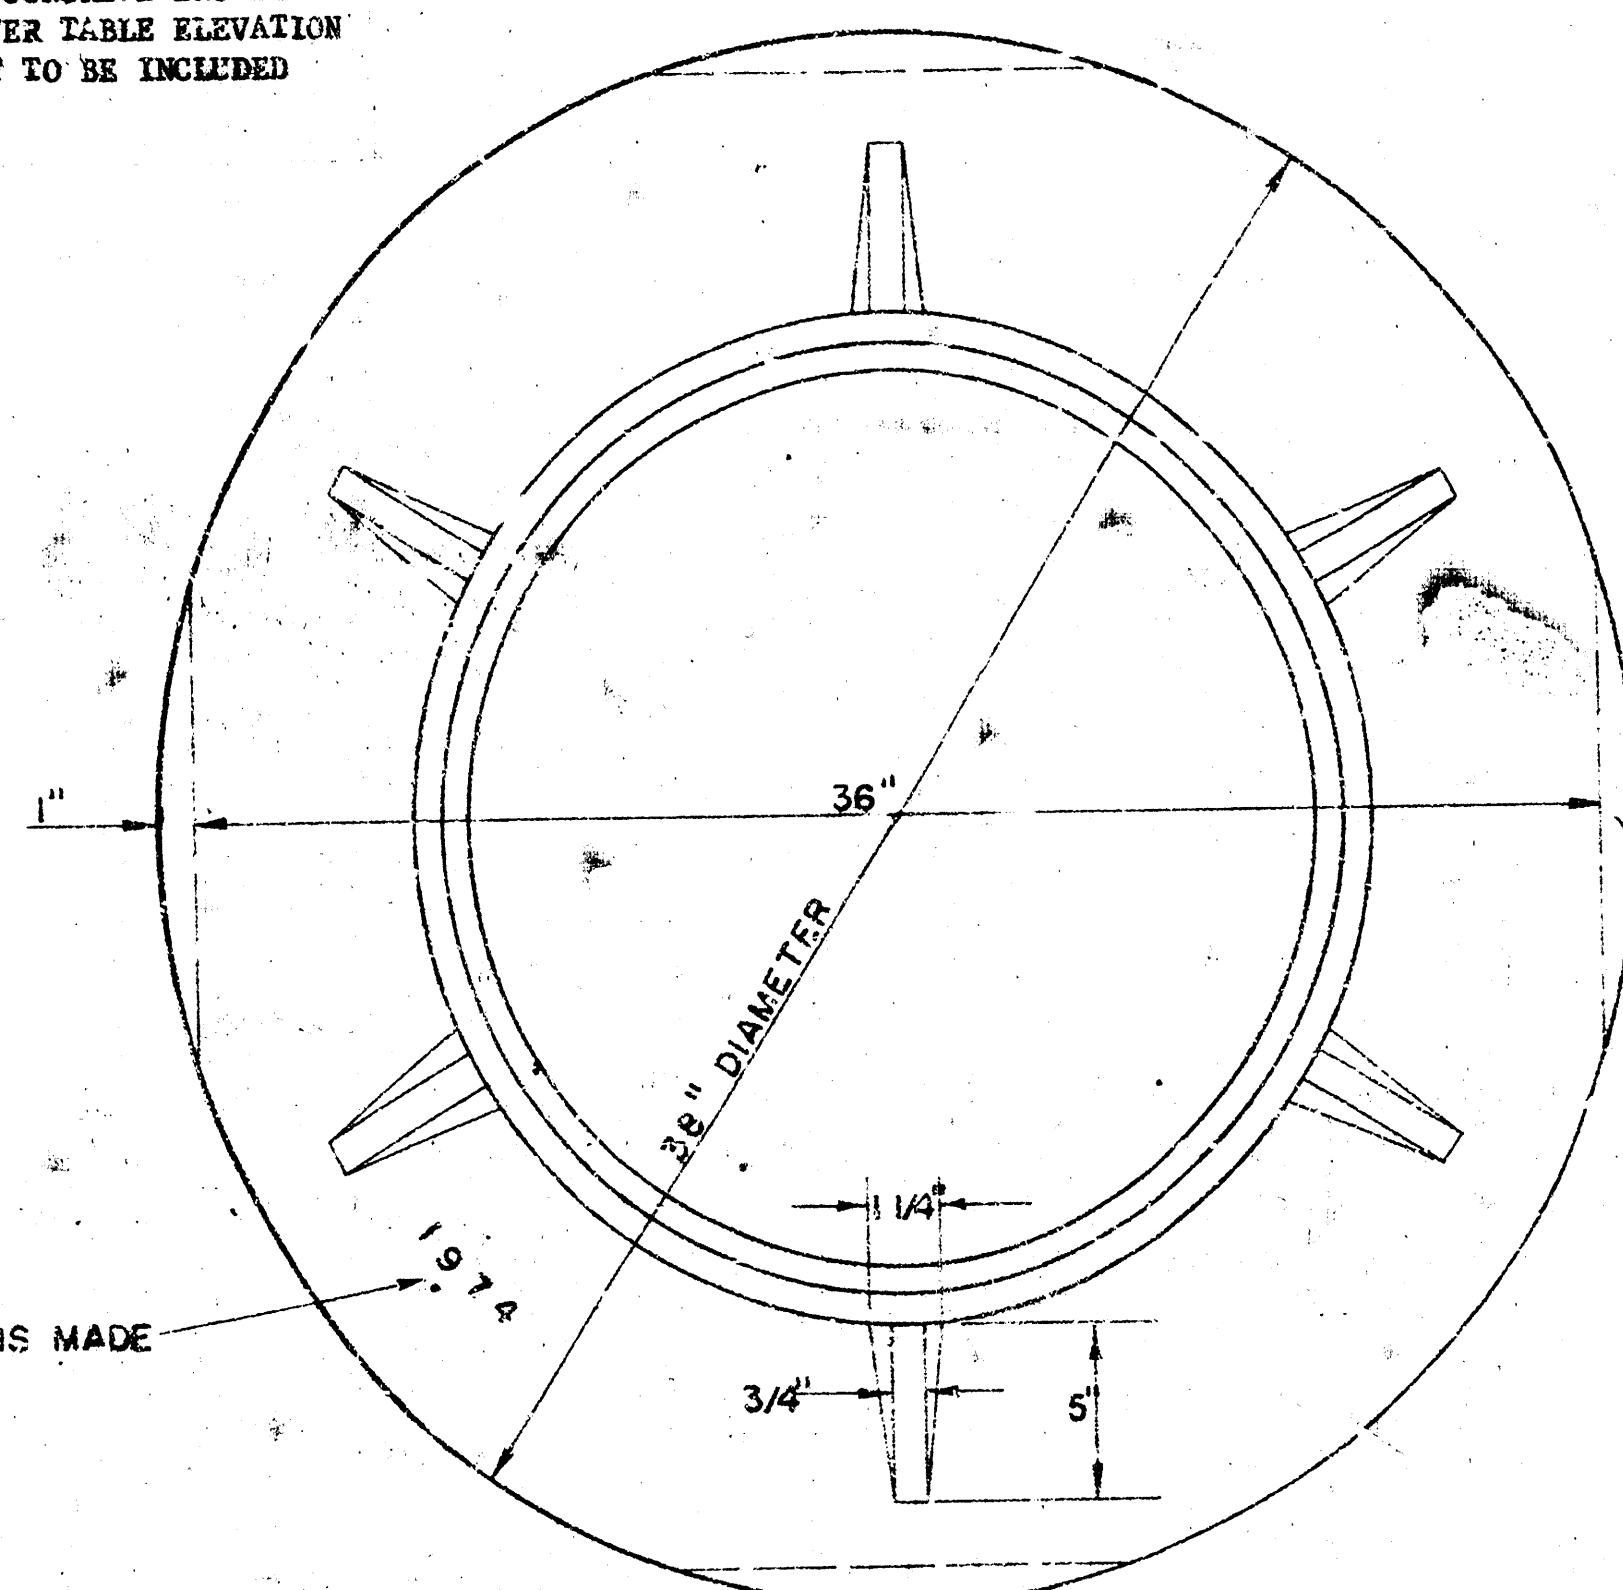


MANHOLE RING


* WEIGHT 325 LBS. RING NO. 500A
WEIGHT 800 LBS. RING NO. 500AS

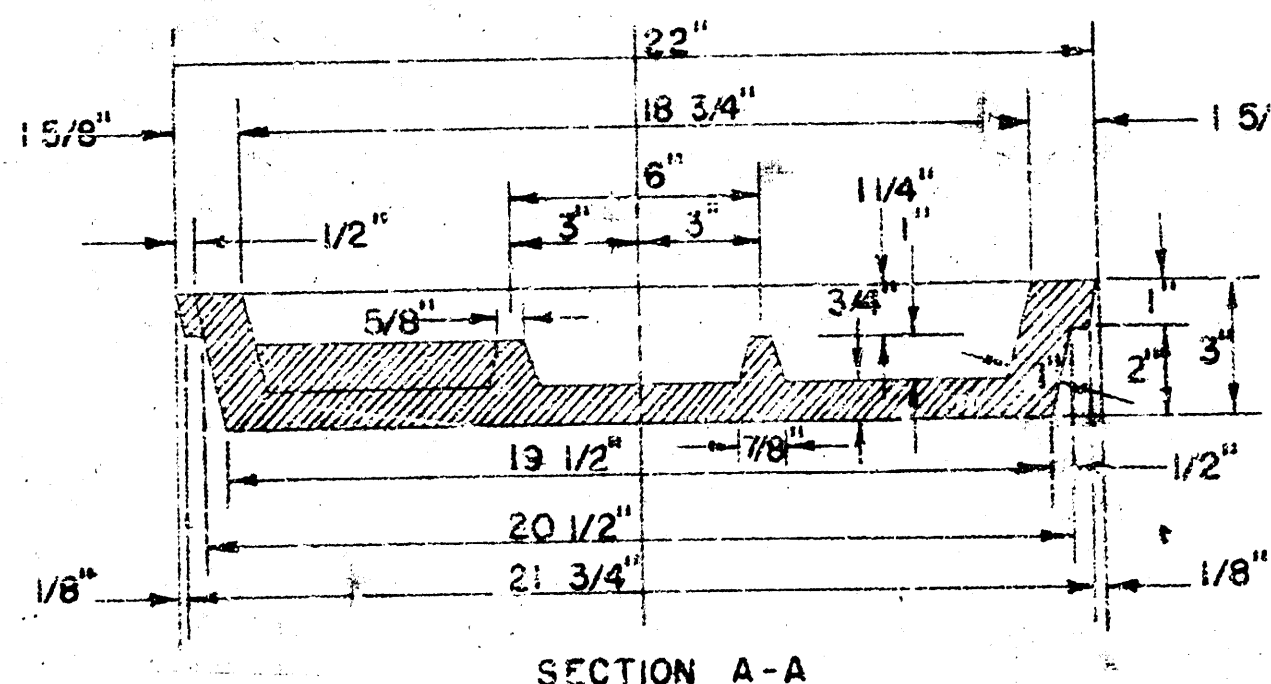

MANHOLE COVER

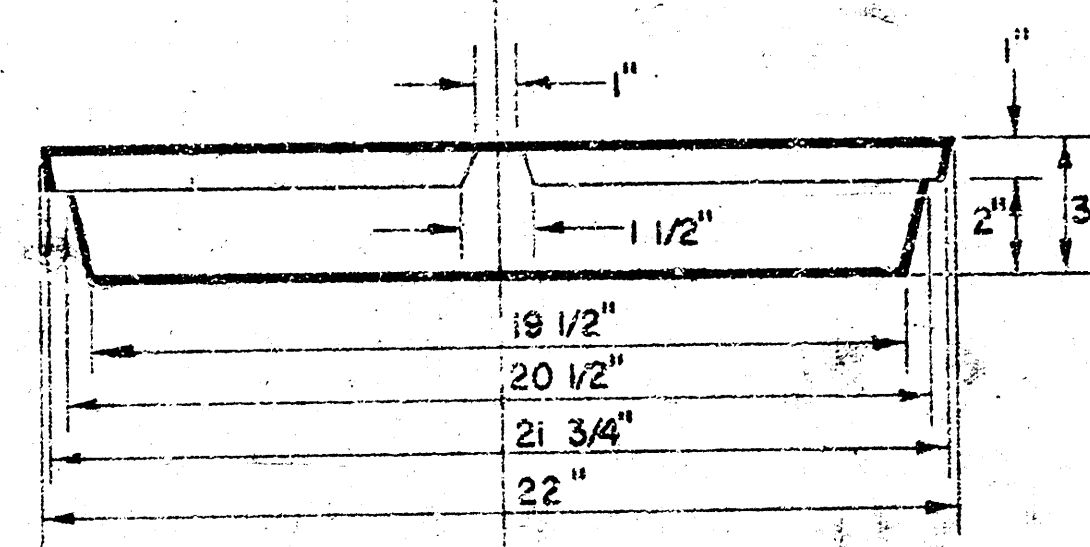


MANHOLE COVER


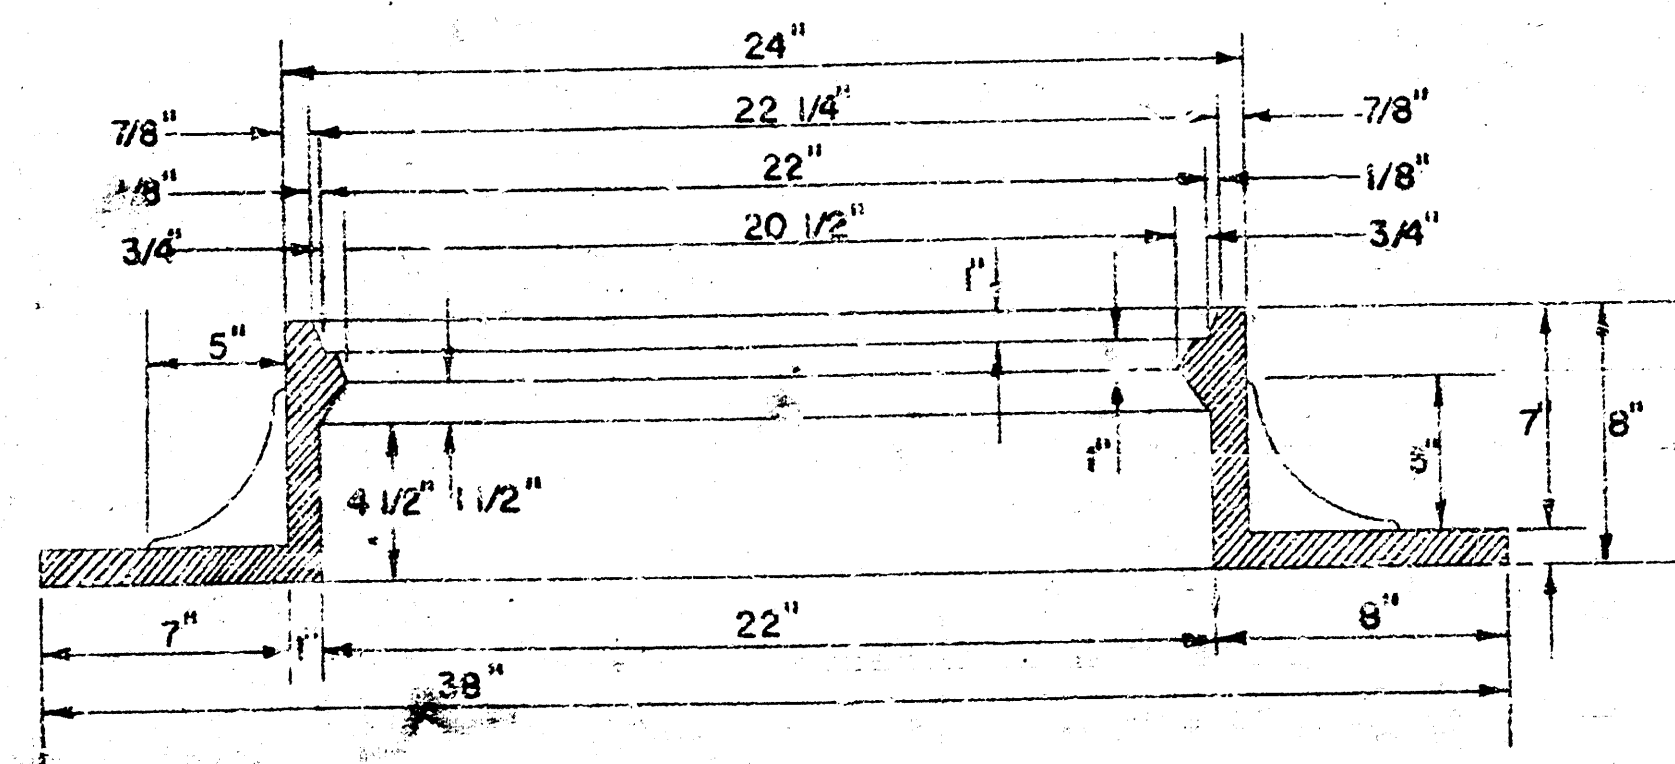


MANHOLE RING


OUTSIDE CIRCUMFERENCE OF COVER
AND THE INNER FACE AND SEAT OF
RING TO BE MACHINE FIT.

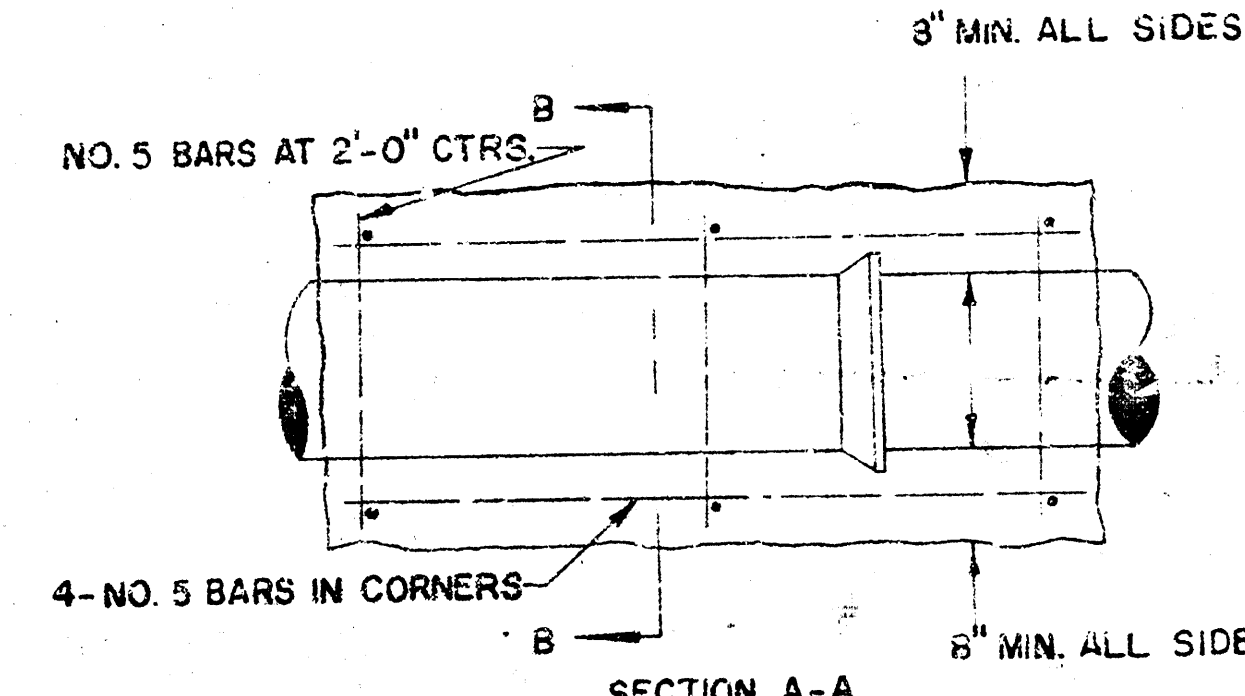

REINFORCED CONCRETE ENCASEMENT
FOR STRENGTH

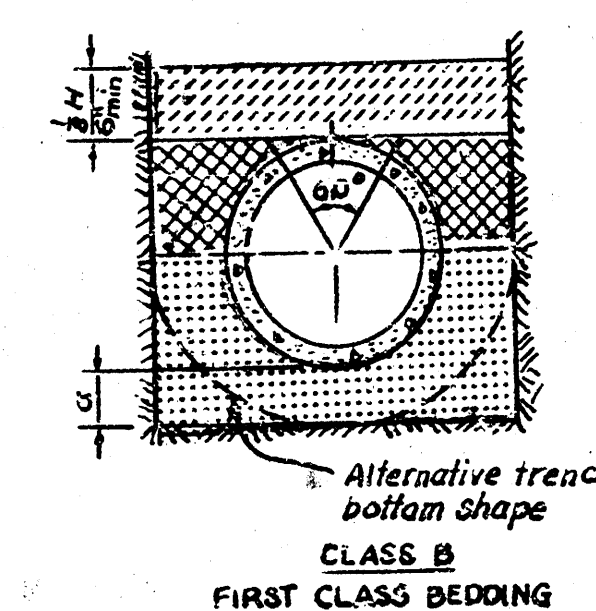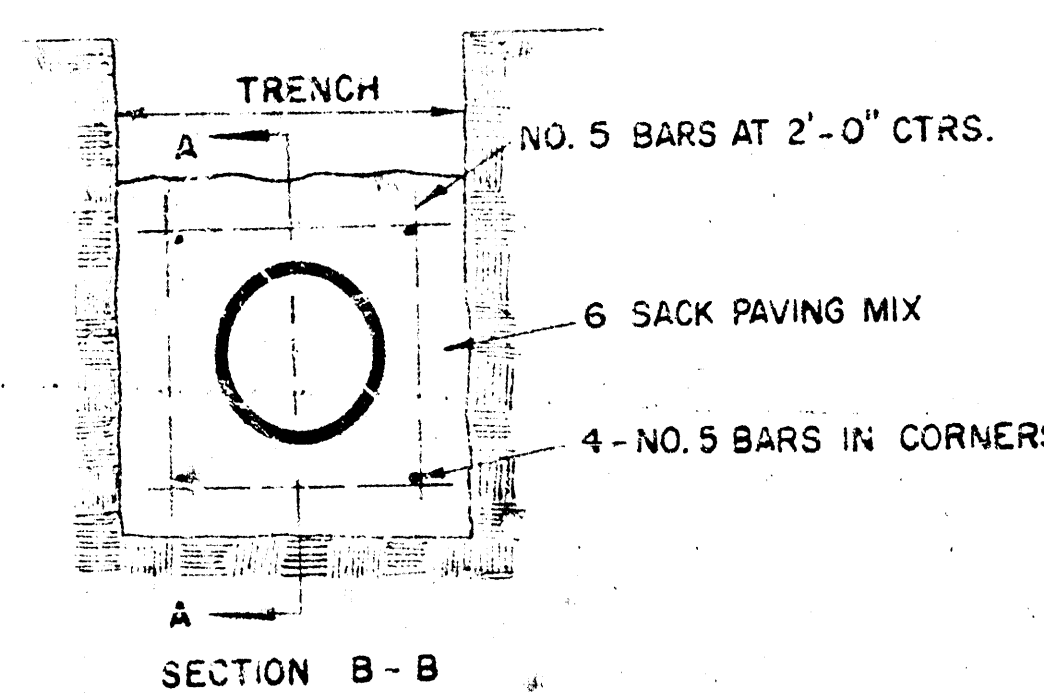

REINFORCED CONCRETE ENCASEMENT

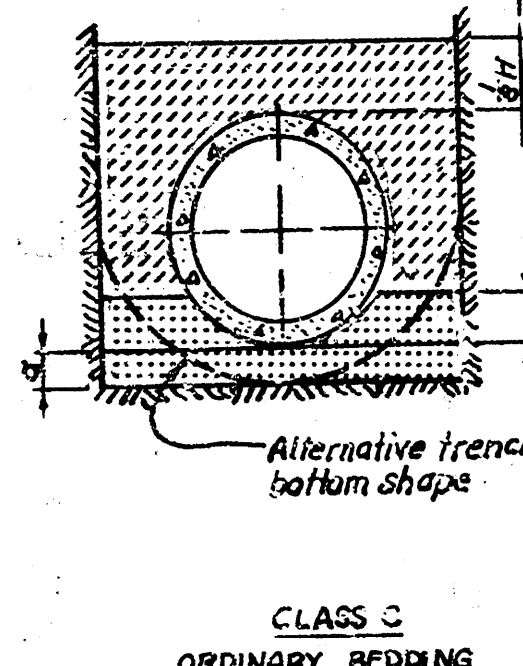

REINFORCED CONCRETE ENCASEMENT

NOTES:
Granular fill to be crushed stone or gravel with not less than 95% passing 1/2 inch, not less than 95% passing 3/4 inch, and not less than 95% passing 1 inch. It shall be placed in not more than 6 layers and compacted by tamping with a shovel.

Tamped backfill shall be finely divided, jagged, non-spherical material free from debris, organic material, and stones, compacted to 95% maximum density as determined by AASHTO Standard Method T-99. Granular fill may be substituted for all or part of tamped backfill.

Hand placed backfill shall be finely divided material free from debris and stones.

LEGEND
Bc Outside diameter of pipe
H Backfill cover above top of pipe
D Nominal pipe size
a Fill below pipe (See table)

Hand placed backfill
Tamped backfill
Granular fill
Concrete

EMBEDMENTS FOR CONDUITS

D	Min. Soil	Min. Rock
24" & smaller	3"	6"
30" to 60"	4"	9"
60" & larger	5"	12"

DETAILS OF
SEWER APPURTENANCES
ADOPTED AS STANDARD DESIGN
BY
ENGINEERING DIVISION
CITY OF WICHITA, KANSAS
R. W. LINN CITY ENGINEER
1974

MAIN 5, S. W. INT. SEWER
SHEET NO. 17 OF 17

FILMED FROM THE BEST