
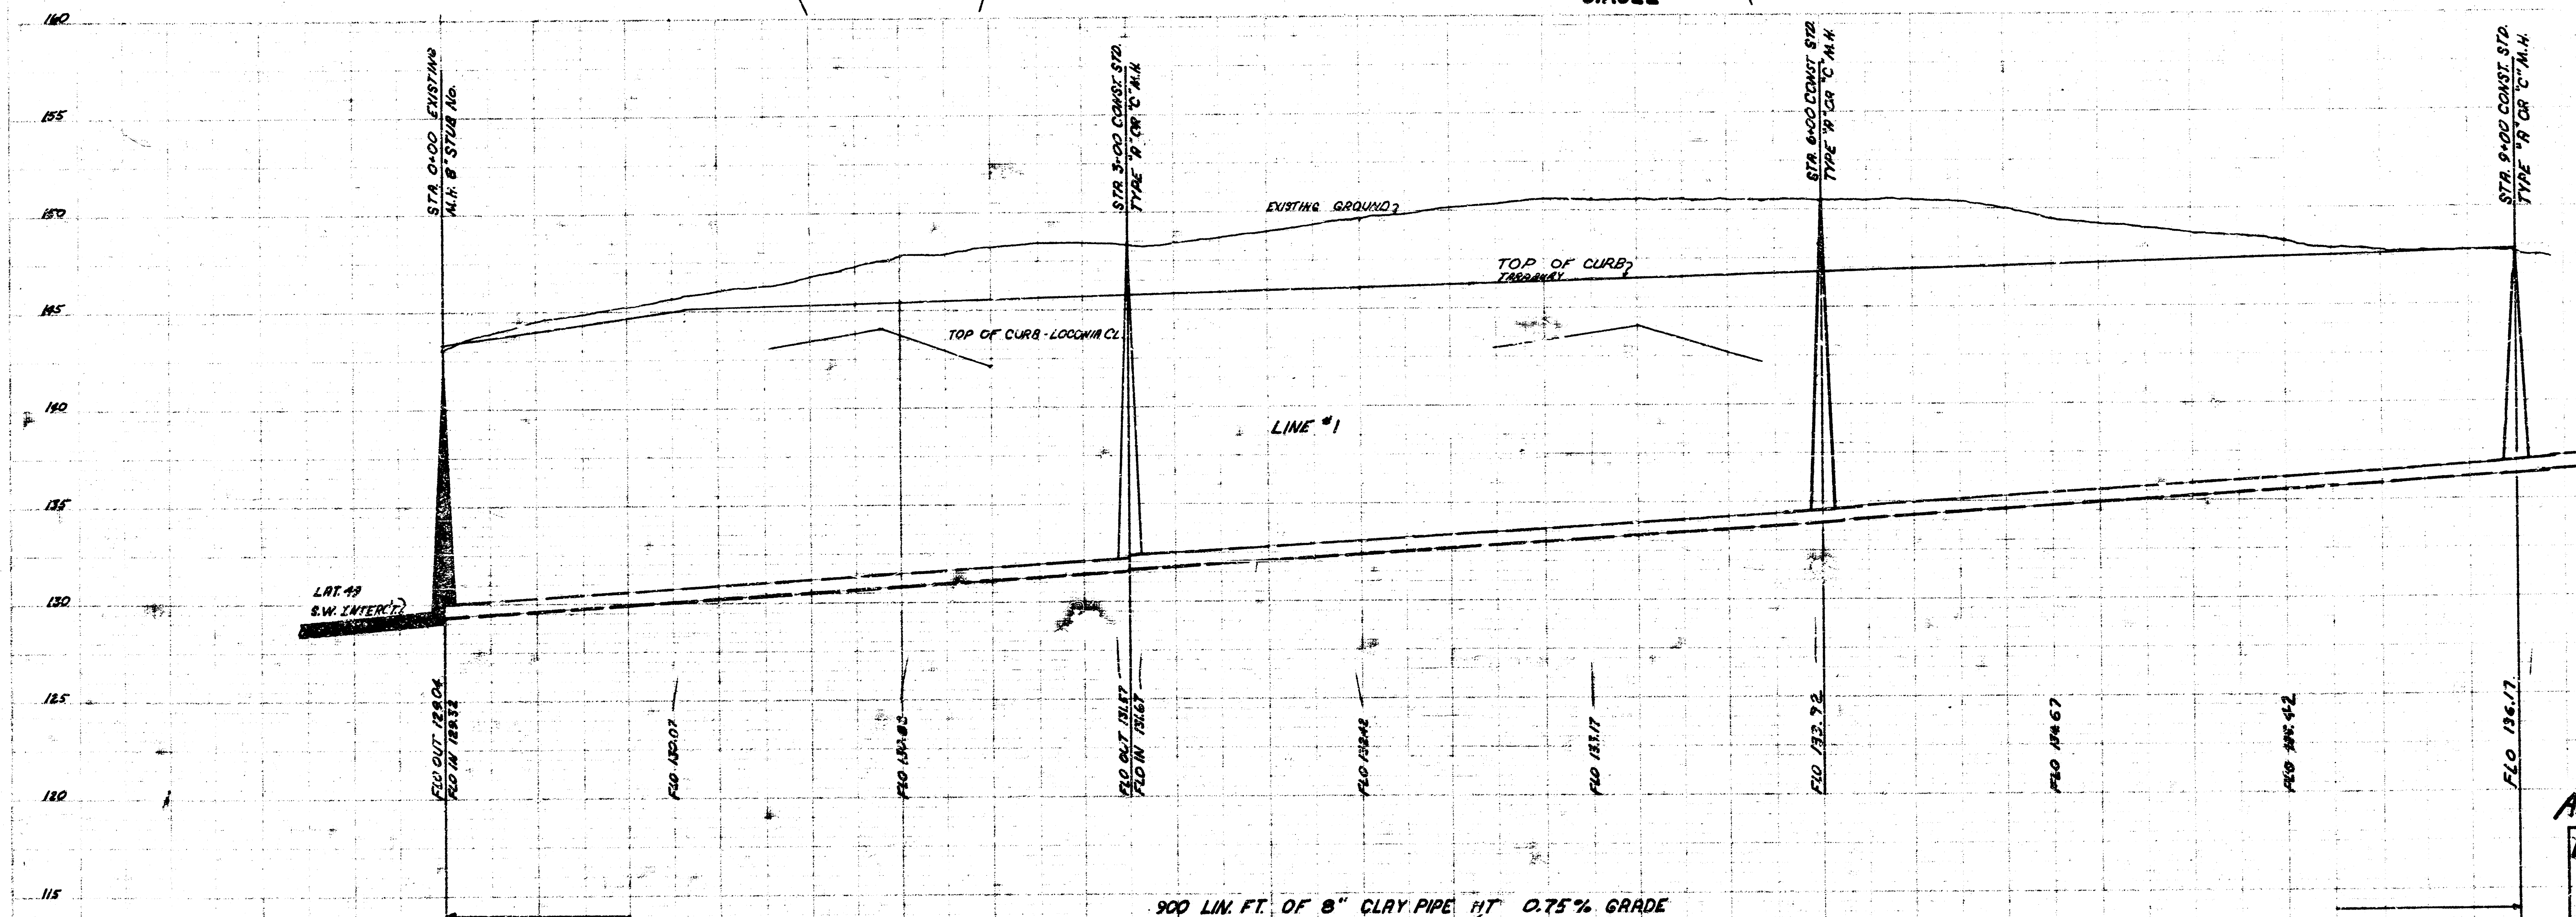


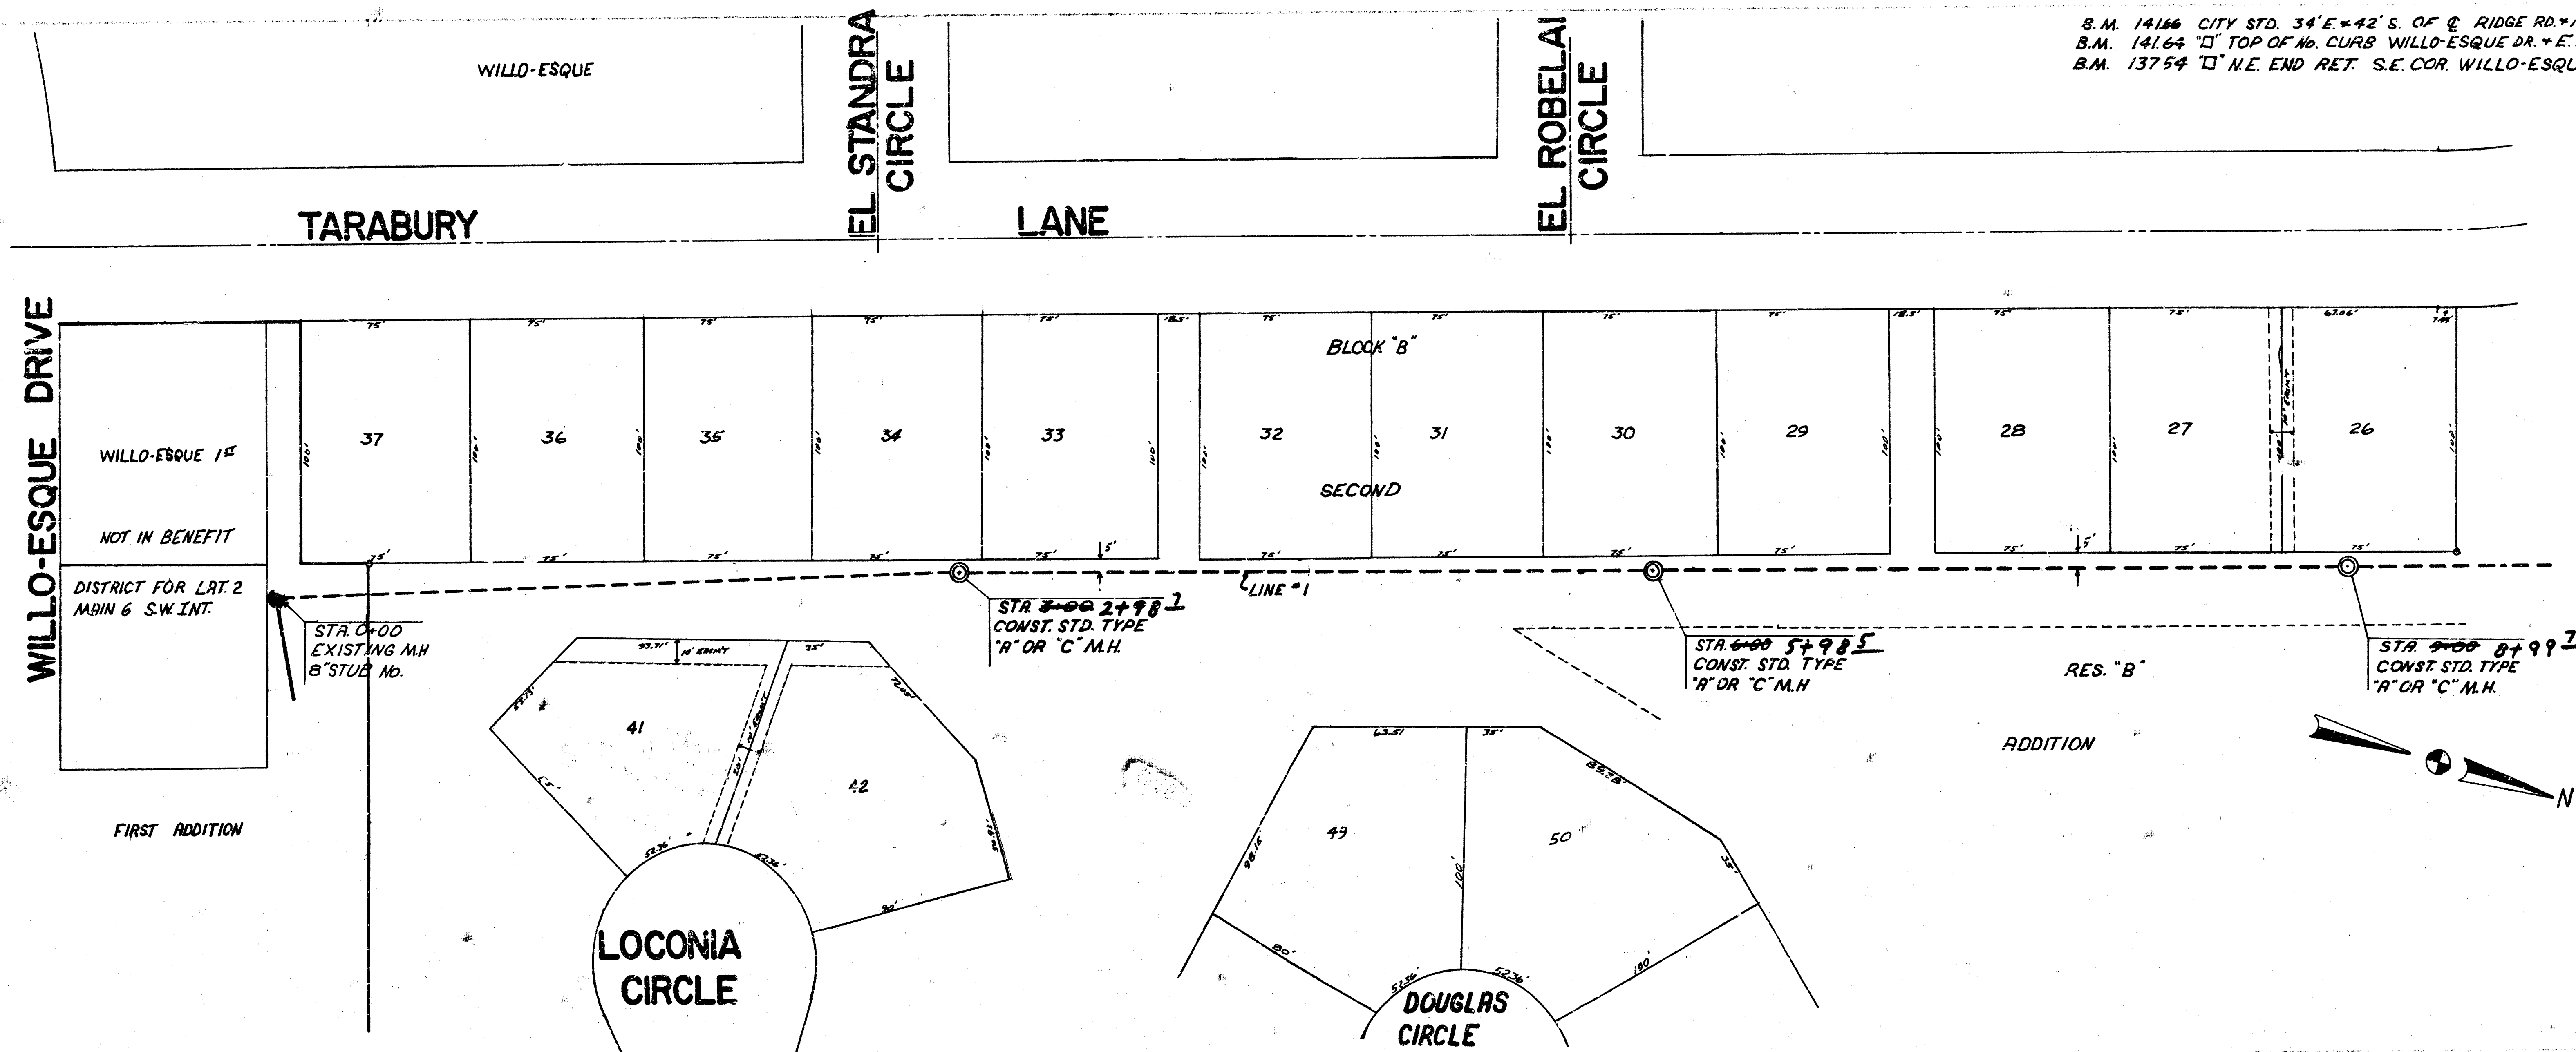

As Built Pk. 6-1



LAT. 2 MAIN 6 S.W. INTERCEPT

CITY OF WICHITA, KANSAS

R.W. LINN - CITY ENGINEER

DATE: PROJ. NO. DBKL 573030



SHEET 1 OF 5 LINE "1"

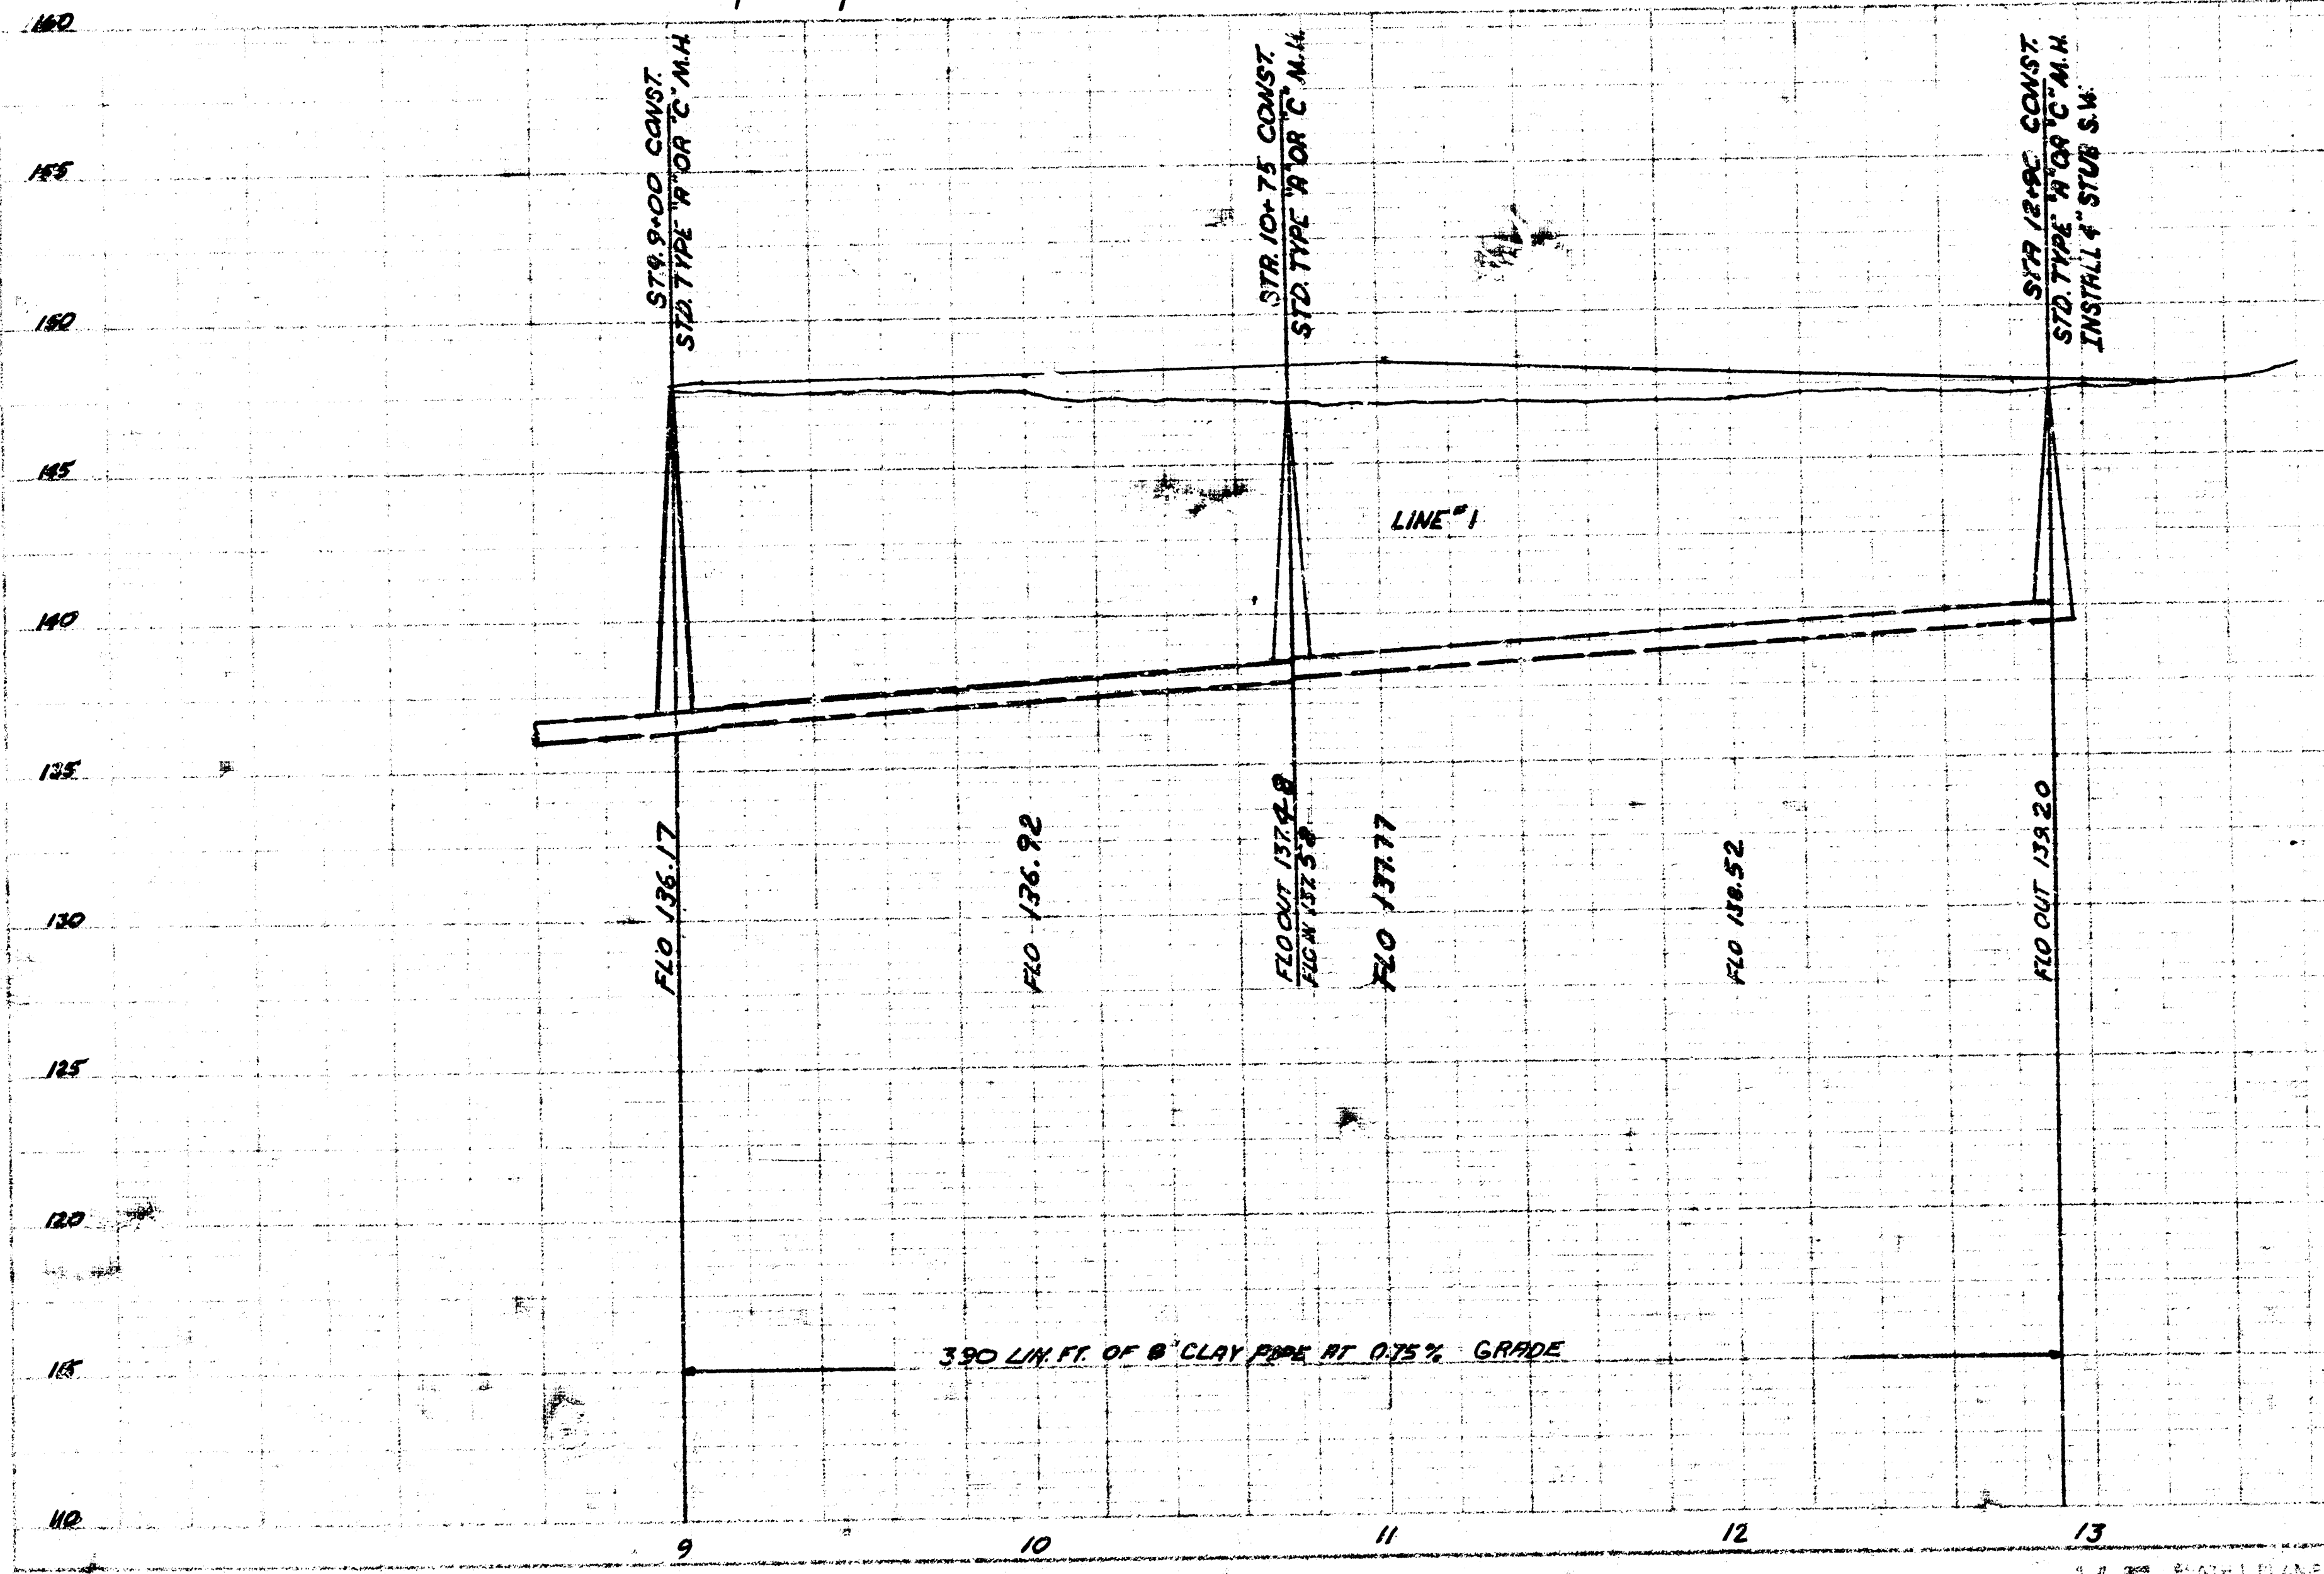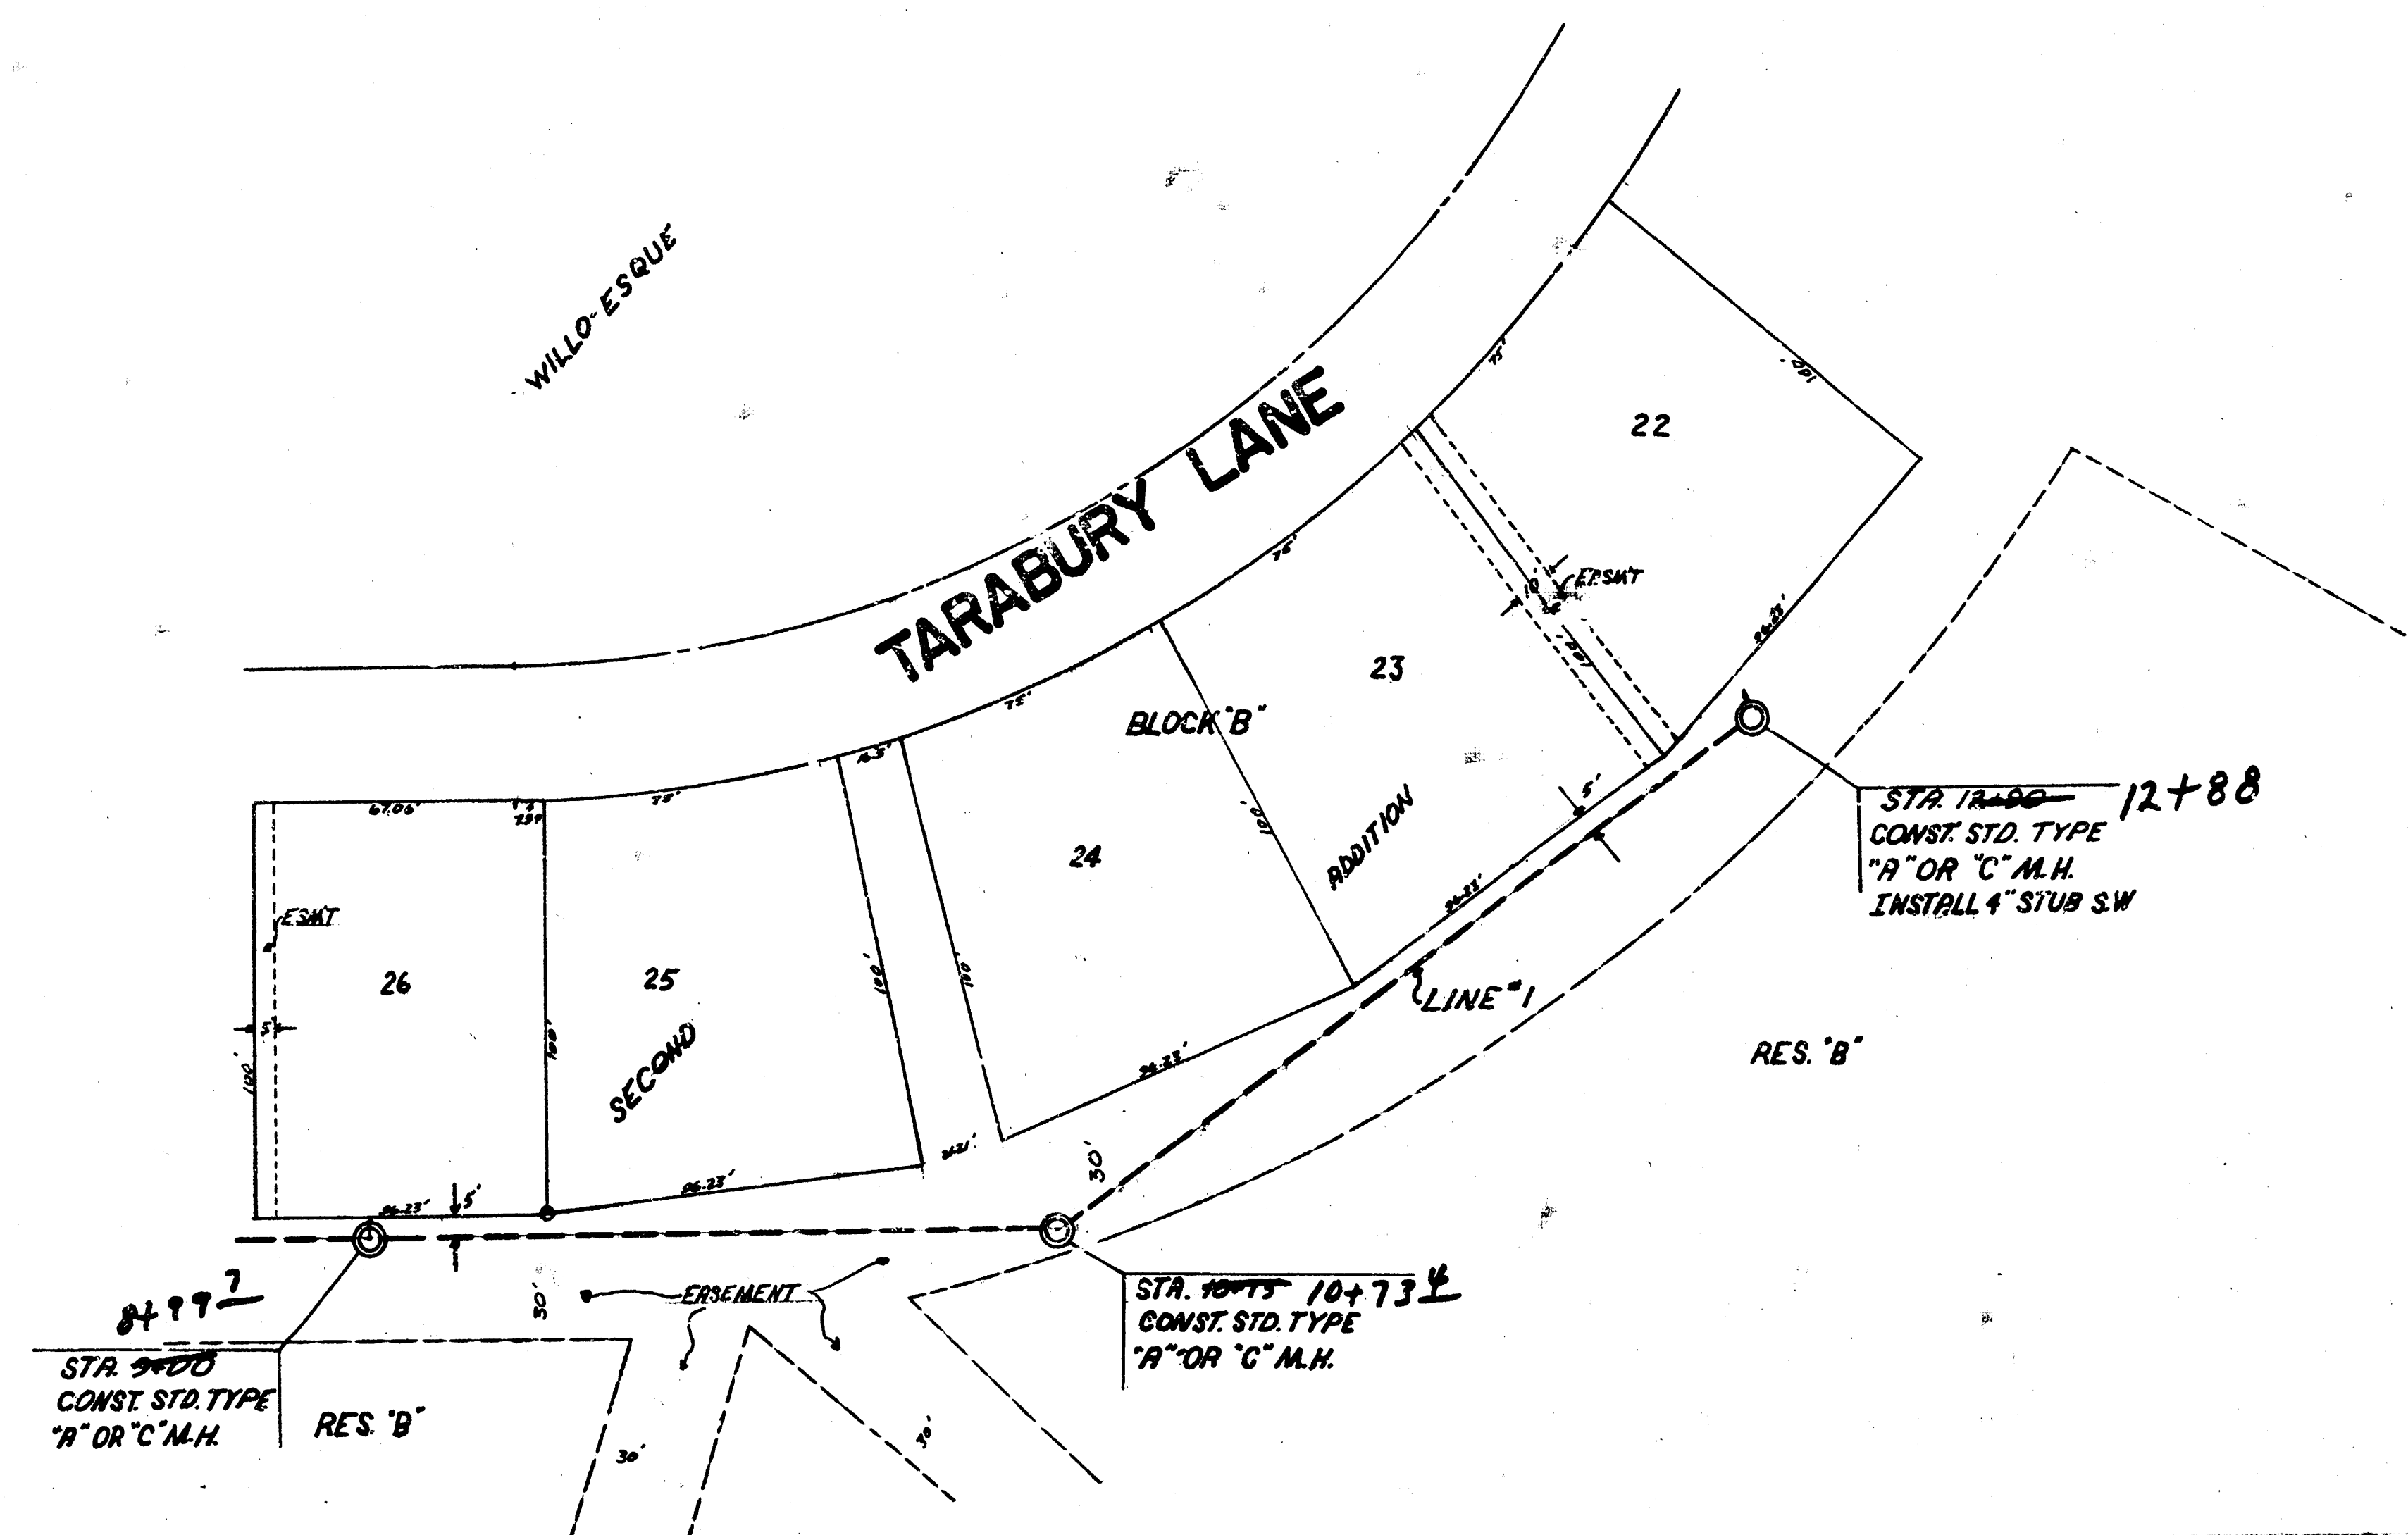


SCALES:
 PLAN: 1"=40'
 PROFILE: 1"=40'
 VERT: 1"=5'

LAT. 2 MAIN 6 S.W. INTERCEPTOR
 PROJ. NO. DBKL 573030
 LINE NO. 1 SHEET 2 OF 5

PREPARED BY: [illegible]
 CHECKED BY: [illegible]
 DATE: [illegible]

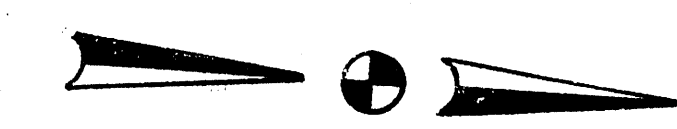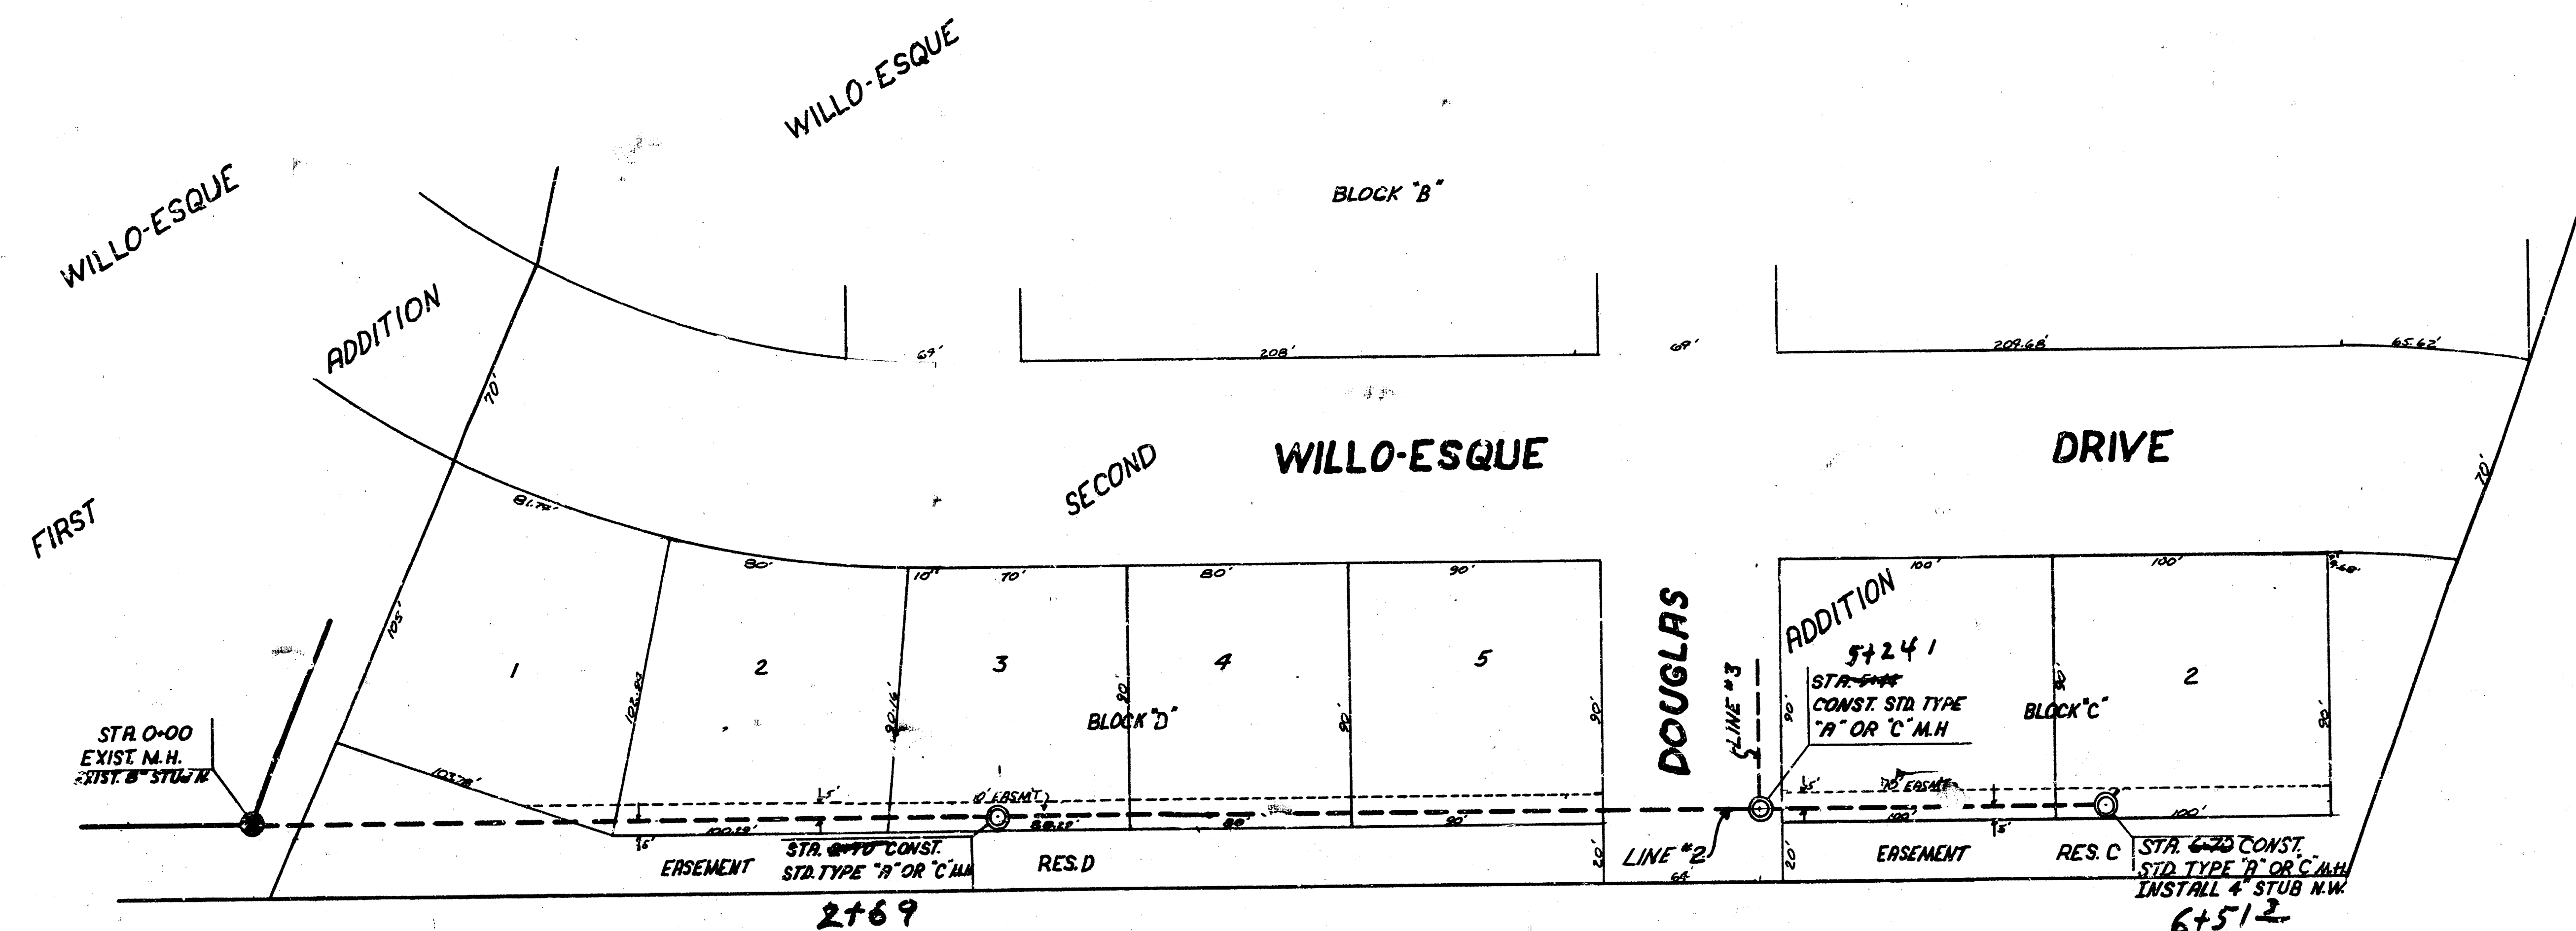


SCALE
PLAN: 1"=40'
PROFILE: HORIZ. 1"=40'
VERT. 1"=5'

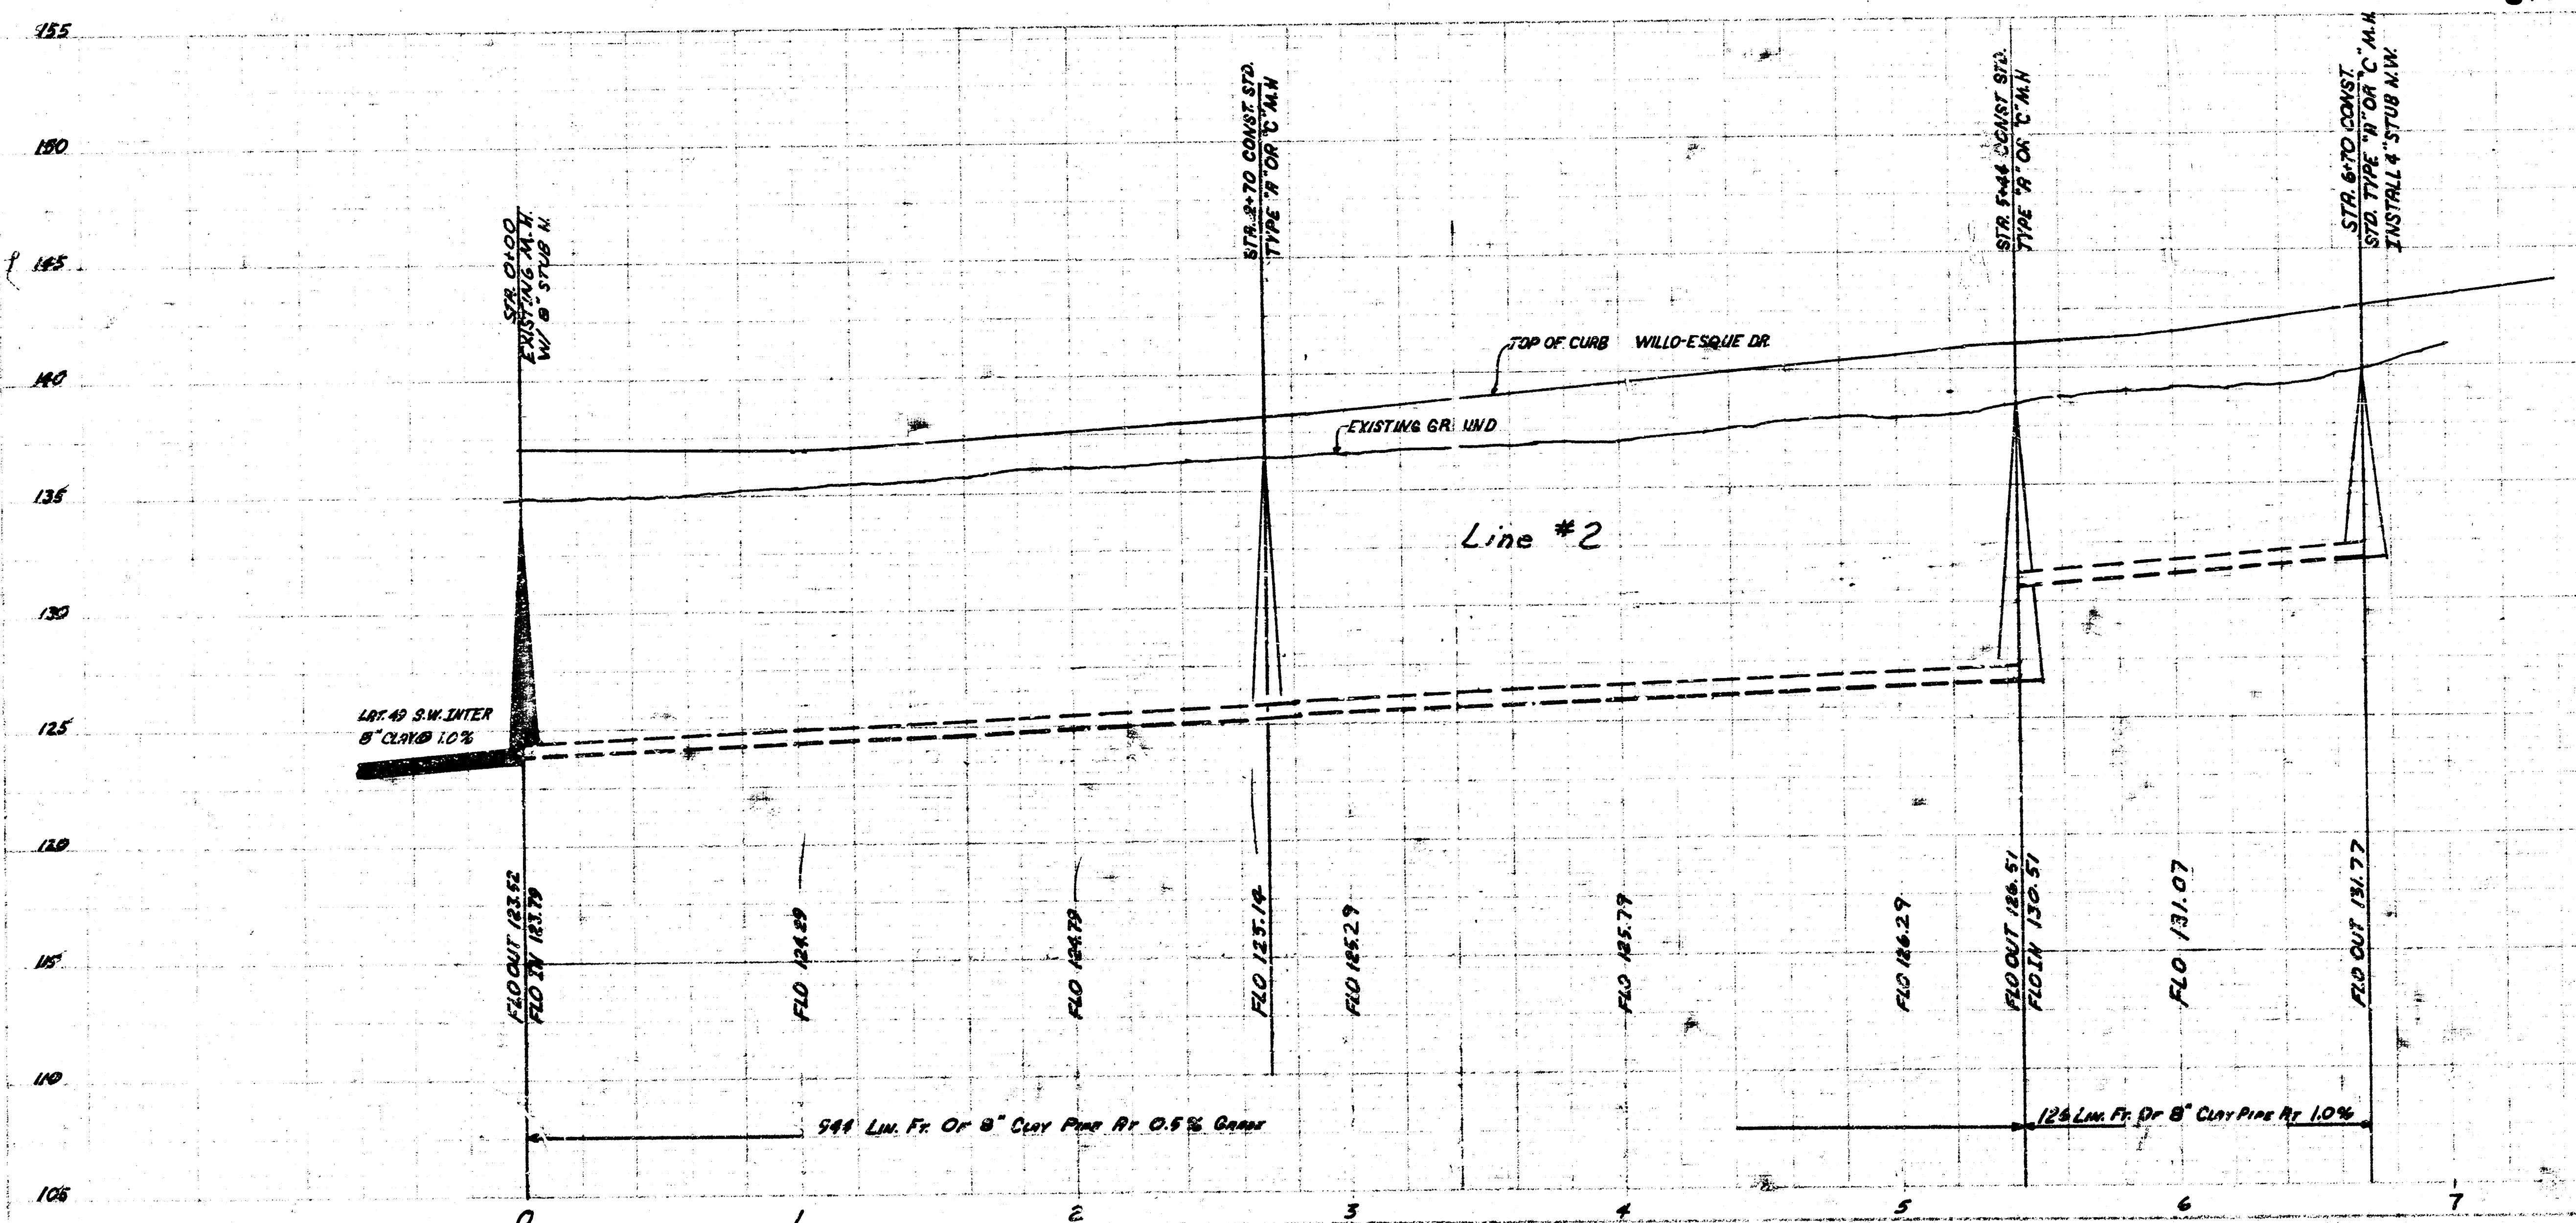


LINE 2, MAIN 6, S.W. INTERCEPTOR
LINE #2 PROJ. NO. DAKL573030
SHEET 3 OF 5


3/5

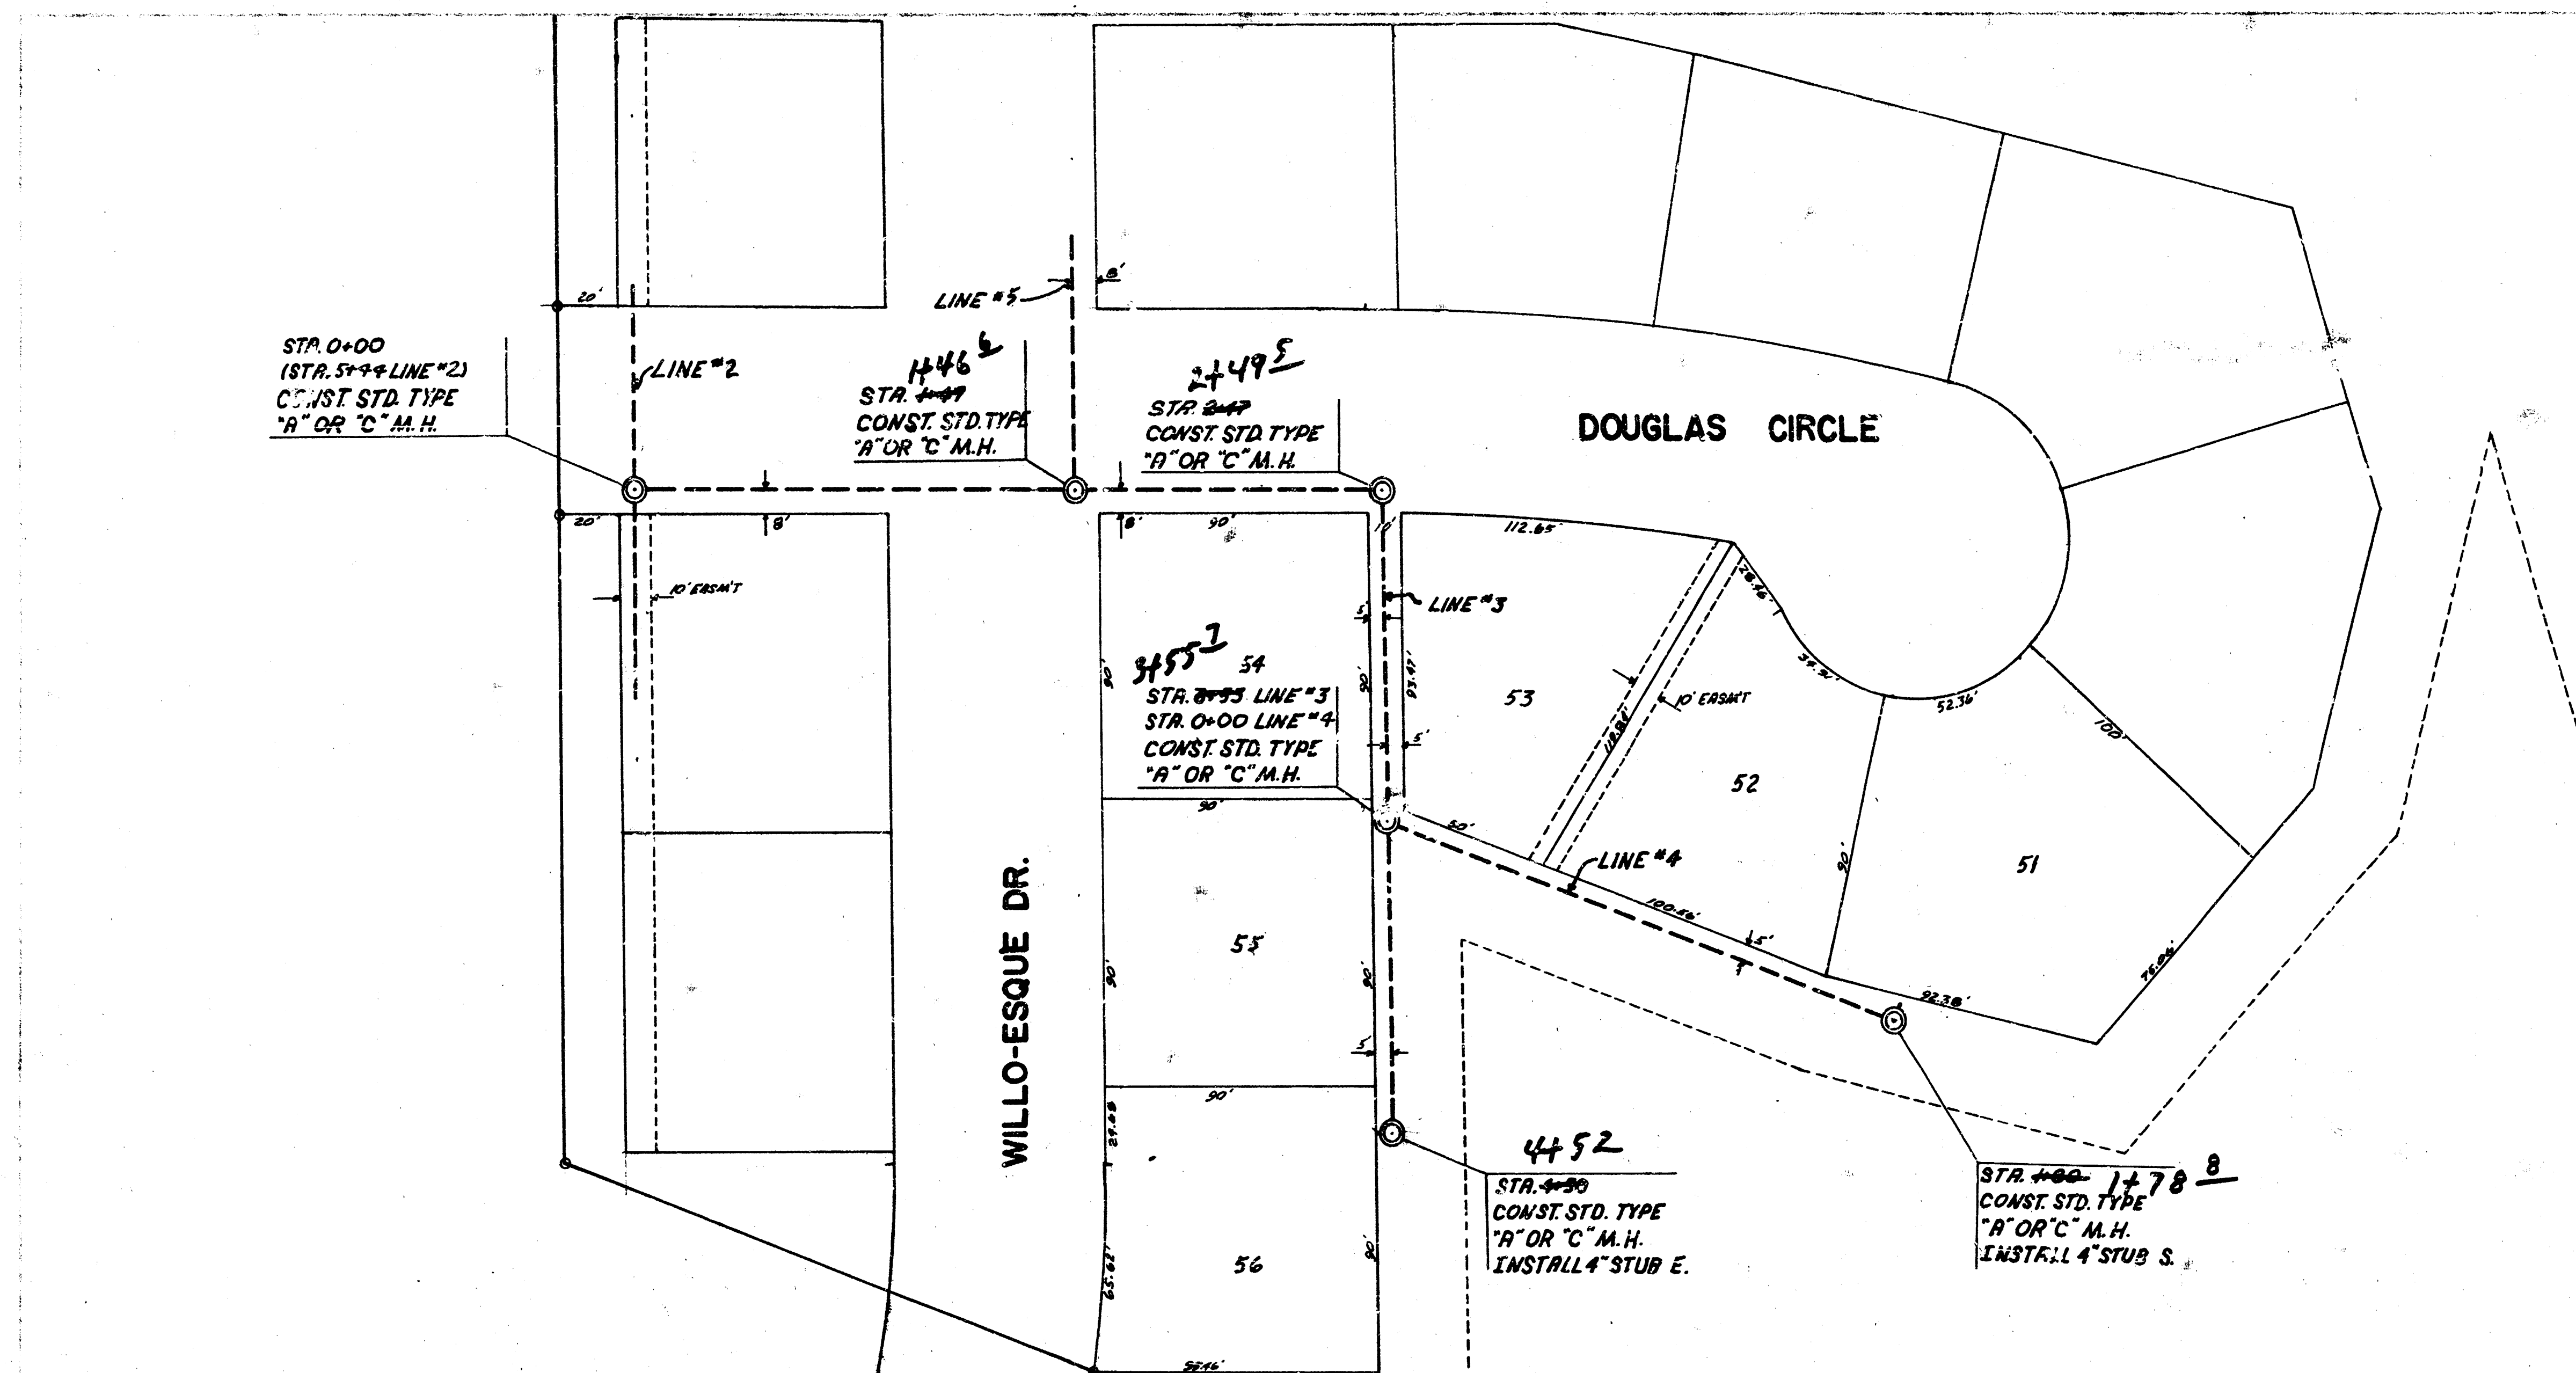


SCALE:
PLAN: 1"=40'
PROFILE: 1"=40'
HORIZ: 1"=40'
VERT: 1"=5'

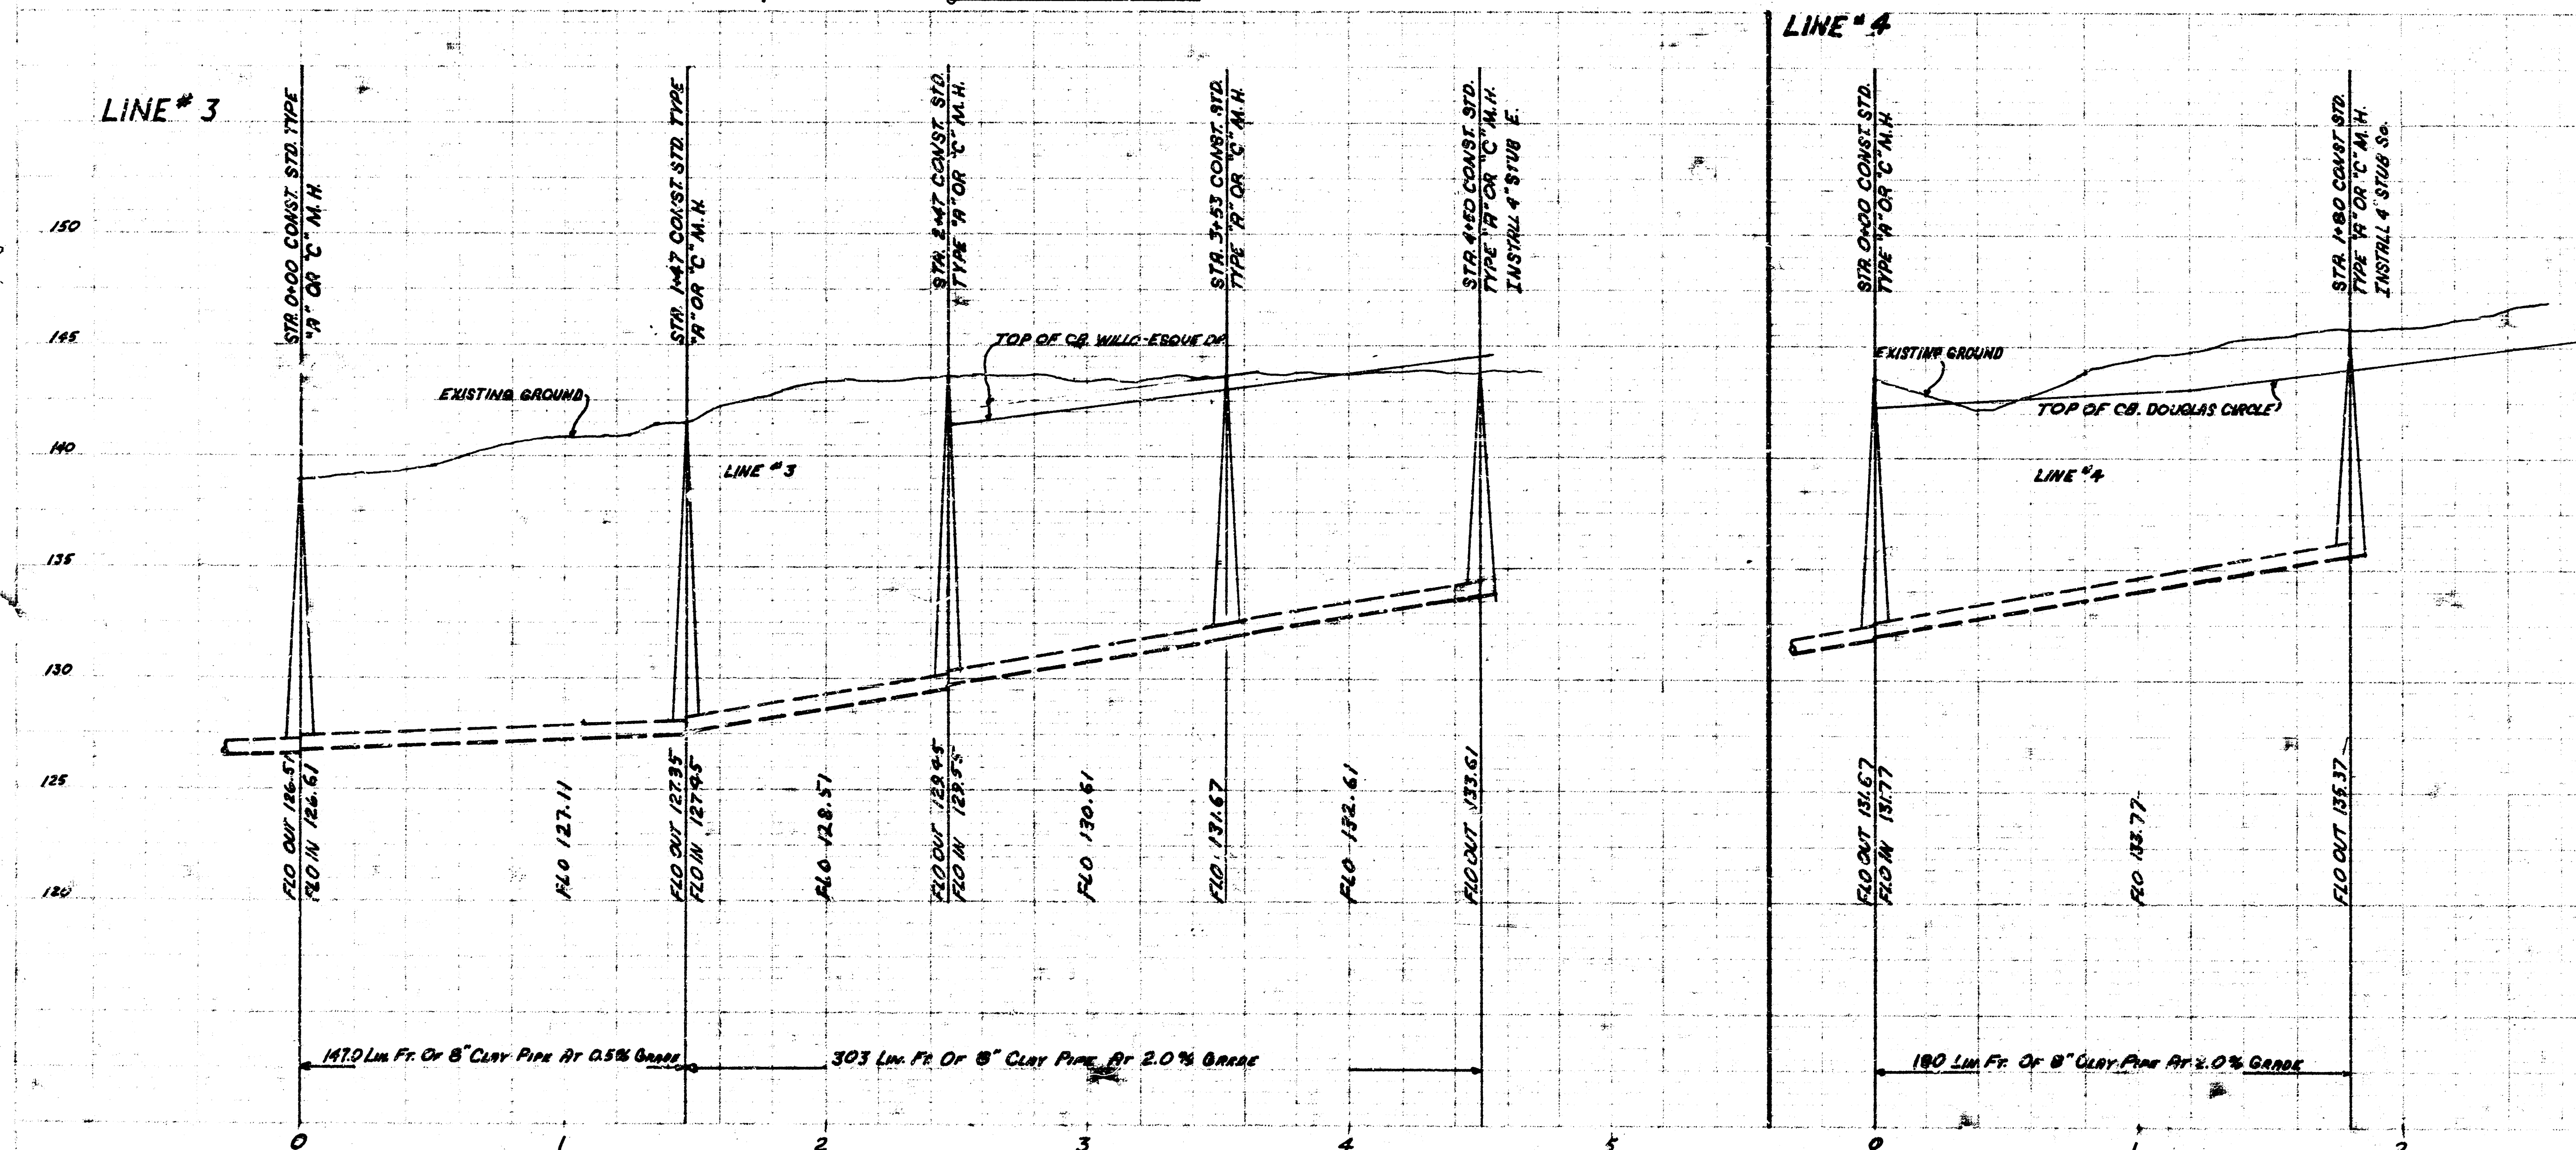

LAT. 2 MAIN 6 S.W. INTERCEPTOR
LINES 3+4 PROJ. NO. DBKL573030
SHEET 4 OF 5

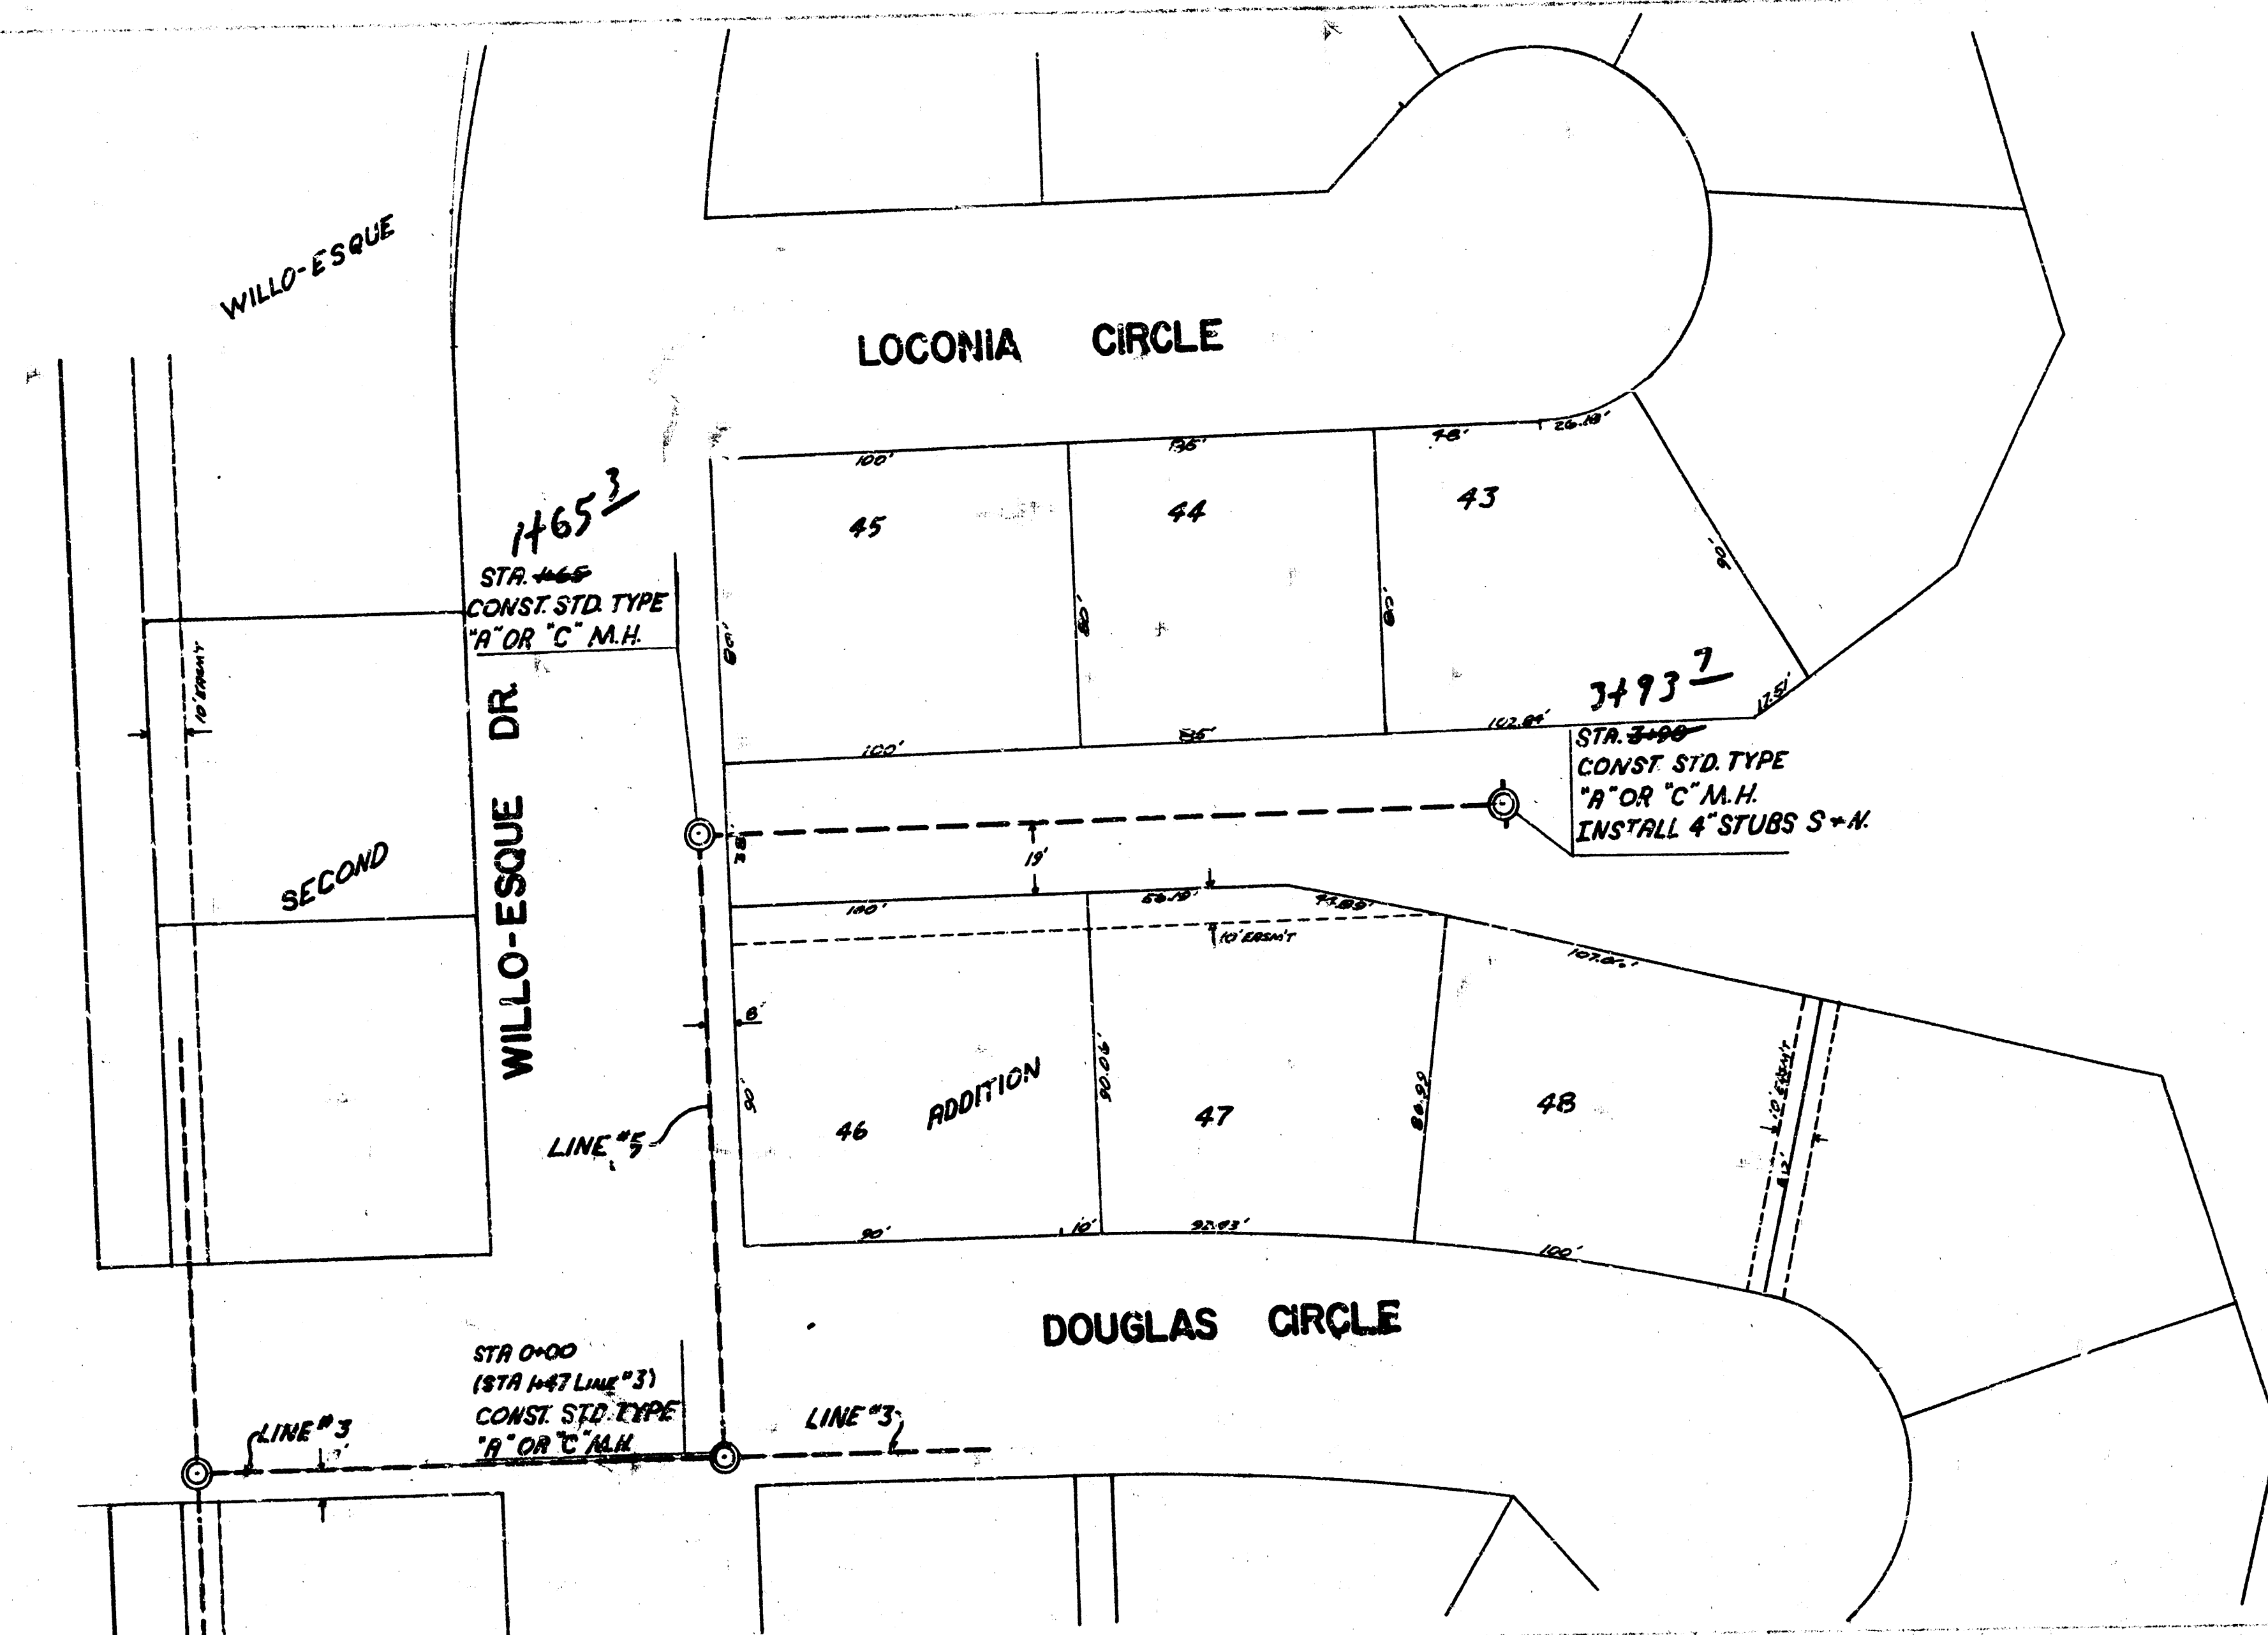

SCALE
PLAN 1"=40'
PROFILE 1"=40'
VERT 1"=5'

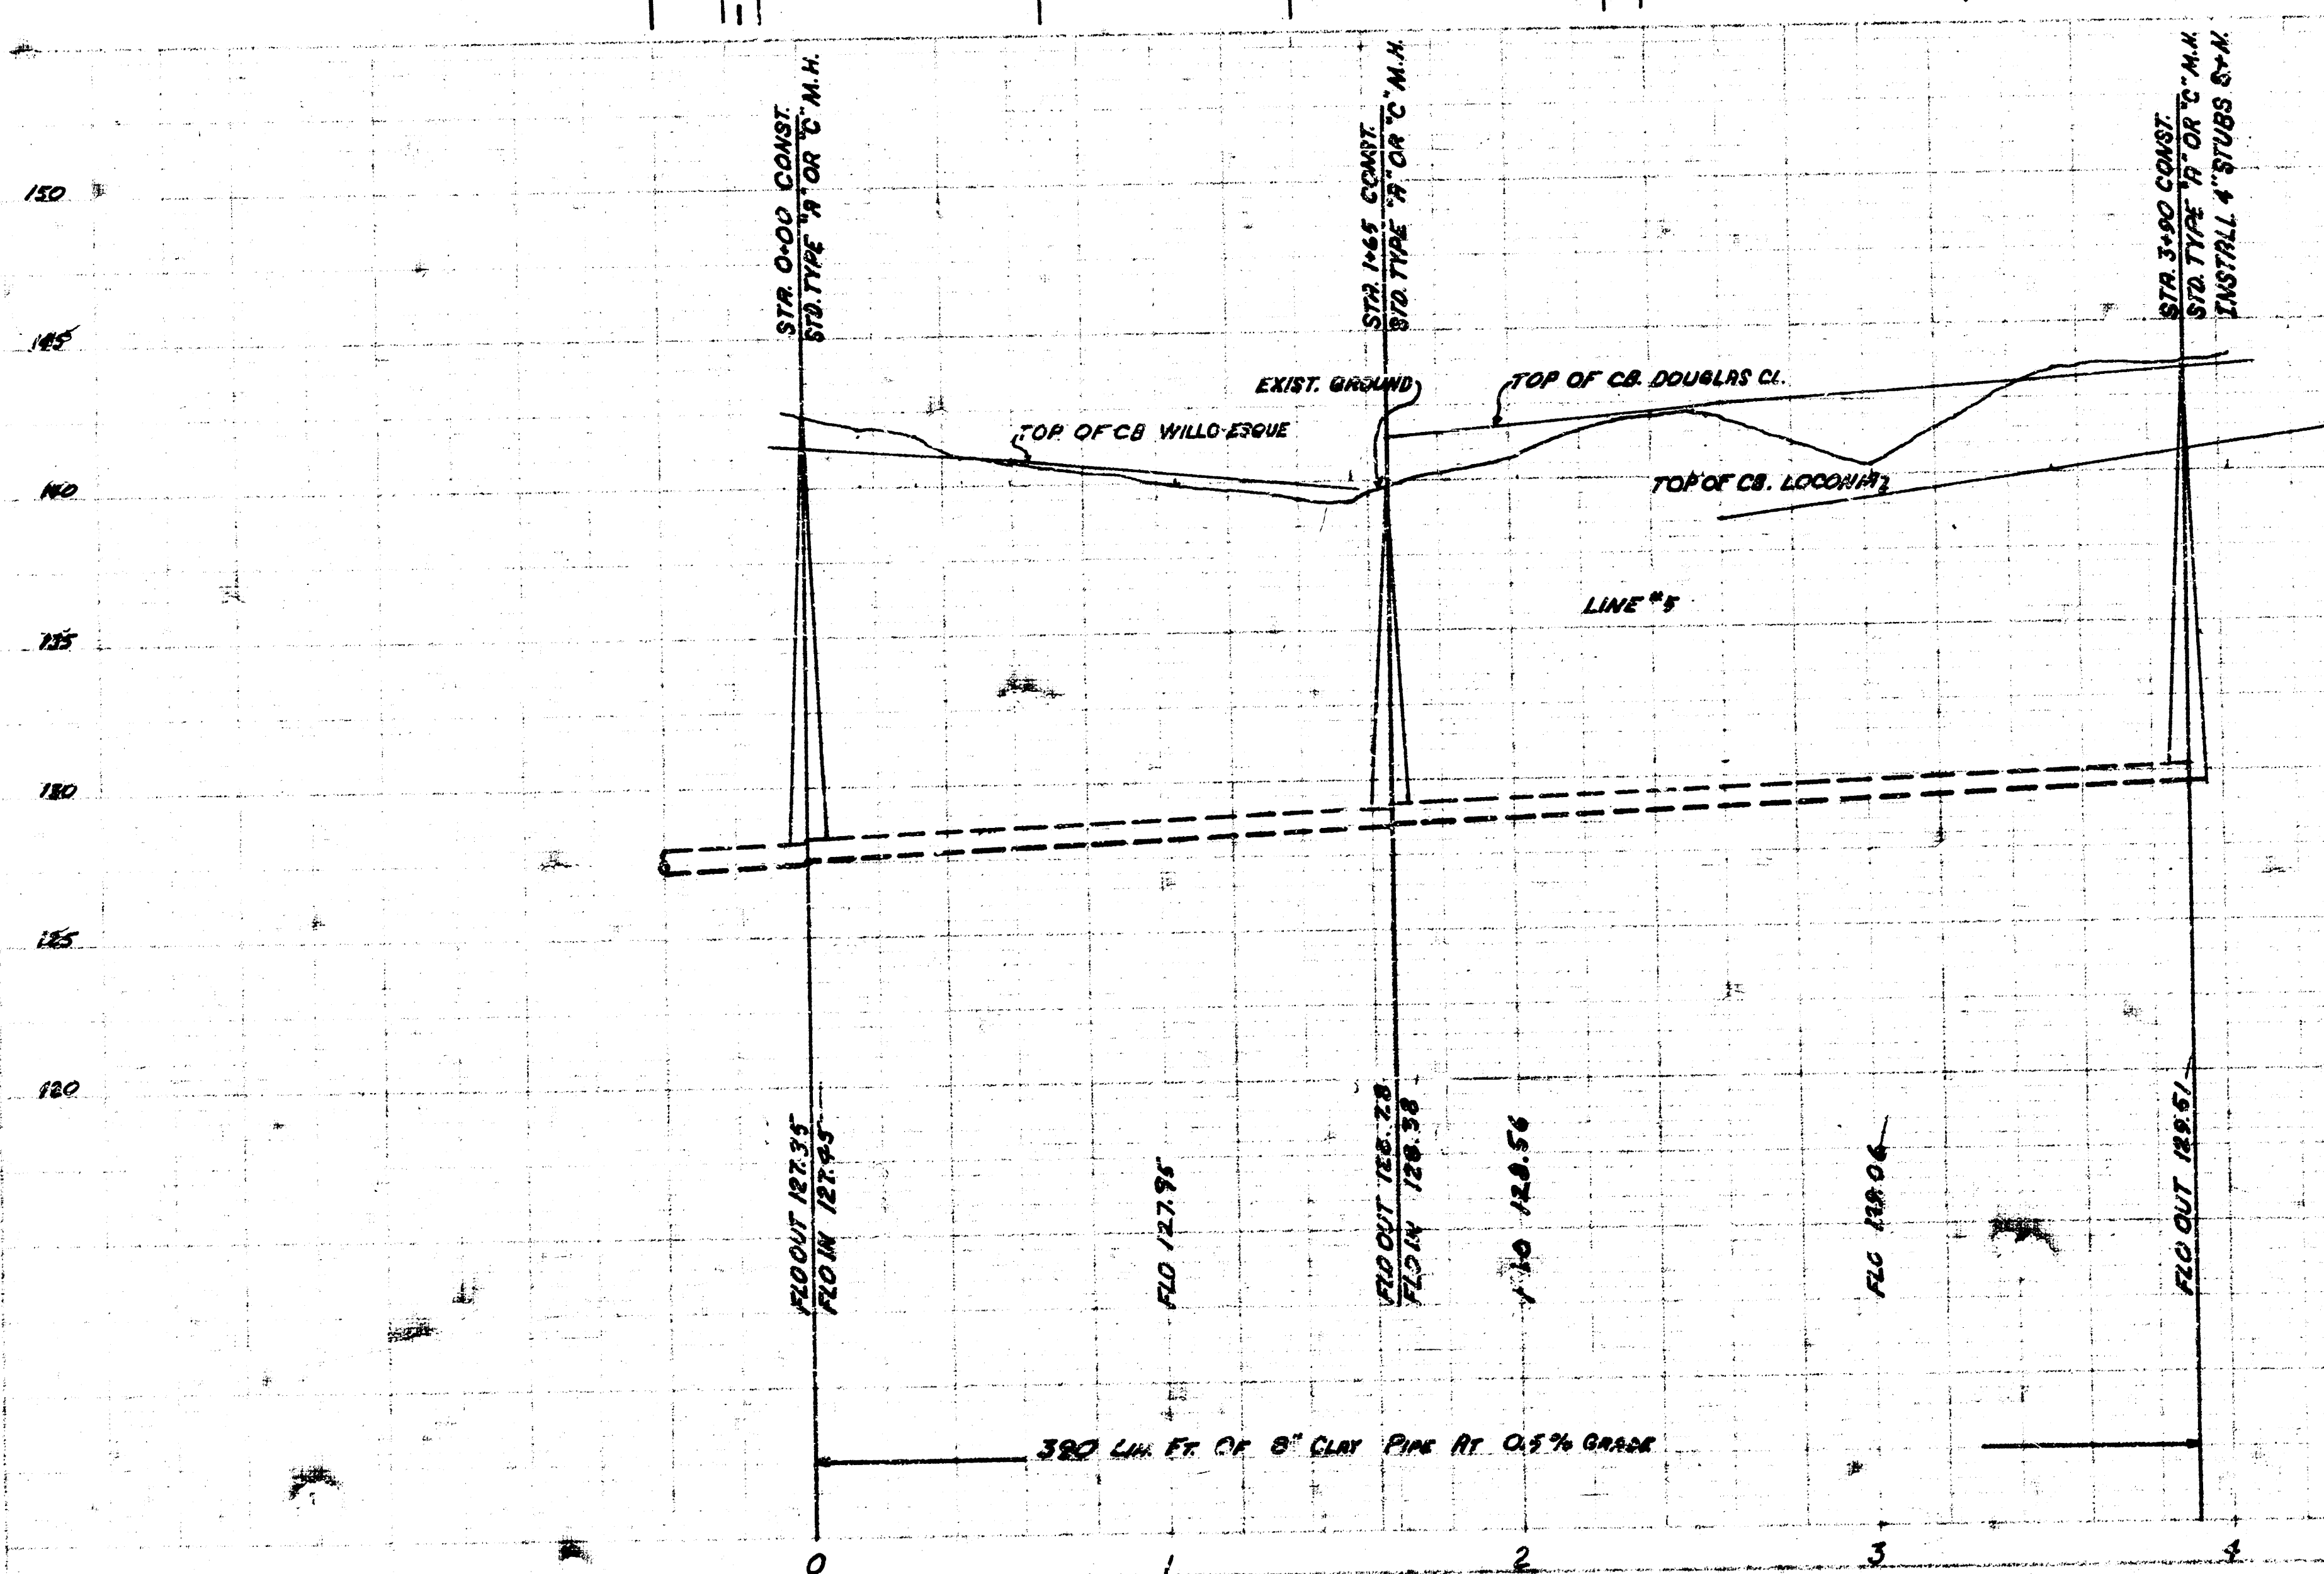

LAT. 2 MAIN 6 S.W. INTERCEPTOR
LINE 5
PROJ. NO. DBKL573030
SHEET 5 OF 5

5/5