


LAT 3, MAIN 6, SOUTHWEST INTERCEPTOR

CITY OF WICHITA, KANSAS

R. W. LINN — CITY ENGINEER

PROJECT NO. DBKL575048


*As Built 7-12-76*

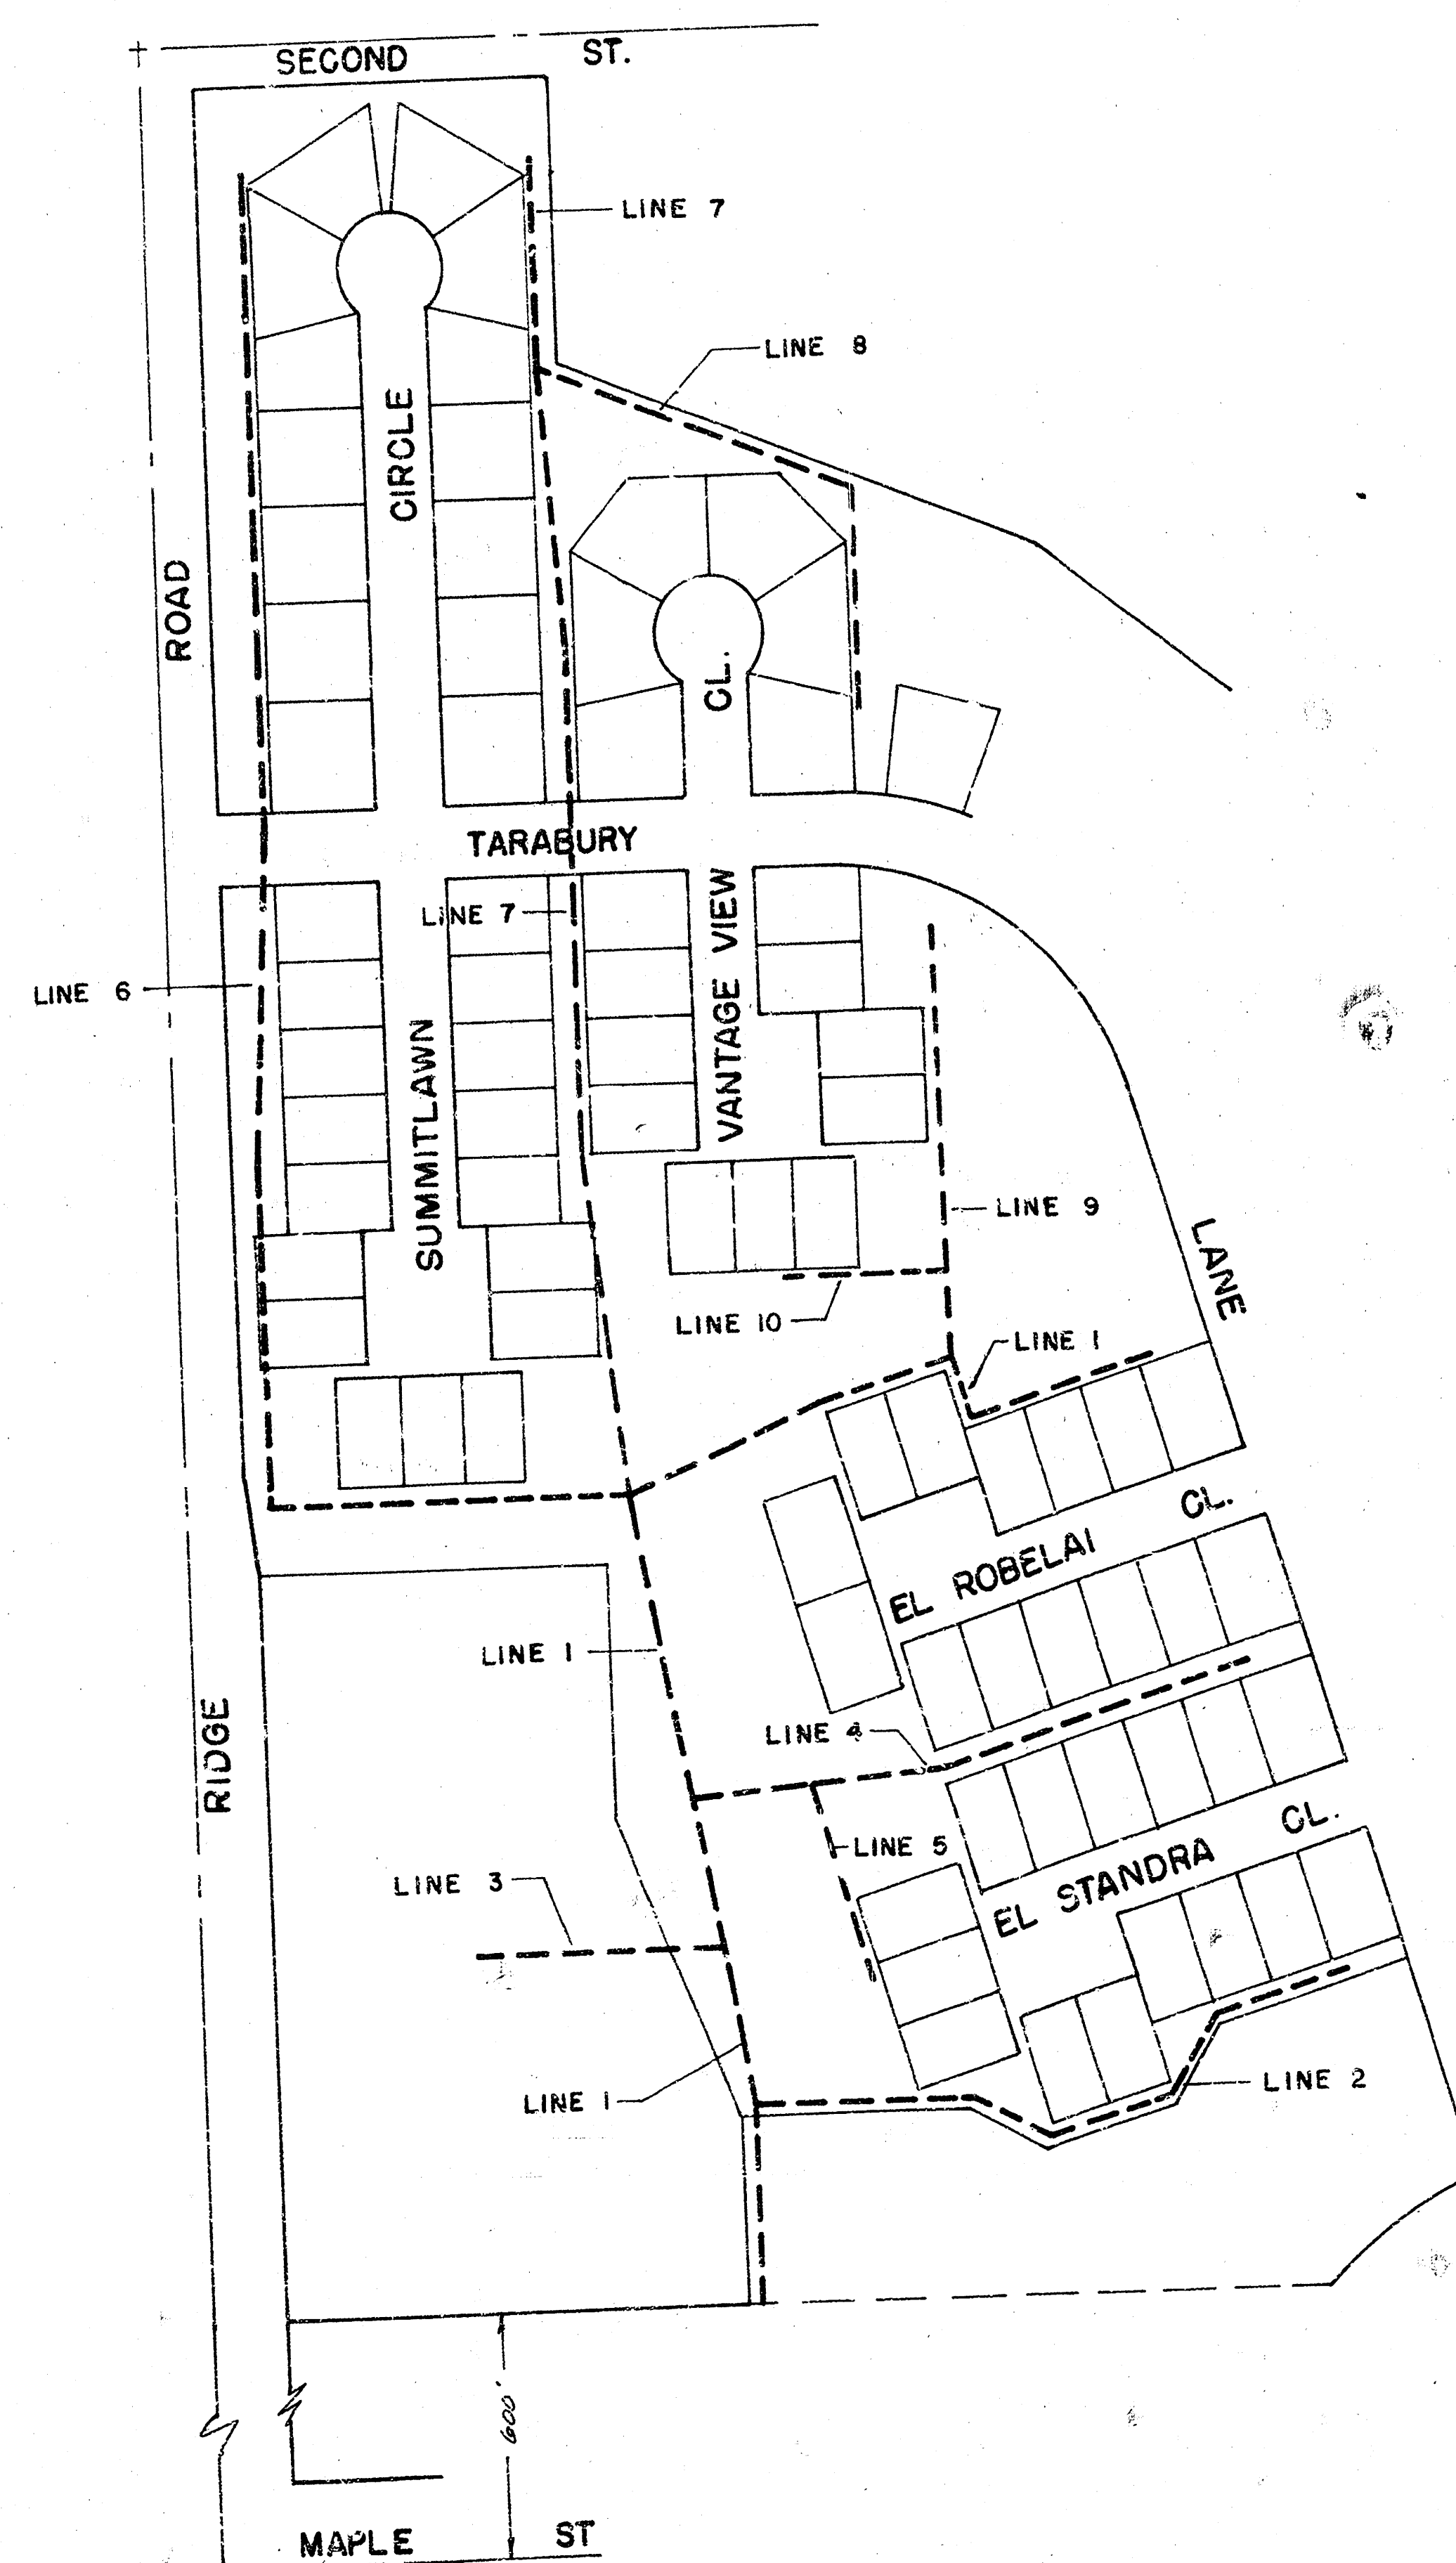




PL 259, 1/19/255  
R. Linn

Scale Plan 1"=40'  
Profile 1"=40' Horiz.  
1"=5' Vert.




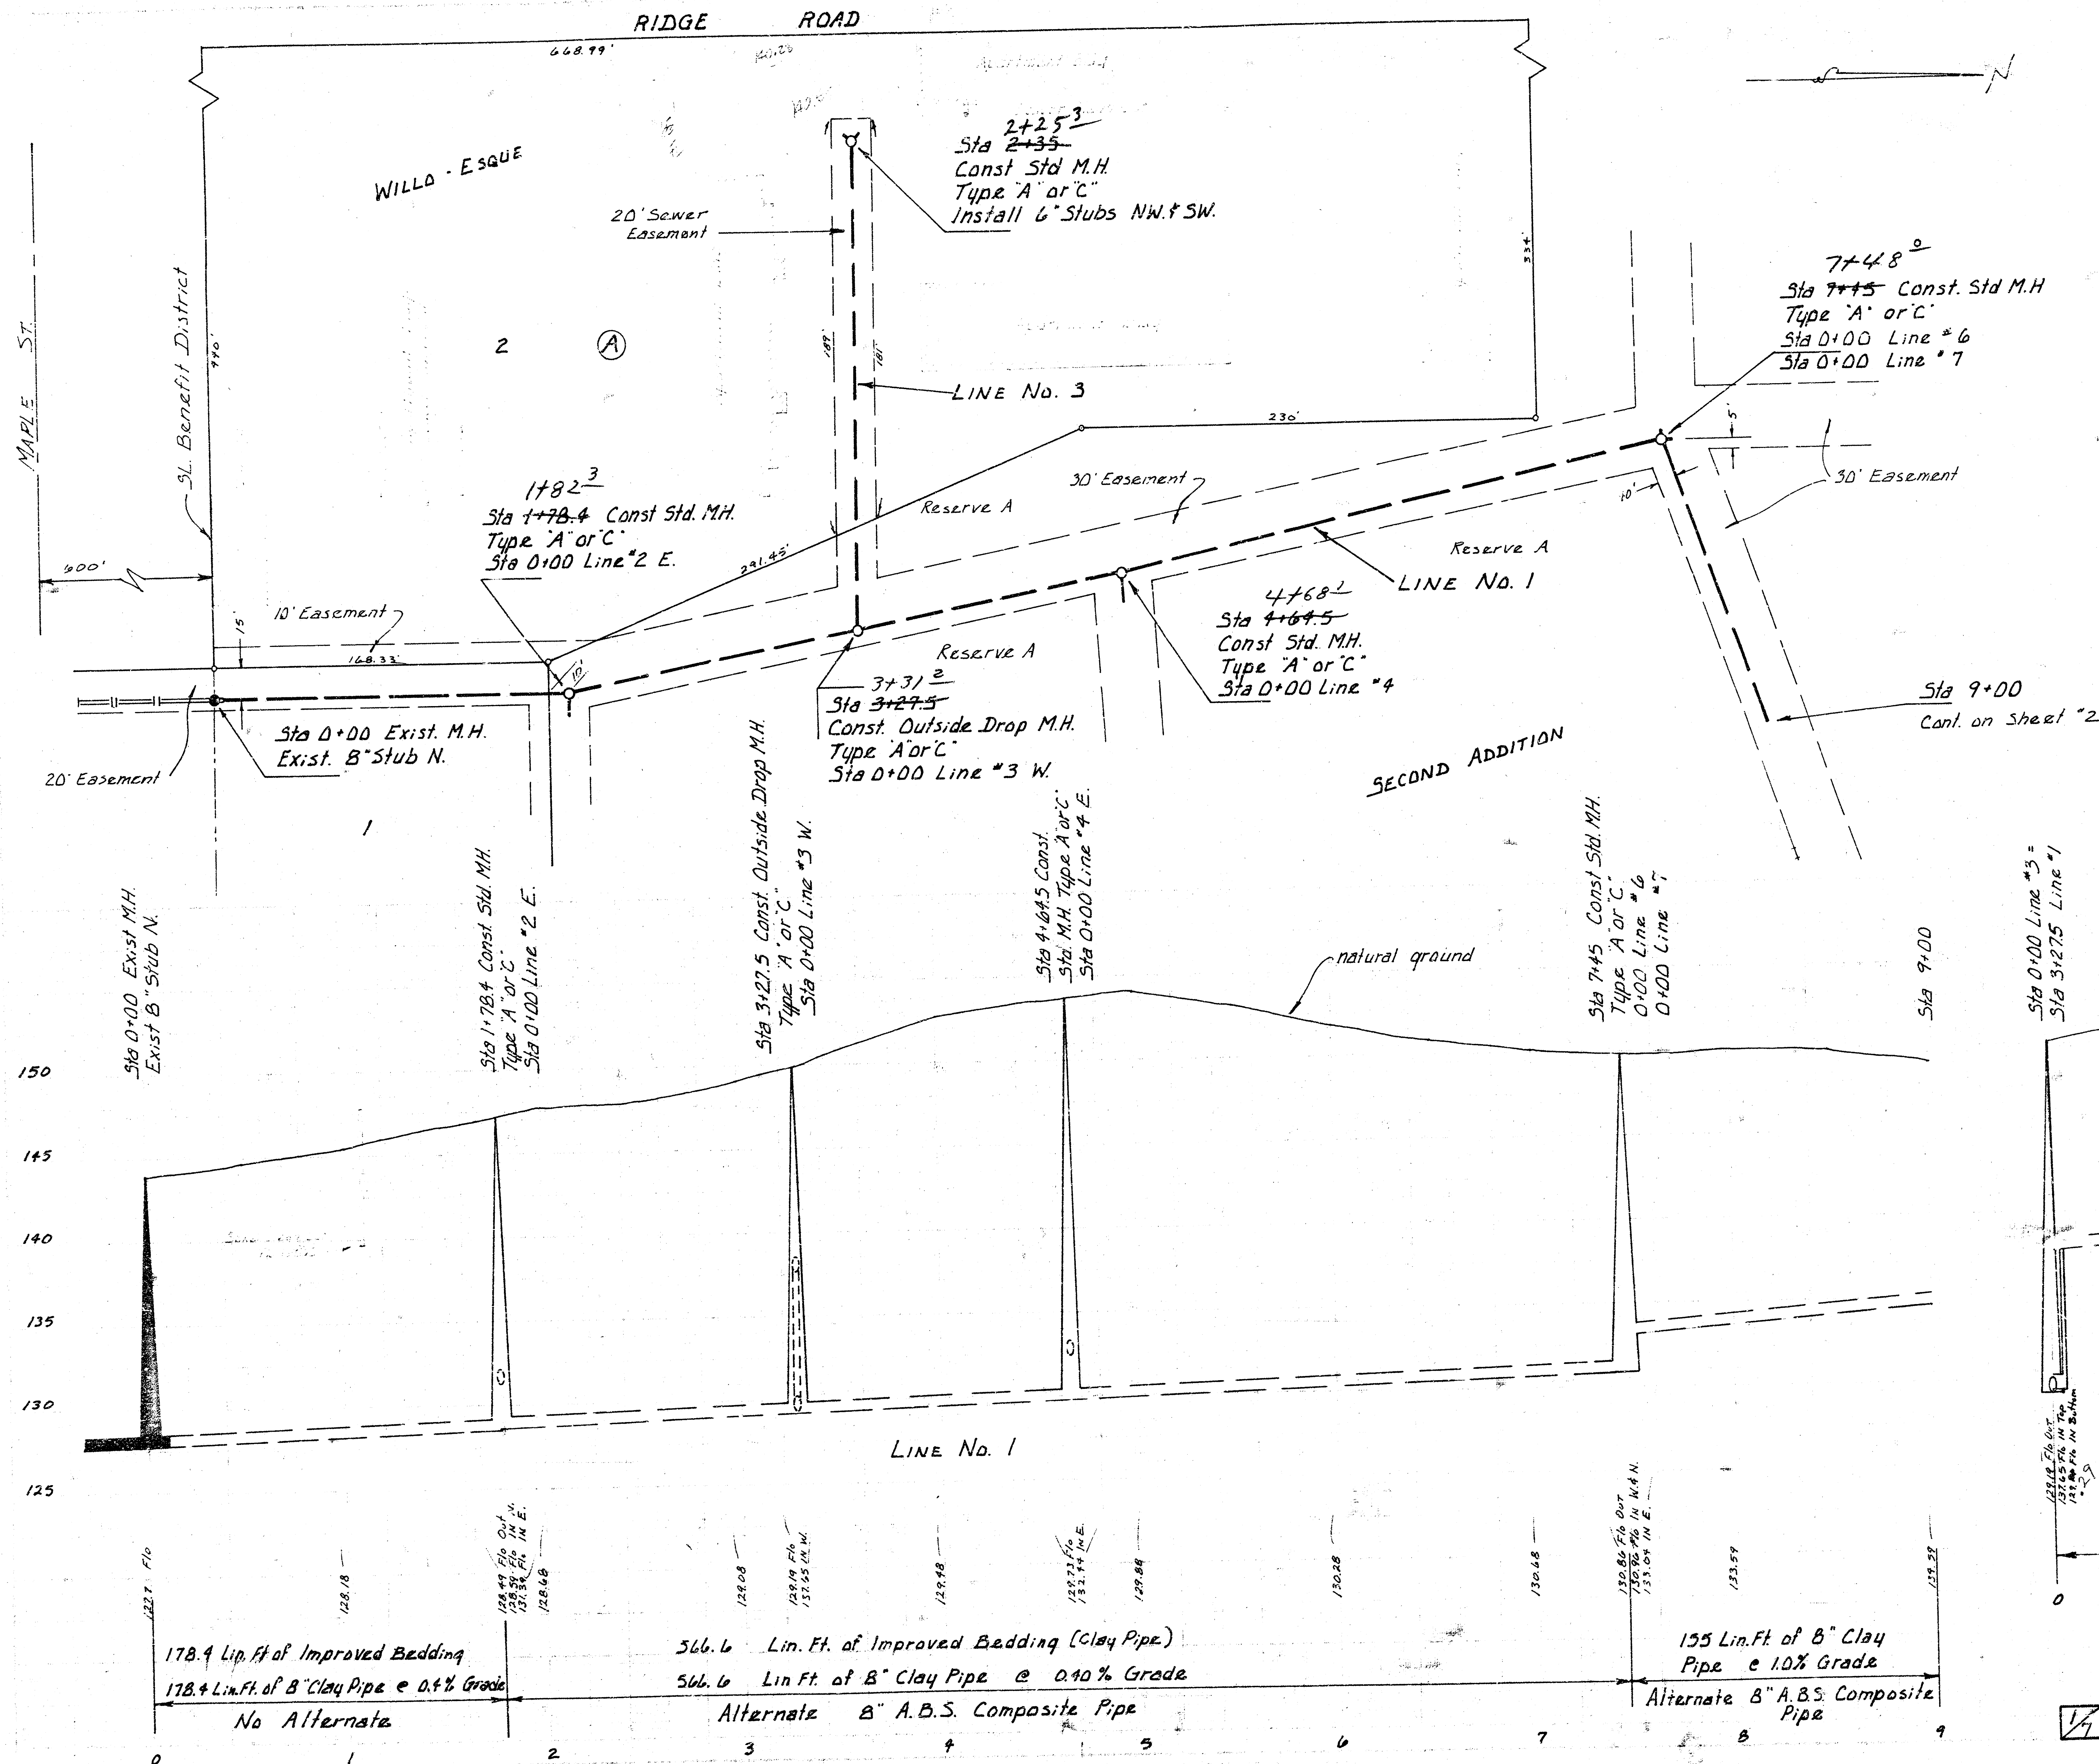


- B.M. 141.66 City Std. disc 34' E. and 42' S. of W. end of Ridge Road and Maple
- B.M. 147.62 "d" top of curb at the center of the W. end of the Island in the cul-de-sac on El Strada Cl.
- B.M. 149.99 "d" top of curb at the center of the W. end of the Island in the cul-de-sac on El Robelar Cl.

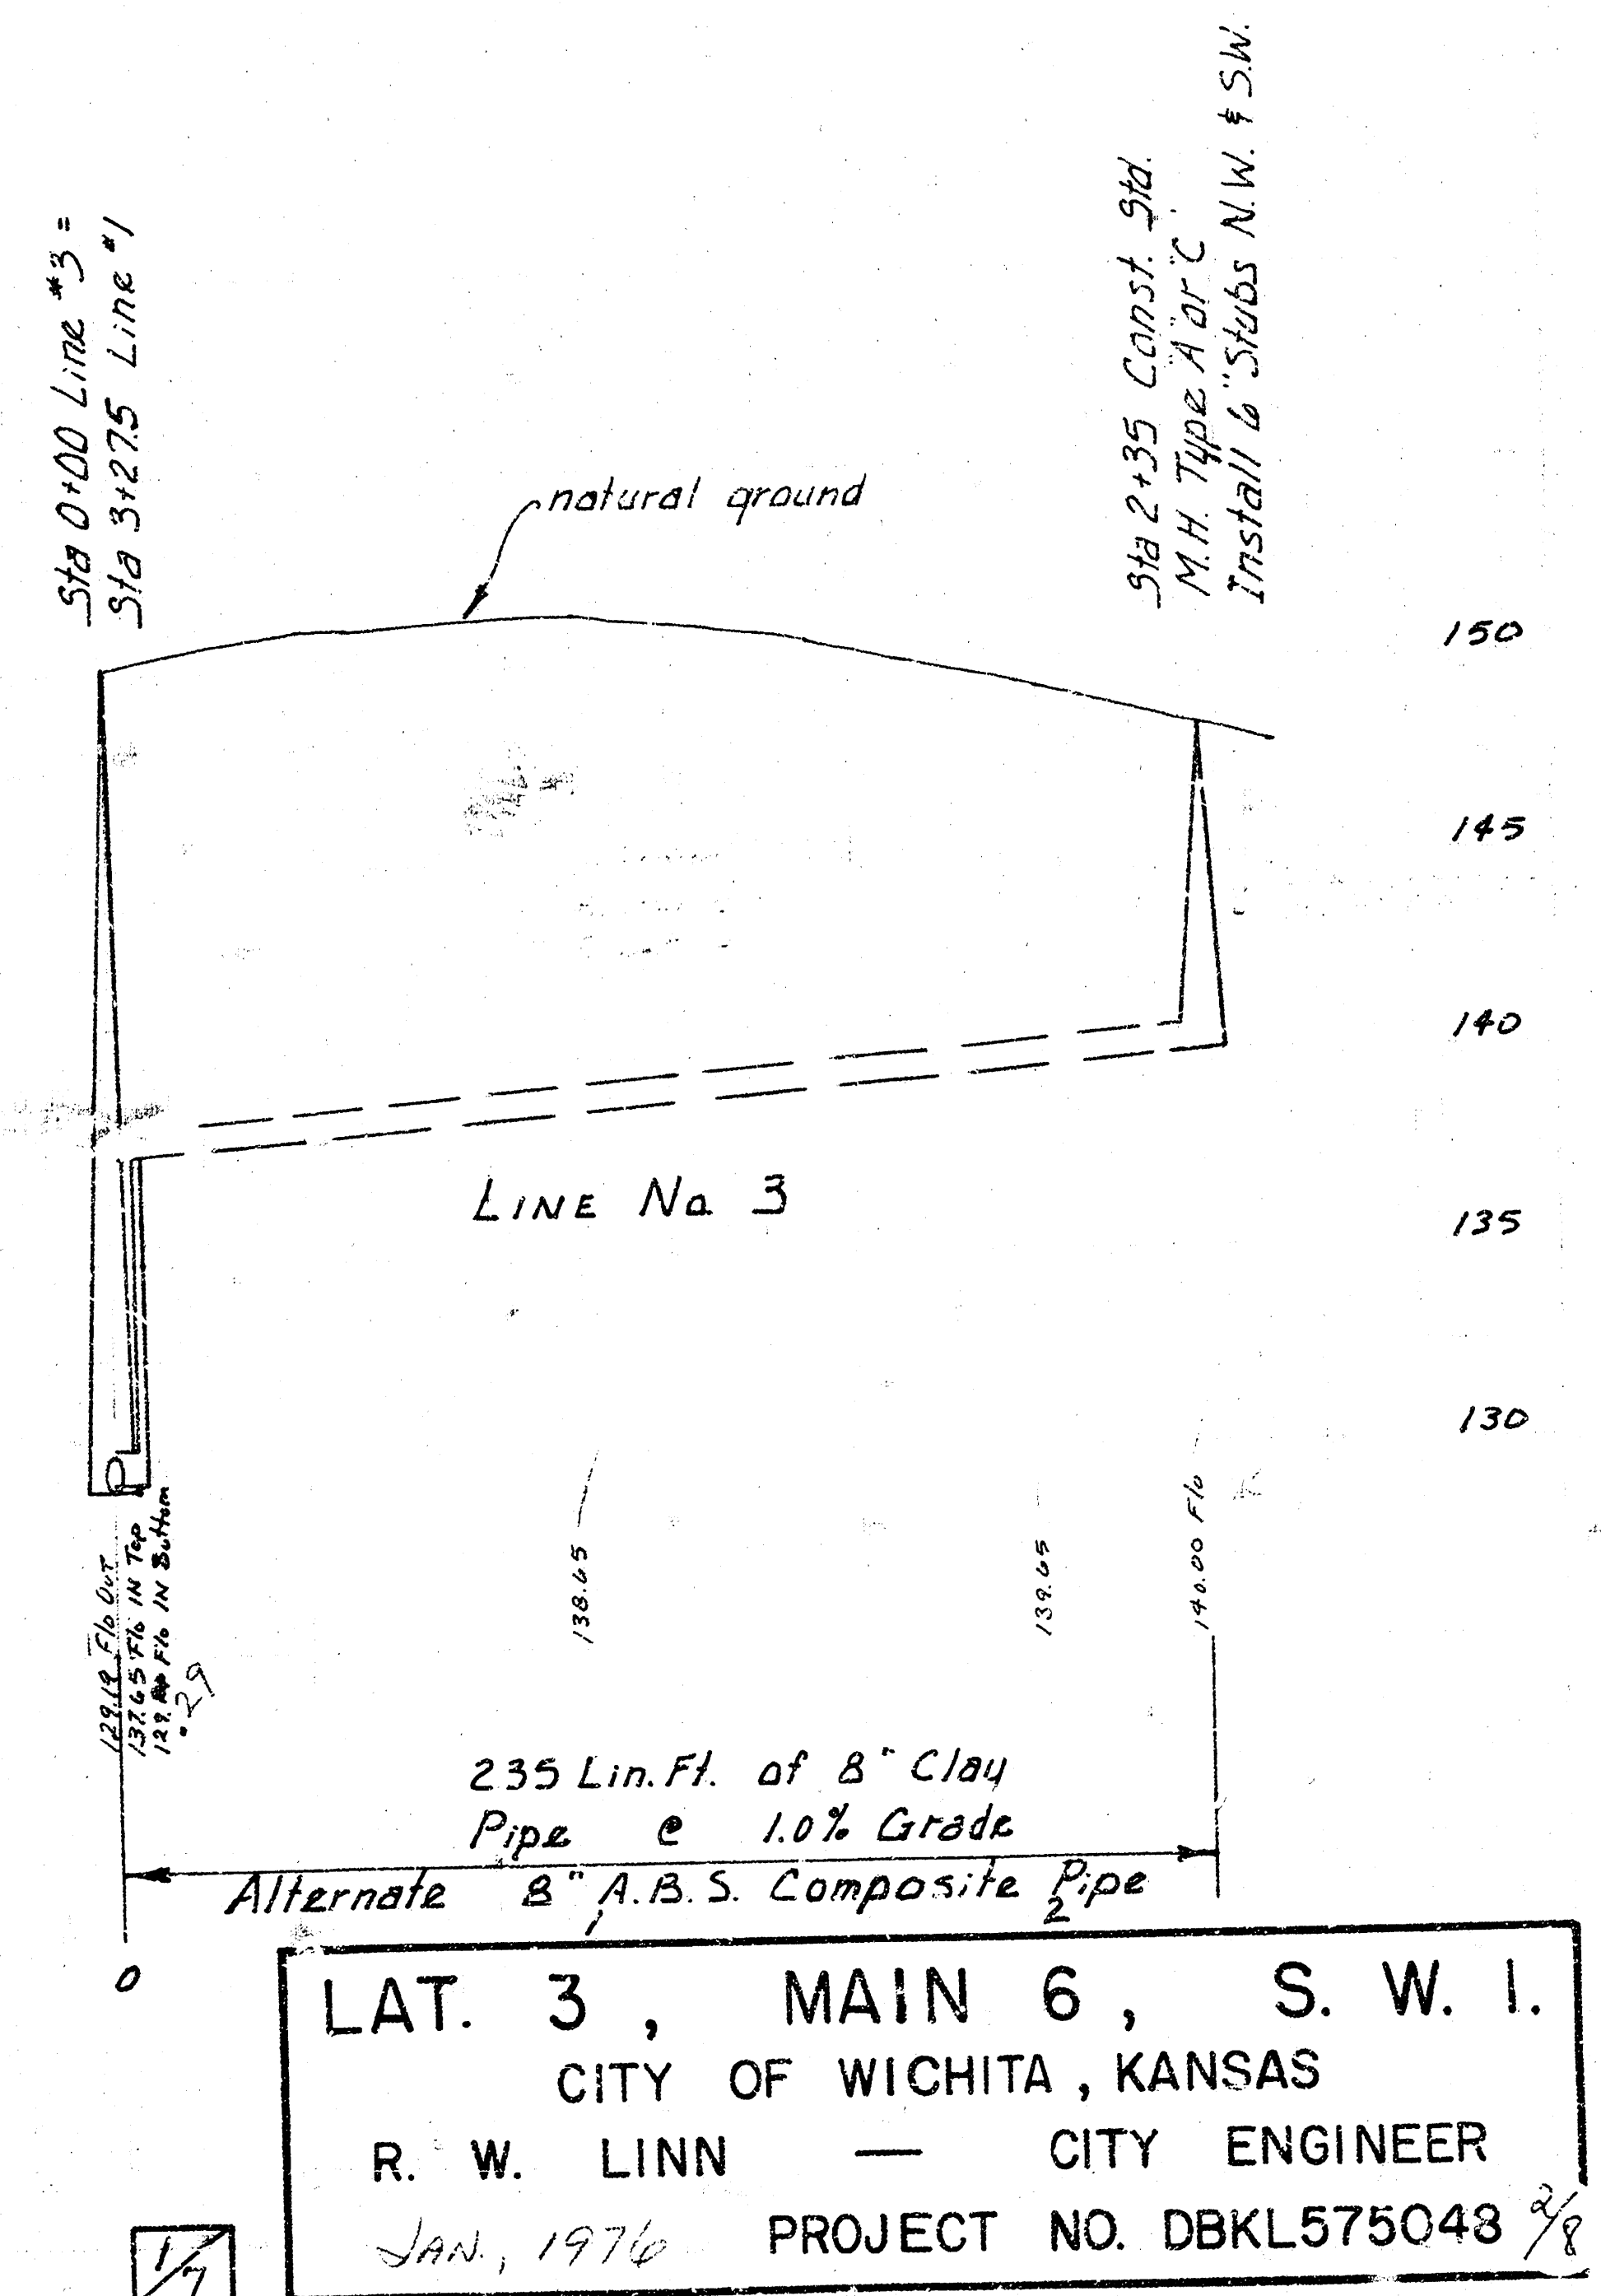






LAT. 3, MAIN 6, S. W. 1.  
CITY OF WICHITA, KANSAS  
R. W. LINN — CITY ENGINEER  
JAN. 1976 PROJECT NO. DBKL575048



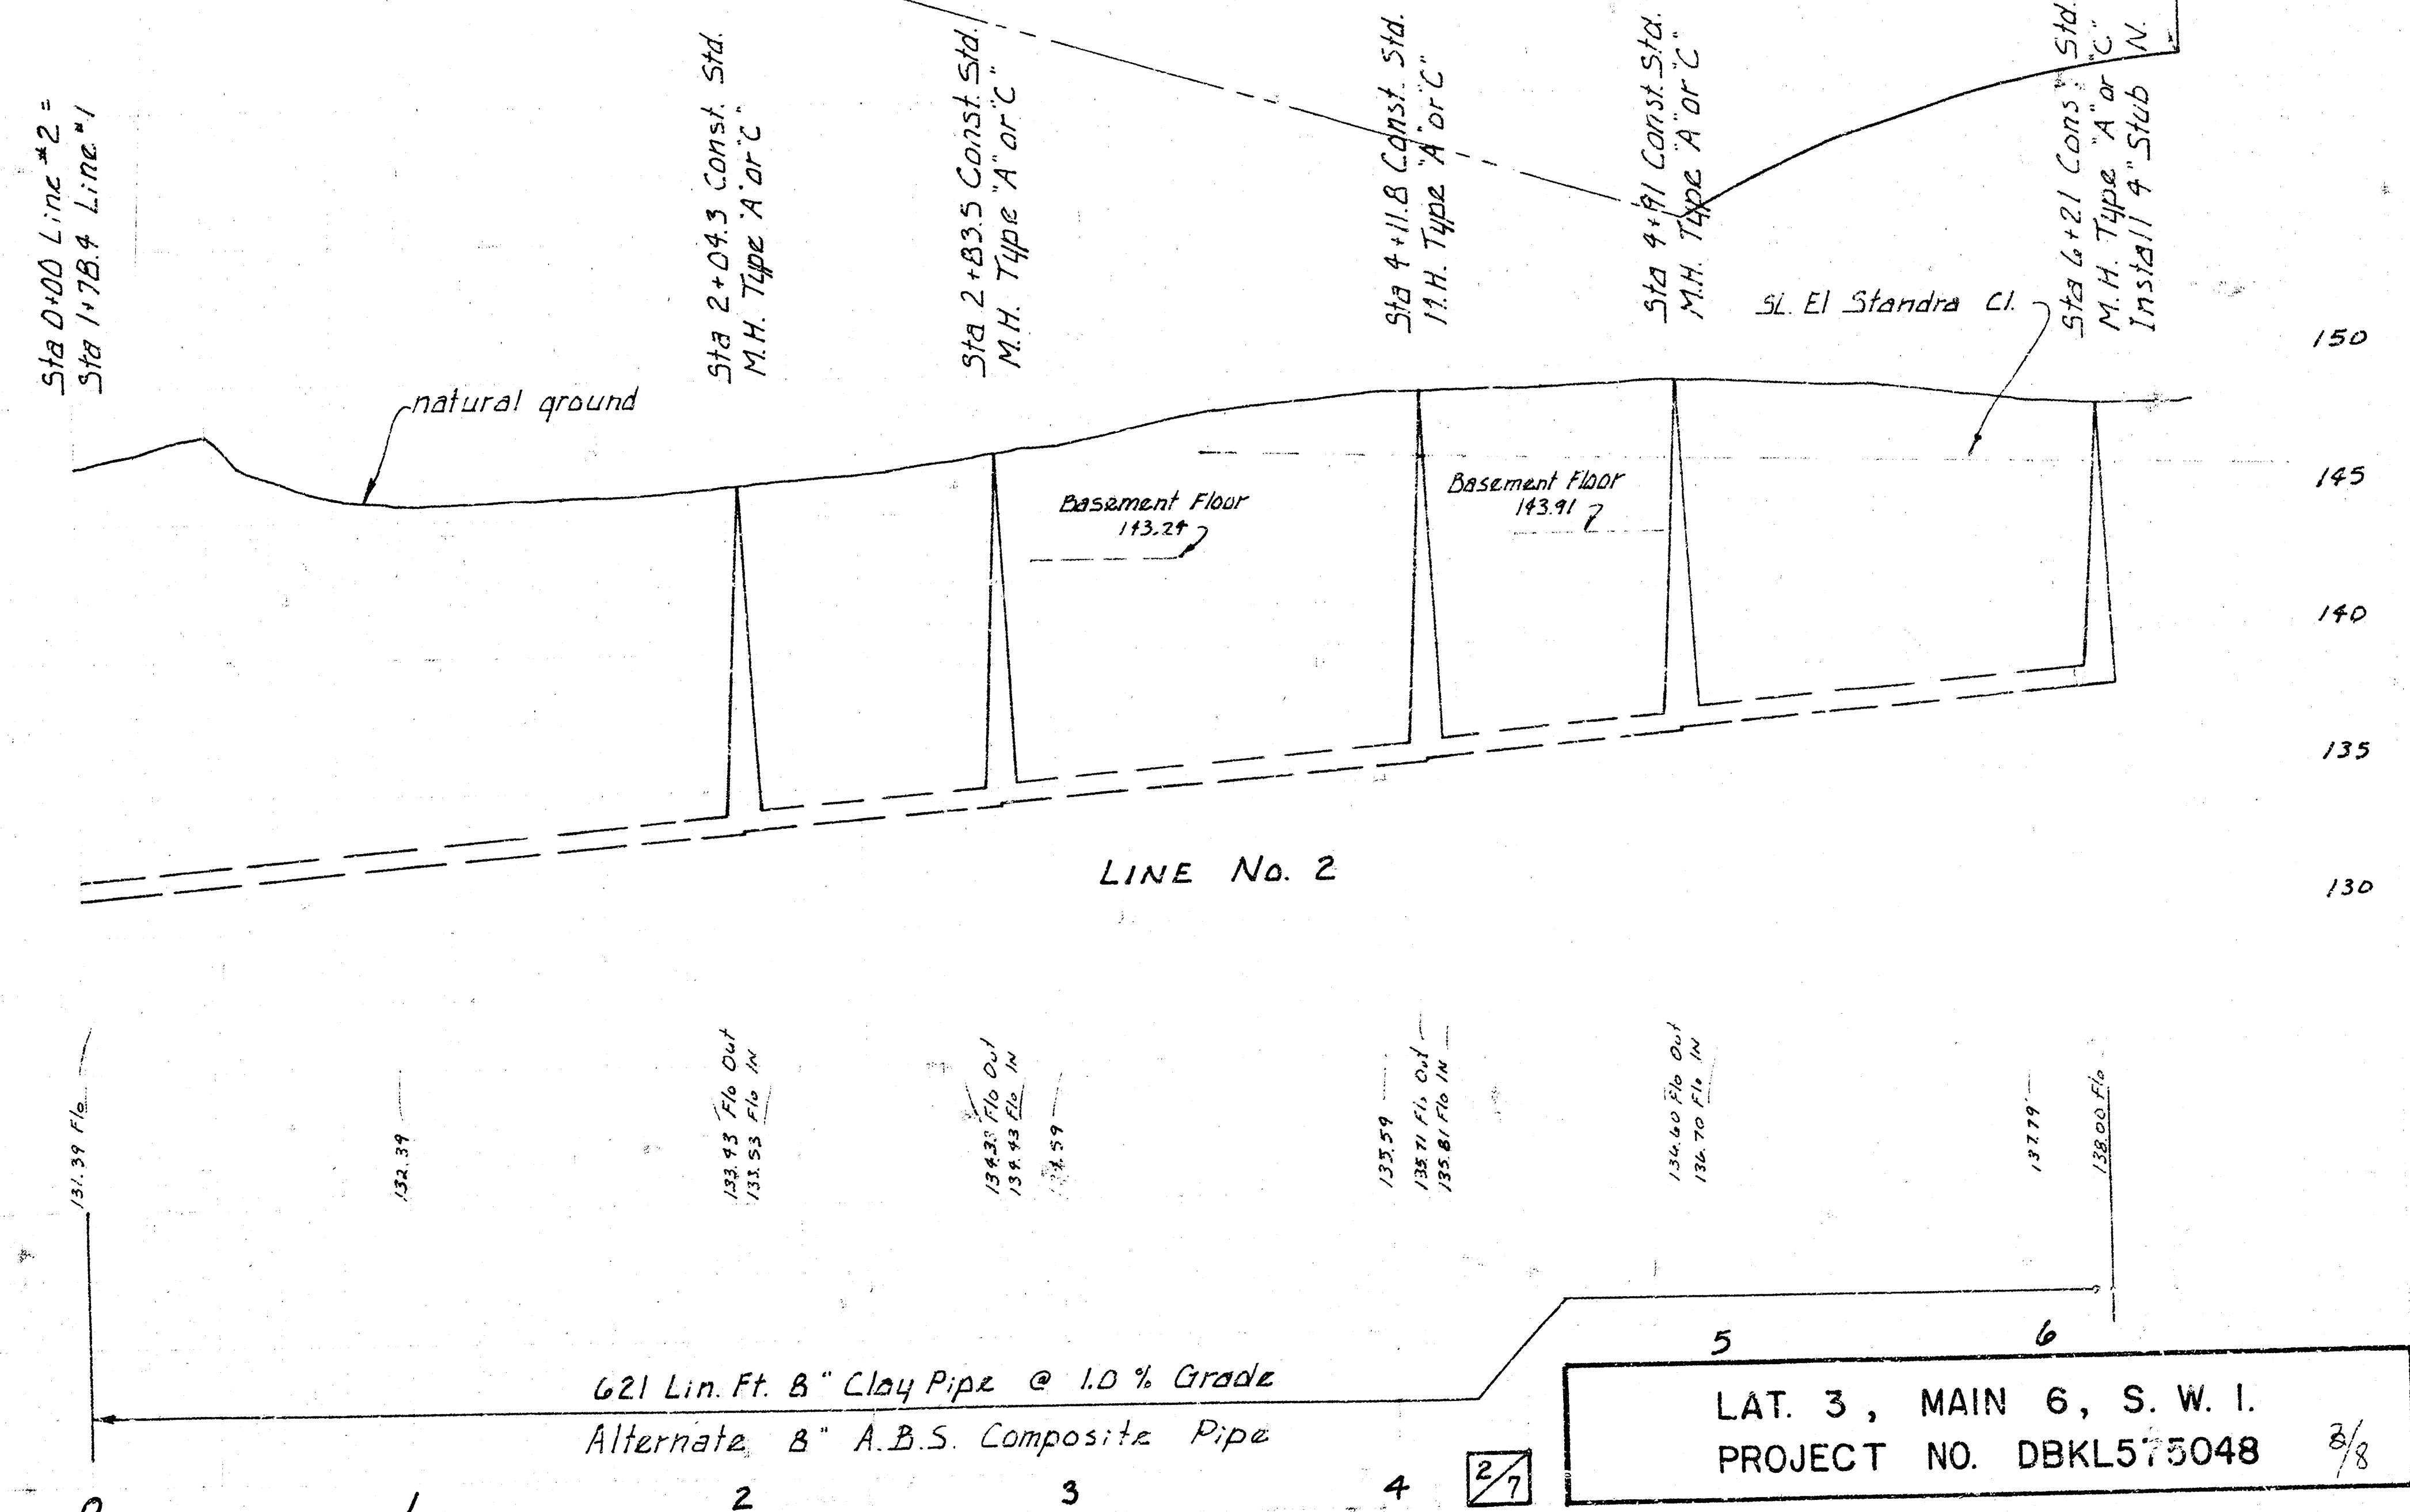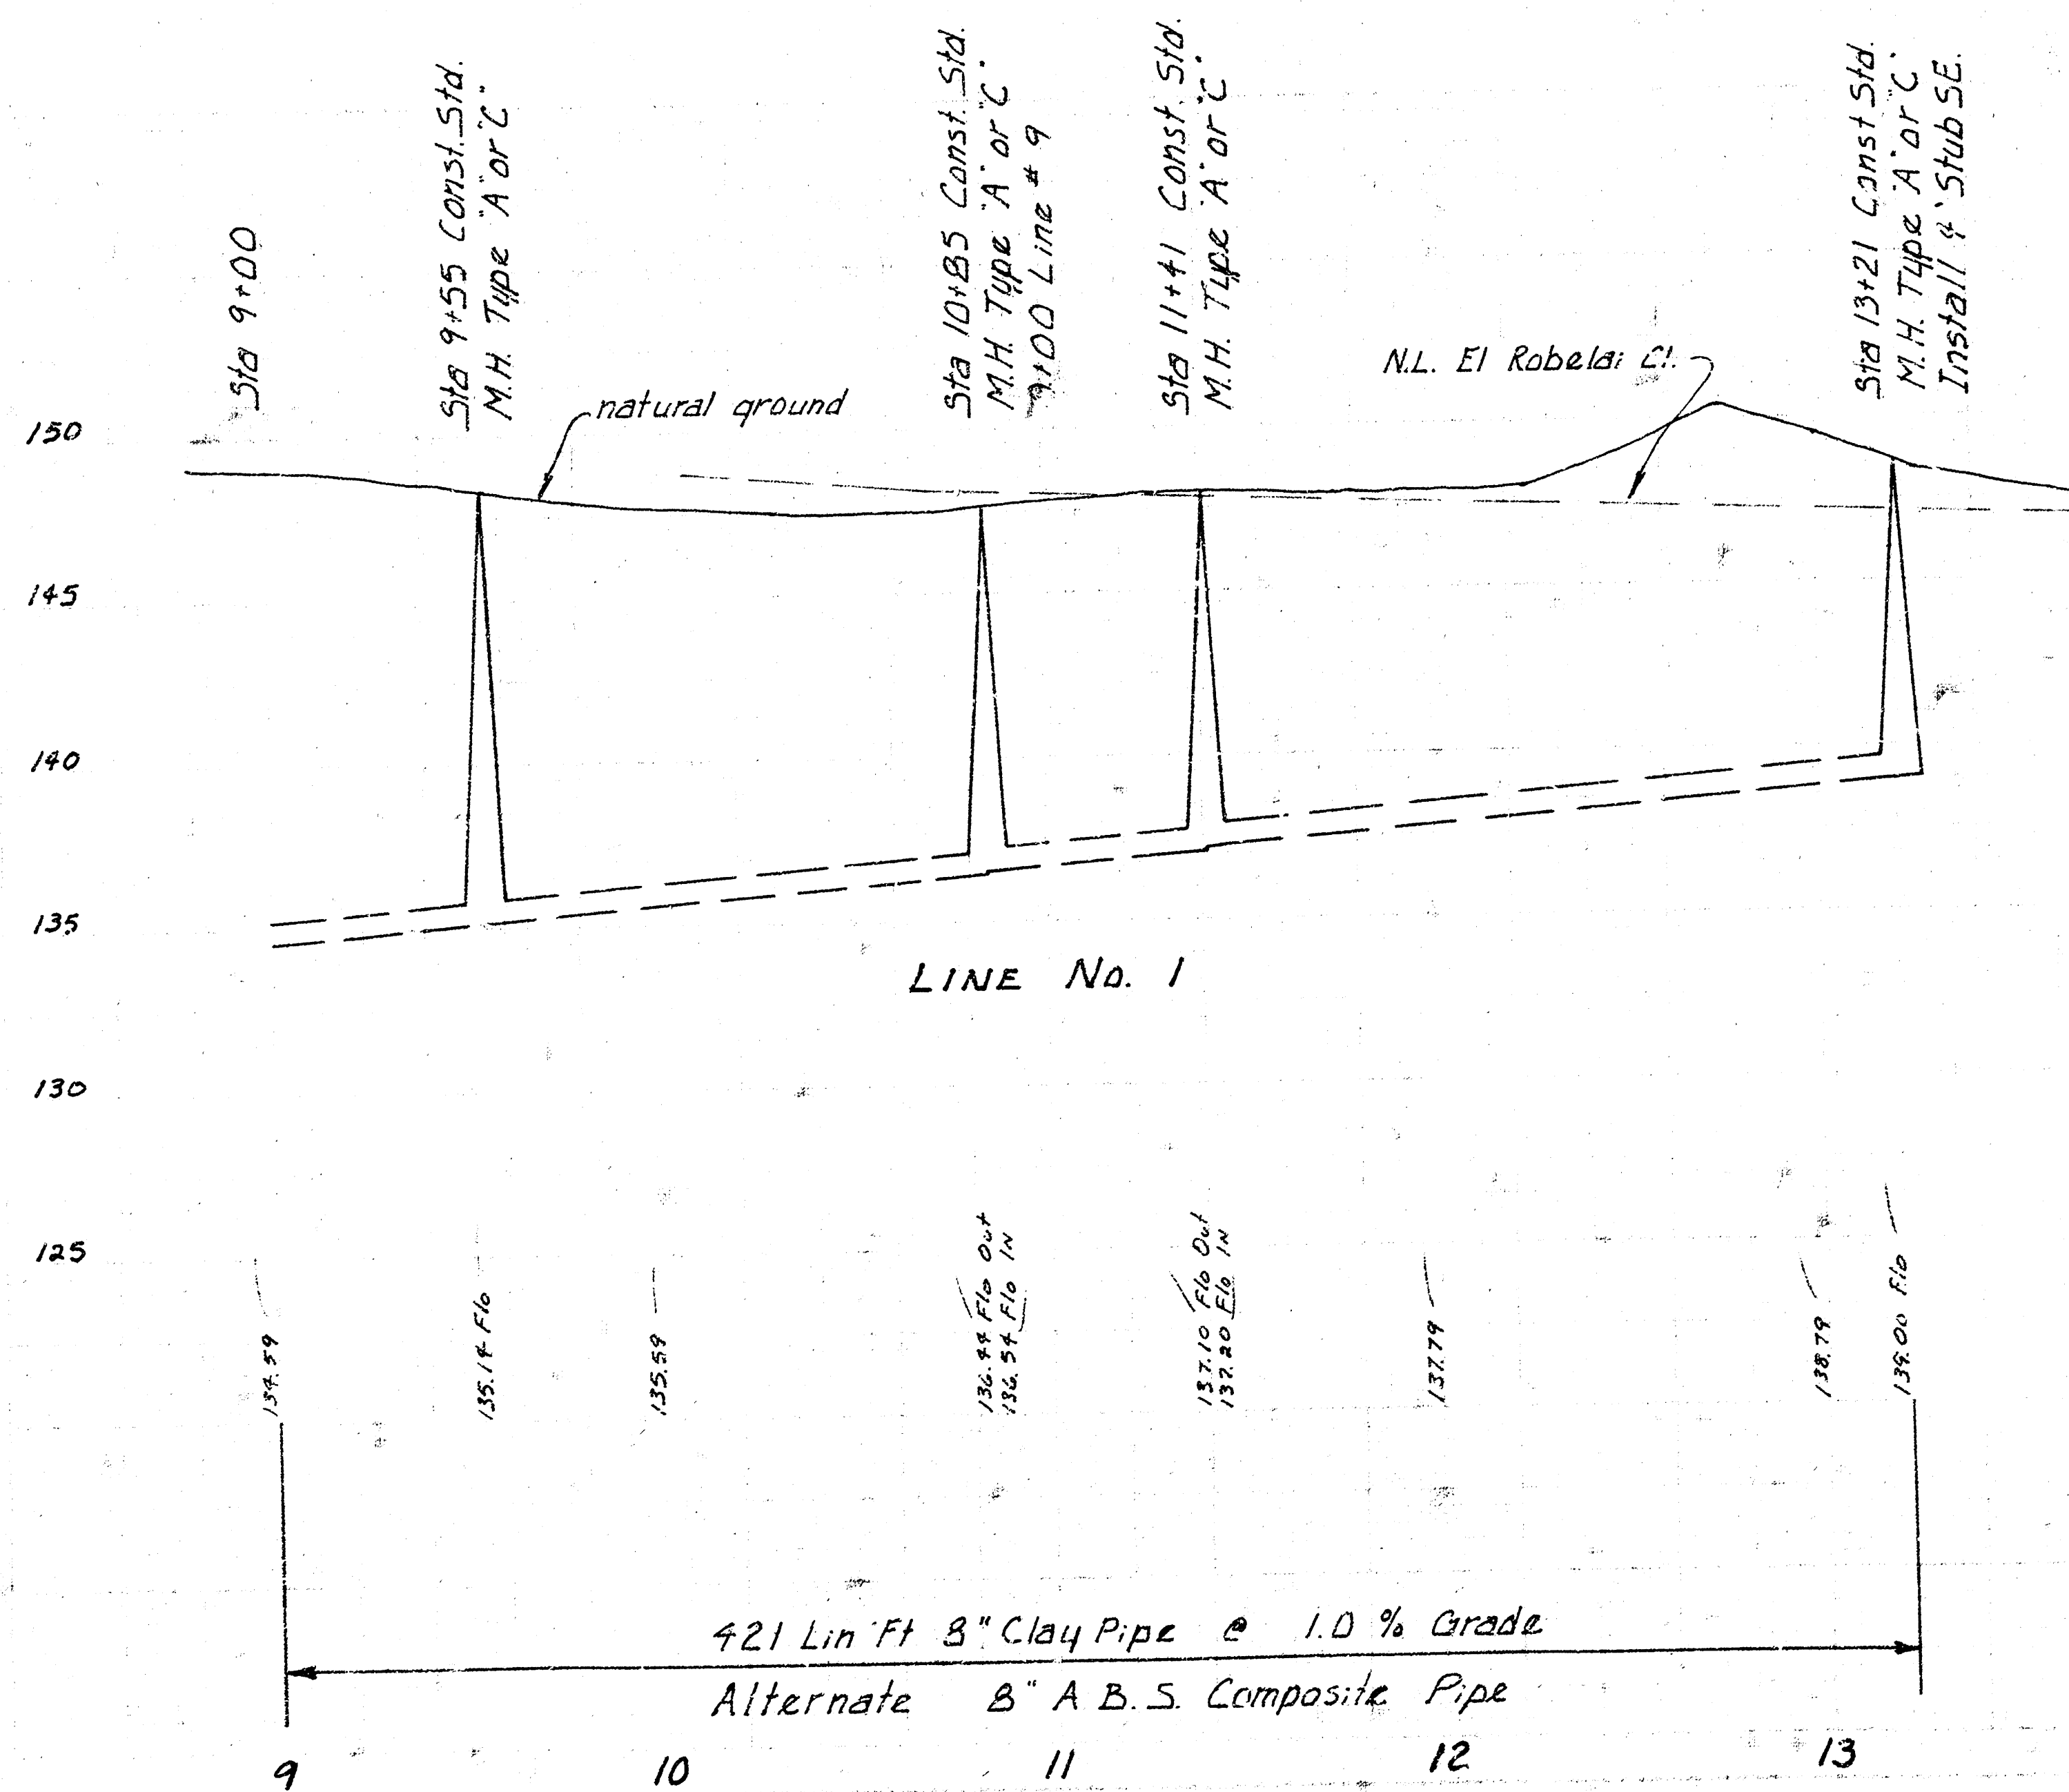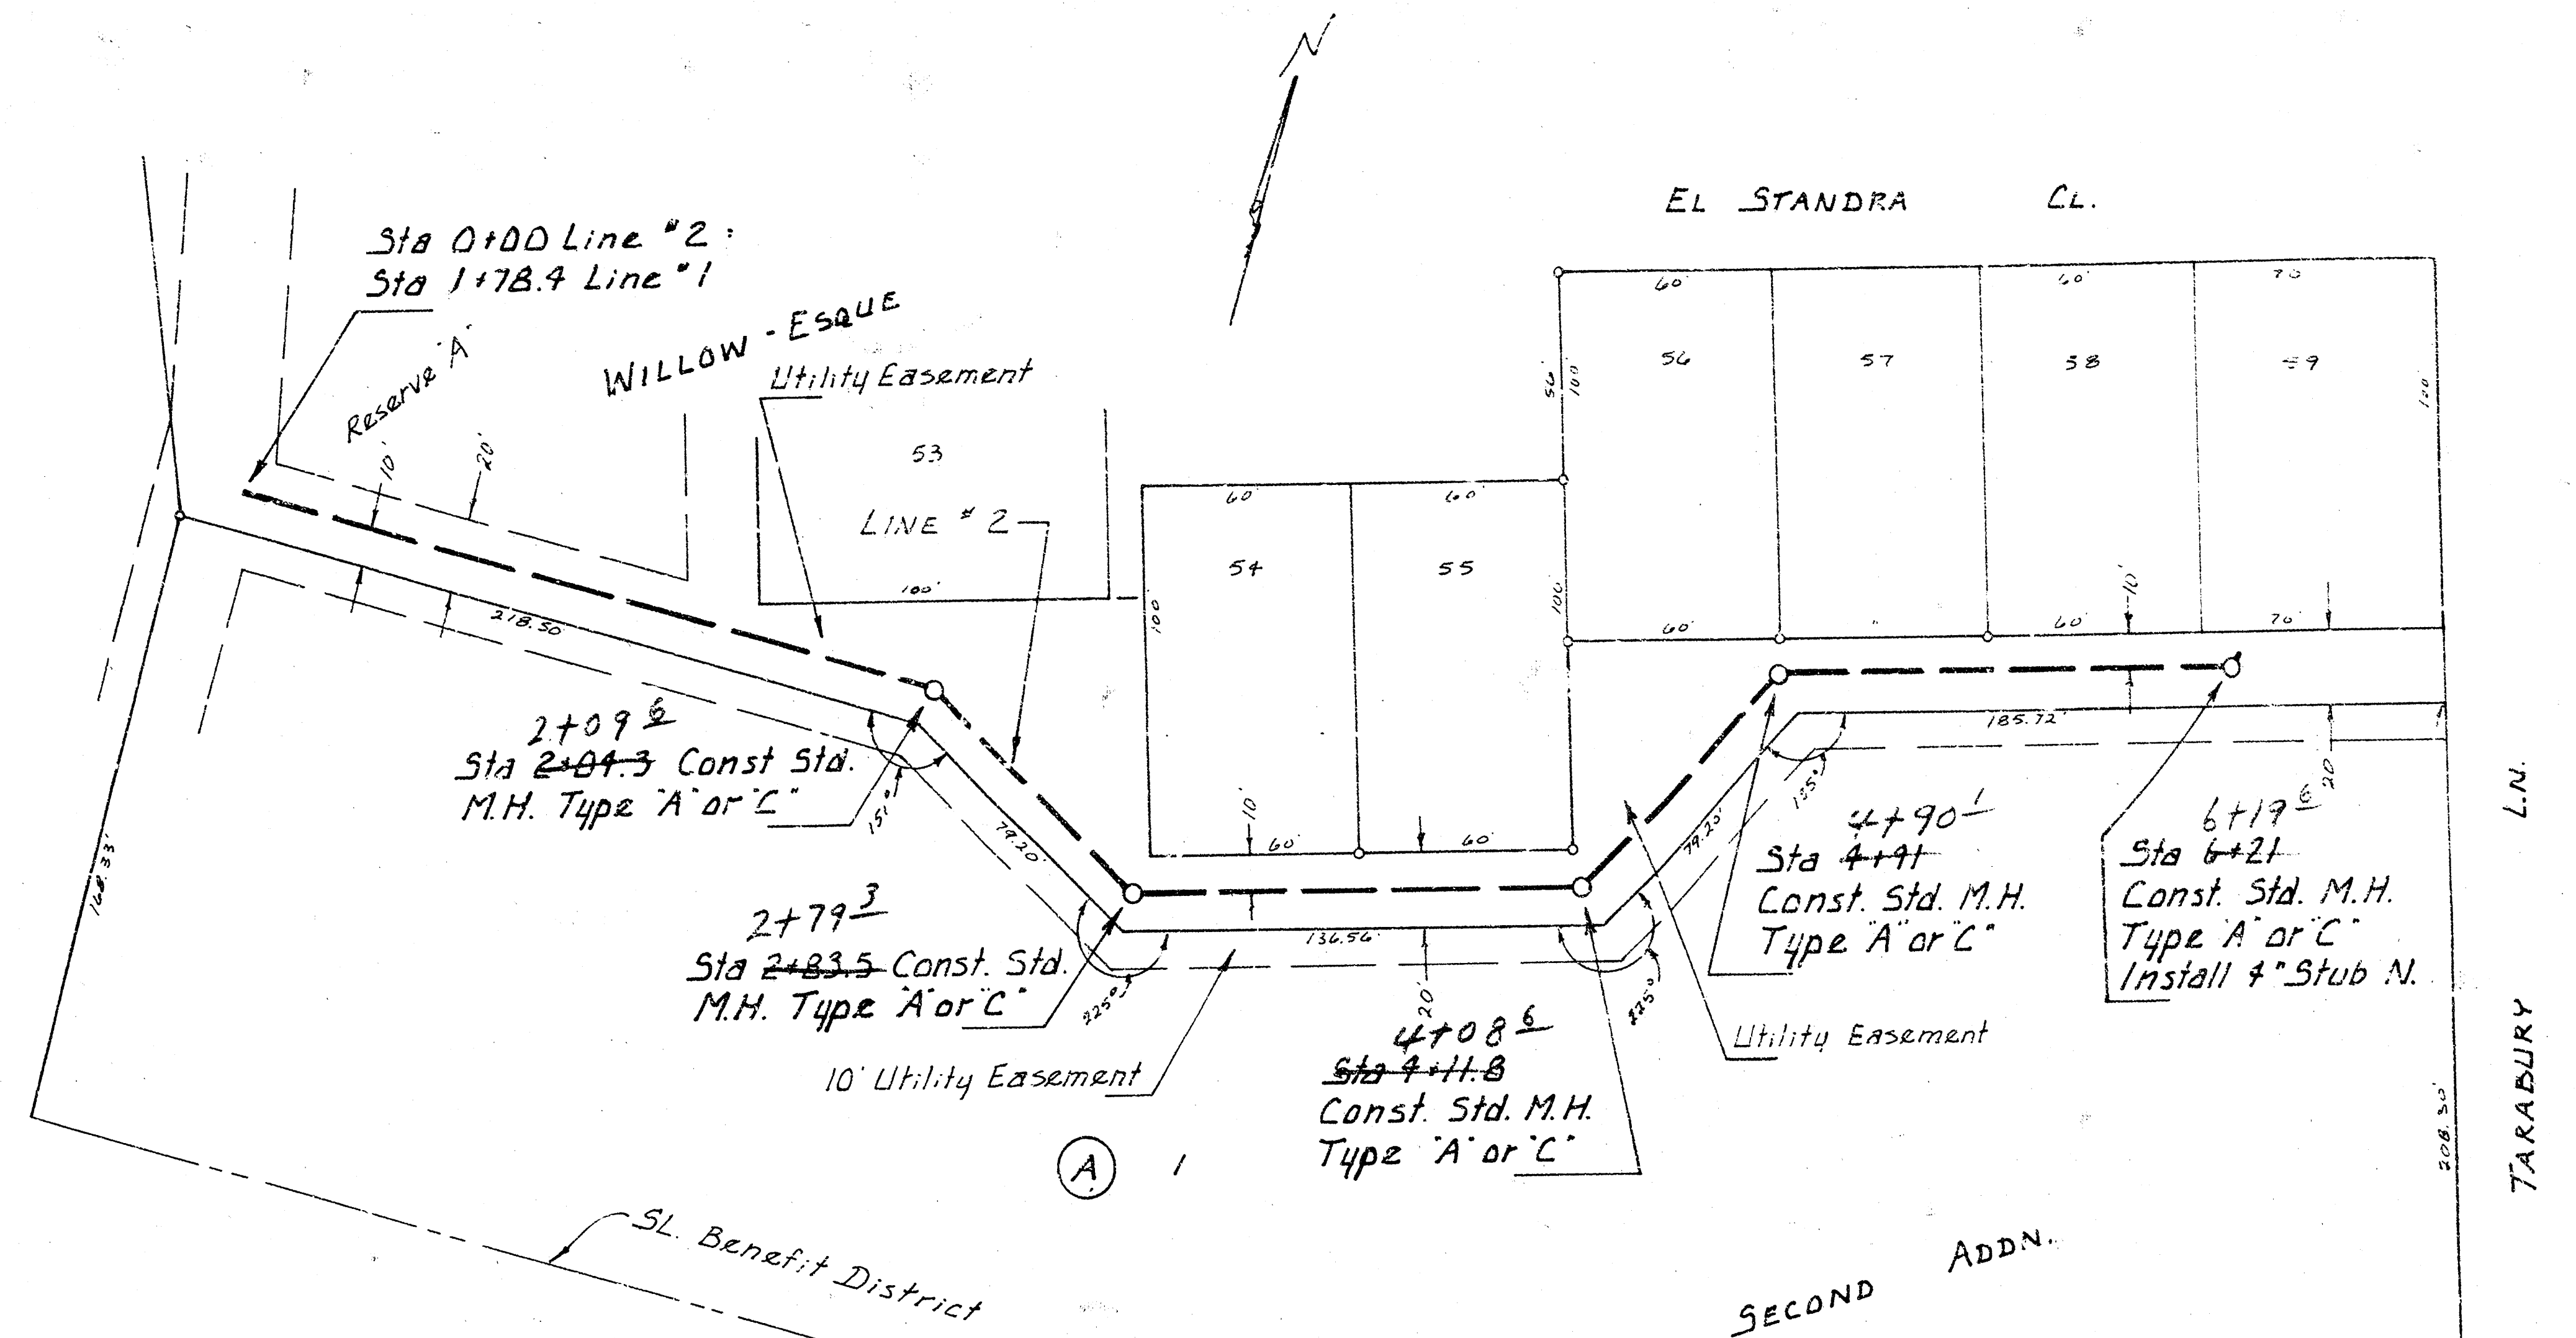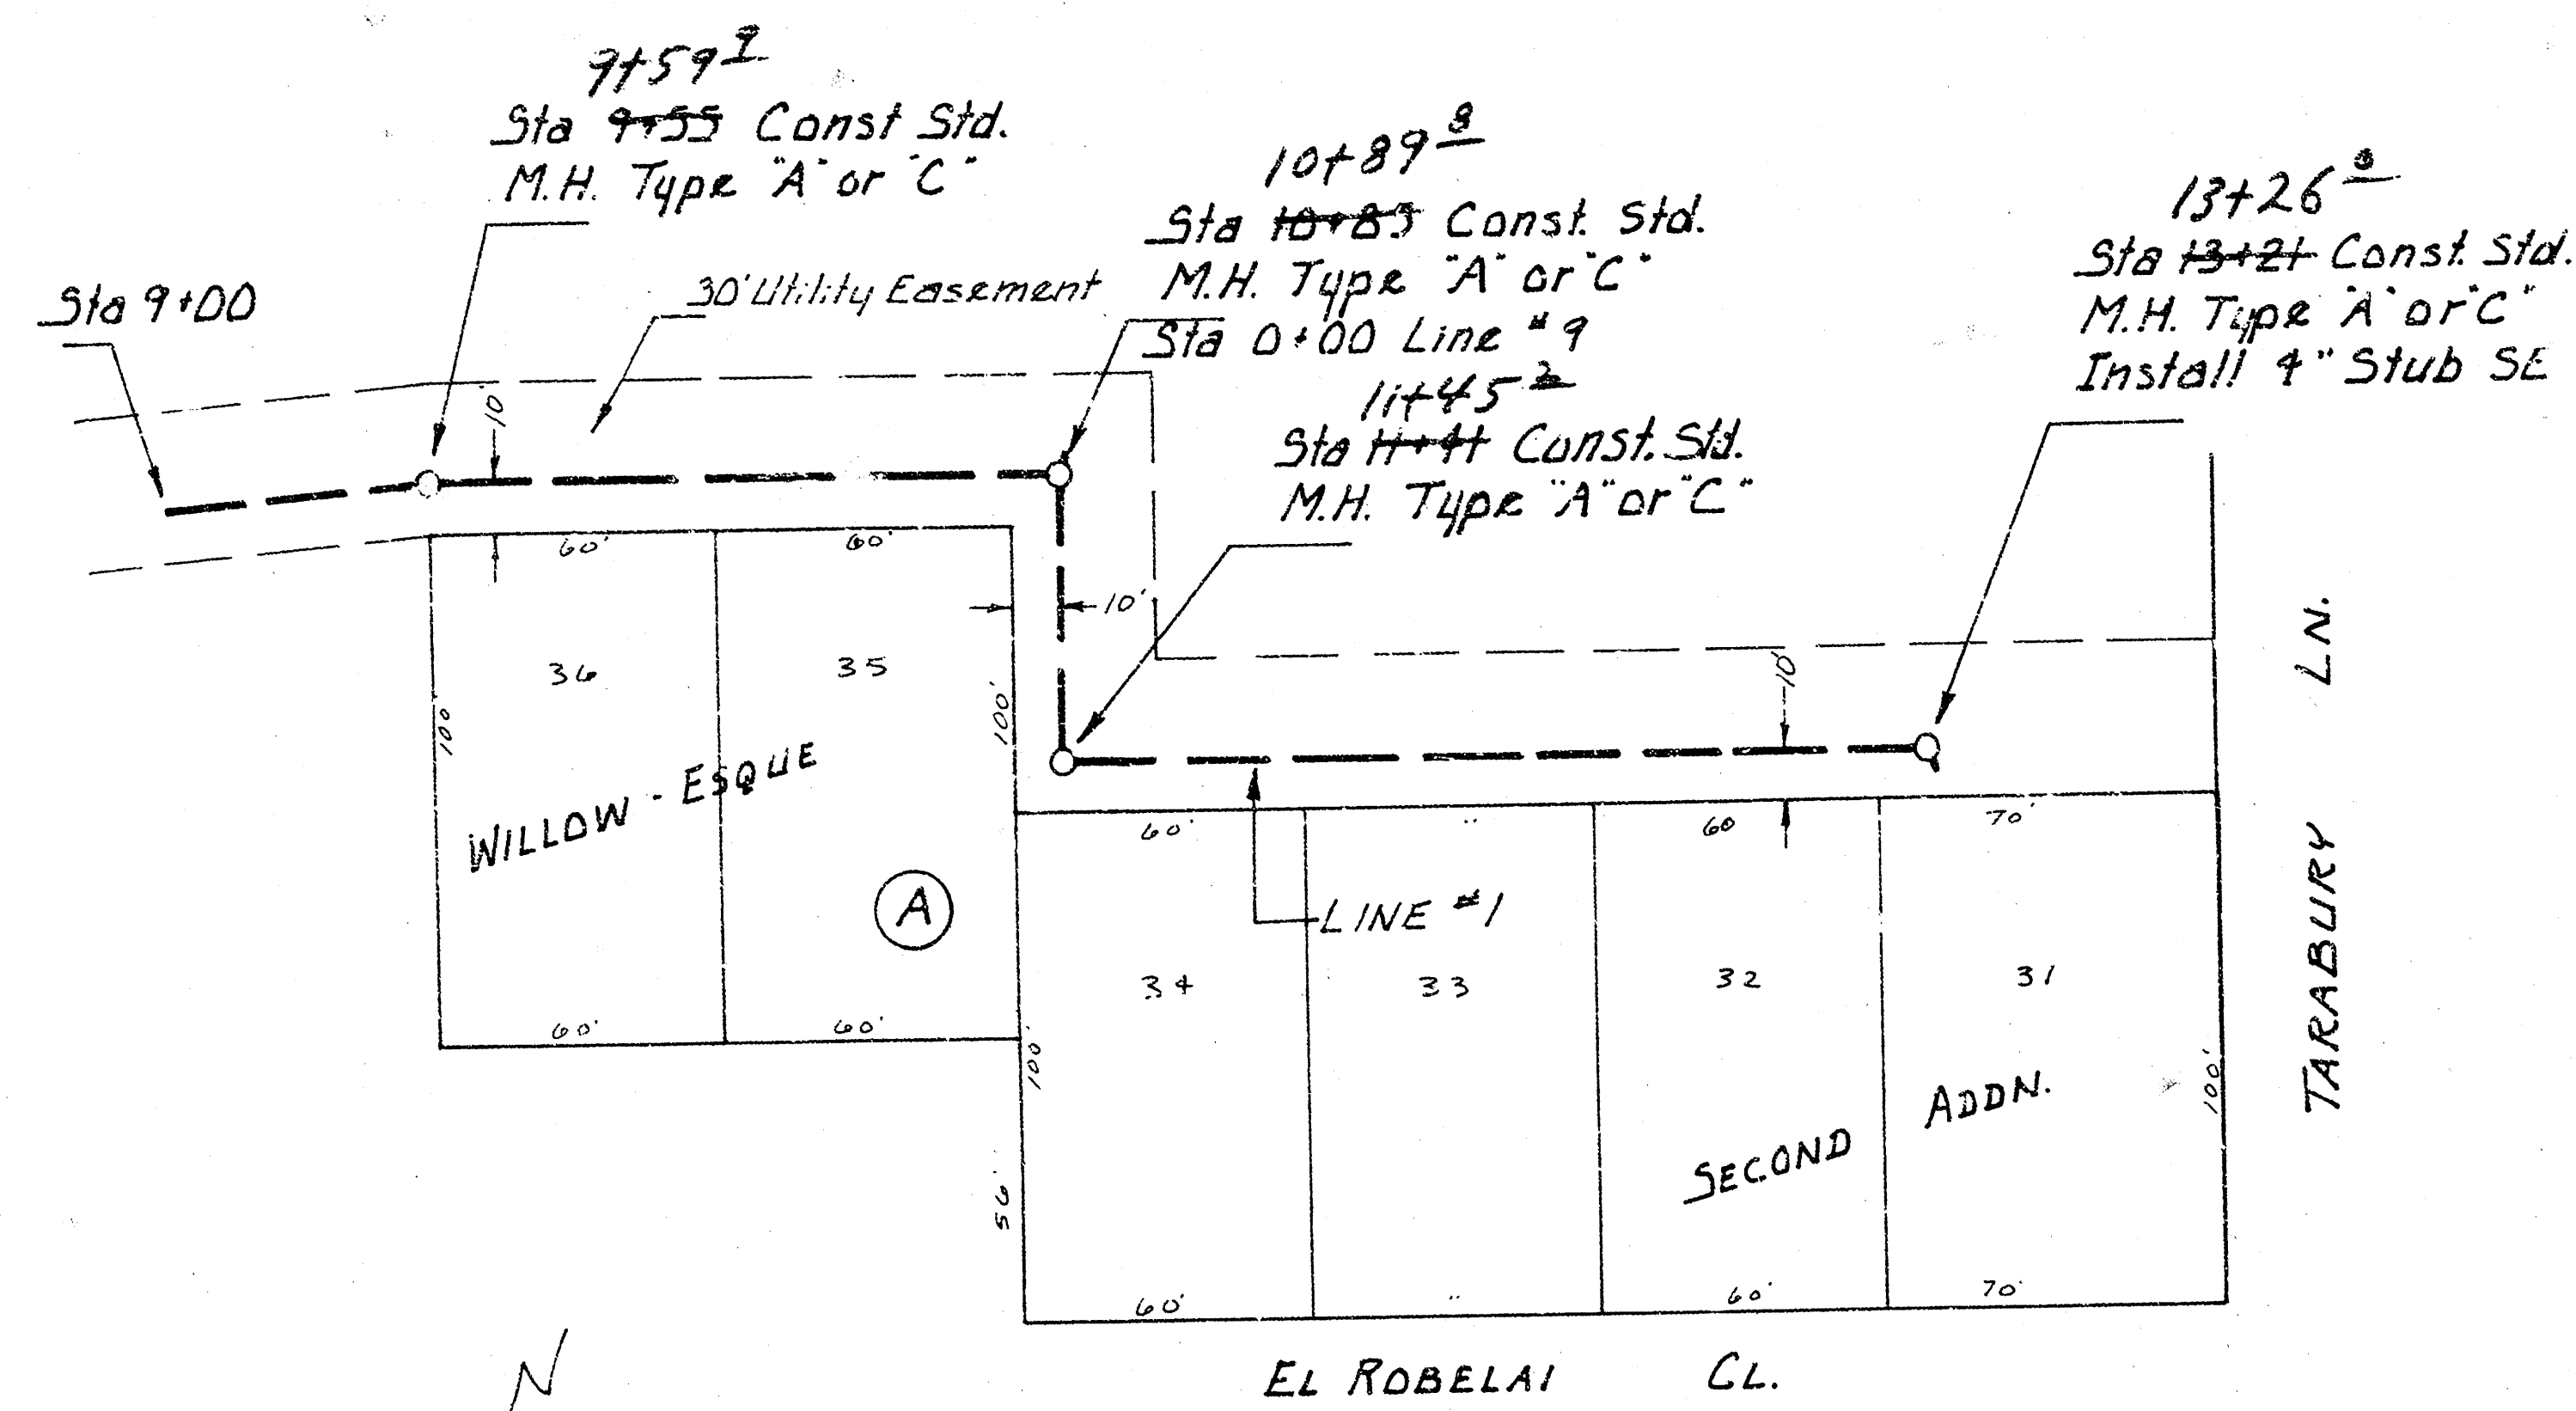


LAT. 3, MAIN 6, S. W. I.  
PROJECT NO. DBKL575048







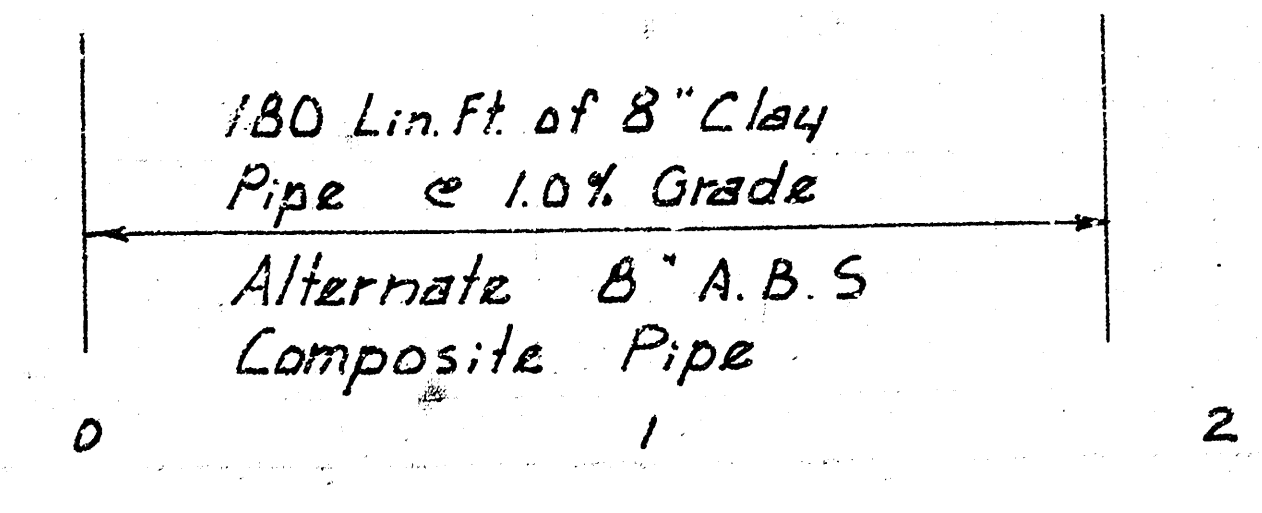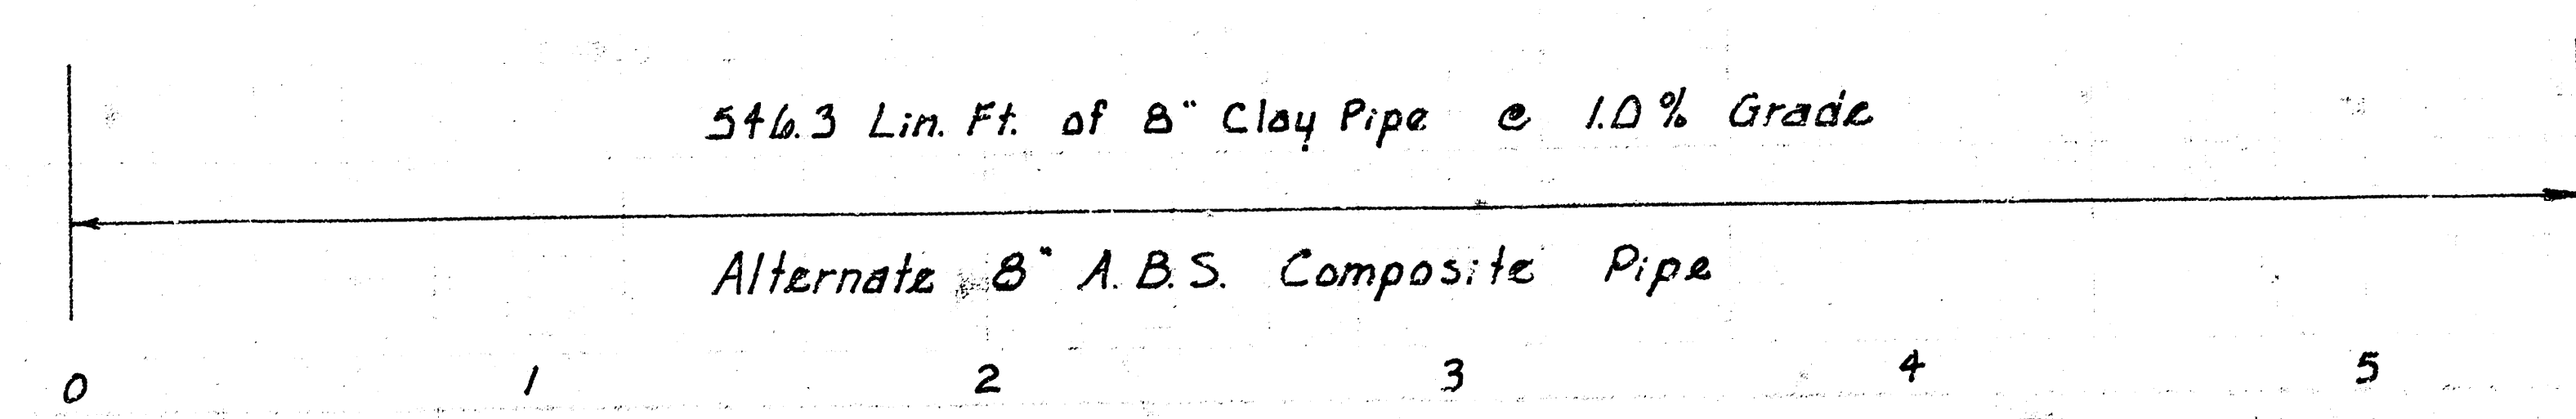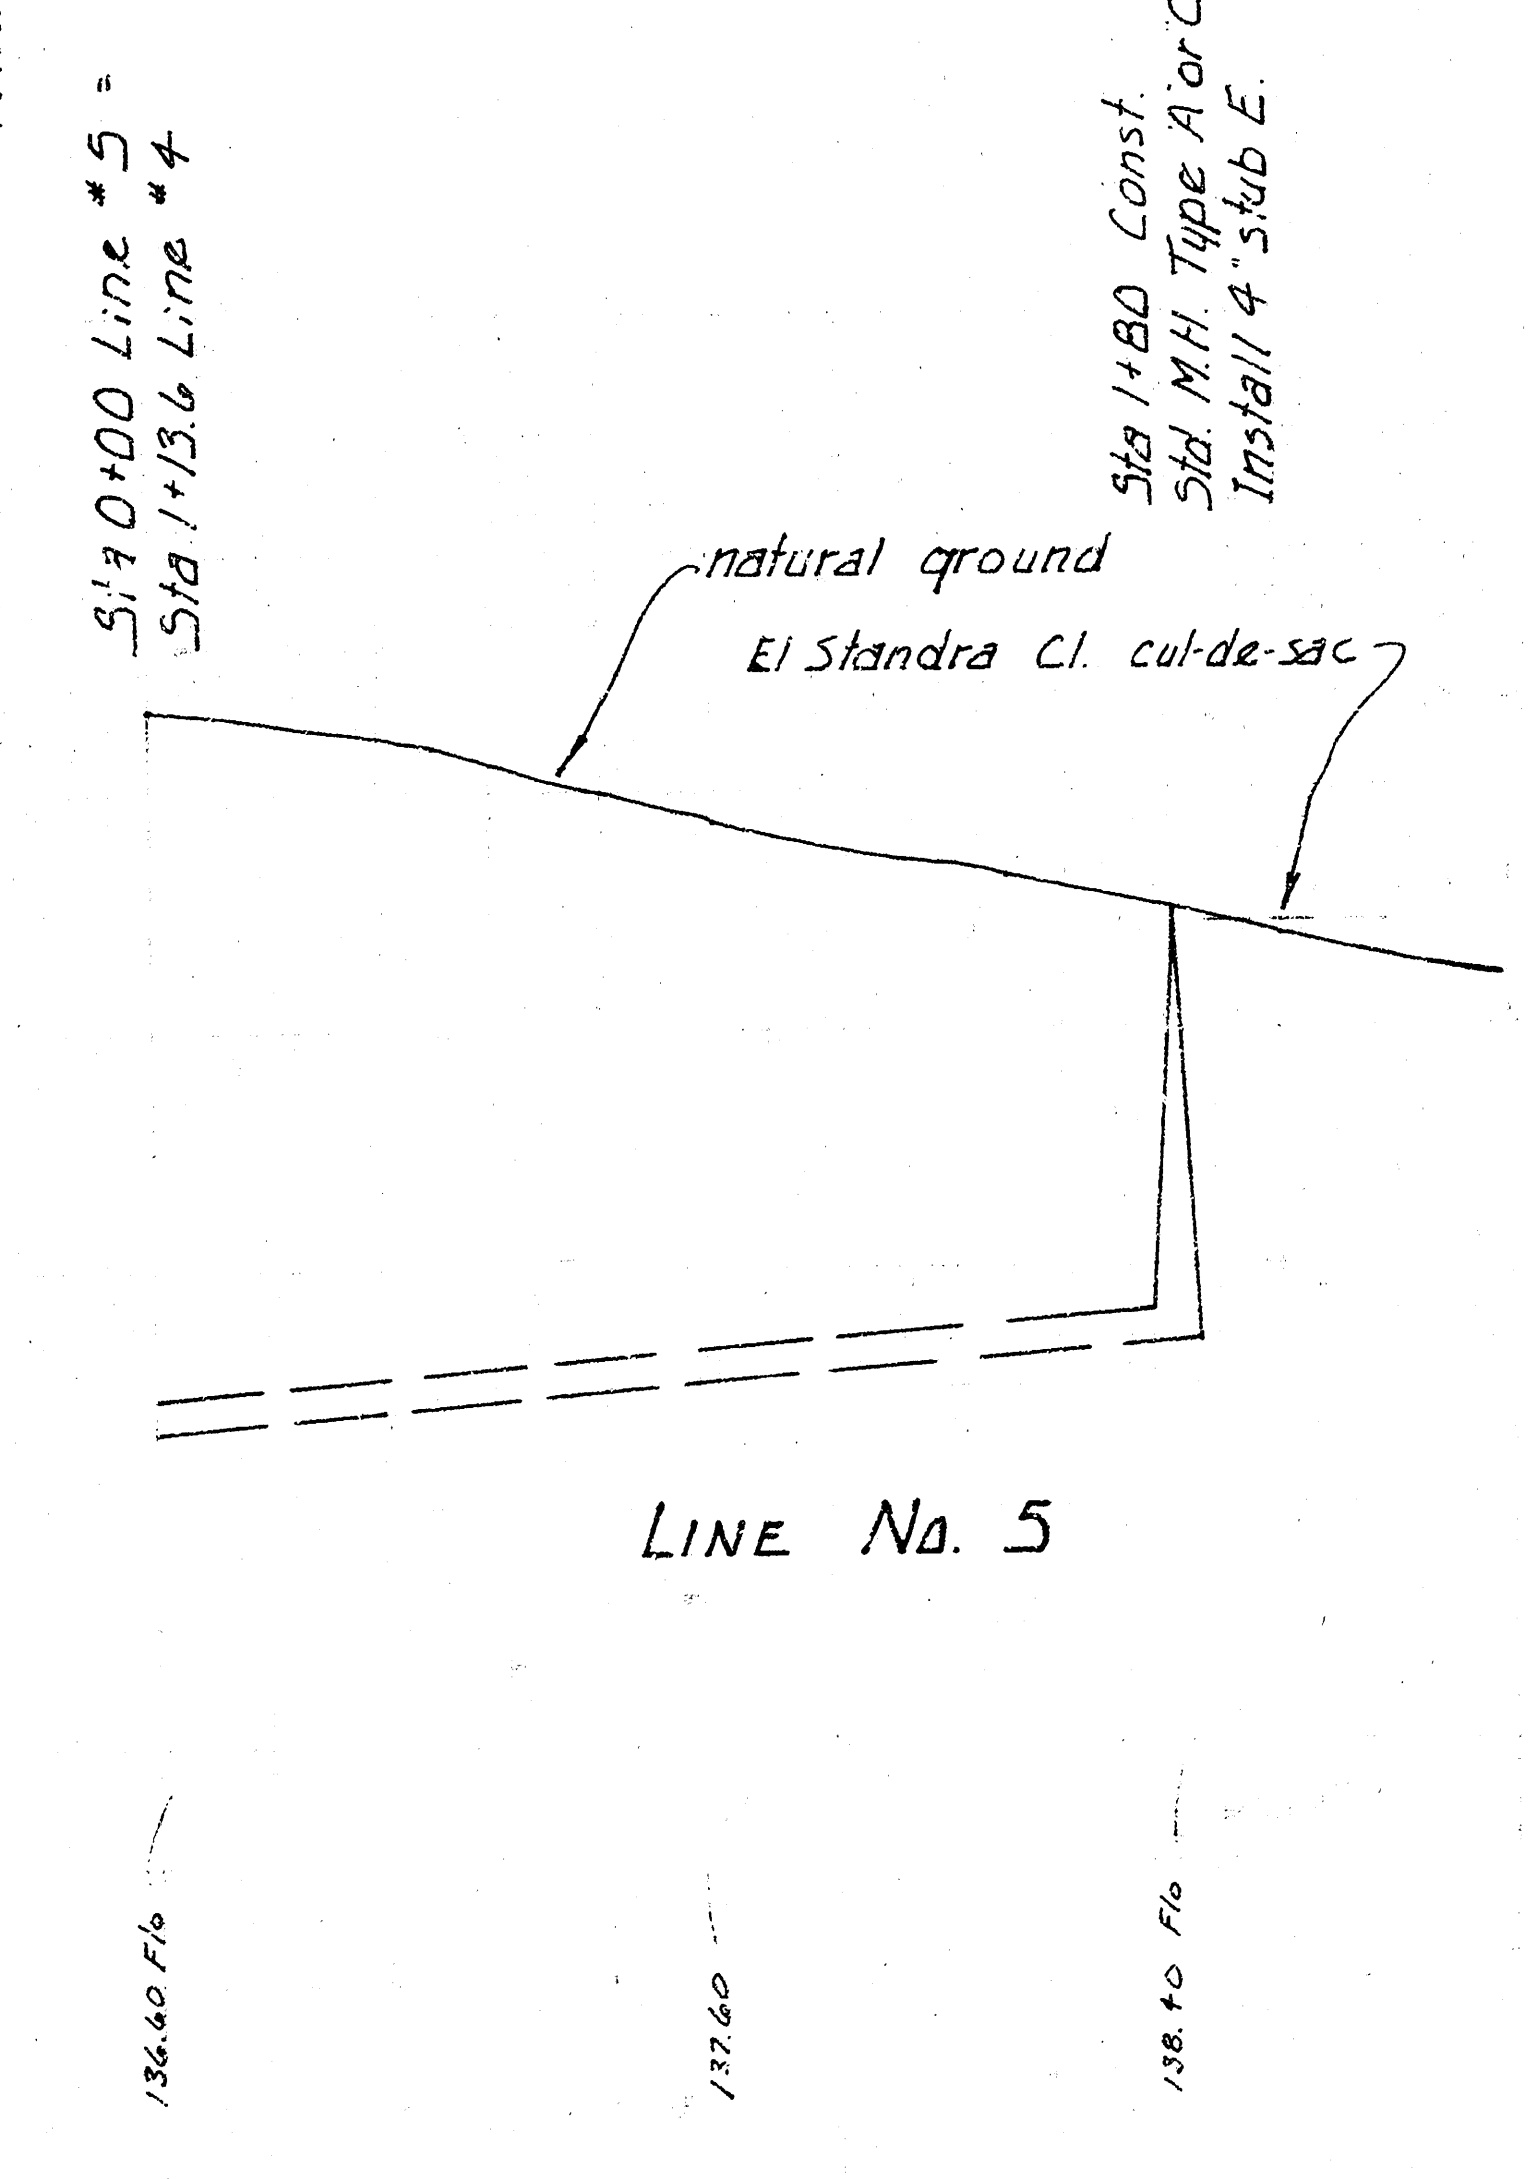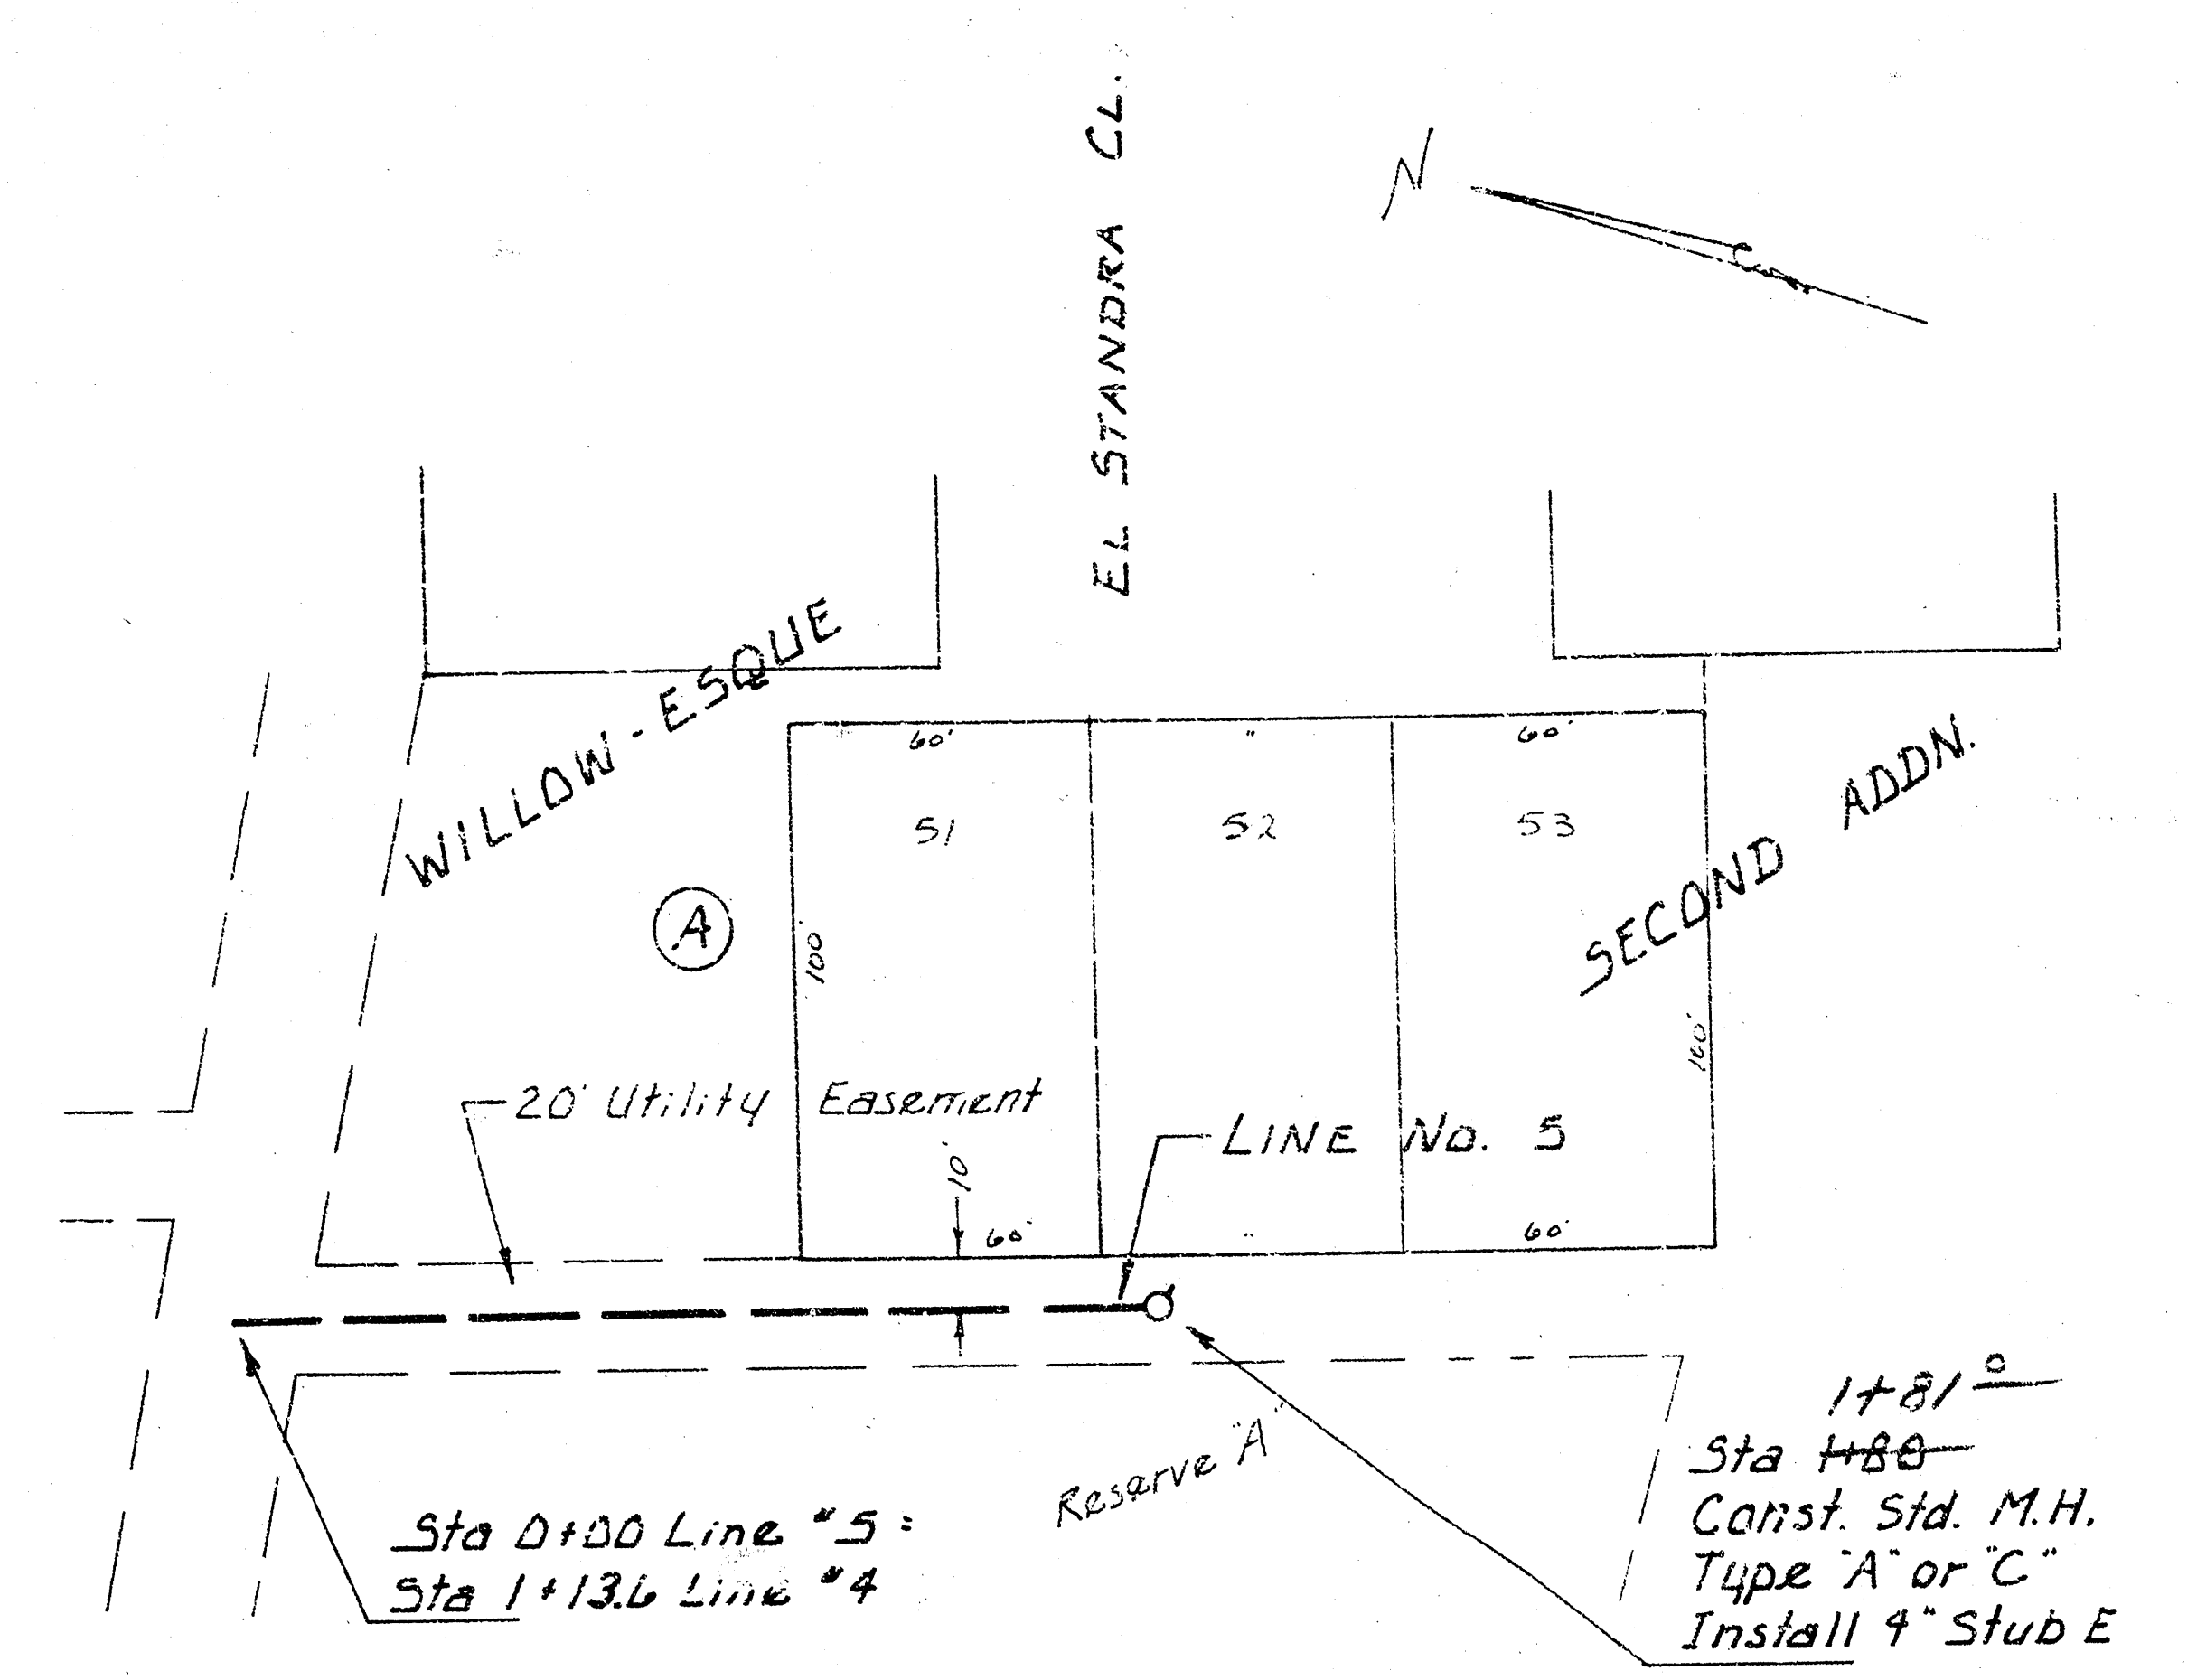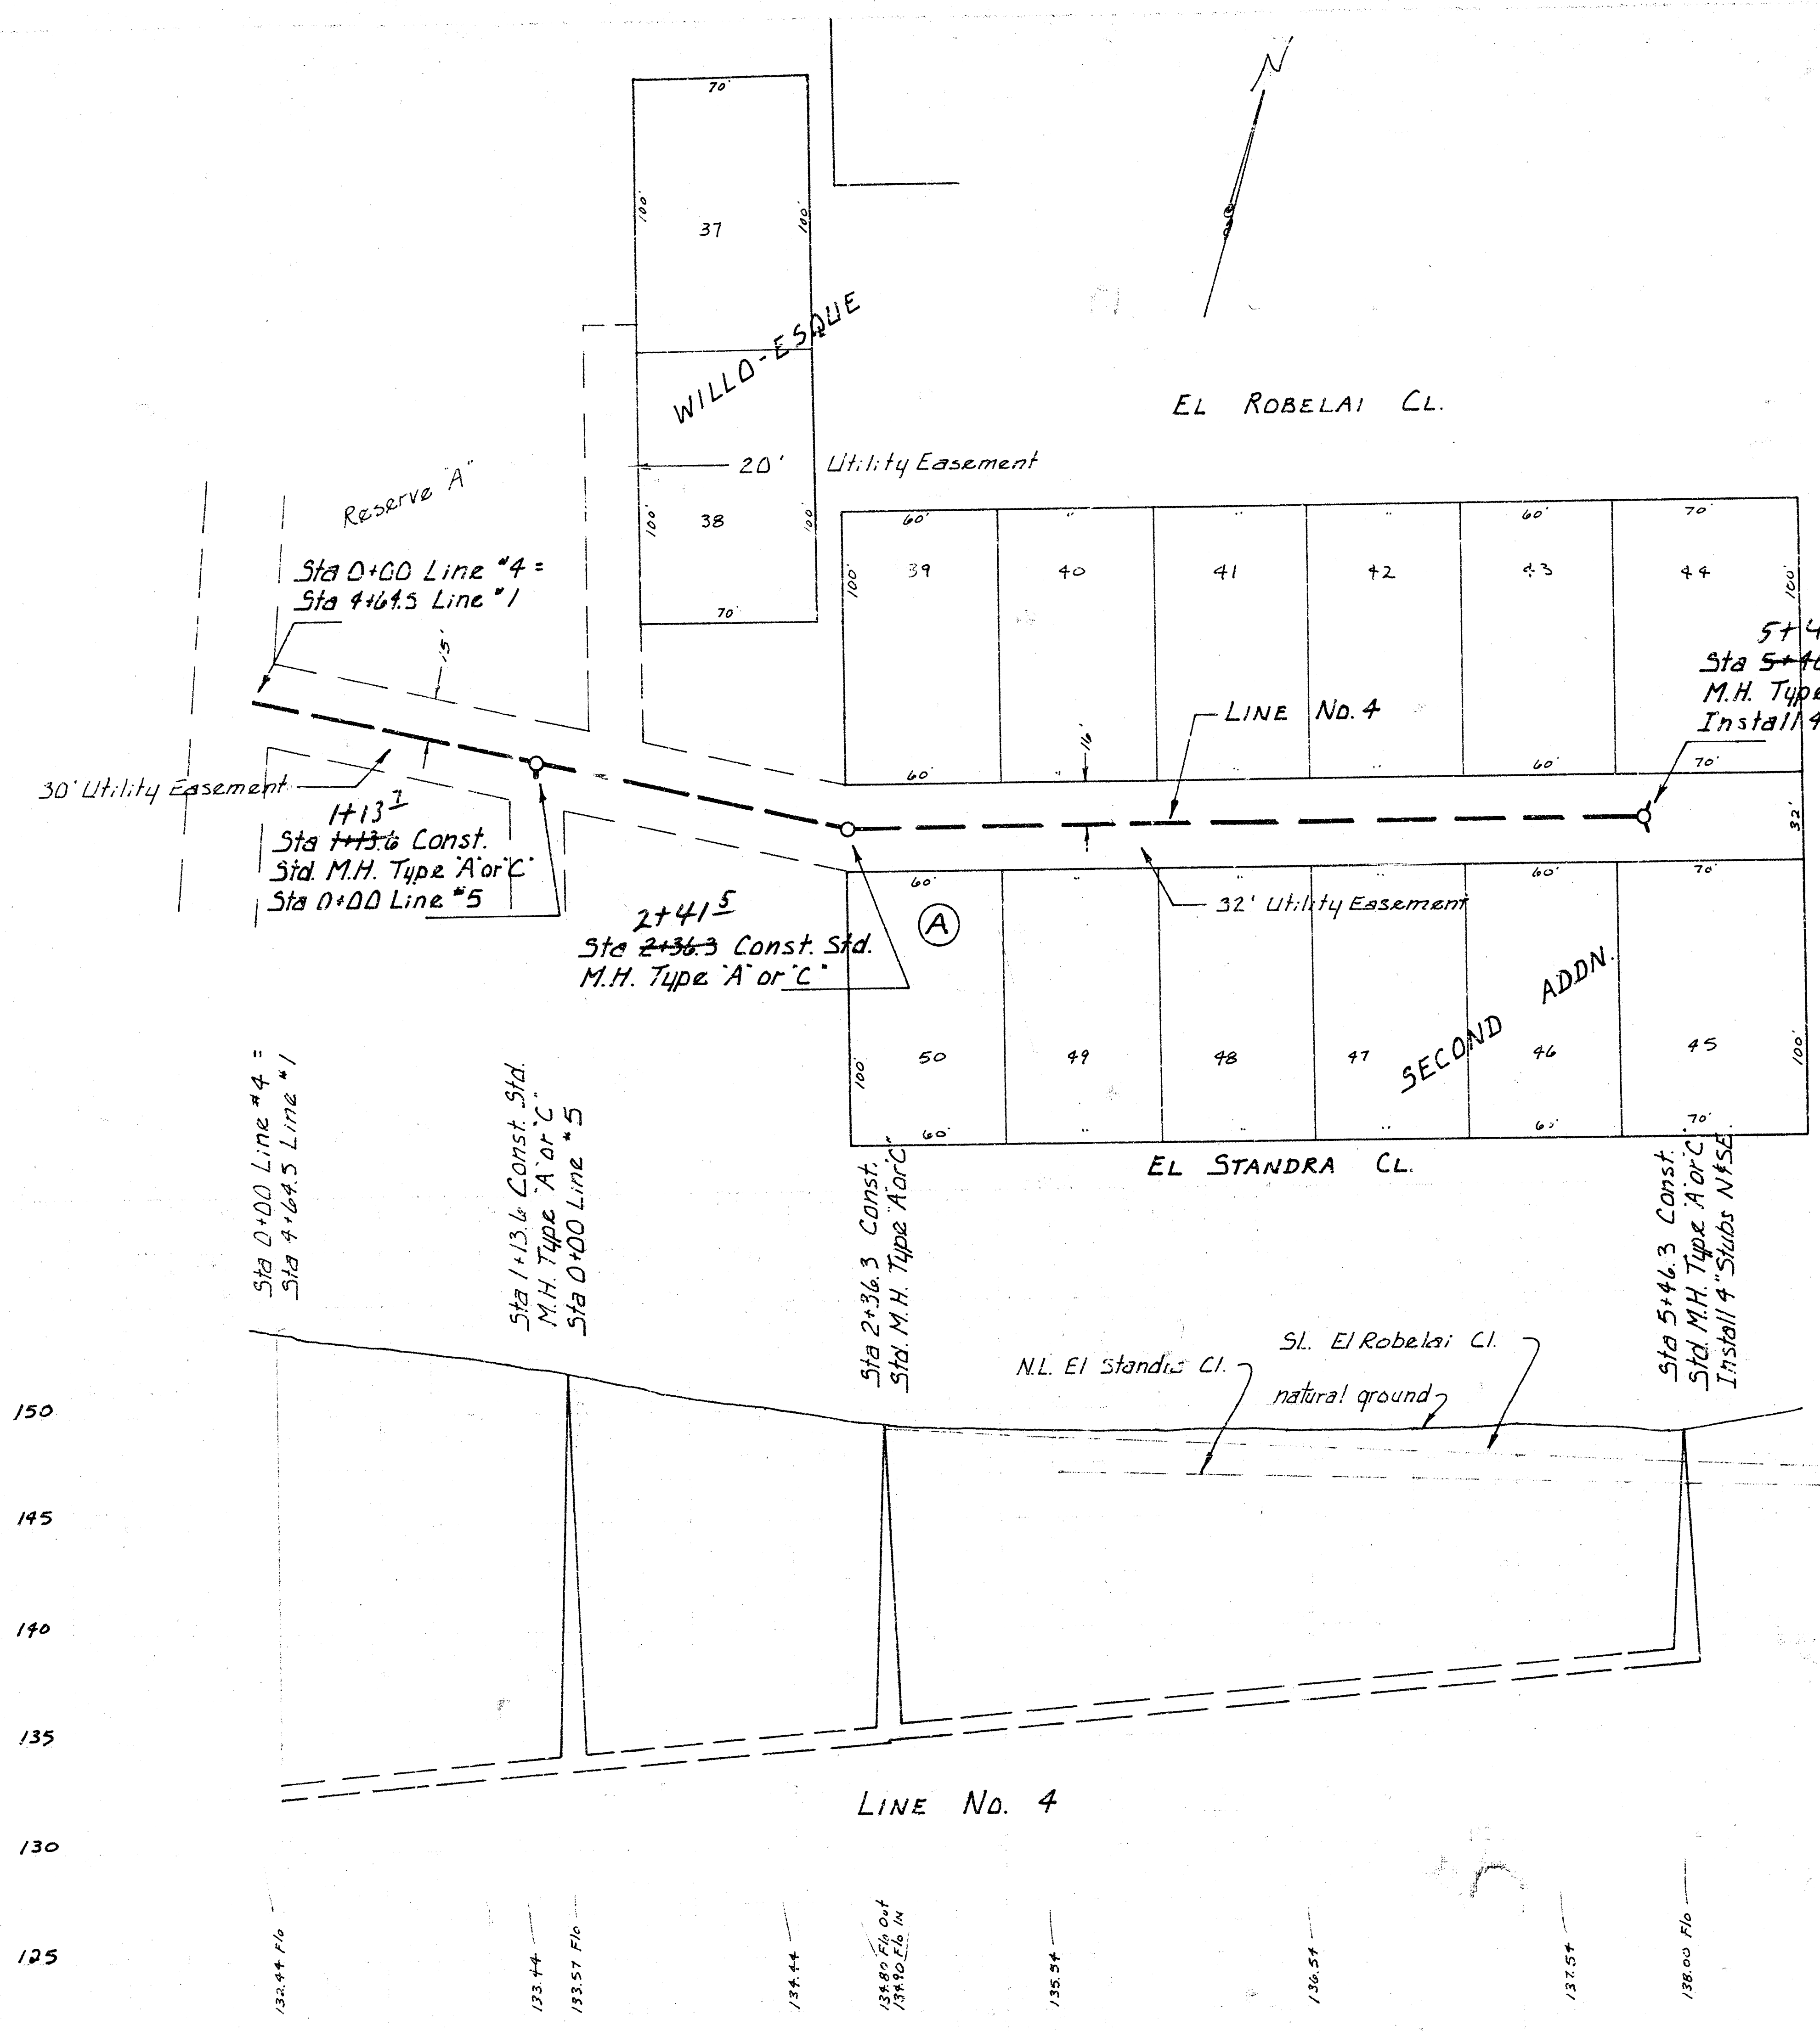







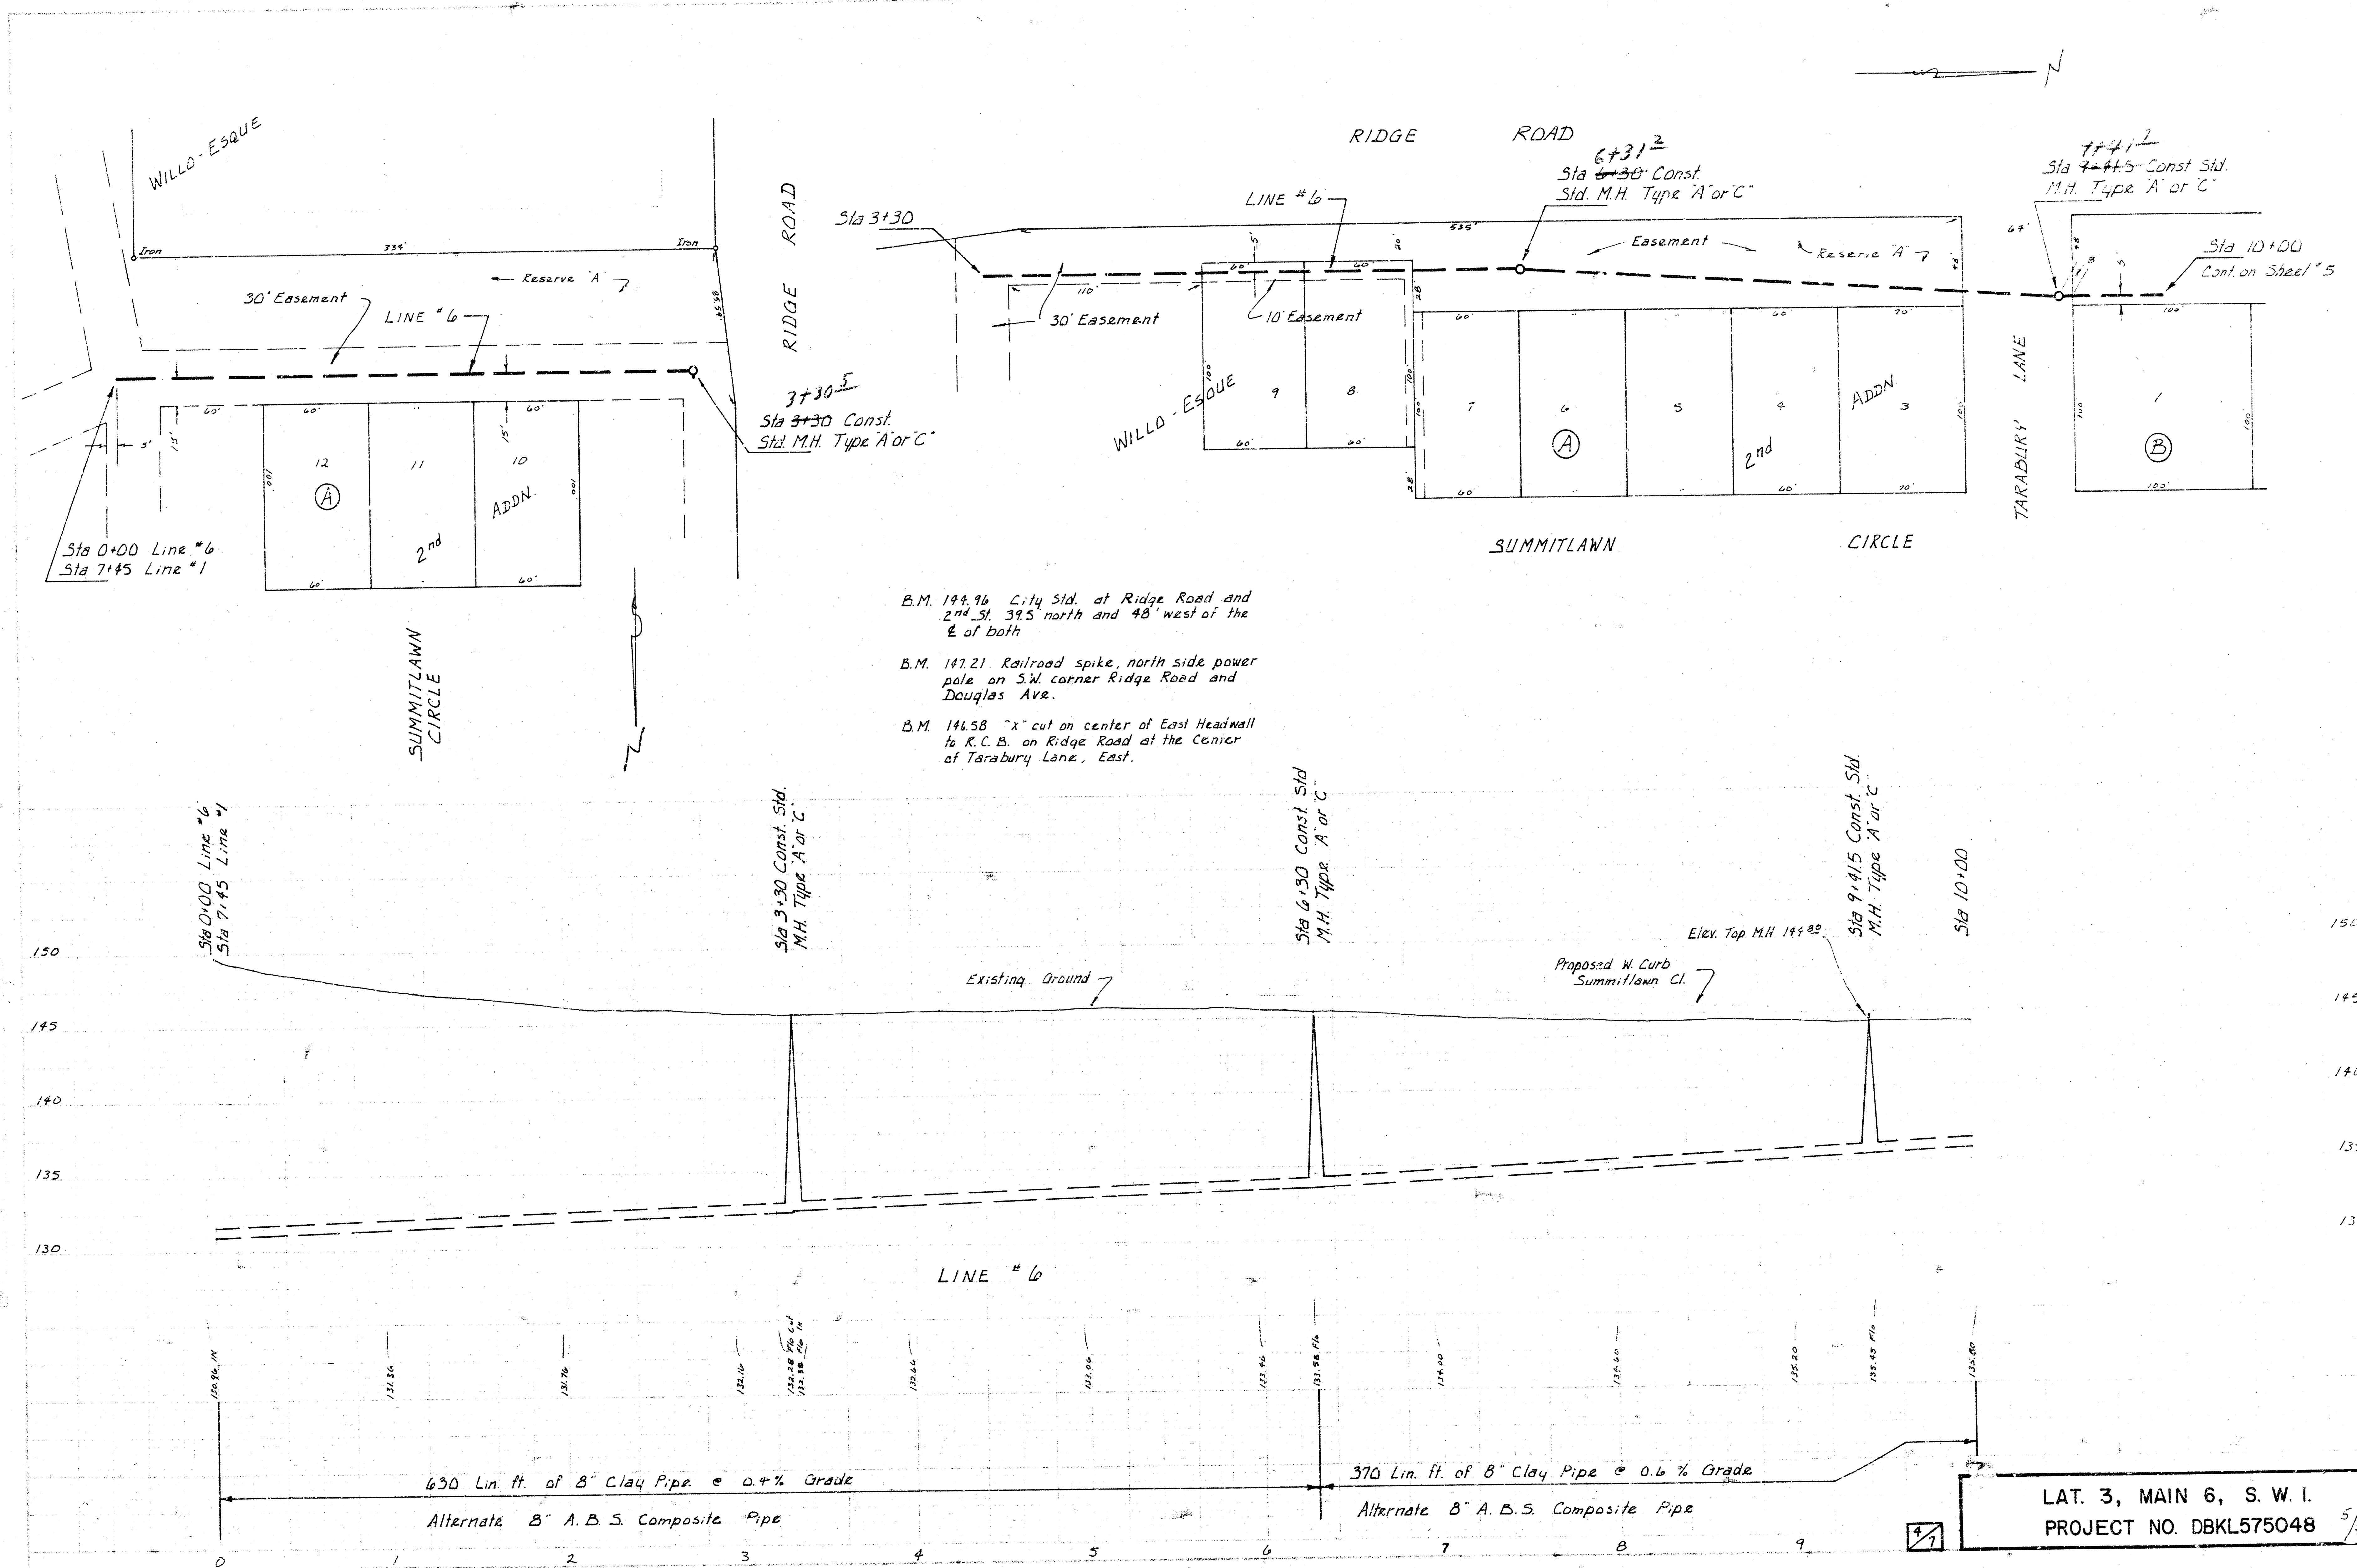




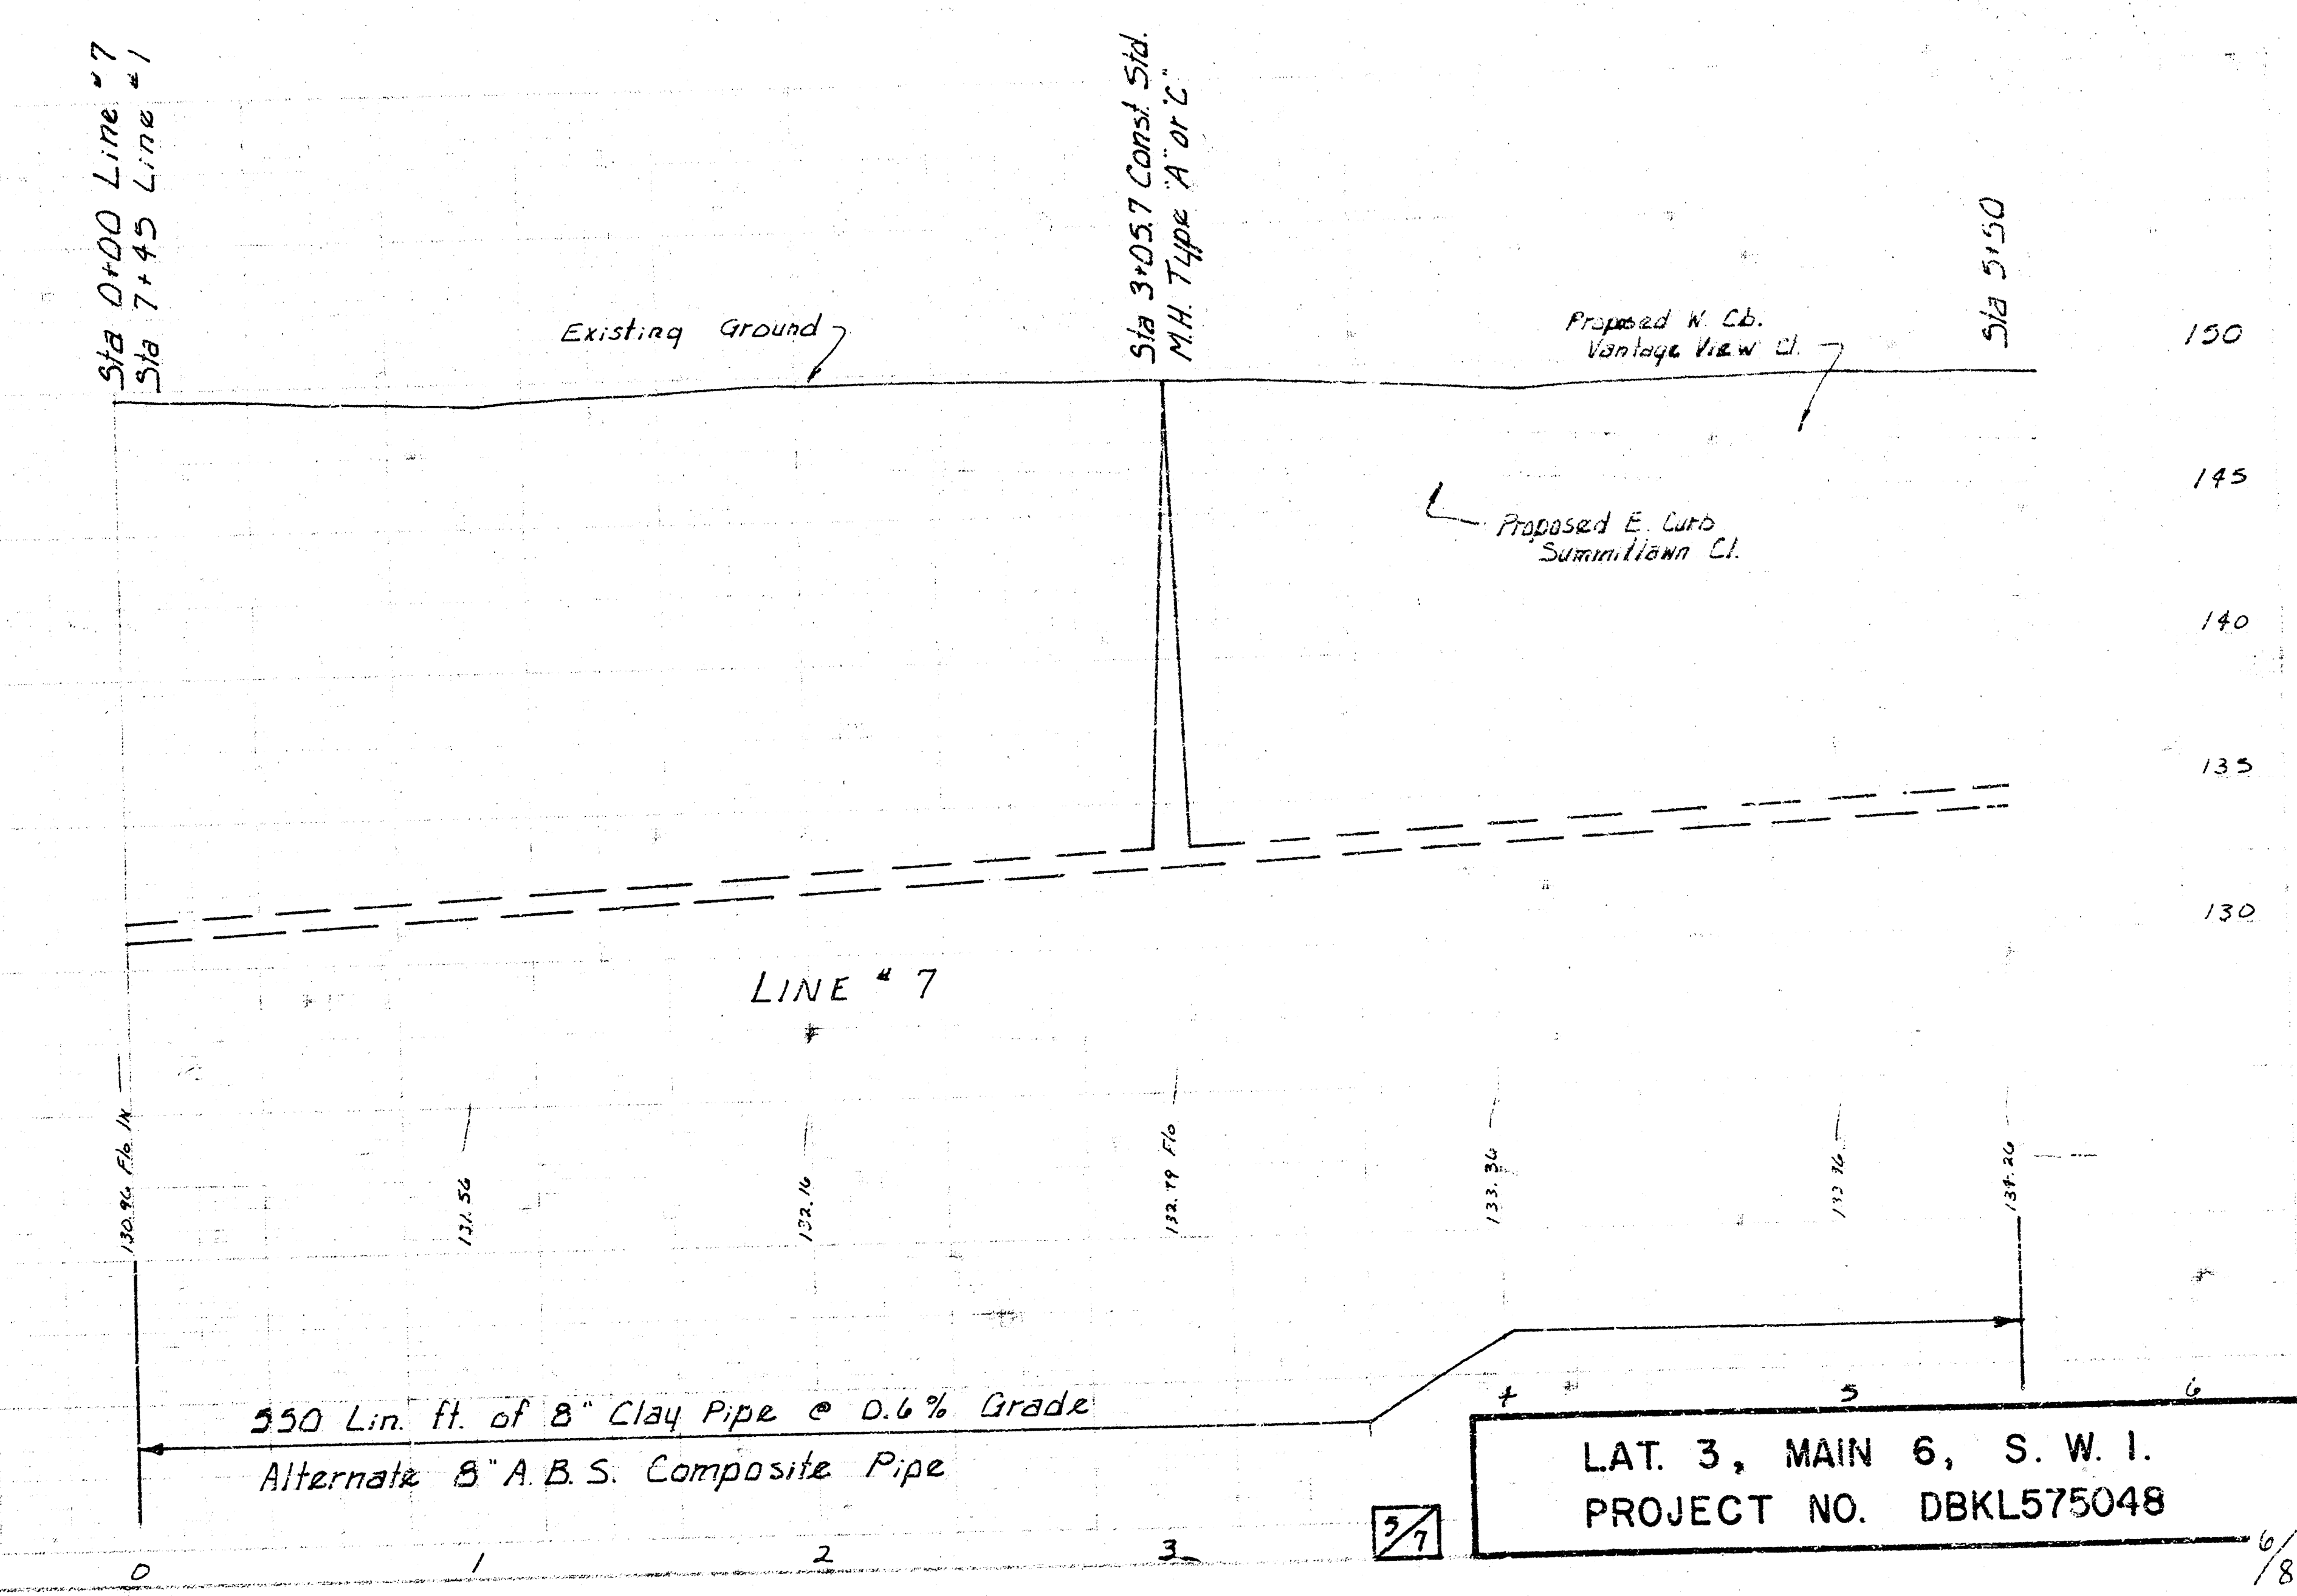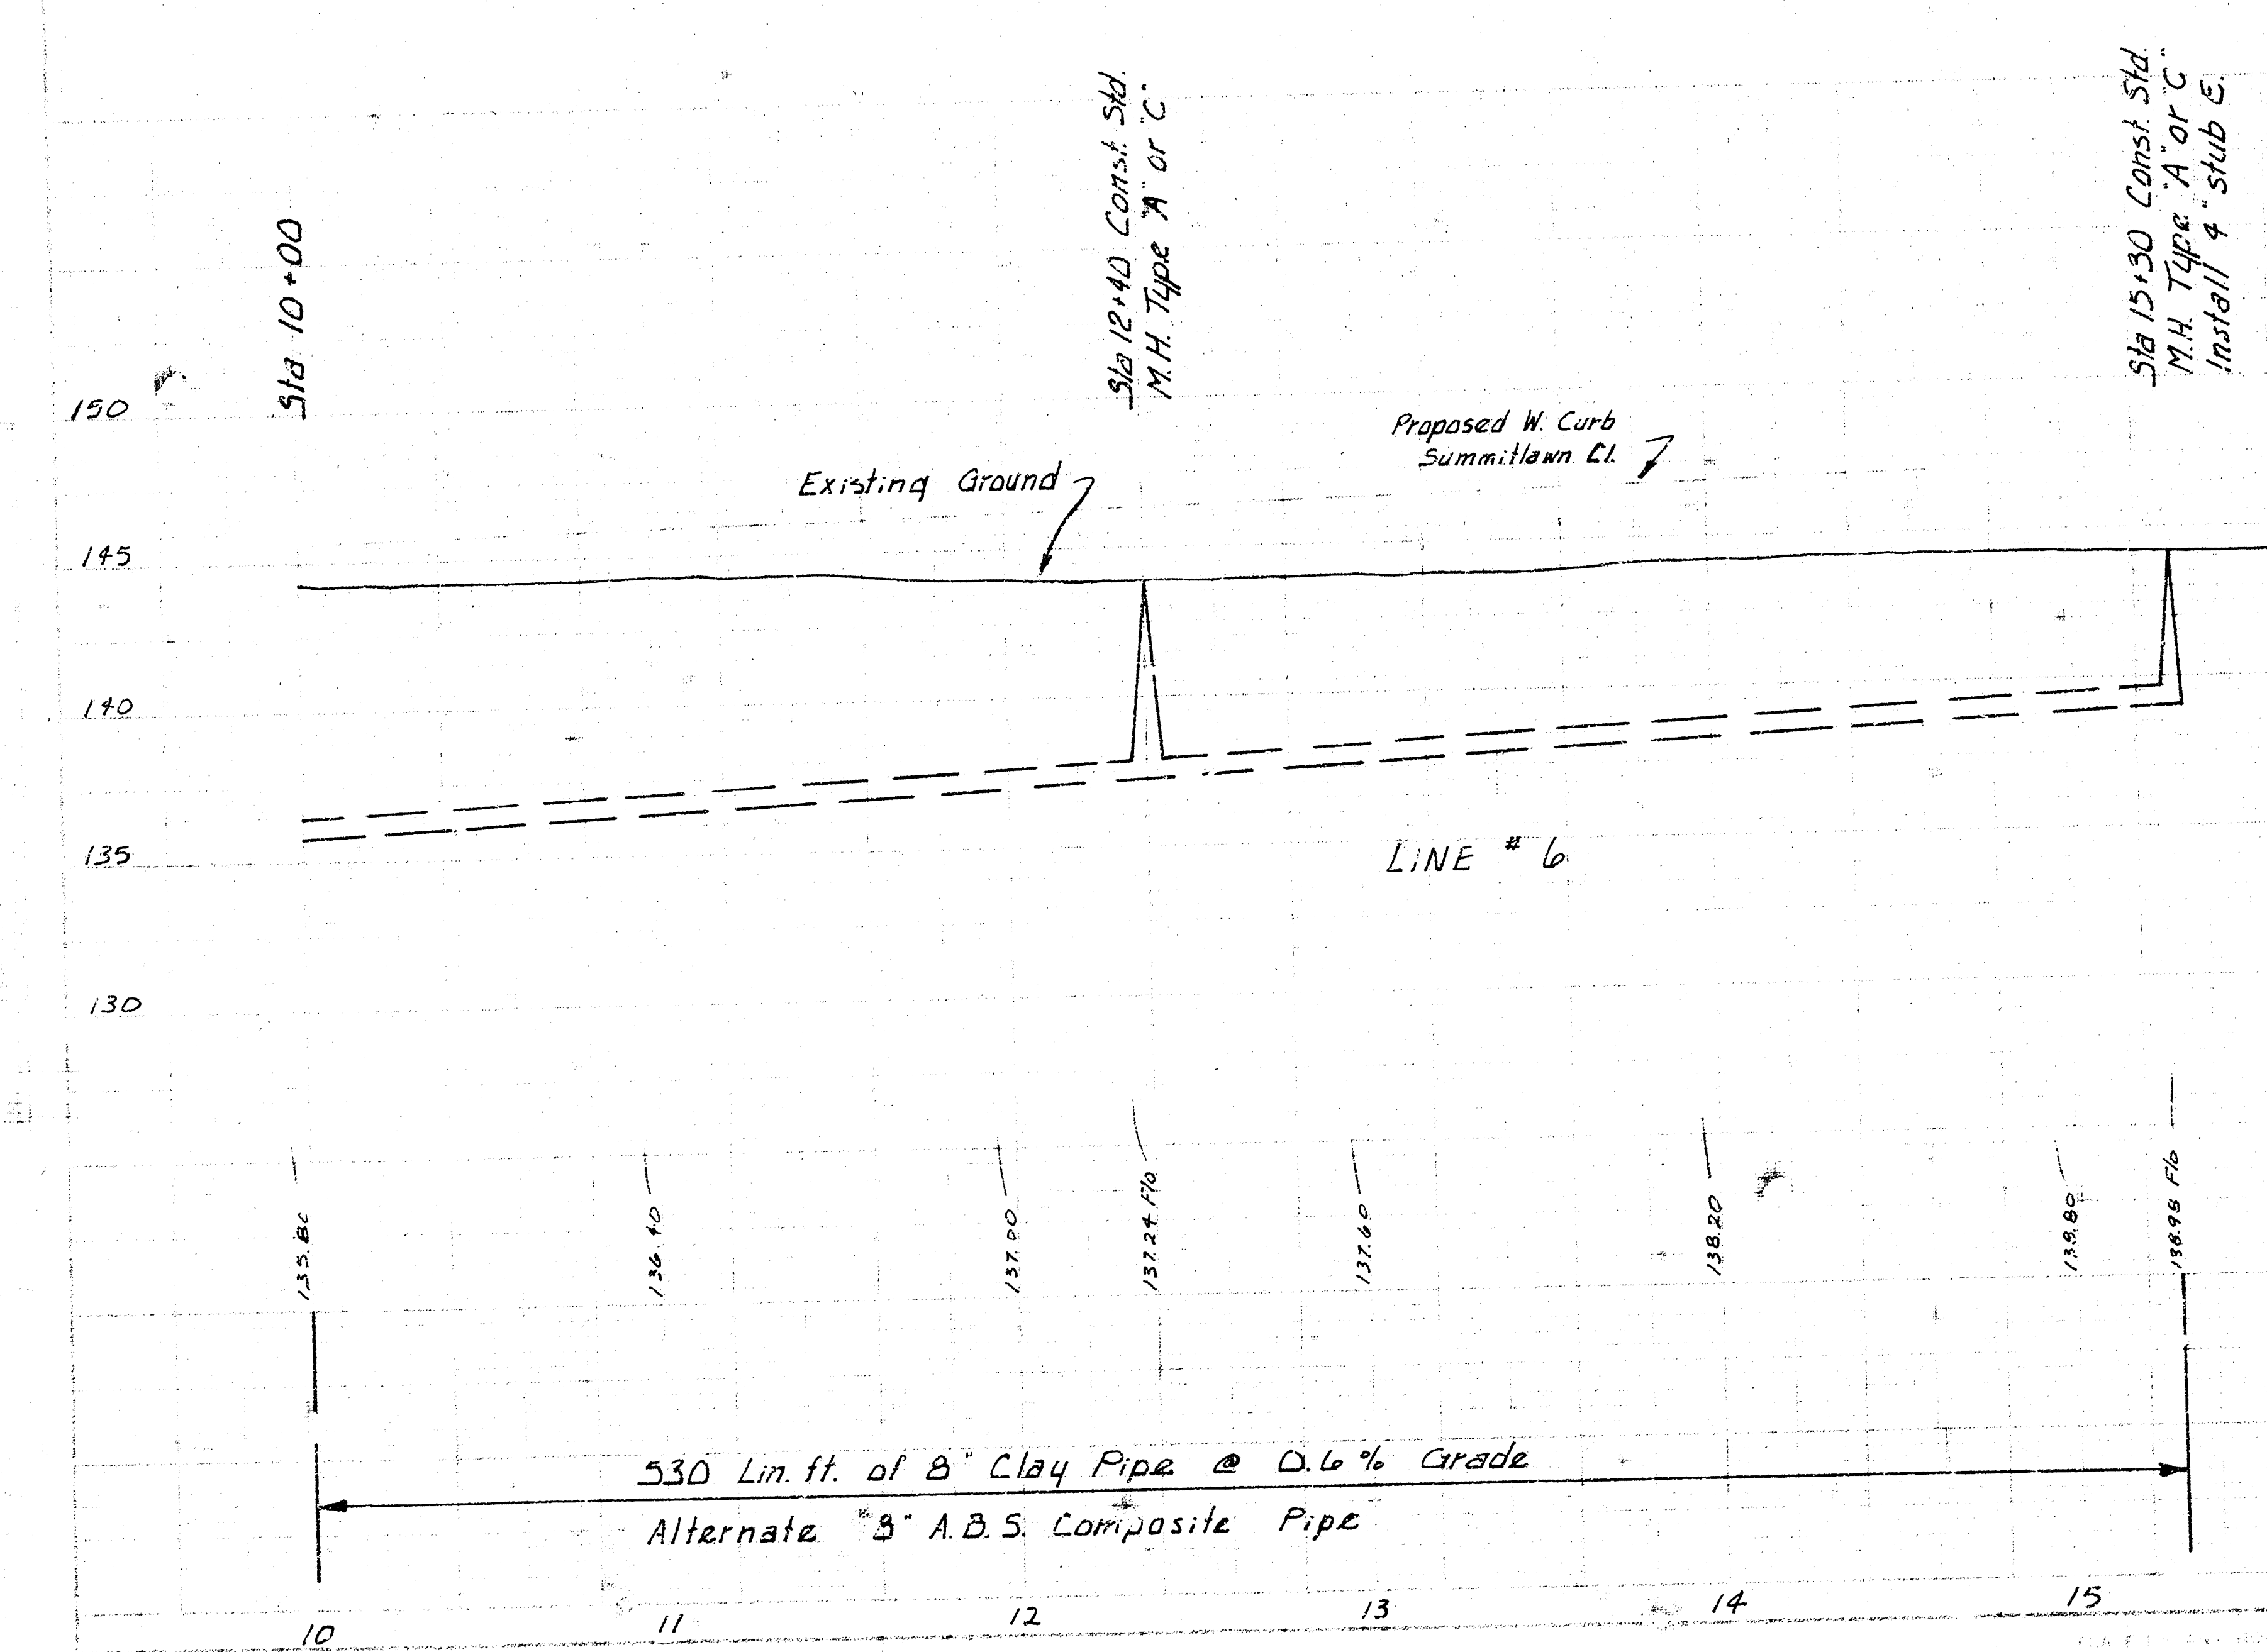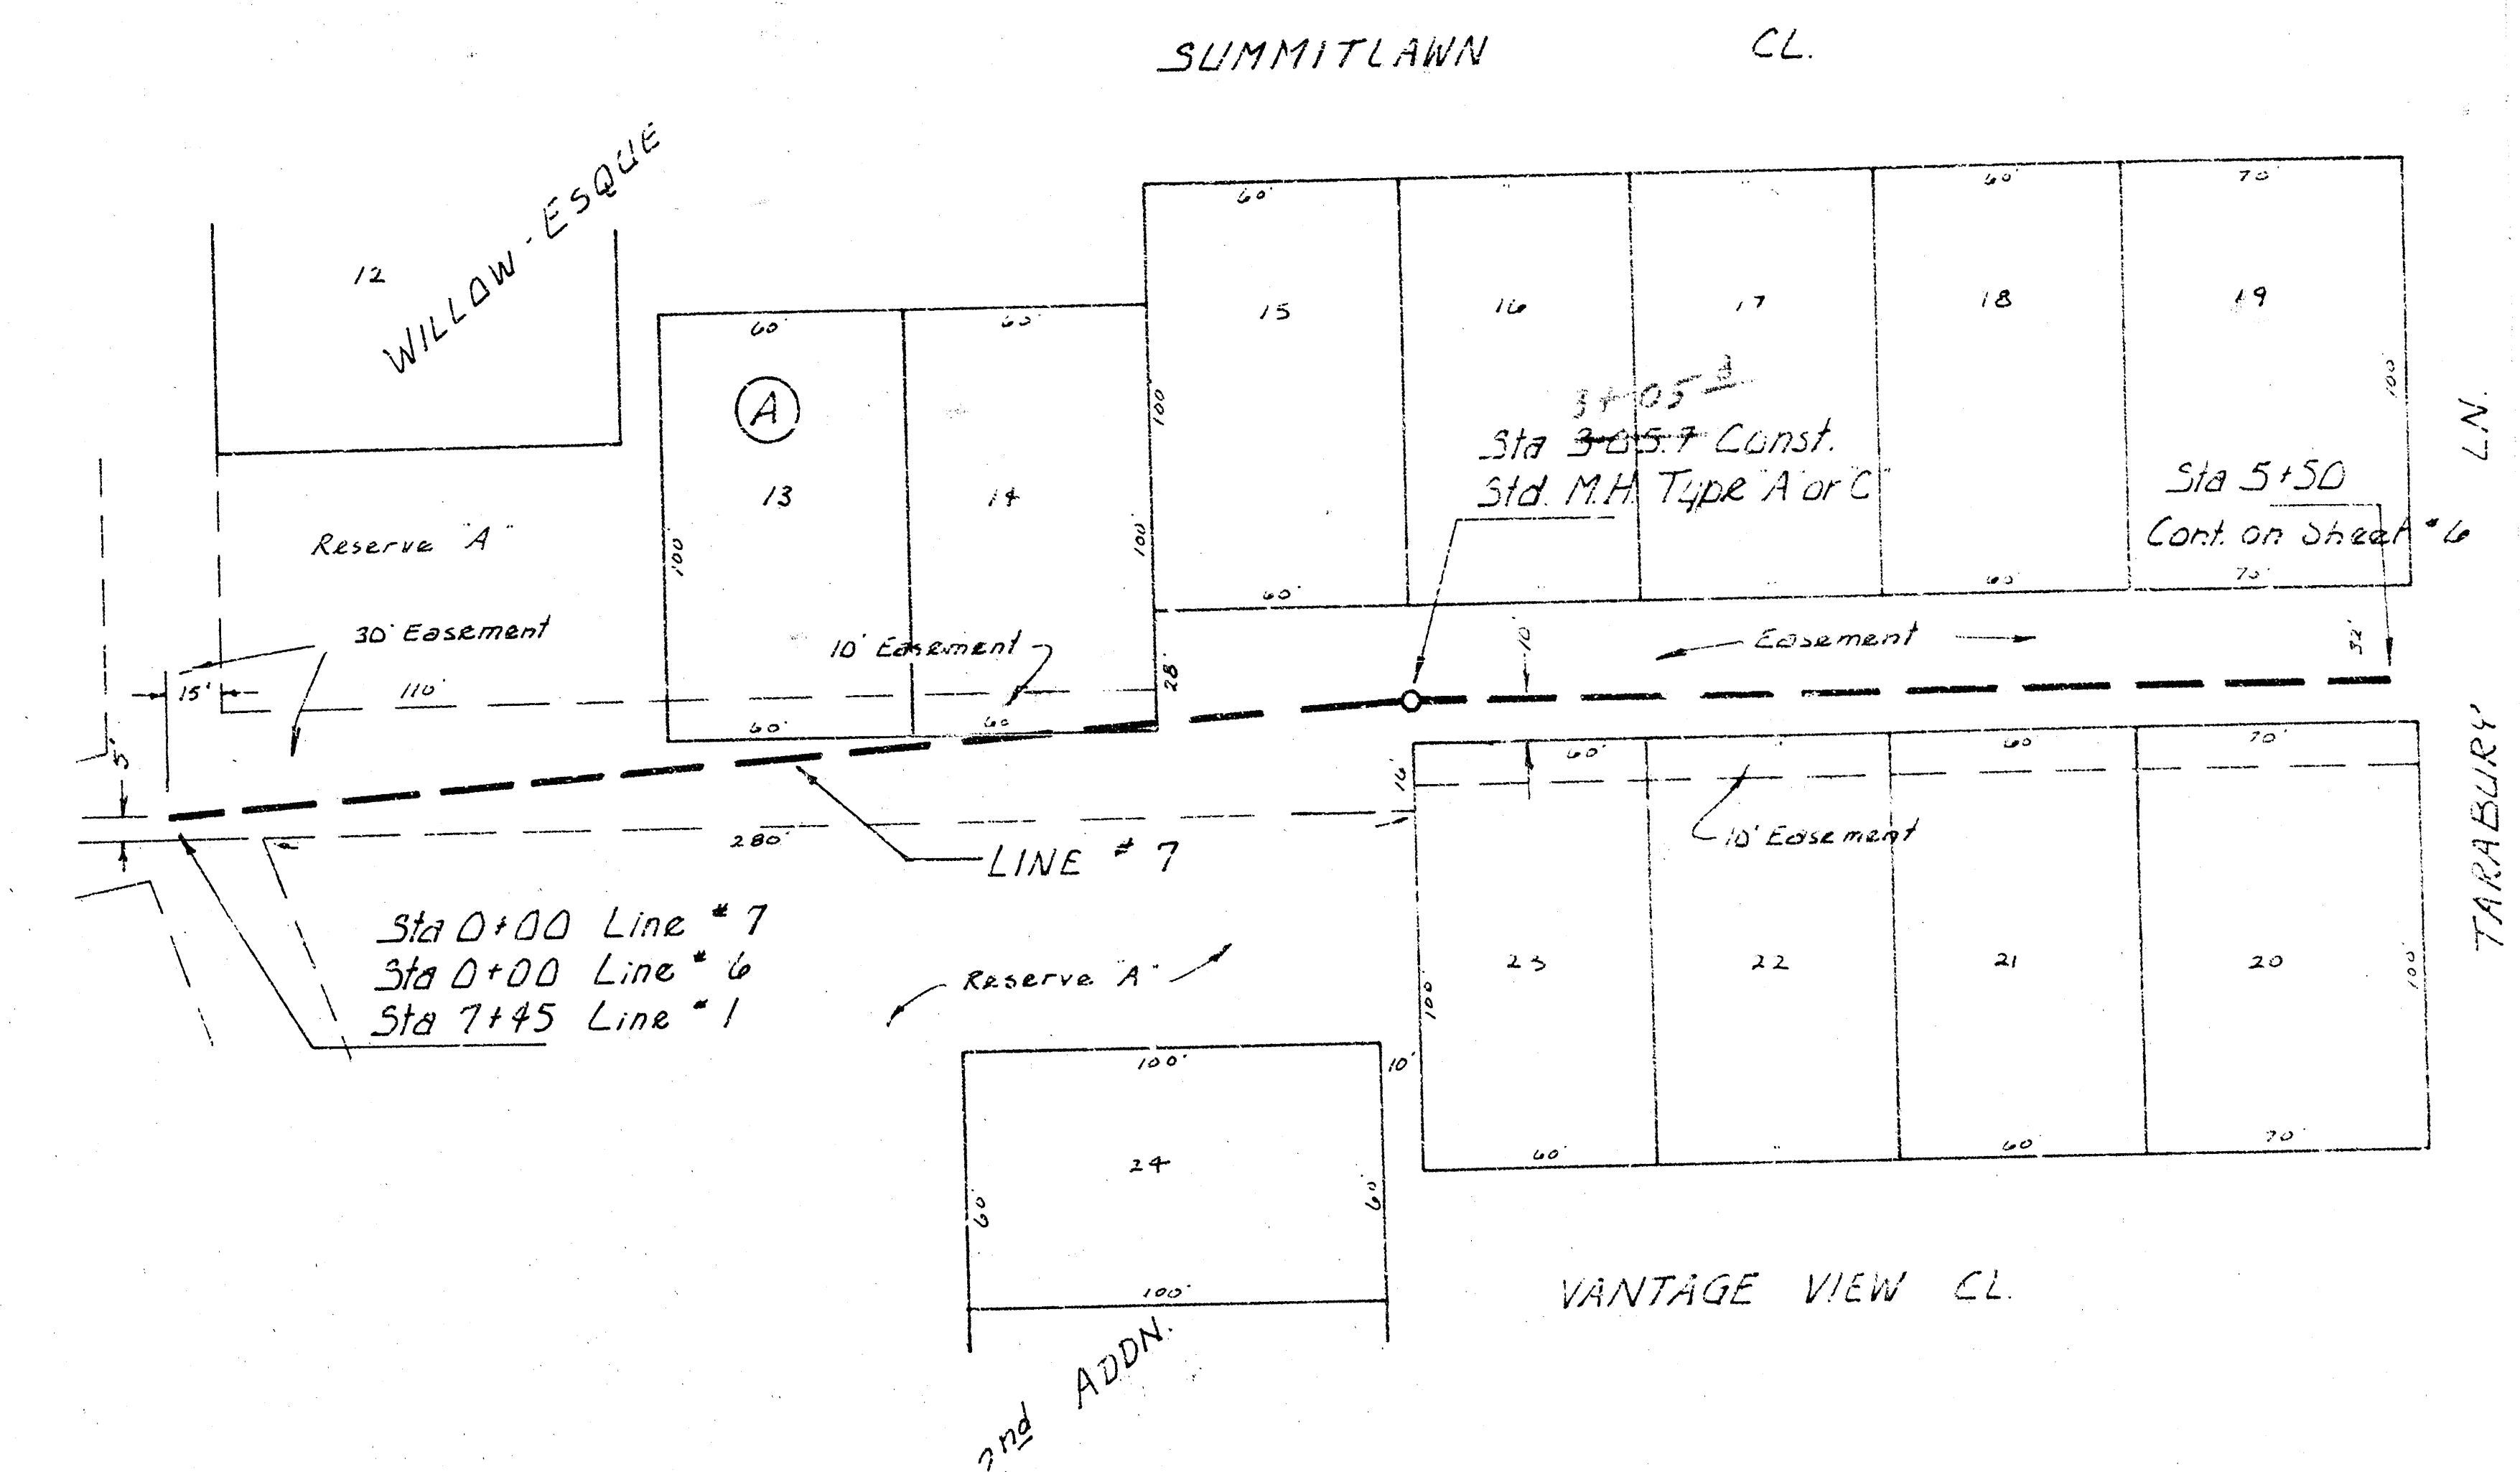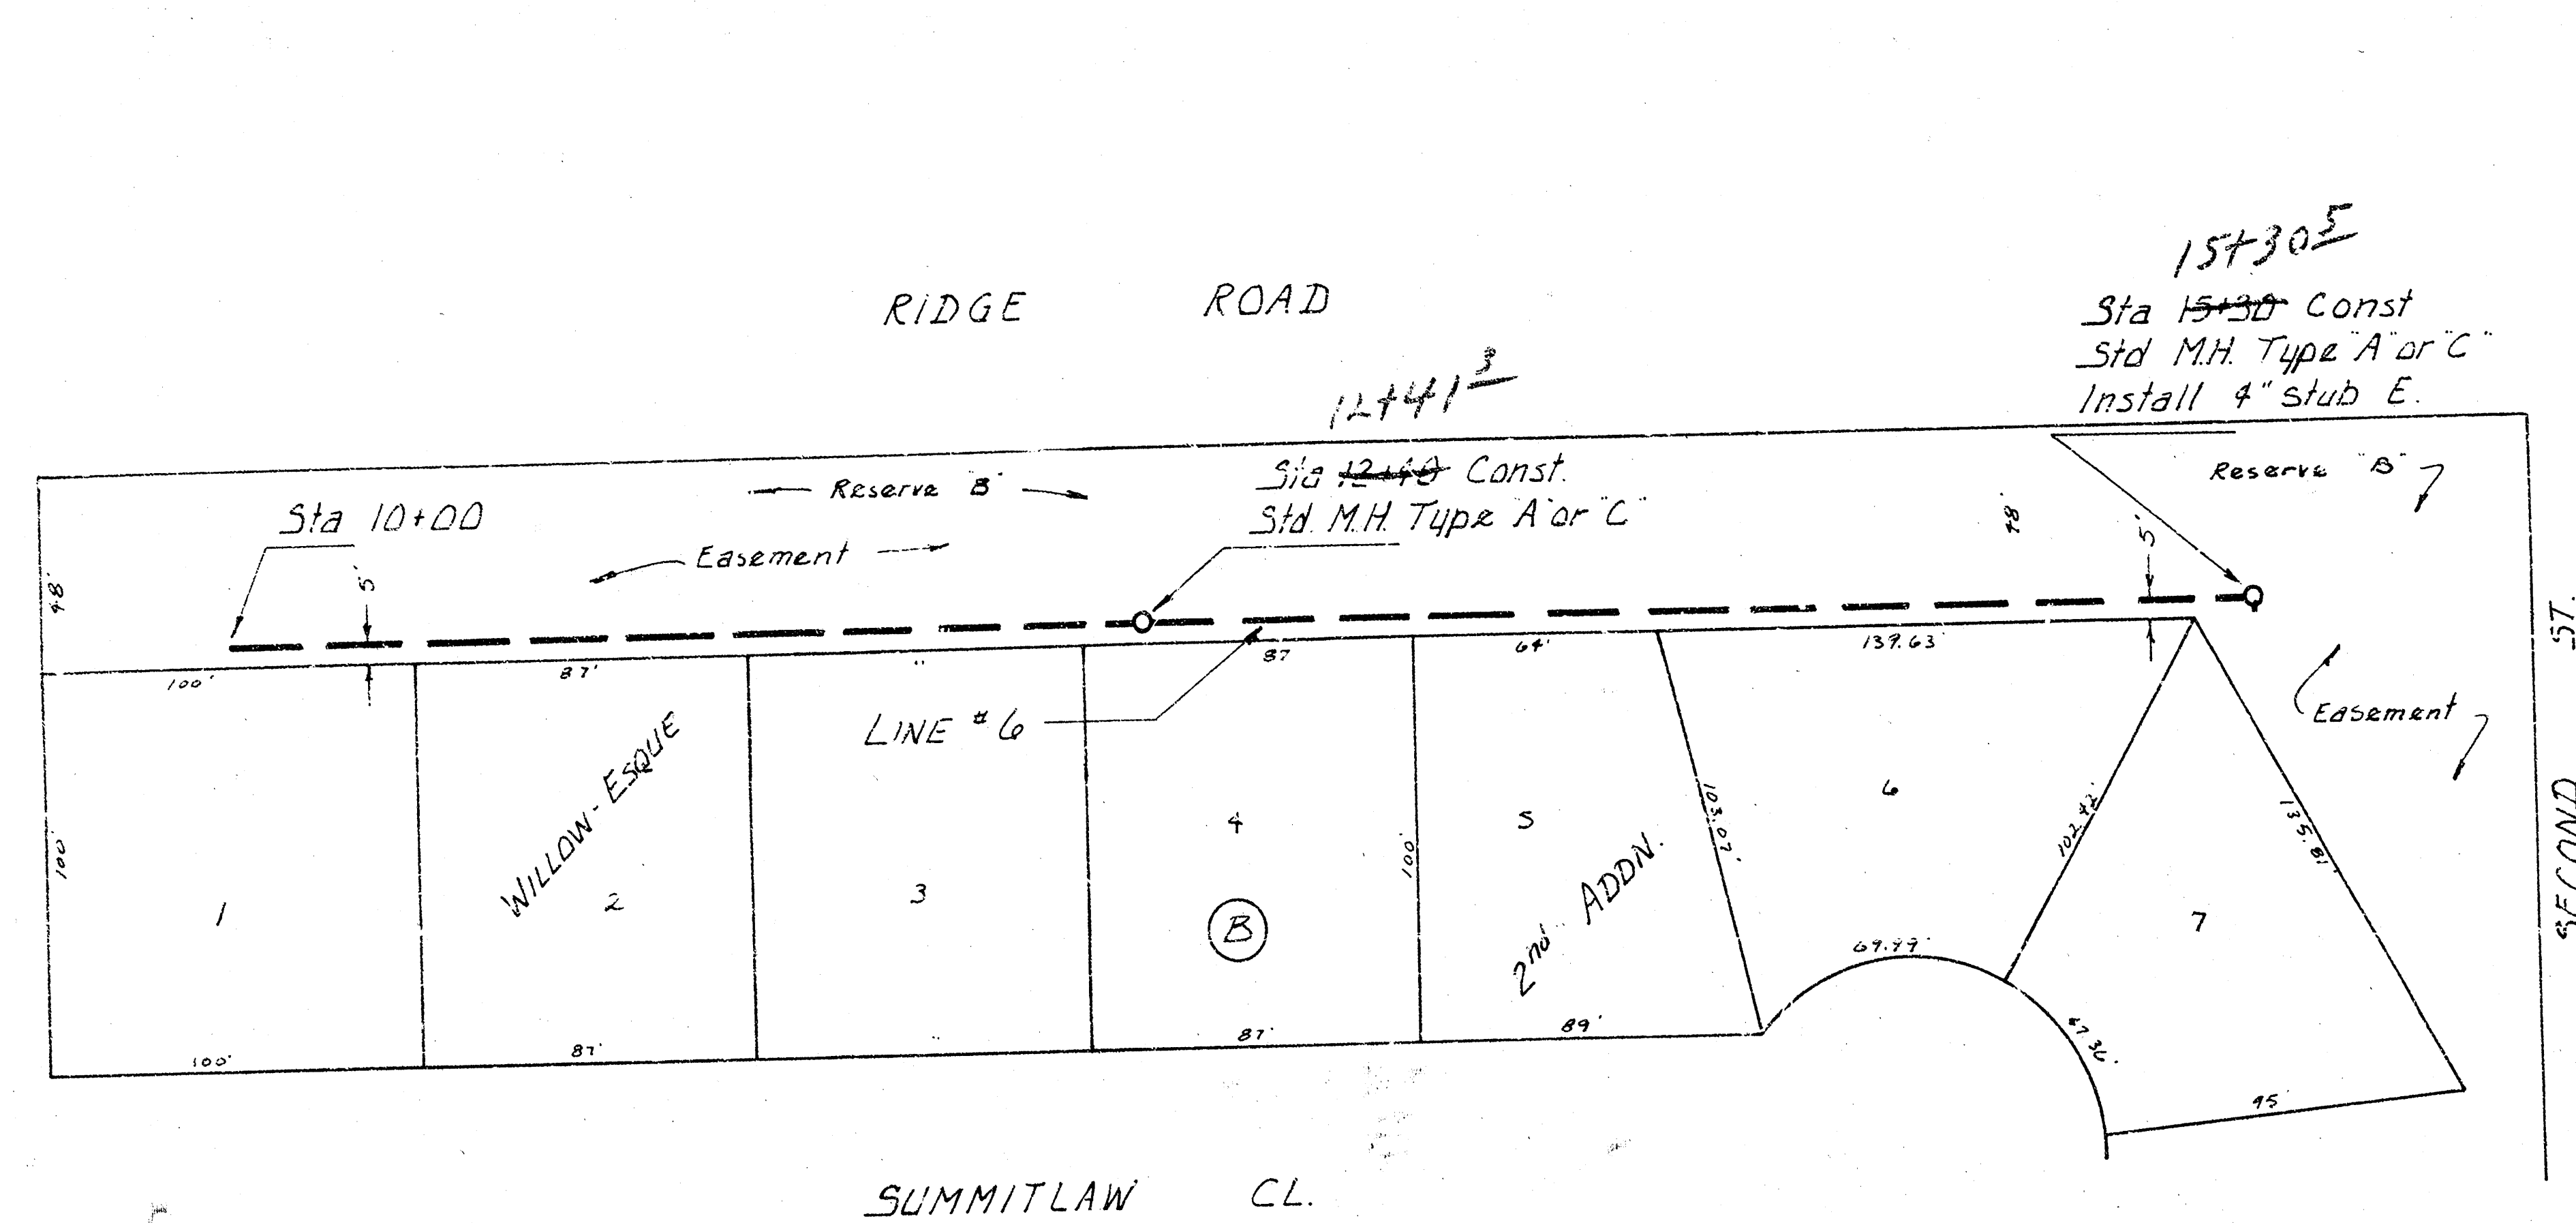


LAT. 3, MAIN 6, S. W. I.  
PROJECT NO. DBKL575048



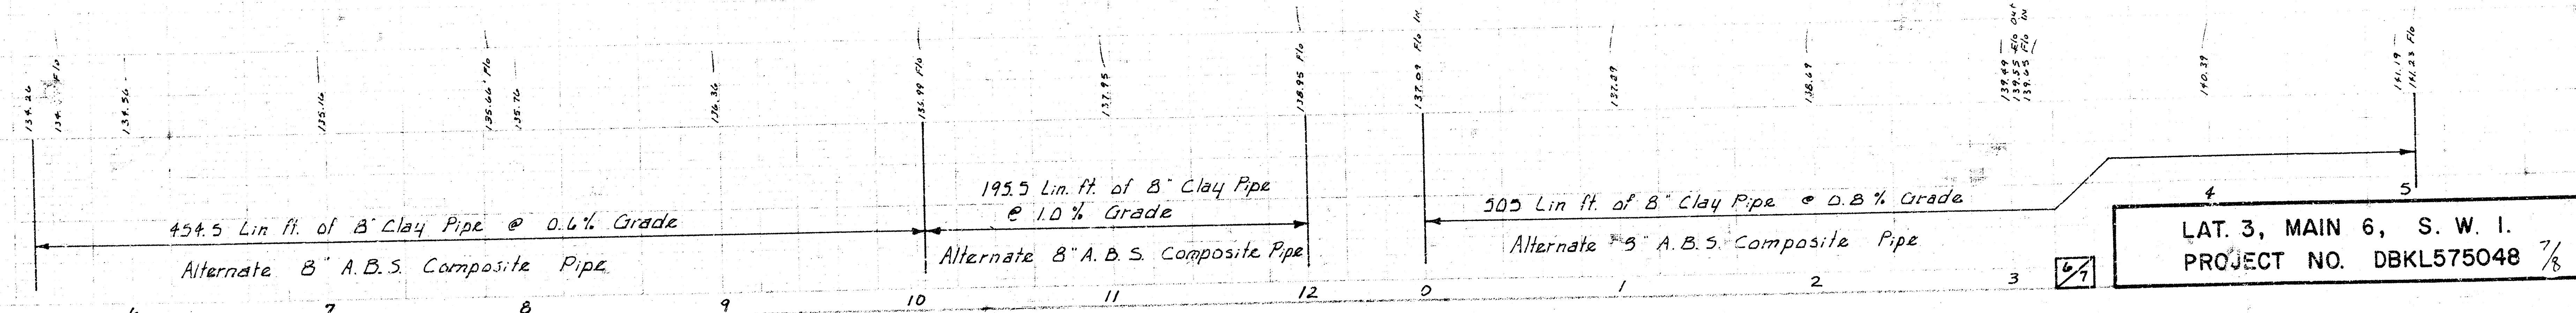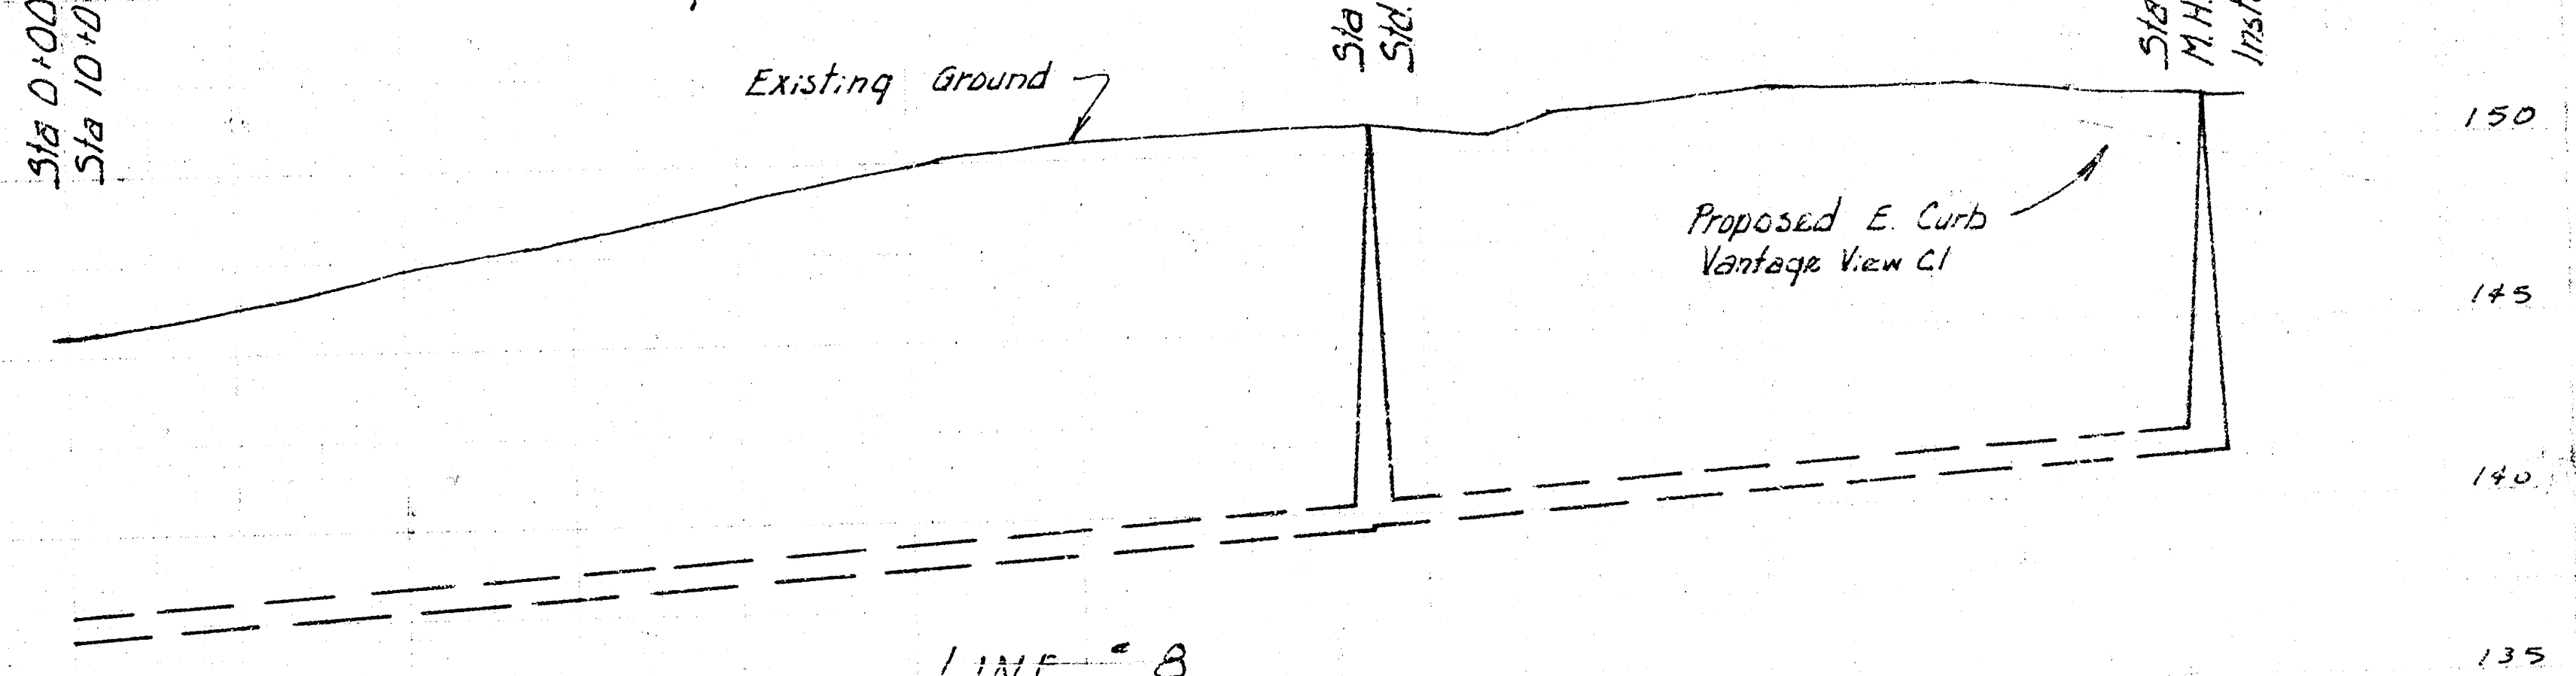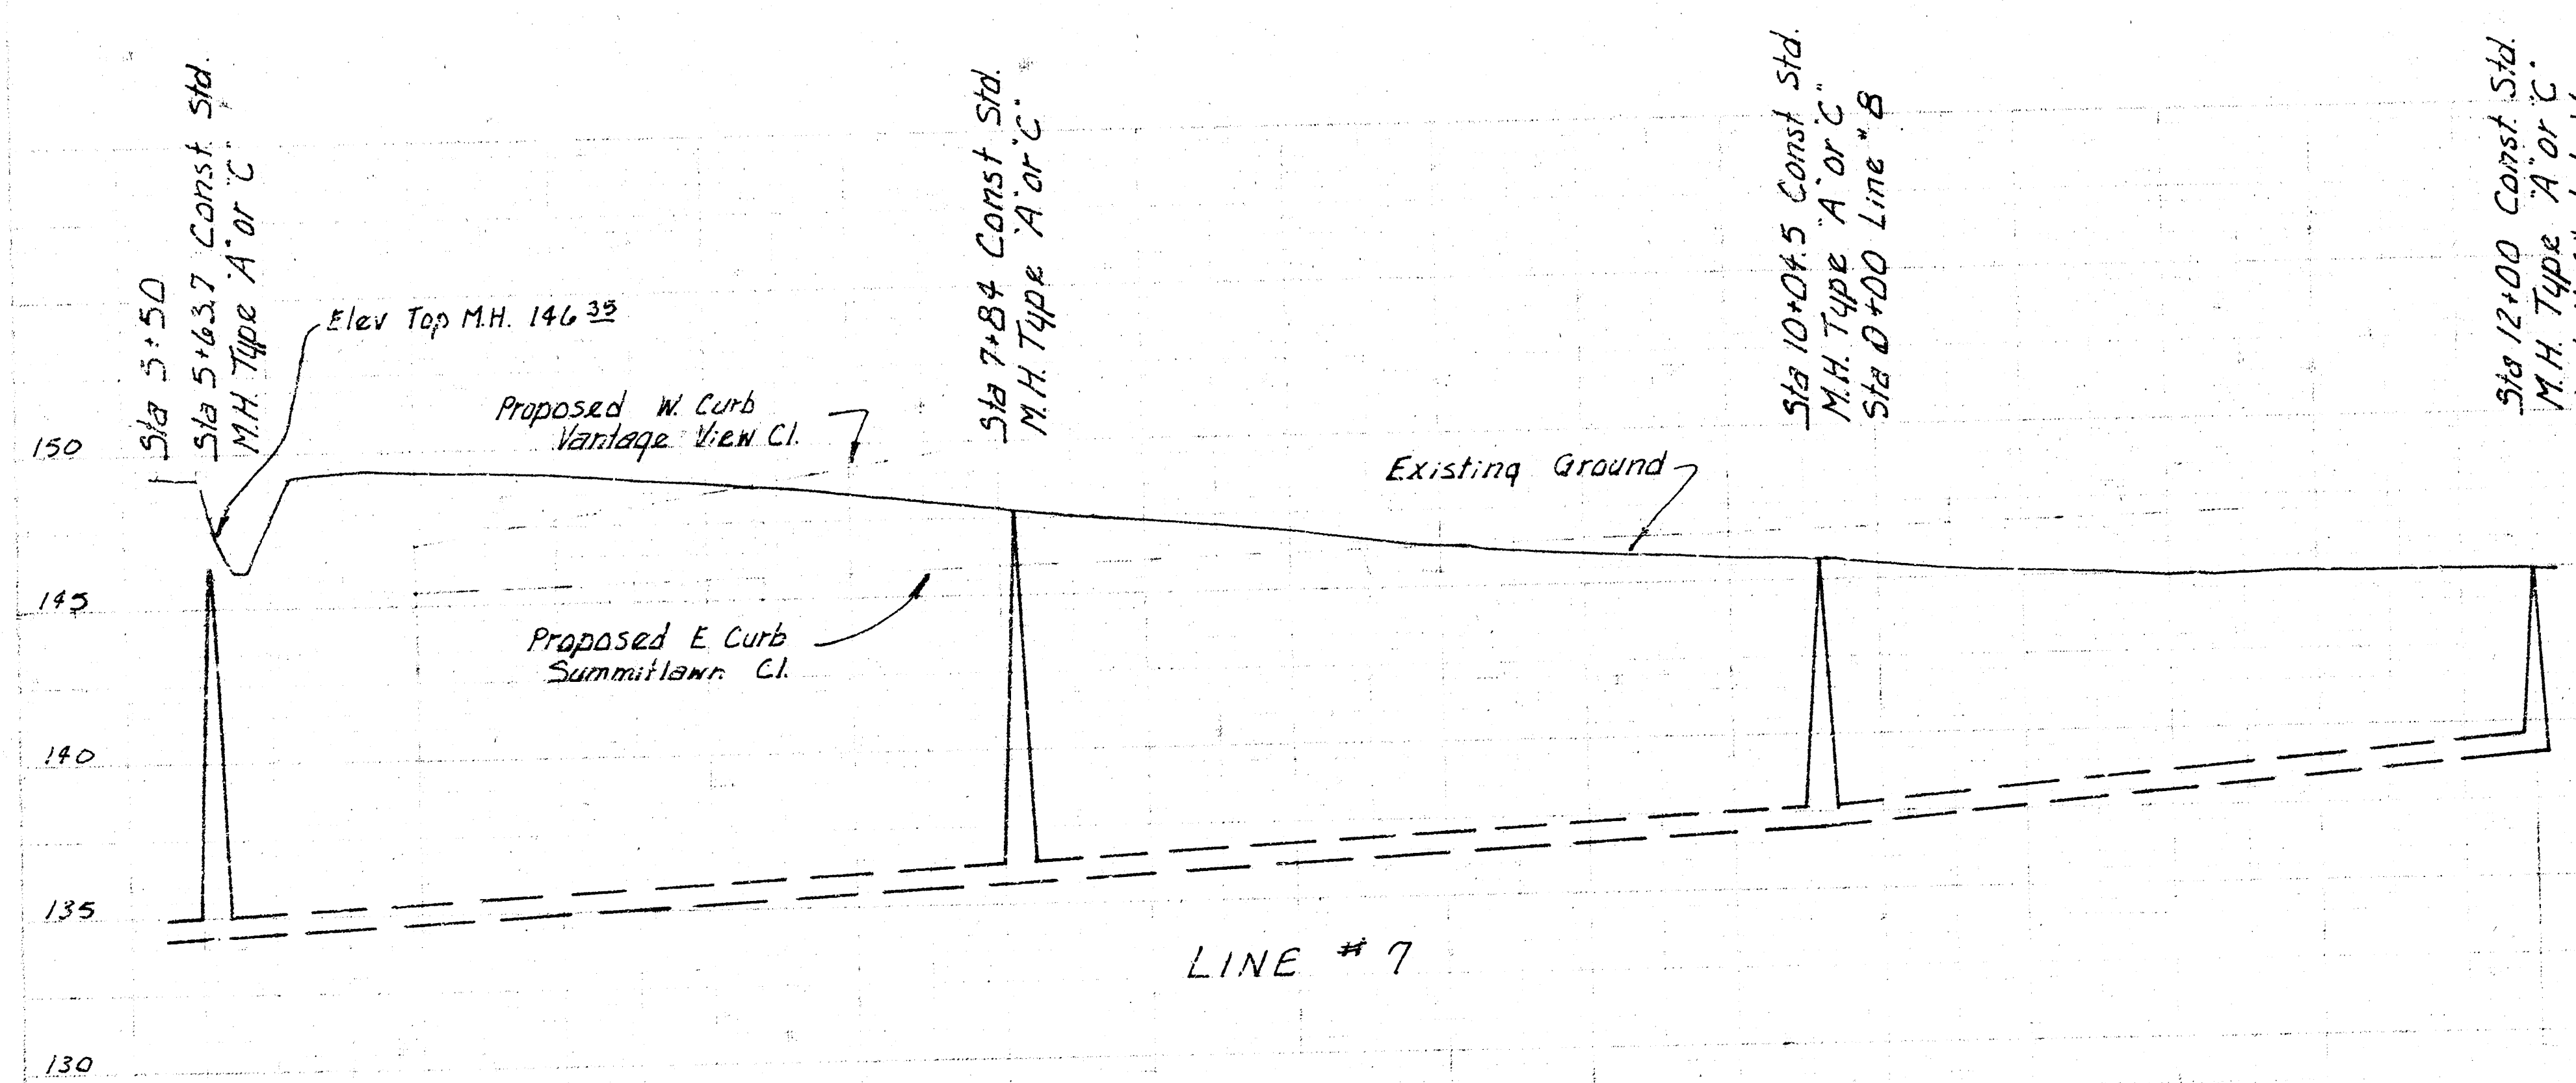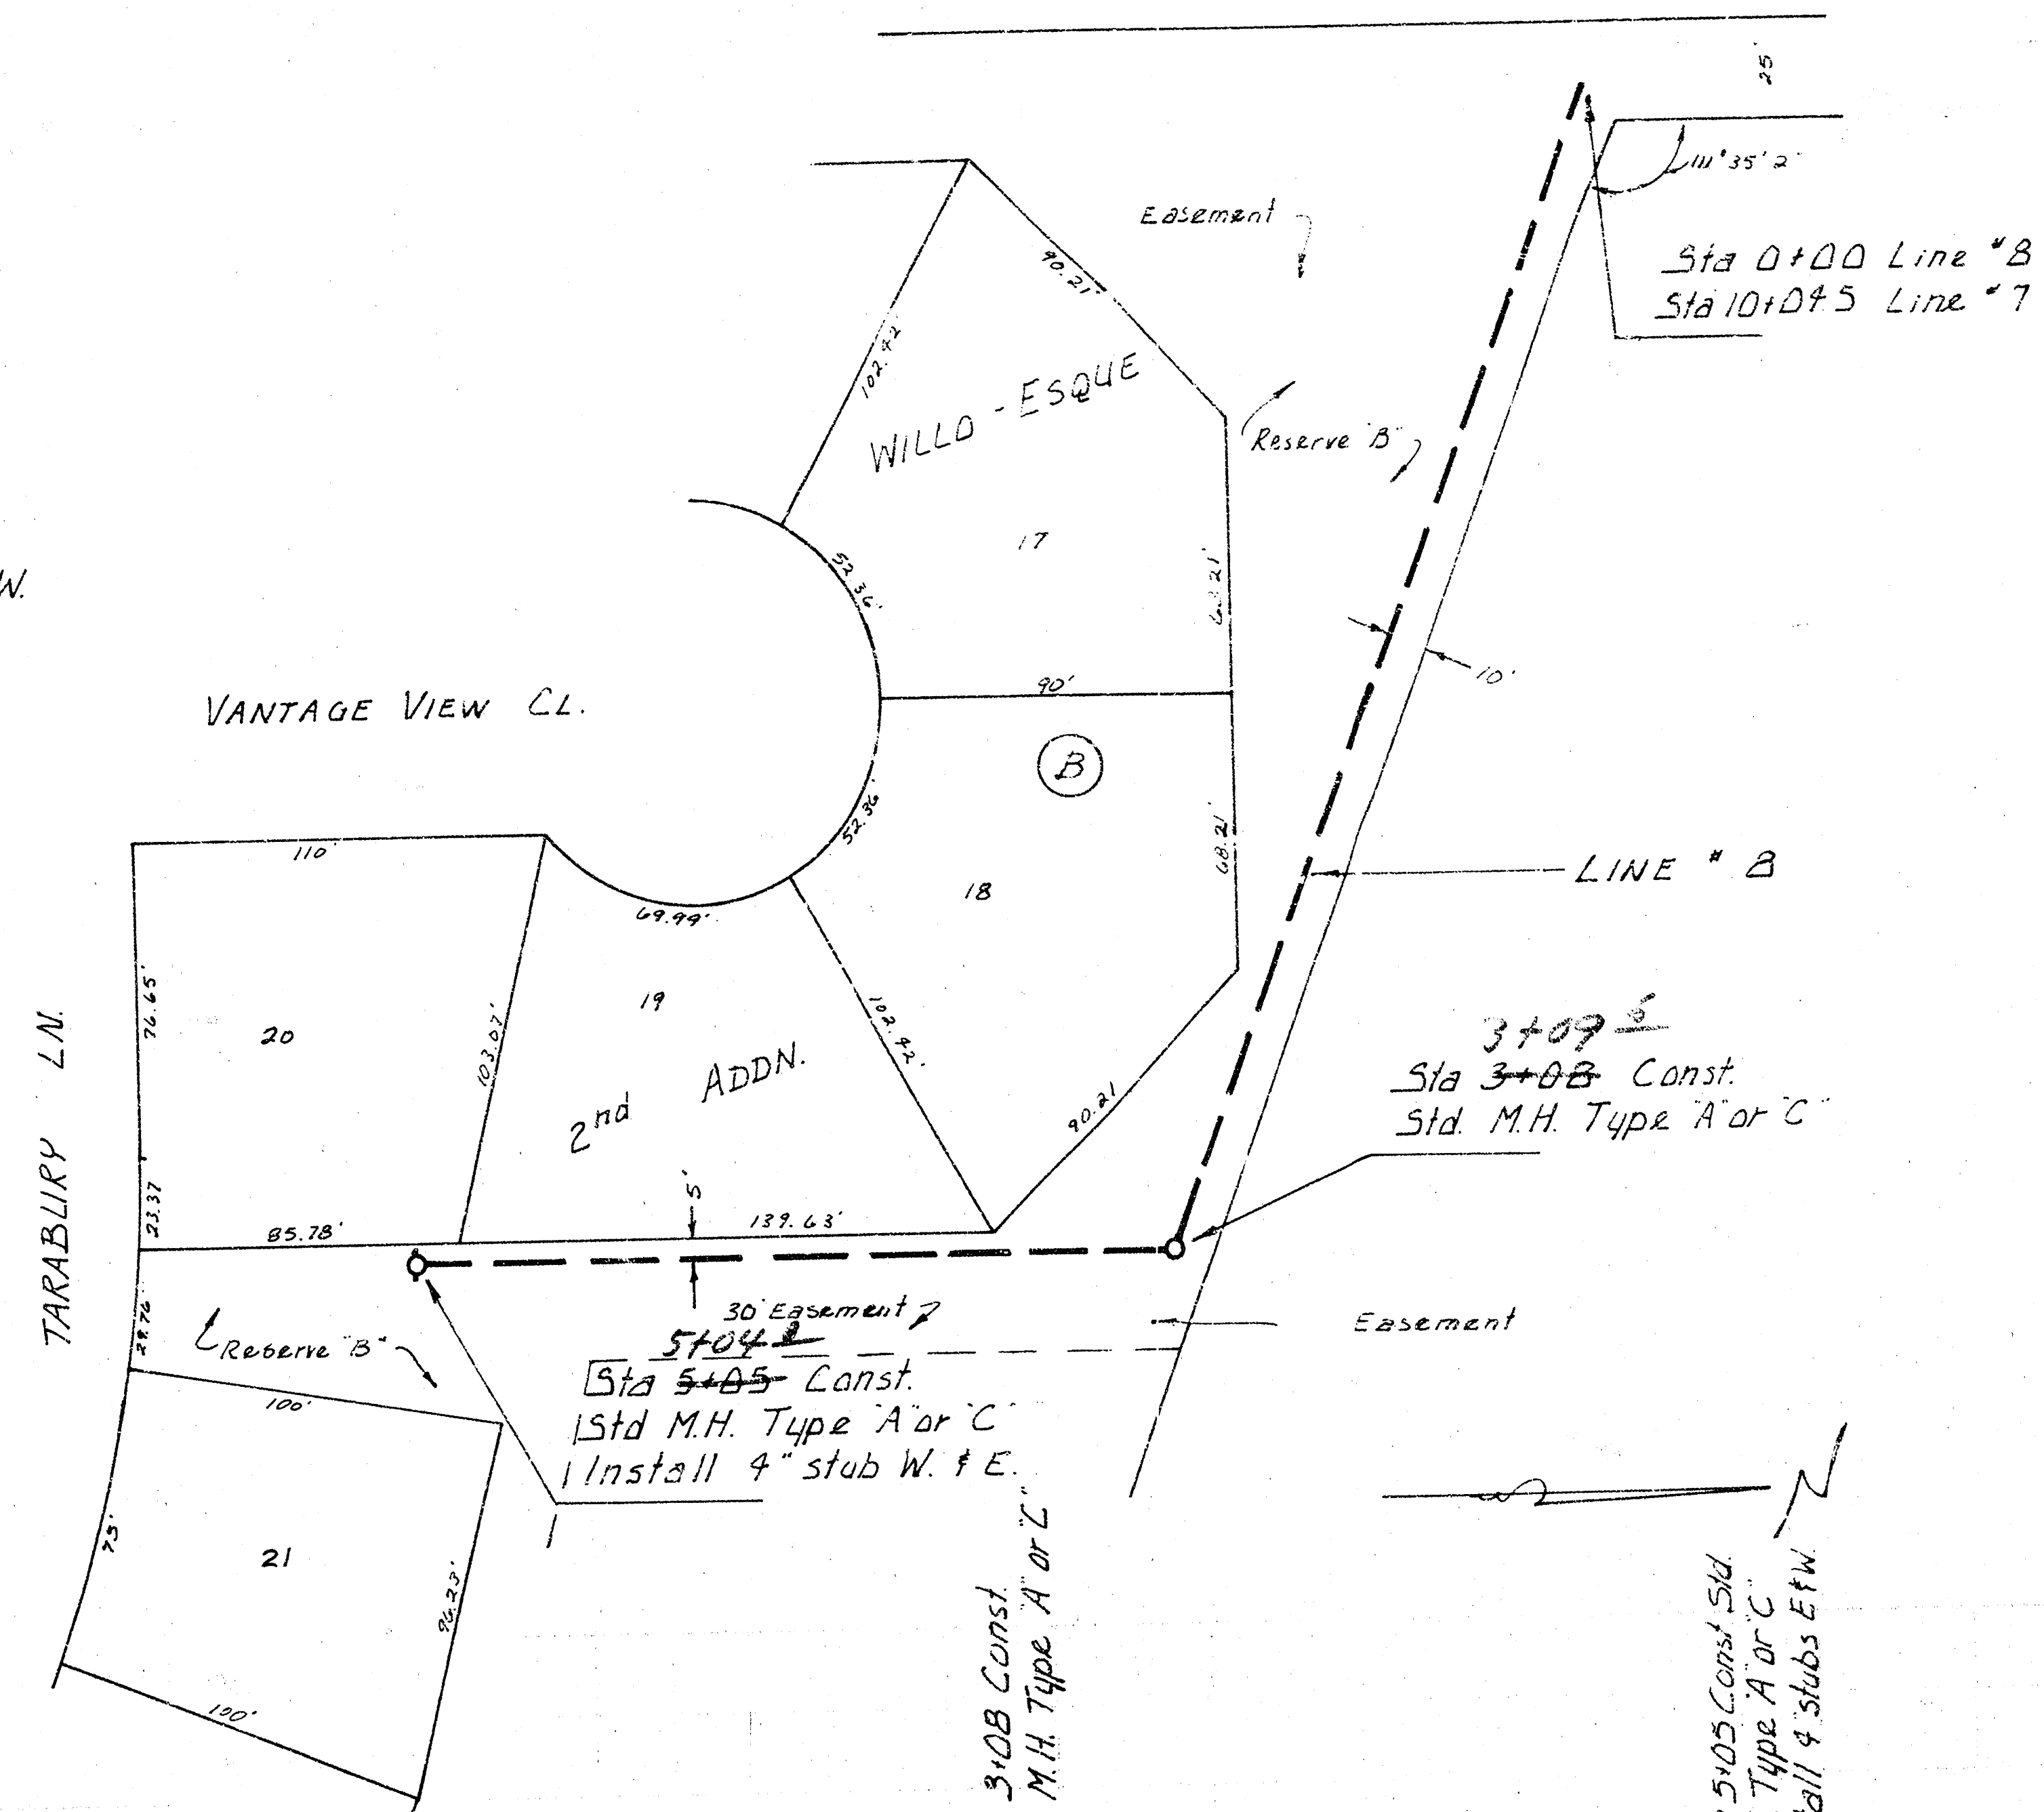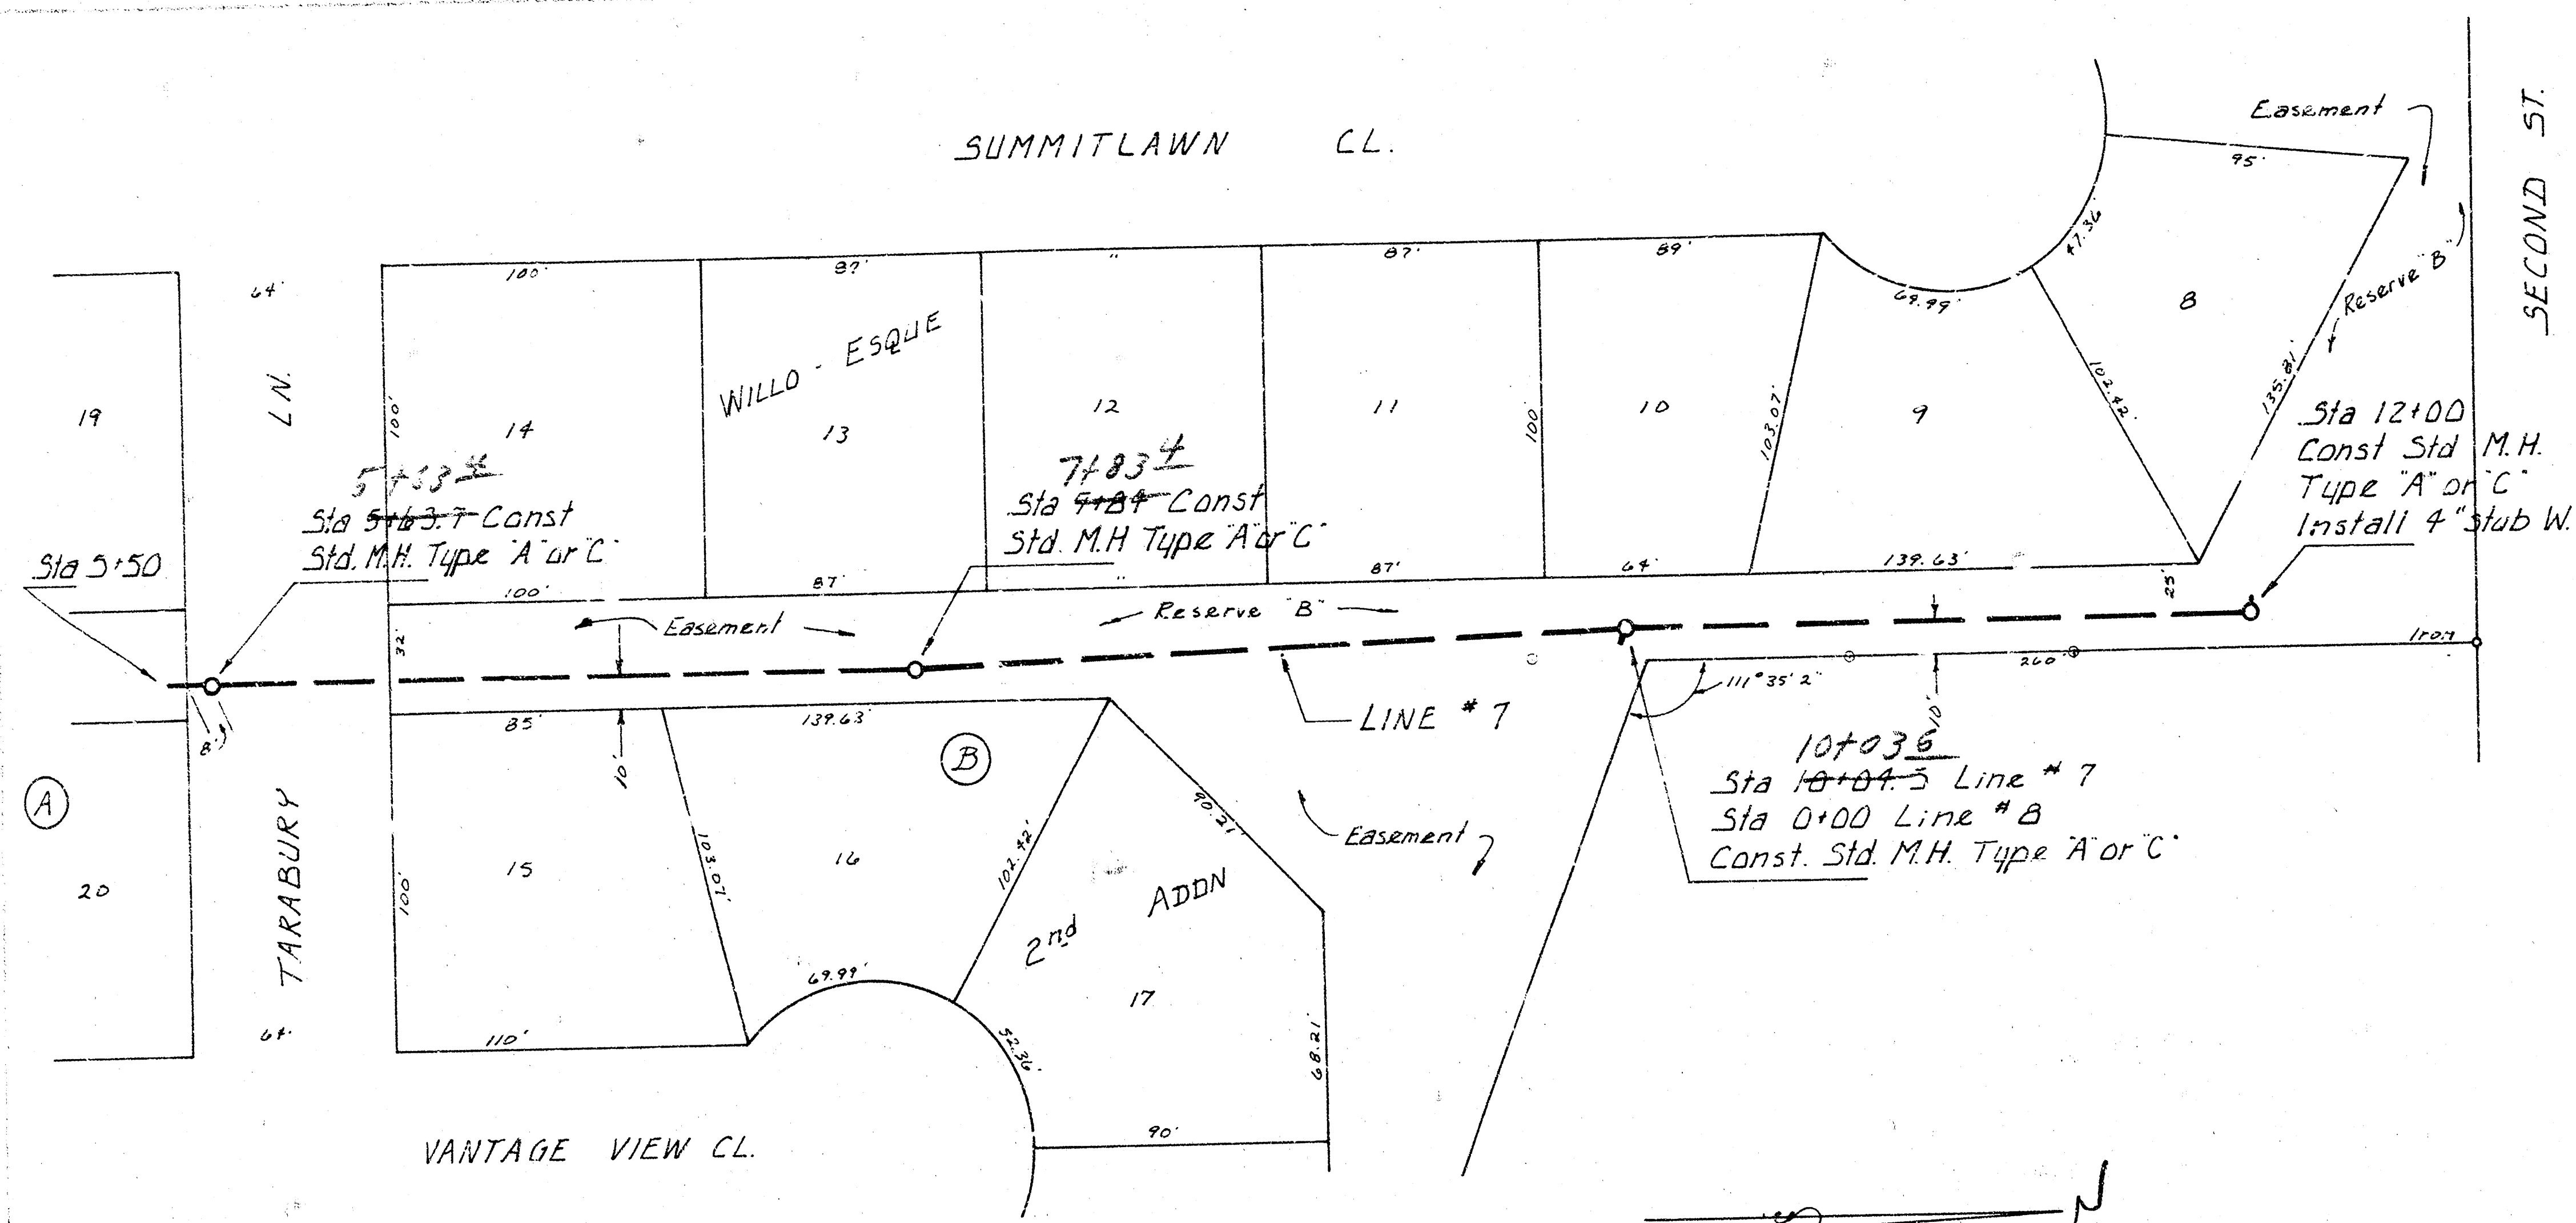

LAT. 3, MAIN 6, S. W. I.  
PROJECT NO. DBKL575048 7/8



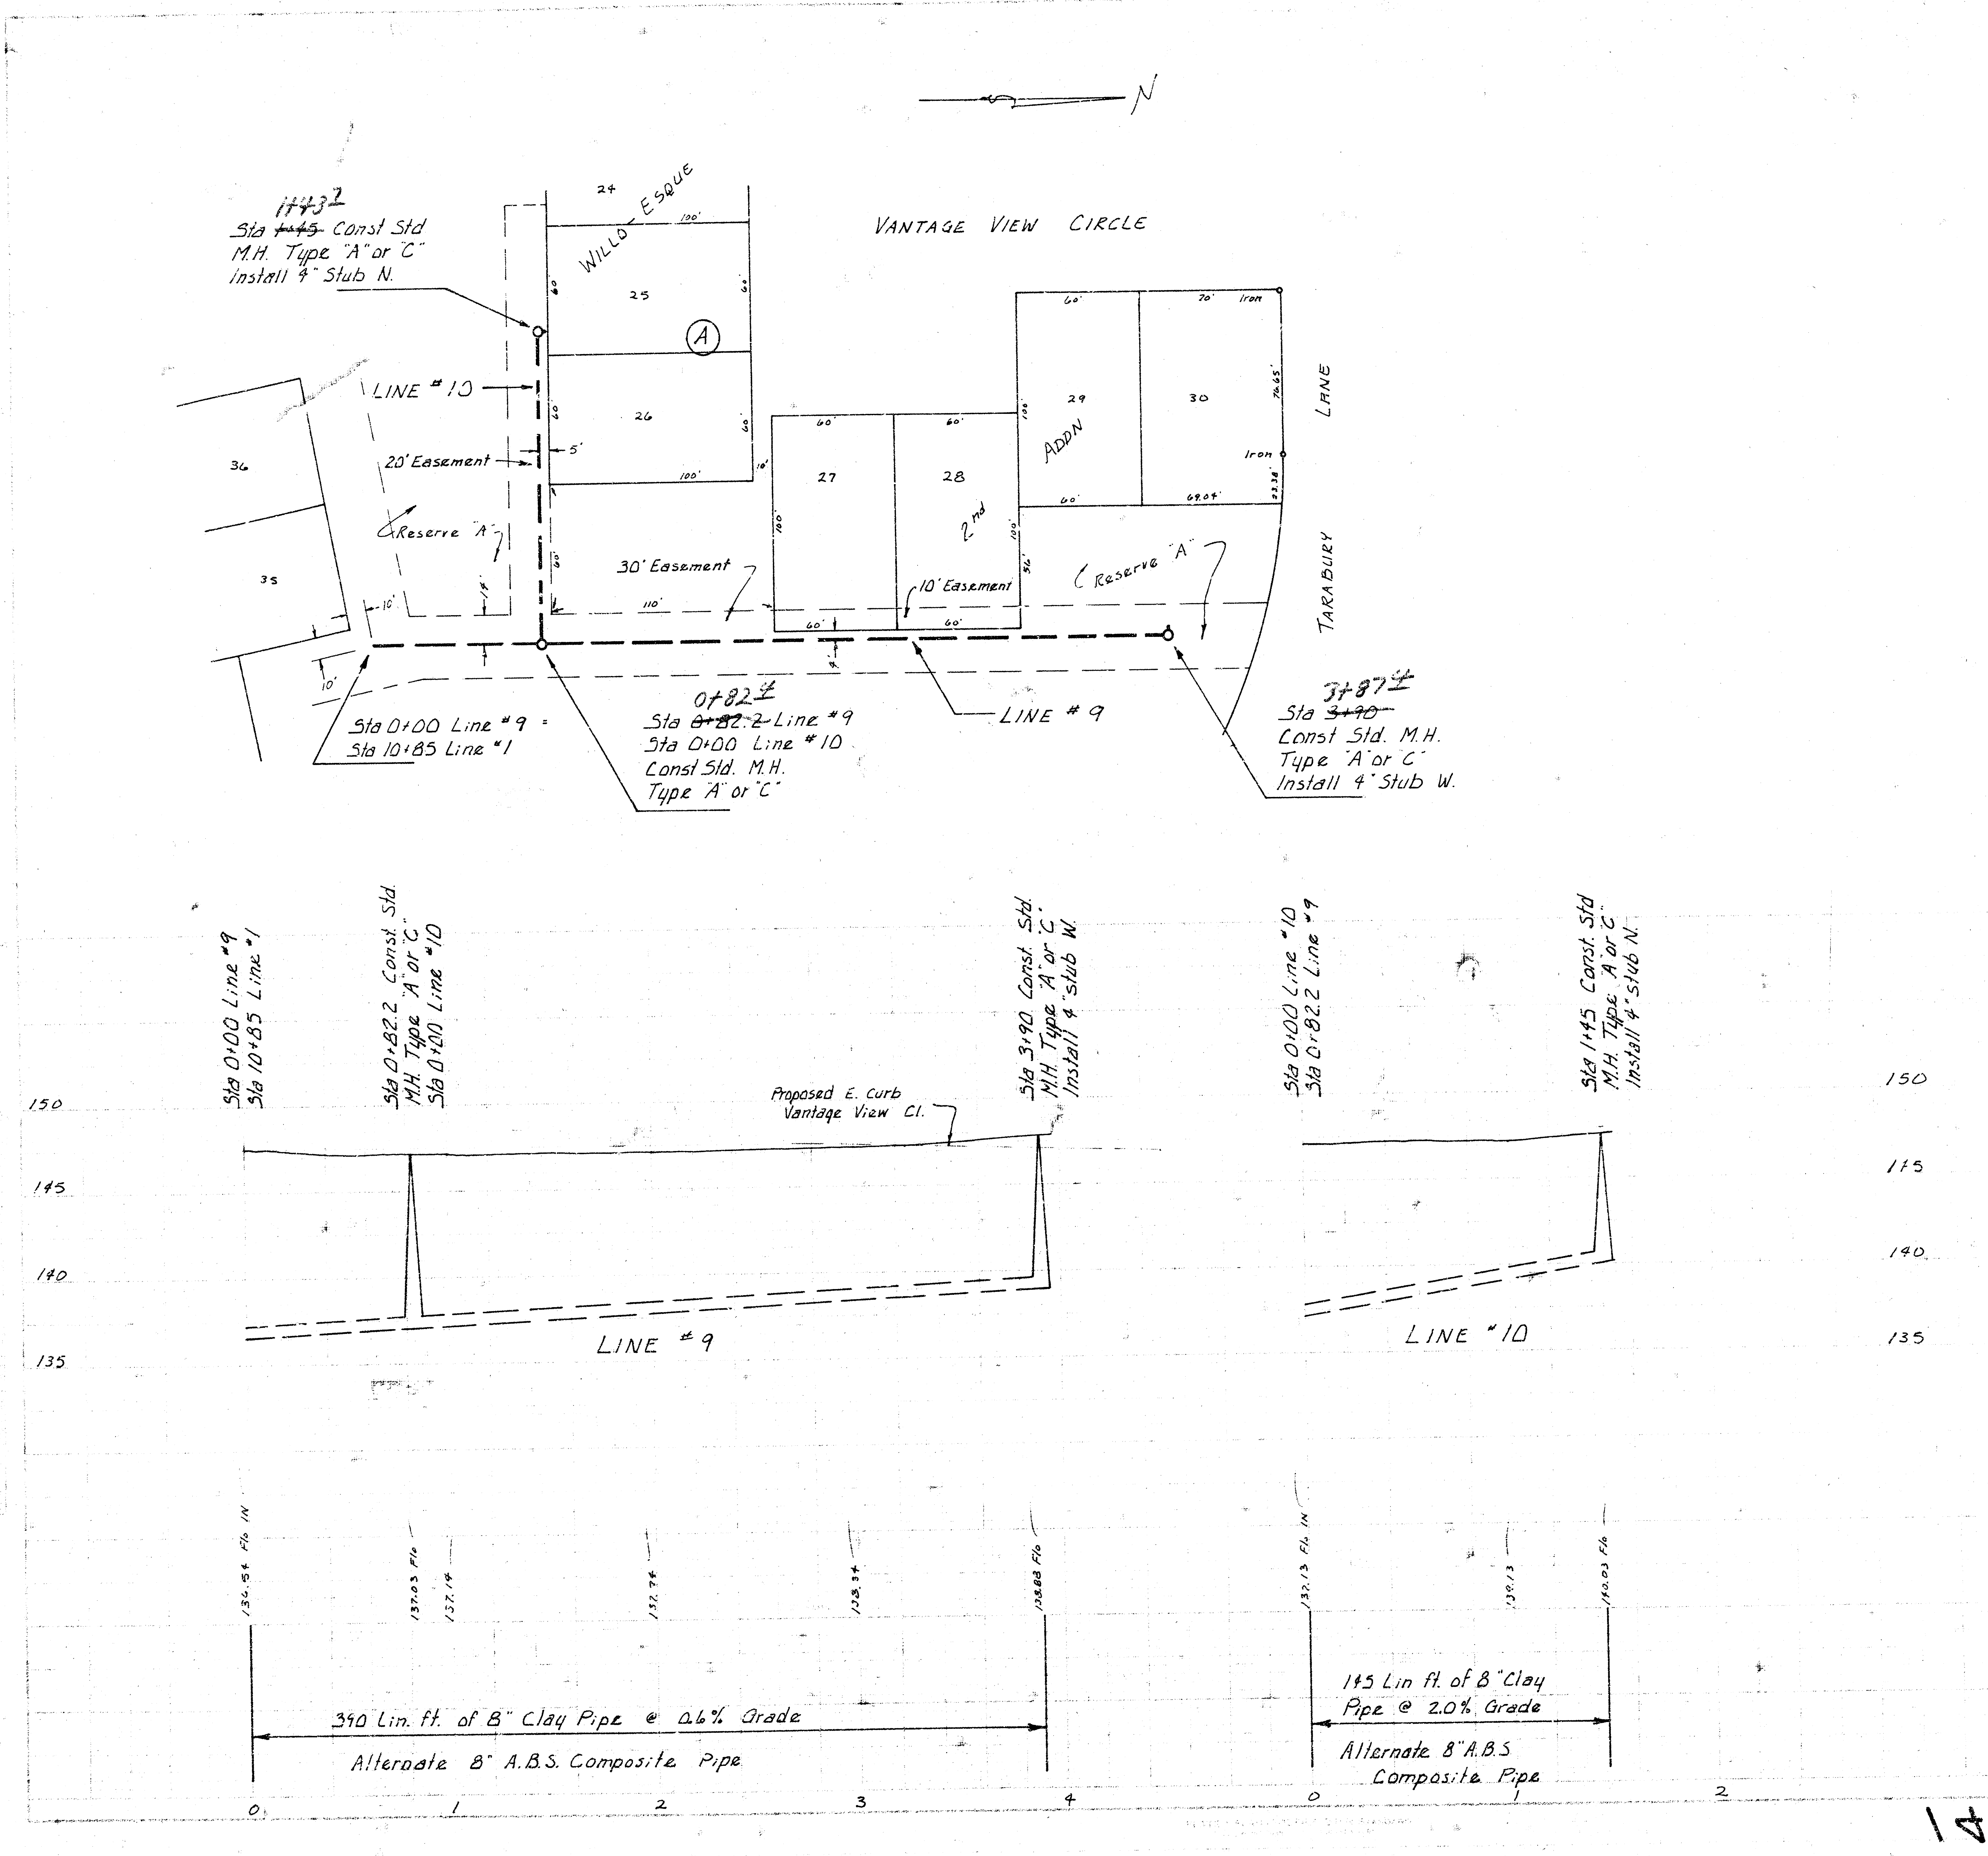

LAT. 3, MAIN 6, S.W. 1.  
PROJECT NO. DBKL575048

14 8 15