



1/14/82  
J. Landry

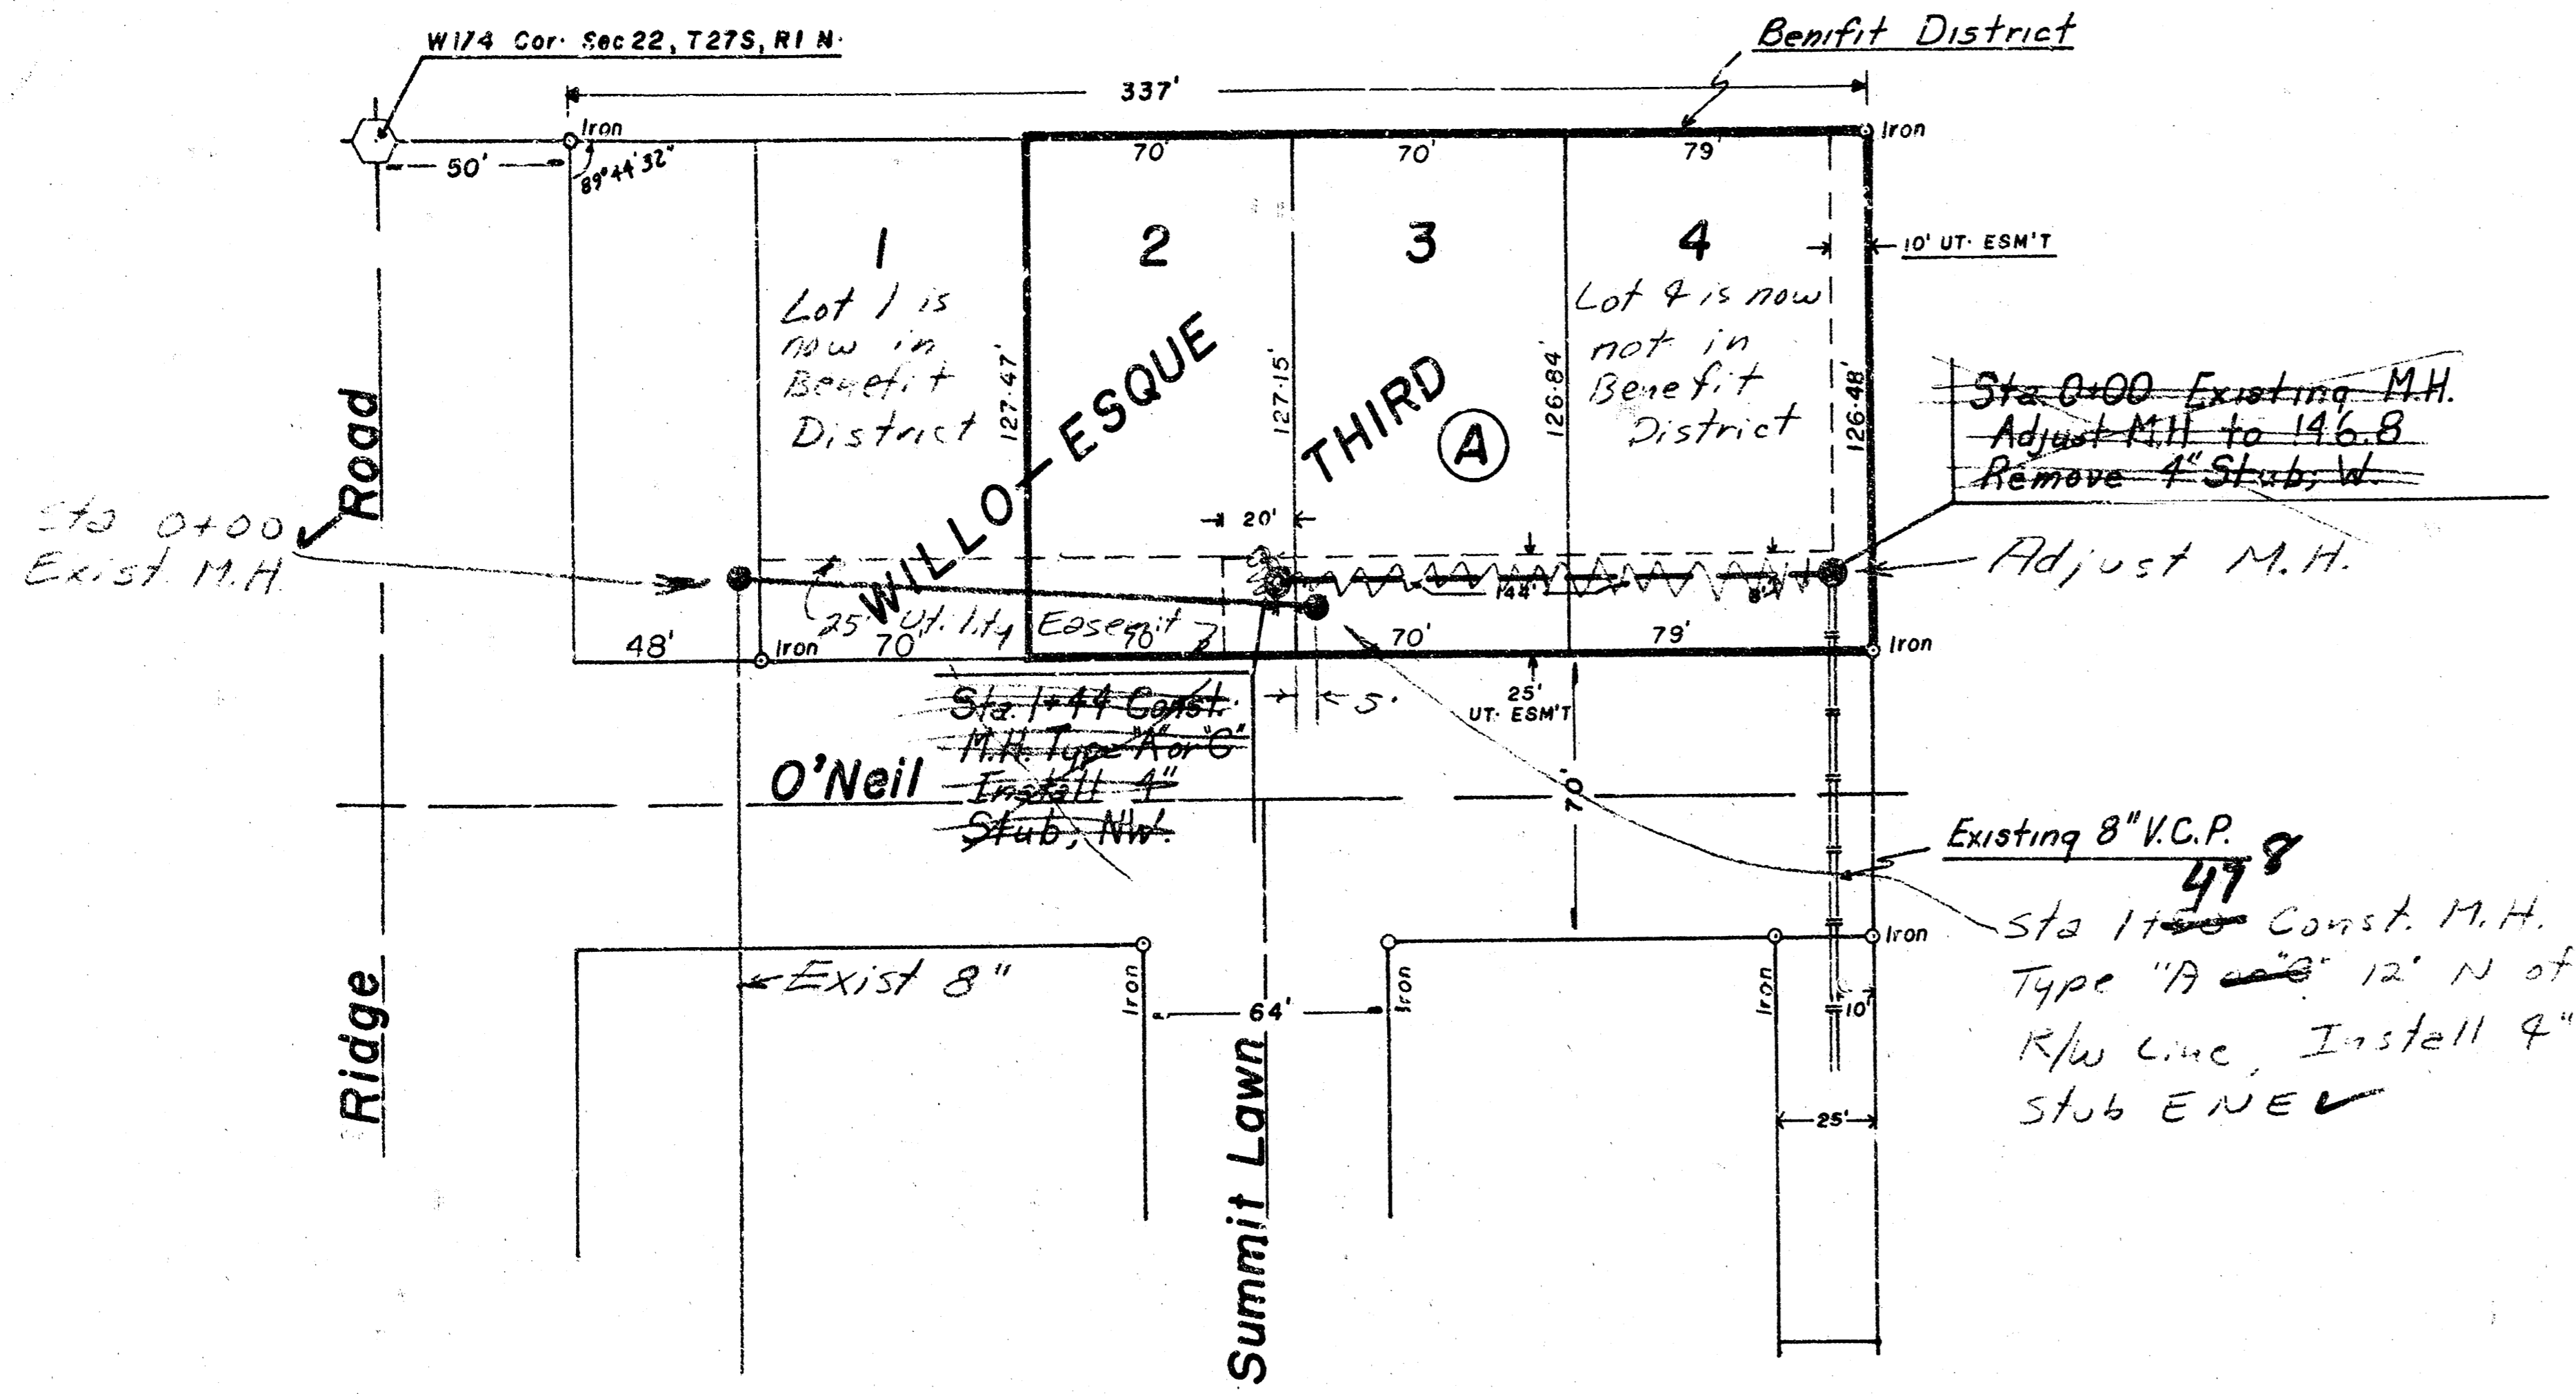


Scale:  
 1" = 40' Plan  
 Horz. 1" = 40' Profile  
 Vert. 1" = 5' Profile

B.M. 144-96 City Std. Disc, 39'-5" N & 48' W of E of Ridge Rd. & Second St.

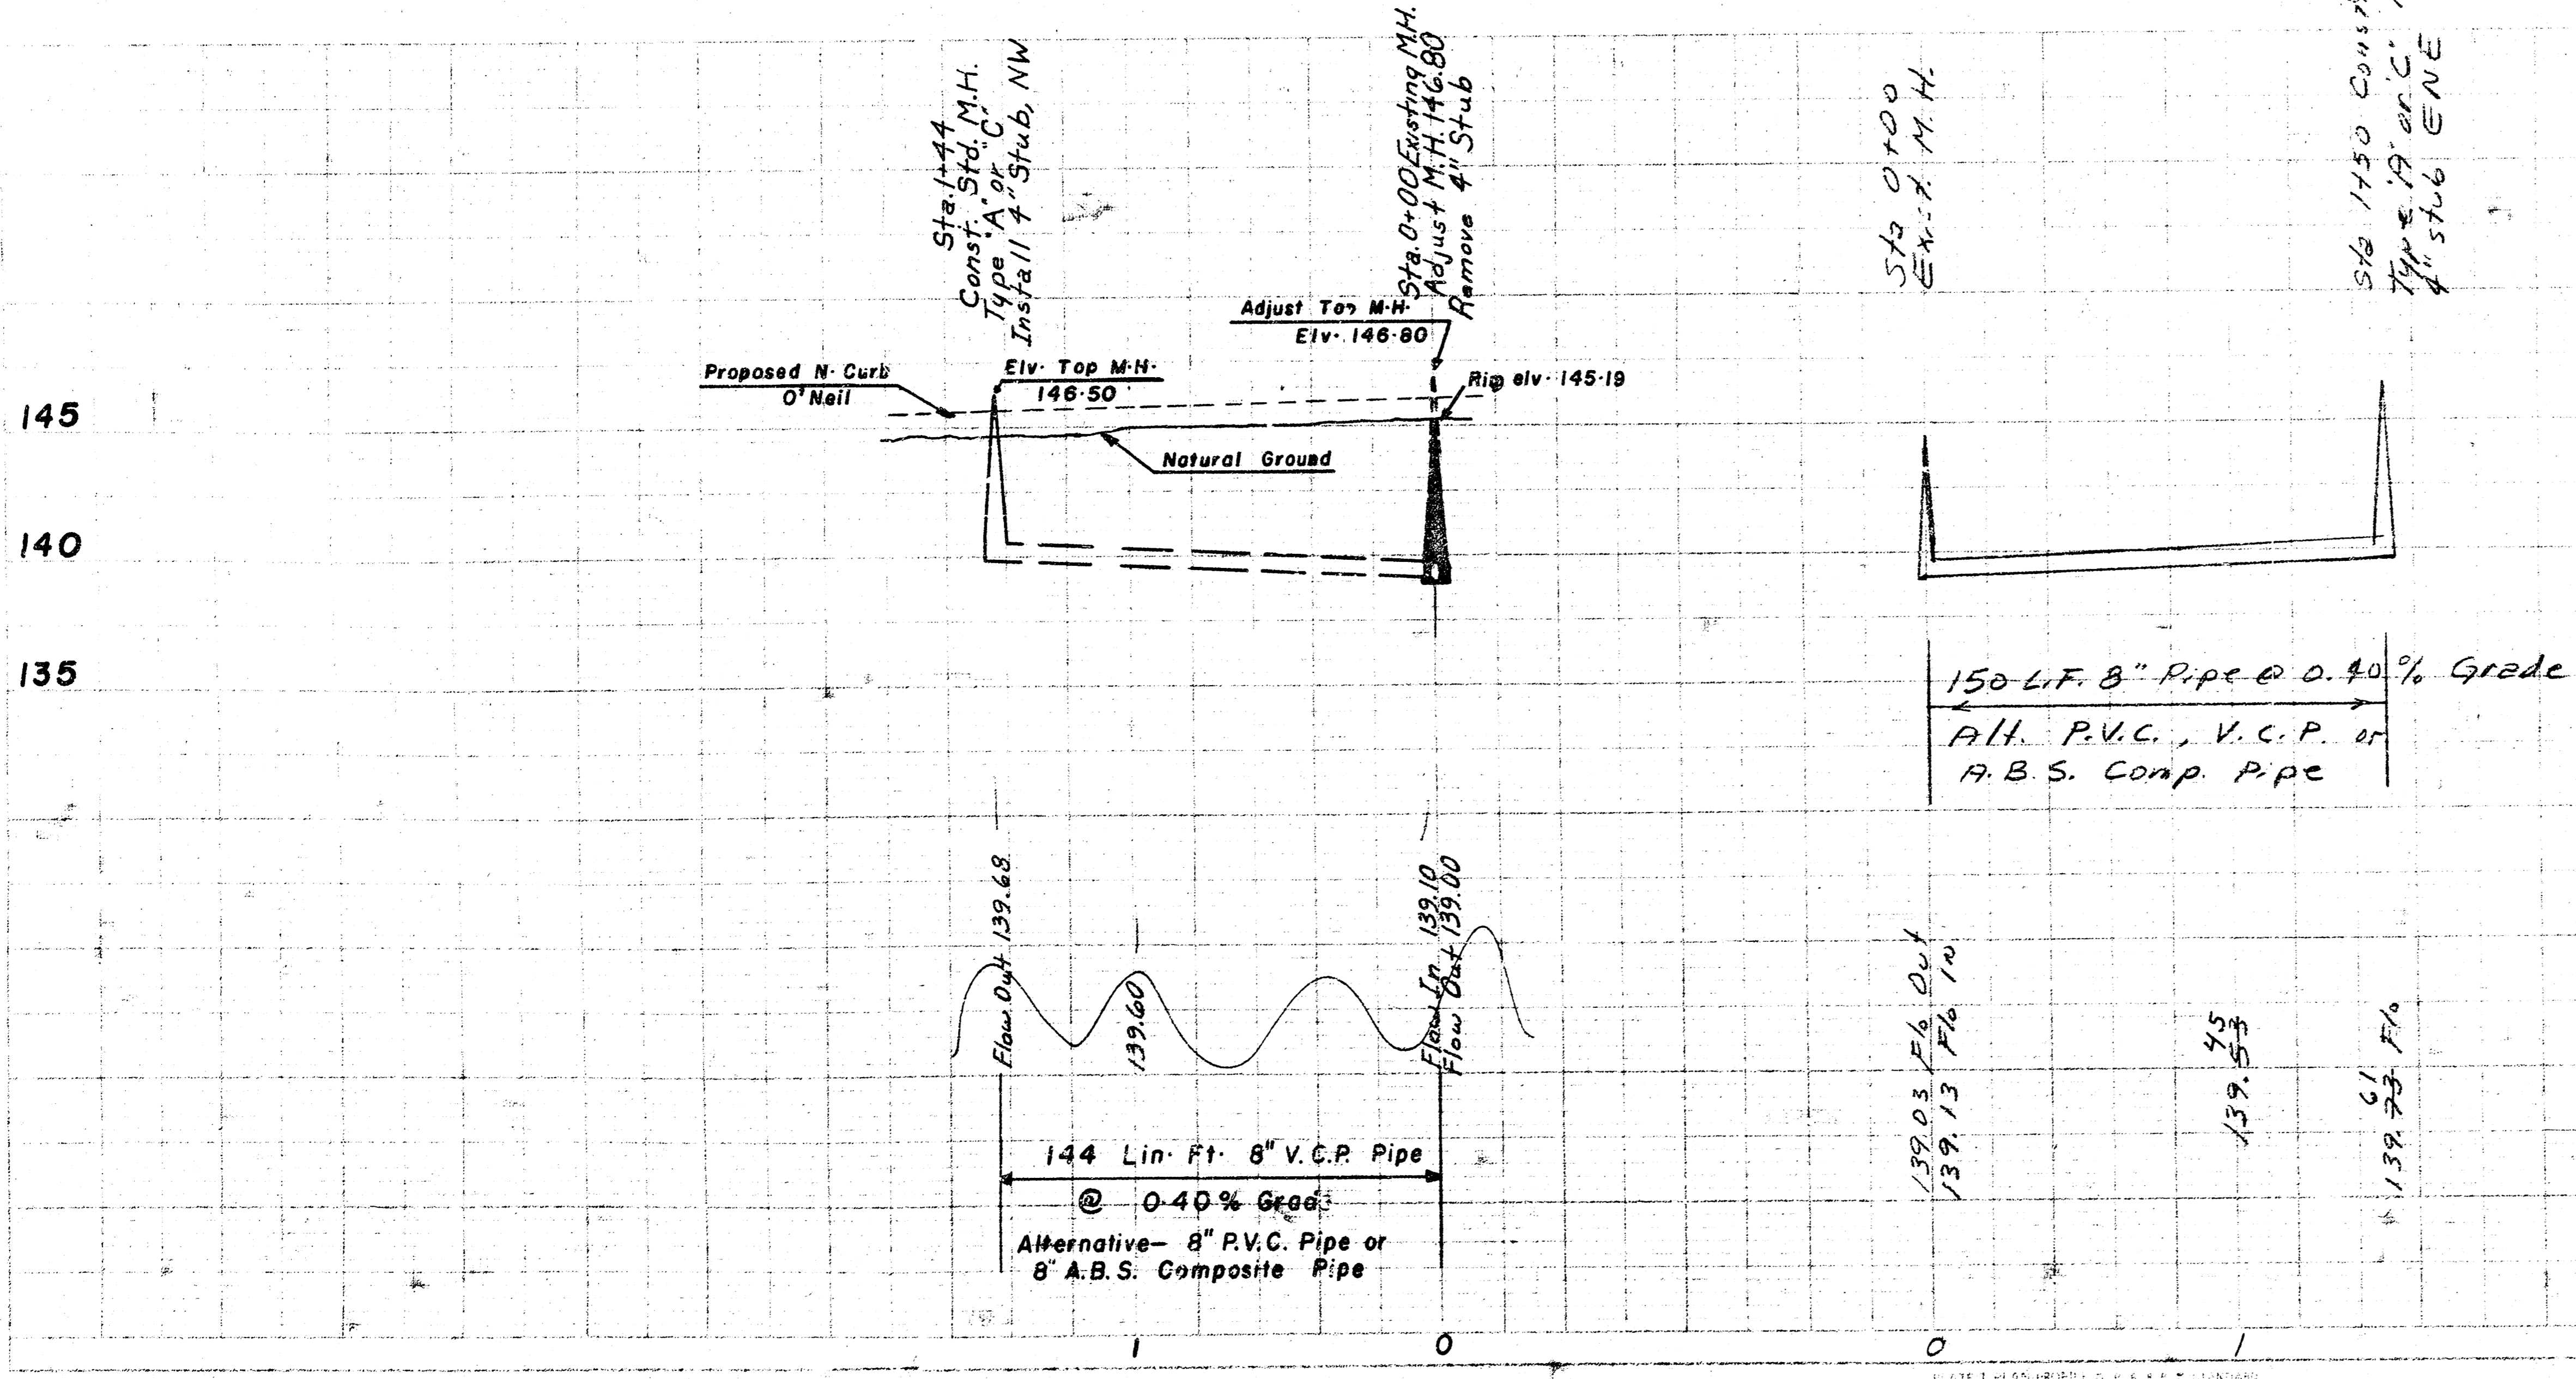

Sta. 1+50 Const. M.H. Type "A" or "C" Install 4" stub ENE

As Built  
 JLL  
 1/82

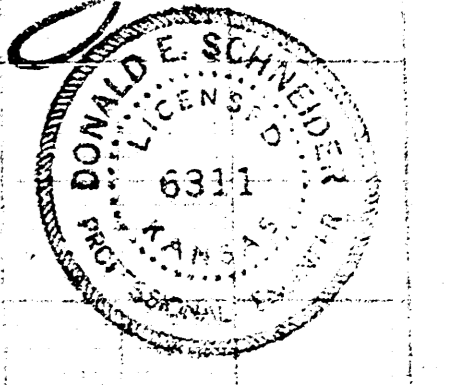

LAT. 4, MAIN 6, S.W. 1.  
 CITY OF WICHITA, KANSAS  
 R.W. BRUGGEMAN, DIRECTOR OF ENGINEERING/CITY ENGINEER  
 Proj. NO. 468-76-245-80778-000-000-001  
 DATE: \_\_\_\_\_

14 5 3