

LATERAL 6, MAIN 6, SOUTHWEST INTERCEPTOR SEWER

CITY OF WICHITA, KANSAS


R. W. BRUGGEMAN: DIRECTOR OF ENGINEERING / CITY ENGINEER

PROJECT NO. 468-76-245-80892-000-000-001

INDEX

LINE 1	SHEETS 2-3
LINE 2	SHEETS 3-4
LINE 2A	SHEET 5
LINE 3	SHEET 5
LINE 4	SHEET 6

NOTE: TRENCHES SHALL NOT BE BACKFILLED ABOVE AN ELEVATION GRADE LINE ESTABLISHED AS 0.4' OF A FOOT BELOW THE TOP OF MANHOLE ELEVATIONS SHOWN ON THE PLANS.

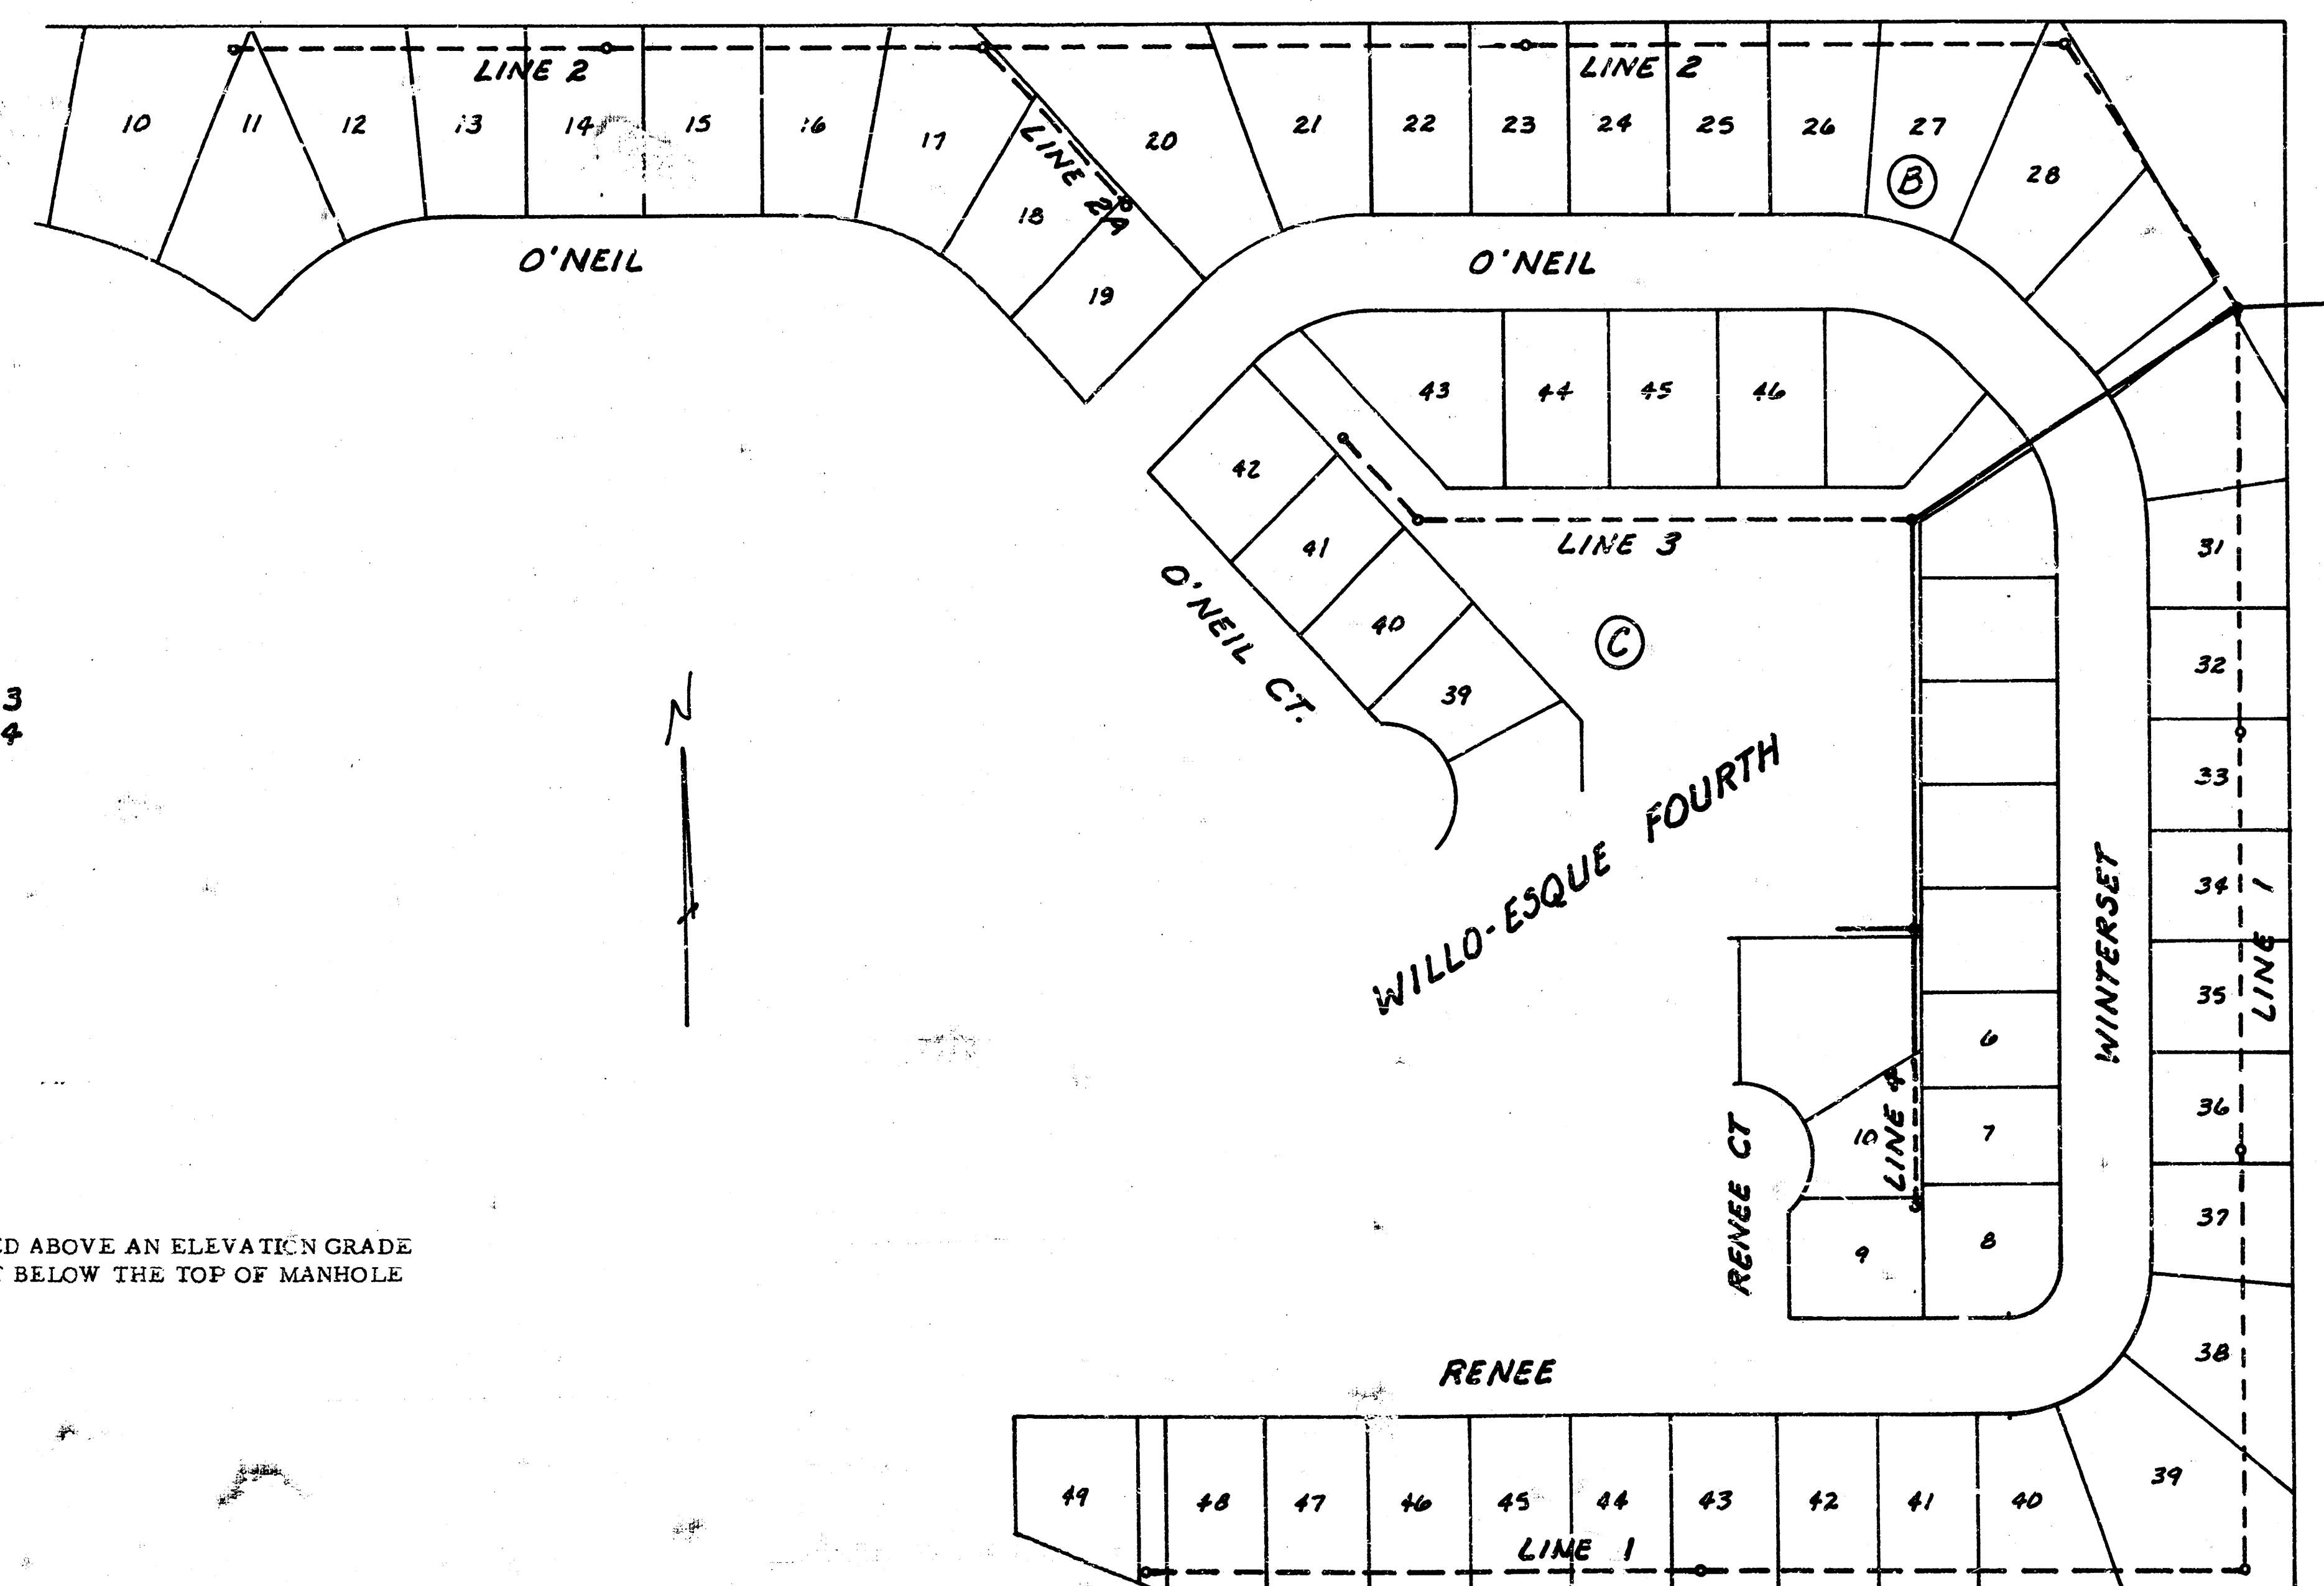


As Built
9.8.83
J.L.L.



R. BULLER

DCD-217


SCALE PLAN 1"=40' HORIZ. PROFILE 1"=5' VERT.

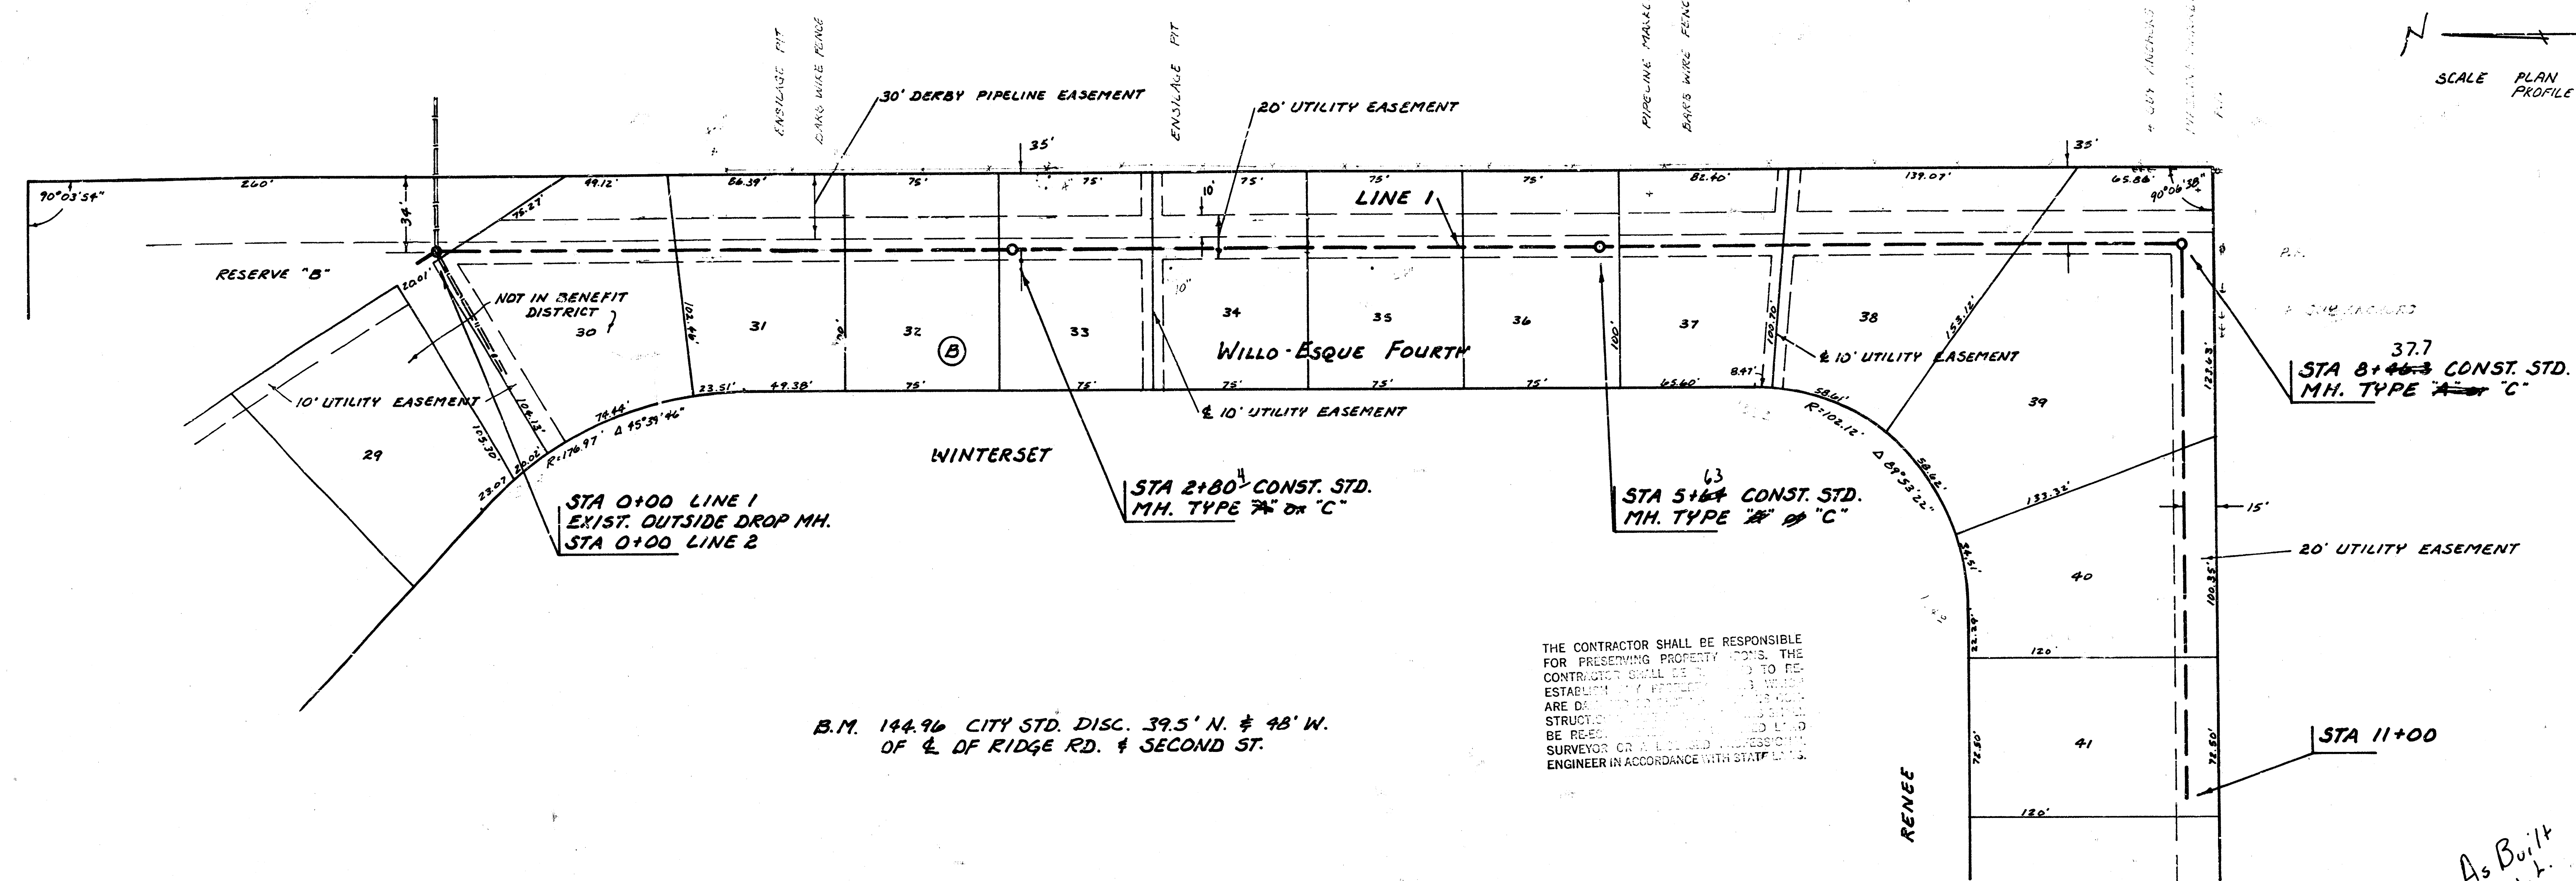

B.M. 144.96 CITY STD. DISC. 39.5' N. & 48' W. OF E. OF RIDGE RD. & SECOND ST.




THE CONTRACTOR SHALL BE RESPONSIBLE FOR PRESERVING PROPERTY LINES. THE CONTRACTOR SHALL BE RESPONSIBLE FOR ESTABLISHING PROPERTY LINES. THE CONTRACTOR SHALL BE RESPONSIBLE FOR ESTABLISHING PROPERTY LINES. THE CONTRACTOR SHALL BE RESPONSIBLE FOR ESTABLISHING PROPERTY LINES.


As Built J.L.L. 9-82

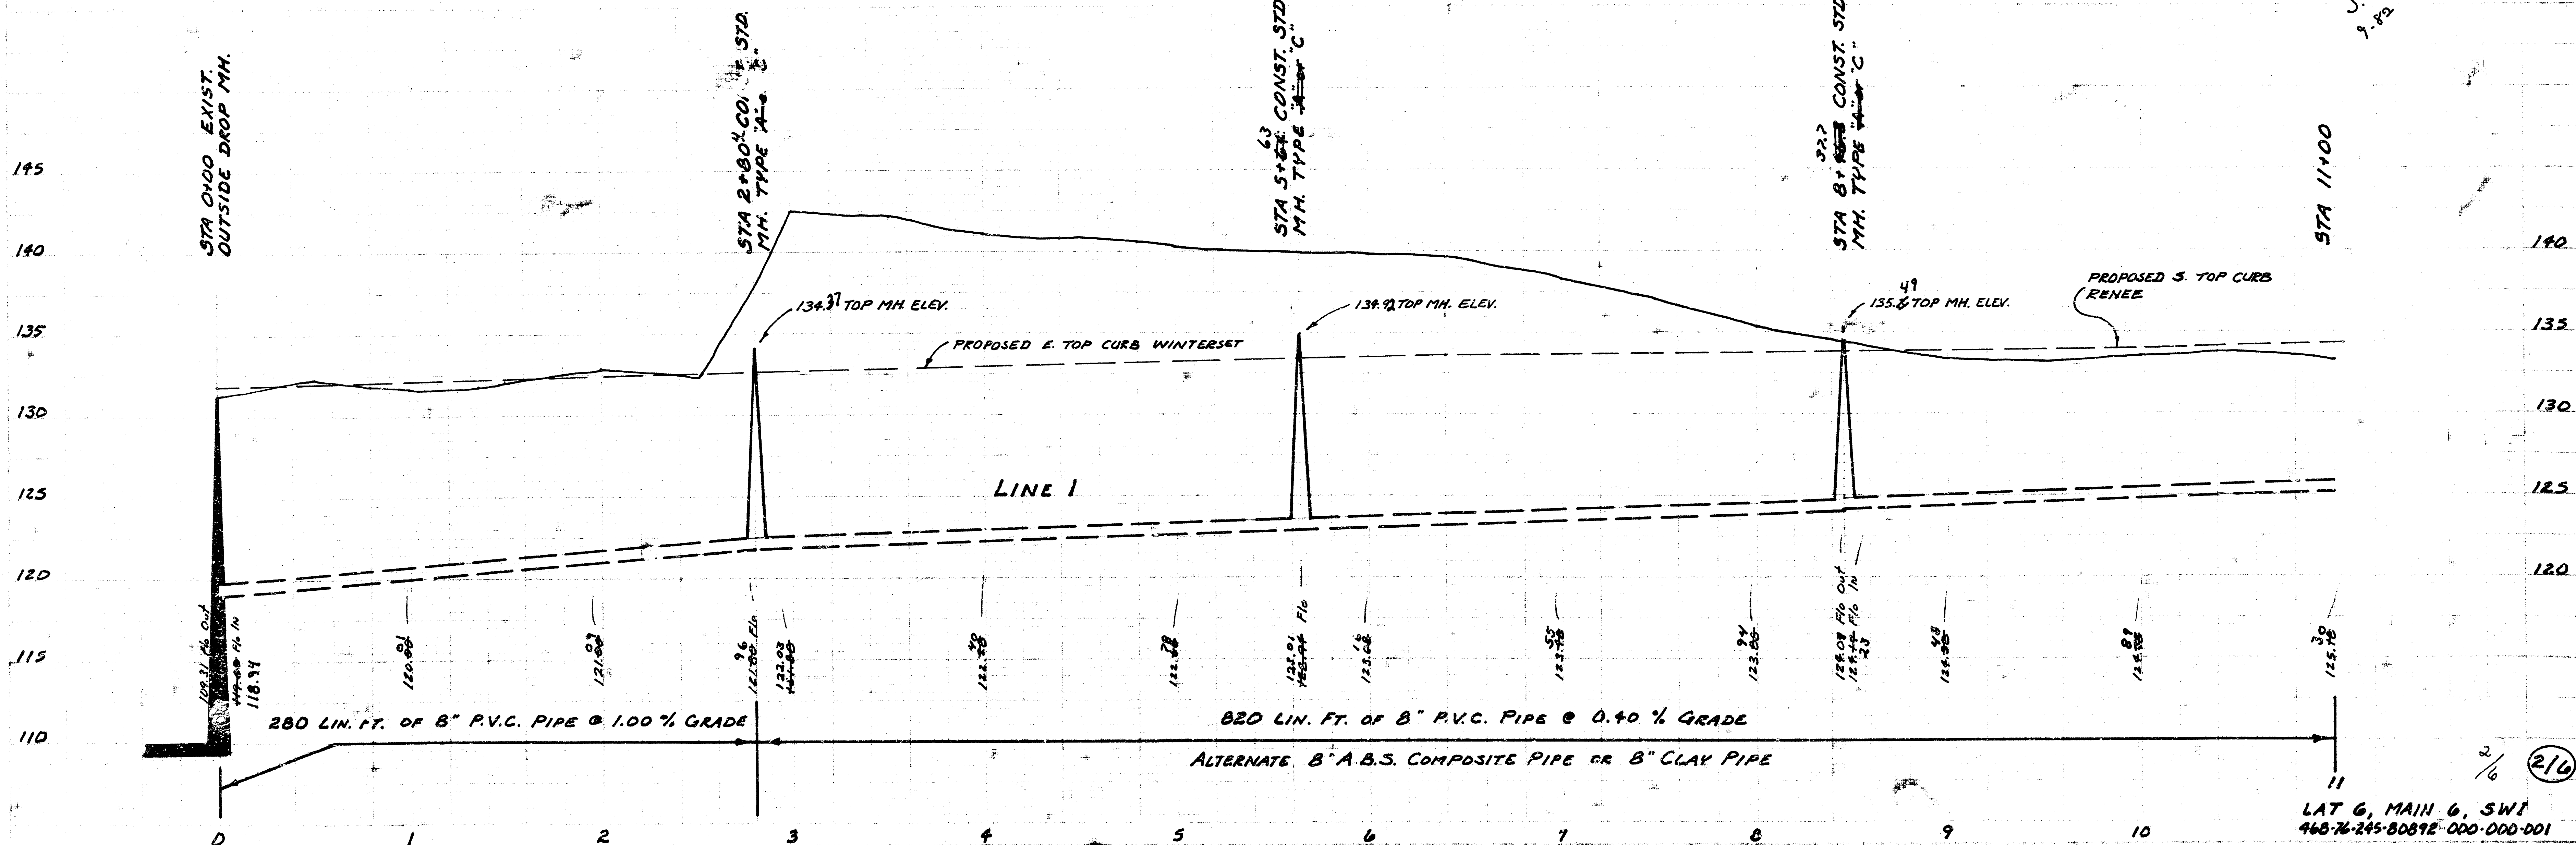



LAT 6, MAIN 6, SW1 468-76-245-80872-000-000-001

2/6

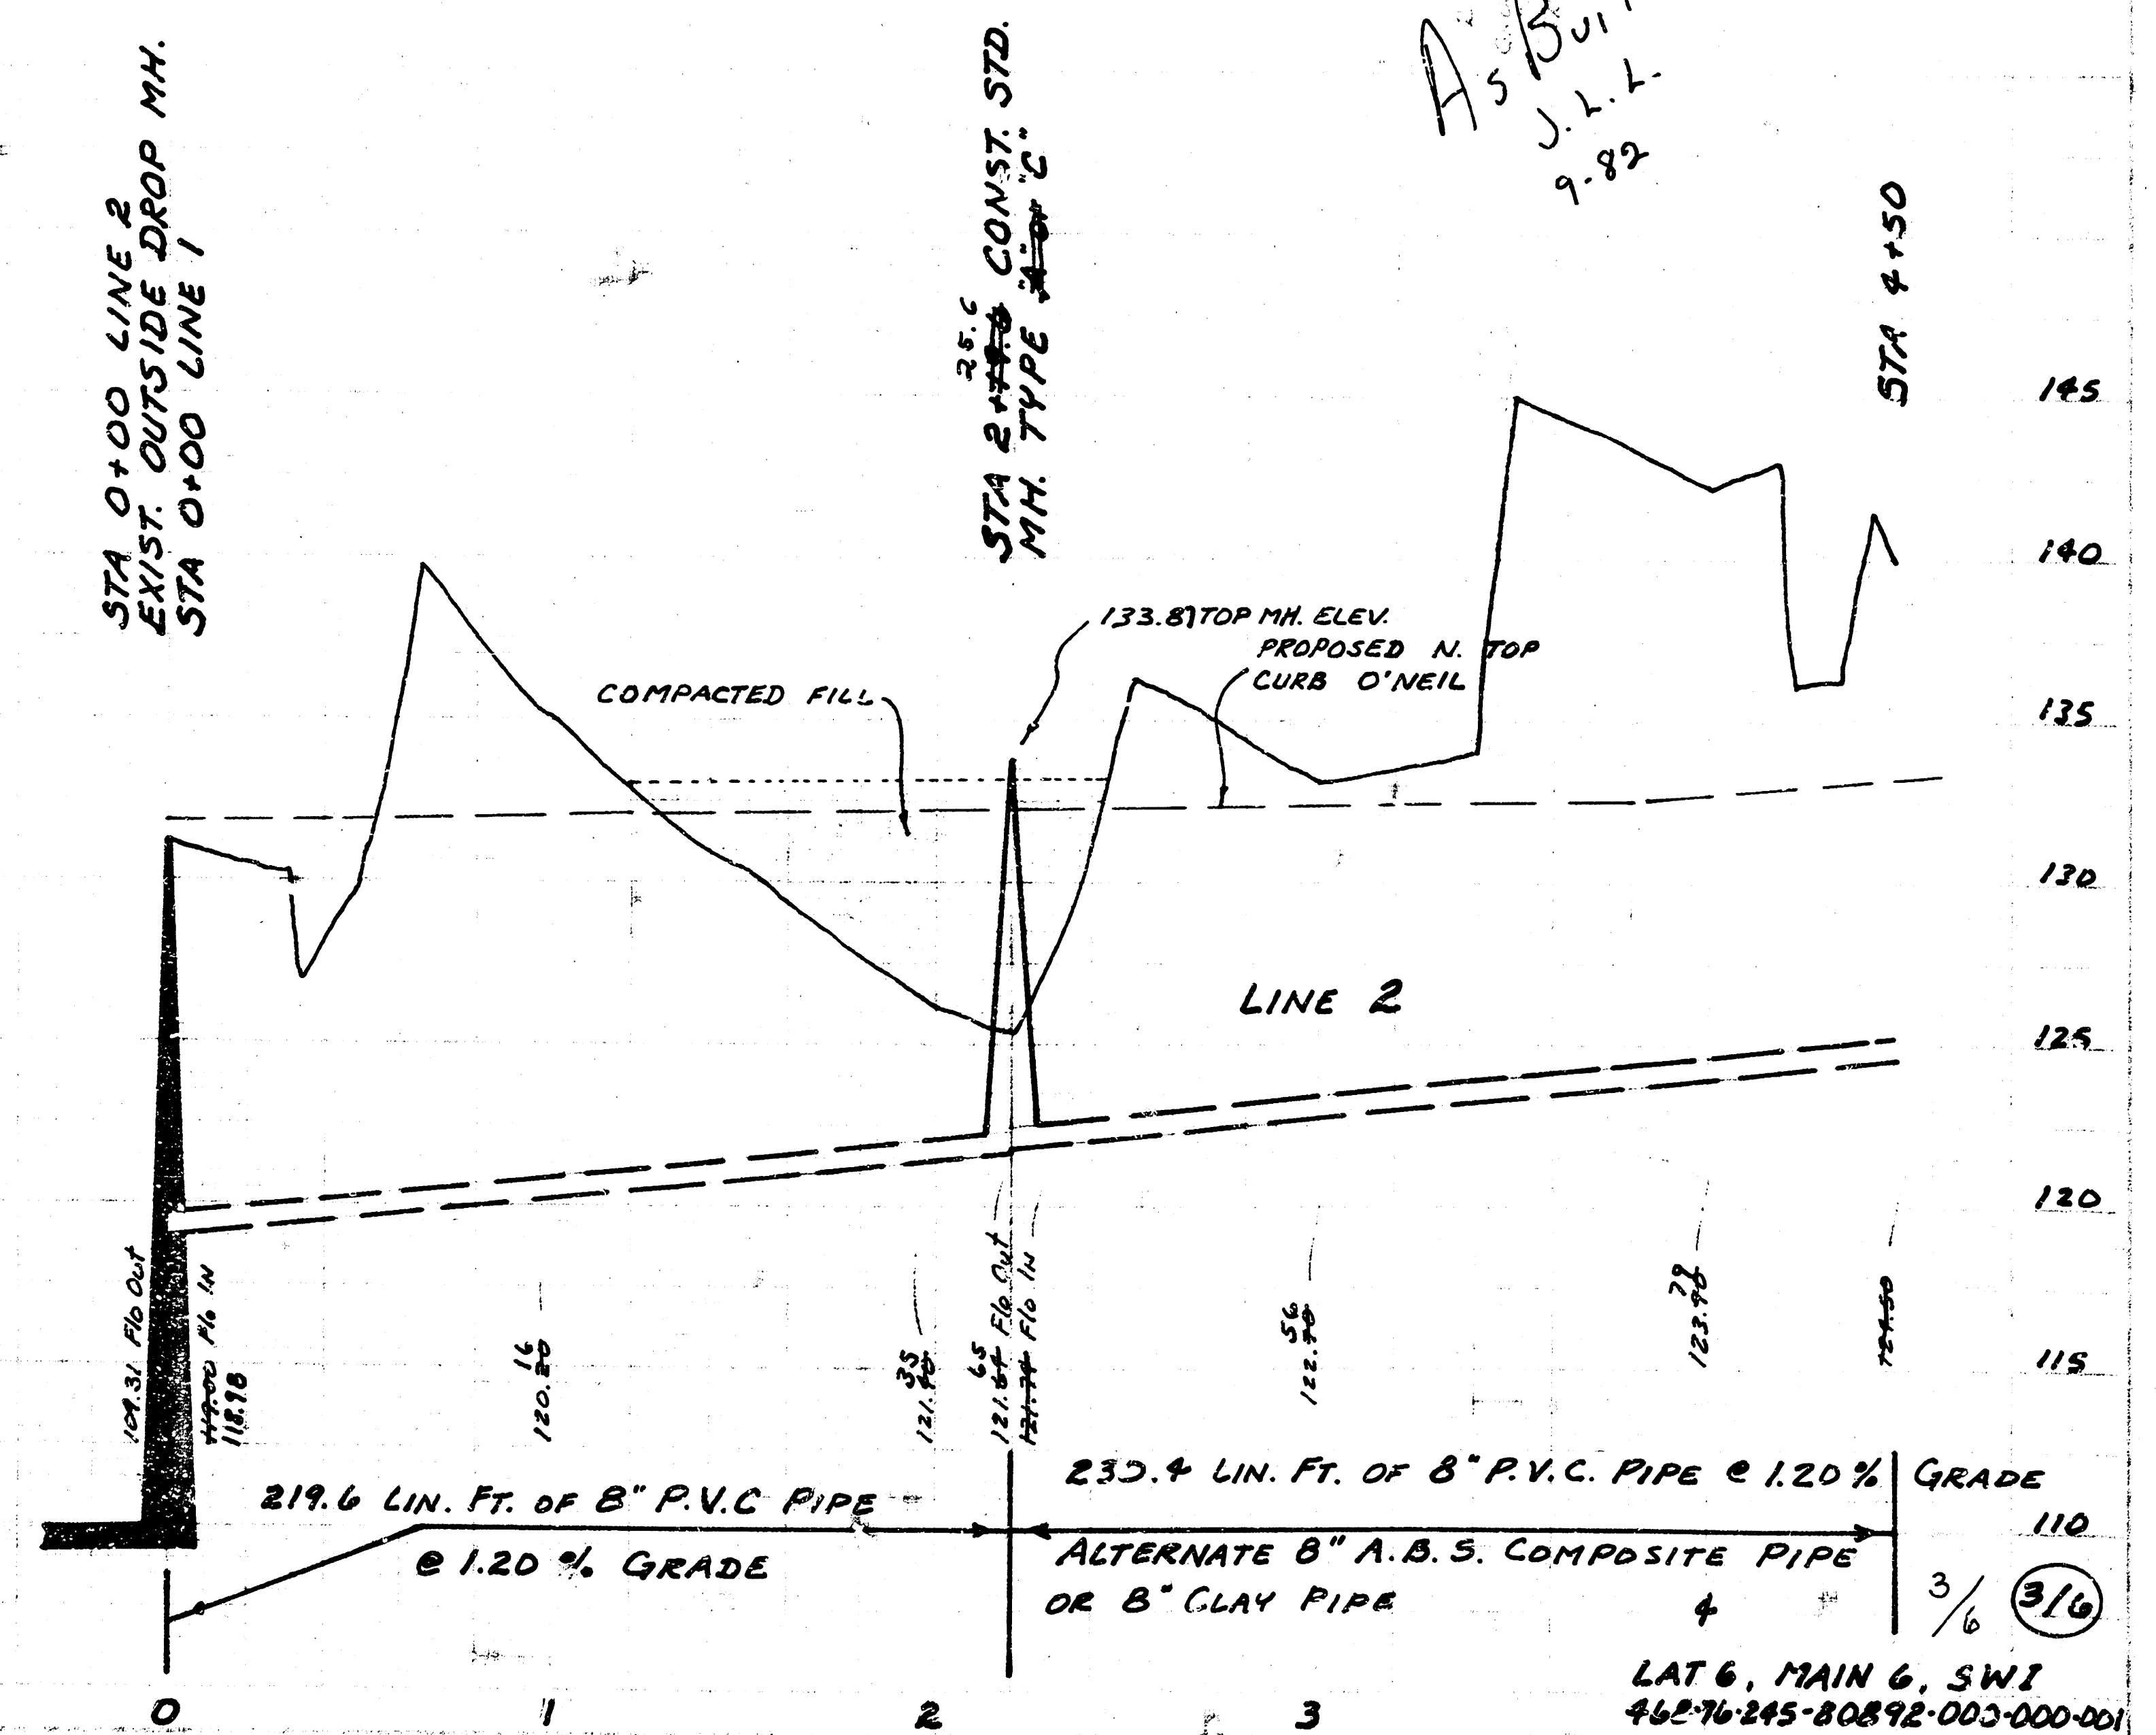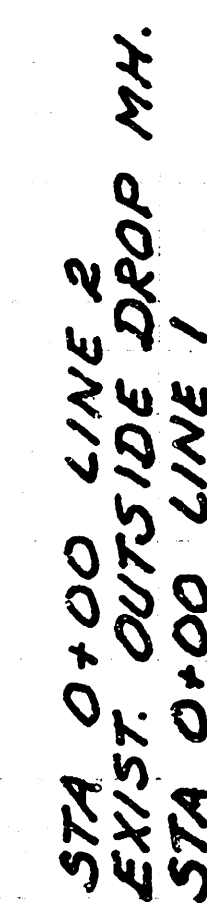
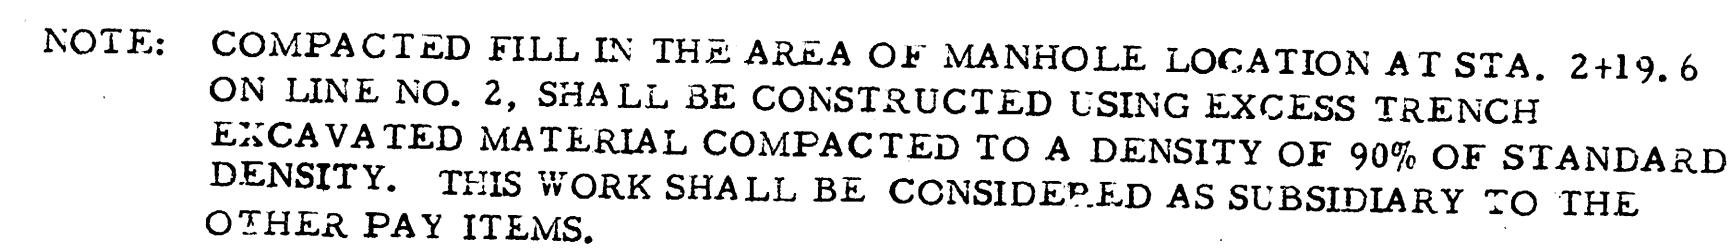


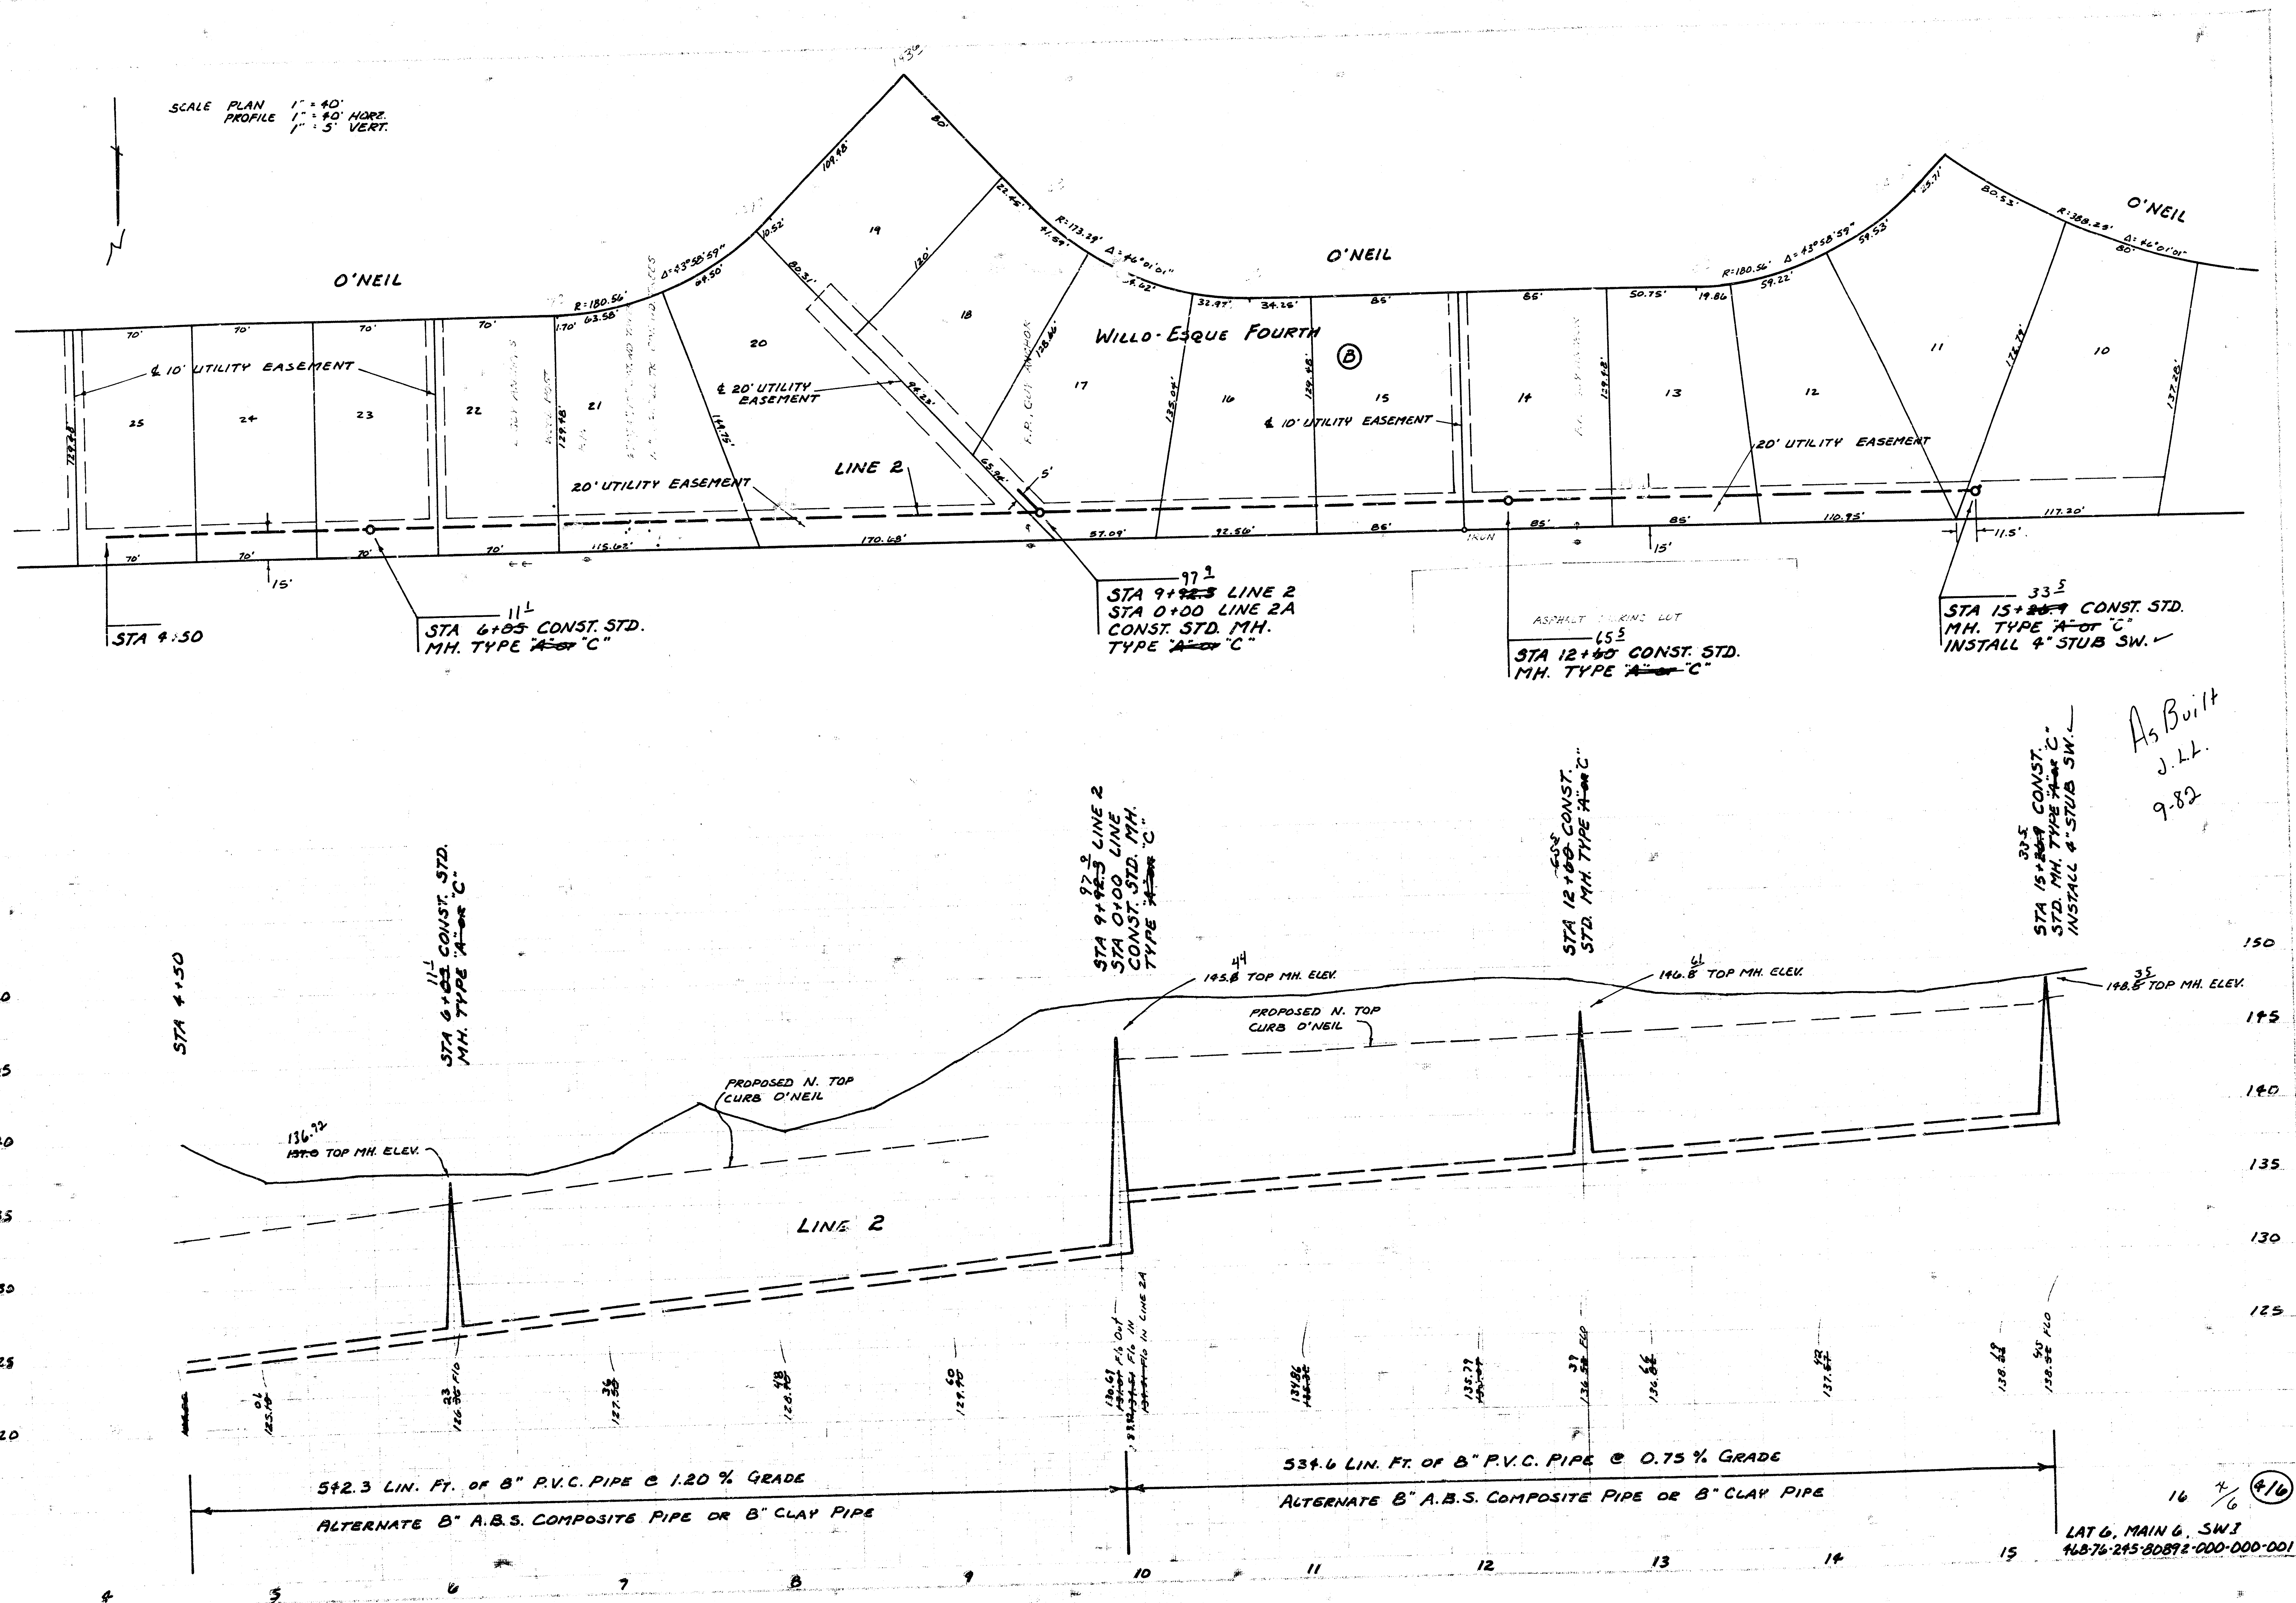


SCALE PLAN 1" = 40'
PROFILE 1" = 40' HORIZ.
1" = 5' VERT.

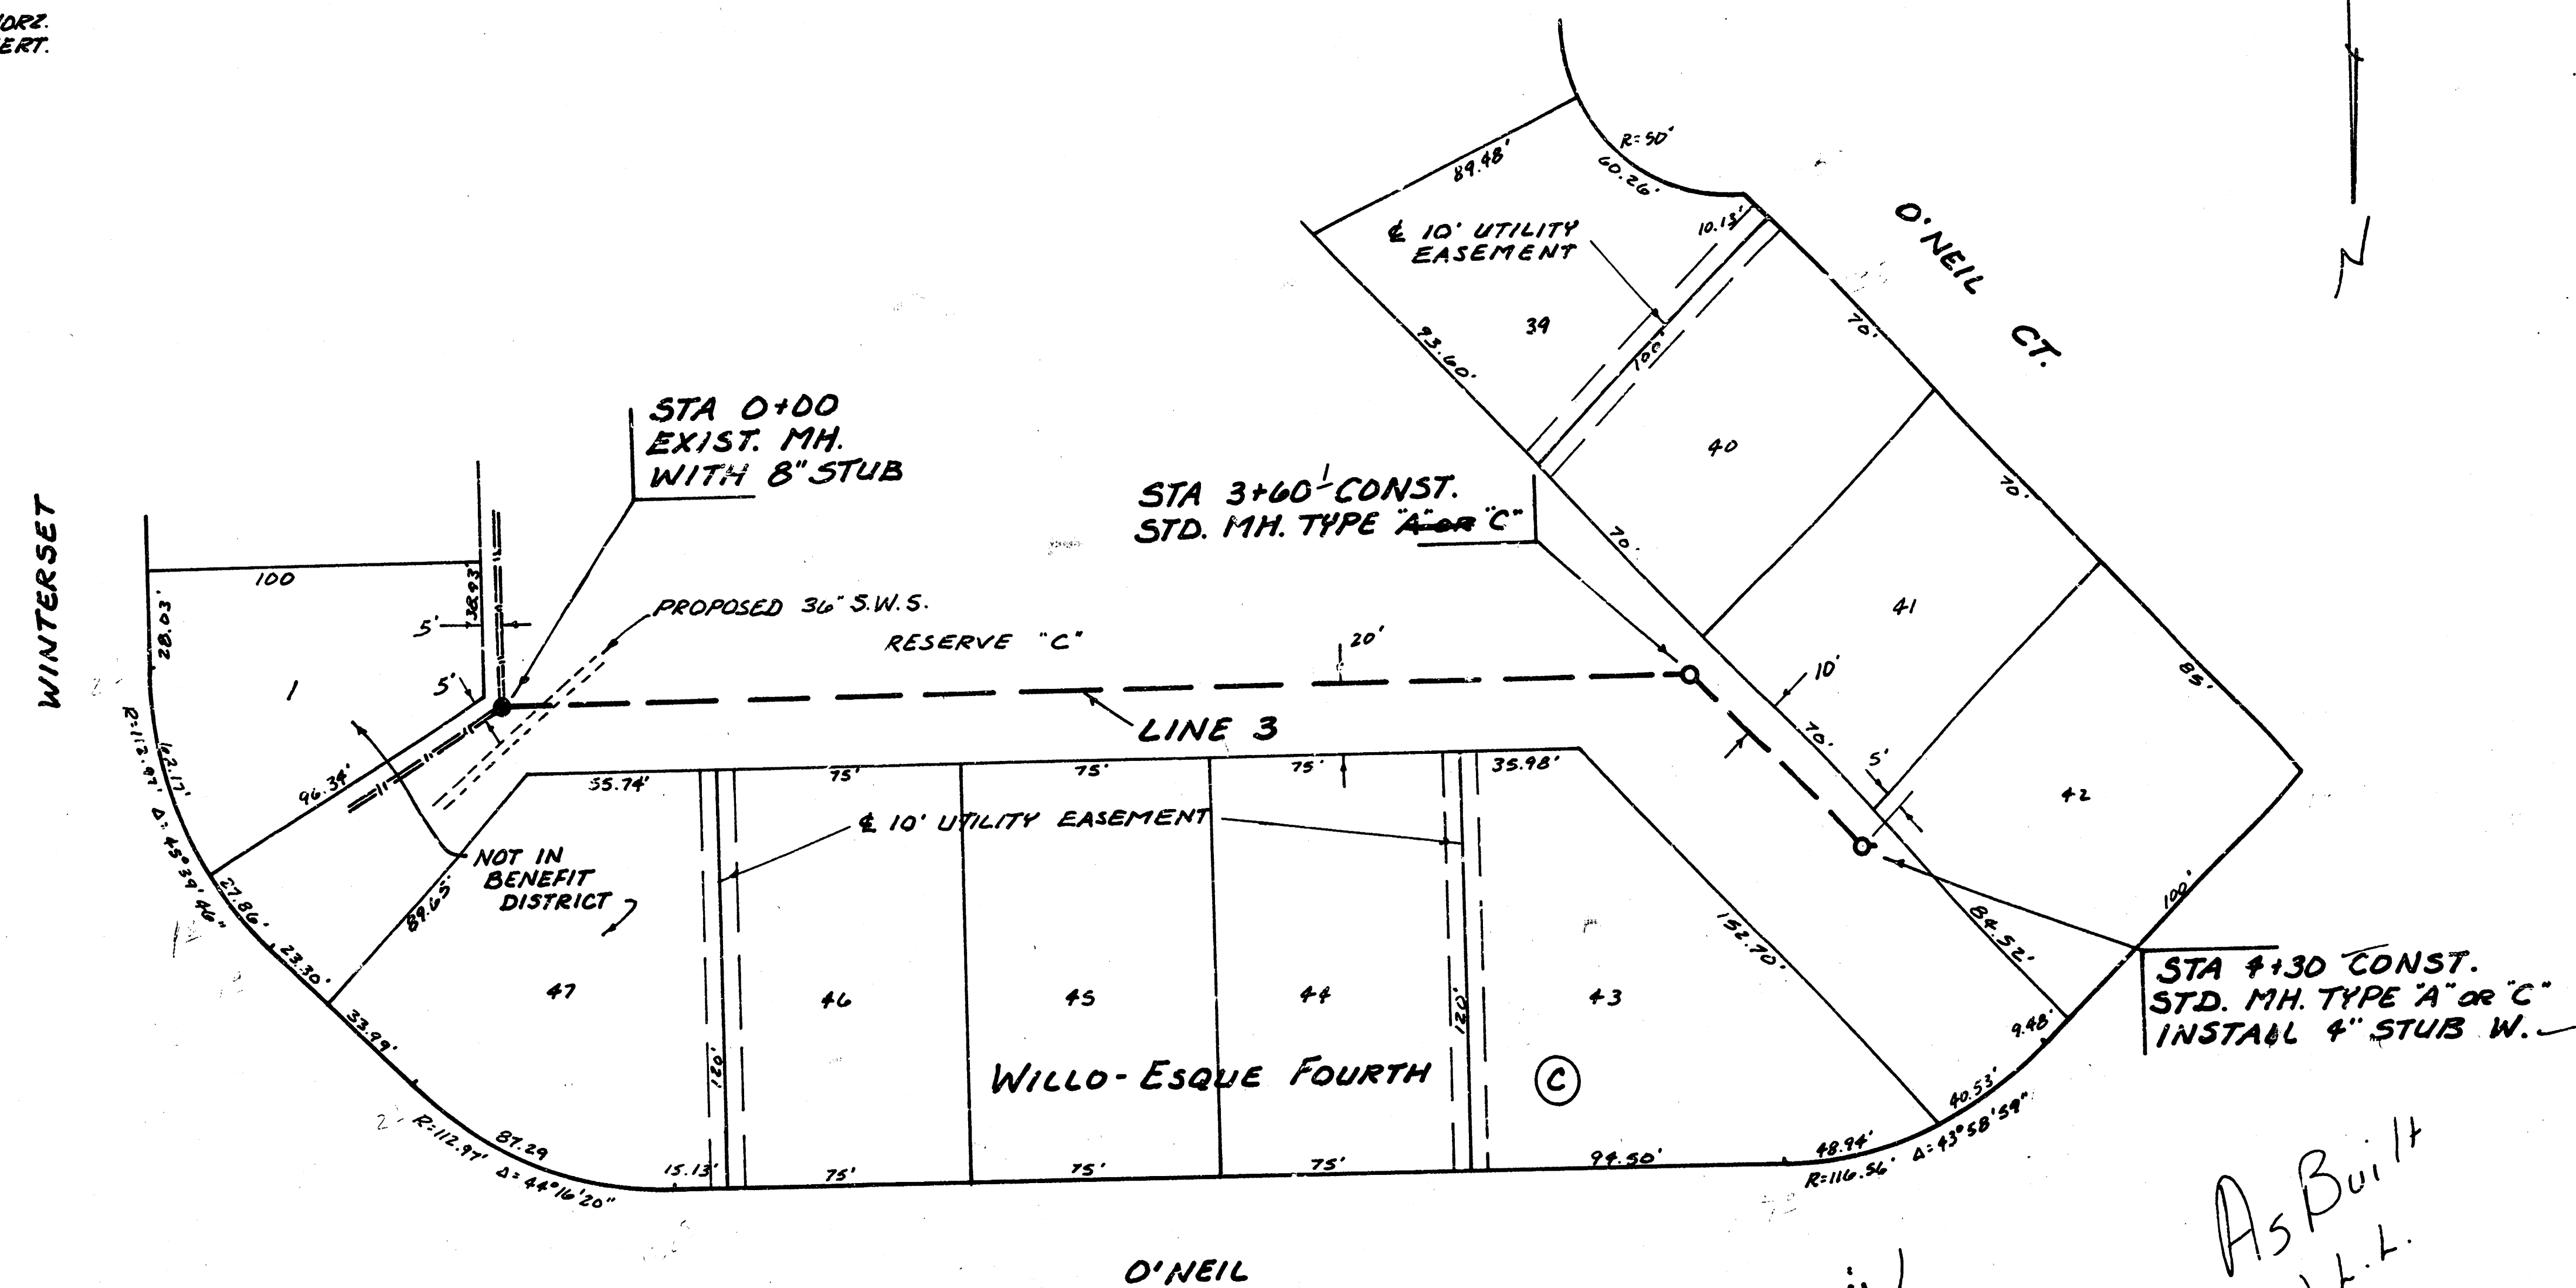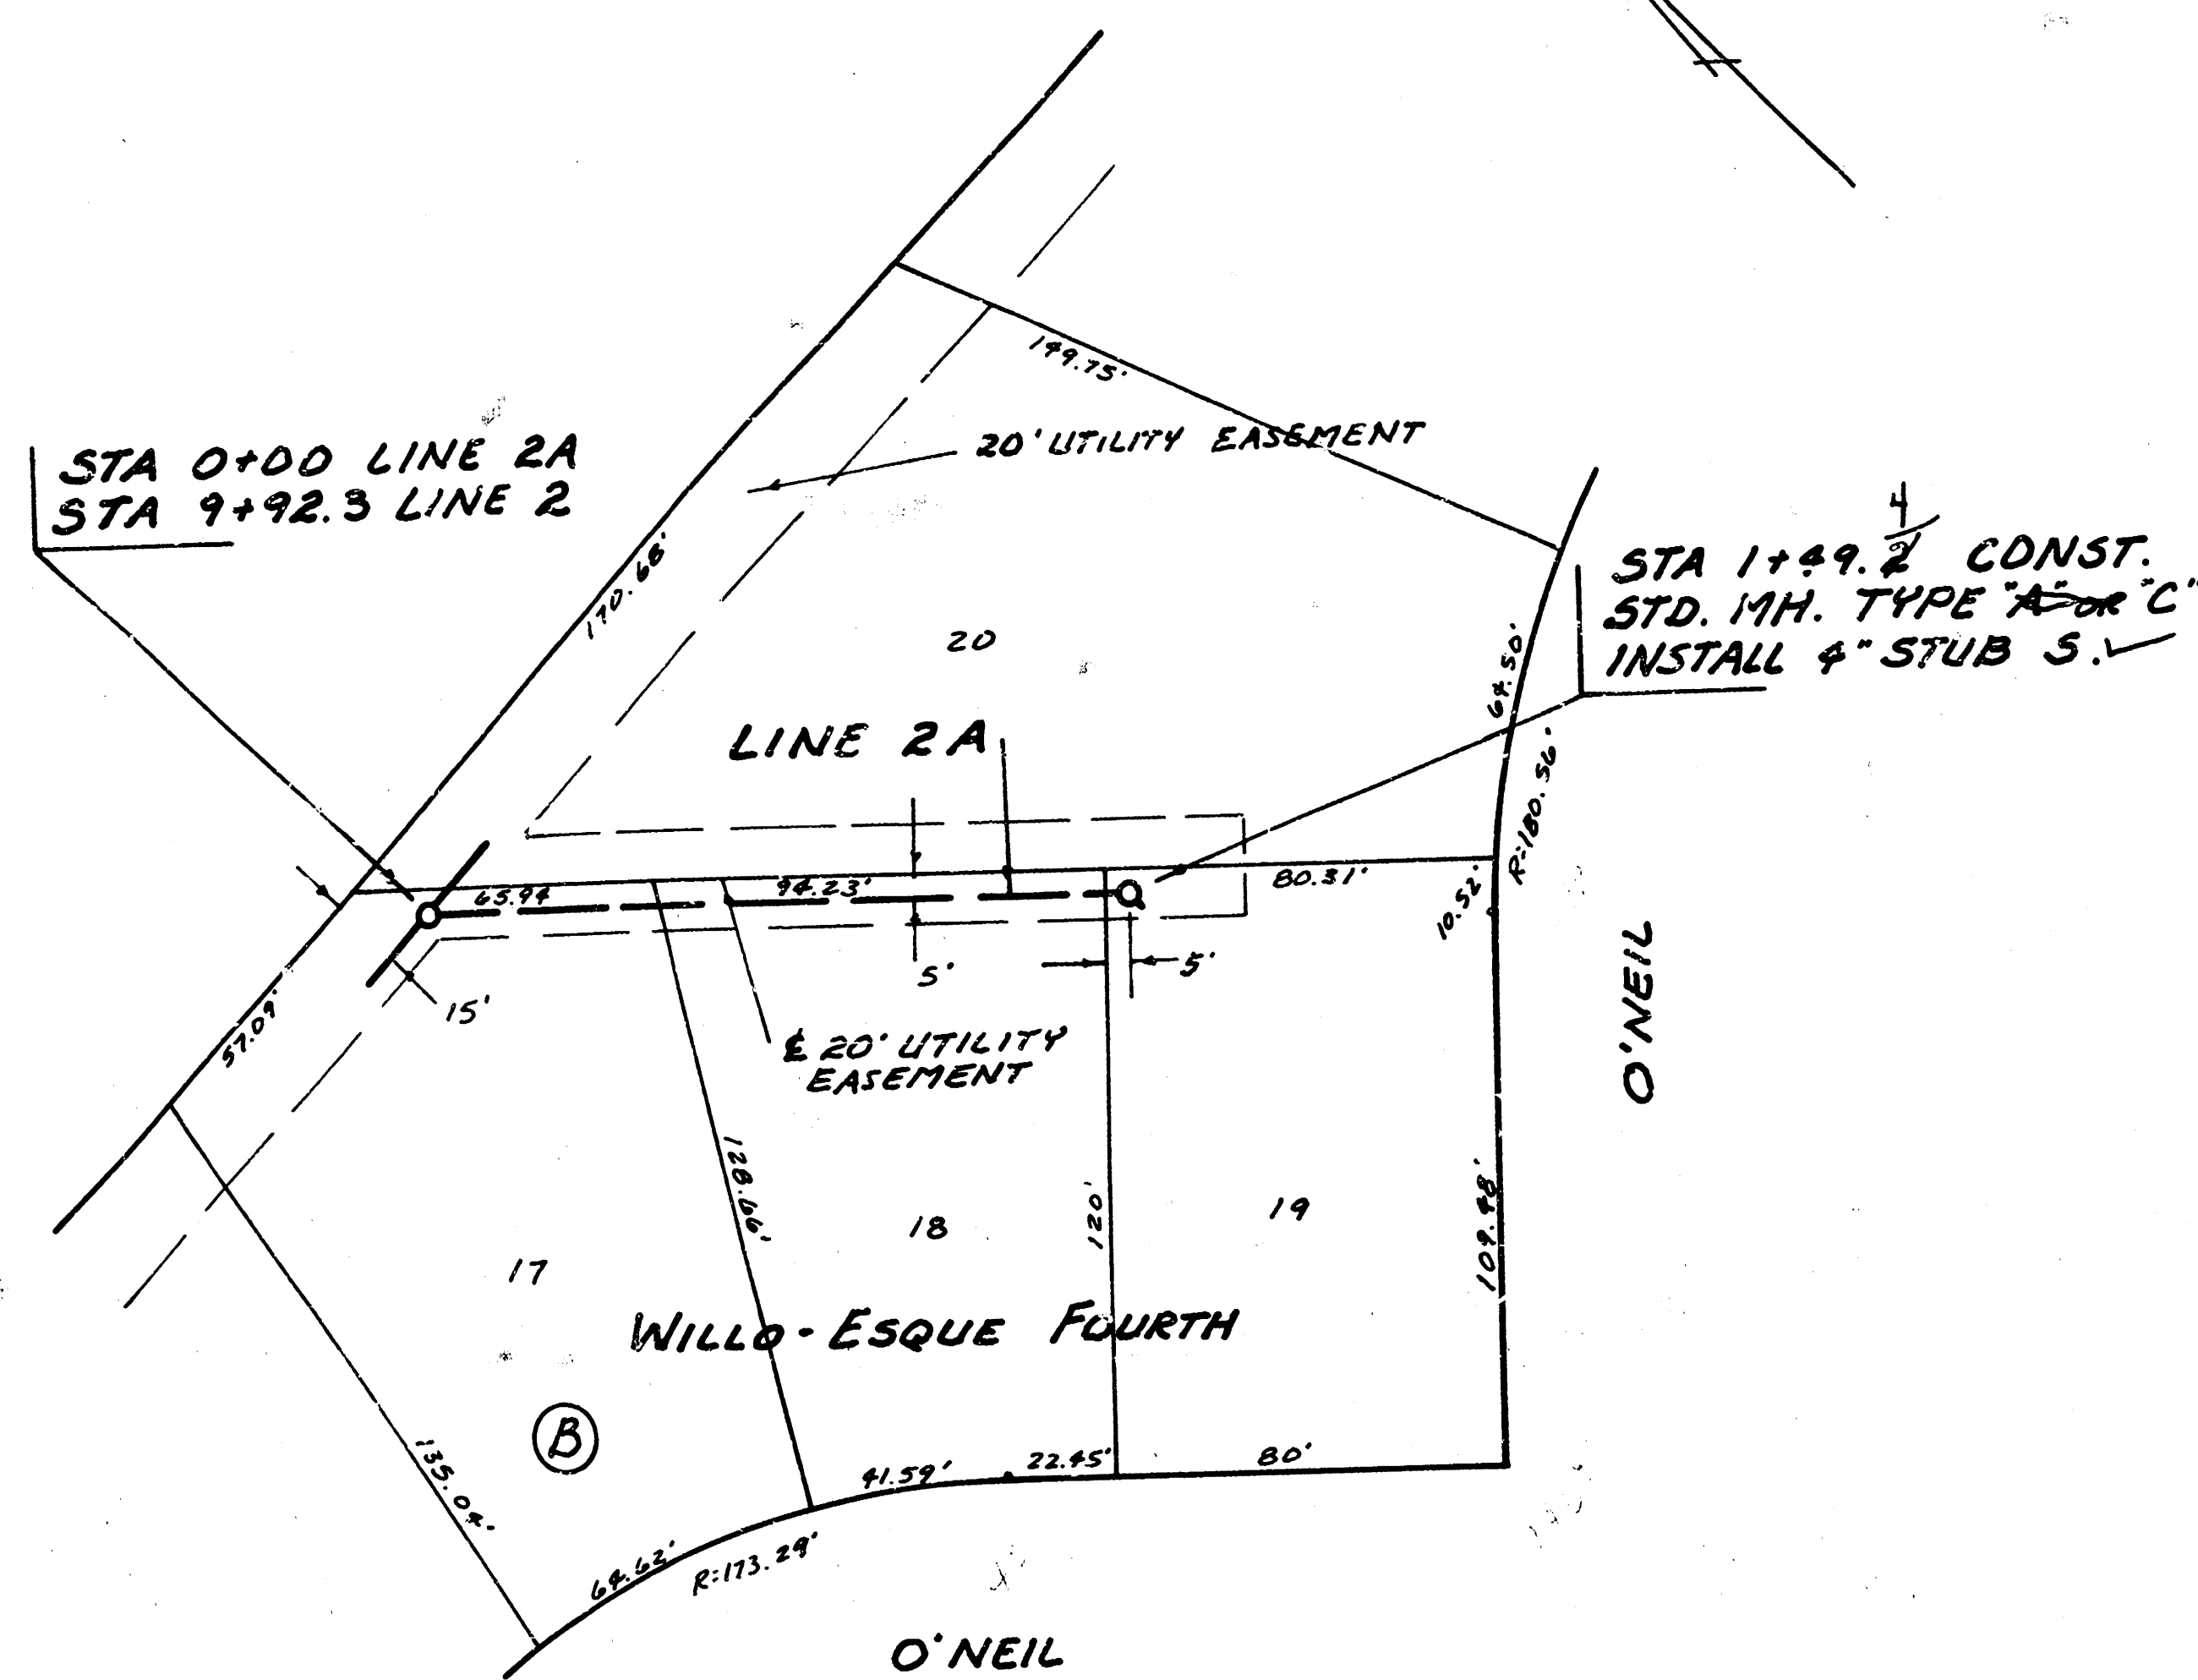


As Built
J.L.L.
9.82

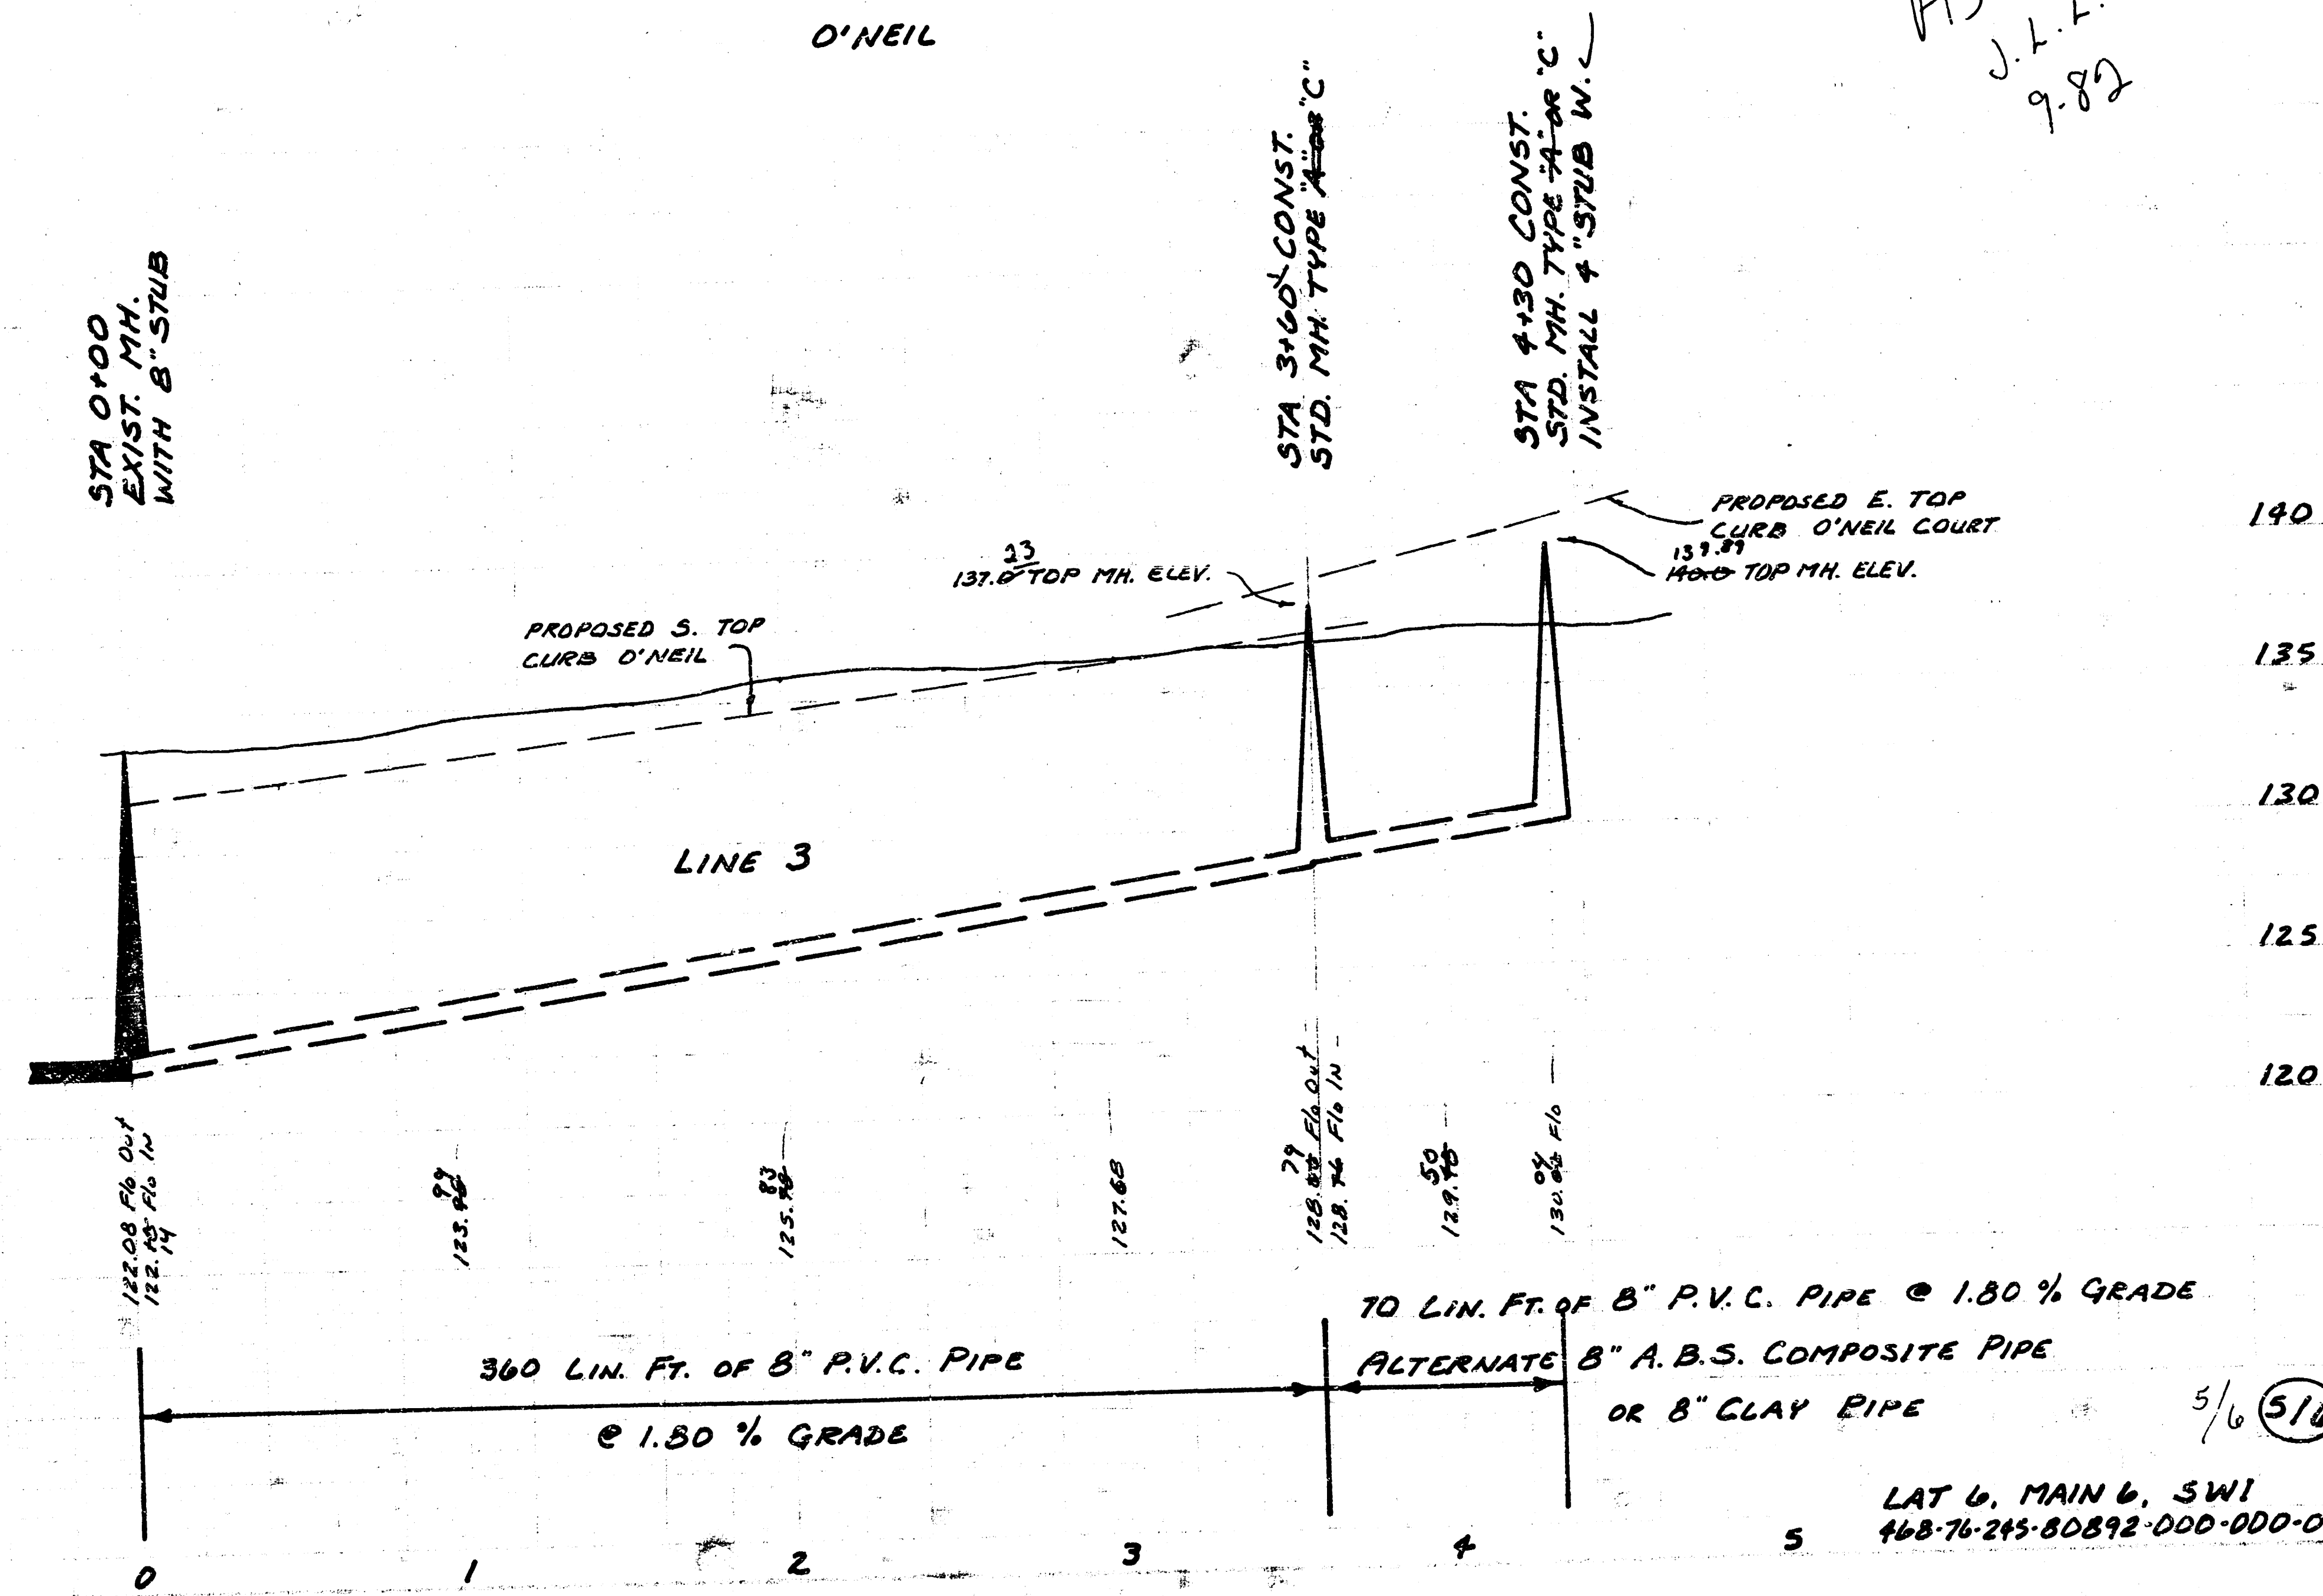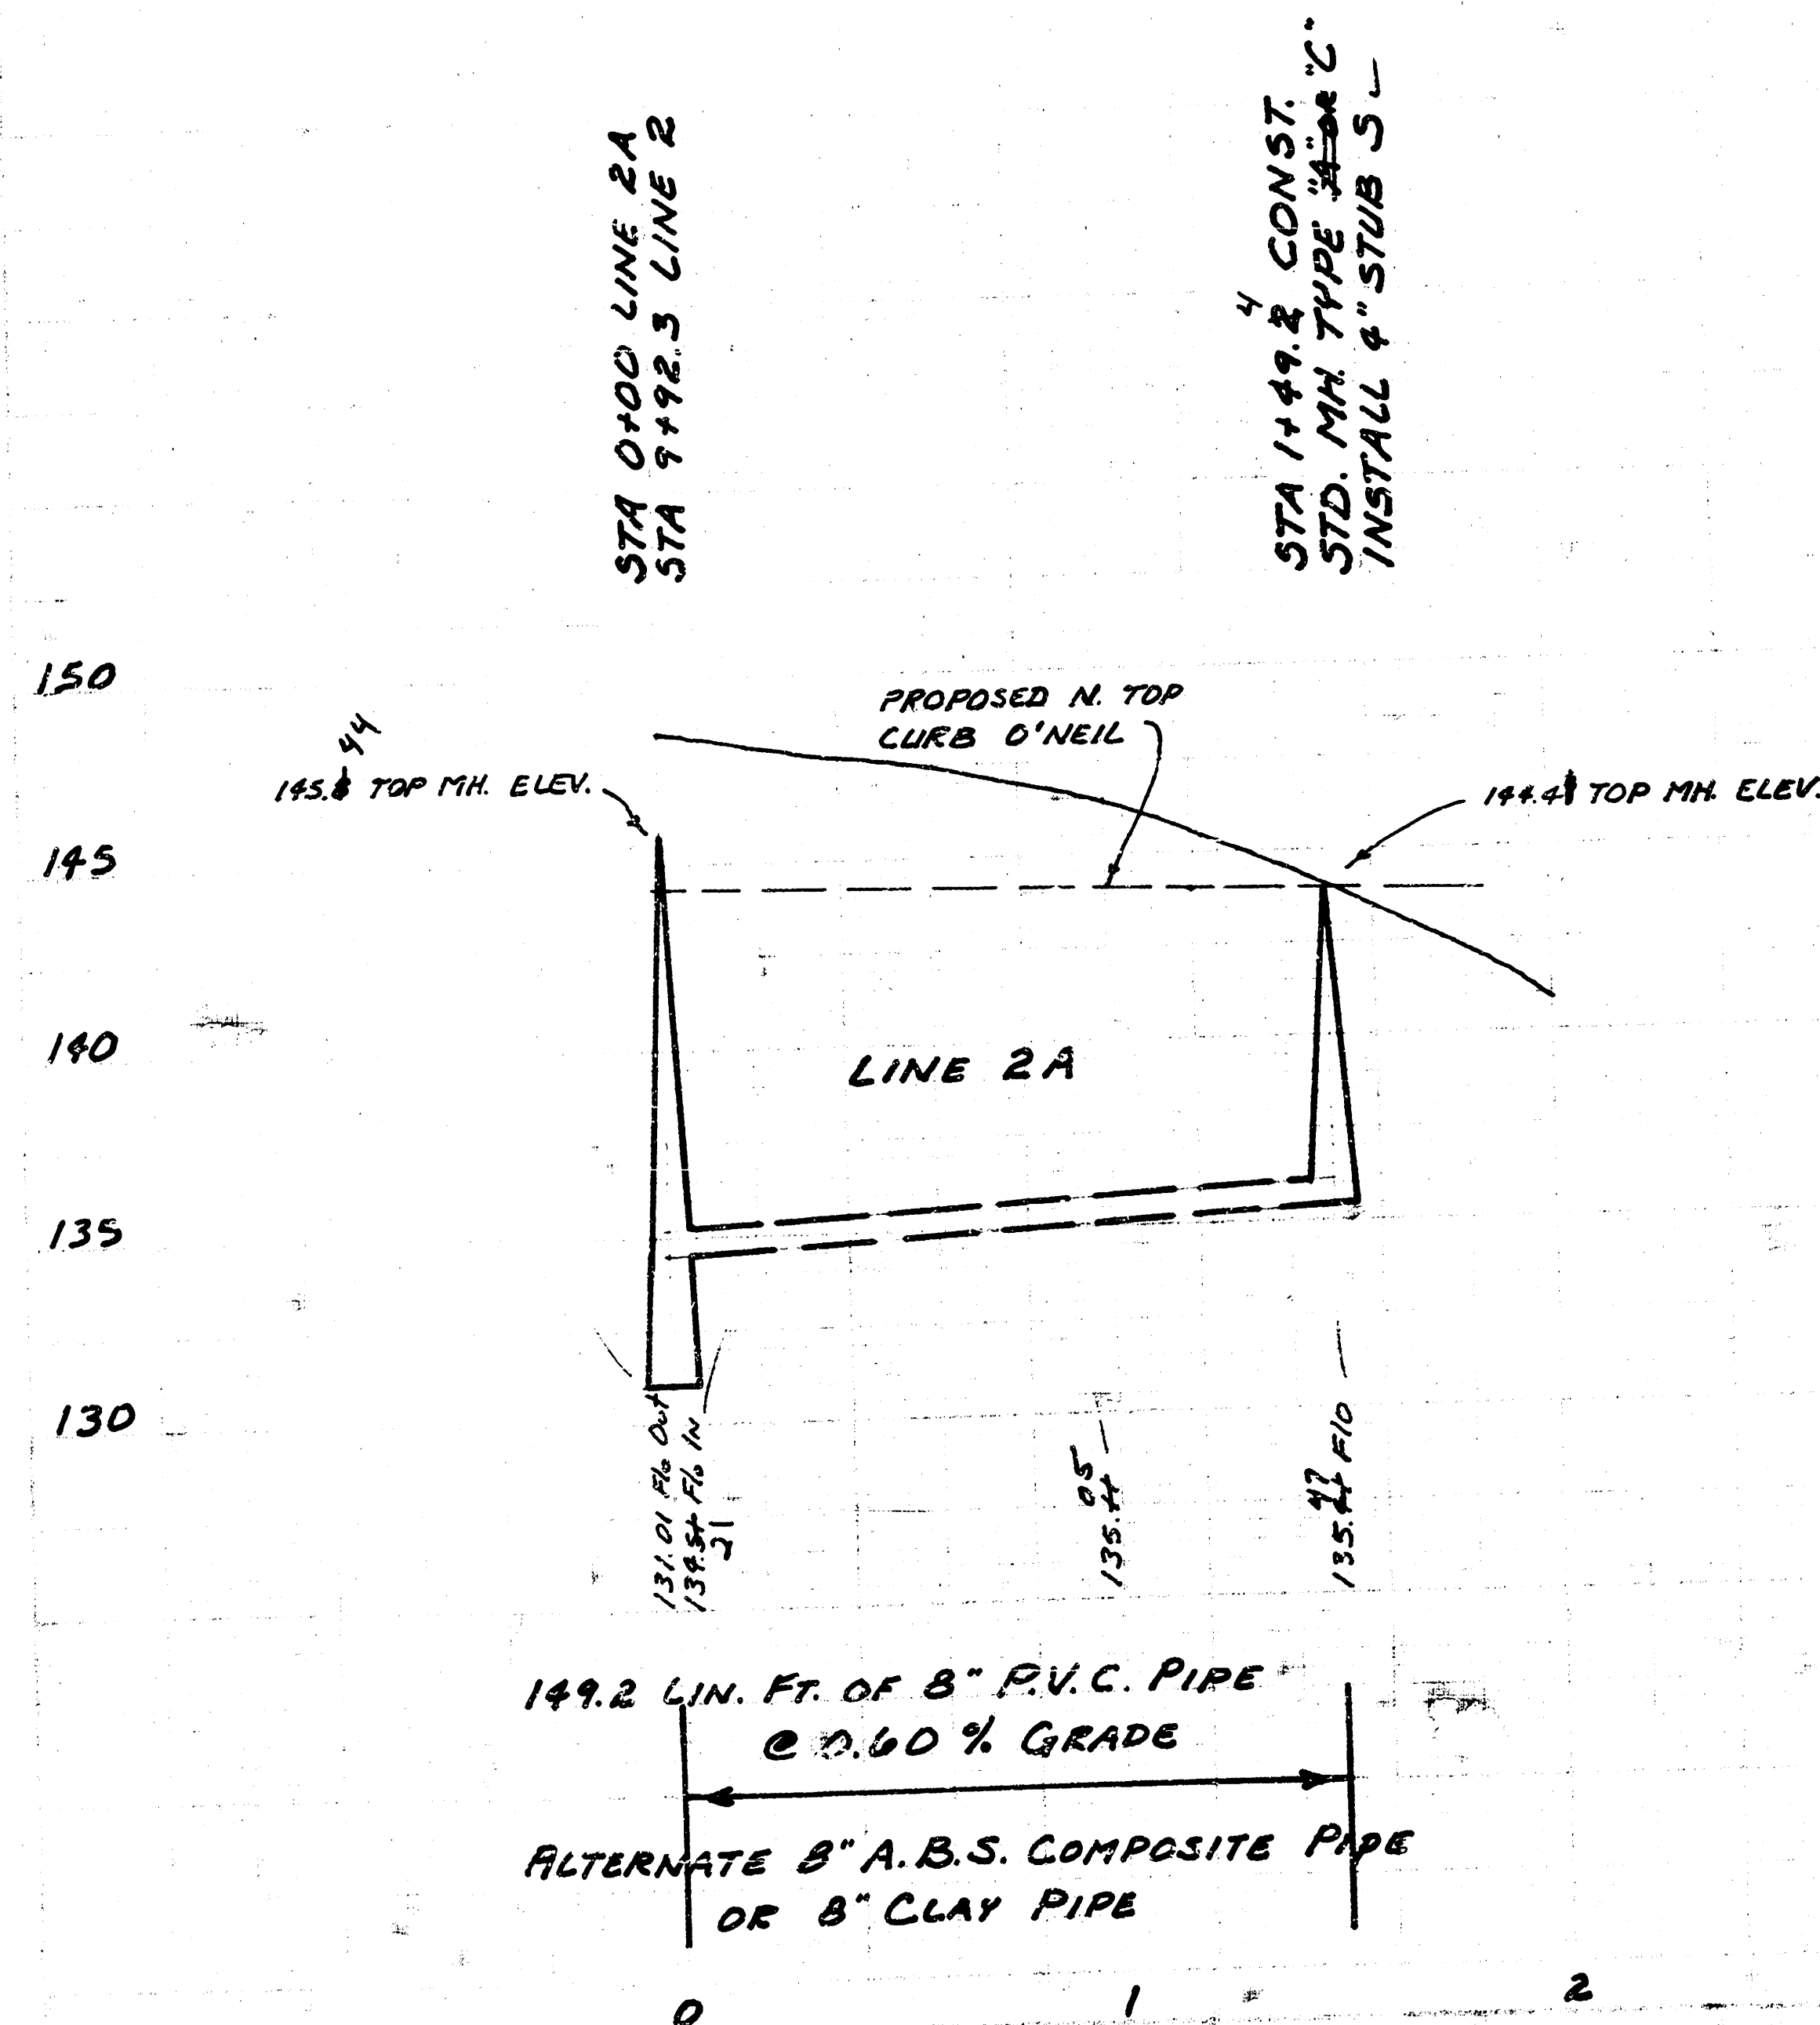

SCALE PLAN 1" = 40'
 PROFILE 1" = 40' HORIZ.
 1" = 5' VERT.

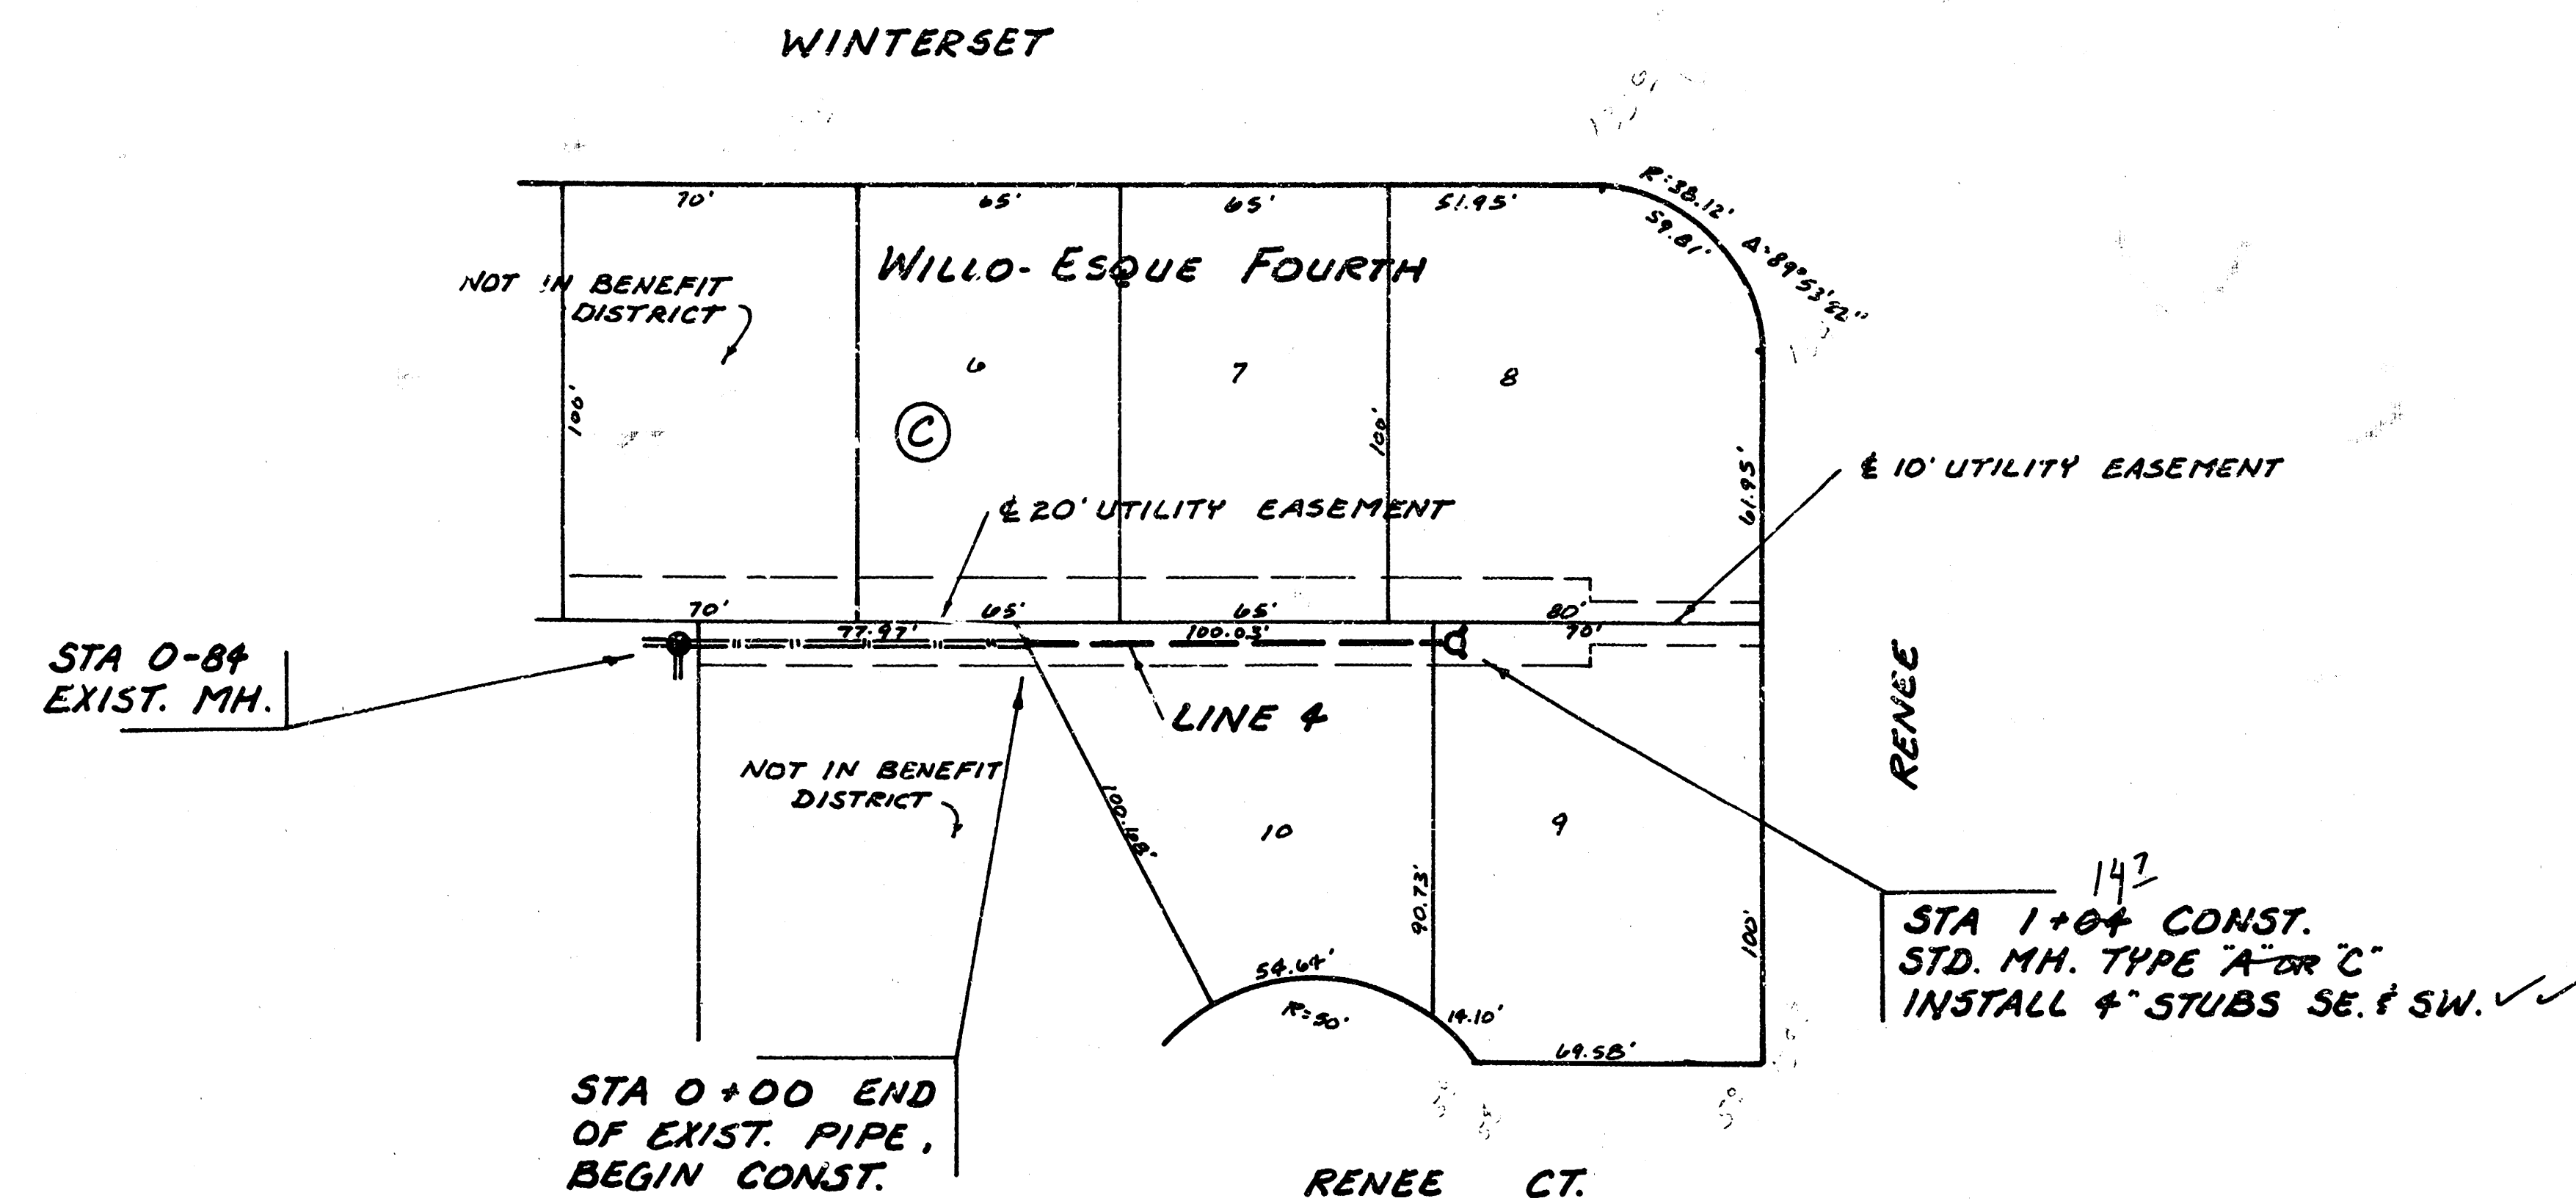

As Built
 J.L.L.
 9-82

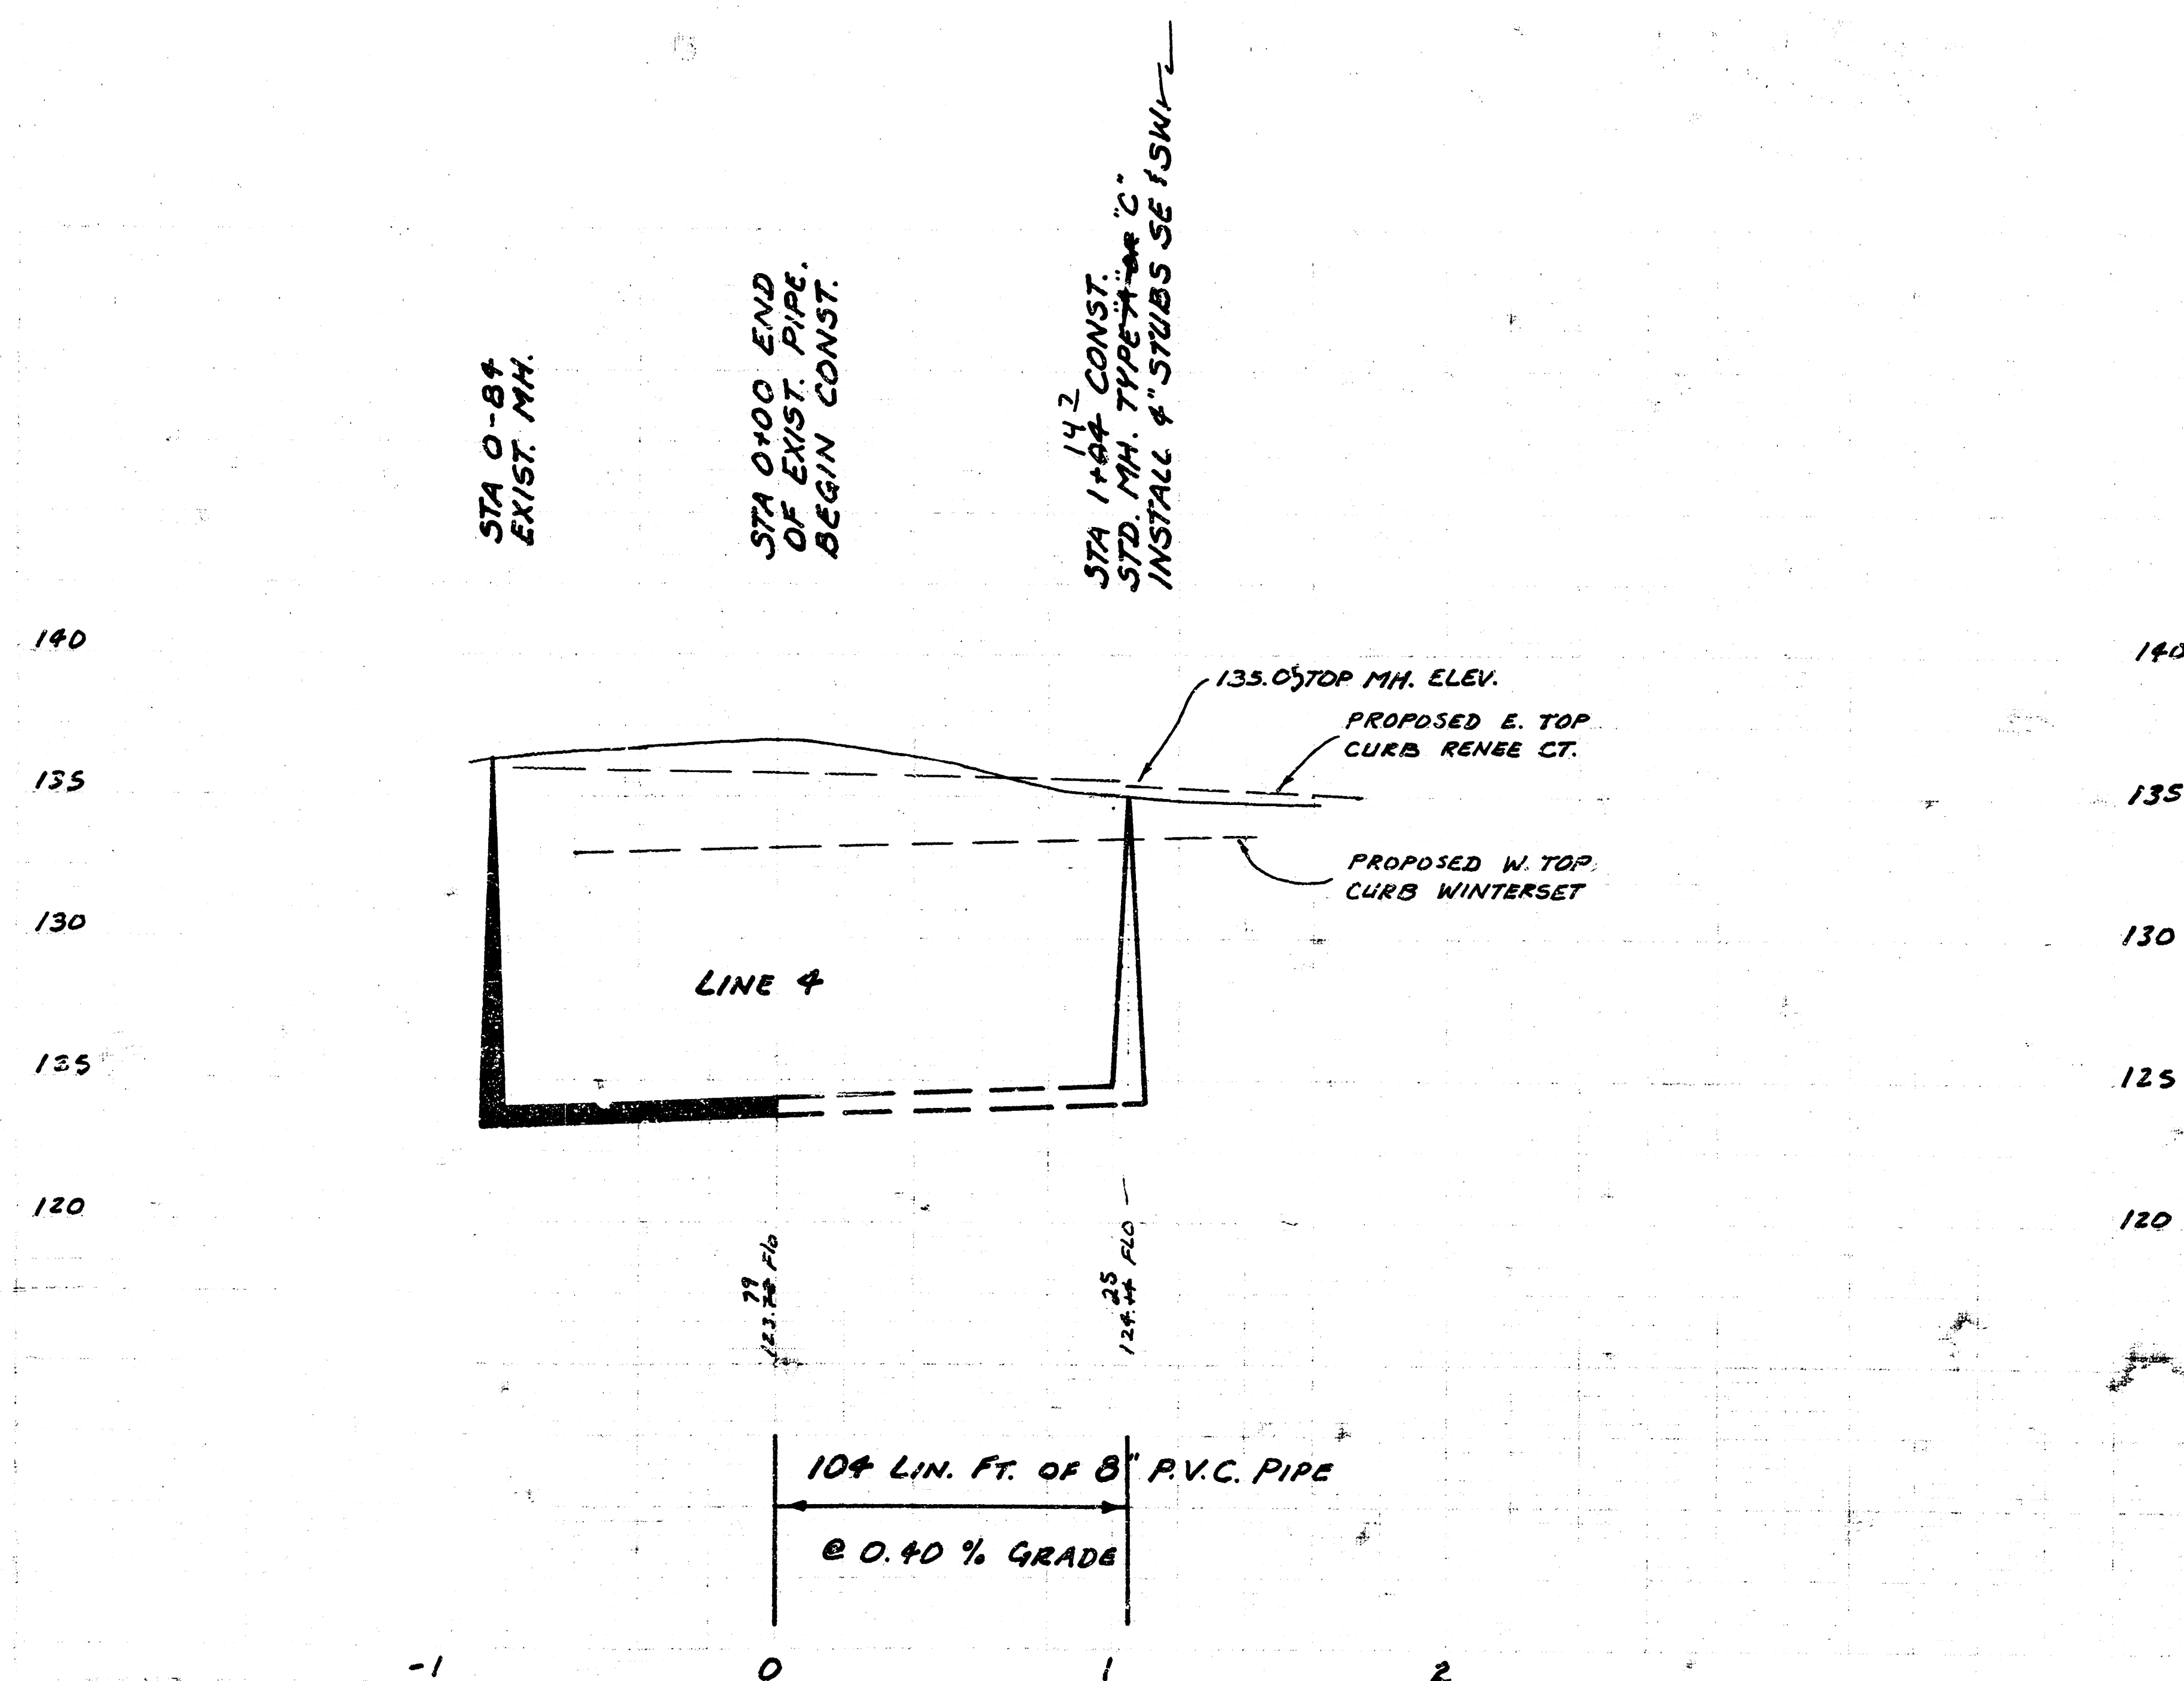

LAT 6, MAIN 6, SW1
 468-76-245-80892-000-000-001

10 2 3 2