


Scale Plan 1"=40'
Profile 1"=40' Horiz.
1"=5' Vert.

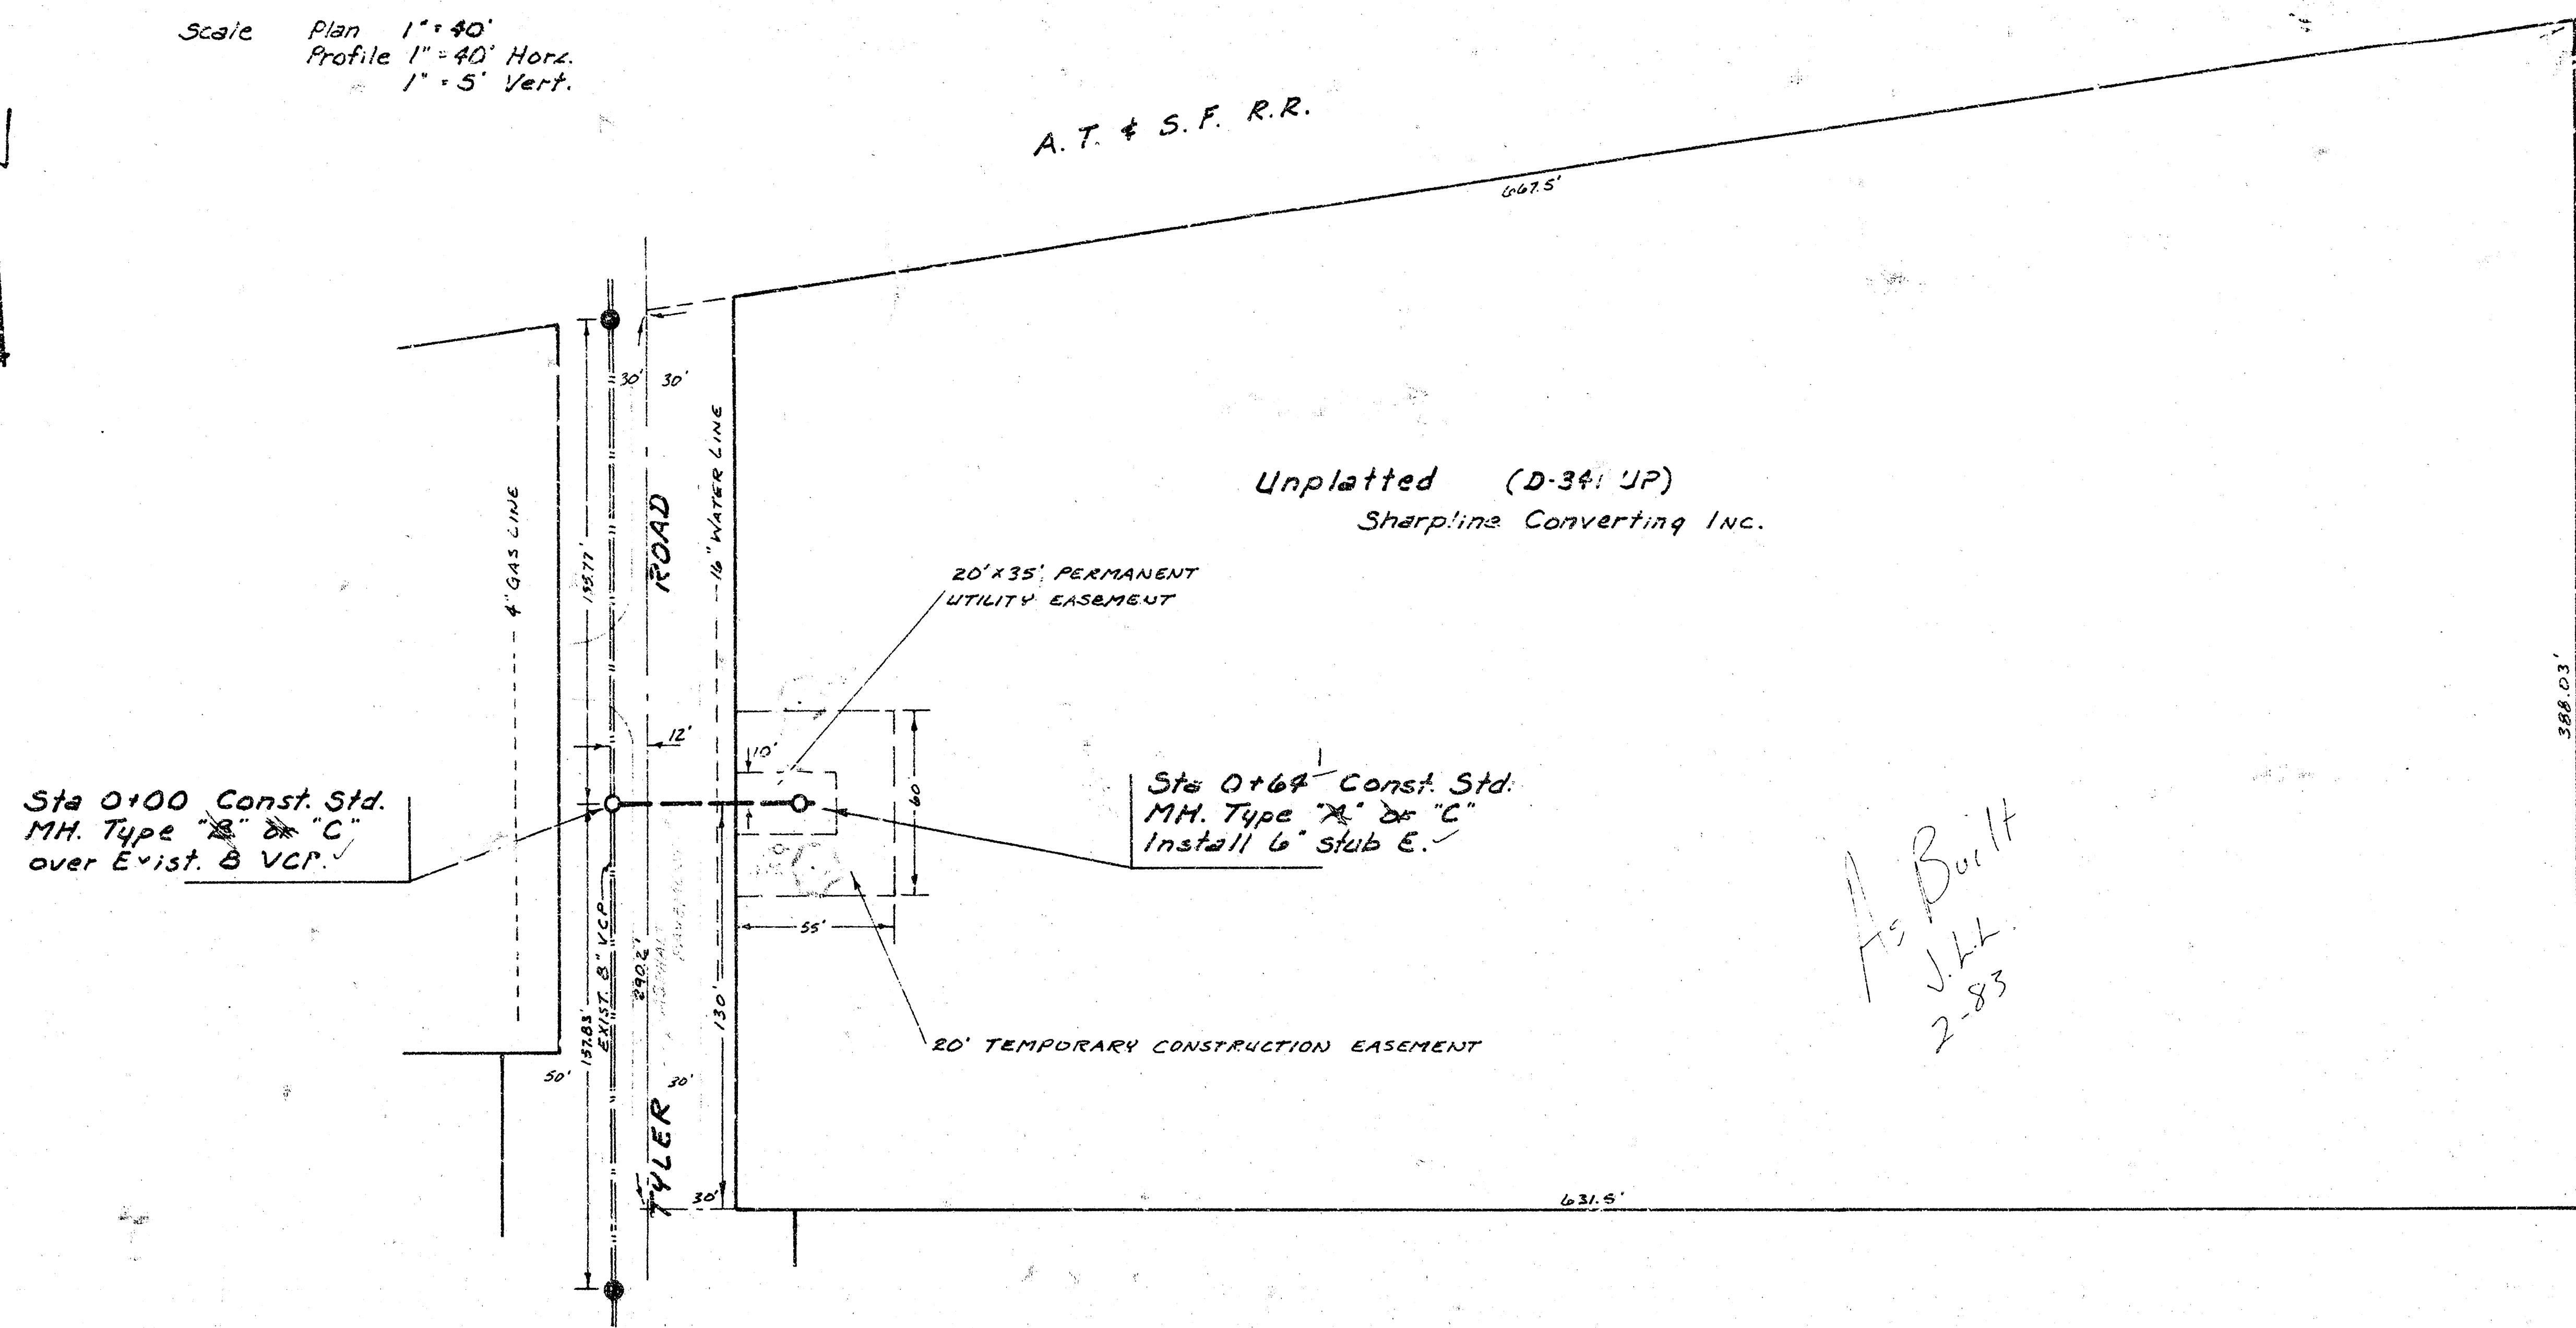


THE CONTRACTOR SHALL BE RESPONSIBLE FOR PRESERVING PROPERTY IRONS. THE CONTRACTOR SHALL BE REQUIRED TO RE-ESTABLISH ANY PROPERTY IRONS WHICH ARE DAMAGED OR DESTROYED BY HIS CONSTRUCTION OPERATIONS. SUCH IRONS SHALL BE RE-ESTABLISHED BY A LICENSED LAND SURVEYOR OR A LICENSED PROFESSIONAL ENGINEER IN ACCORDANCE WITH STATE LAWS.

TBM: Top of the SW 3" x 4" Steel Guard Post of Guard Posts around a Gas Regulator in the NW Quad of the Intersection of Harry St. and Tyler Road. Elev. 143.78

TBM: "M" in Mueller on the Top Flange of Fire Hydrant in the SE Quad of the Intersection of Kellogg (HWY #4) and Tyler Road. Elev. 142.85

As Built
J.L.L.
2-83

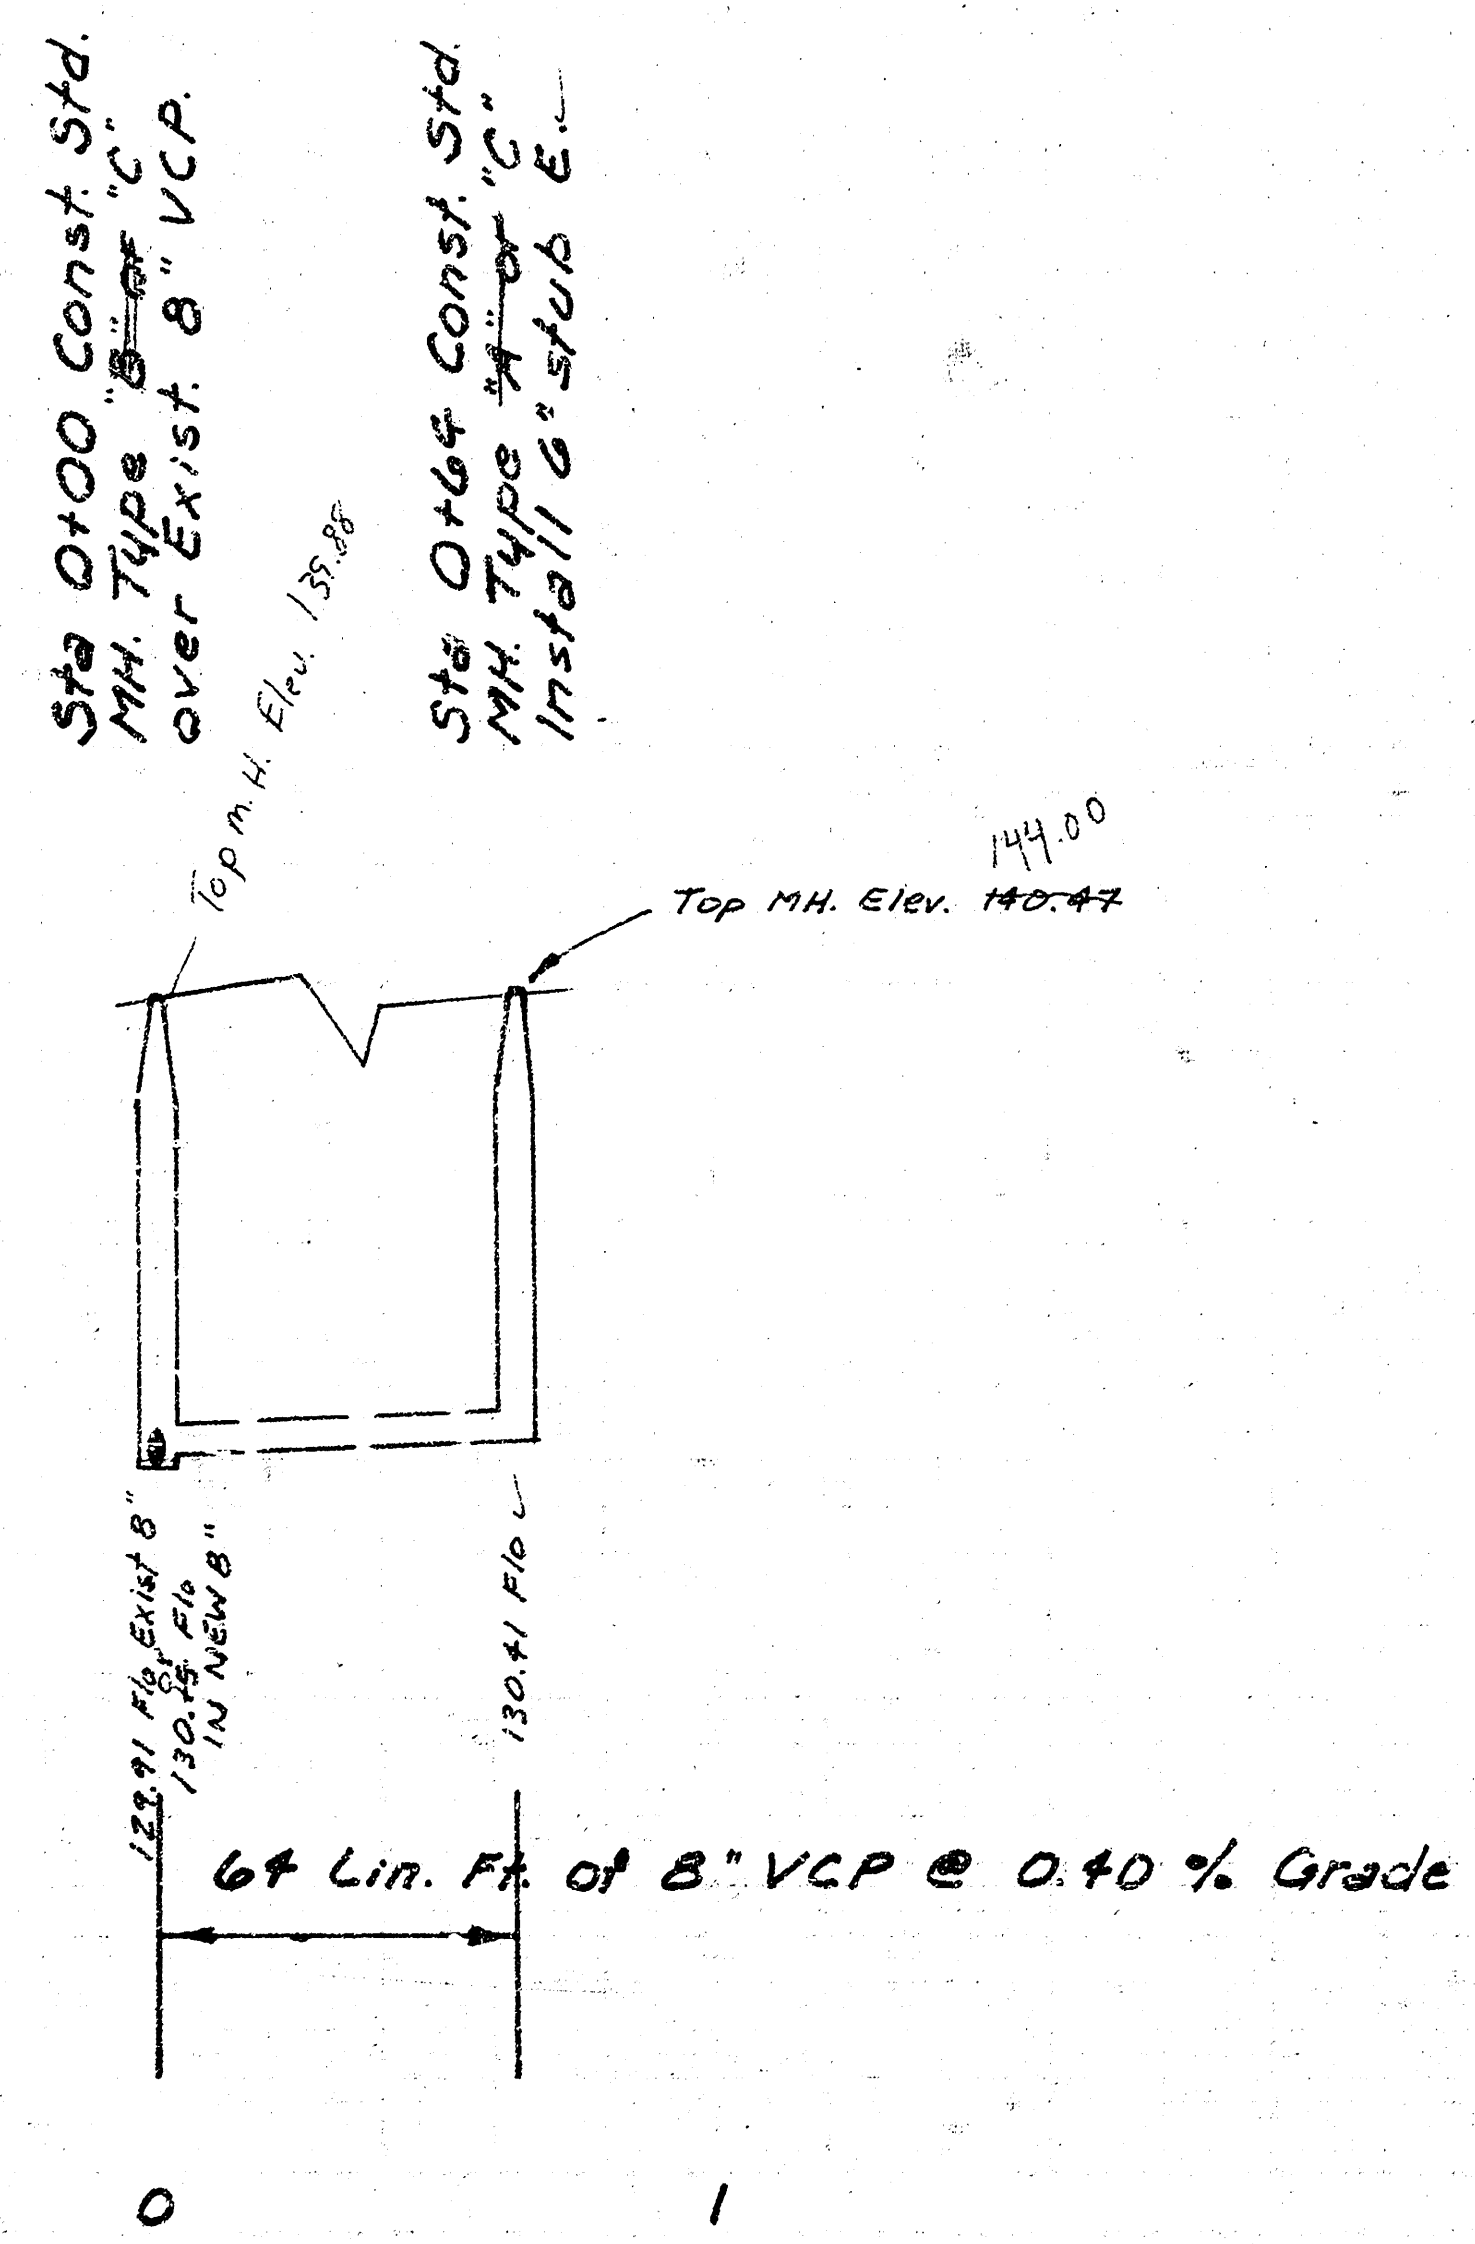

PROJECT DESCRIPTION			
LAT 2, MAIN 3, SOUTHWEST INTERCEPTOR			
PROJECT NUMBER			
468-76-245-81237-000-000-001			
BOOK NO.	APPROVED BY	DATE	REVISED
DRAWN BY 100/M/S			
CITY OF WICHITA			
DEPARTMENT OF ENGINEERING			
DIRECTOR OF ENG./CITY ENGINEER			SCALE
R. W. BRUGGEMAN			