


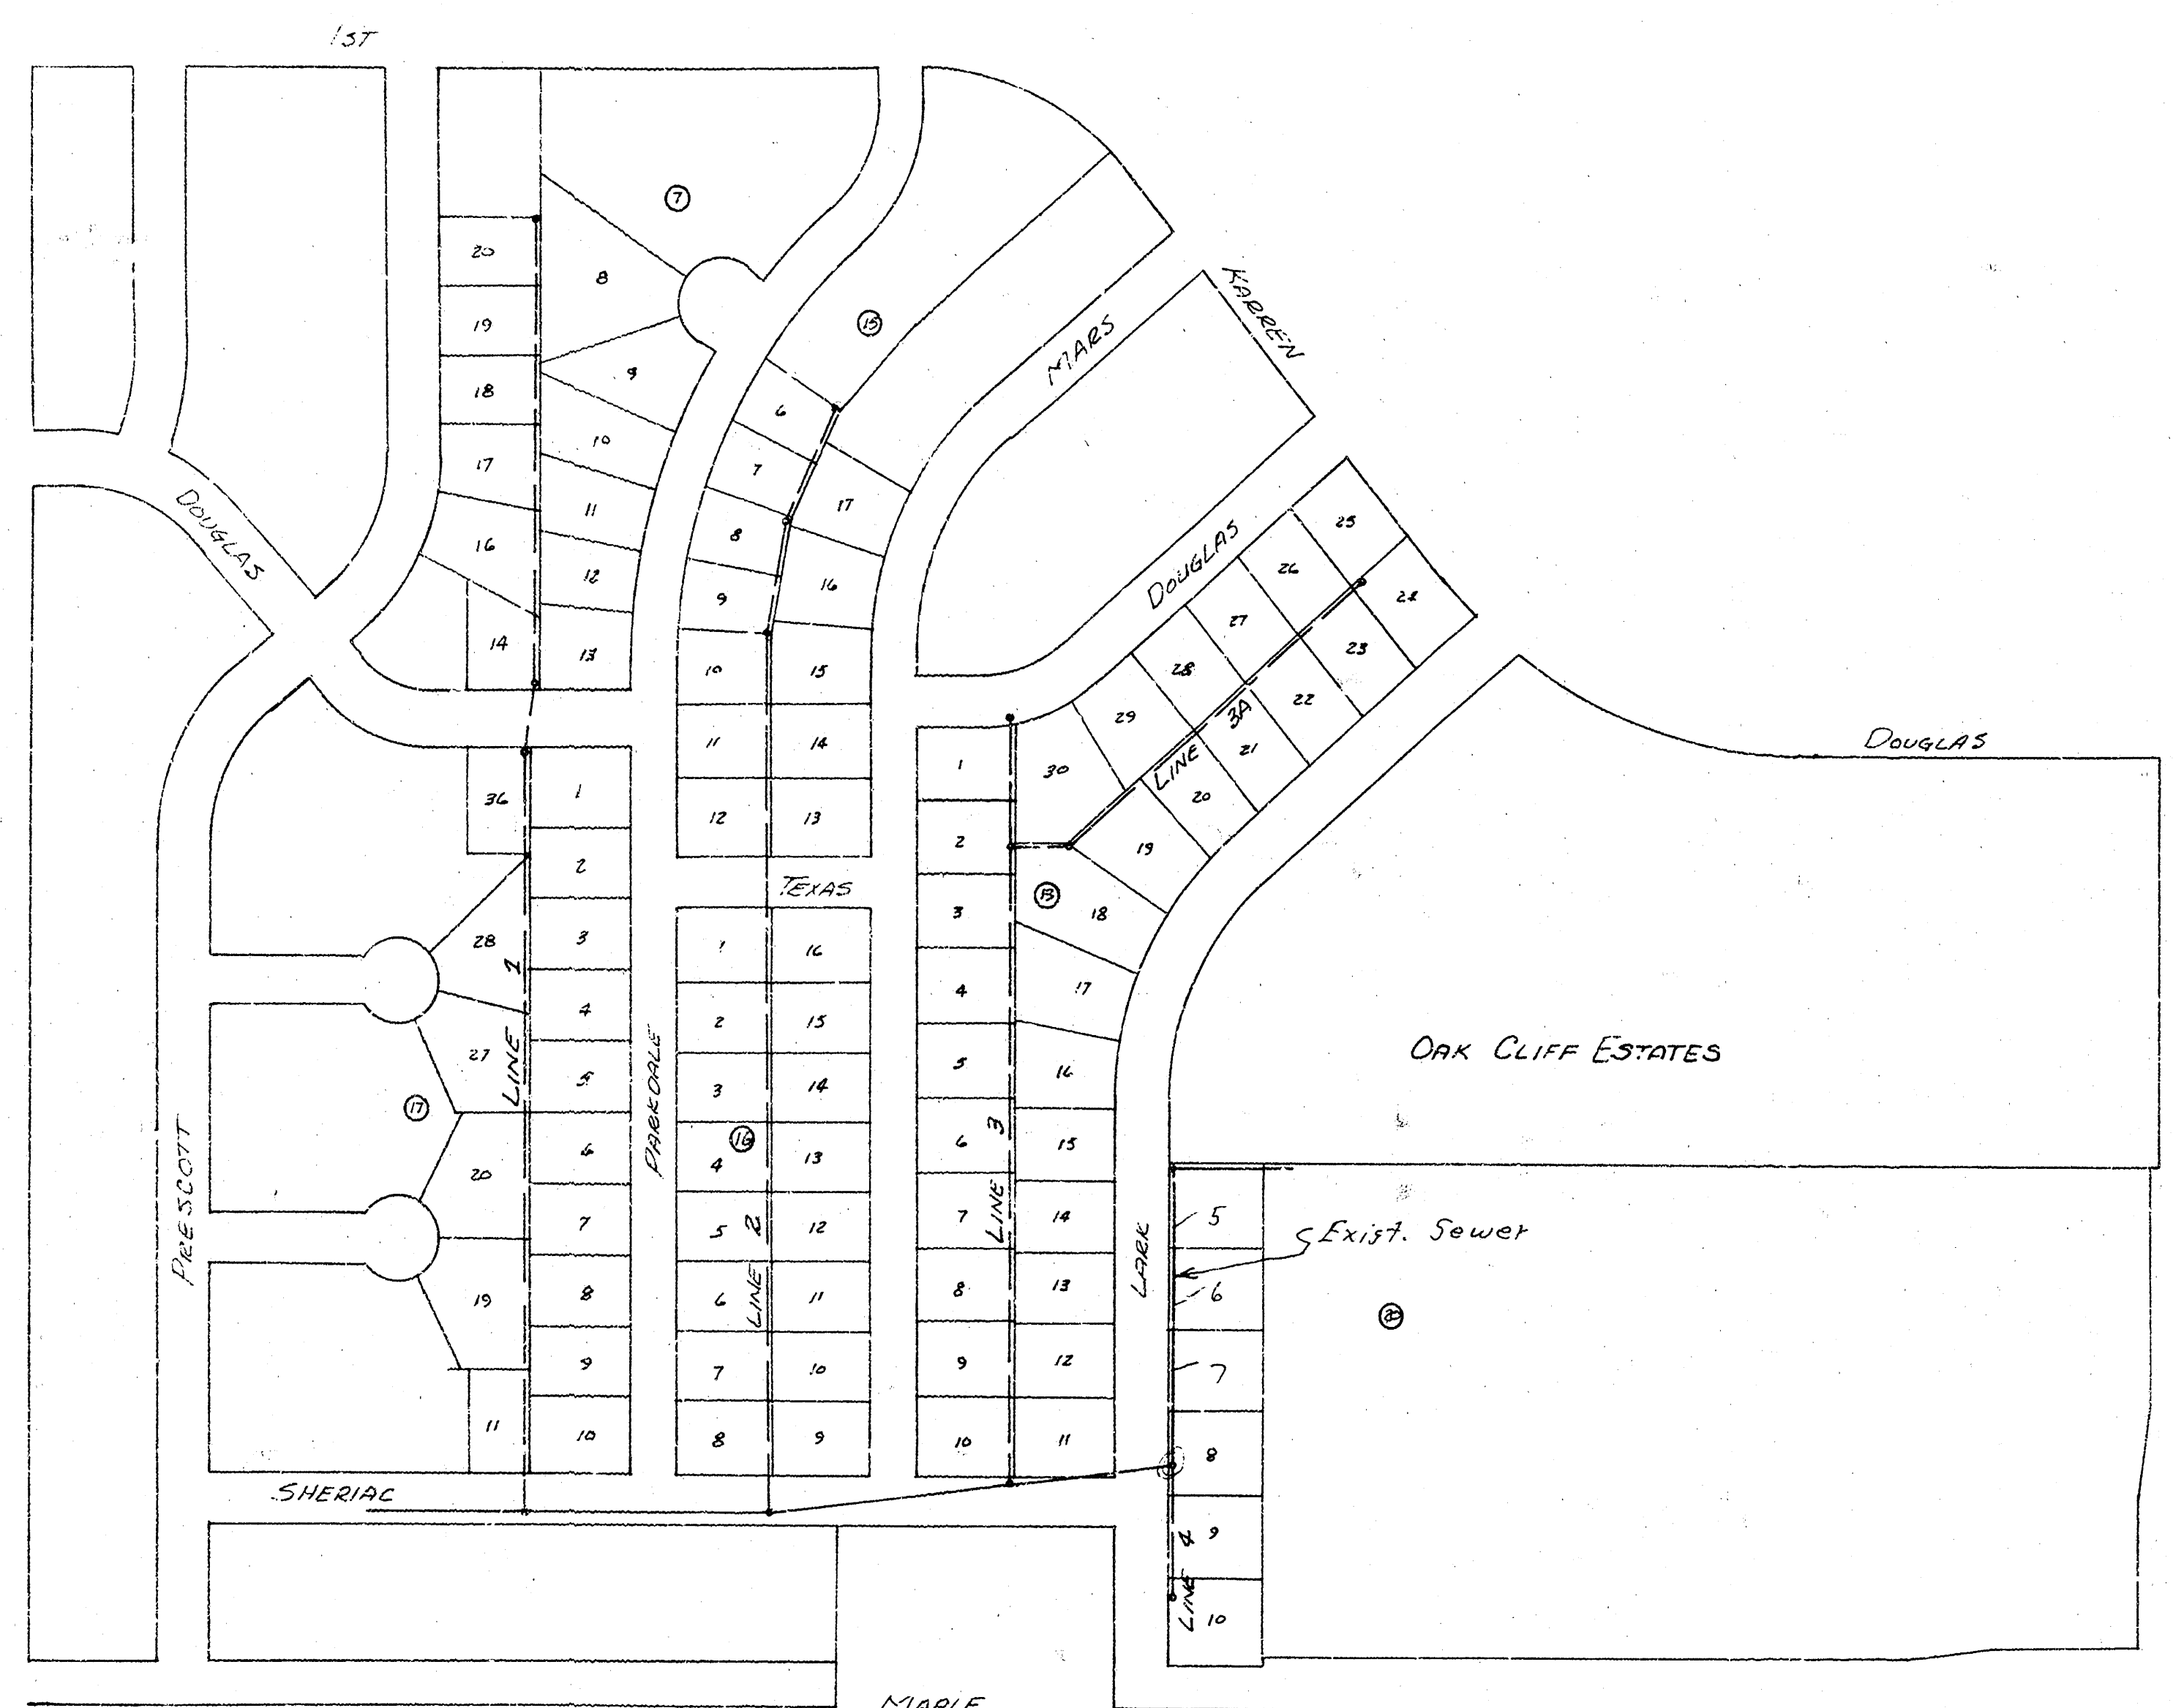

LAT 5 , MAIN 9 , SW. INTERCEPTOR

CITY OF WICHITA

RAY BRUGGEMAN - CITY ENGINEER

PROJ. NO. 468-76-245-80988-000-000-001



LINE 1 SHEET 2#3
 LINE 2 SHEET 4#5
 LINE 3 SHEET 6
 LINE 3A SHEET 7
 LINE 4 SHEET 8

NOTE: RISERS SHALL BE INSTALLED ON THE EXISTING SEWER ALONG THE EAST SIDE OF LARK TO FACILITATE FUTURE HOUSE SEWER CONNECTIONS ON LOTS 5, 6 AND 7, IN BLOCK 20 AS A PART OF PROJECT.

OK


NOTE: PLAN INDICATES CLAY PIPE TO BE USED ON THIS PROJECT BUT A.B.S. COMPOSITE PIPE OR P.V.C. PIPE CAN BE USED AS AN ALTERNATE. TYPE "C" MANHOLES CAN ALSO BE USED AS AN ALTERNATE TO THE TYPE "A" MANHOLES SHOWN ON THE PLANS.

As Built
 7/8/1

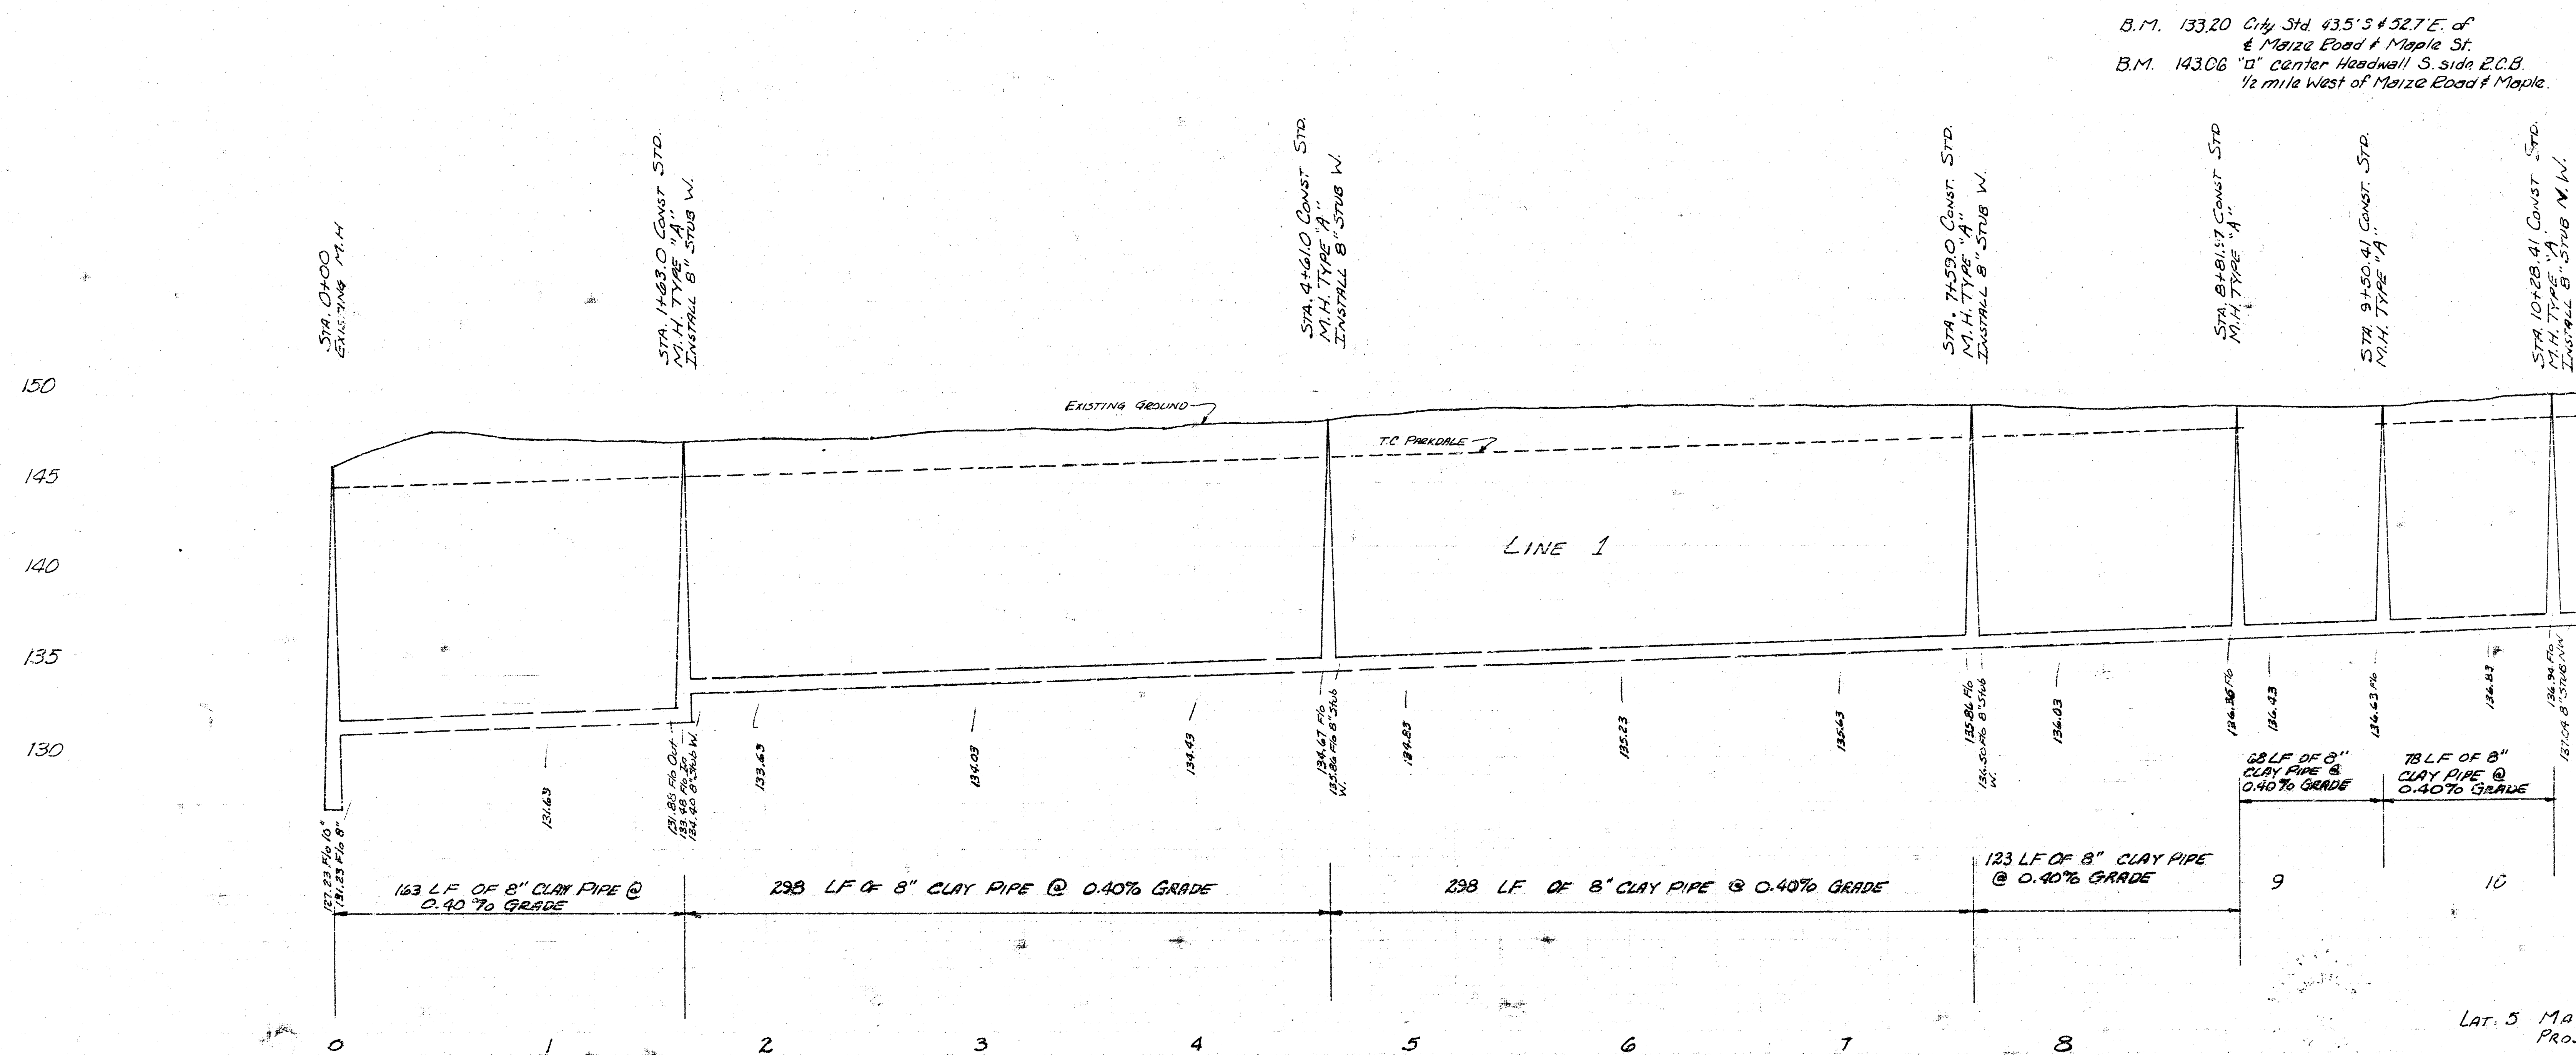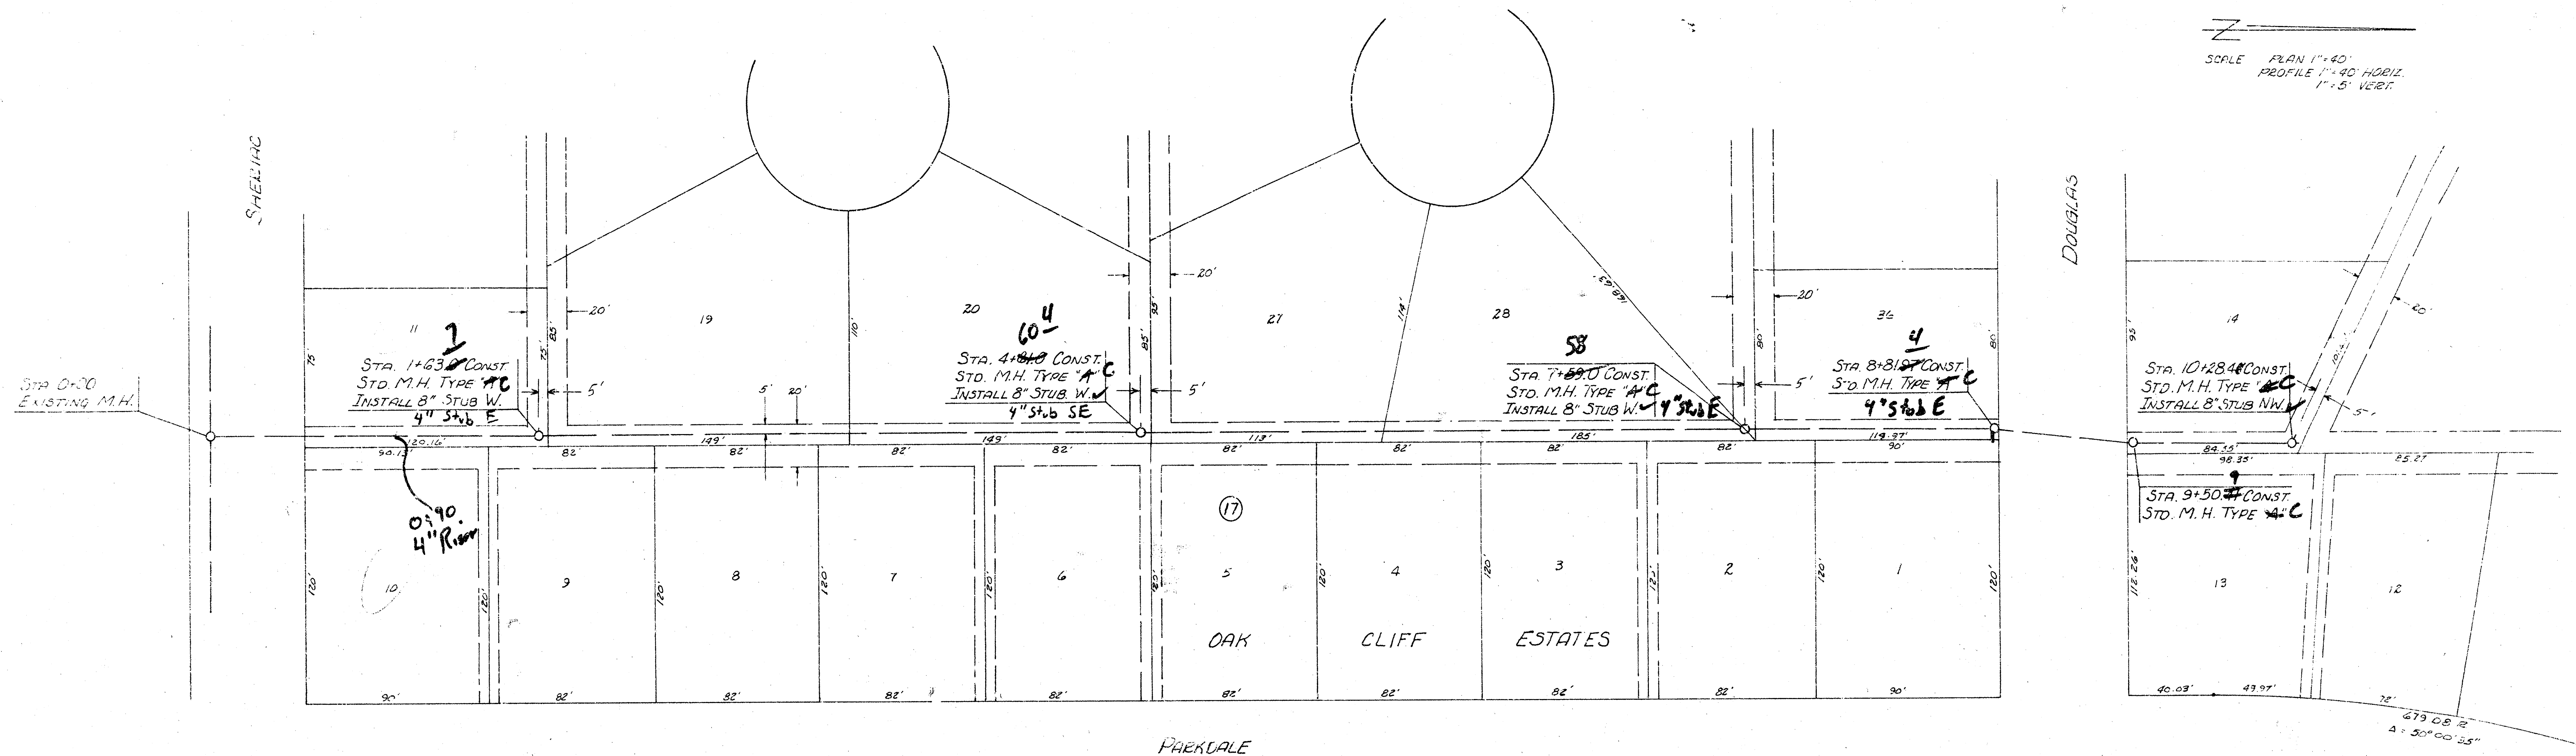


As Built
7/8/15

LAT. 5 MAIN 3, SOUTHWEST INTERCEPTOR
Proj. No. 463-76-245-80388-000-000-001


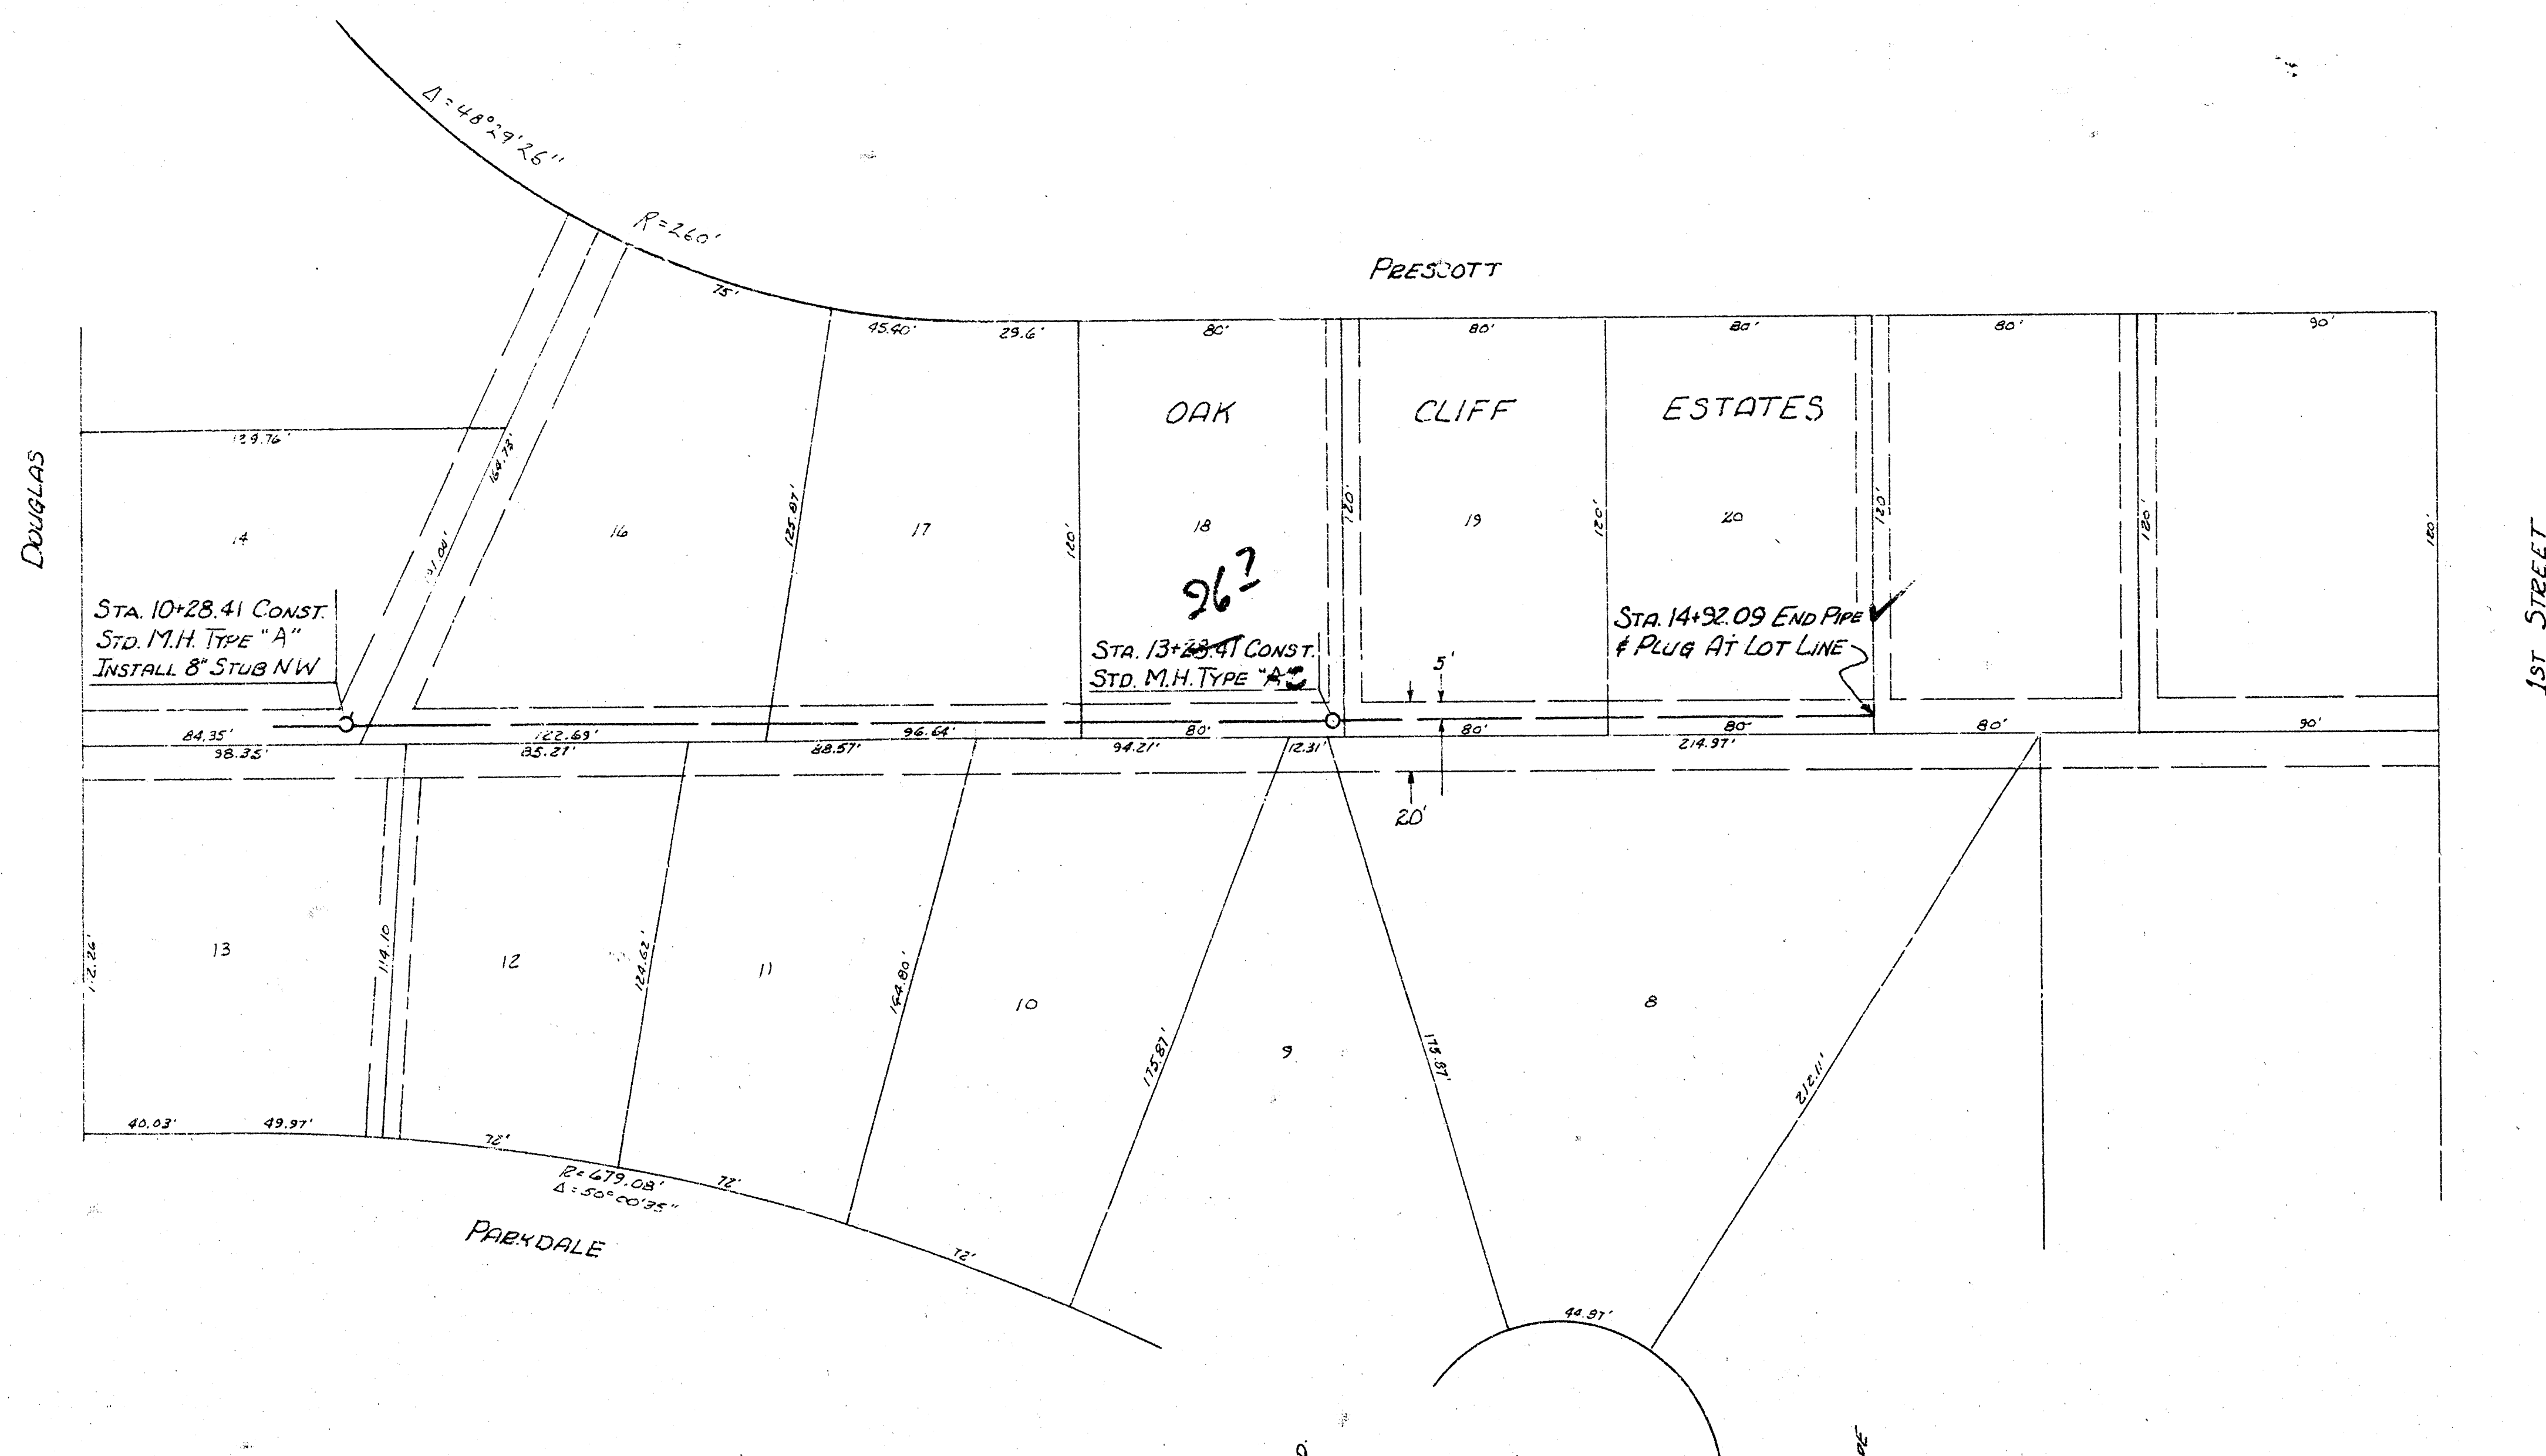


SCALE: PLAN 1"=40'
 PROFILE 1"=40' HORIZ.
 1"=5' VERT.

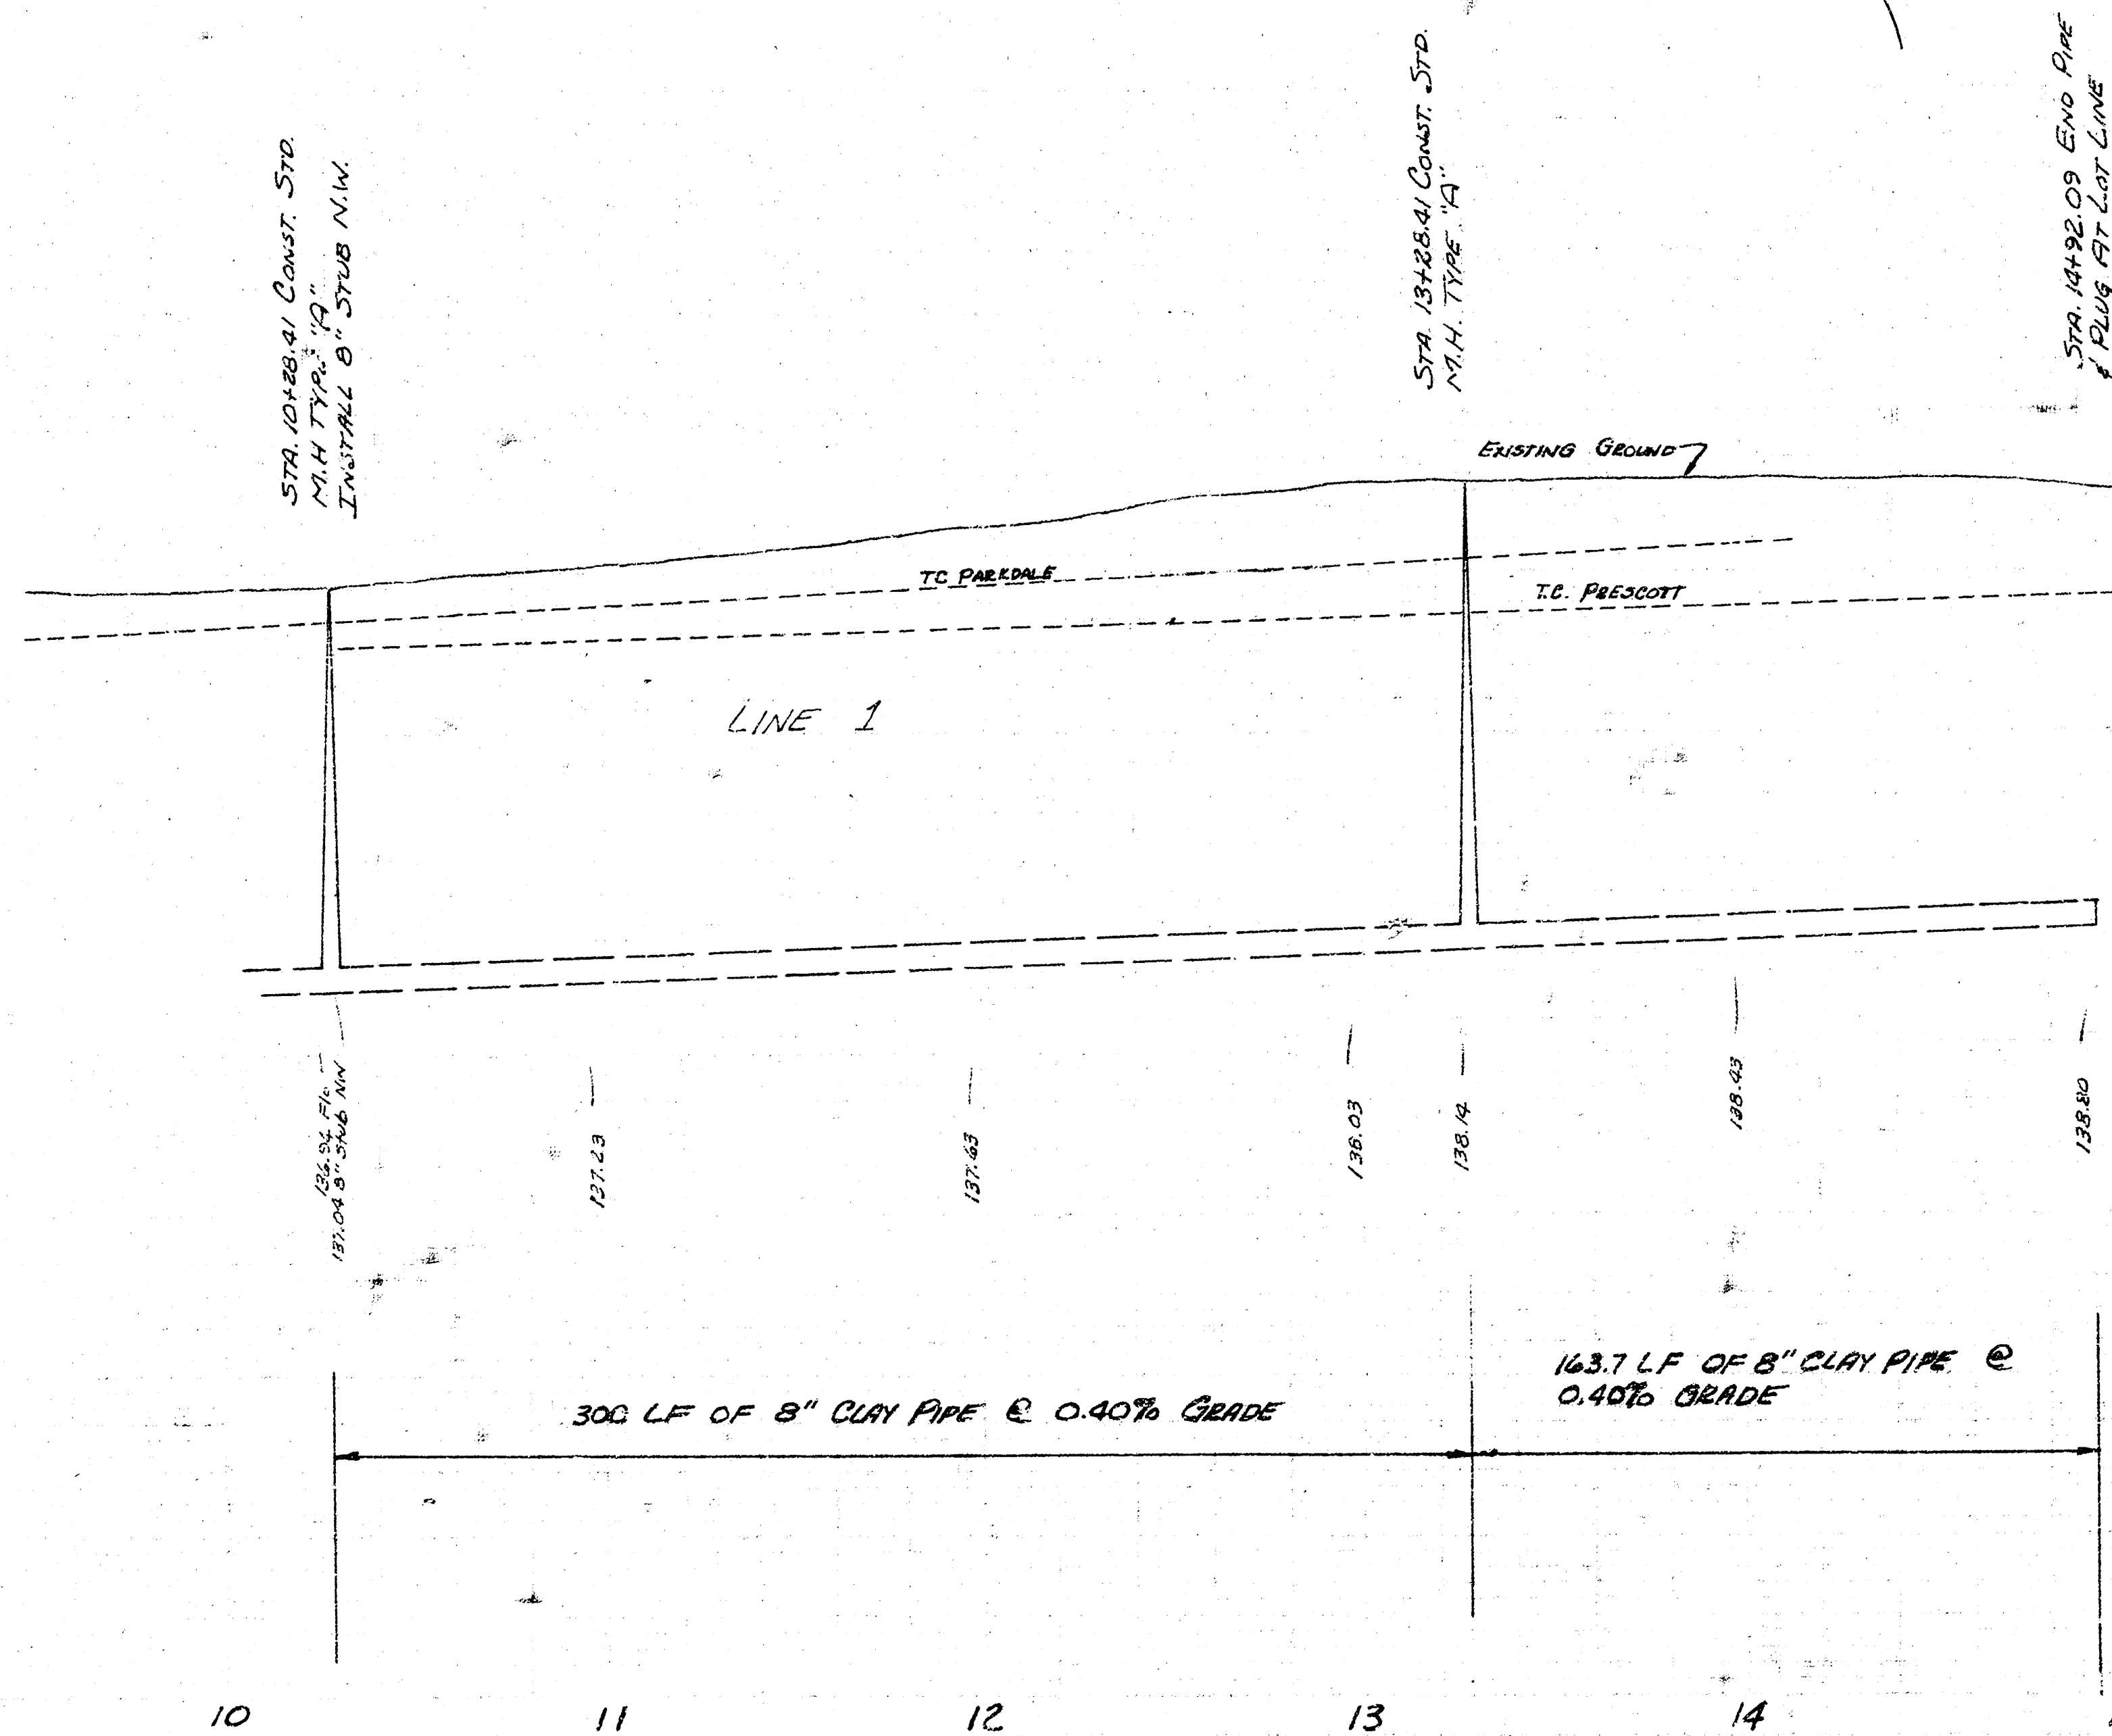

LAT 5 MAIN 9, SOUTHWEST INTERCEPTOR
 PROJ. NO. 468-76-245-80988-000-000-001


SCALE PLAN 1"=40'
 PROFILE 1"=40' HORIZ.
 1"=5' VERT.

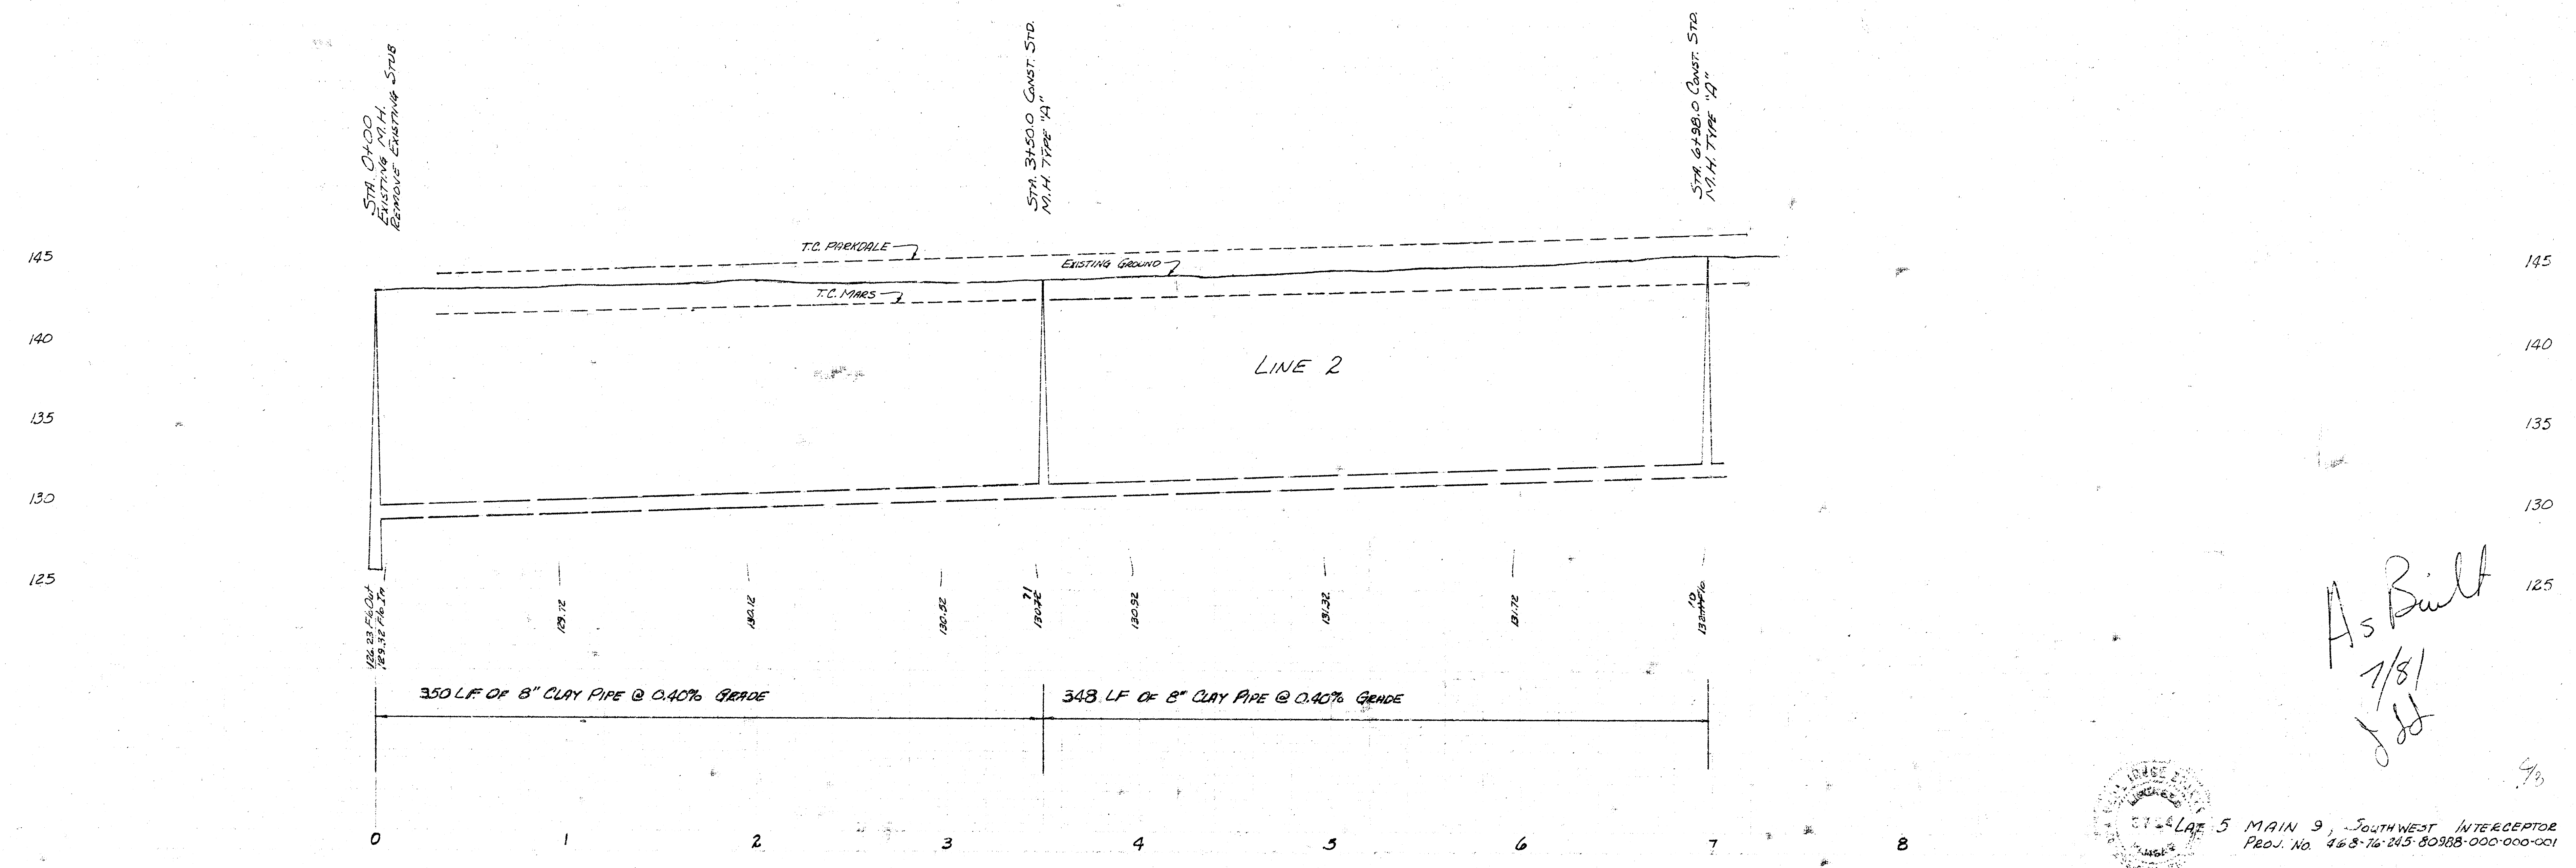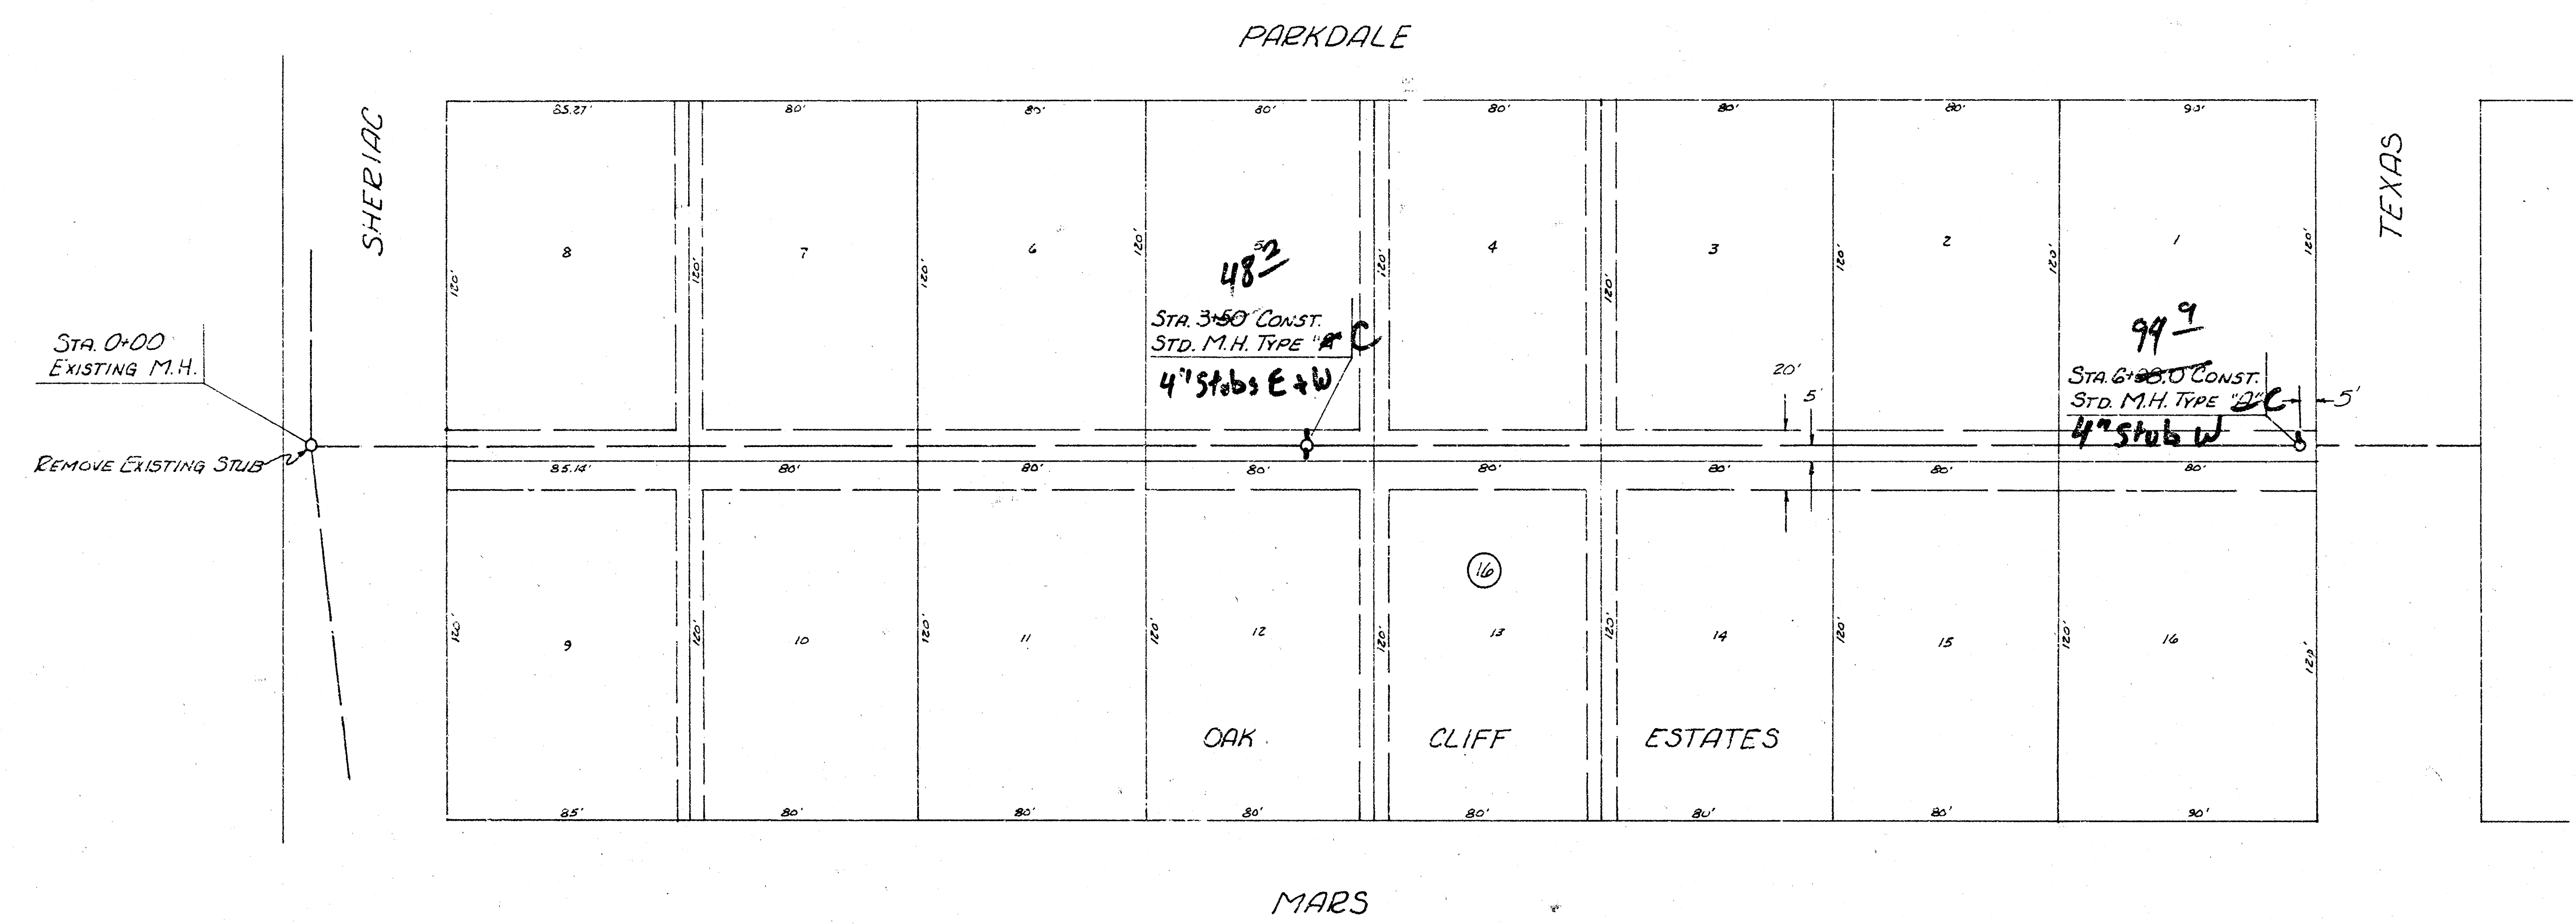


As Built
 7/8/1
 JH



LA 5 MAIN 9, SOUTHWEST INTERCEPTOR
 PROJ. NO. 468-76-245-80988-000-000-001

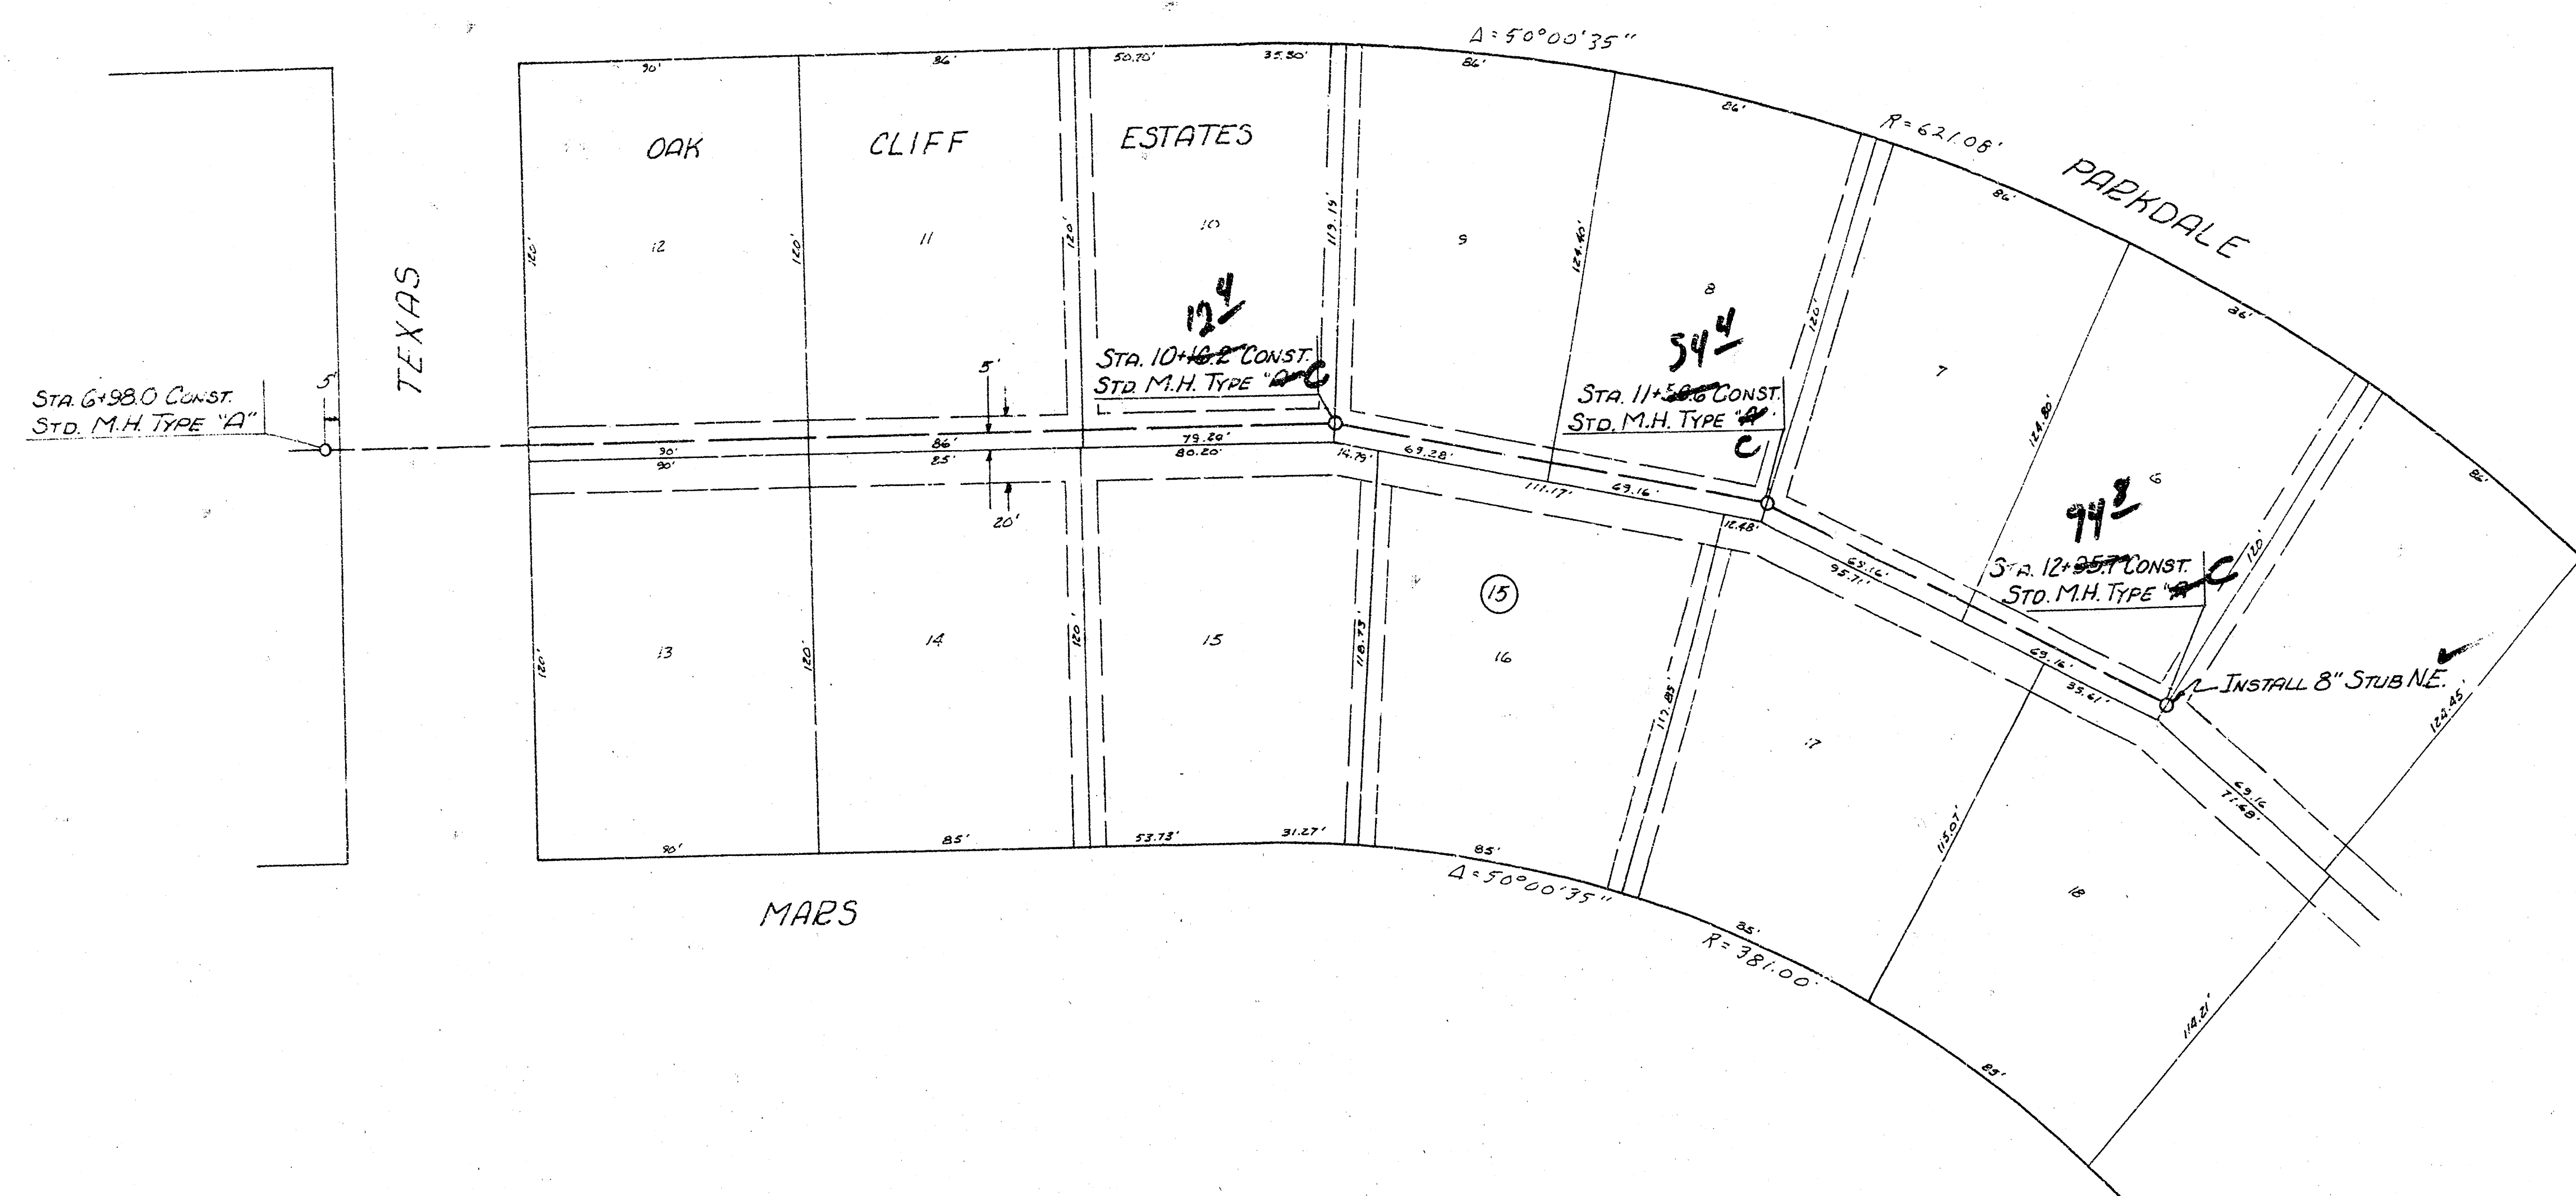



SCALE PLAN 1"=40'
 PROFILE 1"=40' HORIZ.
 1"=5' VERT.

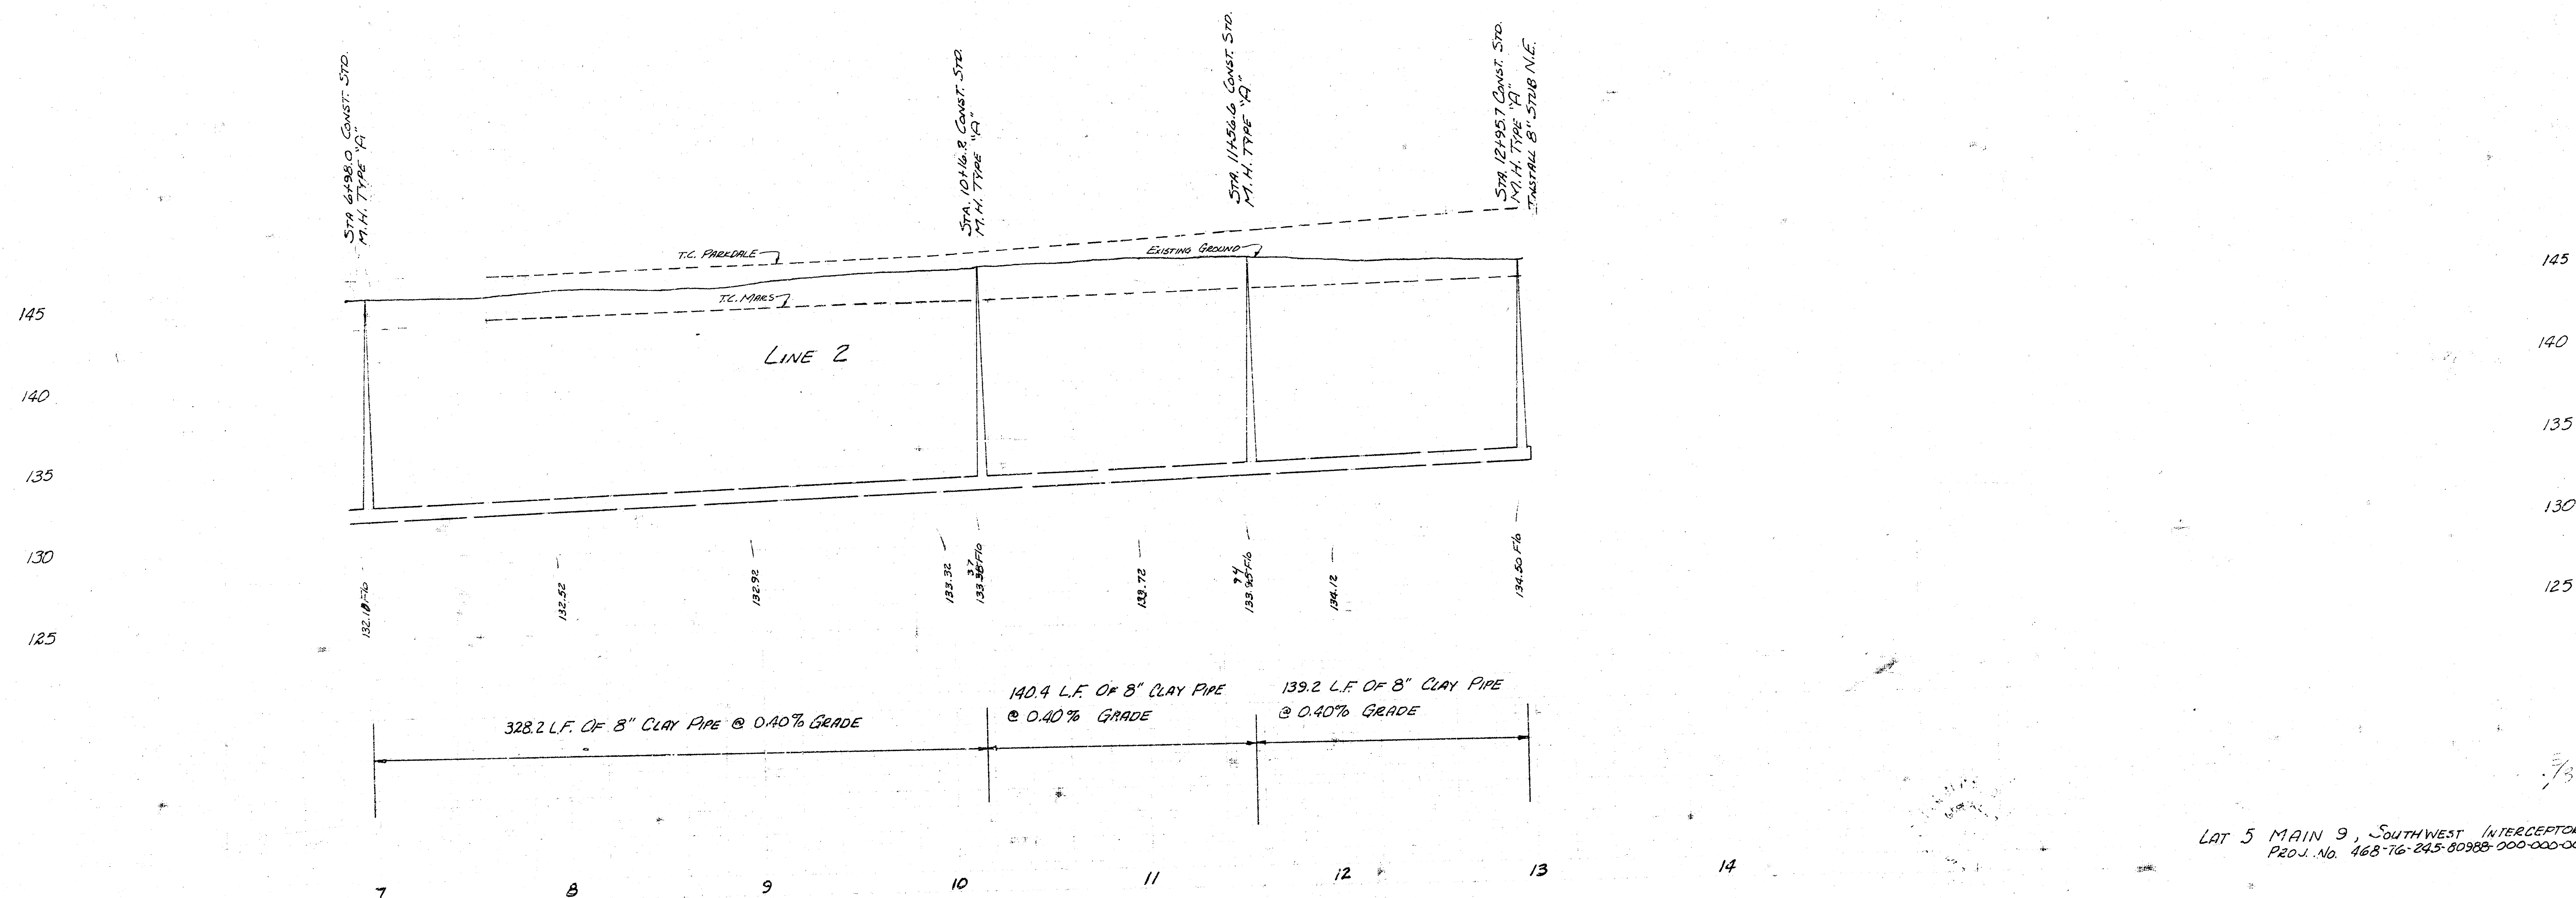

LAT 5 MAIN 9, SOUTHWEST INTERCEPTOR
 PROJ. No. 468-76-245-80988-000-000-001

FILMED FROM THE BEST


SCALE PLAN 1" = 40'
 PROFILE 1" = 40' HORIZ
 1" = 5' VERT.

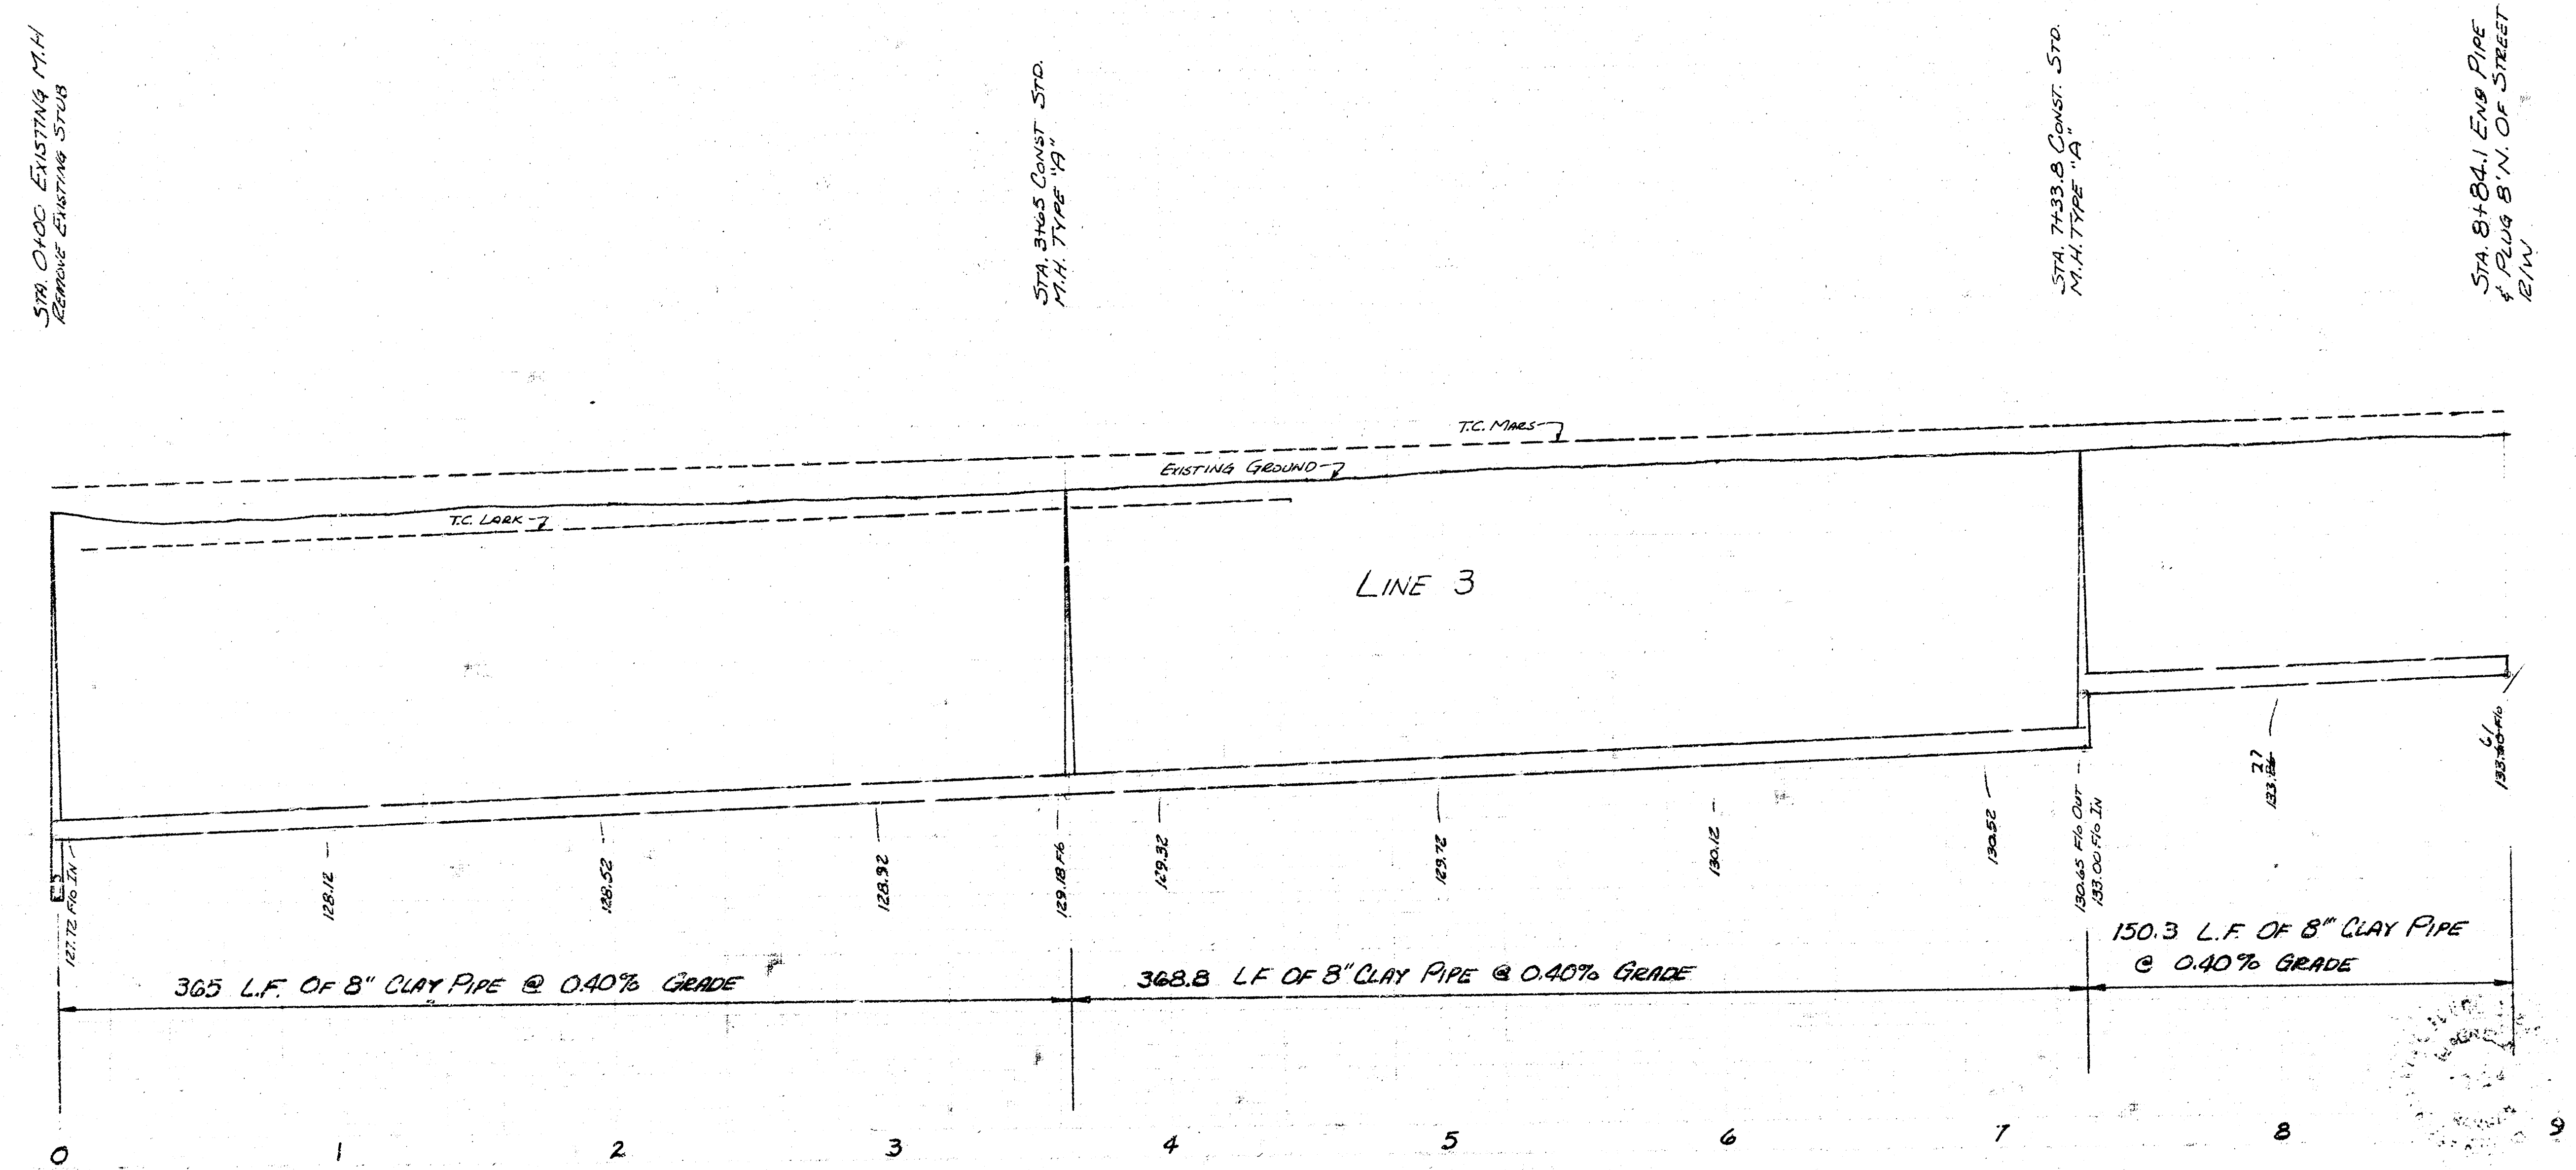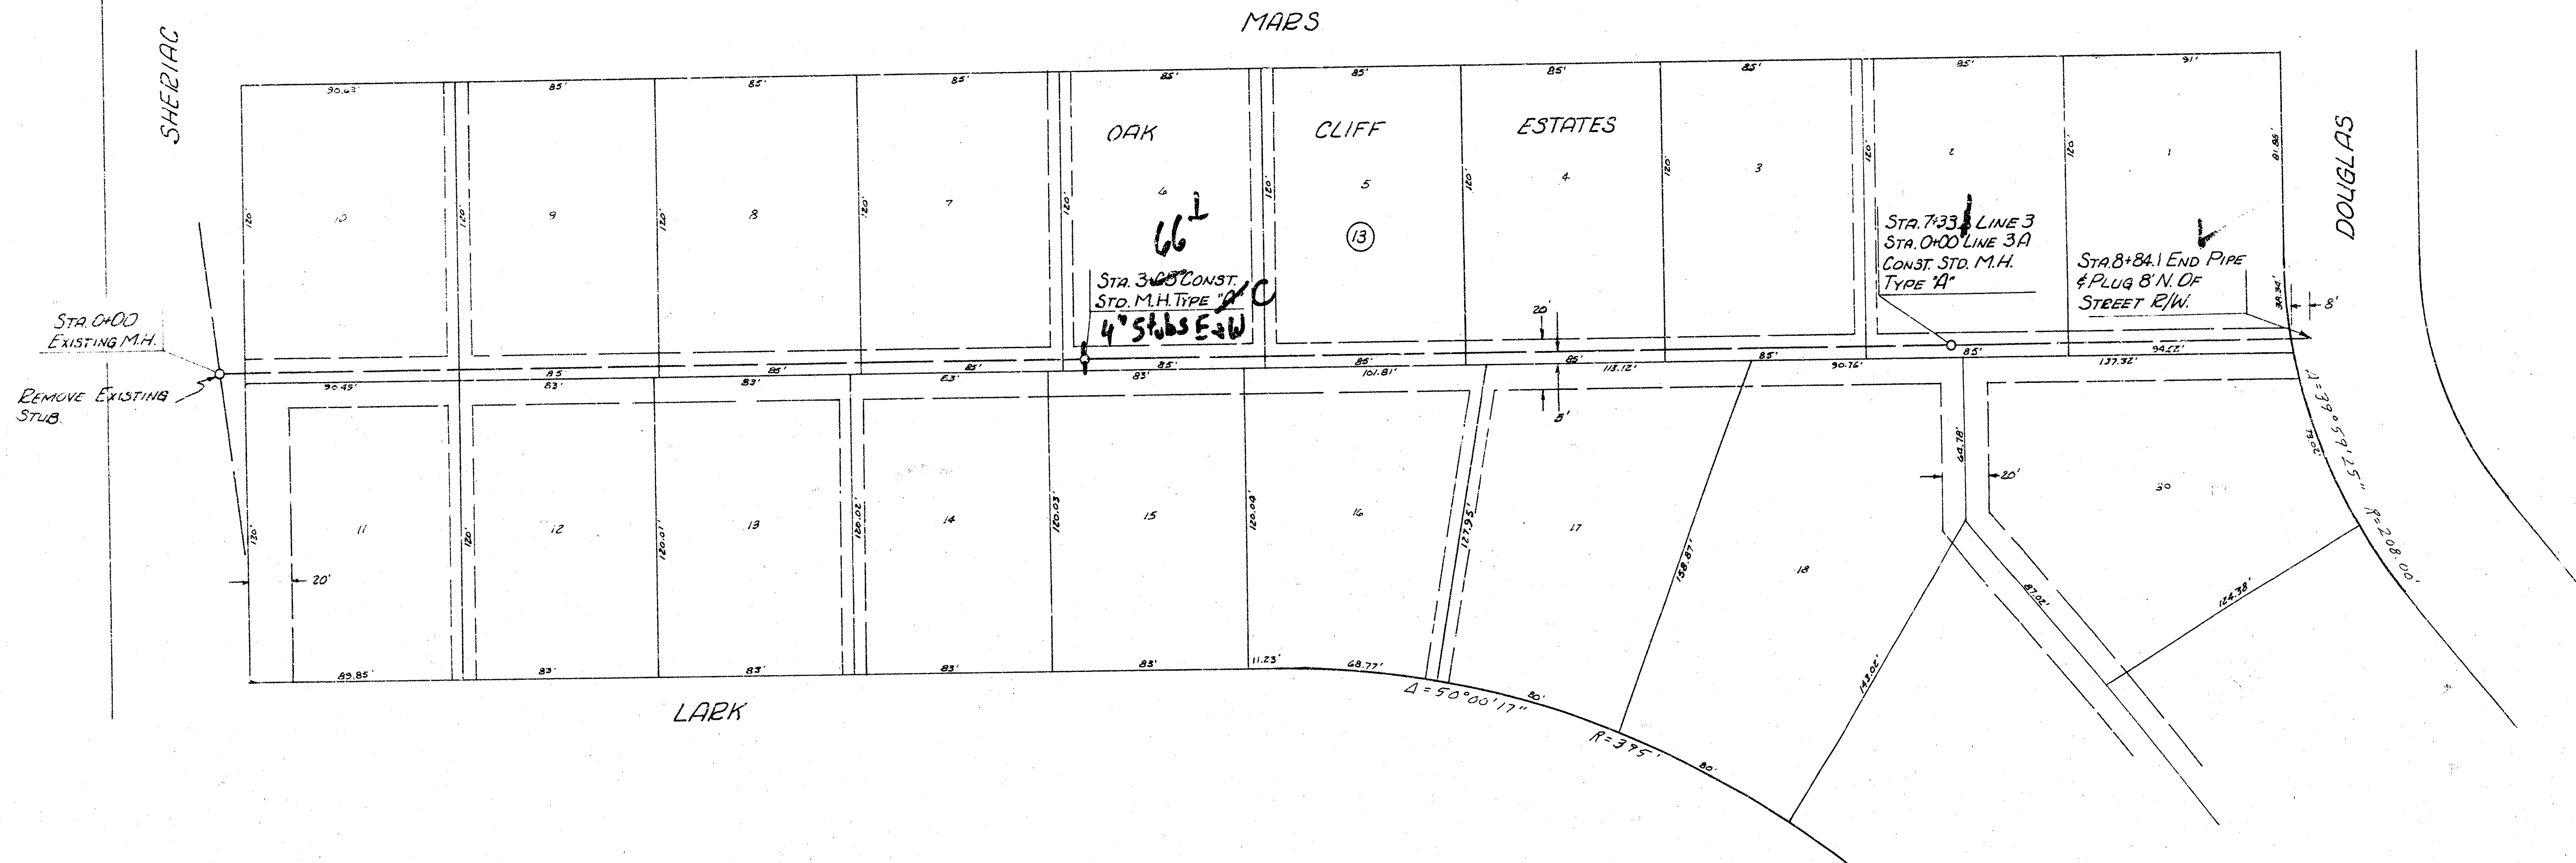

As Built
 7/8/1

LAT 5 MAIN 9, SOUTHWEST INTERCEPTOR
 PROJ. No. 468-76-245-80988-000-000-001


FILMED FROM THE BEST

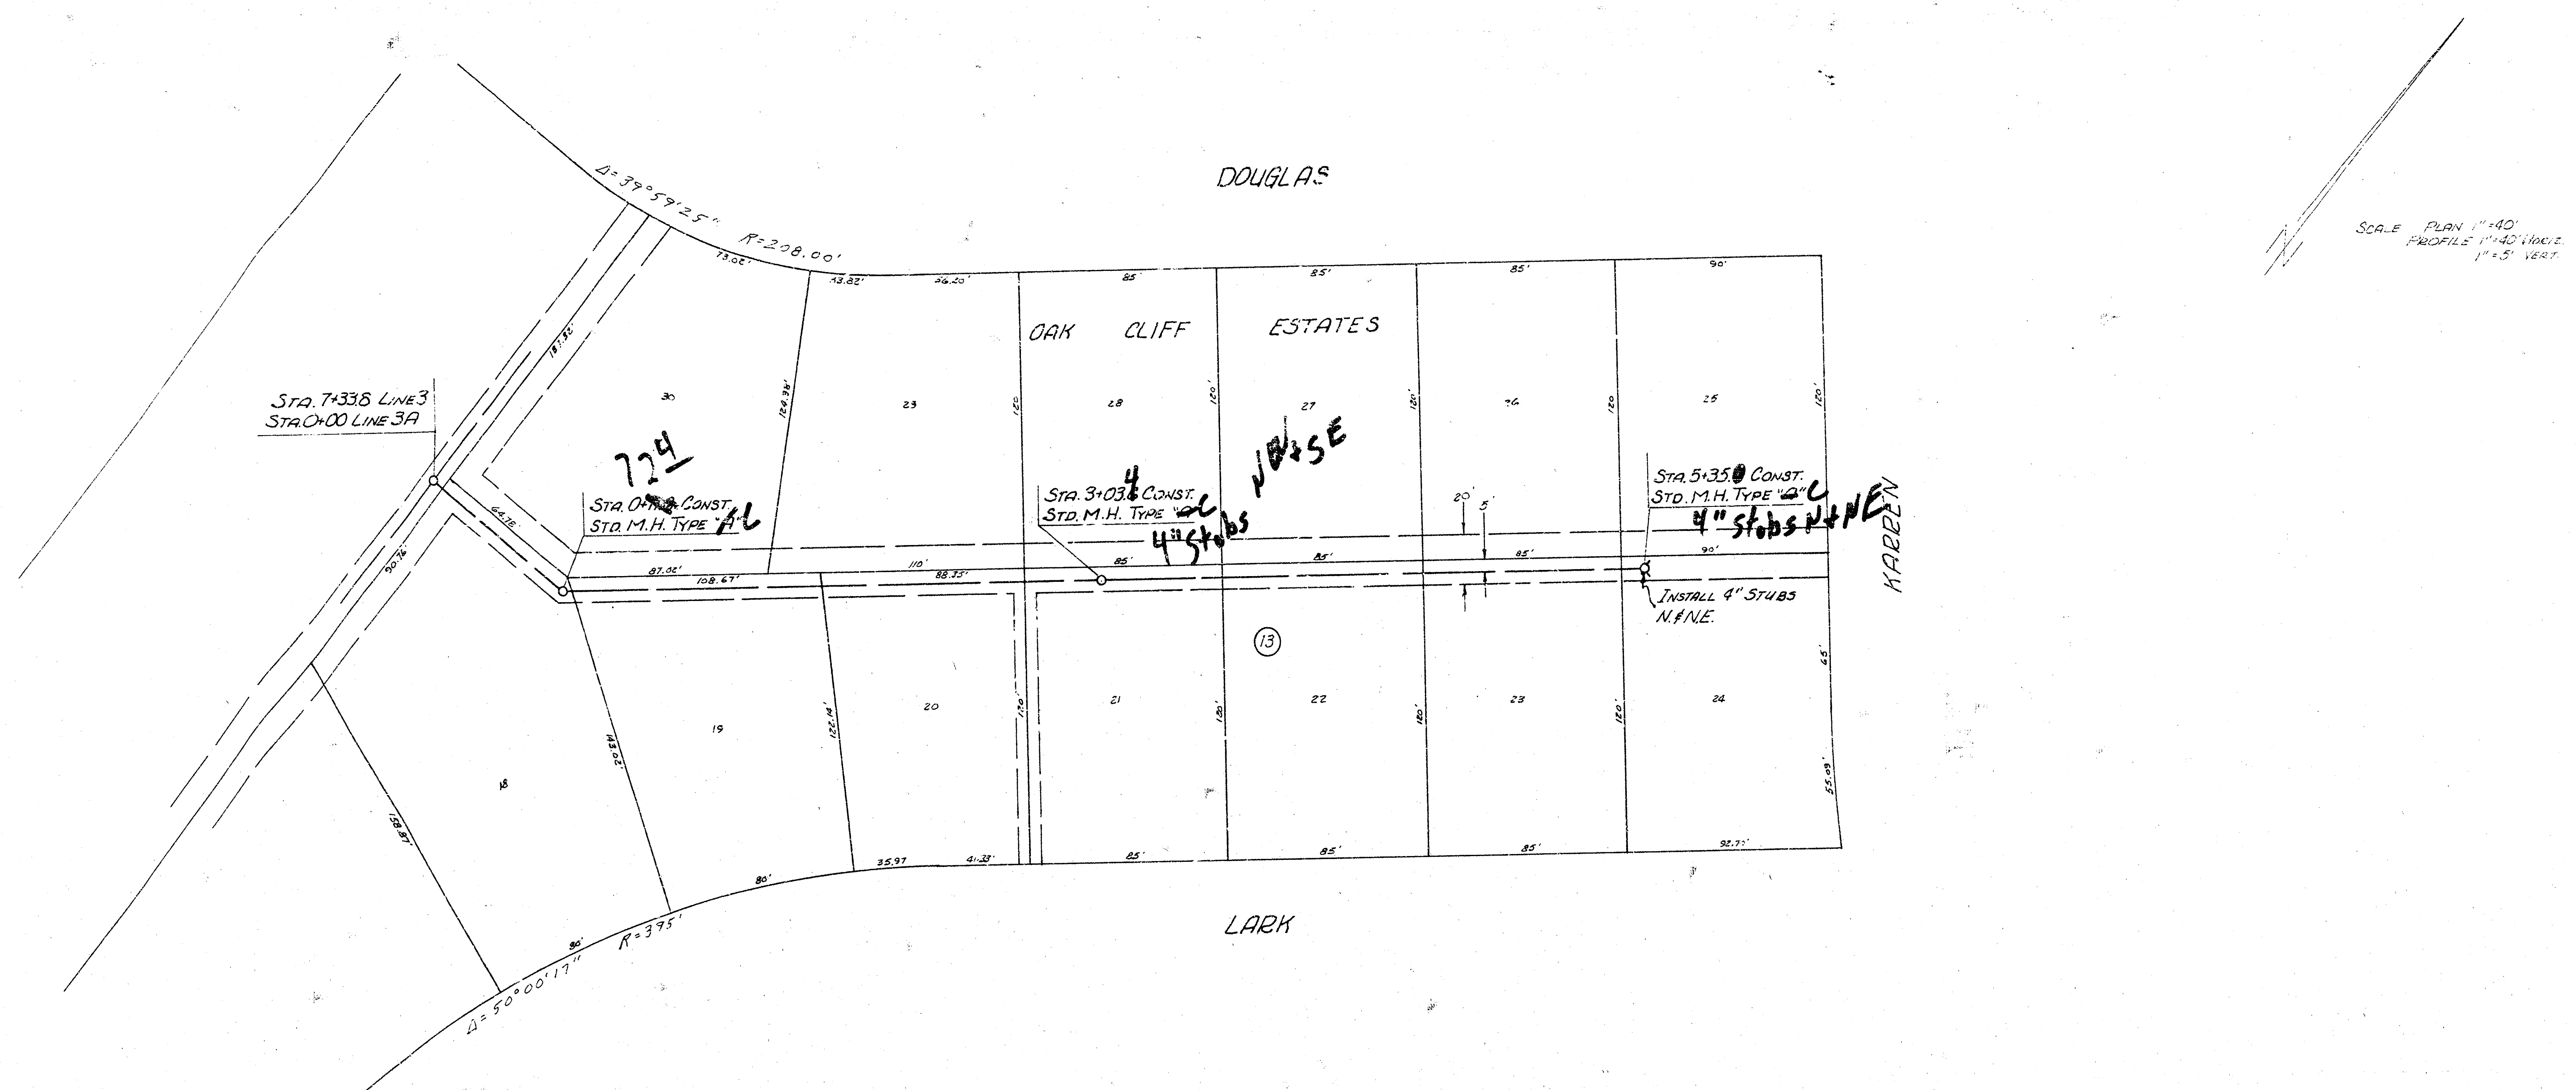

SCALE PLAN 1"=40'
 PROFILE 1"=40' VERT.
 1"=5' VERT.

150
 145
 140
 135
 130

150
 145
 140
 135
 130

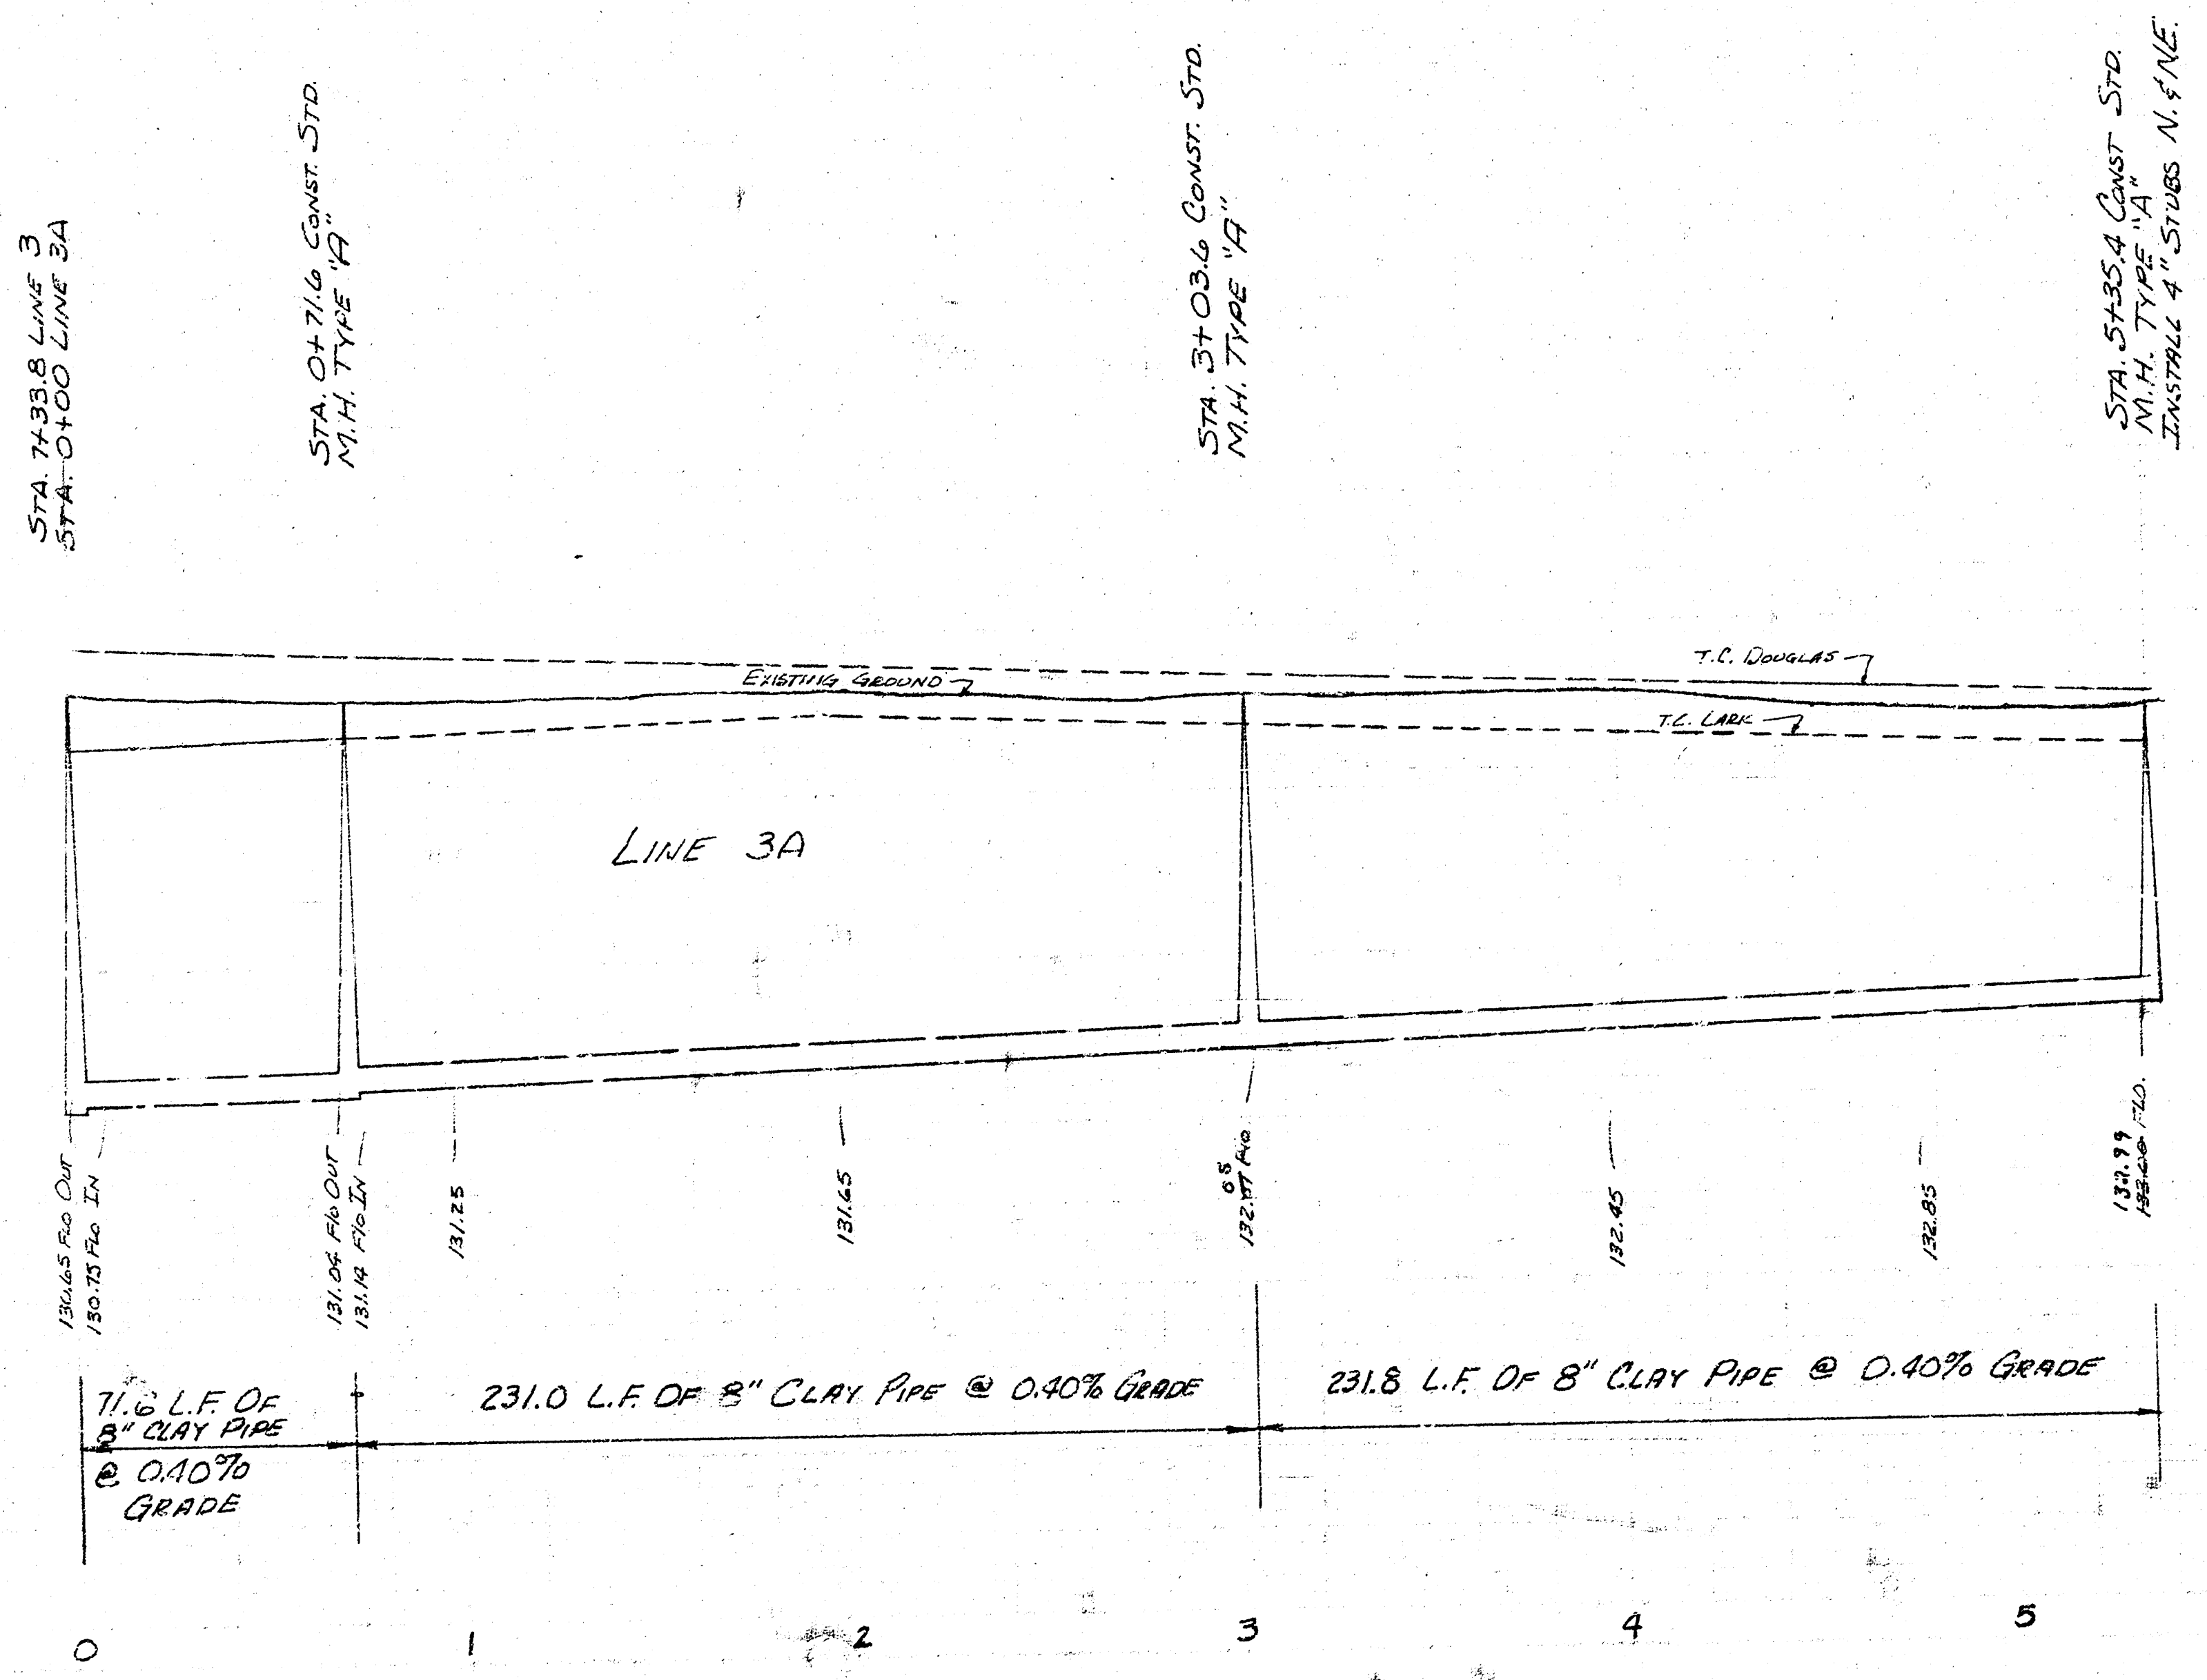

LAT 5 MAIN 9, SOUTHWEST INTERCEPTOR
 PROJ. NO. 468-76-245-80988-000-000-001

