

CAUTION
UNDERGROUND
UTILITIES

Please refer to the City of
Wichita Engineering Department
for location of existing utilities.

Sta 0+00 Existing MH
Begin Const. Connect to
8" Stub. Top MH Elev. = 130.67
Adjust to Proposed Elev.
of 131.53

Sta 4+63.5 Const Std
MH, Type C
Prop. Top MH Elev. = 132.2



Sta 6+76.7 Const Std
MH, Type C
Install 8" Stub, 5'
Prop. Top MH Elev. = 132.0

Sta 2+66.2 Const Std.
MH, Type C
Prop. Top MH Elev. = 131.0

Bench Marks:
131.33 - RR Spk on West Face
Elm Tree @ NE Cor. of
Prairie Park 2nd Add'n.
130.63 - "d" @ Base of Chain Lk. fence
post E.L. Carwood and Carr
130.81 - "d" @ Base of Chain Lk. fence approx.
15 ft. South of N.L. Esthiner and
E.L. Carwood
Elev. 130.67 - N. Rim S.S. MH. Located 7.15 ft. West
and 5.1 ft. South of NE. Cor. Lot 39, Blk 5,
Prairie Park 2nd Add'n.

SCALE: 1" = 40' Plan
Horz. 1" = 40' Profile
Vert. 1" = 5'

THE CONTRACTOR SHALL BE RESPONSIBLE
FOR PRESERVING EXISTING UTILITIES.
CONTRACTOR SHALL BE RESPONSIBLE FOR
PROTECTING ALL EXISTING UTILITIES.
CONTRACTOR SHALL BE RESPONSIBLE FOR
PROTECTING ALL EXISTING UTILITIES.
CONTRACTOR SHALL BE RESPONSIBLE FOR
PROTECTING ALL EXISTING UTILITIES.

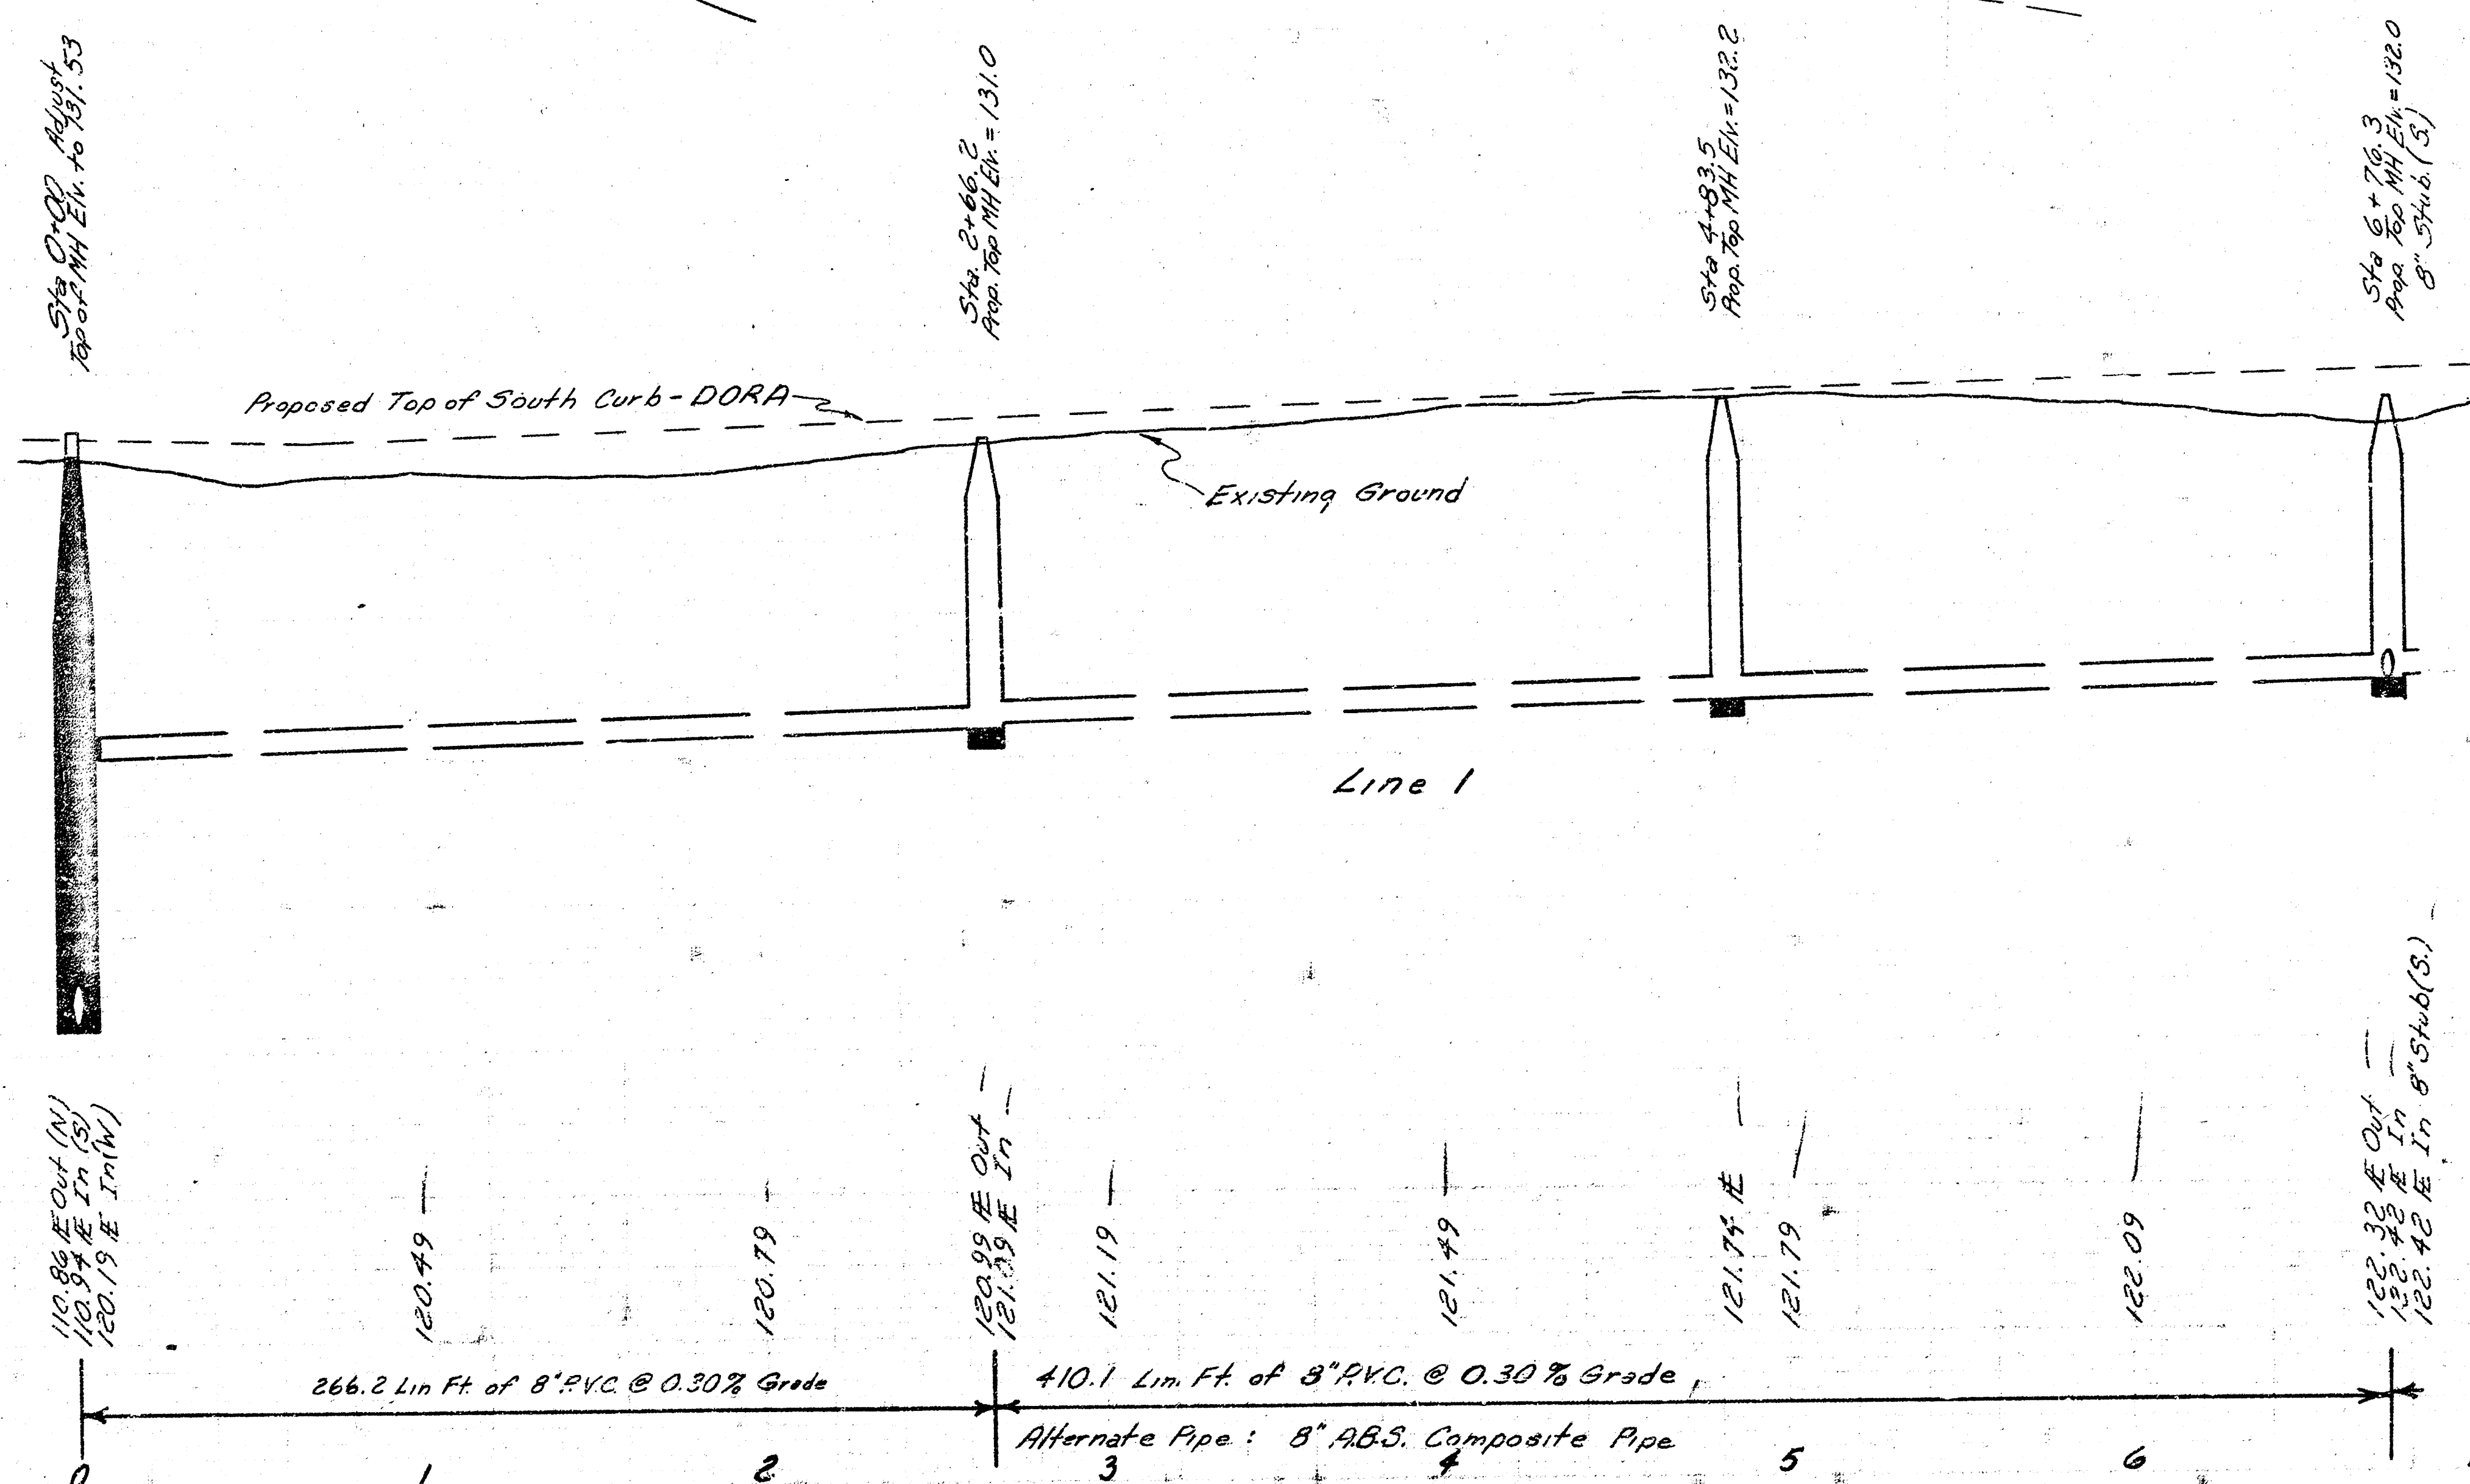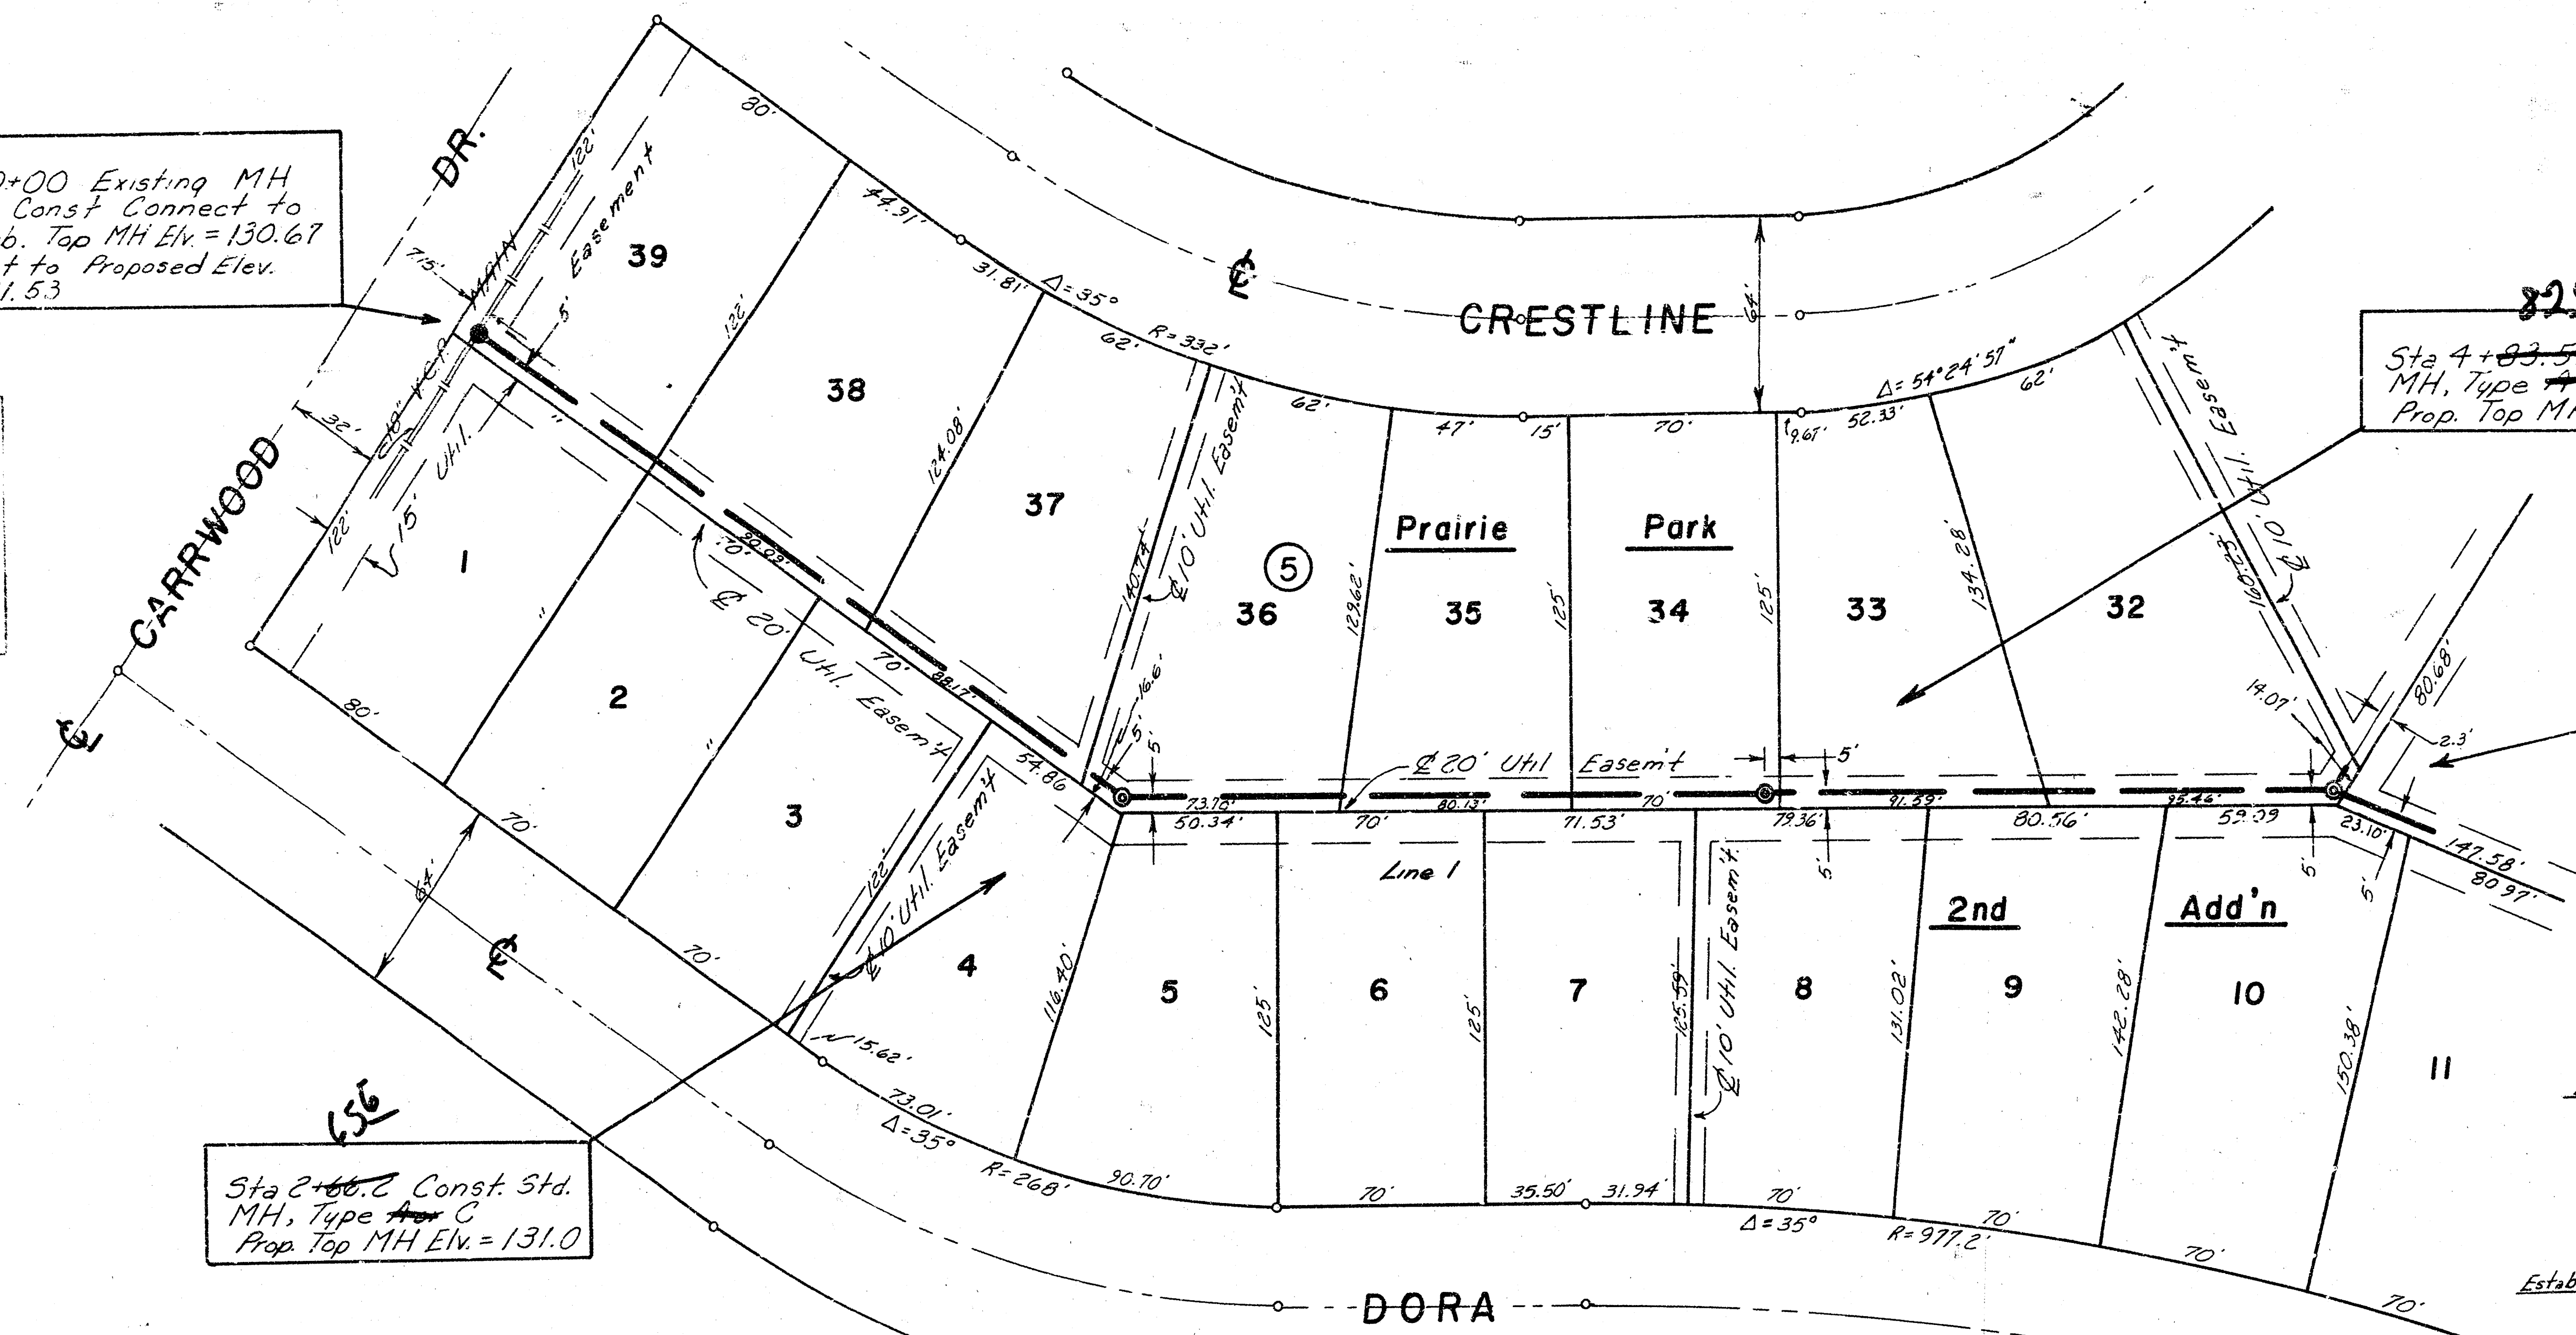

LATERAL 4, MAIN 11, S. W. I.
CITY OF WICHITA, KANSAS
R.W. BRUGGEMAN
DIRECTOR OF ENGINEERING/CITY ENGINEER
PROJ. NO. 468-76-245 81093-000-000-001

As Built
11/81

LAT. 4 , MAIN II , S.W.I.
PROJ. NO. 468-76-245-81093-000-000-001
Sheet 2 of 2

