



B. M. 134.94 R. R. Spike E. Side P. Pole
on S.W. cor. Madison & 26th St. N.


B. M. 137.07 R. R. Spike S. Side P. Pole
on S.E. cor. Madison & 27th St. N.

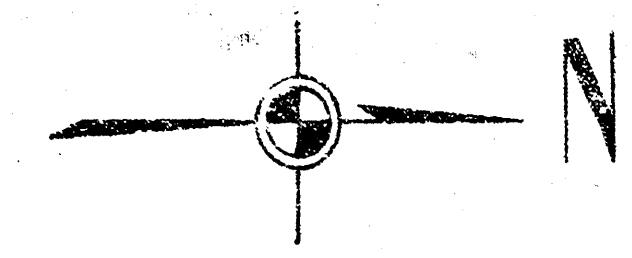

Plan Scale 1" = 40' Horiz.
Profile Scale 1" = 40' Vert.

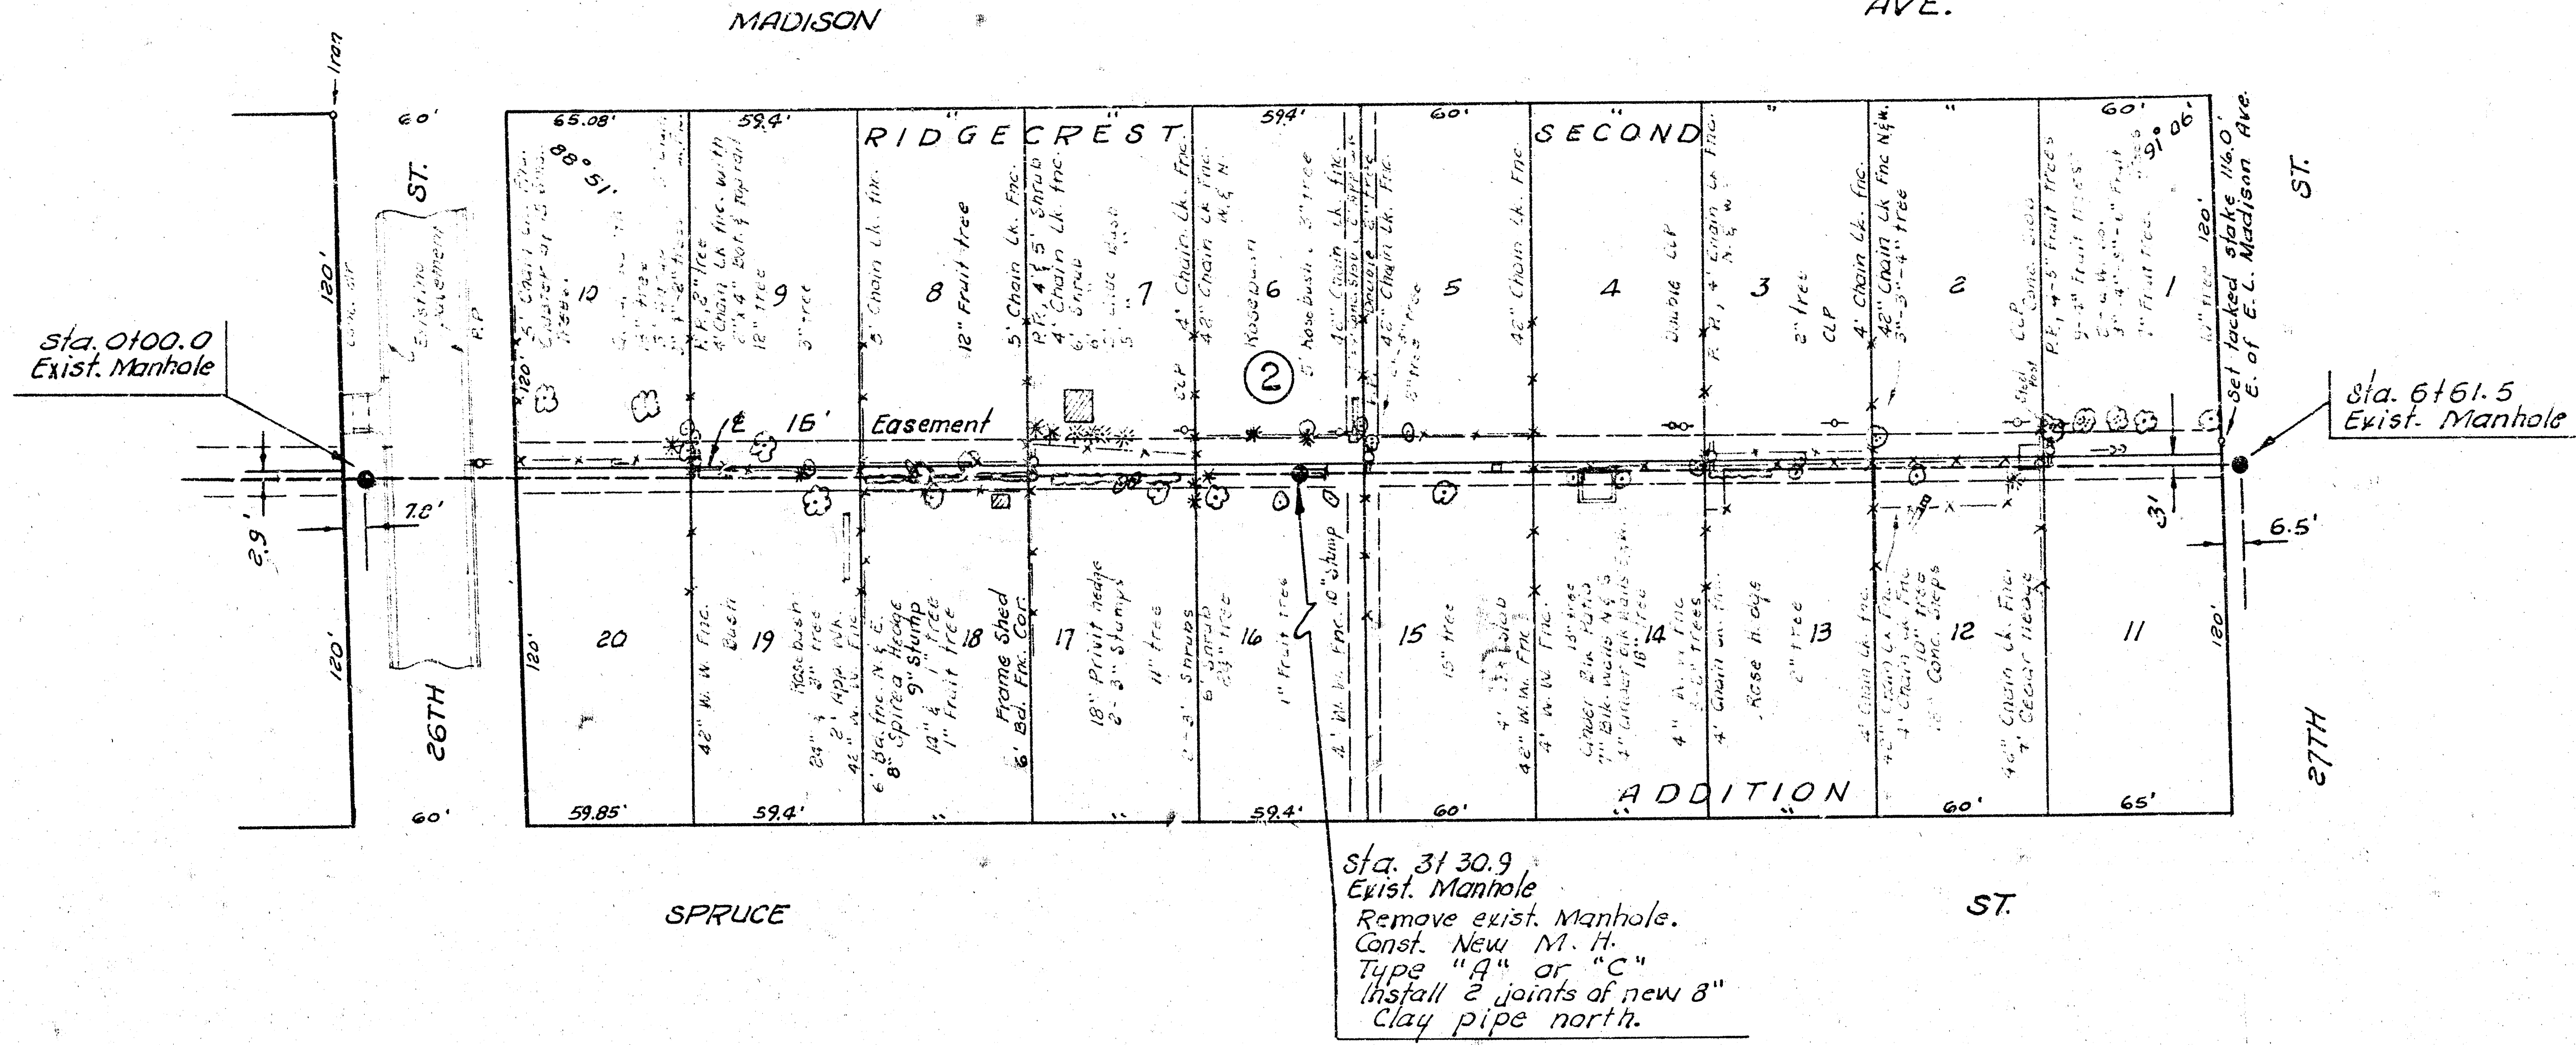

145
140
135
130
125
120

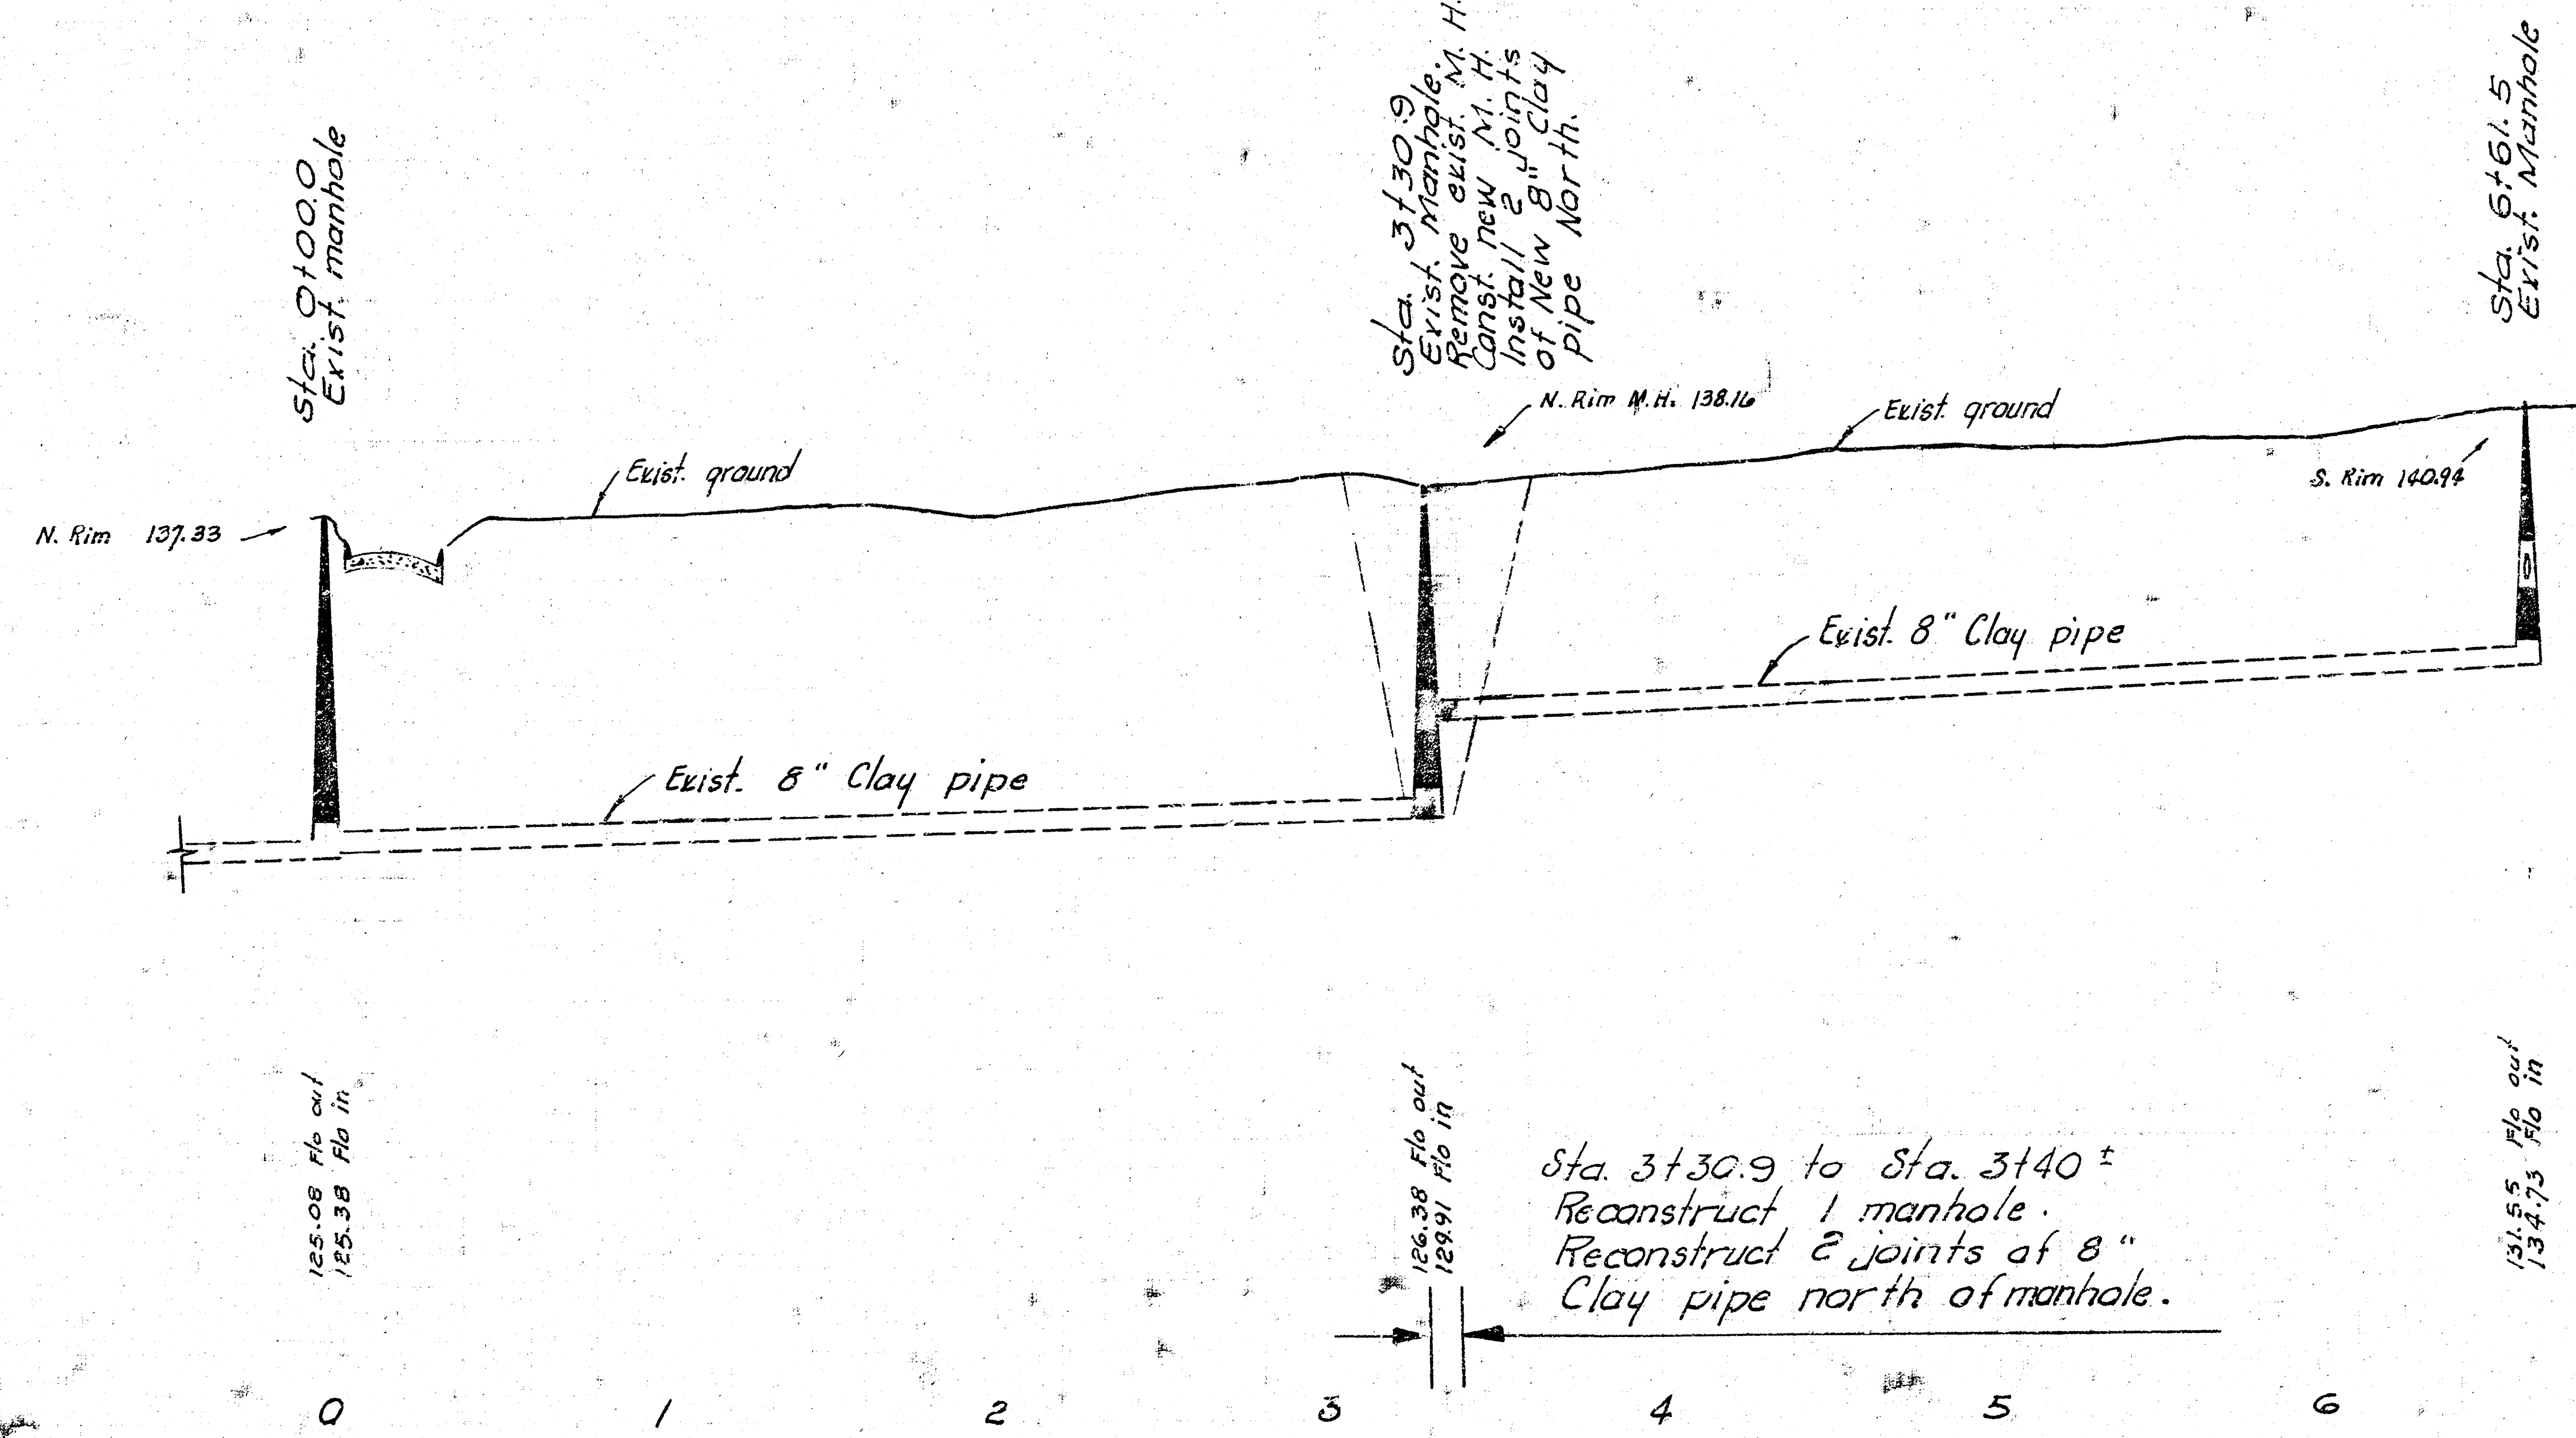

145
140
135
130
125
120

As Built 4-29-76

RECONSTRUCTION OF A PORTION OF
LAT. 31, DISTRICT T, S. S. NO. 12
IN 27TH ST. BETWEEN MADISON AVE. AND GROVE ST.
CITY OF WICHITA, KANSAS
R. W. LINN — CITY ENGINEER
DATE: PROJECT NO. DBKL575060



B. M. 155.56 R. R. Spike W. Side P. Pole
on N.E. cor. Grove & 27th St. N.

E. M. 141.65 City Std. Grove & 27th

B. M. 137.07 R. R. Spike S. Side P. Pole
on S.E. cor. Madison & 27th St. N.


NOTE:
Insertion trench
to be west of
Sta. 6+61.5.

Sta. 6+61.5
Exist. manhole.
Remove and reconstruct
that portion of manhole
extending above Flo elev.
of Inlet Pipe.

Removed & Replaced
Clay pipe 7+02 to 7+17


Sta. 8+75.8
Exist. manhole.
See manhole Detail.

Sta. 10+91.8
Exist. manhole.

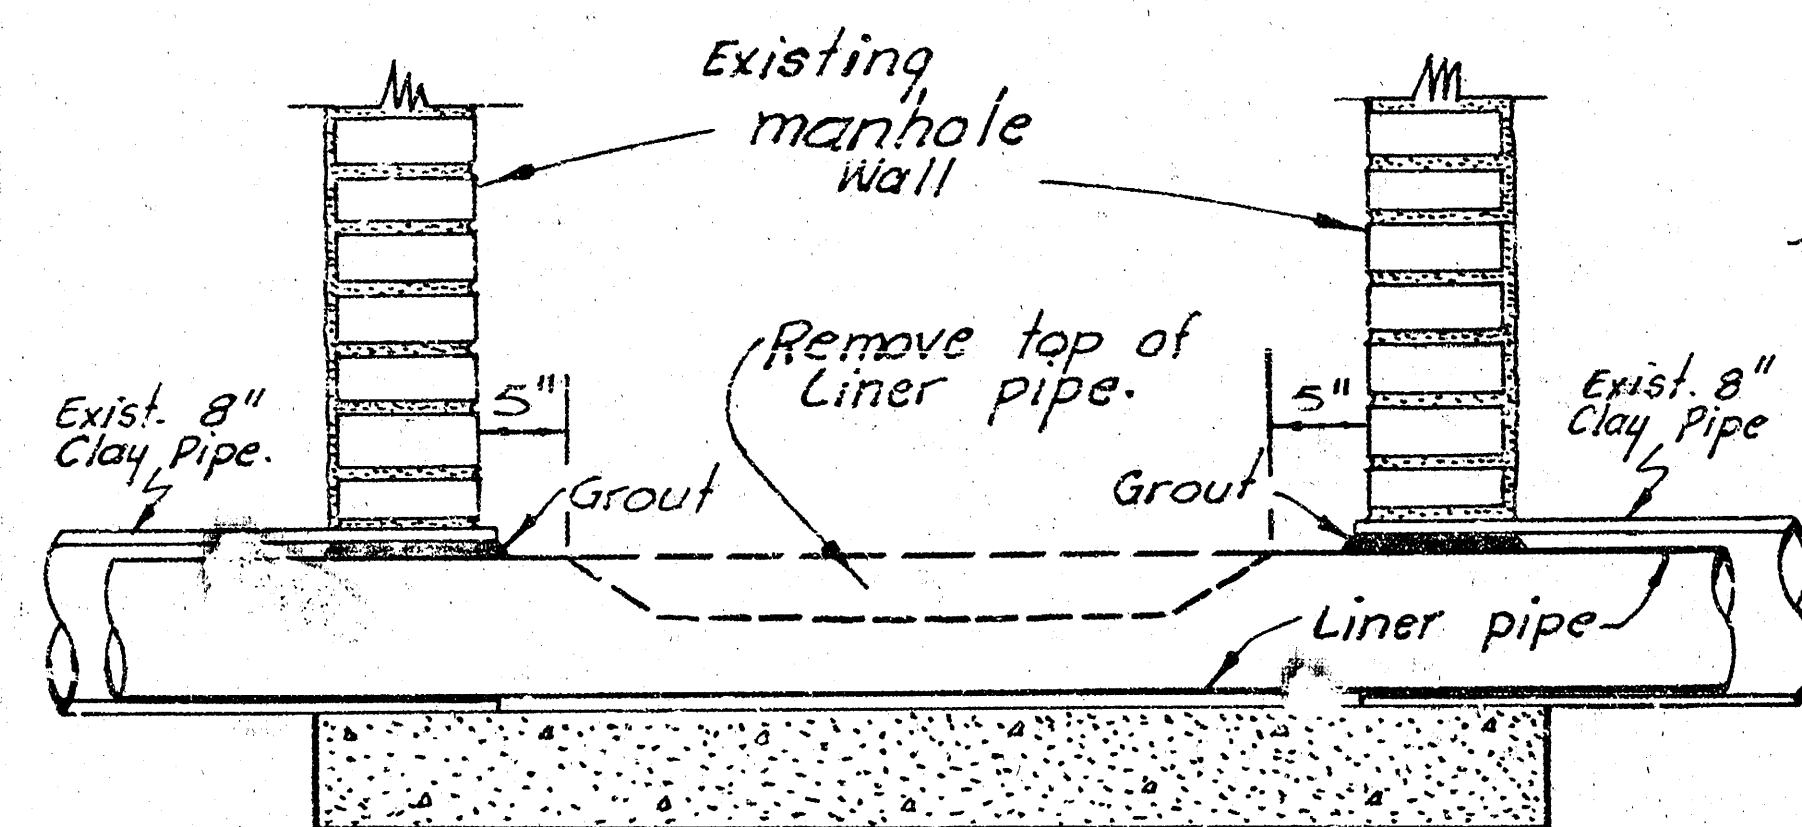



LINER PIPE TROUGH MANHOLE
DETAIL

Sta. 8+75.8

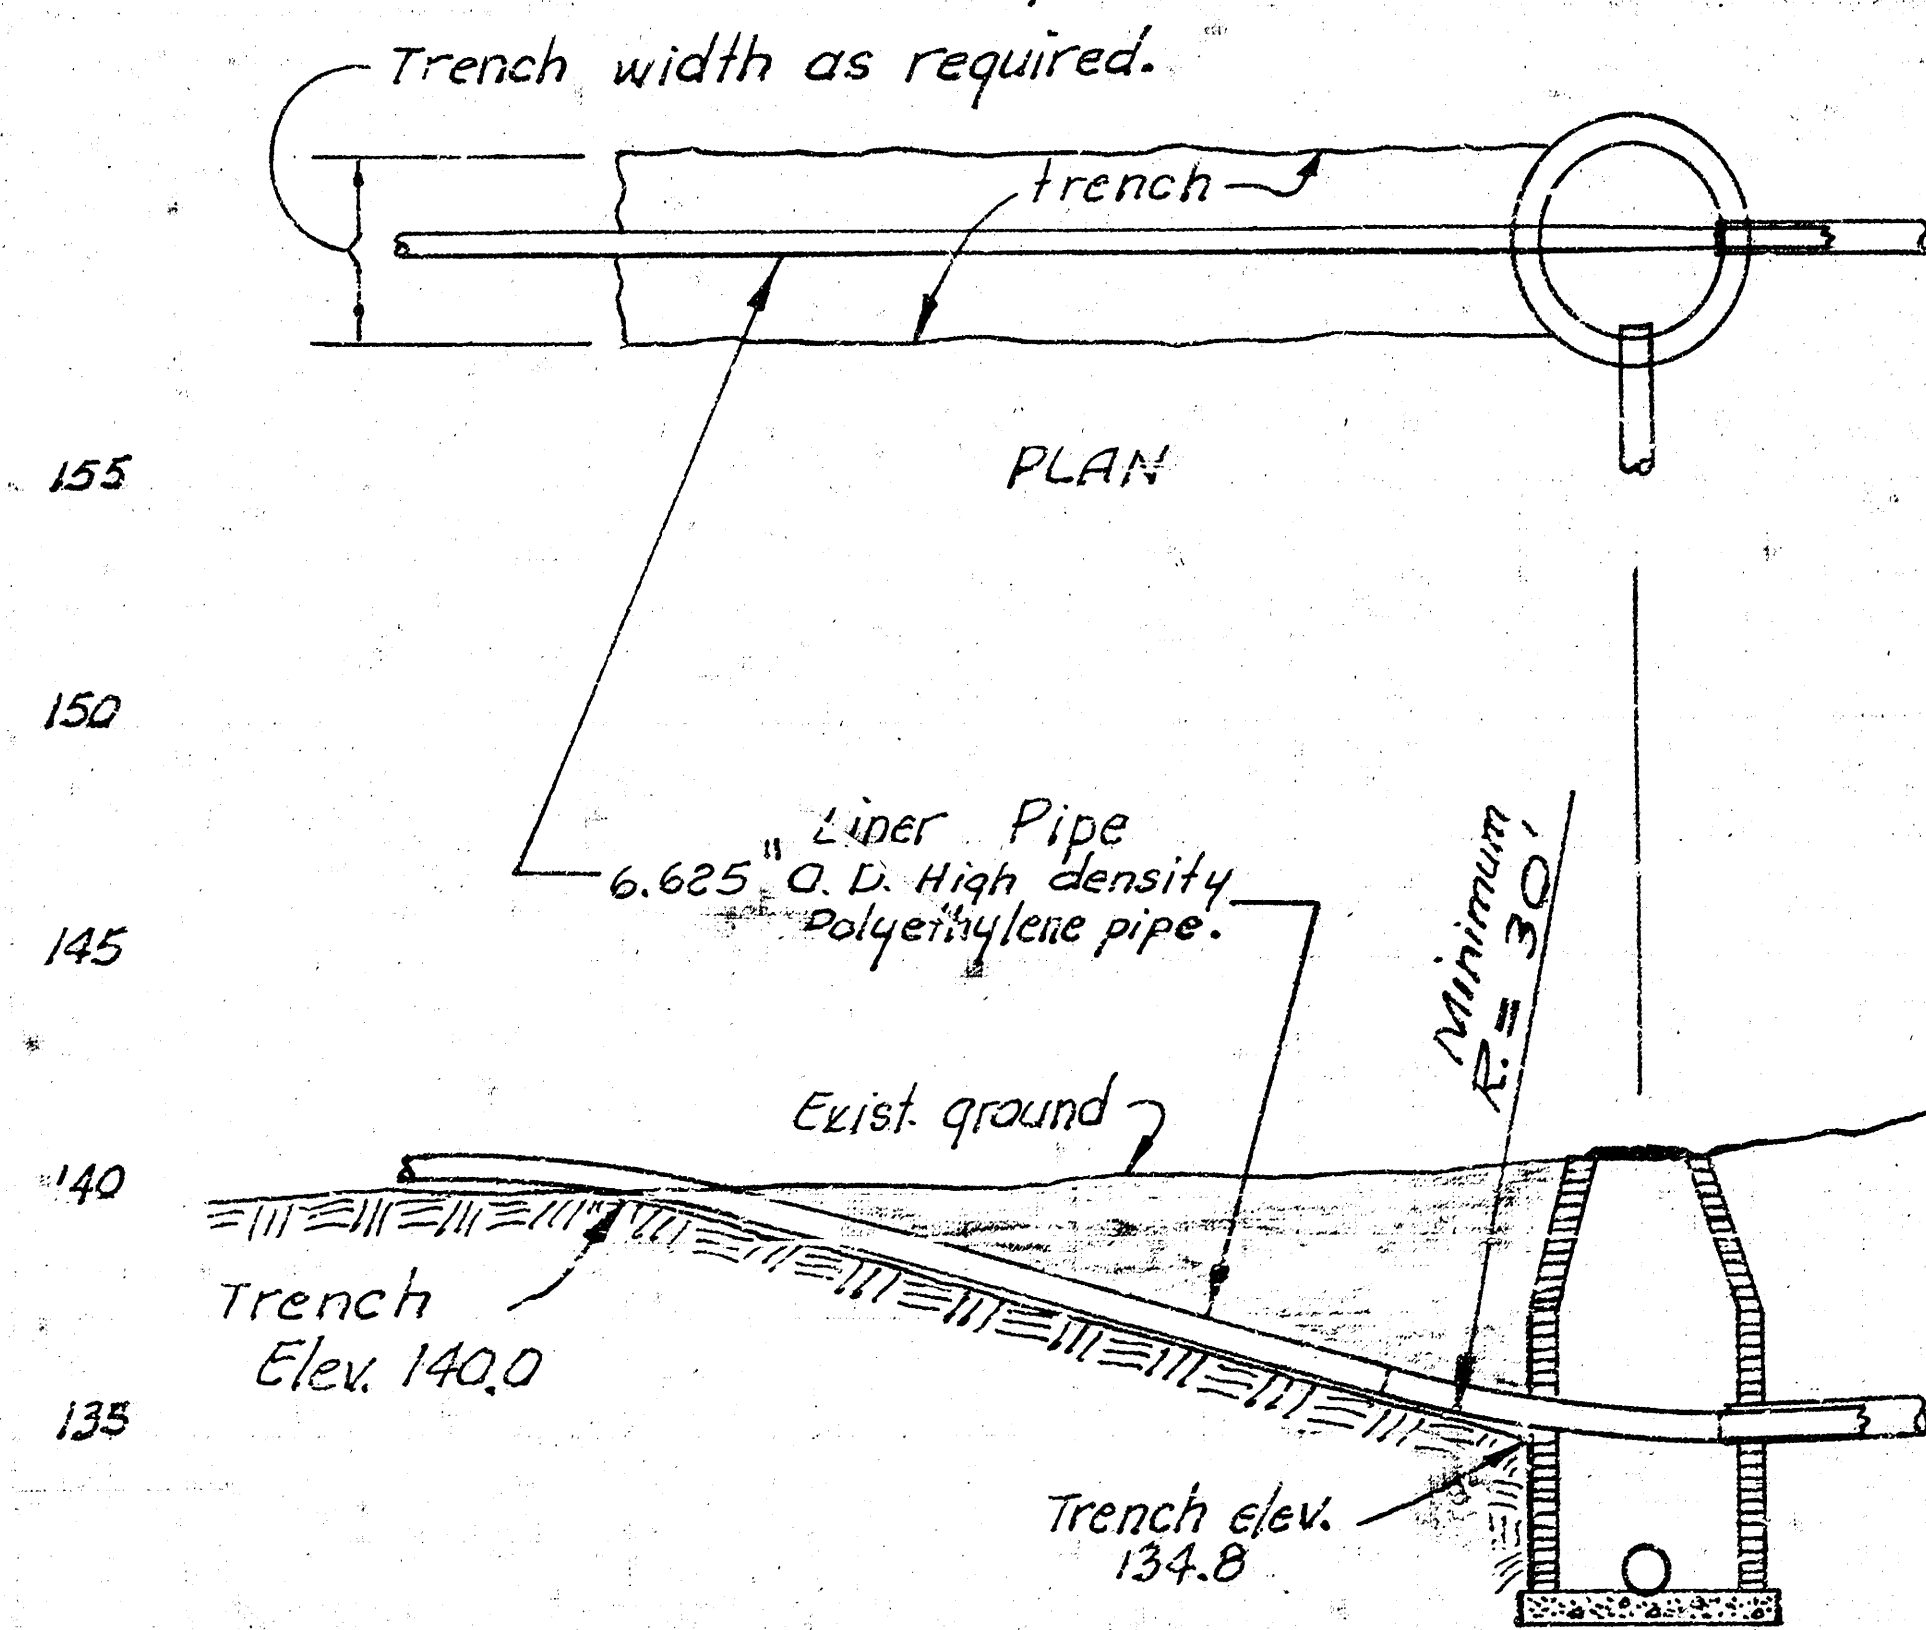

INSERTION TRENCH
DETAIL
STA. 6+61.5

2.5'
Scale

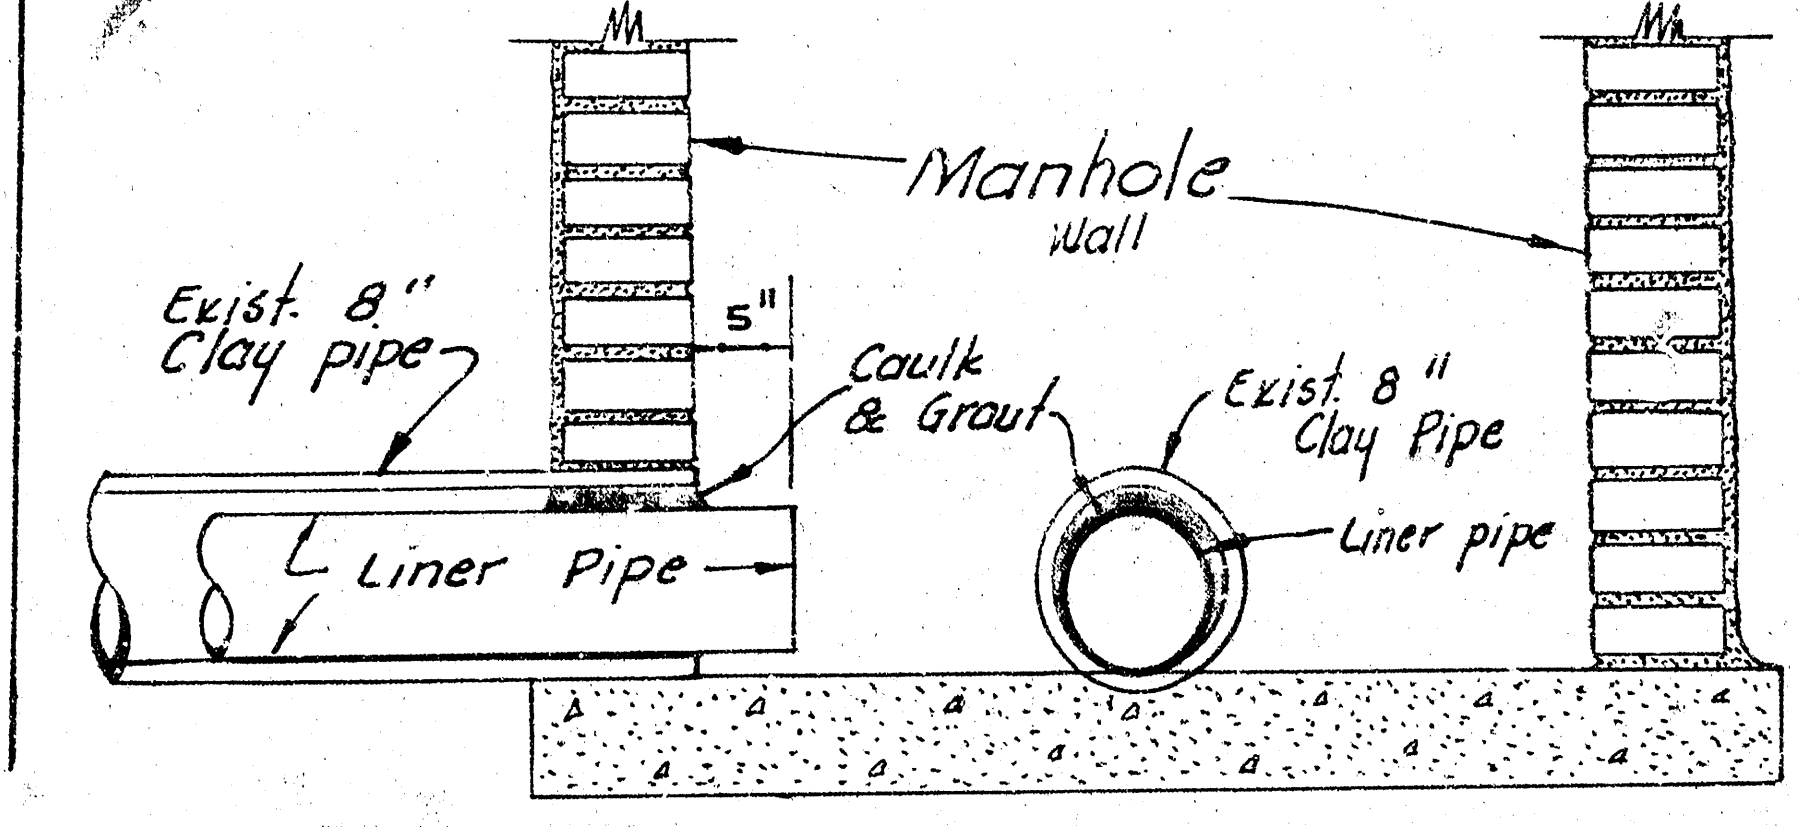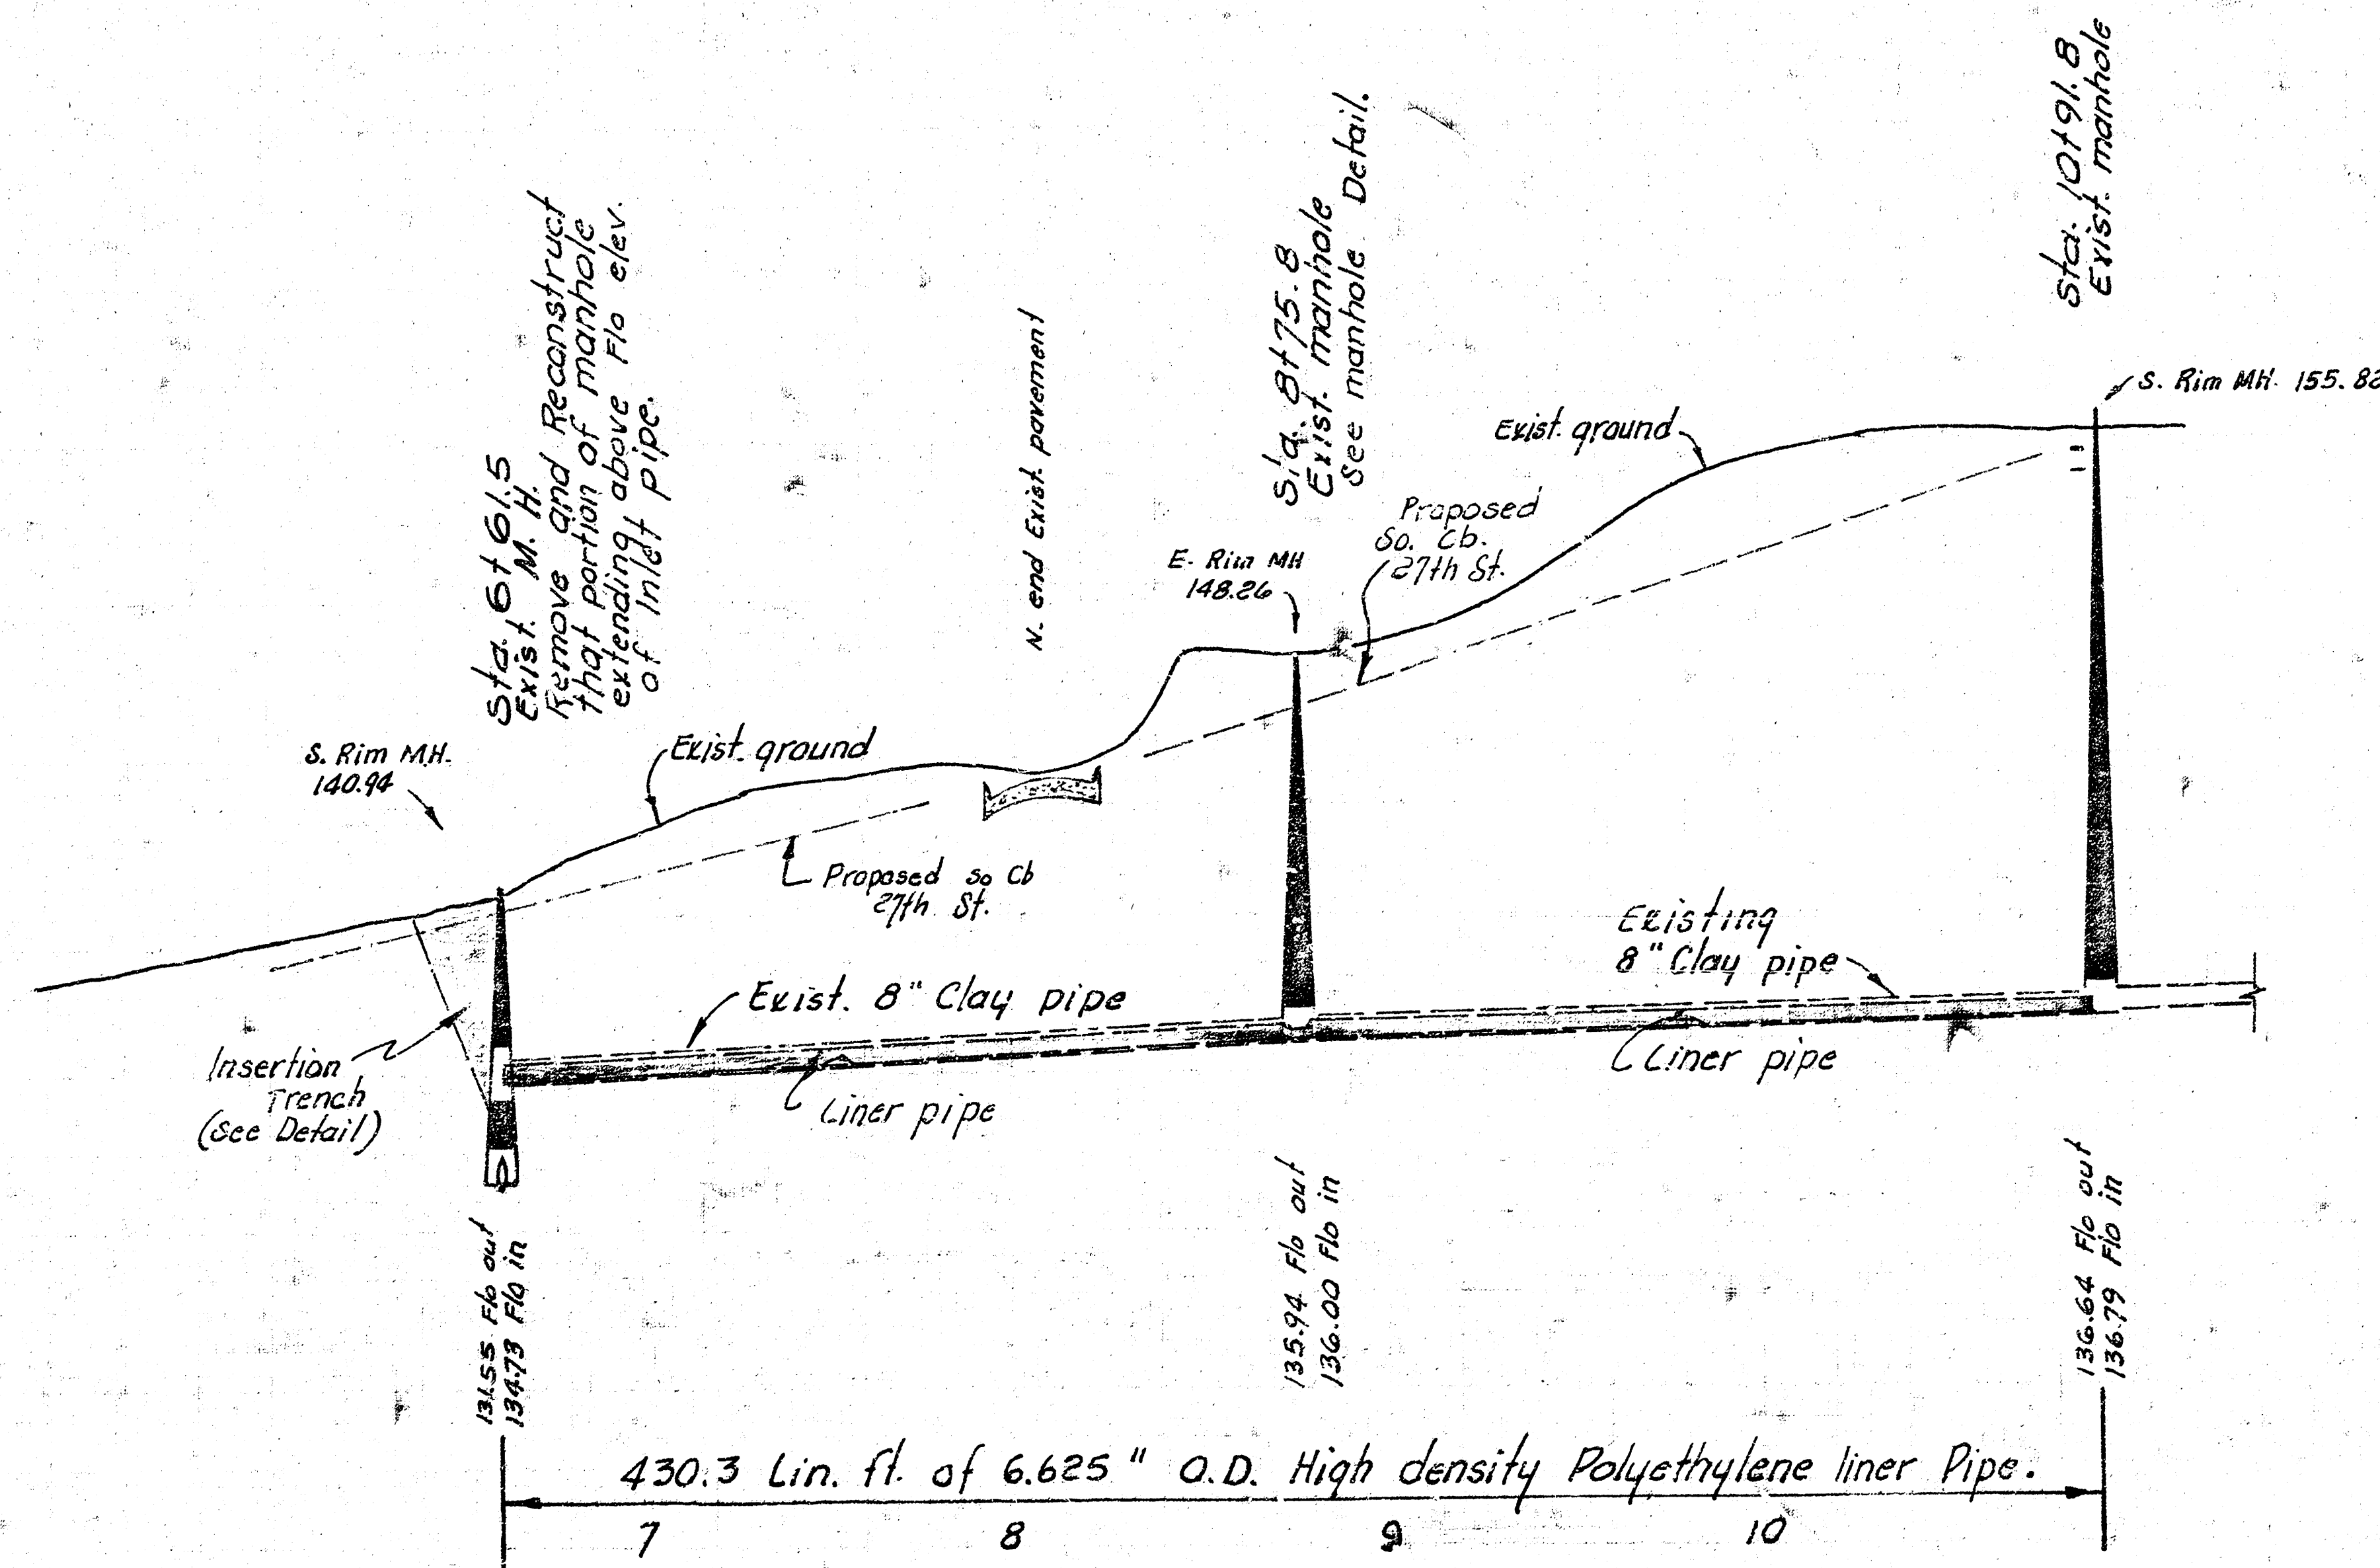

SEALING LINER PIPE
AT MANHOLE

RECONSTRUCTION OF A PORTION OF
LAT. 31, DISTRICT T, S. S. NO. 12
PROJECT NO. DBK L5750 60 2/2