




PLAN
 SHEET 1
 LATERAL 19, D.S.C. No. 2
 SANITARY SEWER No. 12
 WICHITA, KANSAS
 MOEHRING & ASSOCIATES CONSULTING ENGINEERS
 October, 1973

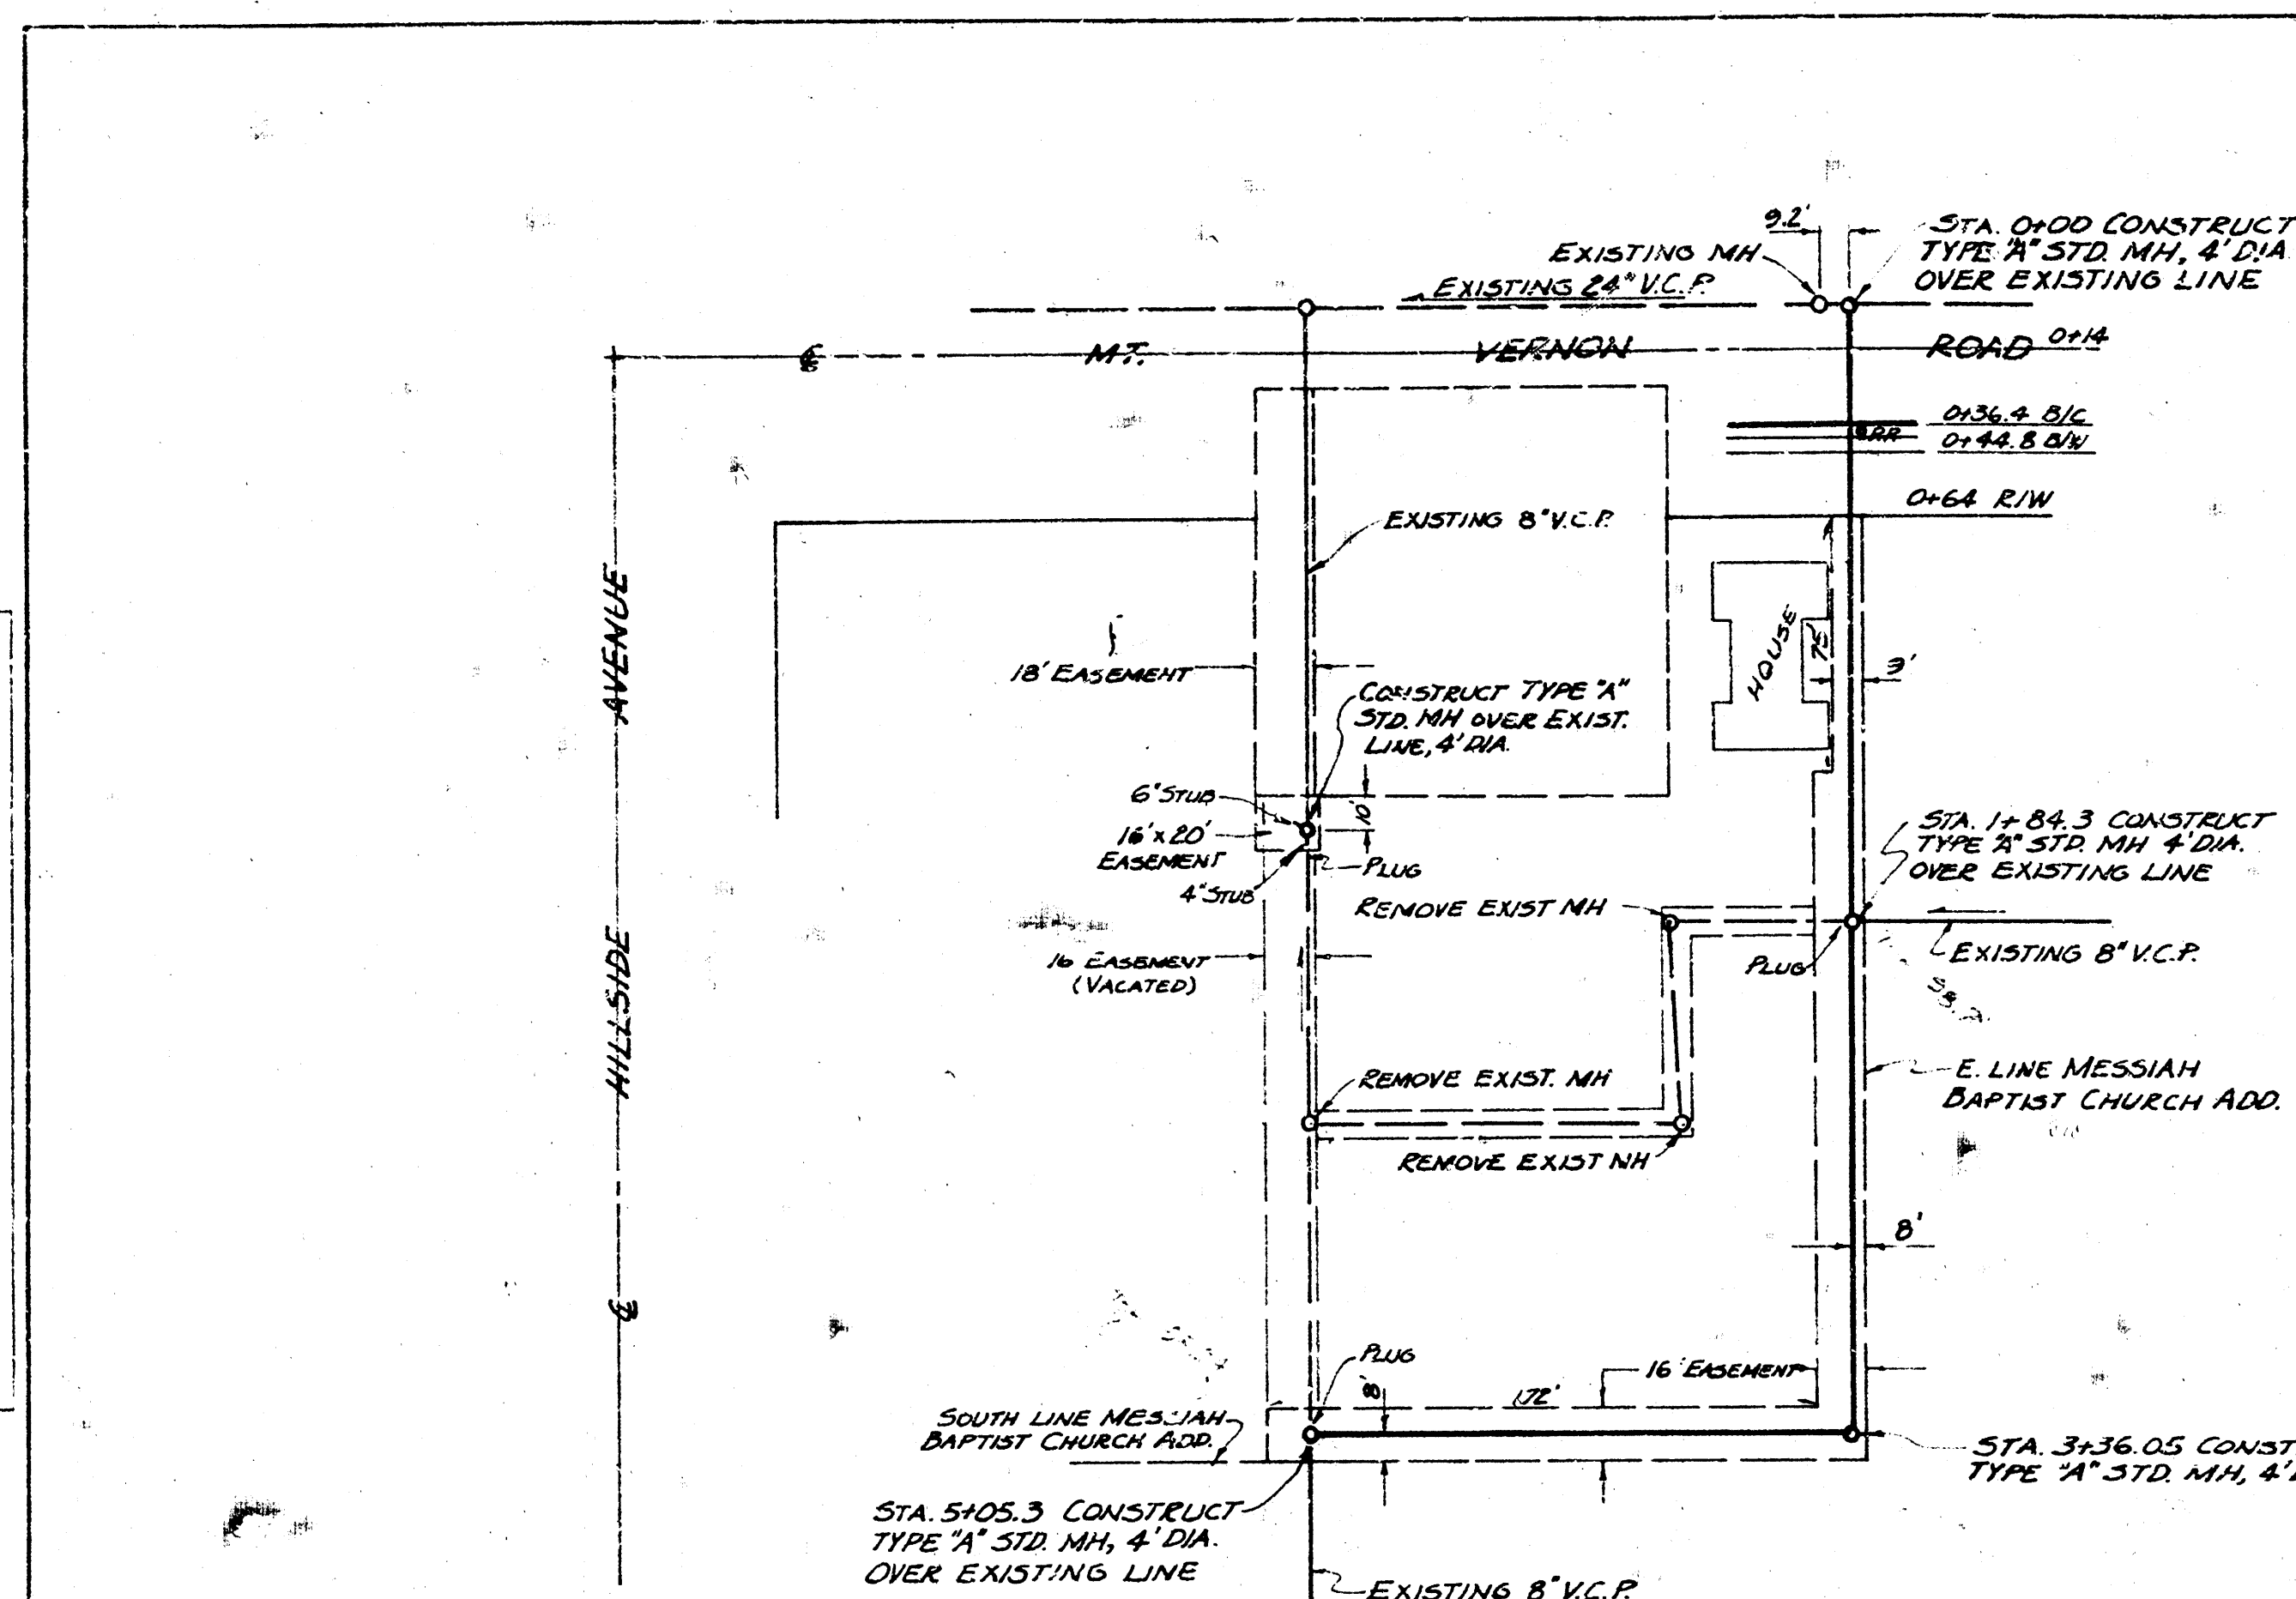

- NOTES:
1. ALL MANHOLES TO BE REMOVED SHALL BE DEMOLISHED AND ALL LINES PLUGGED WITH CONCRETE. SALVAGE FRAME AND COVER AND DELIVER TO CITY OF WICHITA MATERIAL YARD.
 2. ALL LINES TO BE SAND BACKFILLED AND FLUSHED.
 3. ABANDONED LINES UNDER NEW CHURCH BUILDING SHALL BE SAND FILLED.
 4. ALL PAVEMENT REMOVED SHALL BE REPLACED ACCORDING TO CITY OF WICHITA SPECIFICATIONS (SEE DETAIL).

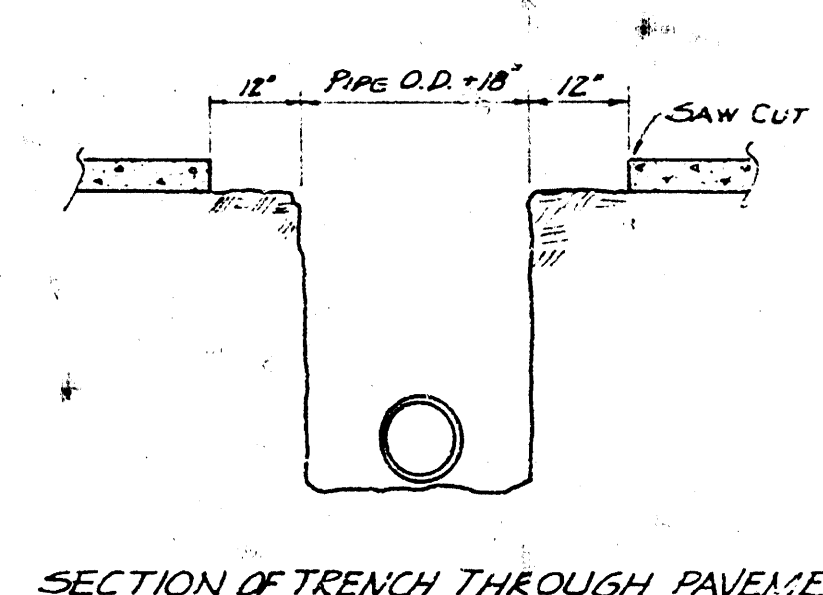

PROFILE
 SHEET 1
 LATERAL 19, D.S.C. No. 2
 SANITARY SEWER No. 12
 WICHITA, KANSAS
 MOEHRING & ASSOCIATES CONSULTING ENGINEERS
 October, 1973

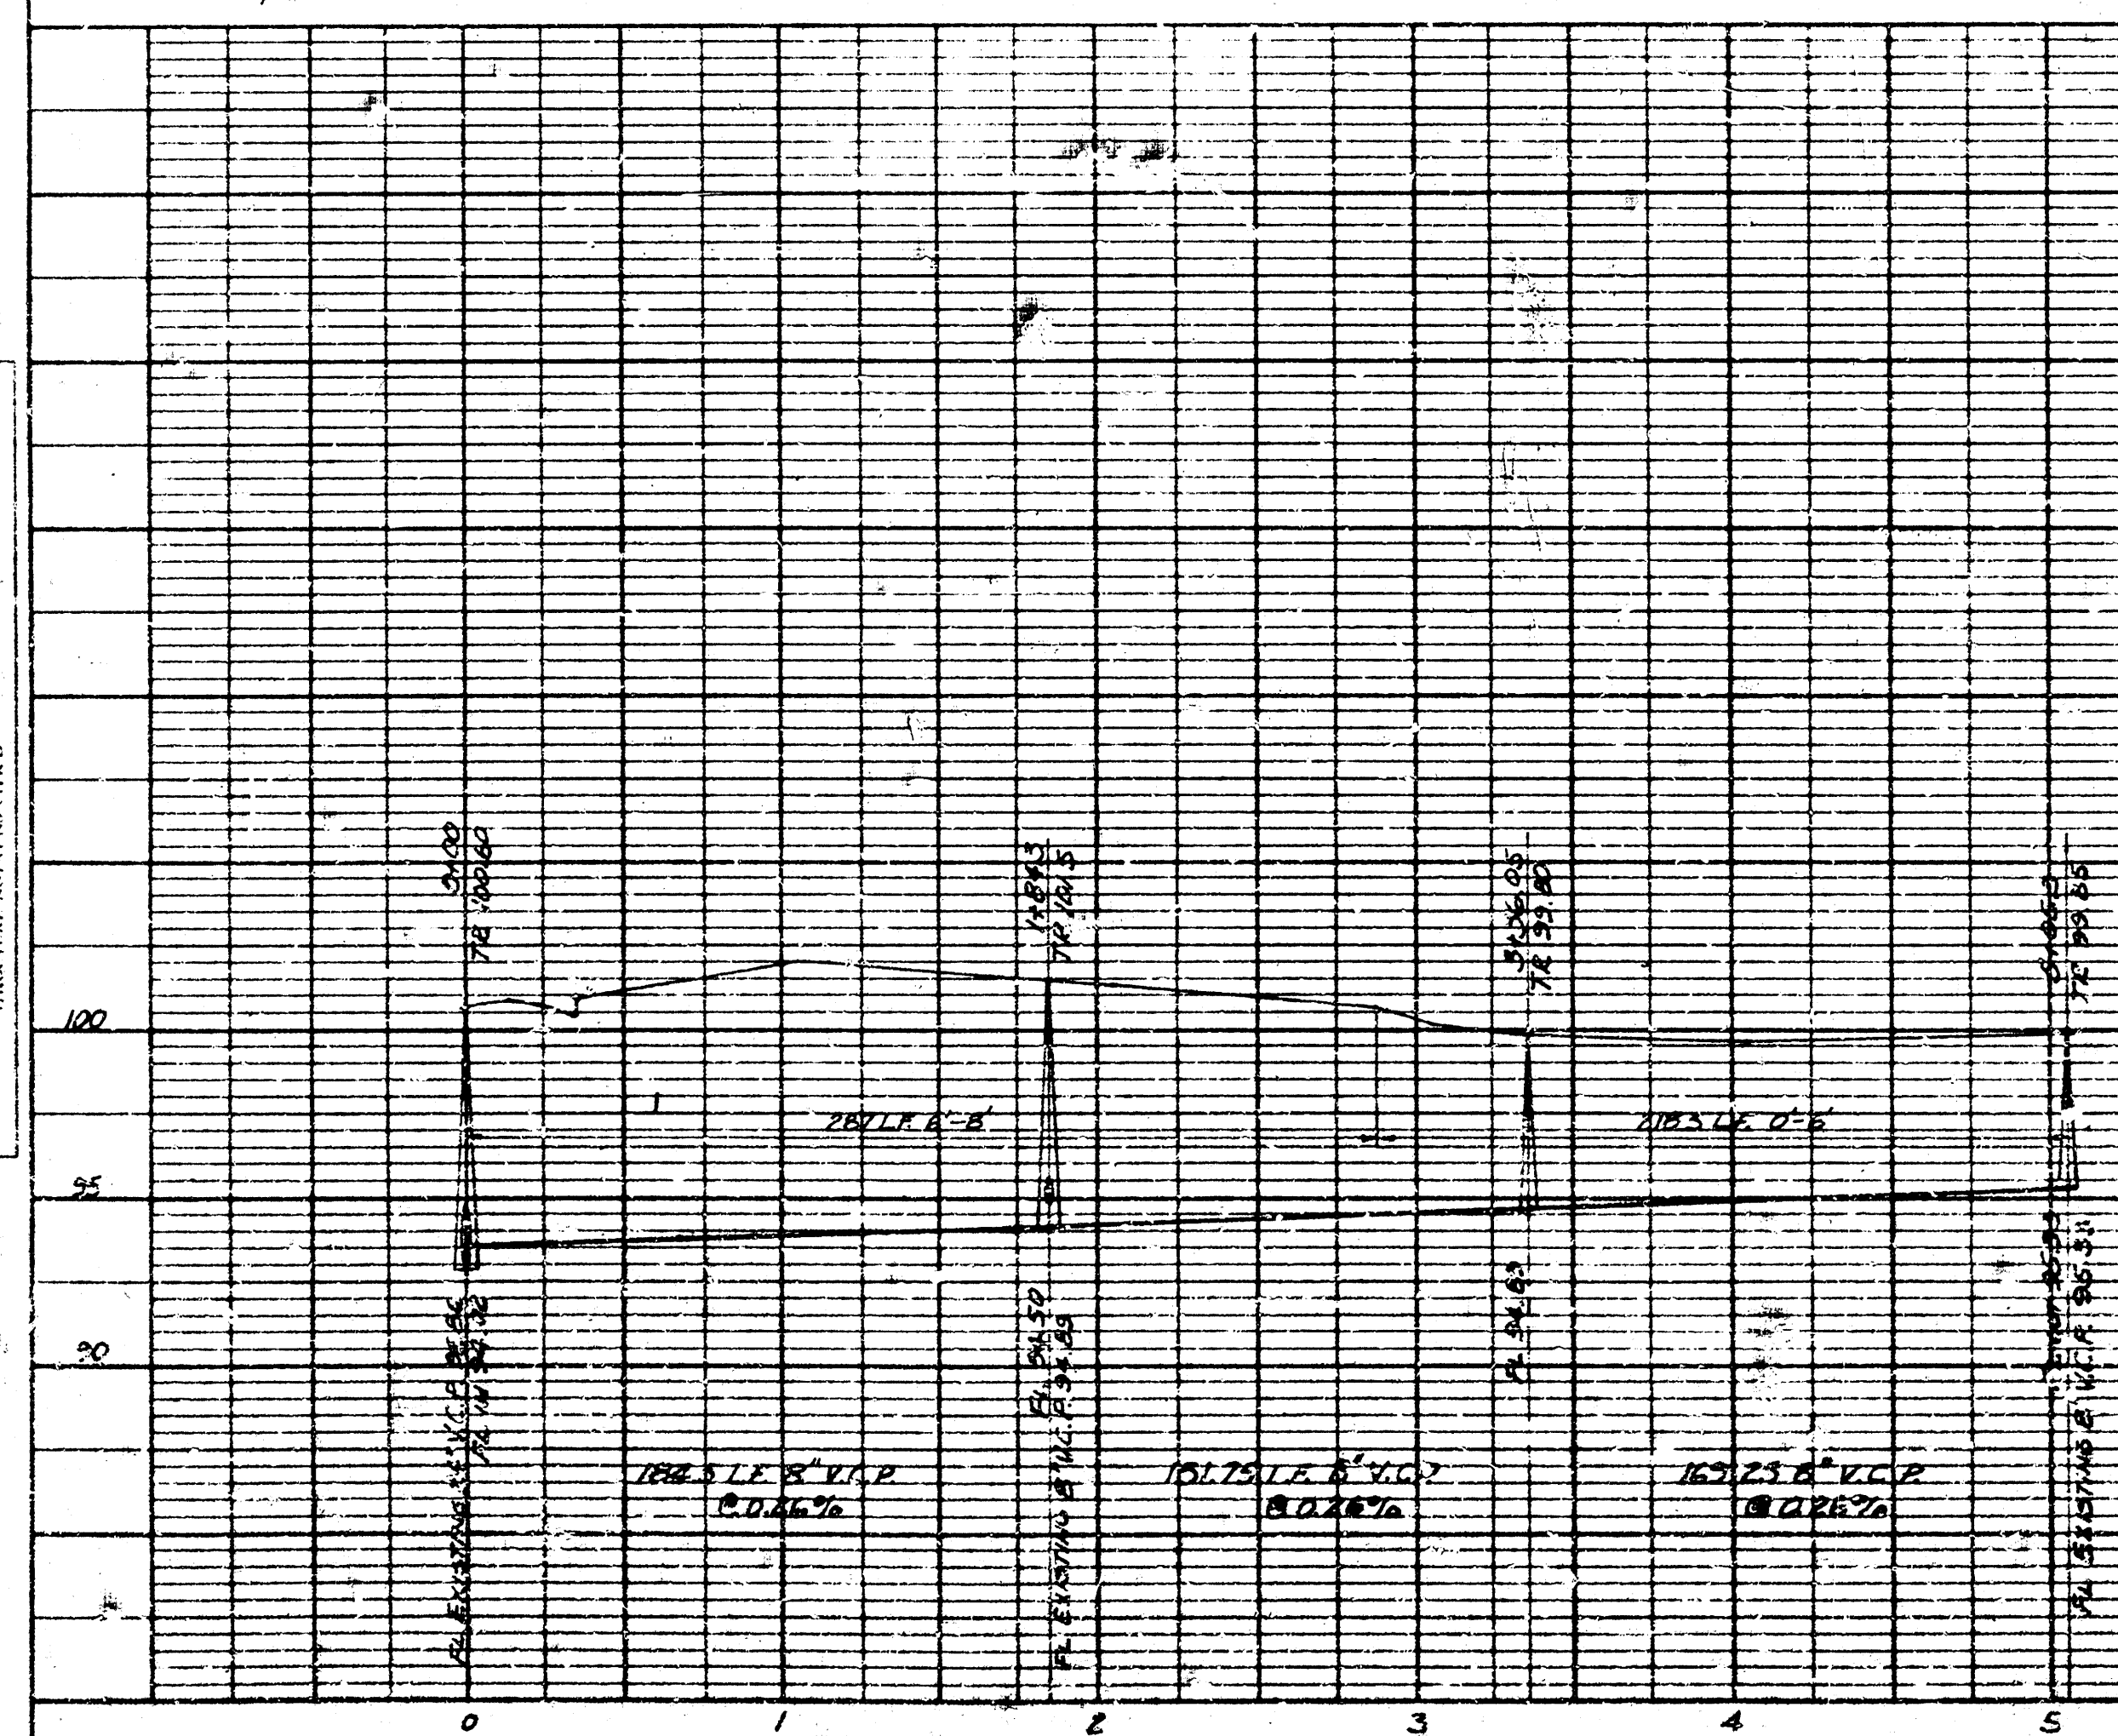

SCALE
 1\"/>

Booked 6-137

RELOCATION OF PART OF
 LATERAL 19, D.S.C. No. 2
 SANITARY SEWER No. 12

WICHITA, KANSAS
 MOEHRING & ASSOCIATES CONSULTING ENGINEERS
 October, 1973

Revised as built, November, 1973
 (SEE DETAIL) SHEET 1 of 2