



Plan by
C/EN
Notes by others

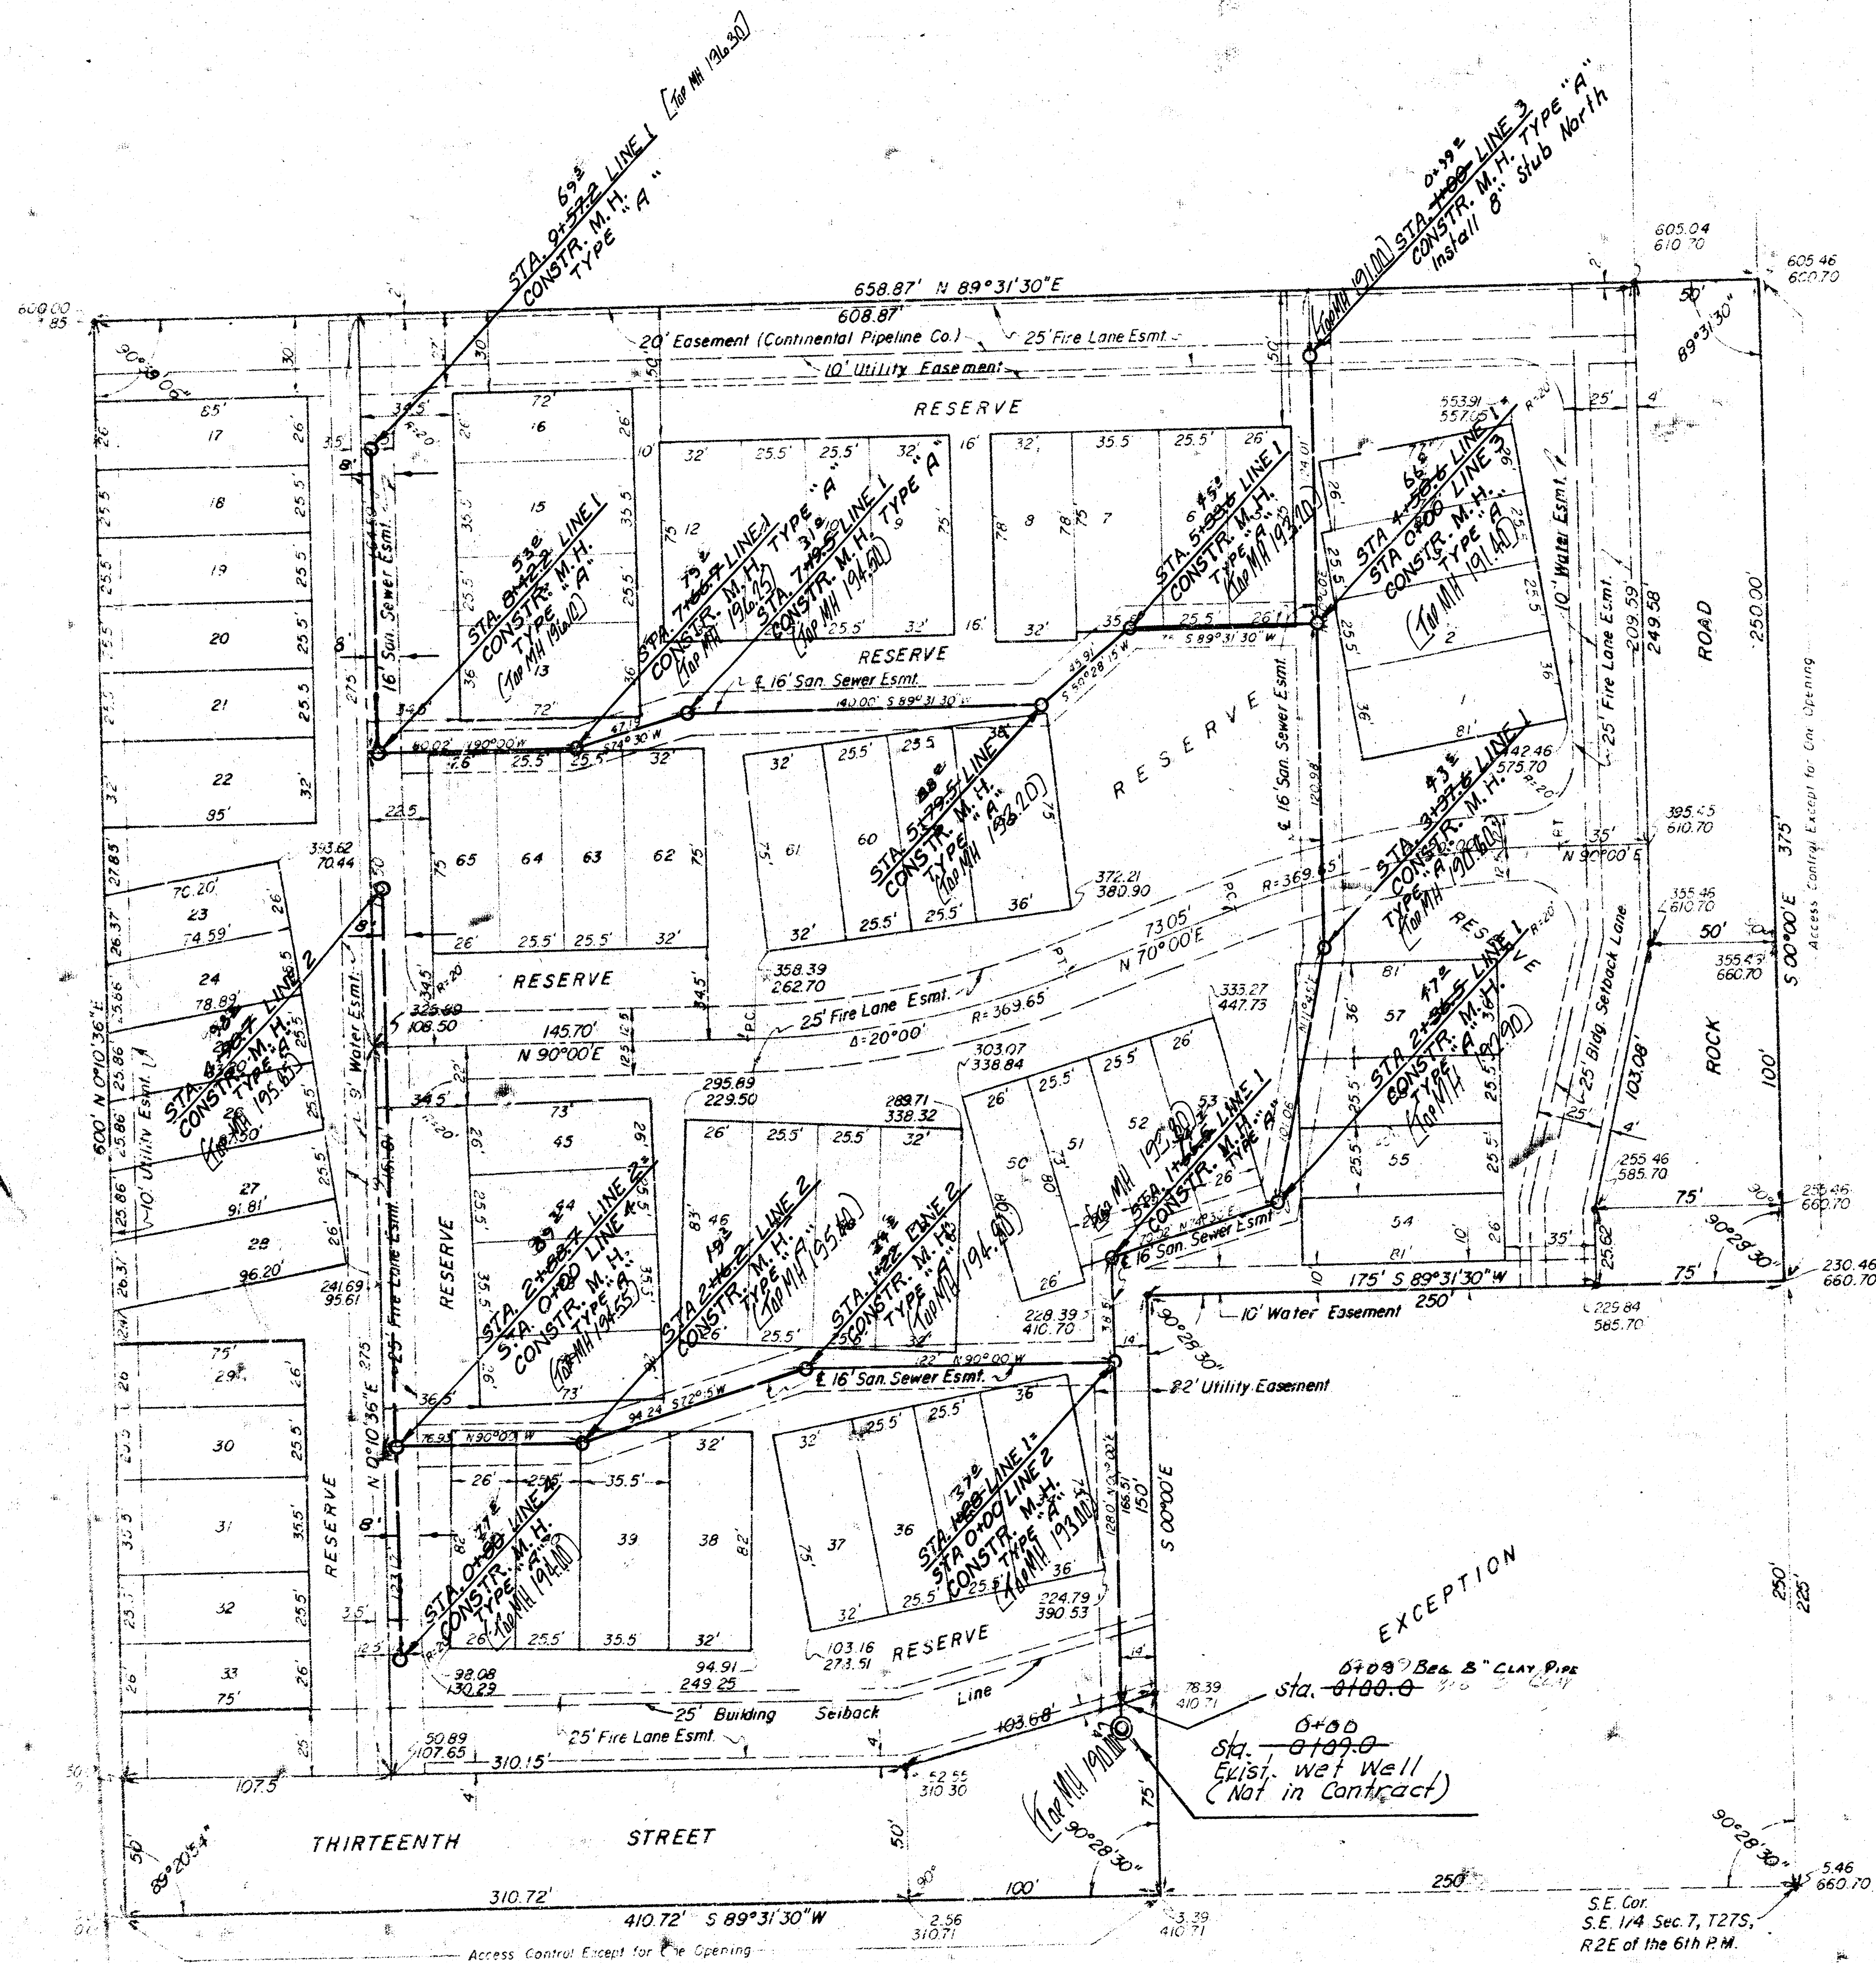

1" = 40'
• = Iron




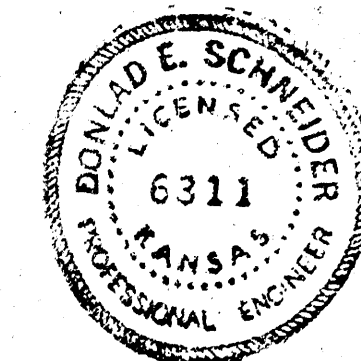


"As Built"
FINAL MEASUREMENTS 1.4.69

LAT. 94, DRY CREEK MAIN 2, S. S. 12
R. W. LINN CITY ENGINEER
CITY OF WICHITA, KANSAS
PROJ. NO. DBKL 572065
DATE: DEC. 1972

S. M. 188.16 R. R. Spike in Power Pole N.E.
Cor. 13th and Rock Rd.

NOTE:
Contractor to contact
developer to establish
top of manhole elevations.

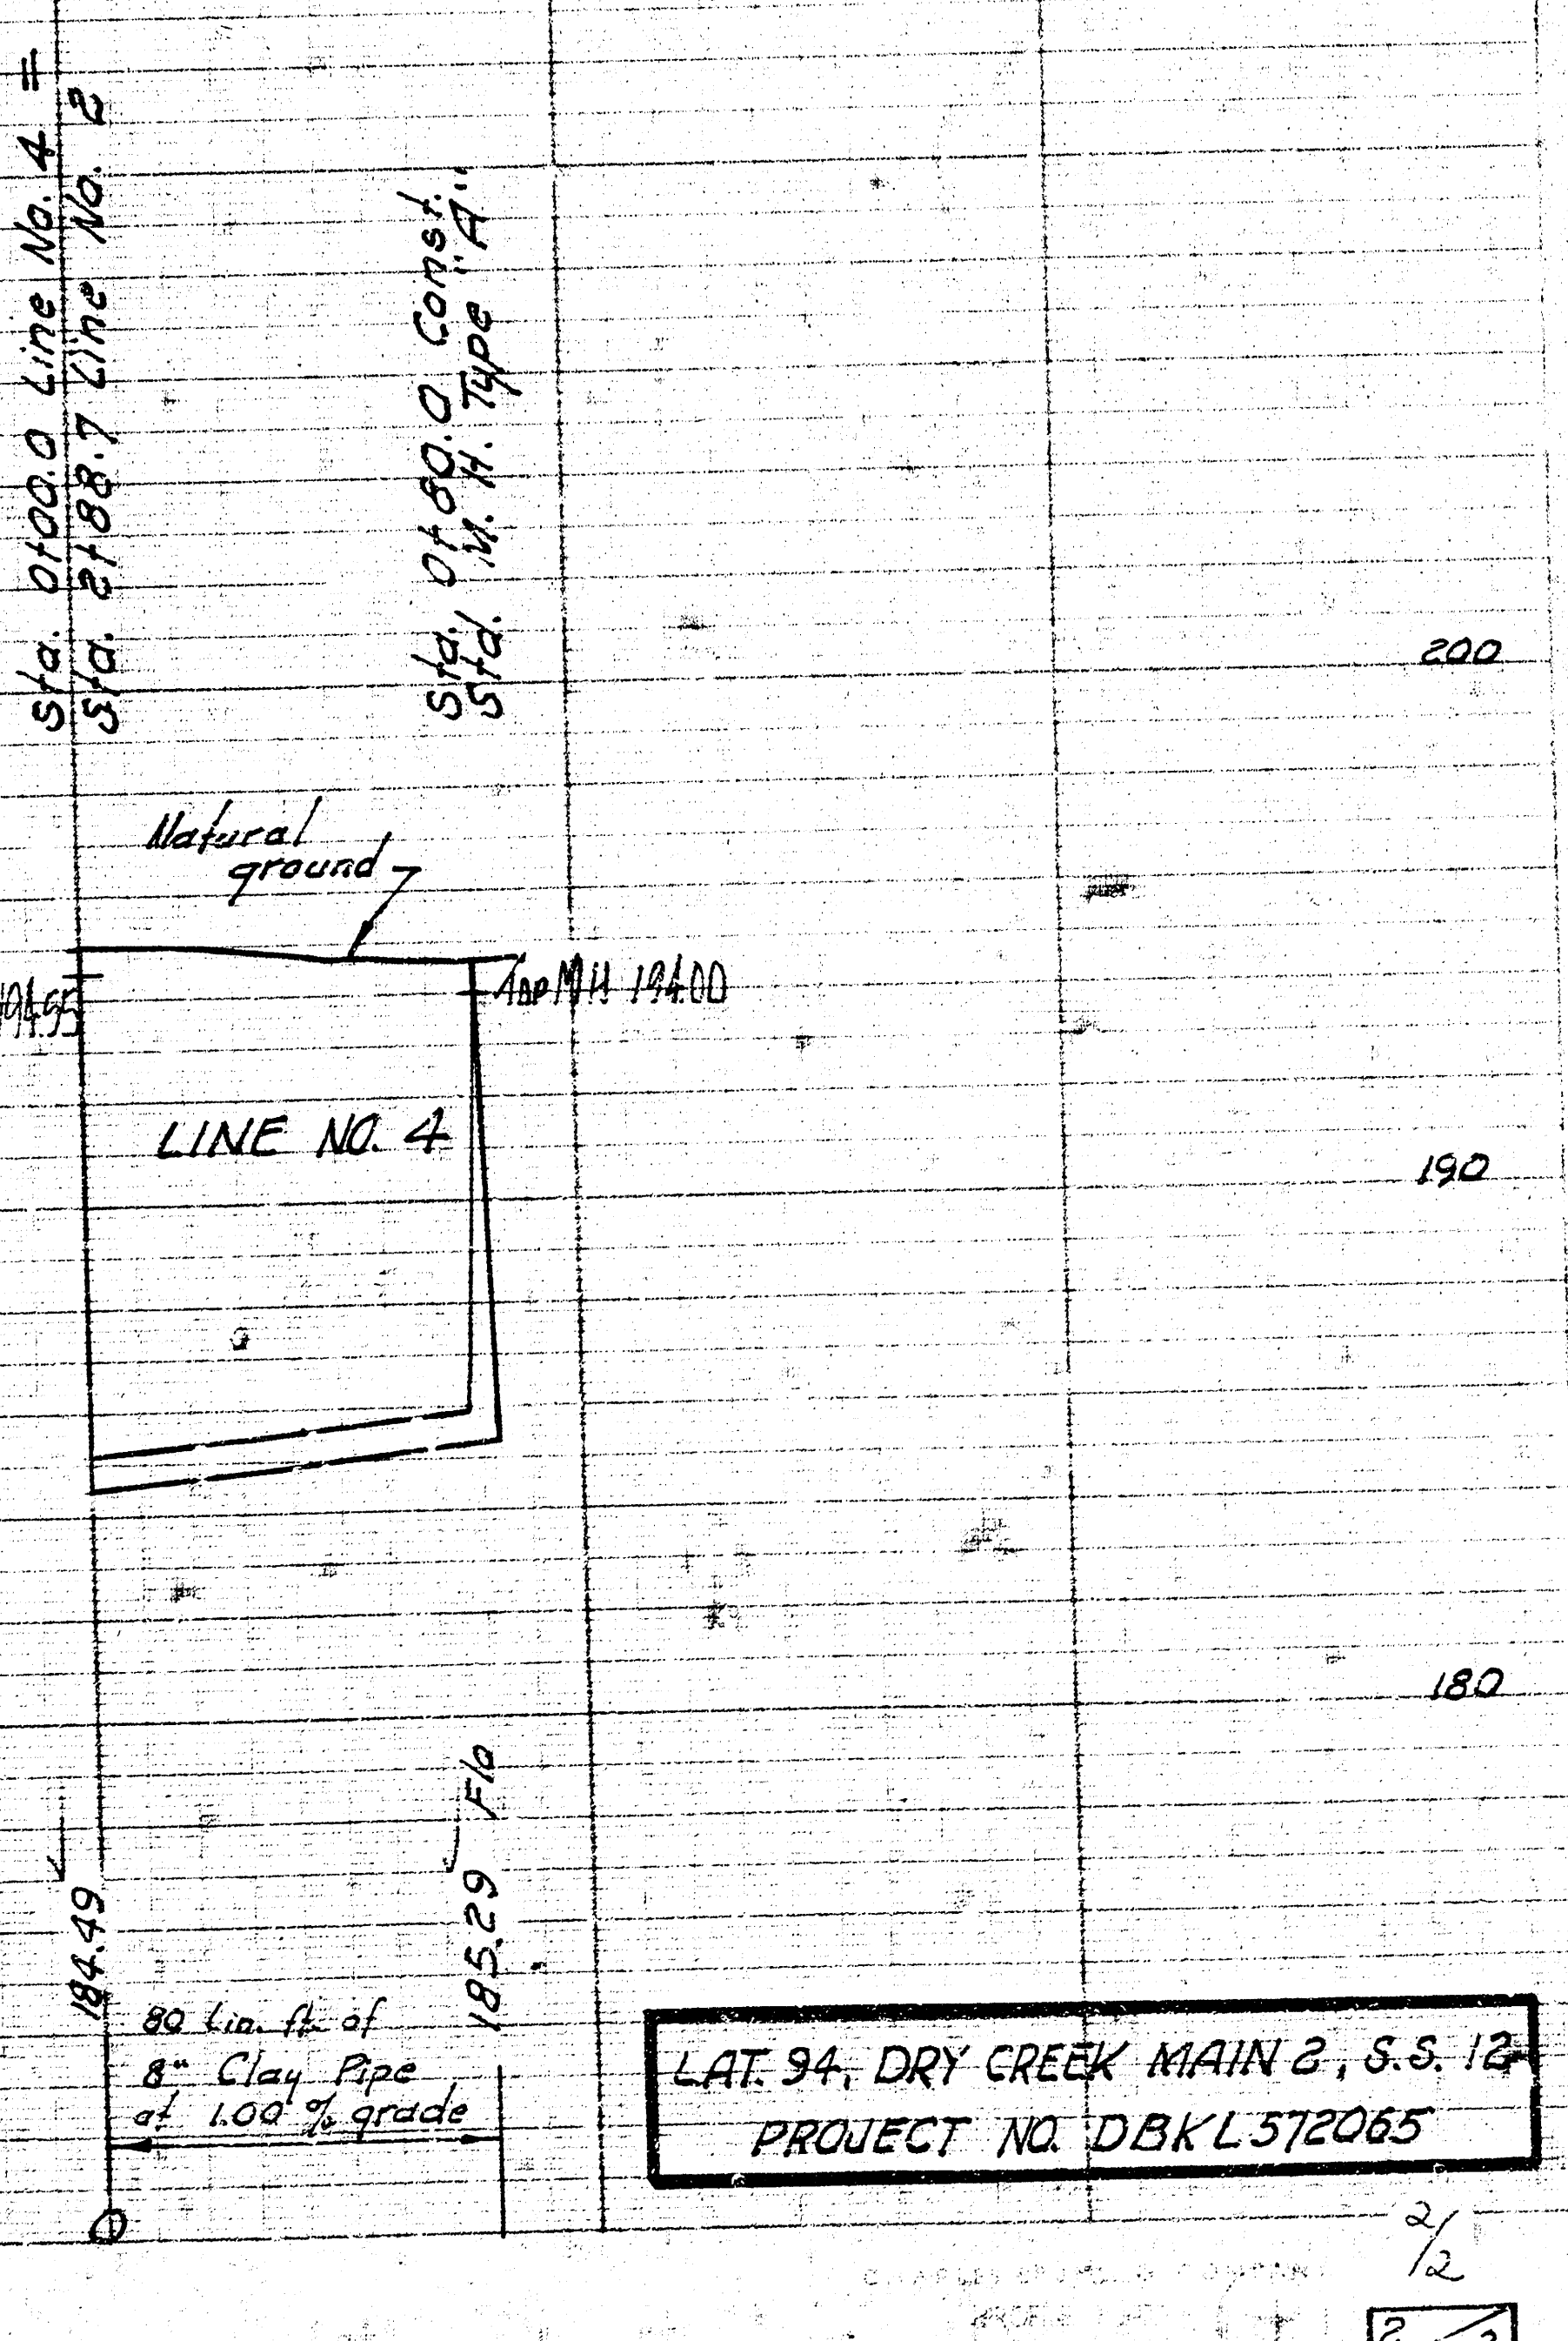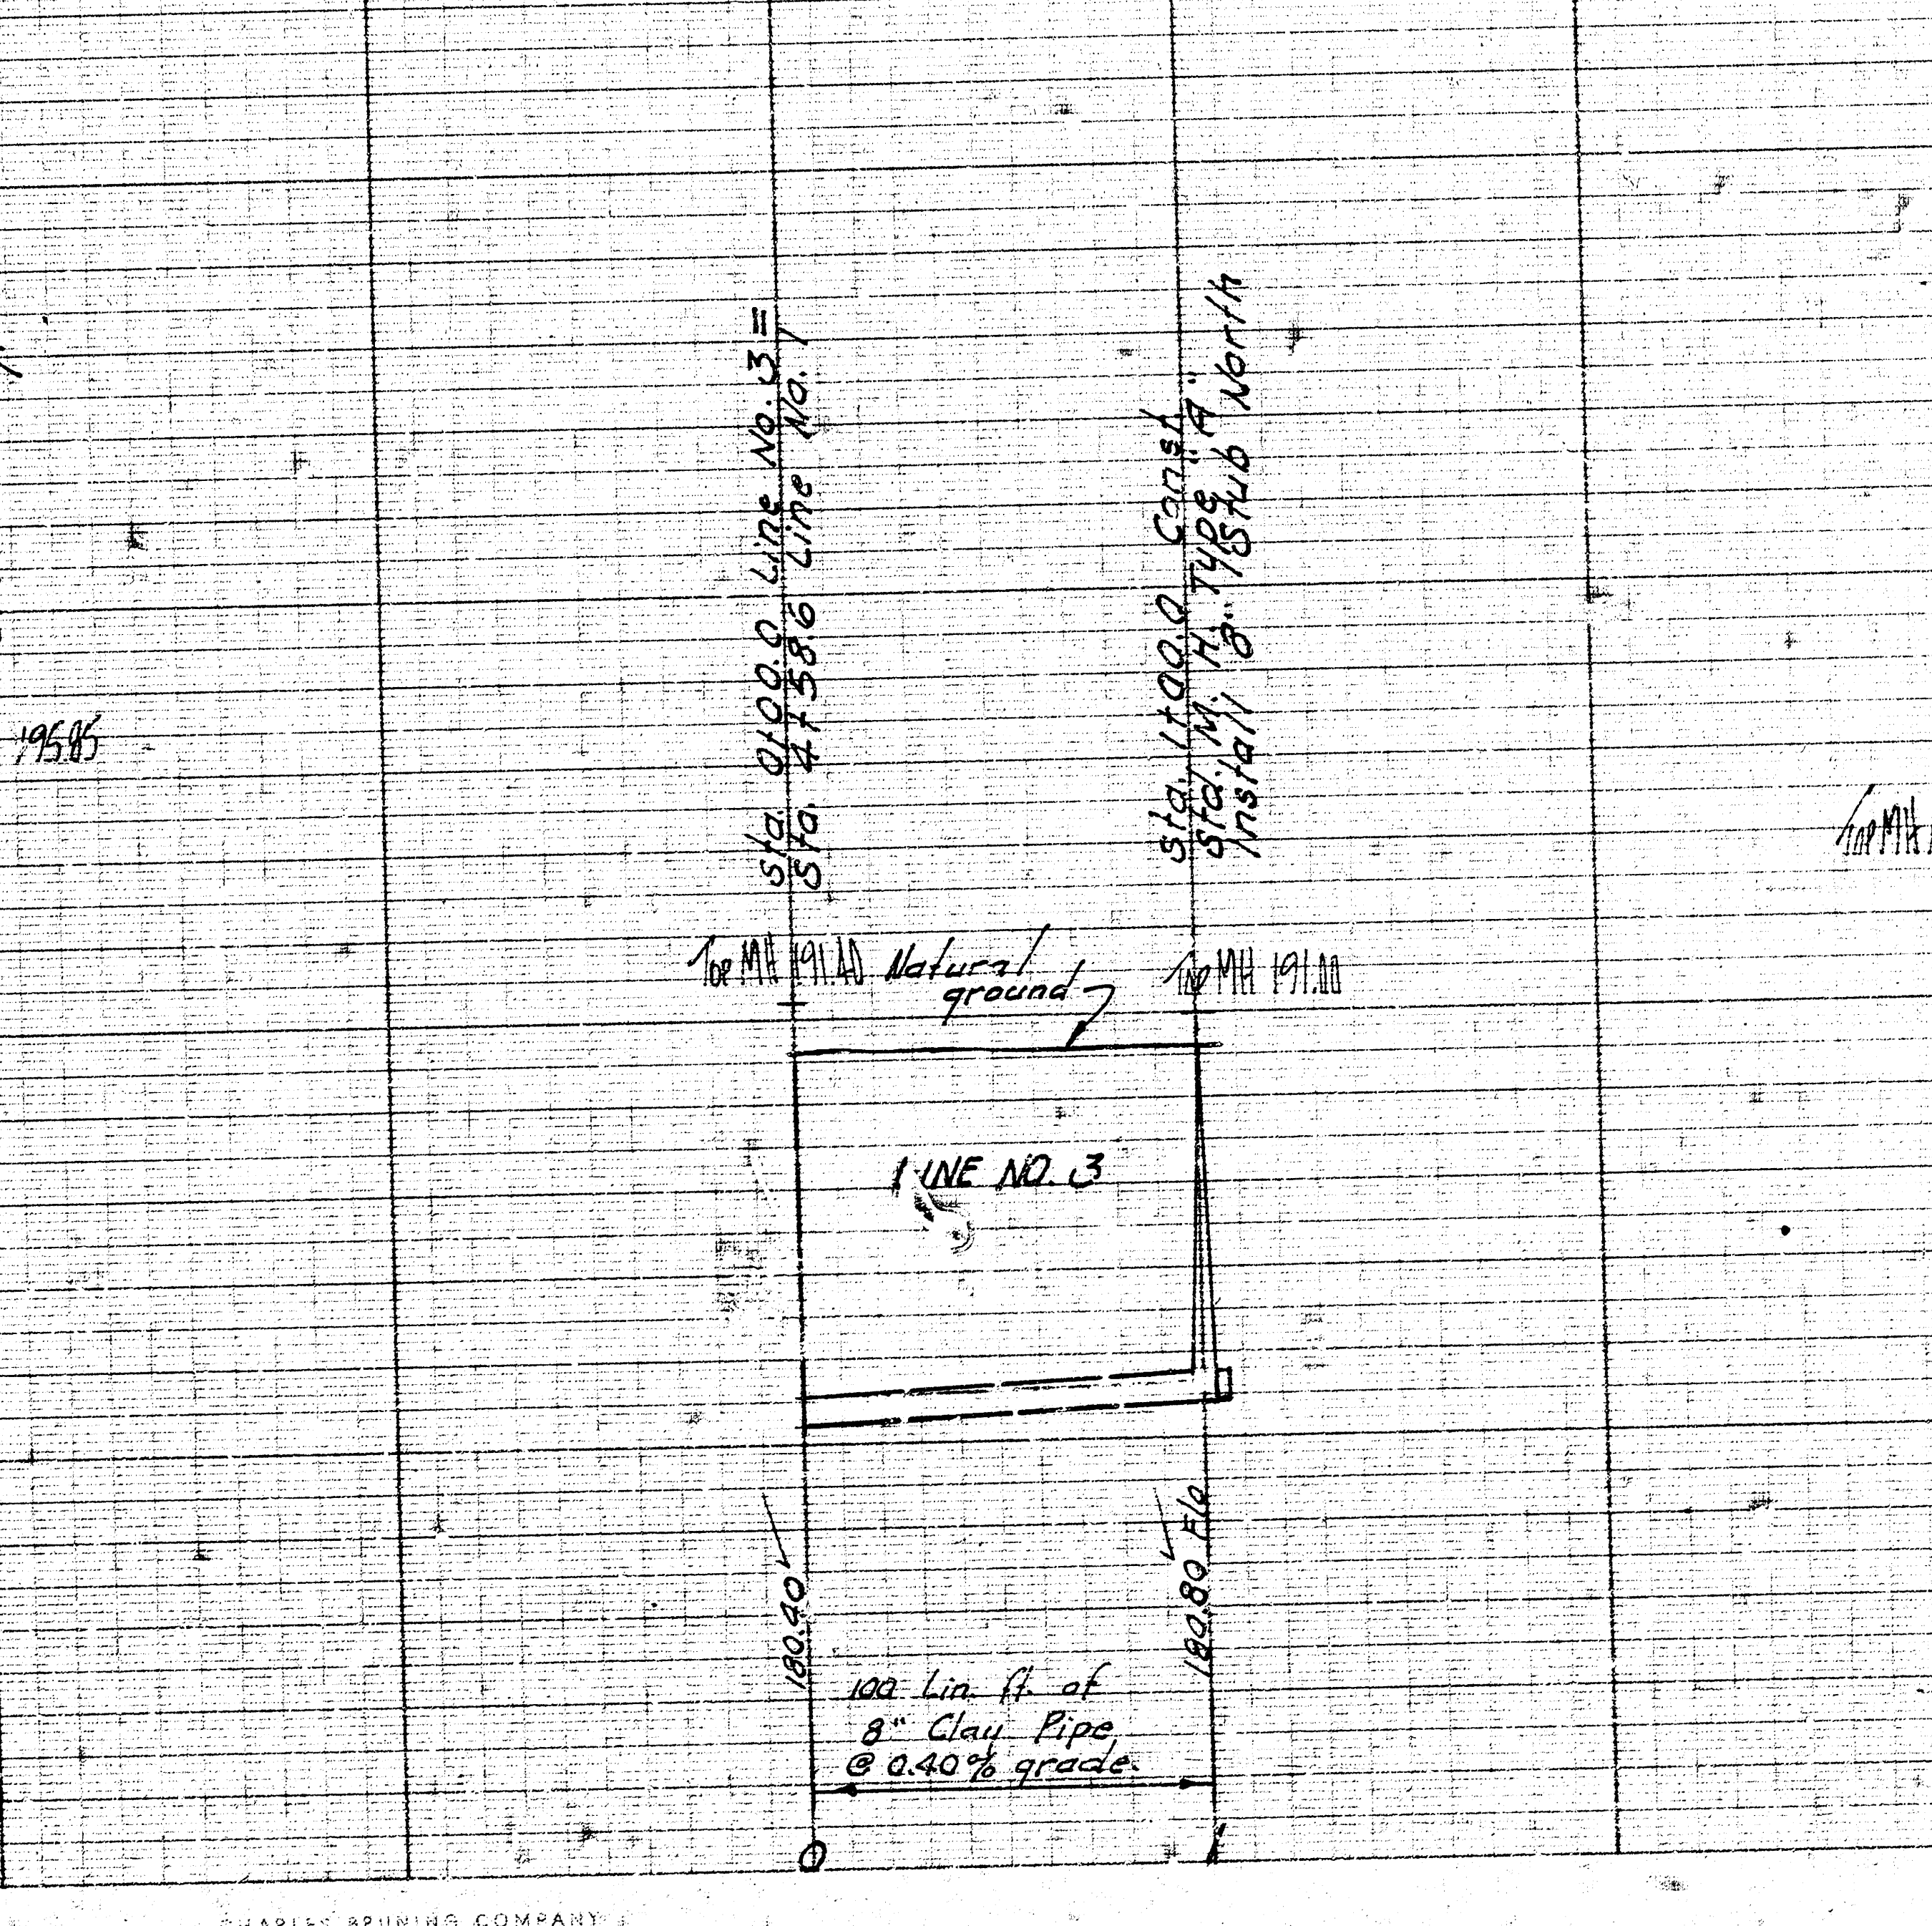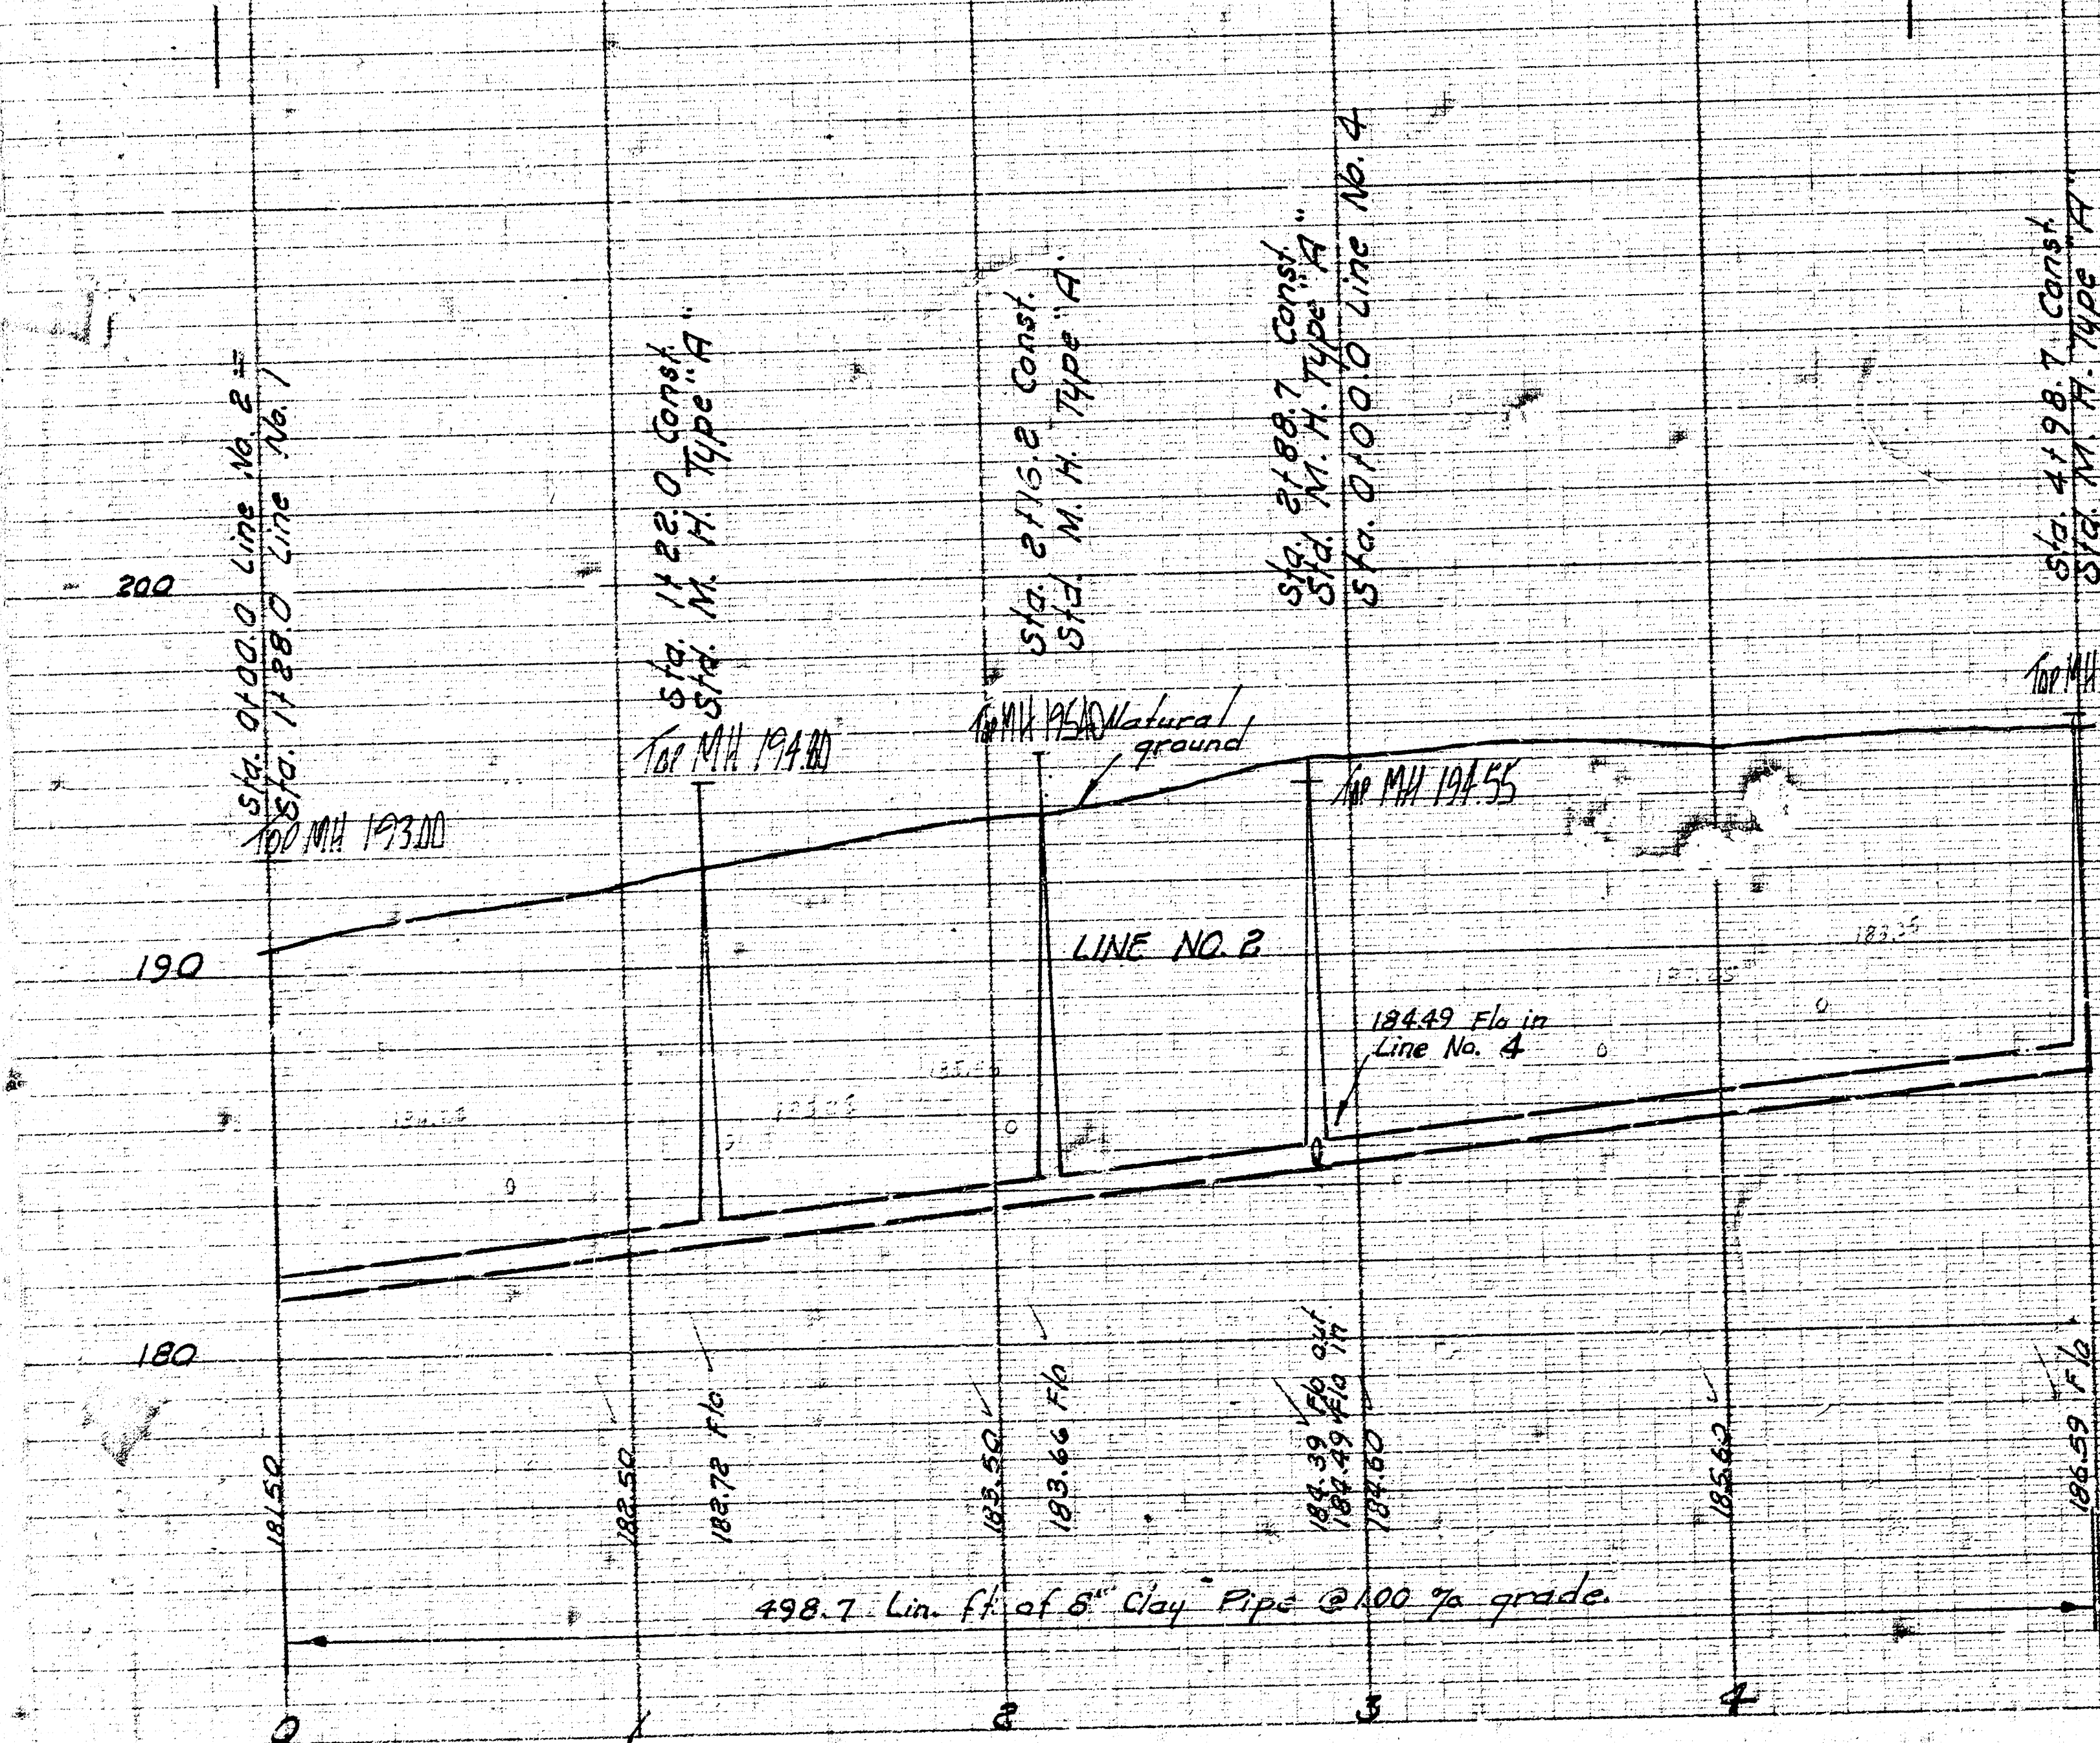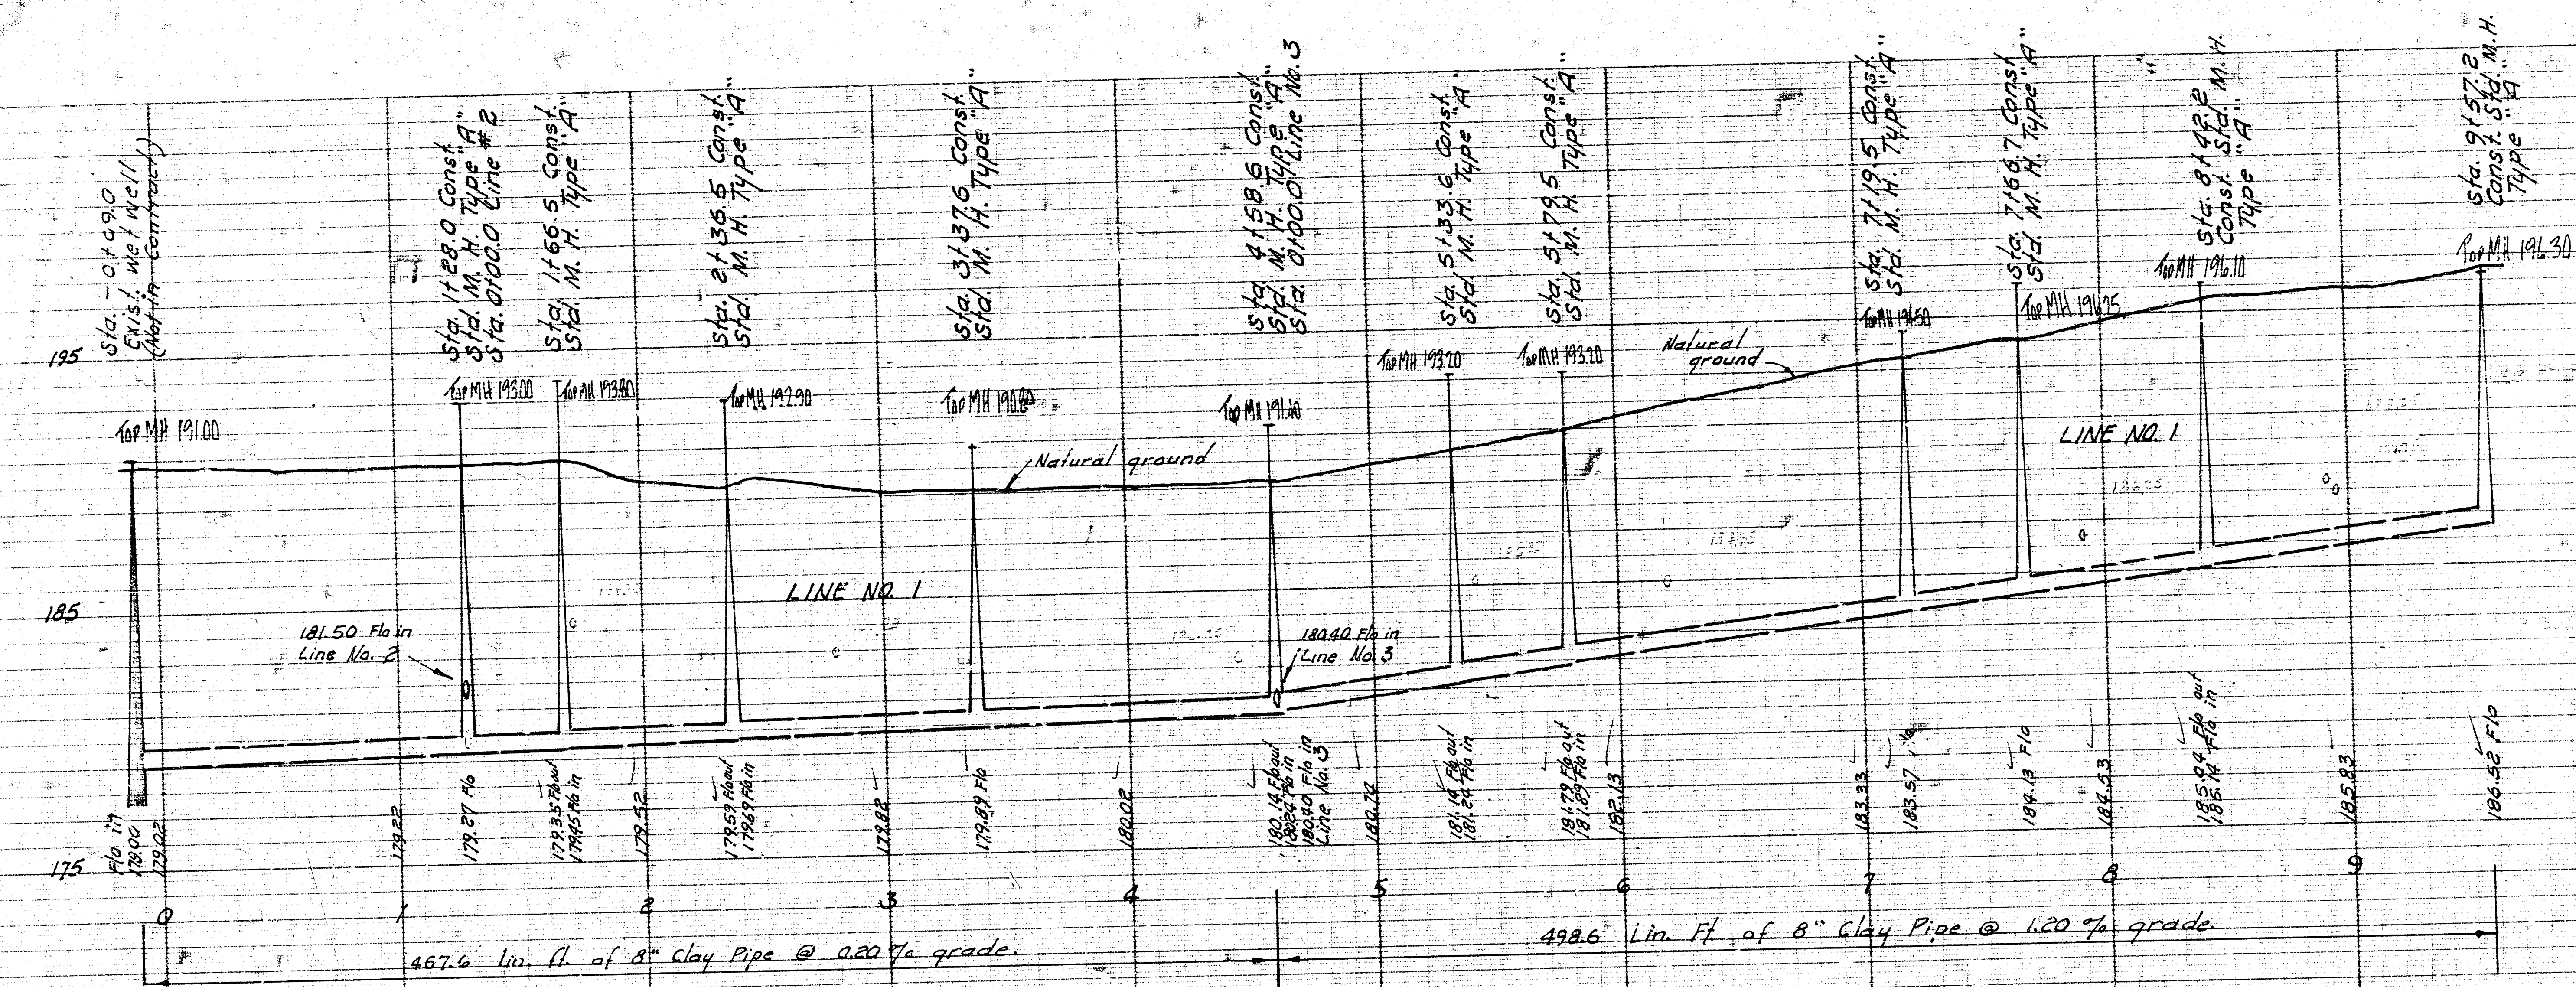

LAT. 94, DRY CREEK MAIN 2, S.S. 12
PROJECT NO. DBK'L572065

CHARLES BRUNING COMPANY
PROFILE PLATE A

FILMED FROM THE BEST