
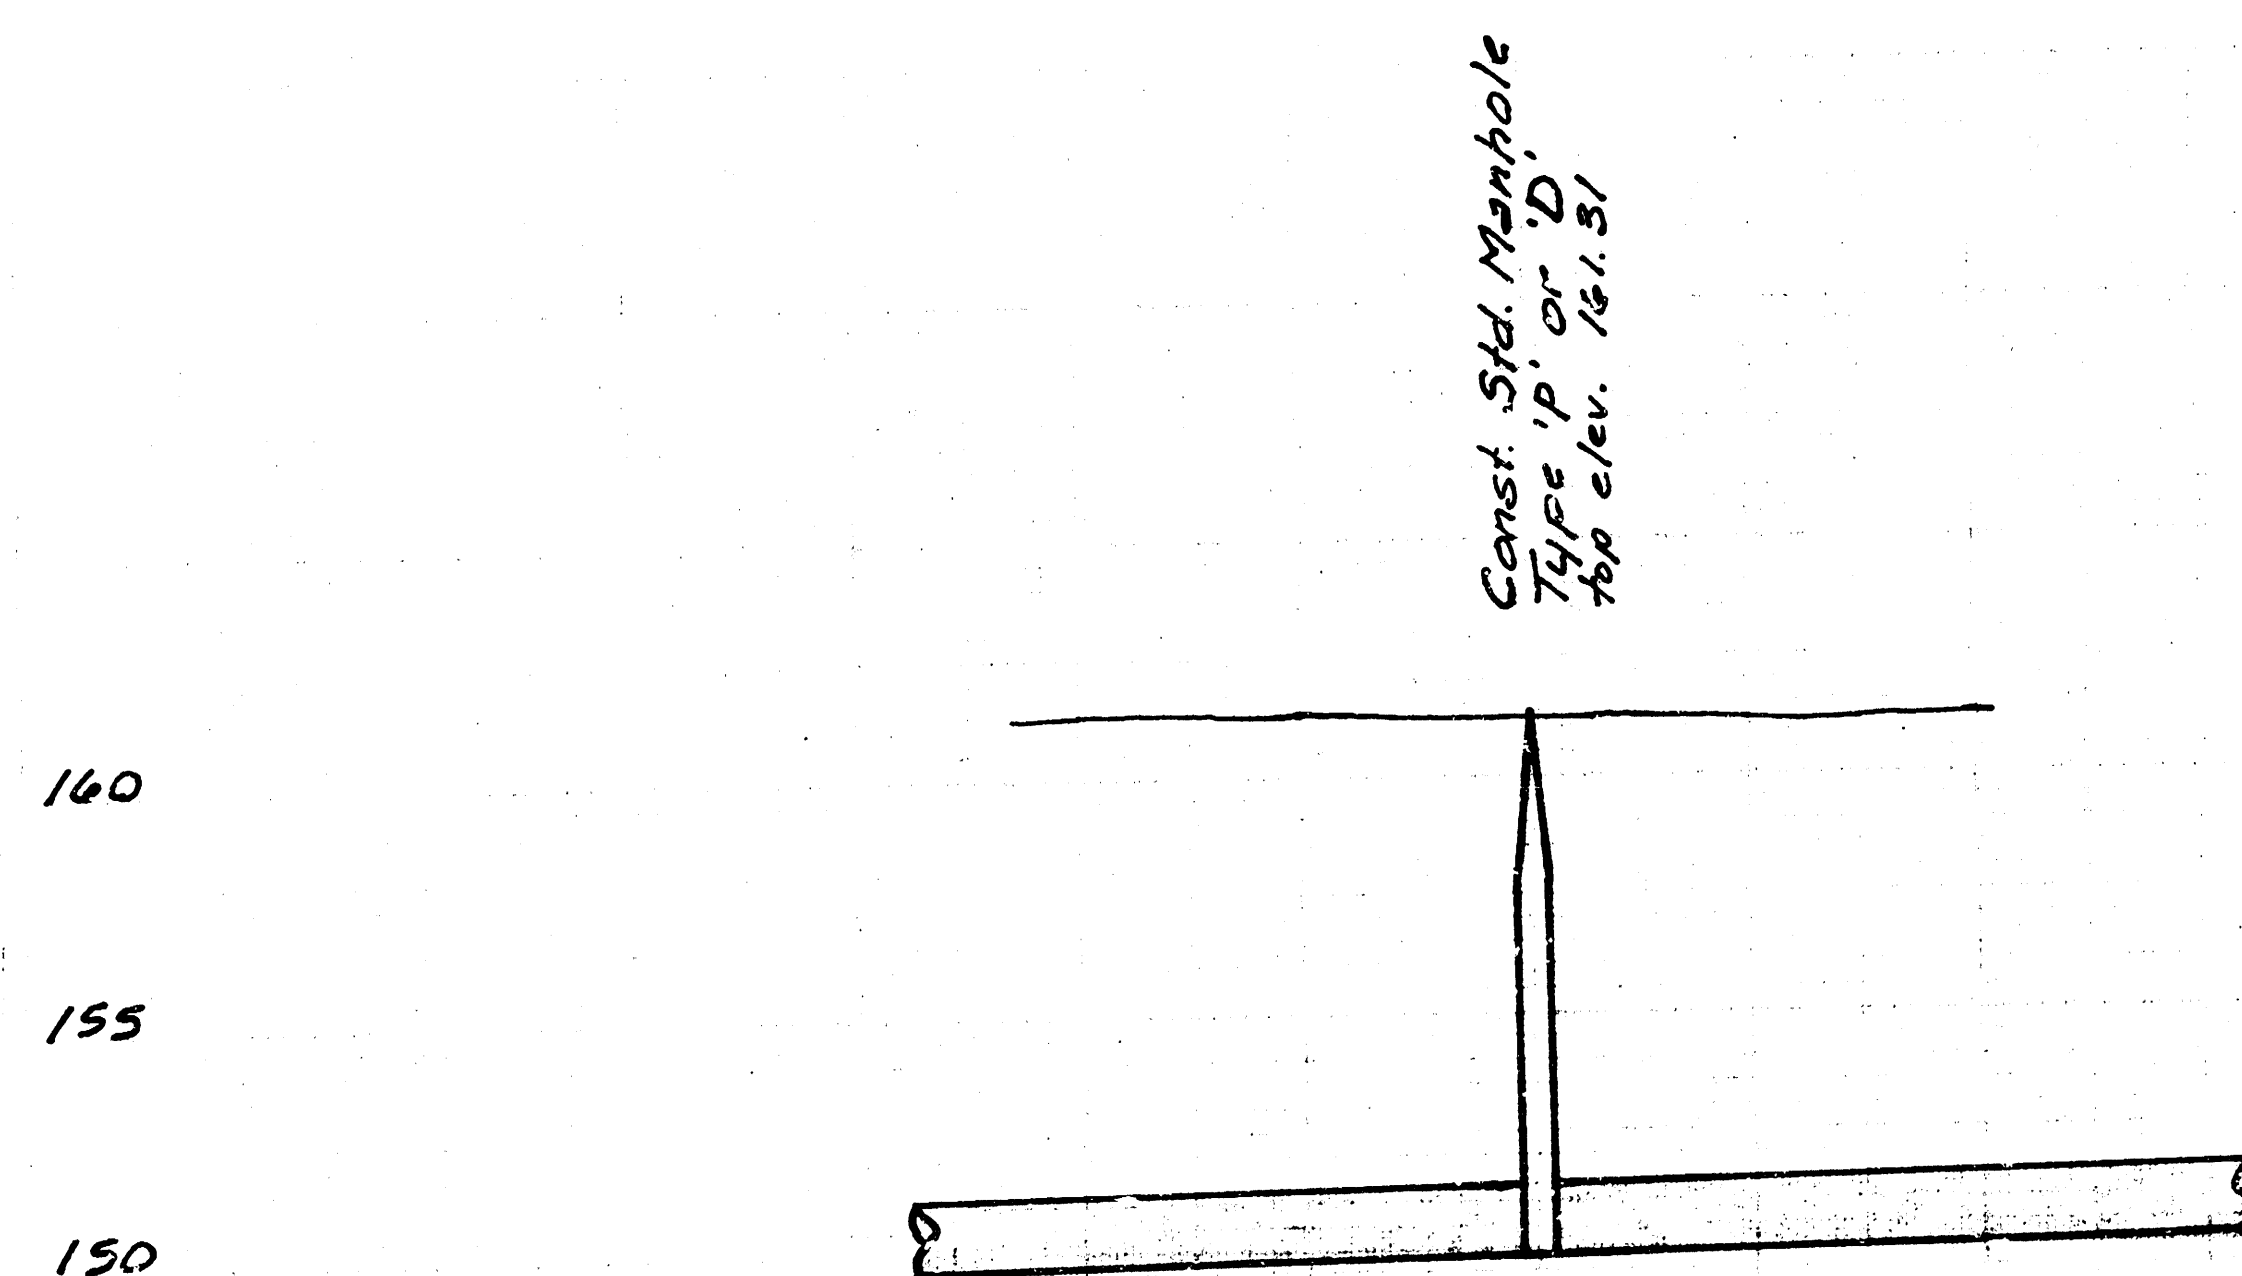
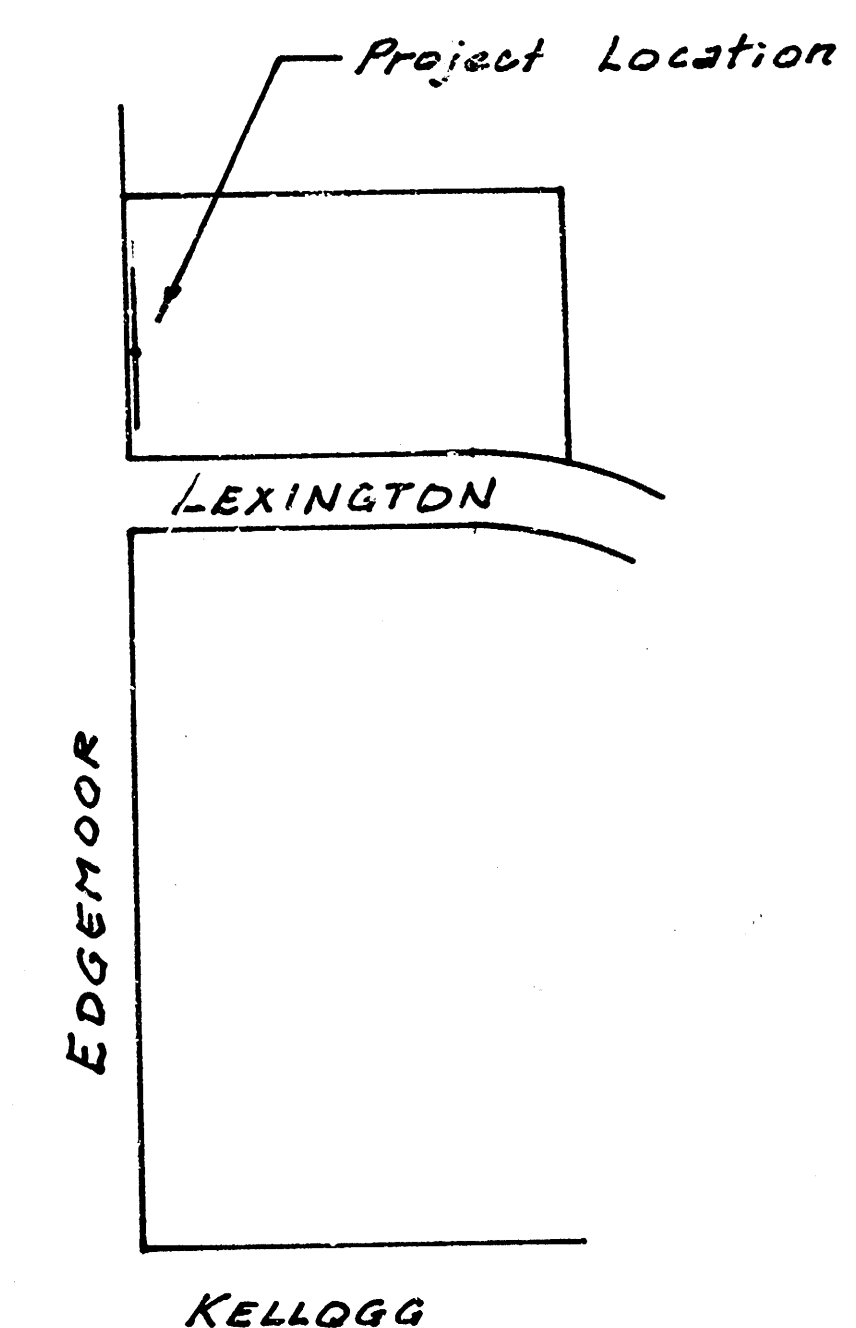


159.99 Elev. City of Wichita Bench Mark Disc.
N.E. Corner R.C.B.C. at Edgemoor and
East Branch Dry Creek (North of Kellogg).

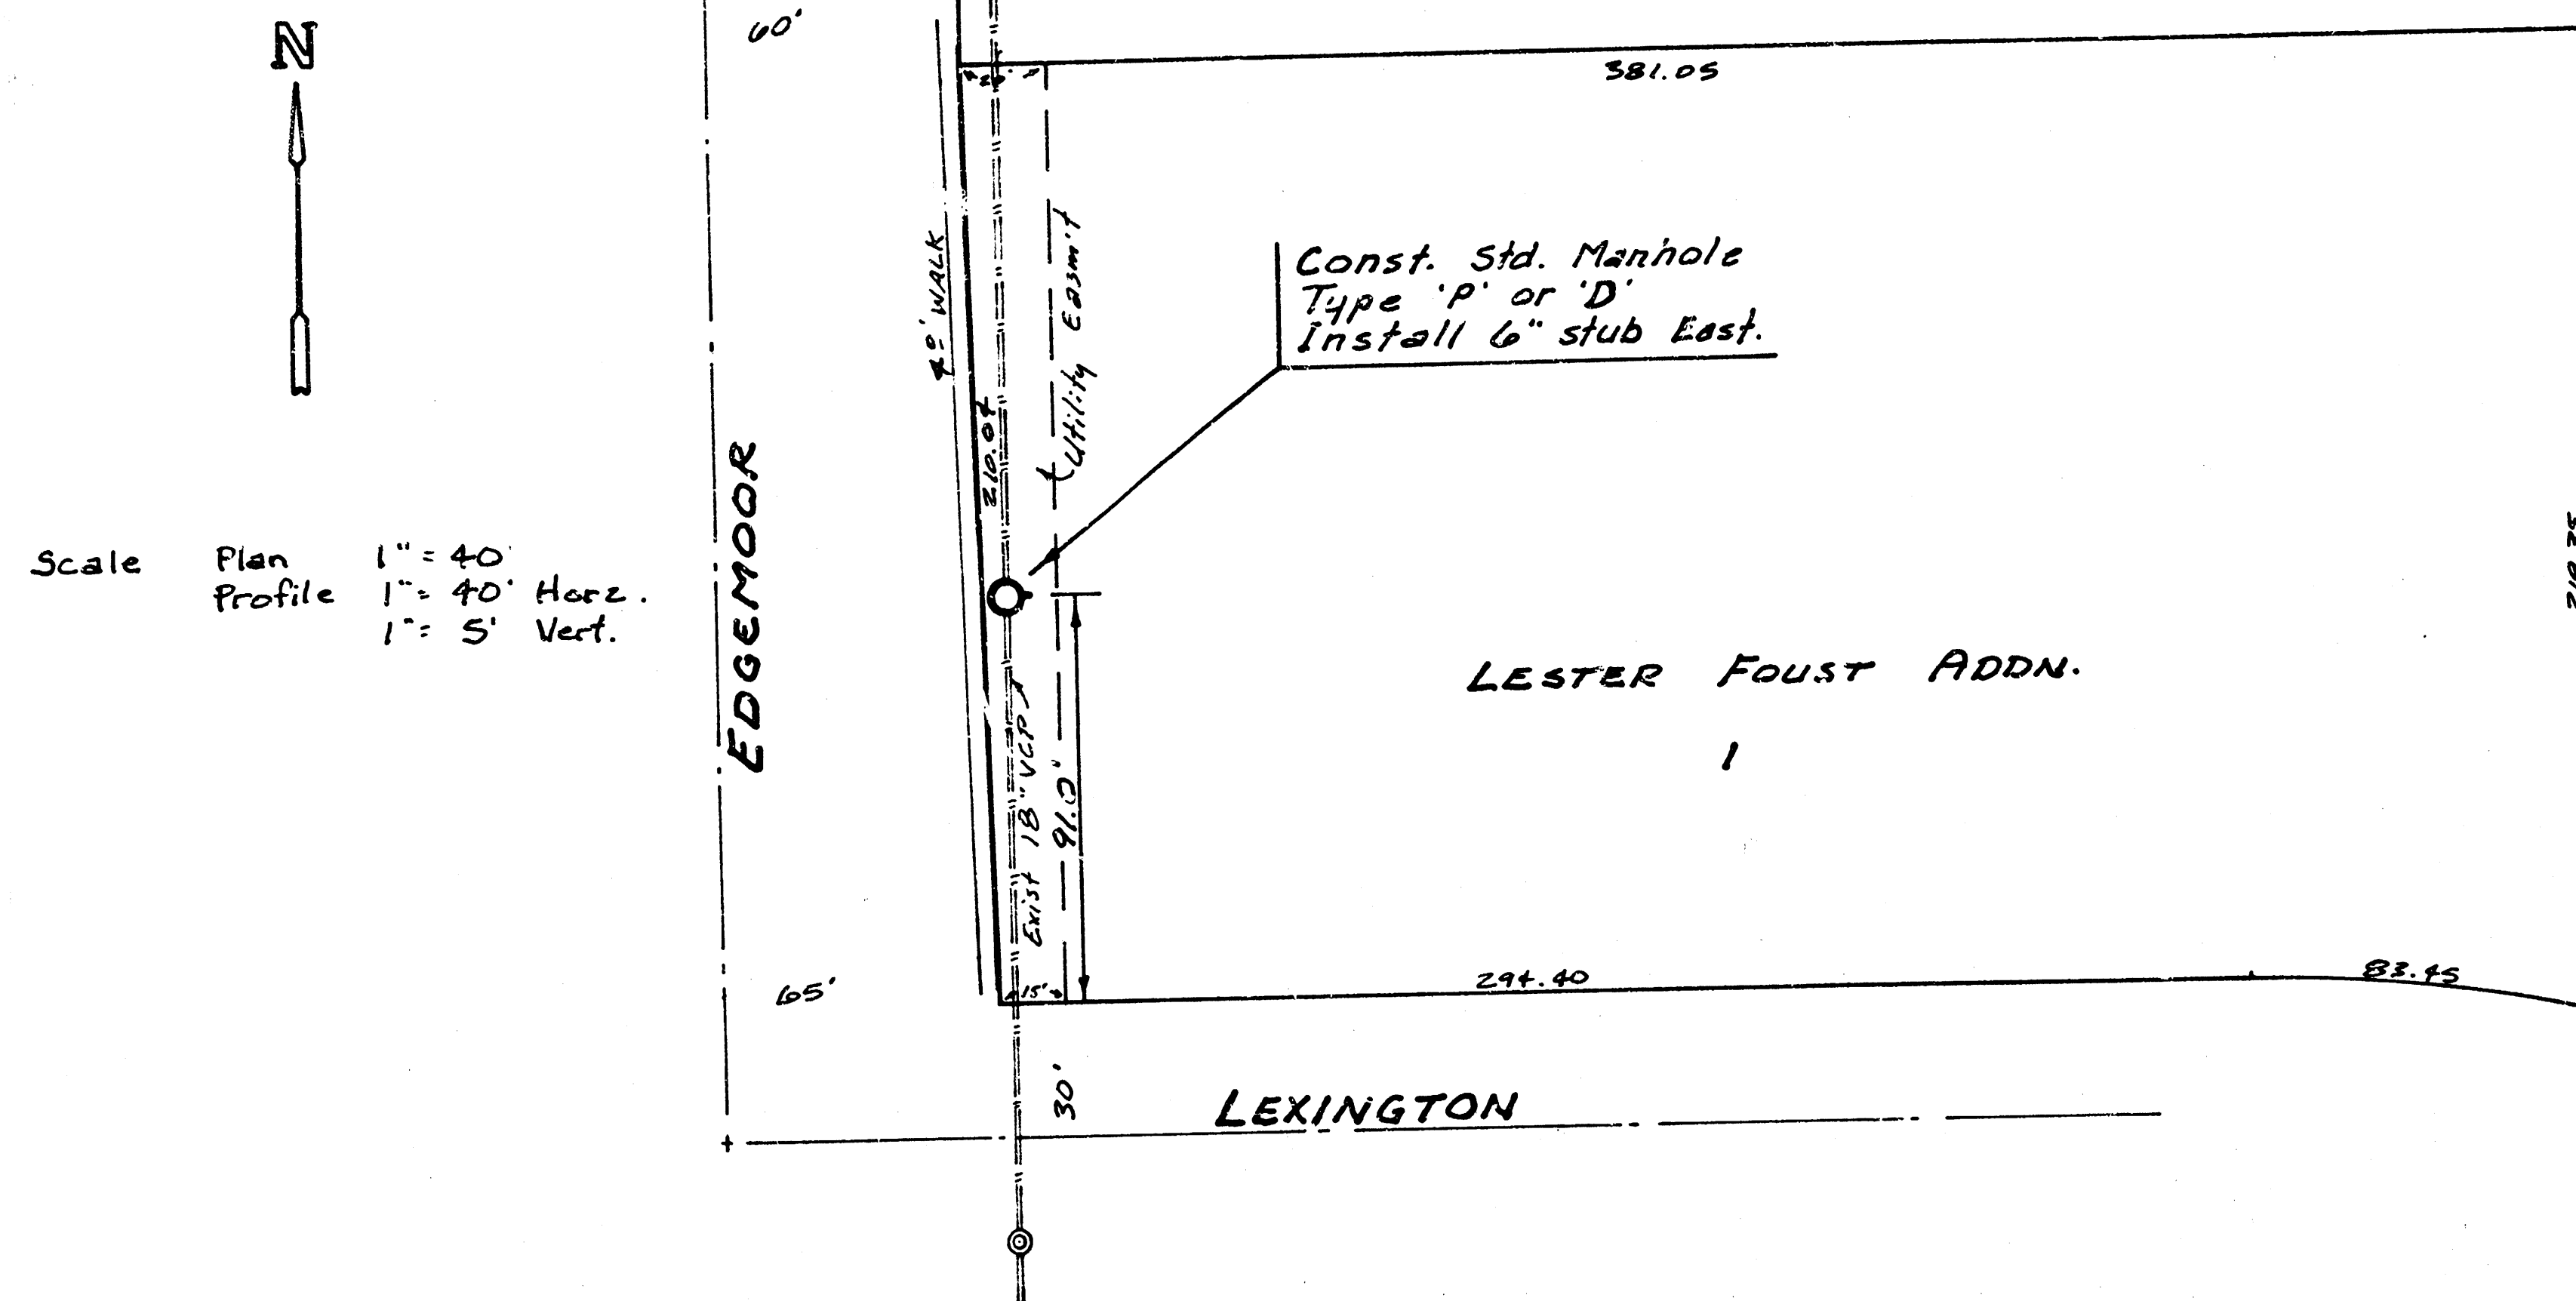

AS BUILT
RPL
12.87


149.85 Elev. 18" V.C.P.
150.85 Elev. 6" stub E.
151.51 Elev.

LATERAL 110, MAIN 2, SANITARY SEWER NO. 12

PROJ. NO. 458-76-245- 81682-000-000-001

CITY OF WICHITA, KANSAS

M. E. LINDEBAK - CITY ENGINEER

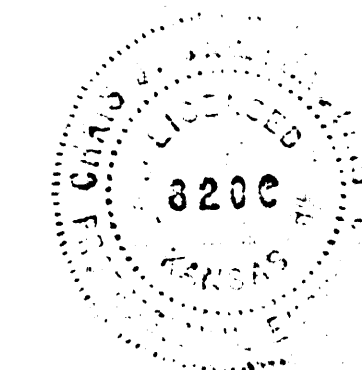

PROJECT DESCRIPTION
PROJECT NUMBER

10 10 4 11 1/2

FILMED FROM THE BEST
AVAILABLE COPY