





Scale Plan 1" = 40'
 Profile 1" = 40' Horiz.
 1" = 5' Vert.

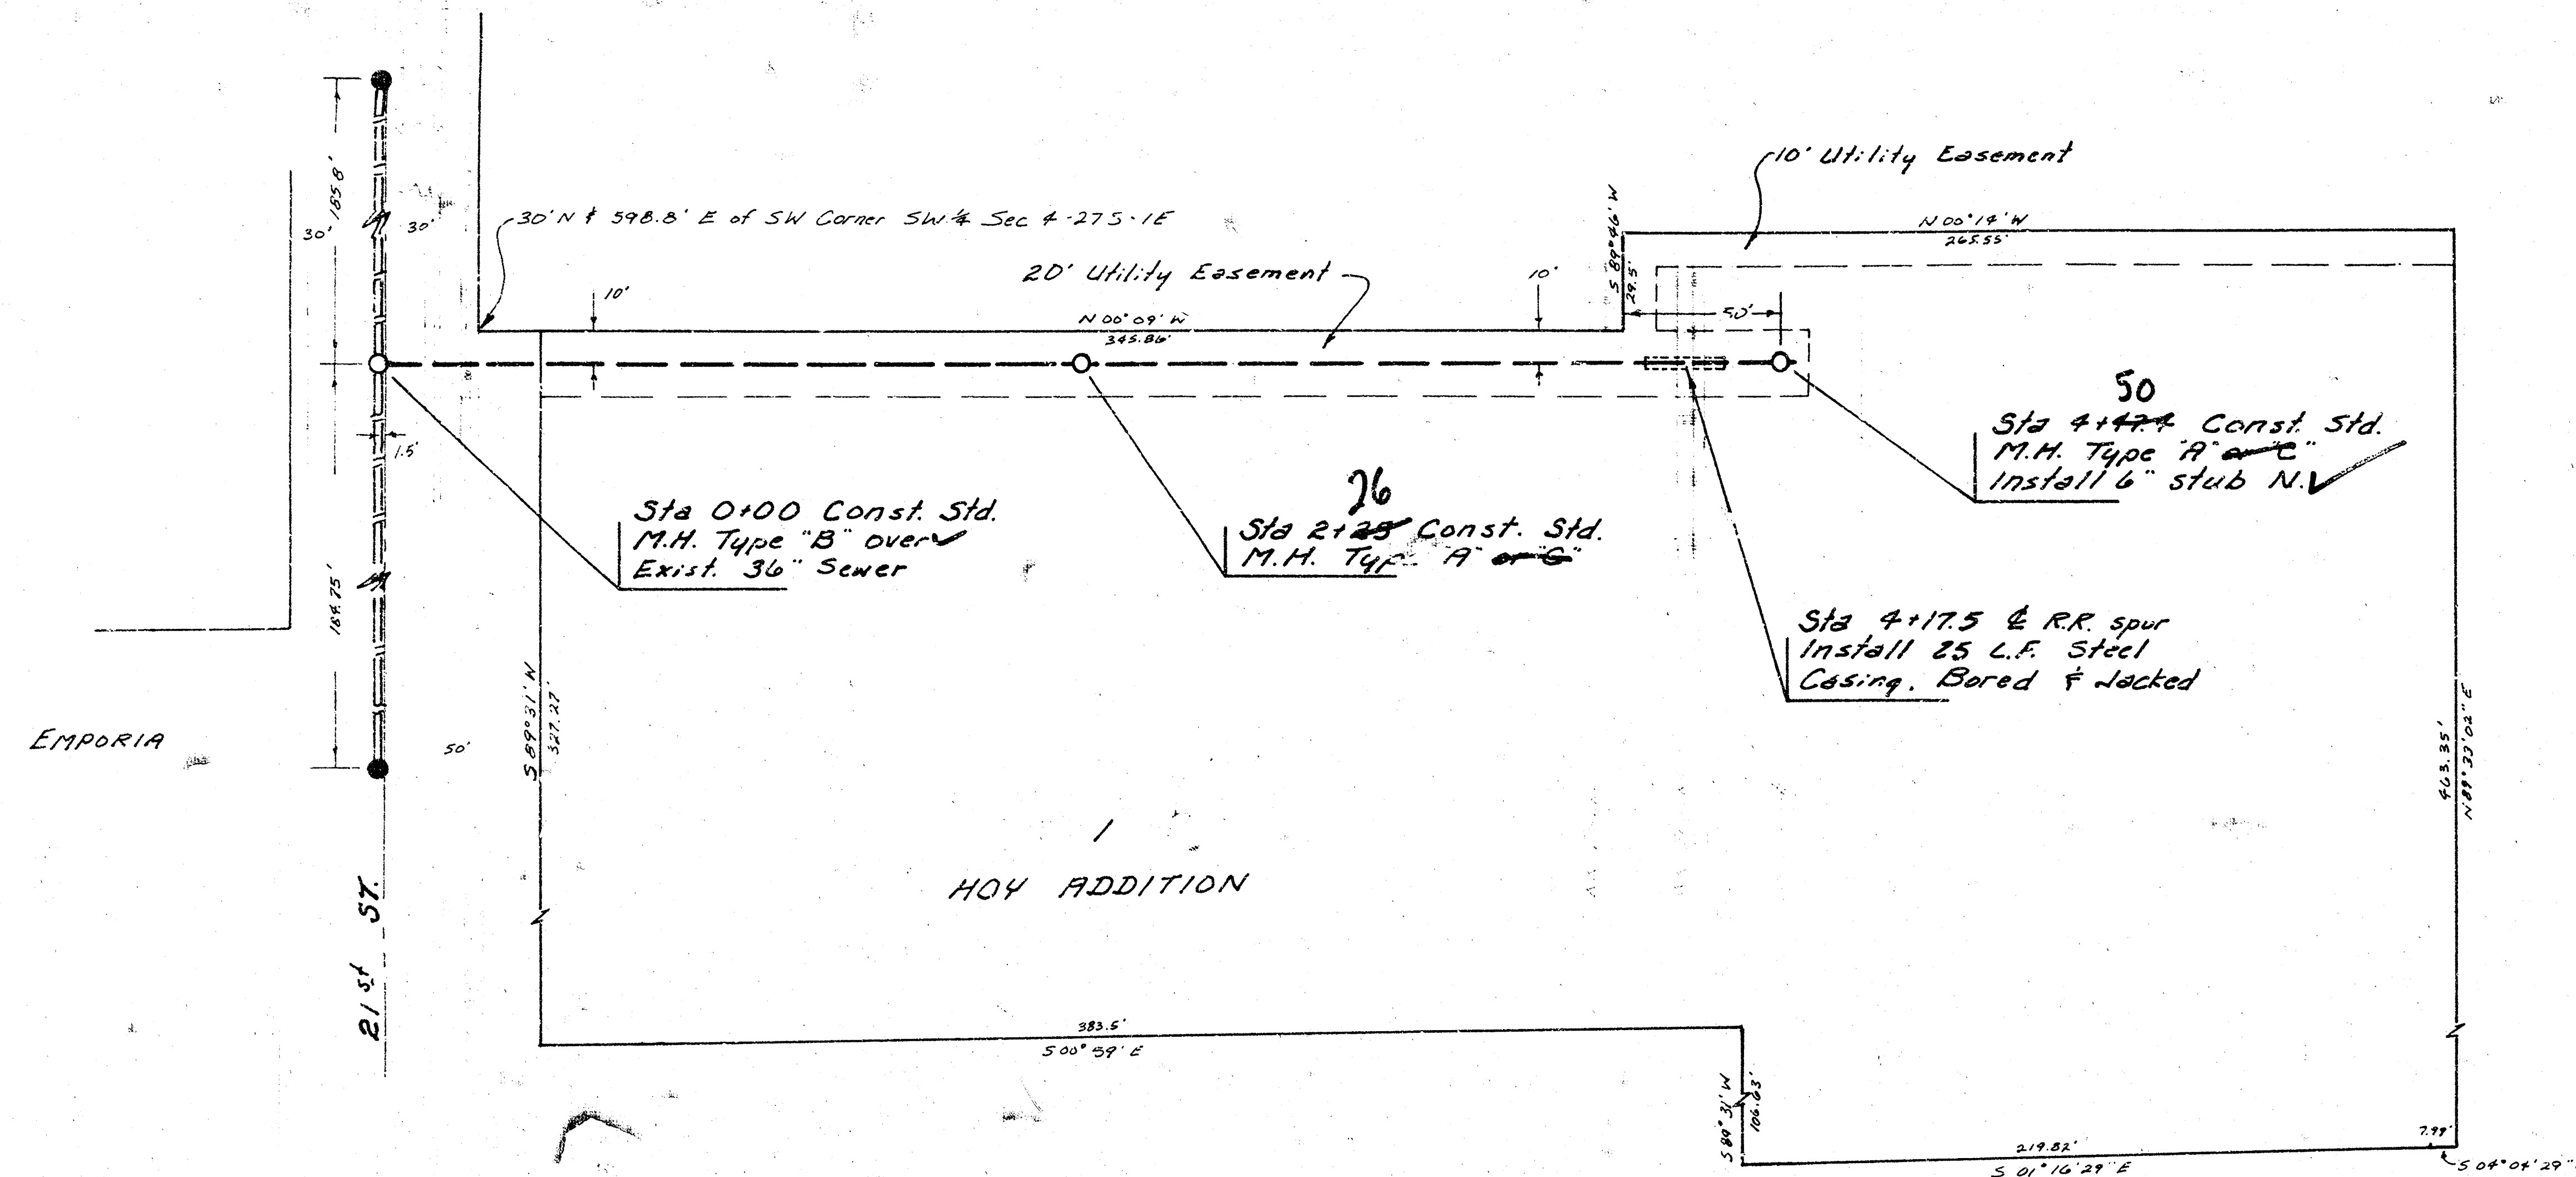

As Built
 JJB
 11/81

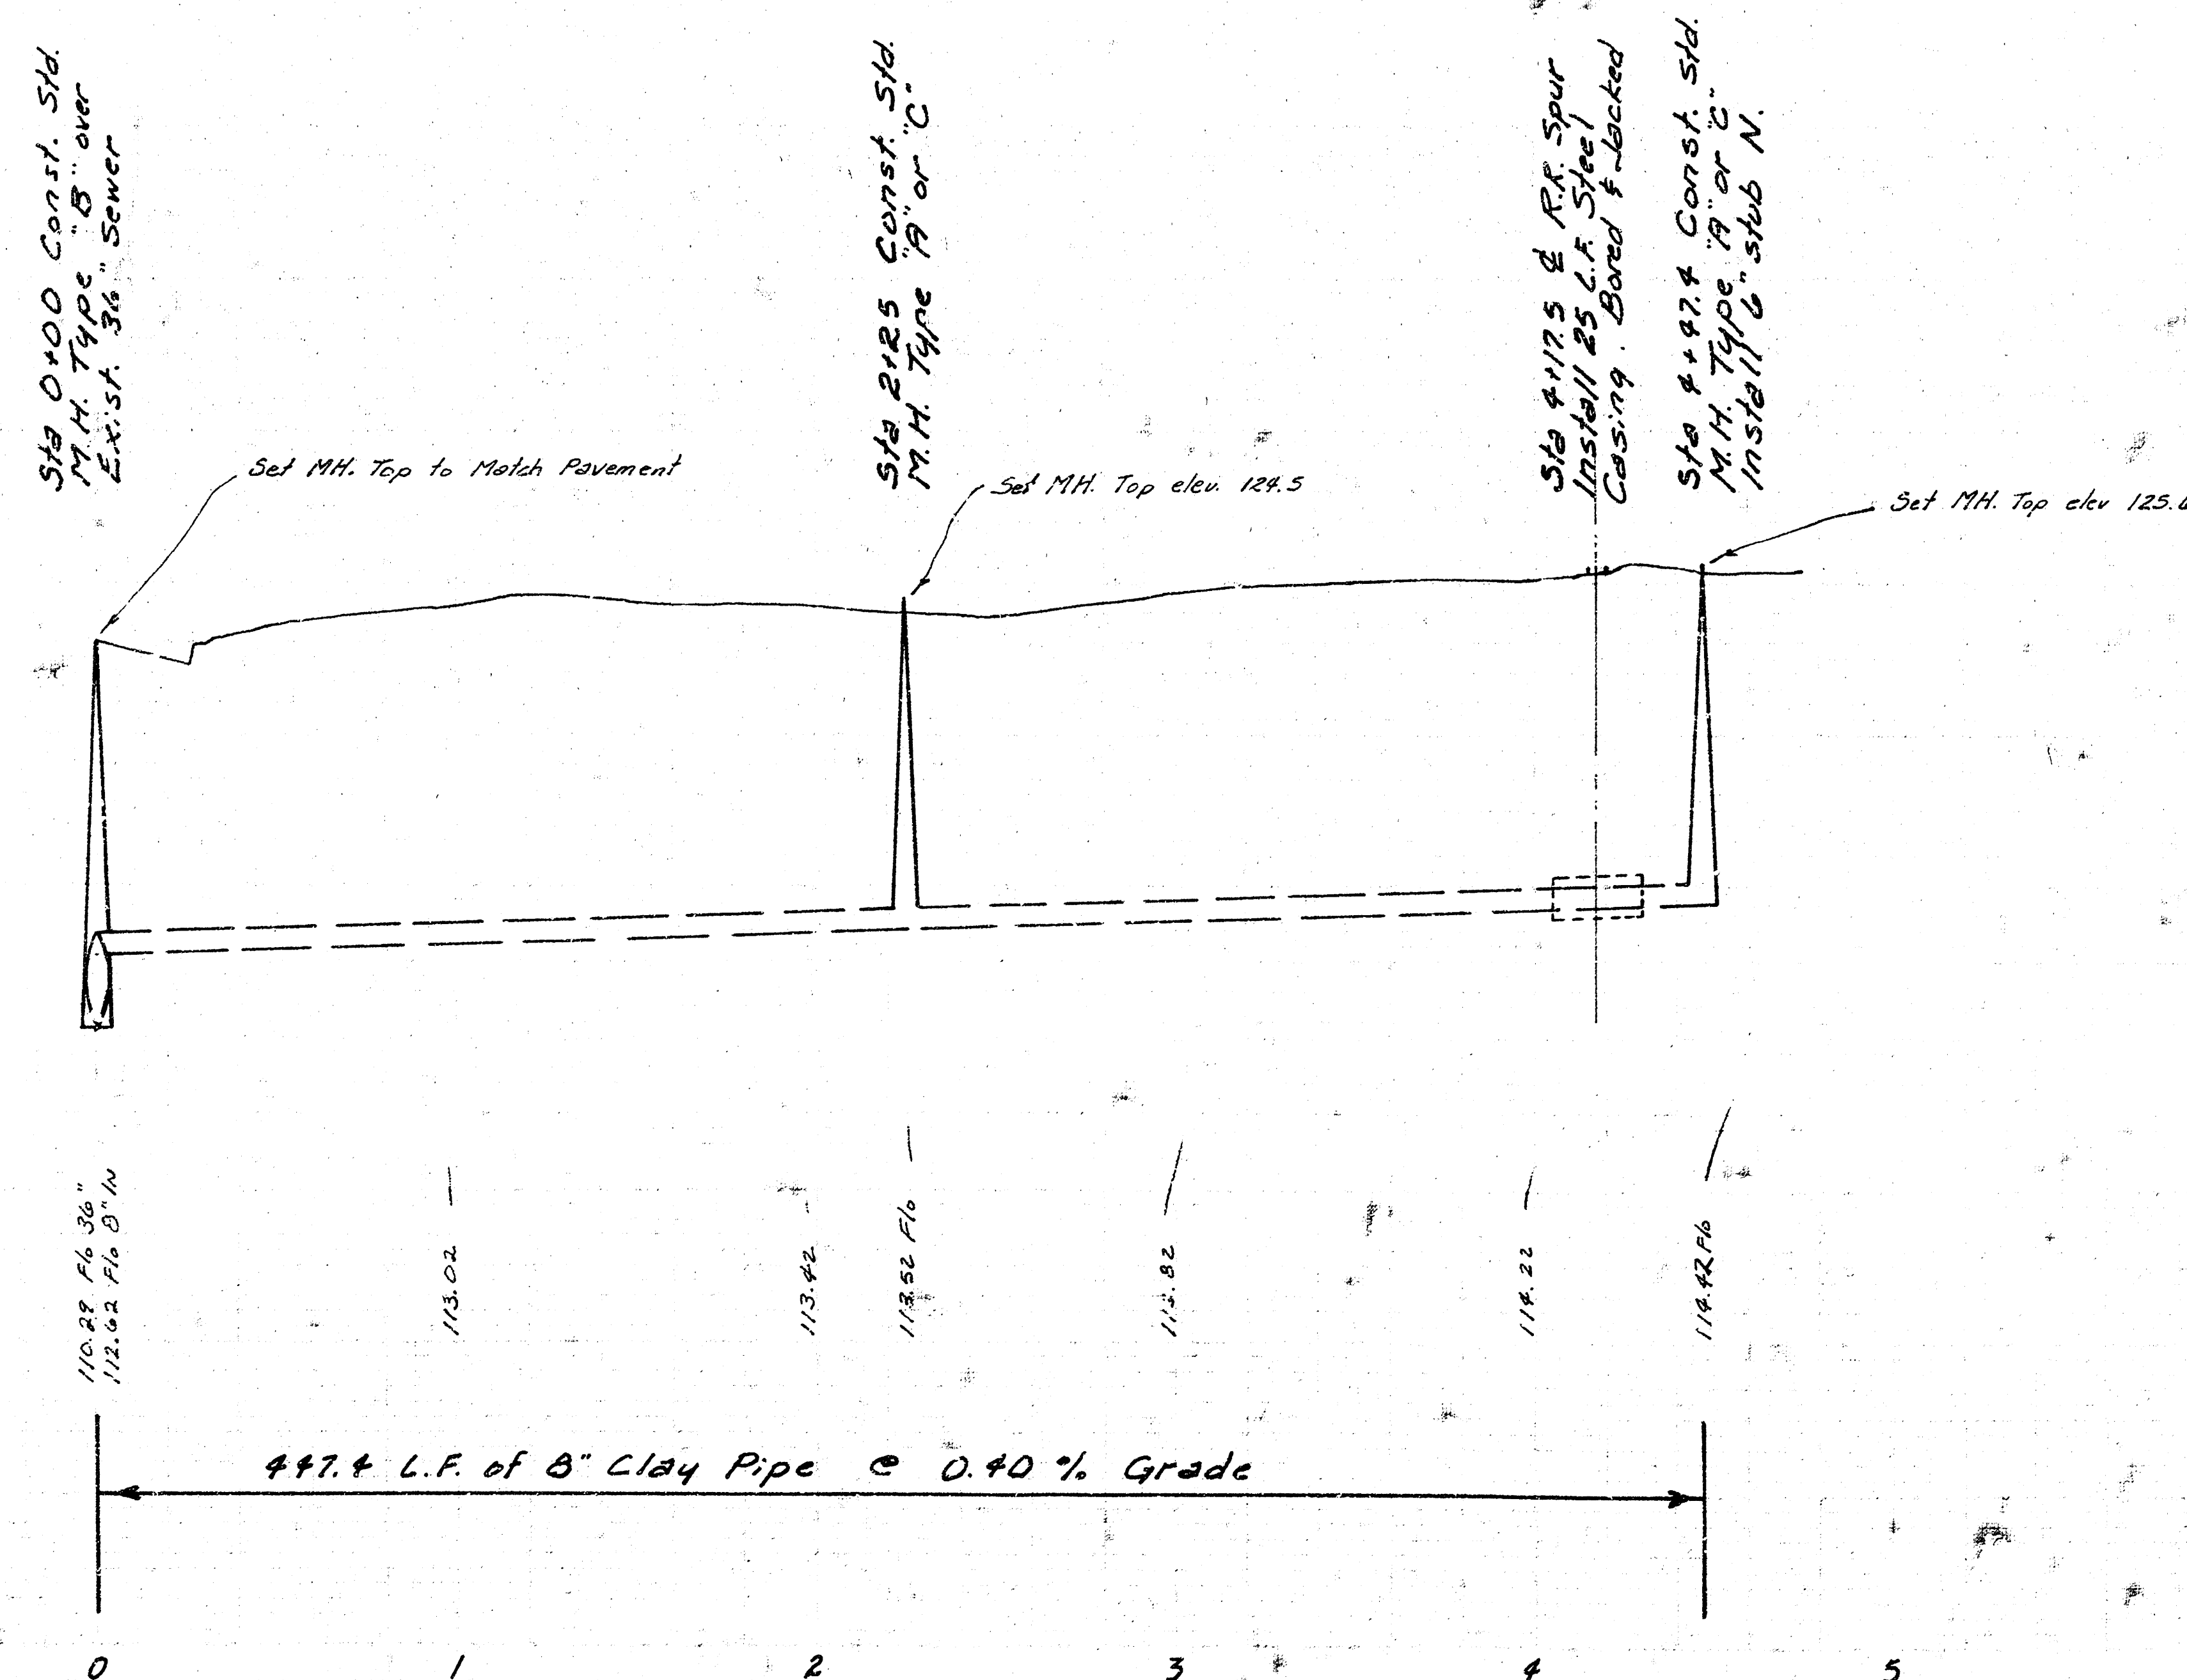

LAT 44, SAN. SEWER NO. 20
 CITY OF WICHITA, KANSAS
 R.W. BRUGGEMAN
 DIRECTOR OF ENGINEERING CITY ENGINEER
 PROJ. NO. 468-76-245-81072-000-001