

SANITARY SEWER PLANS

LAT. 46, S.S. NO. 20

PROJECT NO

468-76-245-81497-000-000-001

CITY OF WICHITA KANSAS
MICHAEL E. LINDEBAK, CITY ENGINEER
DEC. 1985

GENERAL NOTES


1. CONTRACTOR SHALL AVOID UNCOVERING EXISTING WATER LINES UNLESS ABSOLUTELY NECESSARY. UNCOVERING SHALL BE DONE ONLY IN THE PRESENCE OF A WATER DEPARTMENT ENGINEER.
2. THE CONTRACTOR SHALL BE RESPONSIBLE FOR PRESERVING PROPERTY IRONS. THE CONTRACTOR SHALL BE REQUIRED TO RE-ESTABLISH ANY PROPERTY IRONS WHICH ARE DAMAGED OR DESTROYED BY HIS CONSTRUCTION OPERATIONS. SUCH IRONS SHALL BE RE-ESTABLISHED BY A LICENSED LAND SURVEYOR OR A LICENSED PROFESSIONAL ENGINEER IN ACCORDANCE WITH STATE LAWS.
3. CONTRACTOR SHALL NOTIFY THE UTILITY COMPANIES OF CONSTRUCTION SCHEDULING.
4. EXISTING UTILITIES AND THEIR LOCATIONS, AS SHOWN ON THE PLANS, REPRESENT THE BEST INFORMATION OBTAINABLE FOR DESIGN. LOCATION INFORMATION HAS BEEN OBTAINED FROM THE VARIOUS UTILITY COMPANIES AND IS EITHER FROM COMPANY RECORD DRAWINGS OR COMPANY PROVIDED FIELD LOCATIONS. THE PLAN LOCATIONS SHOWN ARE NOT GUARANTEED. ADDITIONAL EXISTING UTILITIES MAY ALSO BE ENCOUNTERED.
5. COST OF SEEDING AND MULCHING SHALL BE SUBSIDIARY TO PROJECT.

NOTE: NOTIFY THE FOLLOWING COMPANIES PRIOR TO ANY EXCAVATION:

BELL TELEPHONE COMPANY	268-2256
CABLEVISION	262-0661
GAS SERVICE COMPANY	263-7511
KANSAS GAS & ELECTRIC	261-8248
KANSAS ONE-CALL	1-800-344-7233


BENCH MARKS

B.M. 103.44 "G" IN GLOBE ON 725' BLOCK IN SIDEWALK
EL GREENWOOD - SS INDIANAPOLIS

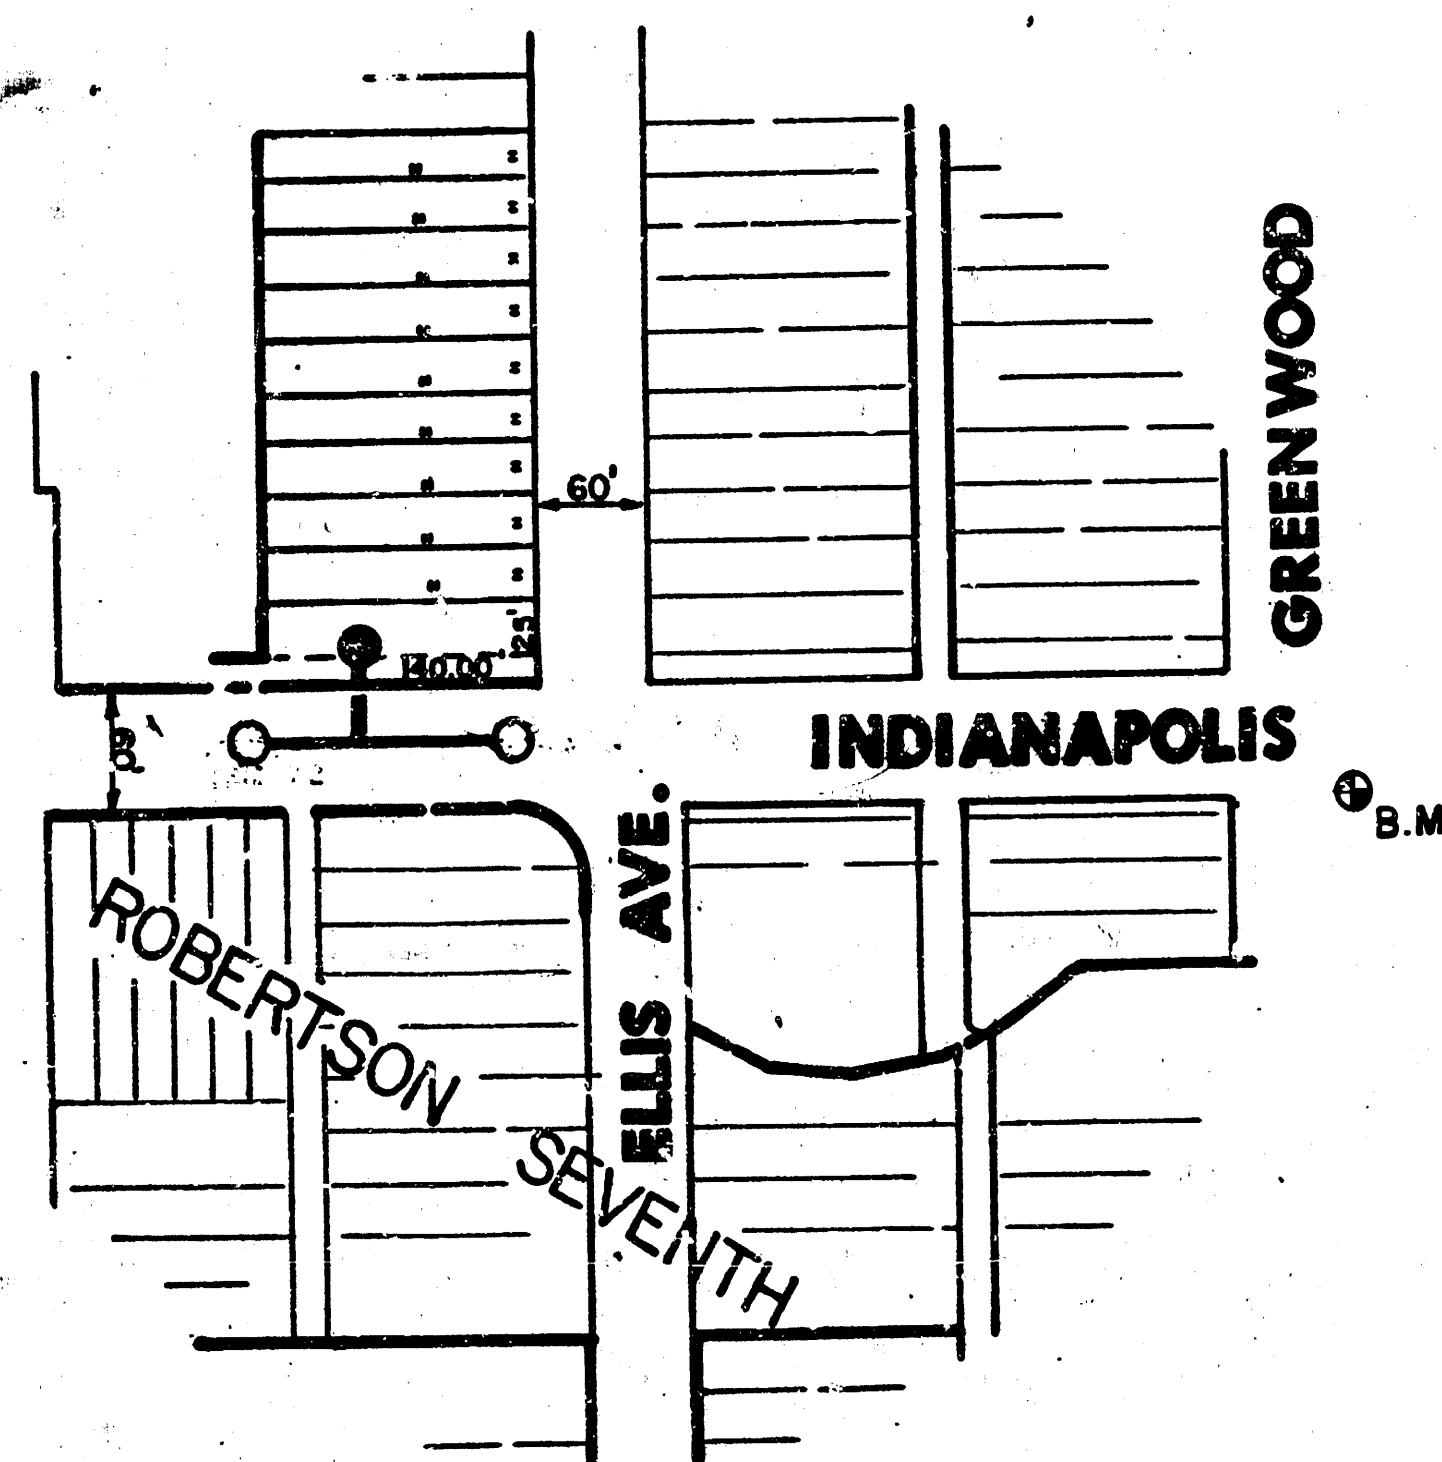

BENEFIT DISTRICT:


The east 70 feet of Lot 63 and the east 70 feet of the north 10.33 feet of Lot 65 on Ellis Avenue in New York 2nd Addition.

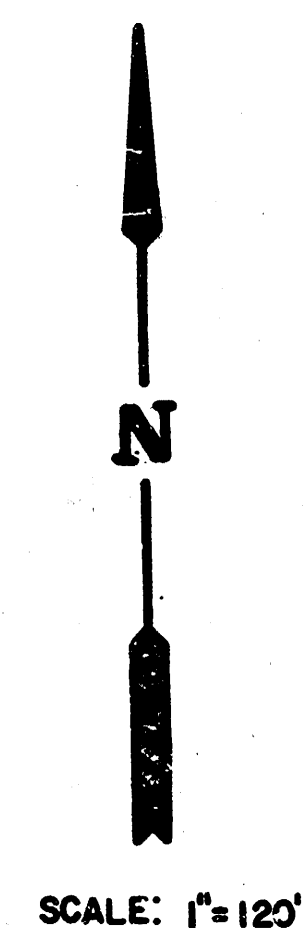

INDEX TO DRAWINGS



SHEET NO.	DESCRIPTION
1	TITLE & LOCATION
2	PLAN & PROFILE

AS BUILT
3-18-86
RDL

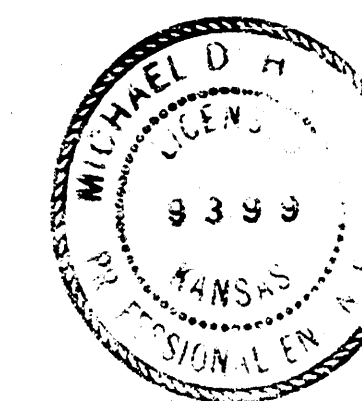

	SANITARY SEWER		Design
	EXTENSION		Drawn by
	LAT. 46 S.S. NO 20		Checked by
			Date
MID-KANSAS ENGINEERING CONSULTANTS PA 3500 NORTH ROCK ROAD BUILDING #900 WICHITA, KANSAS 67226		682-6561	Sheet 1 of 2

FILMED FROM THE BEST AVAILABLE COPY

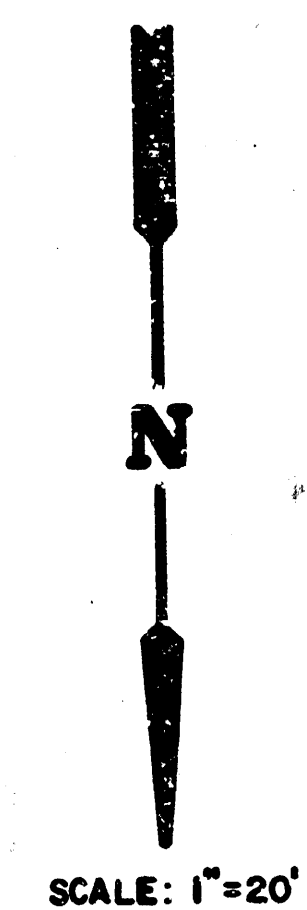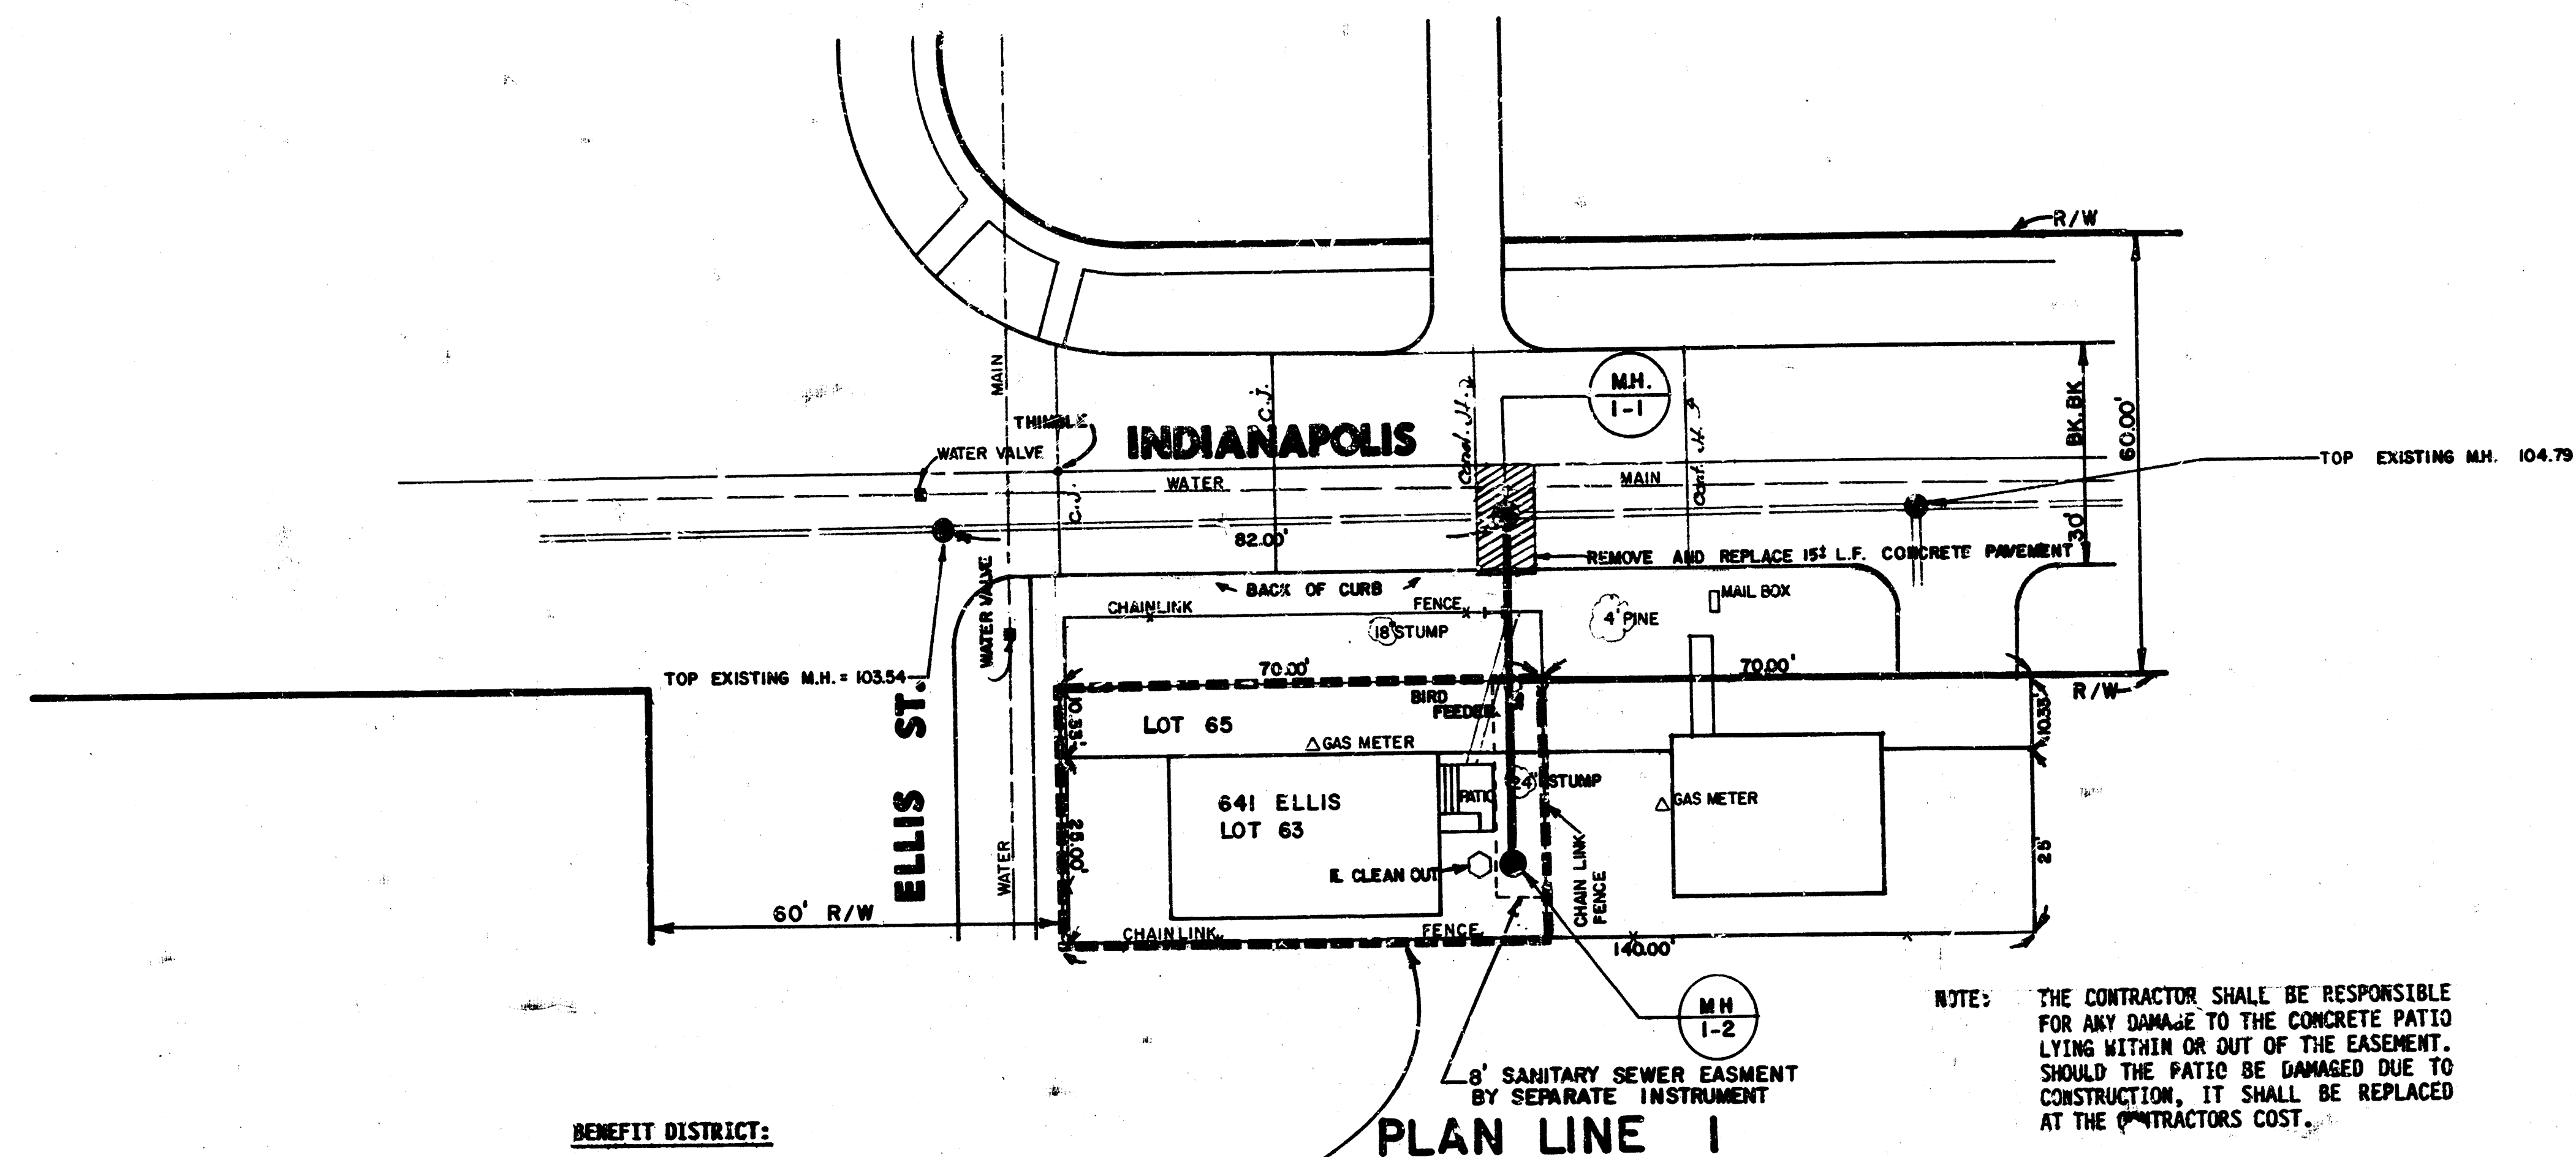

BENEFIT DISTRICT:
 The east 70 feet of Lot 63 and the east 70 feet of the north 10.33 feet of Lot 65 on Ellis Avenue in New York 2nd Addition.

PLAN LINE I

